

11/18/11/19

05-366658

PERMIT

SEWAGE DISPOSAL SYSTEM

MARYLAND STATE DEPARTMENT OF HEALTH DISTRICT

HOWARD COUNTY

BUREAU OF ENVIRONMENTAL HEALTH

461-9933

P 43/3P

A REPAIR

DATE 11/30/88

DATE SYSTEM APPROVED 11/28/88

INSPECTOR C. Williams

Jack Fyock

IS PERMITTED TO INSTALL ALTER X

ADDRESS PHONE 988-9270

SUBDIVISION Holiday Hills ROAD 10621 Vista Road LOT 39

PROPERTY OWNER Shields

ADDRESS

IF GARBAGE GRINDER IS USED INCREASE SEPTIC TANK CAPACITY BY 50% AND ABSORPTION AREA BY 22%.

GARBAGE GRINDER? YES NO X

SEPTIC TANK CAPACITY 1000 GALLONS NUMBER OF BEDROOMS 3

REPAIR - CALL FOR INSPECTION WHEN GROUND IS OPENED UP SO SANITARIAN CAN RECOMMEND REPAIR.

11/18 Recommended site - shallow trench 6' wide from inlet 2'-2 1/2' x 90' long; pipe thru center of trench call for final; pipe to 90' off septic tank cleanout to 13' off L property line; sch. 40 or equiv. From s.t. to new trench; call for insp. no pub sewer avail adj props va; no wells w/in 100' of new repair

PLANS APPROVED BY C. Williams DATE 11/15/88 per info given C. B. + PR

COVER NO WORK UNTIL INSPECTED AND APPROVED

NEITHER THE HOWARD COUNTY COUNCIL NOR THE HEALTH DEPARTMENT IS RESPONSIBLE FOR THE SUCCESSFUL OPERATION OF ANY SYSTEM.

NOTE: CLEANOUT REQUIRED EVERY 70 FEET OF SEWER LINE AND/OR AT 90° SWEEPS IN LINES FROM HOUSE TO DRAIN FIELDS

NOTE: ALL PARTS OF SEPTIC SYSTEMS (I.E. TANK, DISTRIBUTION BOX, TRENCHES) TO BE 100 FEET FROM WELL (UNLESS OTHERWISE SPECIFICALLY AUTHORIZED)

NOTE: IF DEEP TRENCHES ARE USED CALL FOR INSPECTION BEFORE AND AFTER PLACING GRAVEL IN TRENCHES

NOTE: NO DRY WELL SHALL EXCEED 15 FOOT IN DIAMETER NO ABSORPTION TRENCH TO EXCEED 100 FEET IN LENGTH.

NOTE: ALL PIPE FROM HOUSE TO SEPTIC TANK MUST BE CAST IRON OR SCHEDULE 40 PVC OR ABS

PERMIT VOID AFTER TWO YEARS


NOTE: INSTALL STAND PIPE ON SEPTIC TANK AND DRY WELL STAND PIPES MUST BE 6 INCHES IN DIAMETER CAST IRON, CONCRETE OR TERRA COTTA OR PVC OR ABS ACCEPTED. IF TOP OF SEPTIC TANK IS DEEPER THAN 3 FEET, MANHOLE TO GRADE REQUIRED

NOTE: DISTRIBUTION BOXES MUST HAVE BAFFLES

*INSTALLER IS RESPONSIBLE FOR OBTAINING FINAL APPROVAL ON THIS PERMIT

*CALL 461-9933 FOR INSPECTION OF SEPTIC SYSTEMS.

P 43/3P

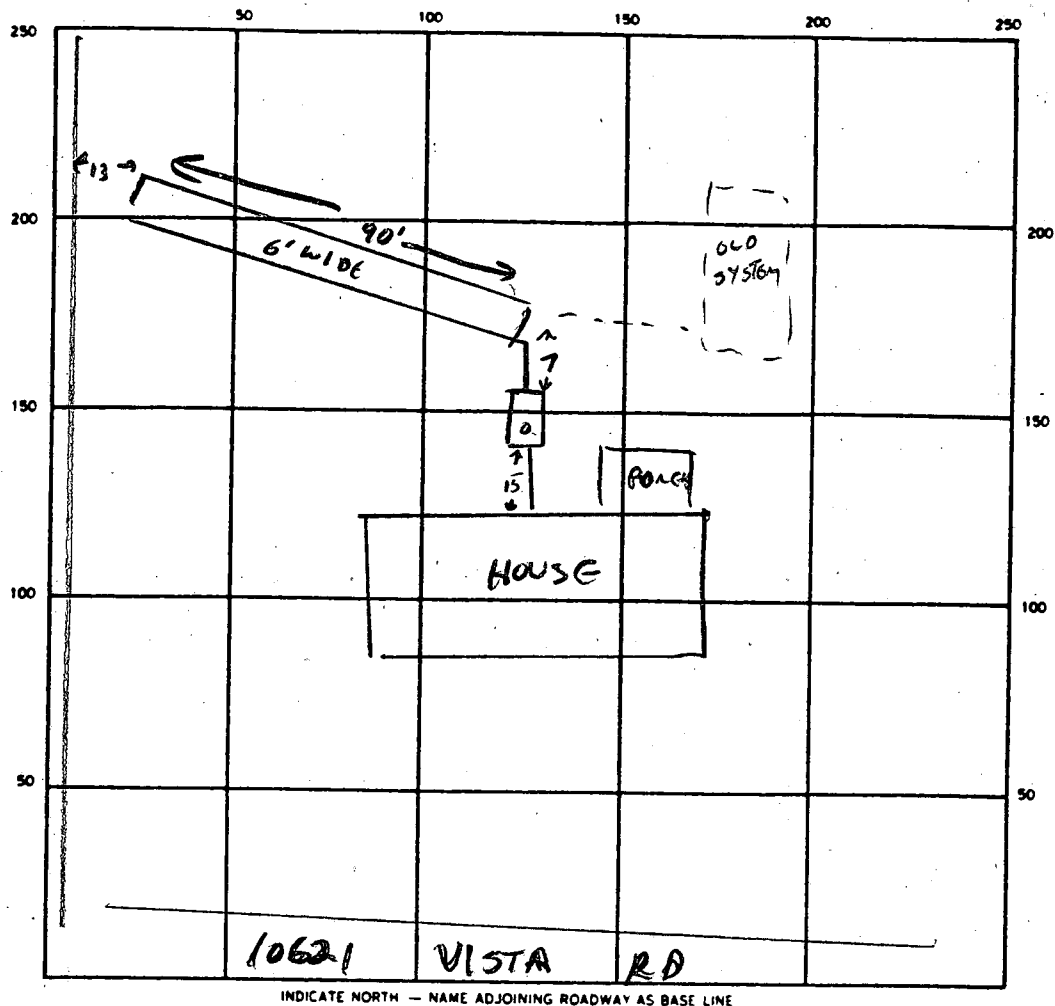

SEPTIC TANK. LEVEL EXISTING CLEANOUTS _____

DISTRIBUTION BOX. LEVEL N/A

DRAIN FIELD/TILE FIELD. DEPTH EST-4' FT. TRENCH WIDTH 6 FT. INLET DEPTH EST 2 1/2 FT.

EFFECTIVE GRAVEL DEPTH 1 1/2 FT. TOTAL LENGTH 90' FT.

NUMBER OF TRENCHES 1 ONE SIDEWALL/BOTTOM AREA 6 x 90 = 540 SQ. FT.

DRYWELL INSIDE DIAMETER — FT. EFFECTIVE DEPTH BELOW INLET — FT.

ABSORBENT AREA 540 SQ. FT.

REMARKS _____

11/19/88 SYSTEM INSTALLED ON SATURDAY WITHOUT INSPECTION.

NOTES PEN INSTALLER, CW

DATE SYSTEM APPROVED 11/28/88 INSPECTOR CW

9/18/69
9:30 + 2 PM

PERMIT

SEWAGE DISPOSAL SYSTEM

MARYLAND STATE DEPARTMENT OF HEALTH

HOWARD COUNTY

ELLICOTT CITY

DISTRICT 5

DATE 9/5/69

INDEXED

Robert Dubin IS PERMITTED TO INSTALL ALTER X

ADDRESS Rt. 2, Clarksville, Md. PHONE 286-3432

A SEWAGE DISPOSAL SYSTEM LOCATED AT _____

SUBDIVISION Holiday Hills ROAD 117 Vista Road LOT 39, Sec. 1

PROPERTY OWNER Thomas Shields - 286-3621

ADDRESS _____

SPECIFICATIONS

DRAIN FIELD _____ DEPTH _____ FEET, BOTTOM AREA _____ SQ. FT.

SEEPAGE PITS _____ ABSORBENT SIDE-WALL AREA _____ SQ. FT.

SEPTIC TANK CAPACITY _____ GALLONS

FOR GARBAGE GRINDER, INCREASE DISPOSAL AREA 22% & TANK CAPACITY 50%.

OTHER REPAIR - Trench - 40 ft. long, 12 ft. deep, 18" wide with 10 ft. stone.

CALL FOR INSPECTION WHEN TRENCH IS EXCAVATED BEFORE ANY GRAVEL IS INSTALLED.

PLANS APPROVED BY Palmer F. Wine DATE 9/5/69


FILL SEPTIC TANK AND DISTRIBUTION BOX WITH WATER BEFORE CALLING FOR AN INSPECTION. COVER NO WORK UNTIL INSPECTED AND APPROVED.

NEITHER THE HOWARD COUNTY COMMISSIONERS NOR THE HEALTH DEPARTMENT IS RESPONSIBLE FOR THE SUCCESSFUL OPERATION OF ANY SYSTEM.

**NOTIFY THE HEALTH DEPARTMENT 48 HOURS
BEFORE EXCAVATIONS ARE TO BE BACK FILLED.**

214785-

6.5
130
6.50

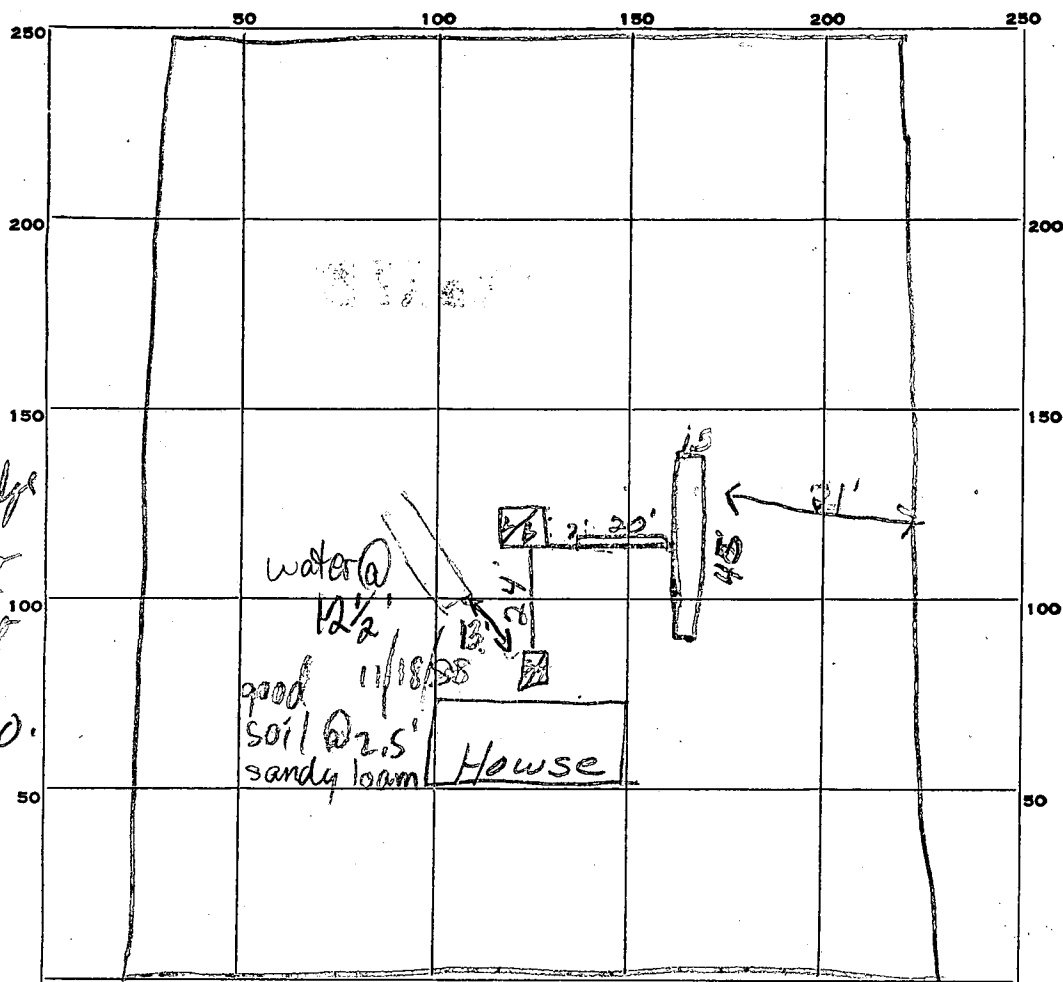

INDICATE NORTH. - NAME ADJOINING ROADWAY AS BASE LINE.

Vista Dr

PERMIT CARD _____

SEPTIC TANK, LEVEL _____

CLEANOUTS _____

DISTRIBUTION BOX, LEVEL _____

TRENCH, DEPTH 7 FT. TRENCH WIDTH 1.5 FT.

GRAVEL DEPTH 60 IN. TOTAL LENGTH 65 FT.

NUMBER OF TRENCHES 2 TOTAL BOTTOM AREA 650

SEEPAGE PITS, INSIDE DIAMETER _____ FT. DEPTH BELOW INLET _____ FT.

ABSORBENT AREA _____ SQ. FT.

REMARKS _____

DATE SYSTEM APPROVED

9/18/69

INSPECTOR

[Signature]