

# PERMIT

## SEWAGE DISPOSAL SYSTEM

DEPARTMENT OF HEALTH AND MENTAL HYGIENE

04-356233

P 57007-D

A 44257

DISTRICT 4th

DATE 6/28/96

HOWARD COUNTY HEALTH DEPARTMENT

BUREAU OF ENVIRONMENTAL HEALTH

~~XXXXXXXX~~

313-2640

DATE SYSTEM APPROVED

7/29/96

INSPECTOR

DKS

(per Jim of NV Homes)

South Carroll Backhoe, Inc.

IS PERMITTED TO INSTALL ☒ ALTER

ADDRESS 4410 Salem Bottom Road, Westminster, MD 21157

PHONE 875-4197

SUBDIVISION Gwyndyl Oak Estates

LOT 27

ROAD 2864 Rolling Fork Way

PROPERTY OWNER

NV Homes

**BUILDING PERMIT SIGNED**

ADDRESS

**AND RETURNED**

SEPTIC TANK CAPACITY 1250

GALLONS

8-7-03 800/43485 - PORCH + DECK

NUMBER OF BEDROOMS

4

210

SQUARE FEET PER BEDROOM

LINEAR FEET OF TRENCH REQUIRED 280

TRENCHES - Trench to be 3 feet wide. Inlet 2 feet below original grade. Bottom maximum depth 4 feet below original grade. Effective area begins at 2 feet below original grade. 2 feet of stone below distribution pipe.

LOCATION - Beginning from the back right lot corner, place distribution box 160 feet down the back lot line (315.00') and 100 feet off that same lot line when facing the lot from the right-of-way. Run trenches on contour in both directions.

NOTES - No trench to exceed 100 feet in length. Provide 6" - 8" diameter cleanout and cap to grade or above on septic tank. OK/MR

PLANS APPROVED BY Amy McMillen/Glen Savage

DATE 4/24/96

COVER NO WORK UNTIL INSPECTED AND APPROVED

NEITHER THE HOWARD COUNTY COUNCIL NOR THE HEALTH DEPARTMENT IS RESPONSIBLE FOR THE SUCCESSFUL OPERATION OF ANY SYSTEM

NOTE: CLEANOUT REQUIRED EVERY 70 FEET OF SEWER LINE AND/OR AT 90° SWEEPS IN LINES FROM HOUSE TO DRAIN FIELDS, 90° ELBOWS NOT ACCEPTABLE.

NOTE: ALL PARTS OF SEPTIC SYSTEMS (I.E. TANK, DISTRIBUTION BOX TRENCHES) TO BE 100 FEET FROM WELL (UNLESS OTHERWISE SPECIFICALLY AUTHORIZED)

NOTE: IF DEEP TRENCH(ES) ARE USED CALL FOR INSPECTION BEFORE AND AFTER PLACING GRAVEL IN TRENCH(ES)

NOTE: NO DRY WELL SHALL EXCEED 15 FOOT IN DIAMETER NO ABSORPTION TRENCH TO EXCEED 100 FEET IN LENGTH

NOTE: ALL PIPE FROM HOUSE TO SEPTIC TANK MUST BE CAST IRON OR SCHEDULE 35/40 PVC OR ABS

PERMIT VOID AFTER TWO YEARS

NOTE: INSTALL STAND PIPE ON SEPTIC TANK AND DRY WELL STAND PIPES MUST BE 6 INCHES IN DIAMETER CAST IRON. CONCRETE OR TERRA COTTA OR PVA OR ABS ACCEPTED. IF TOP OF SEPTIC TANK IS DEEPER THAN 3 FEET. MANHOLE TO GRADE REQUIRED.

NOTE: DISTRIBUTION BOXES MUST HAVE BAFFLES


**\*INSTALLER IS RESPONSIBLE FOR OBTAINING FINAL APPROVAL ON THIS PERMIT**

**BLDG. PERMIT SIGNED**

**AND RETURNED**

Serial # BM101280 purpantank

A 44257

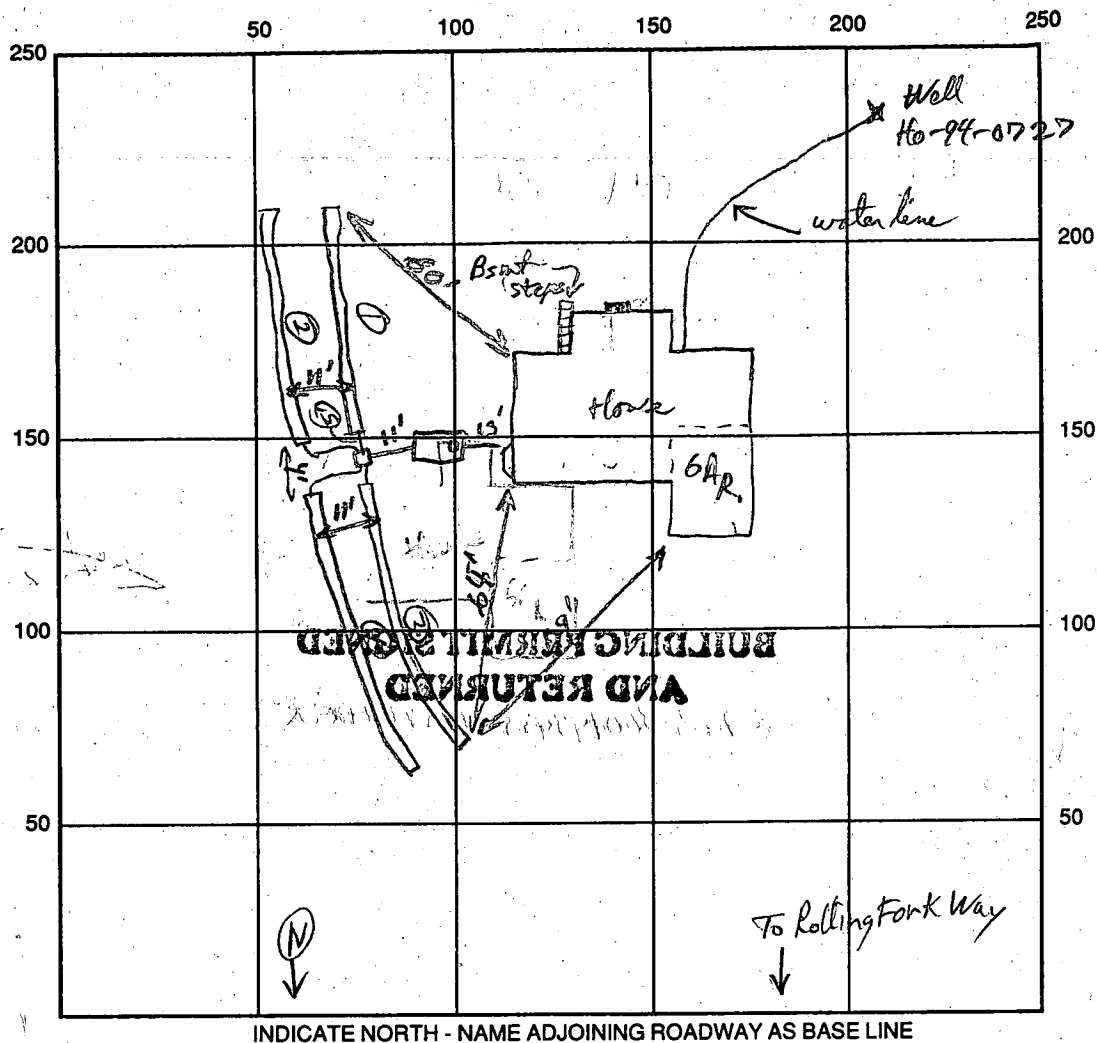

INDICATE NORTH - NAME ADJOINING ROADWAY AS BASE LINE

SEPTIC TANK LEVEL 1500 gal CLEANOUTS \_\_\_\_\_

DISTRIBUTION BOX LEVEL \_\_\_\_\_

DRAIN FIELD/TITLE DEPTH 4 FT. TRENCH WIDTH 3 FT. INLET DEPTH 2 FT.

EFFECTIVE GRAVEL DEPTH 2 FT. TOTAL LENGTH 1123/70/70/70 FT.

NUMBER OF TRENCHES 4 ~~ONE SIDEWALL~~ 840 SQ. FT.

DRYWALL INSIDE DIAMETER \_\_\_\_\_ FT. EFFECTIVE DEPTH BELOW INLET \_\_\_\_\_ FT.

ABSORBENT AREA \_\_\_\_\_ SQ. FT.

REMARKS: S.T. set and already covered; d.b. placed - Needs connecting pipe finished and callus. Trenches open R/P 7/3/96  
1st Open Trench OK to begin gravel filling R/P 7/8/96 rest of Trenches finished, OK to cover R/P 7/9/96

Needs House Connection

WPI - Filter chamber OK at 3 1/2 ft R/P 7/3/96 2" white PVC must use line & connect also.

DATE SYSTEM APPROVED \_\_\_\_\_ INSPECTOR \_\_\_\_\_

# APPLICATION

PERCOLATION TESTING

A 44257

P \_\_\_\_\_

HOWARD COUNTY HEALTH DEPARTMENT  
BUREAU OF ENVIRONMENTAL HEALTH  
P.O. BOX 476 ELLICOTT CITY, MARYLAND 21043  
TELEPHONE: 461-9933

DISTRICT 4th

DATE \_\_\_\_\_

TO: THE COUNTY HEALTH OFFICER  
ELLICOTT CITY, MARYLAND

I, HEREBY, APPLY FOR THE NECESSARY TEST IN ORDER TO CONSTRUCT (OR RECONSTRUCT) A SEWAGE DISPOSAL SYSTEM.

PROPERTY OWNER Pettit and Griffin, Inc. NV Homes

ADDRESS 18205-D Flower Hill Way 2200 Defense Hwy. Crofton, MD 21114 PHONE 301-975-1020  
Gaithersburg, Maryland 20879

PROSPECTIVE BUYER \_\_\_\_\_

ADDRESS \_\_\_\_\_ PHONE \_\_\_\_\_

PROPERTY LOCATION: Gwynndyl Oak Estates

SUBDIVISION McKendree Estates LOT NO. 26 27 28  
30 NEW 28  
9/17/93

ROAD AND DESCRIPTION McKendree Road and Route 97  
2864 Rolling Fork Way.

TAX MAP 14 PARCEL # 123

SIZE OF LOT 3 AC. + TYPE BLDG. Single Family - 4 BRMS  
(SINGLE FAMILY DWELLING OR COMMERCIAL)

BLDG. PERMIT SIGNED  
AND RETURNED 4-24-96  
Serial # 64350

THE SYSTEM INSTALLED UNDER THIS APPLICATION IS ACCEPTABLE ONLY UNTIL PUBLIC FACILITIES BECOME AVAILABLE. I FULLY UNDERSTAND THE  
FEE CONNECTED WITH THE FILING OF THIS PERC TEST APPLICATION IS NON-REFUNDABLE UNDER ANY CIRCUMSTANCES. I ALSO AGREE TO COMPLY  
WITH ALL M.O.S.H.A. REQUIREMENTS IN TESTING THIS LOT. \_\_\_\_\_

(SIGNATURE OF APPLICANT)

APPROVED BY \_\_\_\_\_ FOR \_\_\_\_\_ DATE \_\_\_\_\_

REJECTED BY \_\_\_\_\_ FOR \_\_\_\_\_ DATE \_\_\_\_\_

HOLD PENDING FURTHER TESTS \_\_\_\_\_ DATE \_\_\_\_\_

REASONS FOR REJECTION OR HOLDING \_\_\_\_\_

HD-216


## THIS IS NOT A PERMIT

wt 30  
A 44257

ONLINE  
①  
SOIL PROFILE

CLAY  
BROWN  
SAND  
SILT  
LOAM

AV  
TIME  
9 MIN  
MAX  
DEPTH  
4 FT  
TRENCH  
BETWEEN  
⑤ ⑥

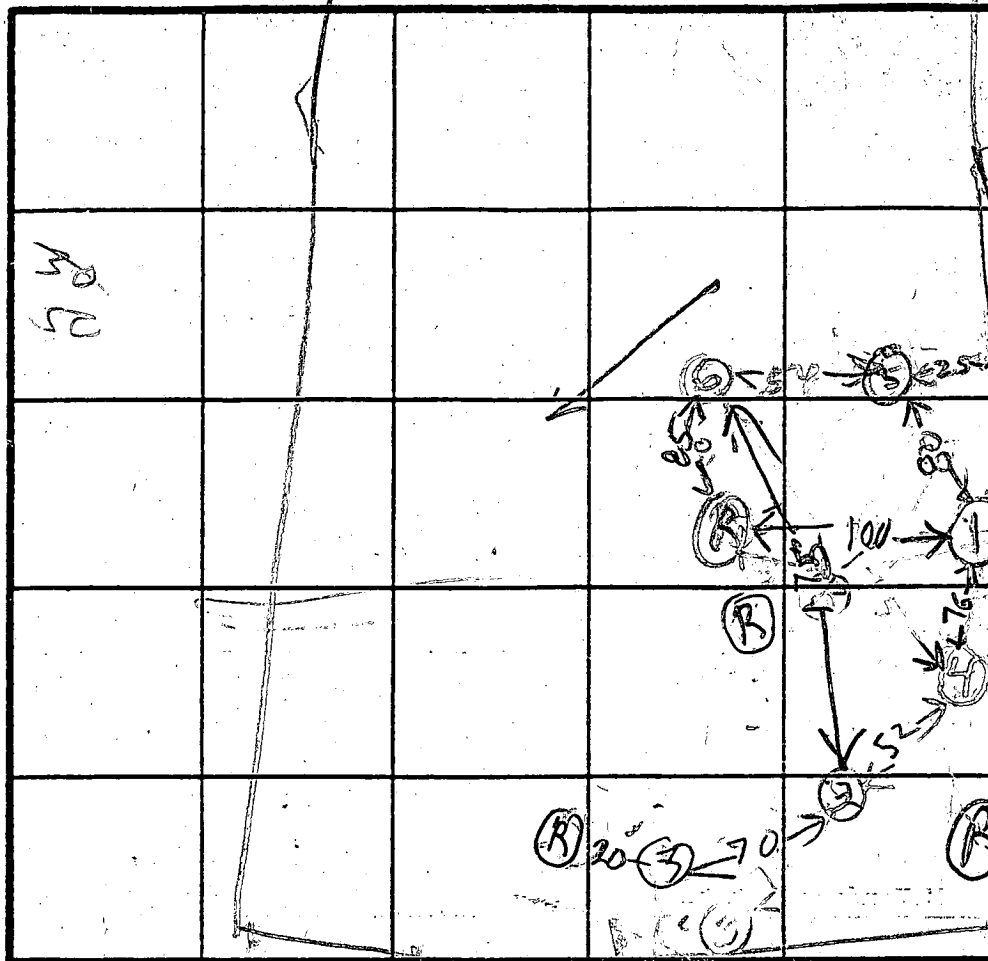

ON LINE  
HOLE

ROCK  
HOLE

INDICATE NORTH - NAME ADJOINING ROADWAY AS BASE LINE.

②  
CLAY  
BROWN  
SAND  
LOAM

③  
CLAY  
HARD  
GRAY  
BROWN  
SAND  
LOAM  
ROCK

④  
CLAY  
RED  
BROWN  
SAND  
LOAM

| DATE    | TEST NO. | DEPTH | PRE-WET    |      | TEST - 1" DROP |      | TIME |
|---------|----------|-------|------------|------|----------------|------|------|
|         |          |       | START      | STOP | START          | STOP |      |
| 6/21/89 | 1 S      | 5     | 1039       | 1048 | 1048           | 1058 | 10   |
|         | 1 D      | 5     | 1039       | 1048 | 1048           | 1058 | 10   |
|         | 1 V      | 11    | OIC        |      |                |      |      |
|         | 2 S      | 4.5   | 1034       | 1140 | 1140           | 1150 | 10   |
|         | 2 V      | 11    | OIC        |      |                |      |      |
|         | 3 S      | 3.5   | 1139       | 1144 | 1144           | 1048 | 4    |
|         | 3 V      | 11.5  | OIC        |      |                |      |      |
|         | 4 V      | 12    | OIC        |      |                |      |      |
|         | 5 S      | 4.5   | 1217       | 1230 | 1230           | 1241 | 11   |
|         | 5 V      | 10.5  | 9          |      |                |      |      |
|         | 6 V      | 10.5  | OIC        |      |                |      |      |
|         | R        |       | ROCK HOLES |      |                |      |      |
|         |          |       |            |      |                |      |      |
|         |          |       |            |      |                |      |      |
|         |          |       |            |      |                |      |      |

ONLINE  
HOLE

⑤  
CLAY  
RED  
BROWN  
SAND  
LOAM

⑥  
CLAY  
RED  
BROWN  
SAND  
LOAM

REMARKS ② ROCK HOLES 4 ROCK HOLES 6 GOOD HOLE

TYPE OF SOIL

TESTED BY R. HODGES

ALSO PRESENT KETERM

10.5 ROCKS

C16917

SEQUENCE NO.  
(DENV USE ONLY)

STATE OF MARYLAND  
WELL COMPLETION REPORT  
FILL IN THIS FORM COMPLETELY  
PLEASE PRINT OR TYPE

THIS REPORT MUST BE SUBMITTED WITHIN  
45 DAYS AFTER WELL IS COMPLETED.

COUNTY  
NUMBERA 44257

ST/CO USE ONLY  
DATE Received

DATE WELL COMPLETED

Depth of Well

PERMIT NO.  
FROM "PERMIT TO DRILL WELL"

8131520

041196

2250026  
(TO NEAREST FOOT)

28293031323334353637  
H0-94-0727

OWNERPettit & Griffin Inc.

STREET OR RFD10215 D Miller Hill Wayfirst nameTOWNGaithersburg20879

SUBDIVISIONGardvil Oak EstatesSECTIONLOT27

| WELL LOG                                                                                    |                 |                        |
|---------------------------------------------------------------------------------------------|-----------------|------------------------|
| Not required for driven wells                                                               |                 |                        |
| STATE THE KIND OF FORMATIONS PENETRATED, THEIR COLOR, DEPTH, THICKNESS AND IF WATER BEARING |                 |                        |
| DESCRIPTION (Use additional sheets if needed)                                               | FEET<br>FROM TO | Check if water bearing |
| dirt                                                                                        | 0 9             |                        |
| hard light gray rock                                                                        | 9 15            |                        |
| red hard brown rock                                                                         | 15 17           |                        |
| hard light gray rock                                                                        | 17 33           |                        |
| red hard gray rock                                                                          | 33 38           | X                      |
| hard light gray rock                                                                        | 38 44           |                        |
| red hard brown rock                                                                         | 44 46           | X                      |
| hard gray rock                                                                              | 46 62           |                        |
| hard green rock                                                                             | 62 88           |                        |
| hard gray rock                                                                              | 88 149          |                        |
| red hard gray rock                                                                          | 149 165         |                        |
| hard gray rock                                                                              | 165 249         |                        |
| red hard gray rock                                                                          | 249 261         |                        |
| hard gray rock                                                                              | 261 314         |                        |
| red hard gray rock                                                                          | 314 381         |                        |
| hard gray rock                                                                              | 381 465         | X                      |
| red hard gray rock                                                                          | 465 486         |                        |
| hard green rock                                                                             | 486 500         |                        |

GROUTING RECORD

WELL HAS BEEN GROUTED  
(Circle Appropriate Box)

TYPE OF GROUTING MATERIAL

CEMENTCMBENTONITE CLAYBC

NO. OF BAGS6NO. OF POUNDS600

GALLONS OF WATER25

DEPTH OF GROUT SEAL (to nearest foot)

from0ft. to20ft.

48TOP5254BOTTOM58  
(enter 0 if from surface)

CASING RECORD

casing types insert appropriate code below

STEELCONCRETE  
PLASTICOTHER

MAIN CASING TYPE

Nominal diameter top (main) casing (nearest inch)

Total depth of main casing (nearest foot)

PL521606163646670

OTHER CASING (if used)

diameter inch

depth (feet) from to

EACH CASING

SCREEN RECORD

screen type or open hole

insert appropriate code below

STEELBRASSBRONZEOPEN HOLE  
PLASTICOTHER

DEPTH (nearest ft.)

123456789101112131415161718192021222324252627282930313233343536373839404142434445464748495051

1H020500

CIRCLE APPROPRIATE LETTER

A A WELL WAS ABANDONED AND SEALED WHEN THIS WELL WAS COMPLETED

E ELECTRIC LOG OBTAINED

P TEST WELL CONVERTED TO PRODUCTION WELL

I HEREBY CERTIFY THAT THIS WELL HAS BEEN CONSTRUCTED IN ACCORDANCE WITH COMAR 26.04.04 "WELL CONSTRUCTION" AND IN CONFORMANCE WITH ALL CONDITIONS STATED IN THE ABOVE CAPTIONED PERMIT, AND THAT THE INFORMATION PRESENTED HEREIN IS ACCURATE AND COMPLETE TO THE BEST OF MY KNOWLEDGE.

DRILLERS IDENT. NO. 304

DRILLERS SIGNATURE

SITE SUPERVISOR (sign. of driller or journeyman responsible for sitework if different from permittee)

SLOT SIZE 123

DIAMETER OF SCREEN (NEAREST INCH)

from to

GRAVEL PACK

IF WELL DRILLED WAS FLOWING WELL INSERT F IN BOX 68

OEP USE ONLY (NOT TO BE FILLED IN BY DRILLER)

T (E.R.O.S.)

W Q

TELESCOPE CASING

LOG INDICATOR

OTHER DATA

PUMPING TEST

HOURS PUMPED (nearest hour)

PUMPING RATE (gal. per min. to nearest gal.)

METHOD USED TO MEASURE PUMPING RATE

WATER LEVEL (distance from land surface)

BEFORE PUMPING

WHEN PUMPING

TYPE OF PUMP USED (for test)

A airP pistonT turbine

C centrifugalR rotaryO other (describe below)

J jetS submersible

PUMP INSTALLED

DRILLER WILL INSTALL PUMP YES NO

IF DRILLER INSTALLS PUMP, THIS SECTION MUST BE COMPLETED FOR ALL WELLS EXCEPT HOME USE

TYPE OF PUMP INSTALLED PLACE (A,C,J,P,R,S,T,O) IN BOX - SEE ABOVE:

CAPACITY: GALLONS PER MINUTE (to nearest gallon)

PUMP HORSE POWER

PUMP COLUMN LENGTH (nearest ft.)

CASING HEIGHT (circle appropriate box and enter casing height)

above

below


LAND SURFACE (nearest foot)


LOCATION OF WELL ON LOT

SHOW PERMANENT STRUCTURE SUCH AS BUILDING, SEPTIC TANKS, AND/OR LANDMARKS AND INDICATE NOT LESS THAN TWO DISTANCES (MEASUREMENTS TO WELL)

Drilled on

Approved stake

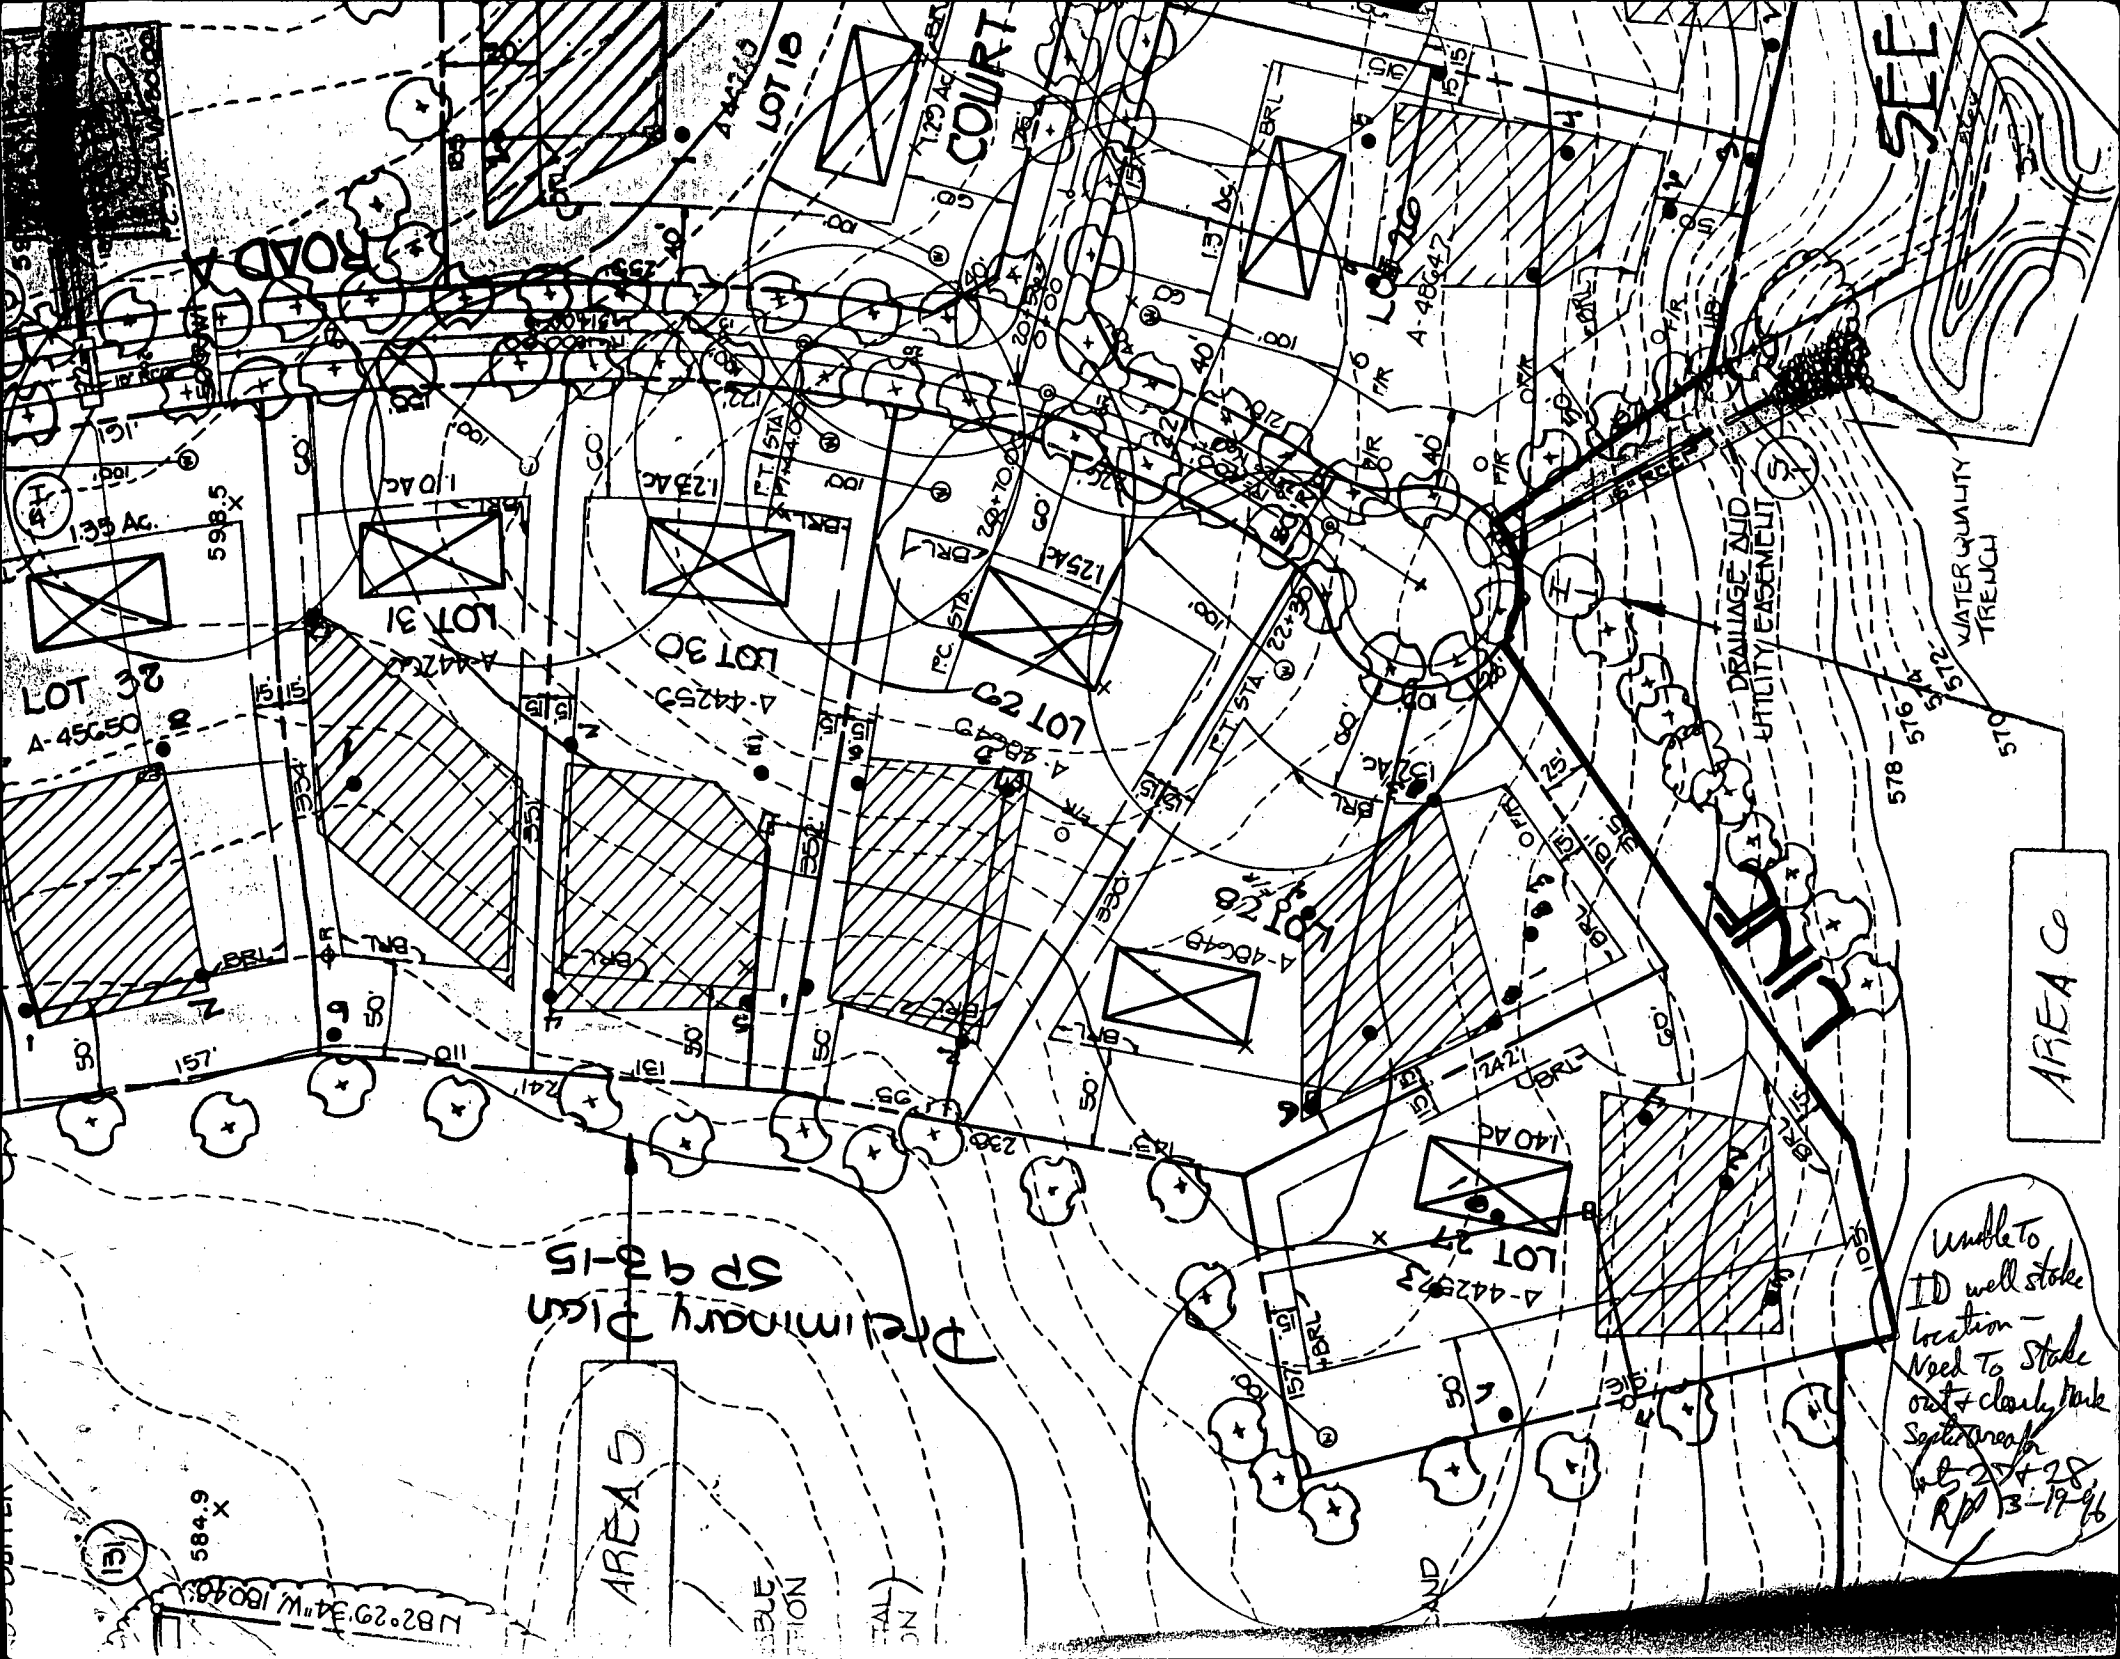

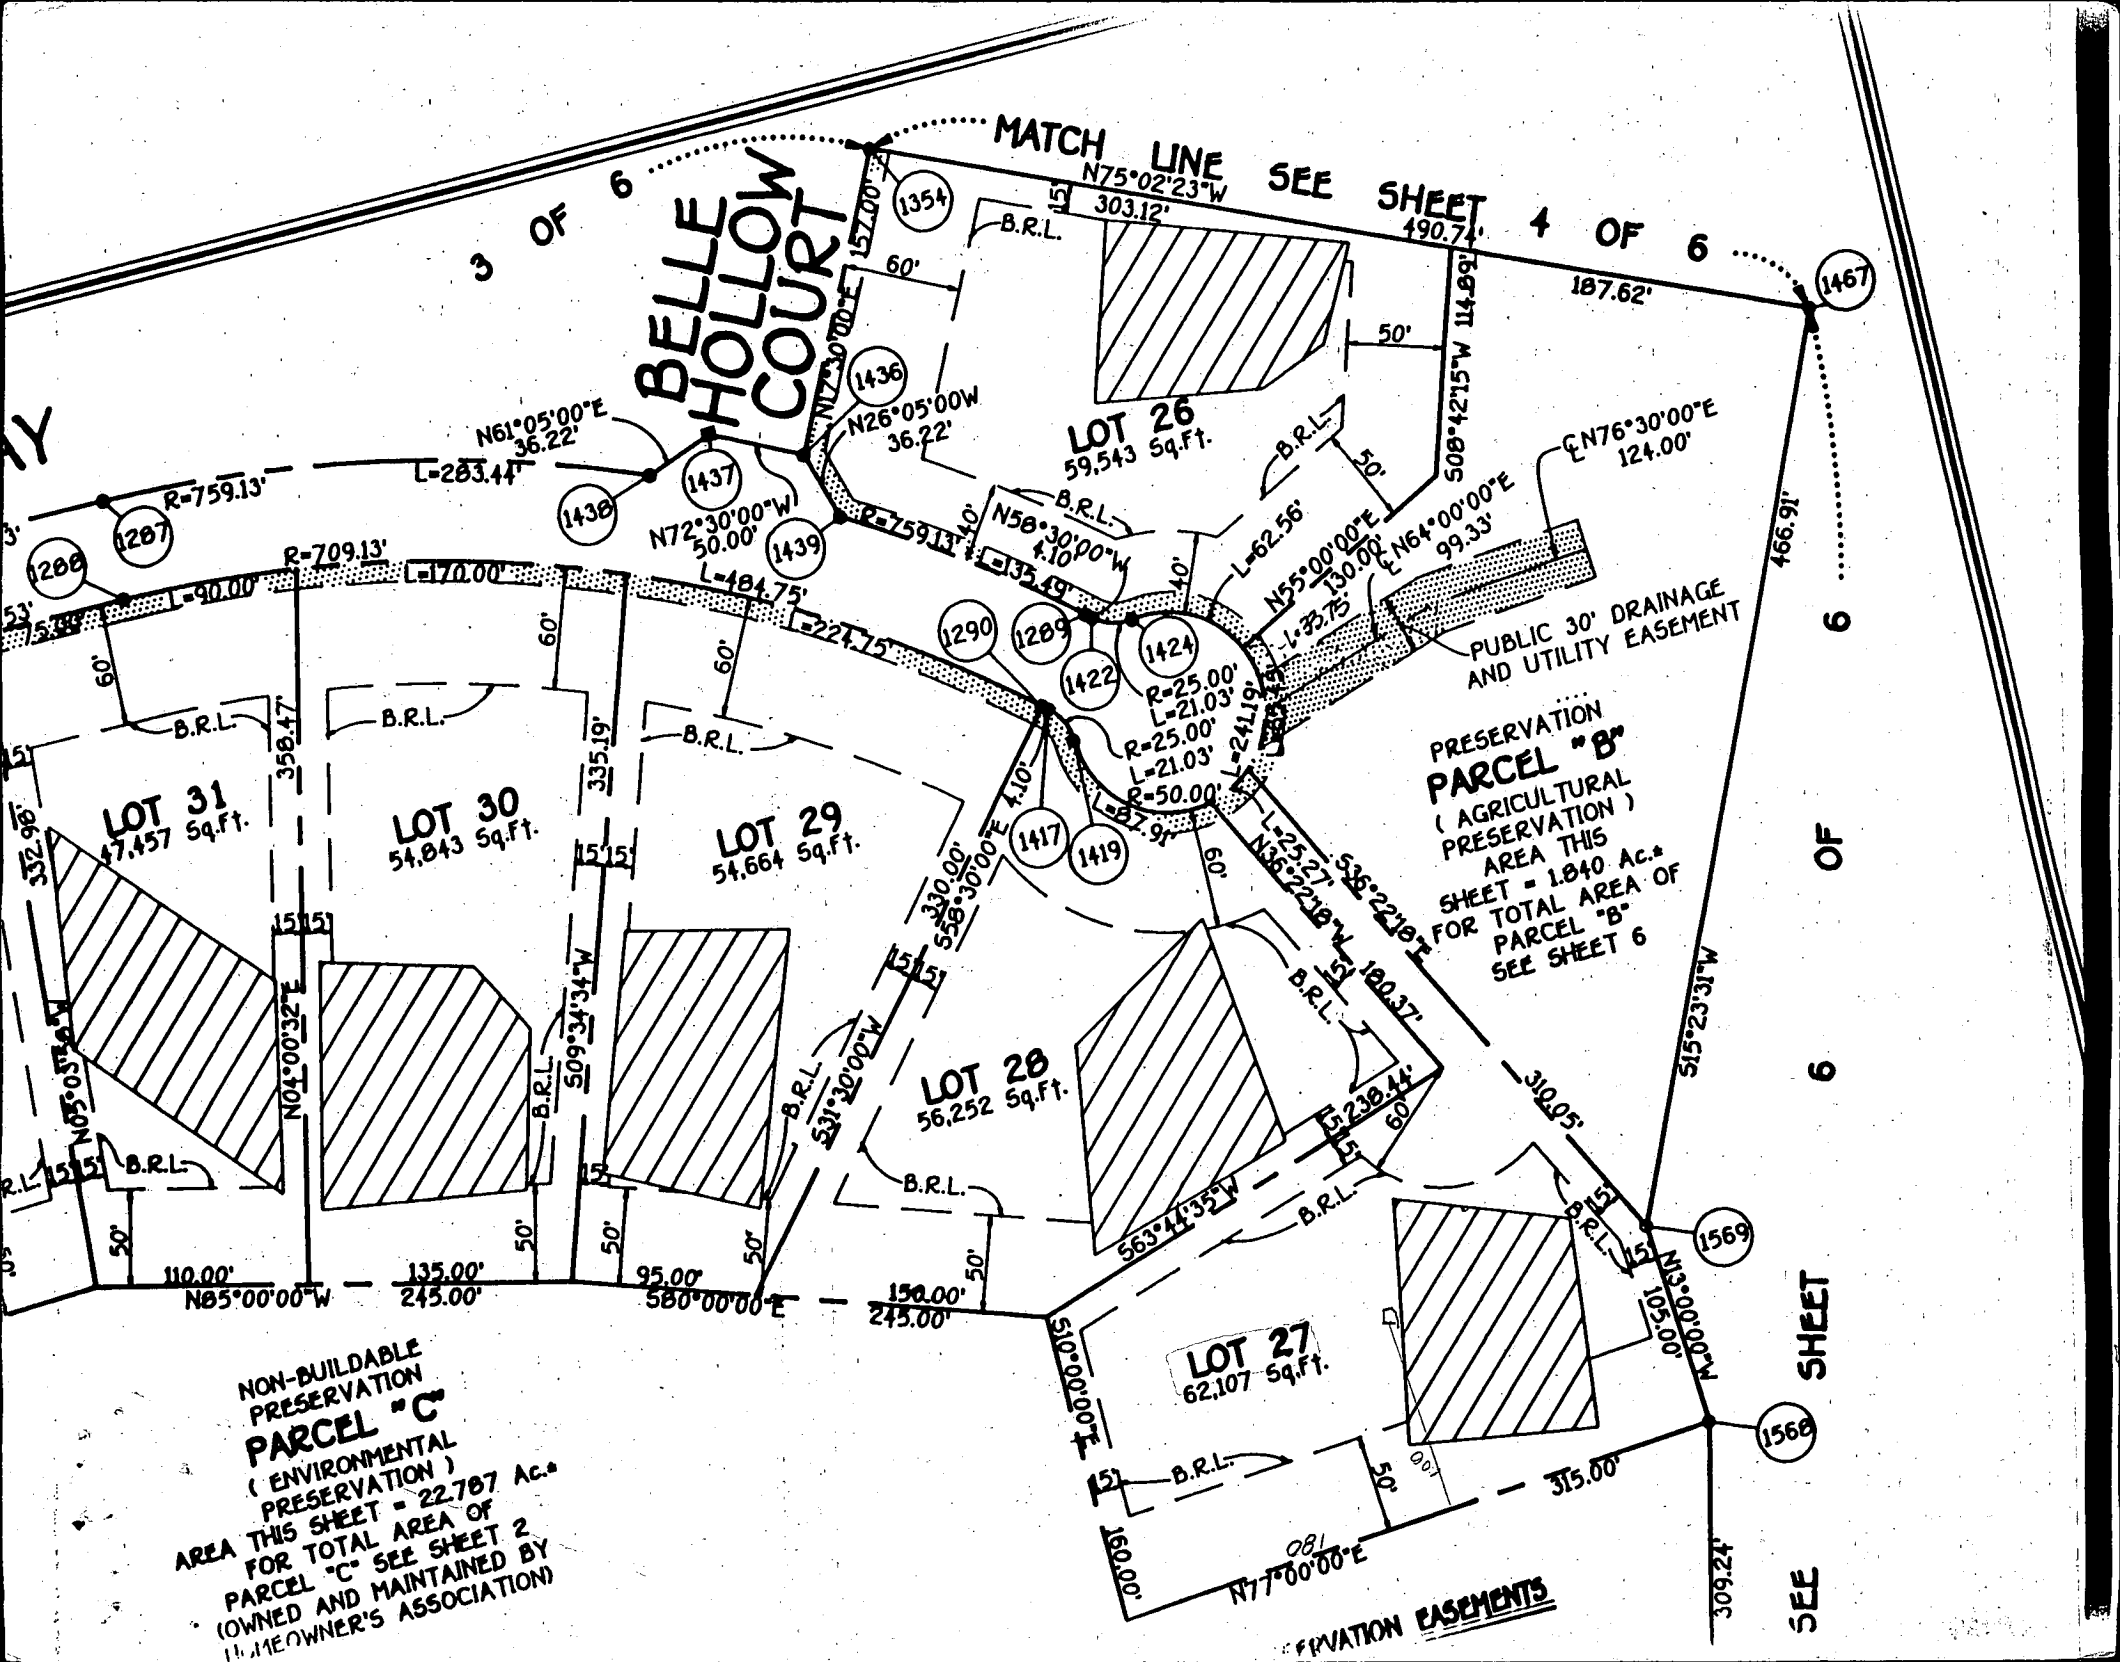

3 OF 6  
MATCH LINE SEE SHEET 4 OF 6  
N75°02'23"W 303.12'  
B.R.L.  
N72°30'00"W 50.00'  
N26°05'00"W 36.22'  
N61°05'00"E 36.22'  
L=283.44'  
R=759.13'  
L=90.00'  
L=170.00'  
N72°30'00"W 50.00'  
L=484.75'  
N58°30'00"W 410.00'  
L=335.49'  
N55°00'00"E 130.00'  
L=99.33'  
N64°00'00"E 99.33'  
N76°30'00"E 124.00'  
S08°42'15"W 114.89'  
187.62'  
1467

LOT 26  
59,543 Sq.Ft.

PUBLIC 30' DRAINAGE  
AND UTILITY EASEMENT

PRESERVATION  
PARCEL "B"  
( AGRICULTURAL  
PRESERVATION )  
AREA THIS  
SHEET = 1.840 Ac.  
FOR TOTAL AREA OF  
PARCEL "B" SEE SHEET 6

LOT 31  
47,457 Sq.Ft.

LOT 30  
54,843 Sq.Ft.

LOT 29  
54,664 Sq.Ft.

LOT 28  
56,252 Sq.Ft.

LOT 27  
62,107 Sq.Ft.

NON-BUILDABLE  
PRESERVATION  
PARCEL "C"  
( ENVIRONMENTAL  
PRESERVATION )  
AREA THIS SHEET = 22.787 Ac.  
FOR TOTAL AREA OF  
PARCEL "C" SEE SHEET 2  
( OWNED AND MAINTAINED BY  
HOMEOWNER'S ASSOCIATION )

RESERVATION EASEMENTS

6 OF 6  
SEE SHEET

REVISED  
4/12/96

LOT 27  
GWYNDYL OAK ESTATES  
4th ELEC. DIST. HOWARD CO., MD  
Revised April 11, 1996 1"=50'

## SEPTIC SYSTEM DATA:


BASEMENT FLOOR AREA = 593.4'  
INV. OUT OF HOUSE = 596.55' HUNG SEWER  
INV. IN AT SEPTIC TANK = 596.25'  
INV. OUT AT SEPTIC TANK = 596.00'  
EX. ELEV. AT SEPTIC TANK = 596.5'±  
PROP. ELEV. AT SEPTIC TANK = 598.3'  
INV. IN AT DIST. BOX = 592.0'  
EX. ELEV. AT DIST. BOX = 594.0'±

## Notes:

1. Lot shown contains 62,107 s.f. of land and recorded at plat # 11552 among the Land Records of Howard County, Maryland.
2. Prepared by Gutschick, Little and Weber, P.A.
3. Grading around house may vary due to field conditions.
4. No construction stockpiling refuse or excess material shall be buried in septic easement.
5. Wells shown per SP-93-15.
6. Install sediment controls as required by Site Inspector. See Sediment Control Plan # GP-95-26.
7. Disturbed area shown is 23,909 s.f.
8. Pile excavated material on high side of trench when installing septic field prior to disposal of excess material.
9. Length of trench for septic system to be determined and specified by Howard County Department of Health.

7/26/96  
Proposed propane  
tank location will  
have no impact  
to existing well or  
septic. OK to  
proceed.

ALW

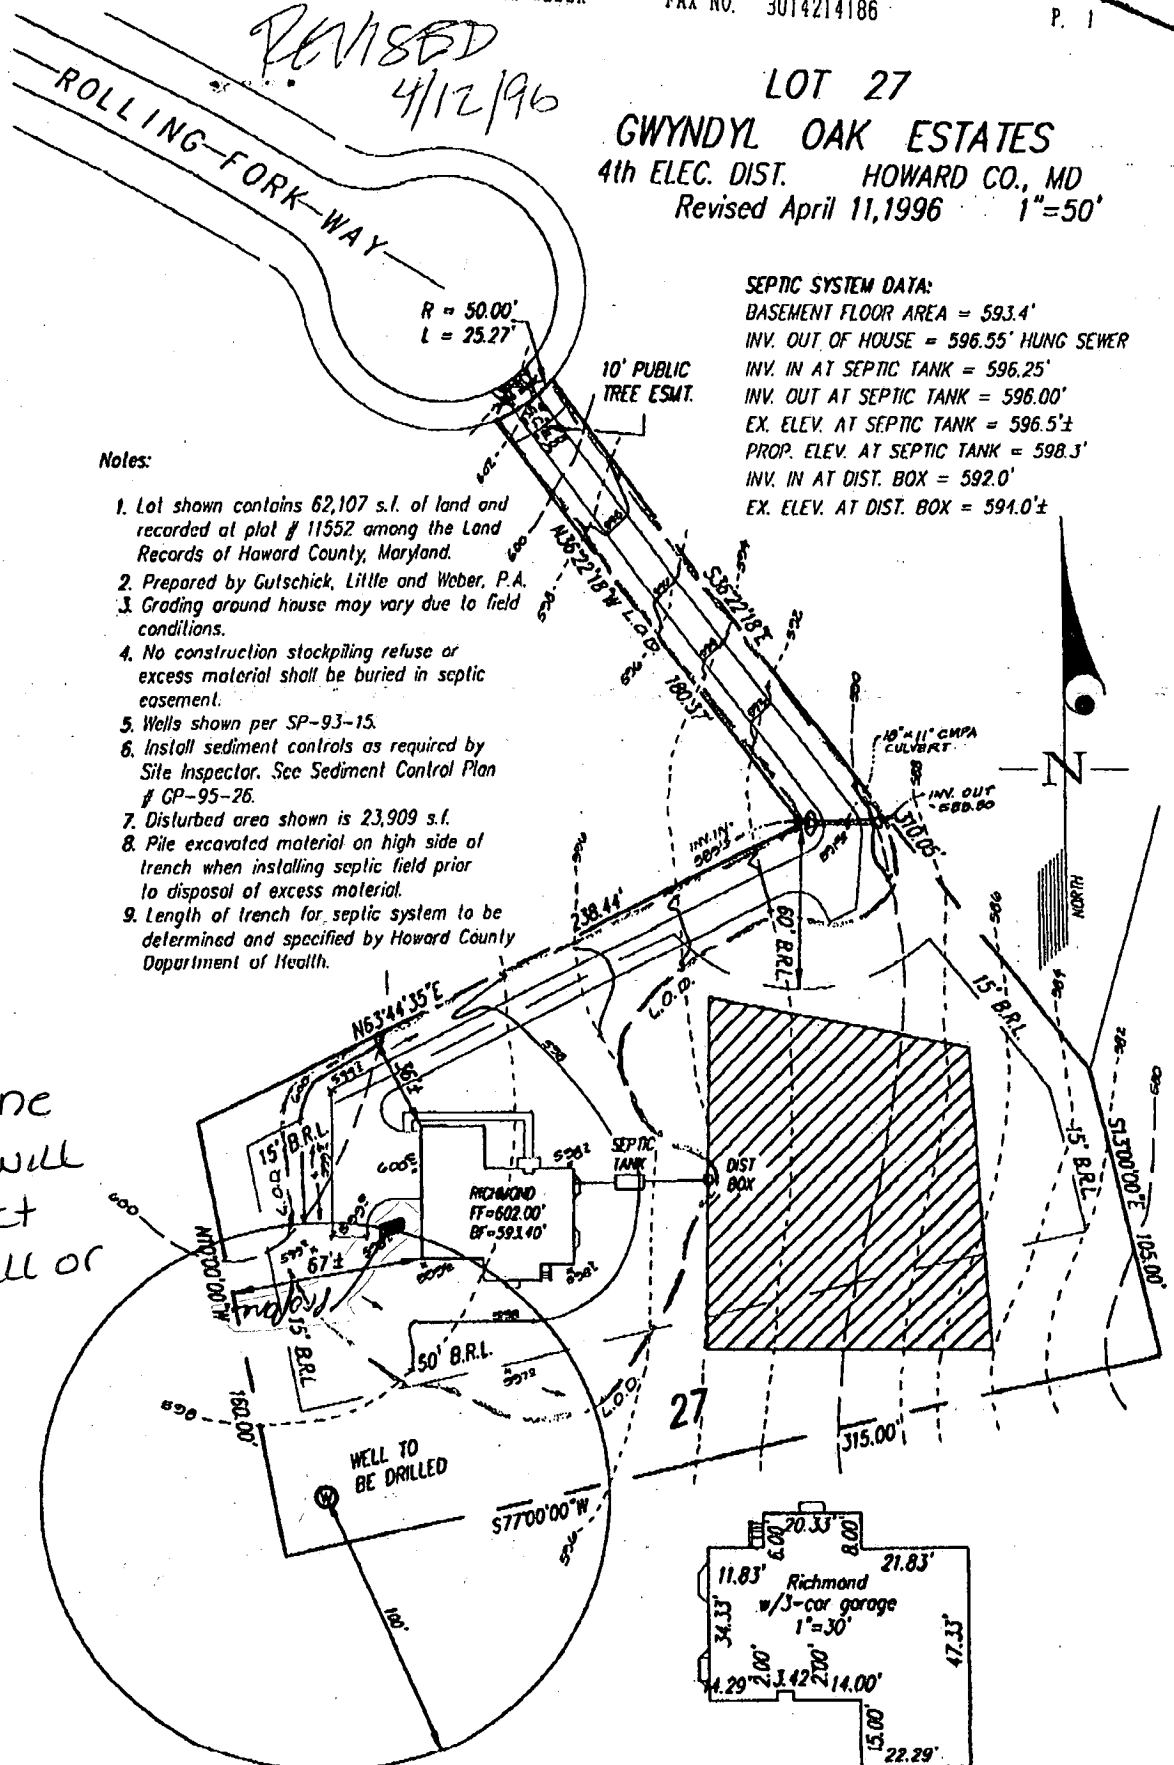




**LOT 27**  
**GWYNDYL OAK ESTATES**  
 4th ELEC. DIST. HOWARD CO., MD  
 Revised April 11, 1996 1"=50'

**SEPTIC SYSTEM DATA:**

BASEMENT FLOOR AREA = 593.4'  
 INV. OUT OF HOUSE = 596.55' HUNG SEWER  
 INV. IN AT SEPTIC TANK = 596.25'  
 INV. OUT AT SEPTIC TANK = 596.00'  
 EX. ELEV. AT SEPTIC TANK = 596.5'±  
 PROP. ELEV. AT SEPTIC TANK = 598.3'  
 INV. IN AT DIST. BOX = 592.0'  
 EX. ELEV. AT DIST. BOX = 594.0'±

**Notes:**


1. Lot shown contains 62,107 s.f. of land and recorded at plot # 11552 among the Land Records of Howard County, Maryland.
2. Prepared by Gutschick, Little and Weber, P.A.
3. Grading around house may vary due to field conditions.
4. No construction stockpiling refuse or excess material shall be buried in septic easement.
5. Wells shown per SP-93-15.
6. Install sediment controls as required by Site Inspector. See Sediment Control Plan # GP-95-26.
7. Disturbed area shown is 23,909 s.f.
8. Pile excavated material on high side of trench when installing septic field prior to disposal of excess material.
9. Length of trench for septic system to be determined and specified by Howard County Department of Health.

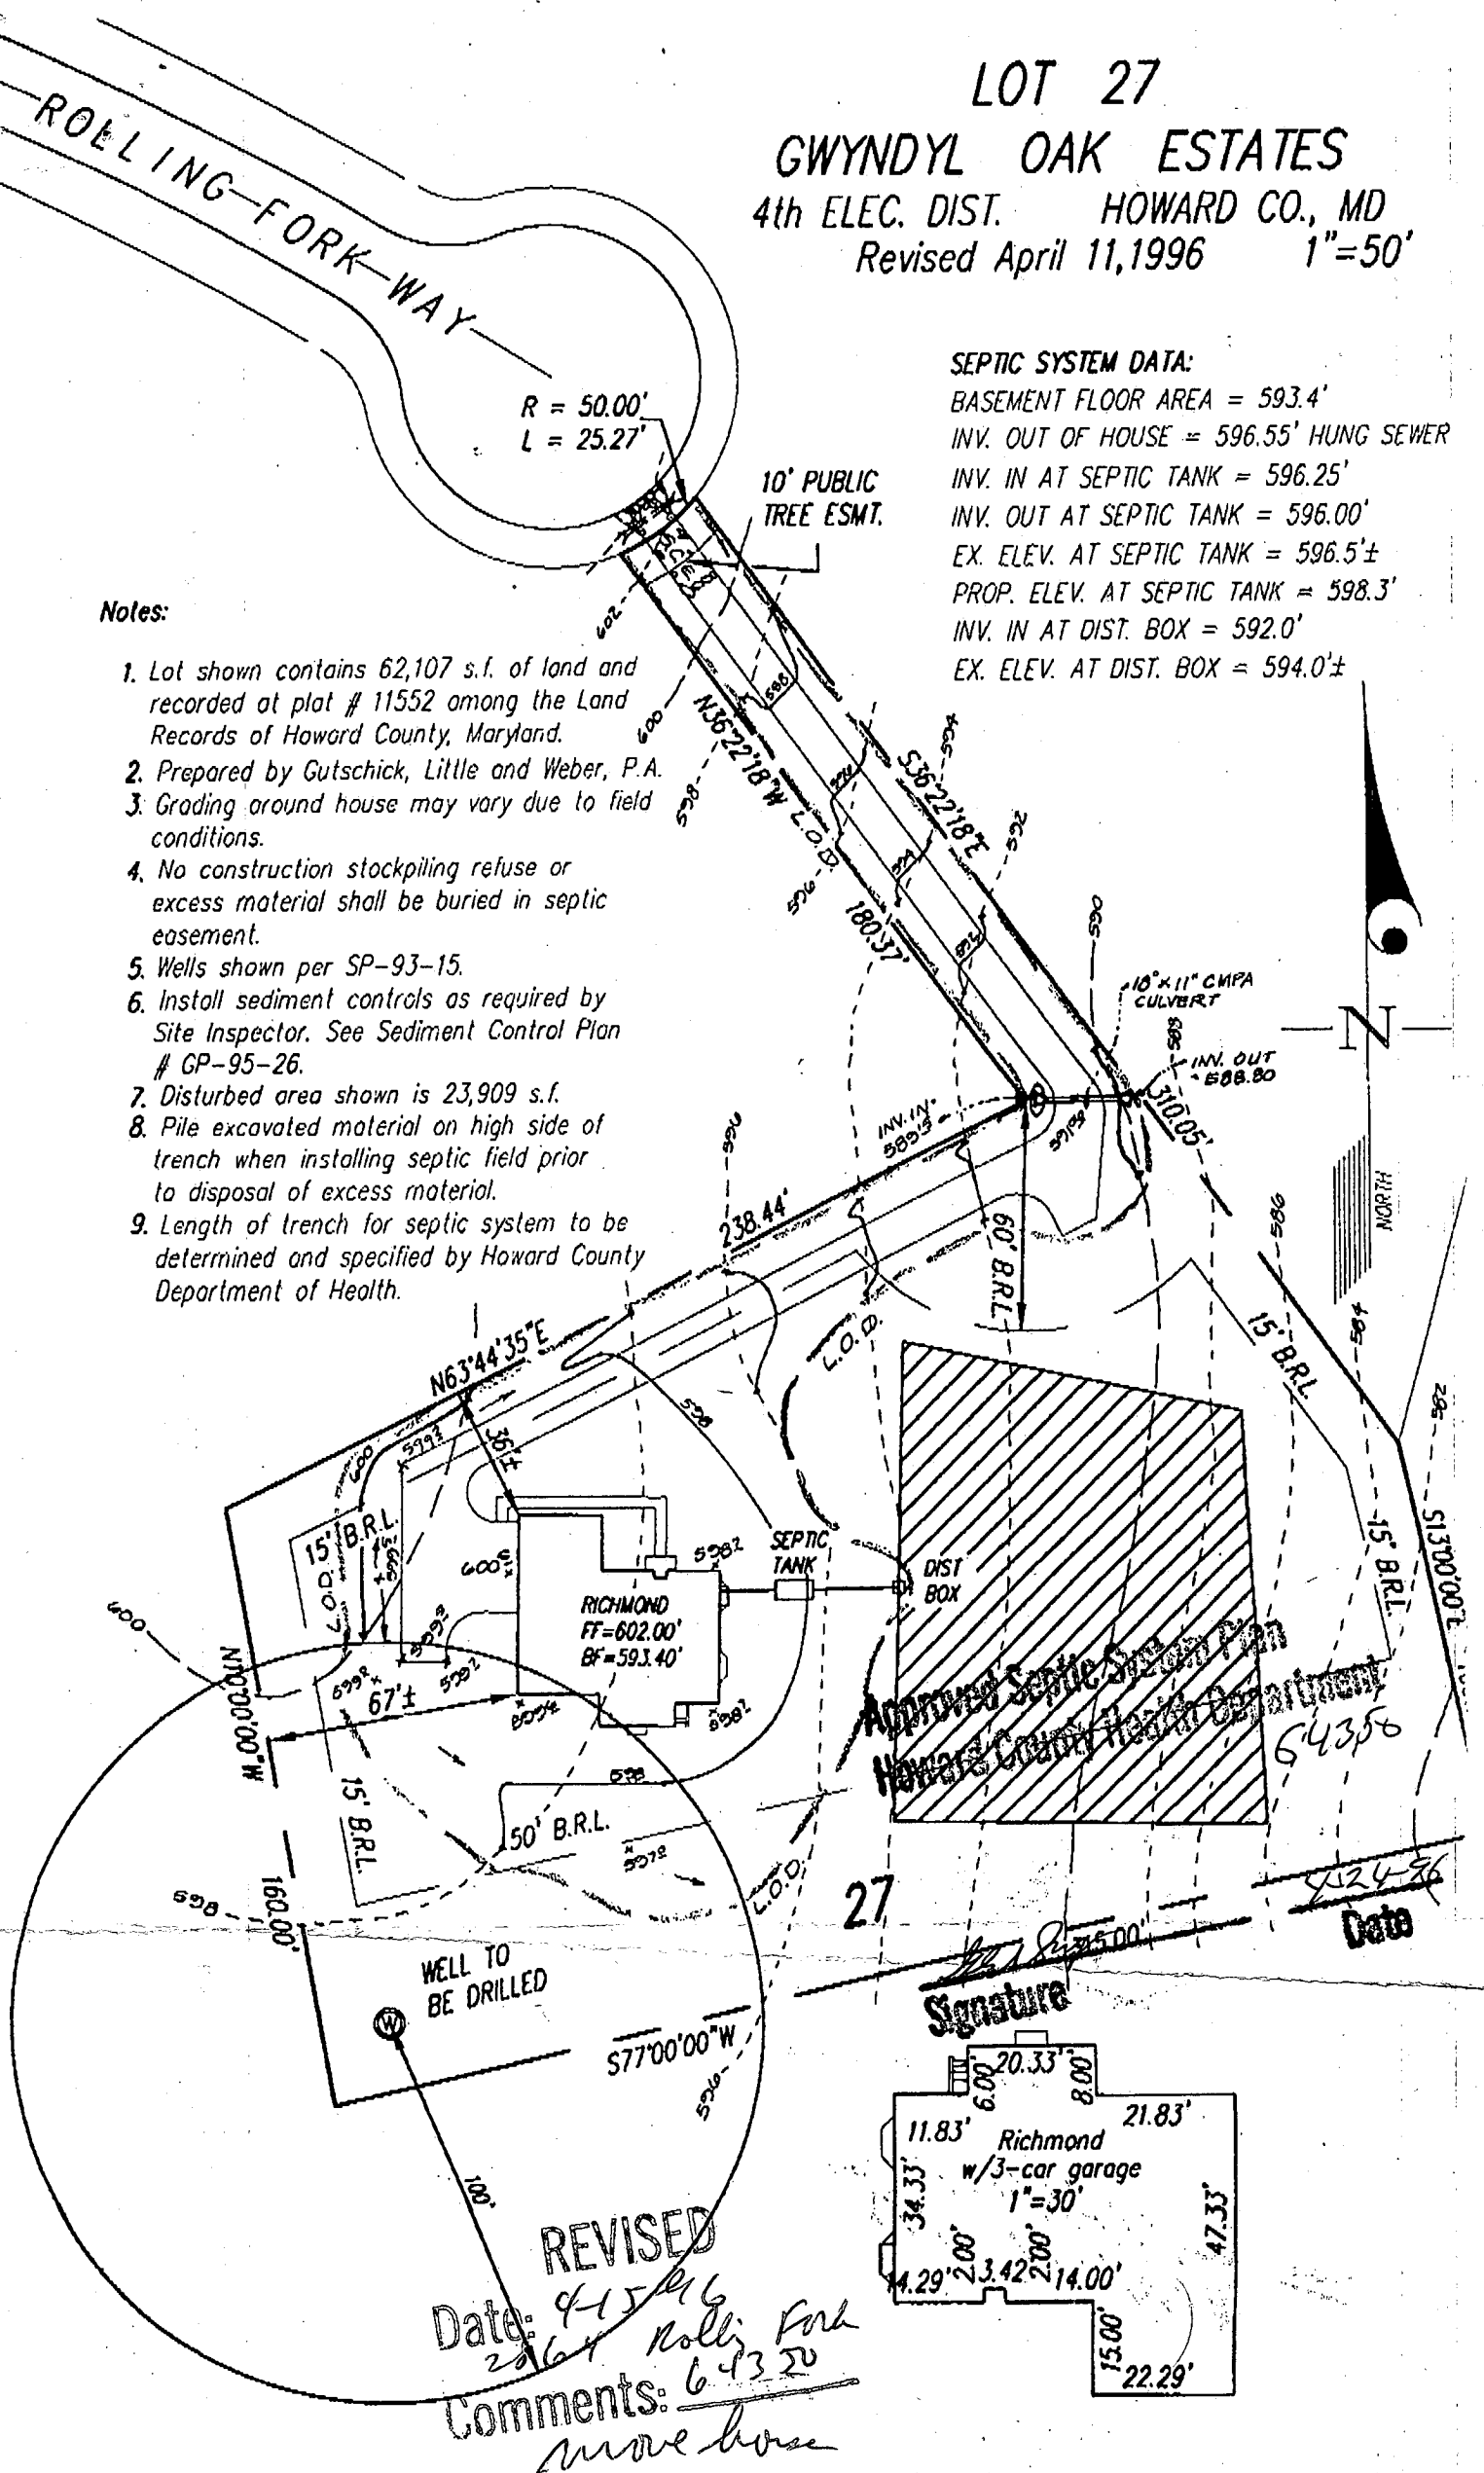

Notes:

1. Lot shown contains 62,107 s.f. of land and recorded at plat # 11552 among the Land Records of Howard County, Maryland.
2. Prepared by Cutschick, Little and Weber, P.A.
3. Grading around house may vary due to field conditions.
4. No construction stockpiling refuse or excess material shall be buried in septic easement
5. Wells shown per SP-93-15.
6. Install sediment controls as required by Site Inspector See Sediment Control Plan # CI-95 26.
7. Disturbed area shown is 23,909 s.f.
8. Pile excavated material on high side of trench when installing septic field prior to disposal of excess material.
9. Length of trench for septic system to be determined and specified by Howard County Department of Health.

EX. ELEV. AT DIST. BOX = 594.01

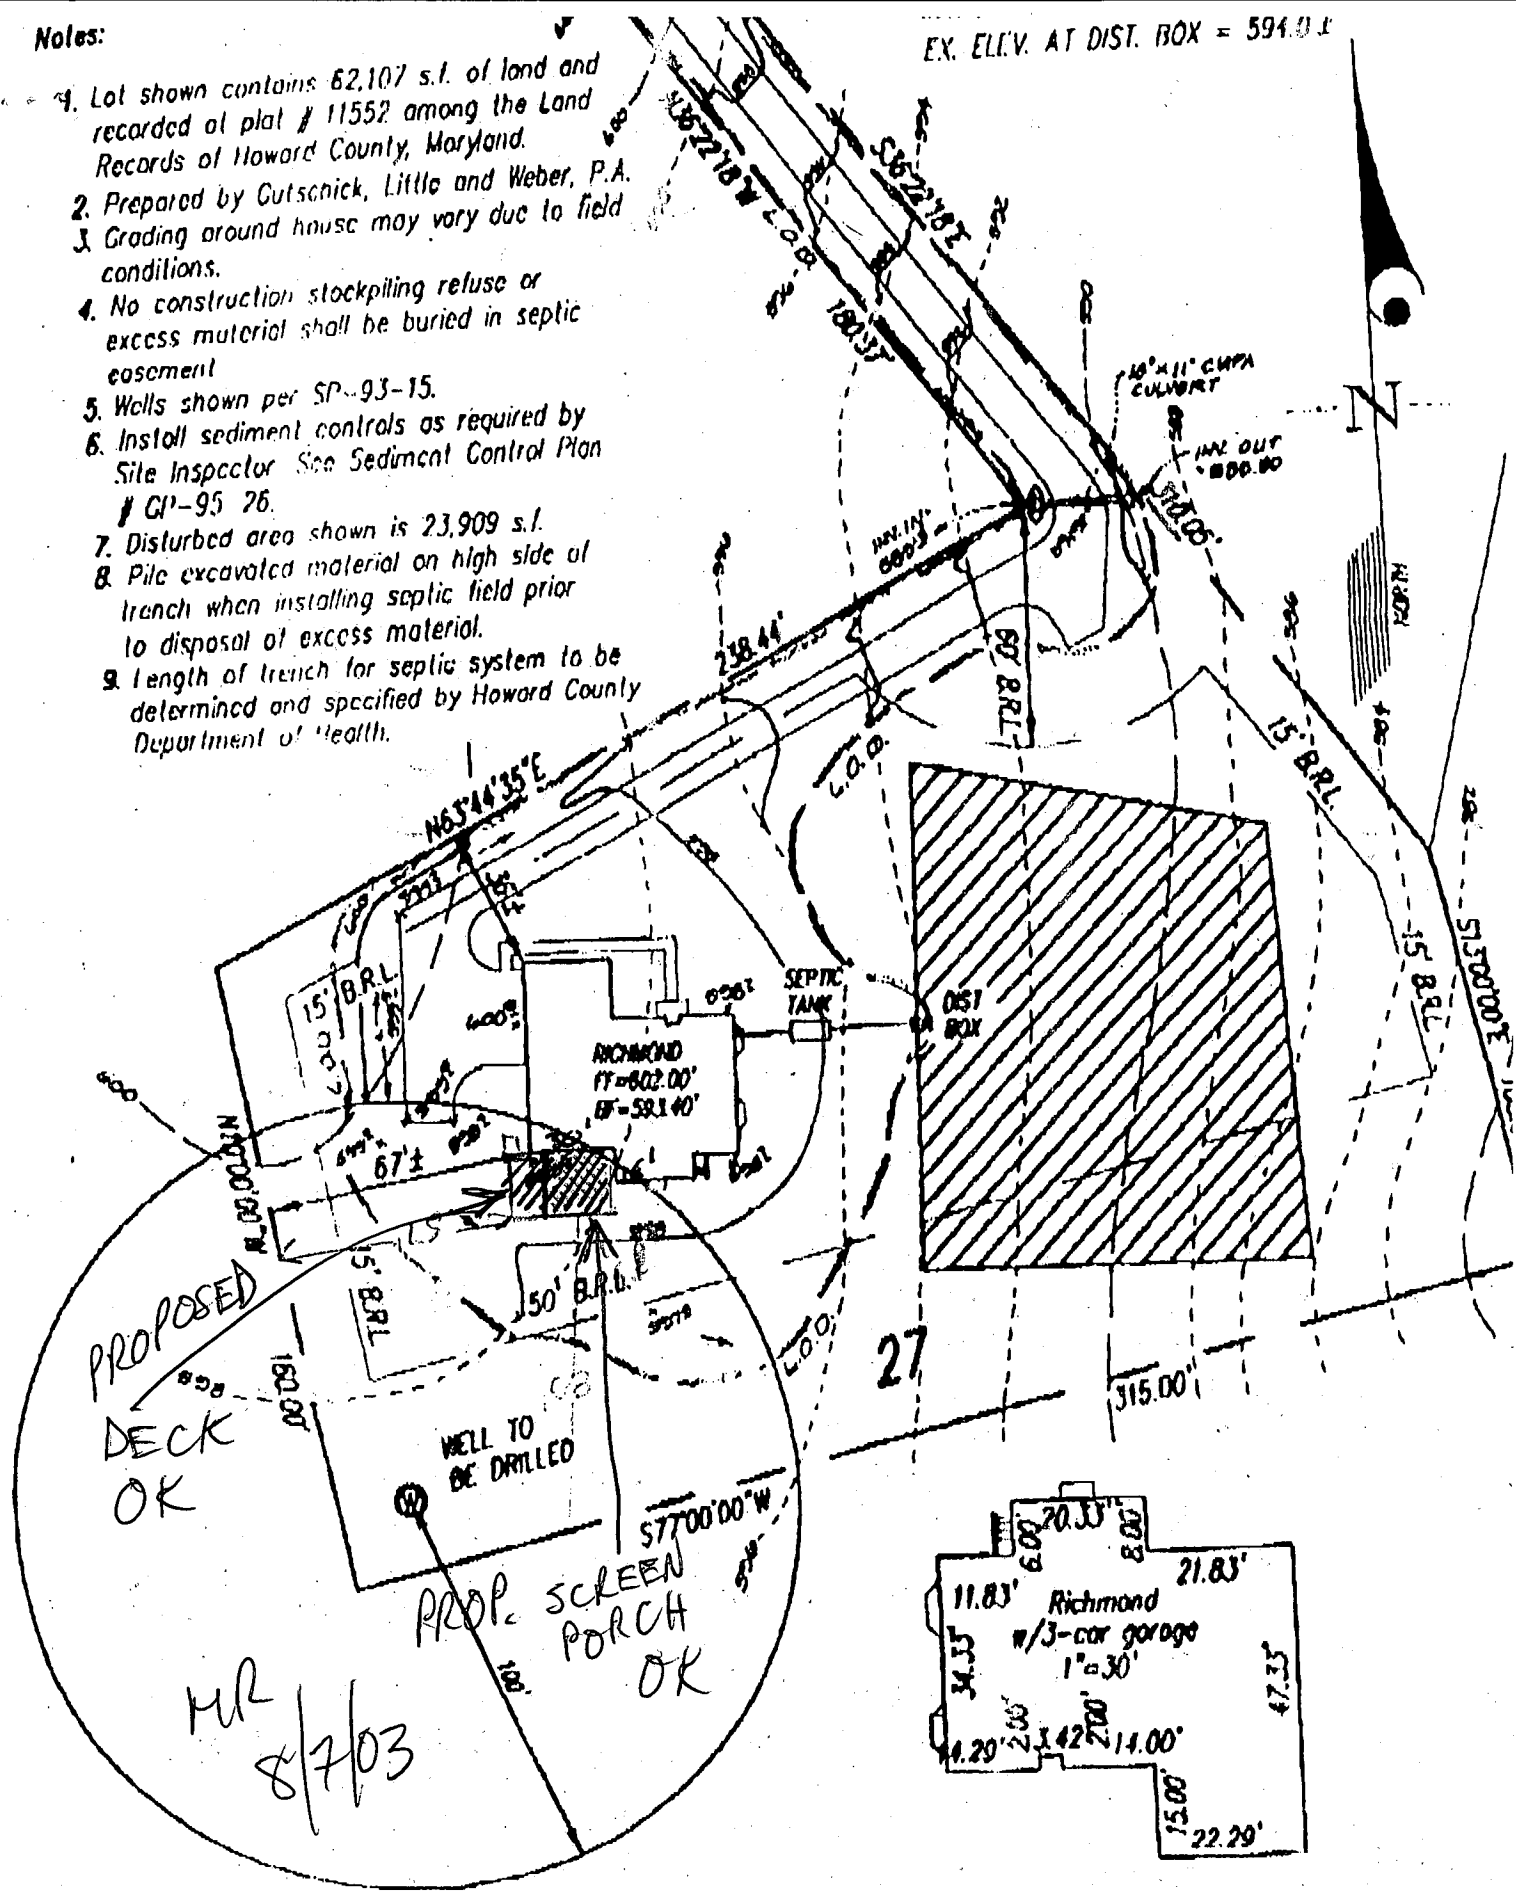

HOWARD COUNTY  
PERMIT APPLICATION

PERMIT NUMBER

1300143485

Building Address 2864 Rolling Forkway  
Glenwood, MD 21738

Suite/Apt. #: \_\_\_\_\_ SDP/WP/Petition #: \_\_\_\_\_

Census Tract 6C4002 Subdivision Gwynneth Park

Section \_\_\_\_\_ Area \_\_\_\_\_ Lot 27

Tax Map 14 Parcel 123 Grid 11

Zoning RC Map Coordinates 9E3 Lot size \_\_\_\_\_

Property Owner's Name John & Frances Delker

Address 2864 Rolling Forkway

City Glenwood State MD Zip Code 21738

Home Phone 410-442-343 Work Phone 201-633-428

Applicant's Name & Mailing Address, (if other than stated hereon): \_\_\_\_\_

Phone \_\_\_\_\_ Fax \_\_\_\_\_

Existing Use Residential

Proposed Use Residential Single Family with Deck

Estimated Construction Cost \$ 20,000

Description of Work 18x16 Screen porch  
16x12 Deck attached to back  
of house 4 steps to grade

Occupant or Tenant John & Frances Delker

Contact Name Home & Deck Works Inc.

Address 261 Reams Dr.

City Glenwood State MD Zip Code 21738

Phone 410-442-3663

Fax 410-876-0200

Contractor Company Home & Deck Works Inc.

Contact Person David Bittner

Address 261 Reams Dr.

City Westminster State MD Zip Code 21158

License No. 30327

Phone 410-876-0200 Fax \_\_\_\_\_

Engineer or Architect Company \_\_\_\_\_

Contact Person Same

Address \_\_\_\_\_

City \_\_\_\_\_ State \_\_\_\_\_ Zip Code \_\_\_\_\_

Phone \_\_\_\_\_ Fax \_\_\_\_\_

BUILDING DESCRIPTION - COMMERCIAL

BUILDING DESCRIPTION - RESIDENTIAL

Building Characteristics

Utilities

Height: \_\_\_\_\_

No. of stories: \_\_\_\_\_

Gross area, sq. ft. per floor: \_\_\_\_\_

Use group: \_\_\_\_\_

Construction type:

☐ Reinforced Concrete

☐ Structural Steel

☐ Masonry

☐ Wood Frame

☐ State Certified Modular

Water Supply:

☐ Public

☐ Private

Sewage Disposal:

☐ Public

☐ Private

Electric Yes ☐ No ☐

Gas Yes ☐ No ☐

Heating System:

Electric ☐ Oil ☐

Natural Gas ☐

Propane Gas ☐

Sprinkler system: N/A ☐

☐ Full

☐ Partial

☐ Other Suppression

☐ # of Heads \_\_\_\_\_

Building Characteristics

Utilities

SF Dwelling ☒ SF Townhouse ☐

Depth Width

1st floor: \_\_\_\_\_

2nd floor: \_\_\_\_\_

Basement: \_\_\_\_\_

Finished Basement ☐ Unfinished Basement ☐

Crawl space ☐ Slab on Grade ☐

No. of Bedrooms \_\_\_\_\_

Multi-family dwellings:

No. of efficiency units: \_\_\_\_\_

No. of 1 BR units: \_\_\_\_\_

No. of 2 BR units: \_\_\_\_\_

No. of 3 BR units: \_\_\_\_\_

Other Structure: \_\_\_\_\_

Dimensions: \_\_\_\_\_

Footings: \_\_\_\_\_

Roof: \_\_\_\_\_

☐ State Certified Modular

☐ Manufactured Home

Water Supply:

☐ Public

☒ Private

Sewage Disposal:

☐ Public

☒ Private

Electric Yes ☐ No ☐

Gas Yes ☐ No ☐

Heating System:

Electric ☐ Oil ☐

Natural Gas ☐

Propane Gas ☒

Sprinkler system: N/A ☐

☐ NFPA #13D

☐ NFPA #13R

☐ Other: \_\_\_\_\_

THE UNDERSIGNED HEREBY CERTIFIES AND AGREES AS FOLLOWS: (1) THAT HE/SHE IS AUTHORIZED TO MAKE THIS APPLICATION; (2) THAT THE INFORMATION IS CORRECT; (3) THAT HE/SHE WILL COMPLY WITH ALL REGULATIONS OF HOWARD COUNTY WHICH ARE APPLICABLE THERETO; (4) THAT HE/SHE WILL PERFORM NO WORK ON THE ABOVE REFERENCED PROPERTY NOT SPECIFICALLY DESCRIBED IN THIS APPLICATION; (5) THAT HE/SHE GRANTS COUNTY OFFICIALS THE RIGHT TO ENTER ONTO THIS PROPERTY FOR THE PURPOSE OF INSPECTING THE WORK PERMITTED AND POSTING NOTICES.

Applicant's Signature

David Bittner

Title/Company

President

Print Name

David Bittner

Date

8-9-03

Checks payable to: DIRECTOR OF FINANCE OF HOWARD COUNTY

\*\* PLEASE WRITE NEATLY AND LEGIBLY. \*\*

- FOR OFFICE USE ONLY -

AGENCY

DATE

SIGNATURE APPROVAL

DPZ SETBACK

ION

PROPERTY ID#

16826