

PERMIT

SEWAGE DISPOSAL SYSTEM

DEPARTMENT OF HEALTH AND MENTAL HYGIENE

04-356276

HOWARD COUNTY HEALTH DEPARTMENT

BUREAU OF ENVIRONMENTAL HEALTH

313-2640

P 57059

A 44259

DISTRICT 4th

DATE 8/5/96

DATE SYSTEM APPROVED 10/11/96

INSPECTOR M. P. P. Kin

INDEXED

South Carroll Backhoe, Inc.

IS PERMITTED TO INSTALL ☒ ALTER ☐

ADDRESS 4410 Salem Bottom Road, Westminster, Maryland 21157 PHONE 875-4197

SUBDIVISION Gwyndyl Oak Estates LOT 30 ROAD 2852 Rolling Fork Way

PROPERTY OWNER NV Homes

ADDRESS

SEPTIC TANK CAPACITY 1250 GALLONS

NUMBER OF BEDROOMS 4

180 SQUARE FEET PER BEDROOM

LINEAR FEET OF TRENCH REQUIRED 240

TRENCHES - Trench to be 3 feet wide. Inlet 3 feet below original grade. Bottom maximum depth 5 feet below original grade. Effective area begins at 3 feet below original grade. 2 feet of stone below distribution pipe.

LOCATION - Place the distribution box 225 feet up the left lot line (335.19) and 30 feet off that same lot line when facing the lot from Rolling Fork Way. Run trenches on contour toward the right lot line.

NOTES - No trench to exceed 100 feet in length. Provide 6" - 8" diameter cleanout and cap to grade or above on septic tank. OK/CW

PLANS APPROVED BY Amy McMillen/Ronald J. Pinkley

DATE 12/15/94, 3/26/96

COVER NO WORK UNTIL INSPECTED AND APPROVED

vr/

NEITHER THE HOWARD COUNTY COUNCIL NOR THE HEALTH DEPARTMENT IS RESPONSIBLE FOR THE SUCCESSFUL OPERATION OF ANY SYSTEM

NOTE: CLEANOUT REQUIRED EVERY 70 FEET OF SEWER LINE AND/OR AT 90° SWEEPS IN LINES FROM HOUSE TO DRAIN FIELDS, 90° ELBOWS NOT ACCEPTABLE.

NOTE: ALL PARTS OF SEPTIC SYSTEMS (I.E. TANK, DISTRIBUTION BOX TRENCHES) TO BE 100 FEET FROM WELL (UNLESS OTHERWISE SPECIFICALLY AUTHORIZED)

NOTE: IF DEEP TRENCH(ES) ARE USED CALL FOR INSPECTION BEFORE AND AFTER PLACING GRAVEL IN TRENCH(ES)

NOTE: NO DRY WELL SHALL EXCEED 15 FOOT IN DIAMETER NO ABSORPTION TRENCH TO EXCEED 100 FEET IN LENGTH

NOTE: ALL PIPE FROM HOUSE TO SEPTIC TANK MUST BE CAST IRON OR SCHEDULE 35/40 PVC OR ABS

PERMIT VOID AFTER TWO YEARS

NOTE: INSTALL STAND PIPE ON SEPTIC TANK AND DRY WELL STAND PIPES MUST BE 6 INCHES IN DIAMETER CAST IRON. CONCRETE OR TERRA COTTA OR PVA OR ABS ACCEPTED. IF TOP OF SEPTIC TANK IS DEEPER THAN 3 FEET. MANHOLE TO GRADE REQUIRED.

NOTE: DISTRIBUTION BOXES MUST HAVE BAFFLES

*INSTALLER IS RESPONSIBLE FOR OBTAINING FINAL APPROVAL ON THIS PERMIT

HD-260(6-90)

*CALL 461-9933 FOR INSPECTION OF SEPTIC SYSTEM.


OG. PERMIT SIGNED

AND RETURNED

Serial # 200103039

install 1-570 gal undeg pipes tank

A 44259

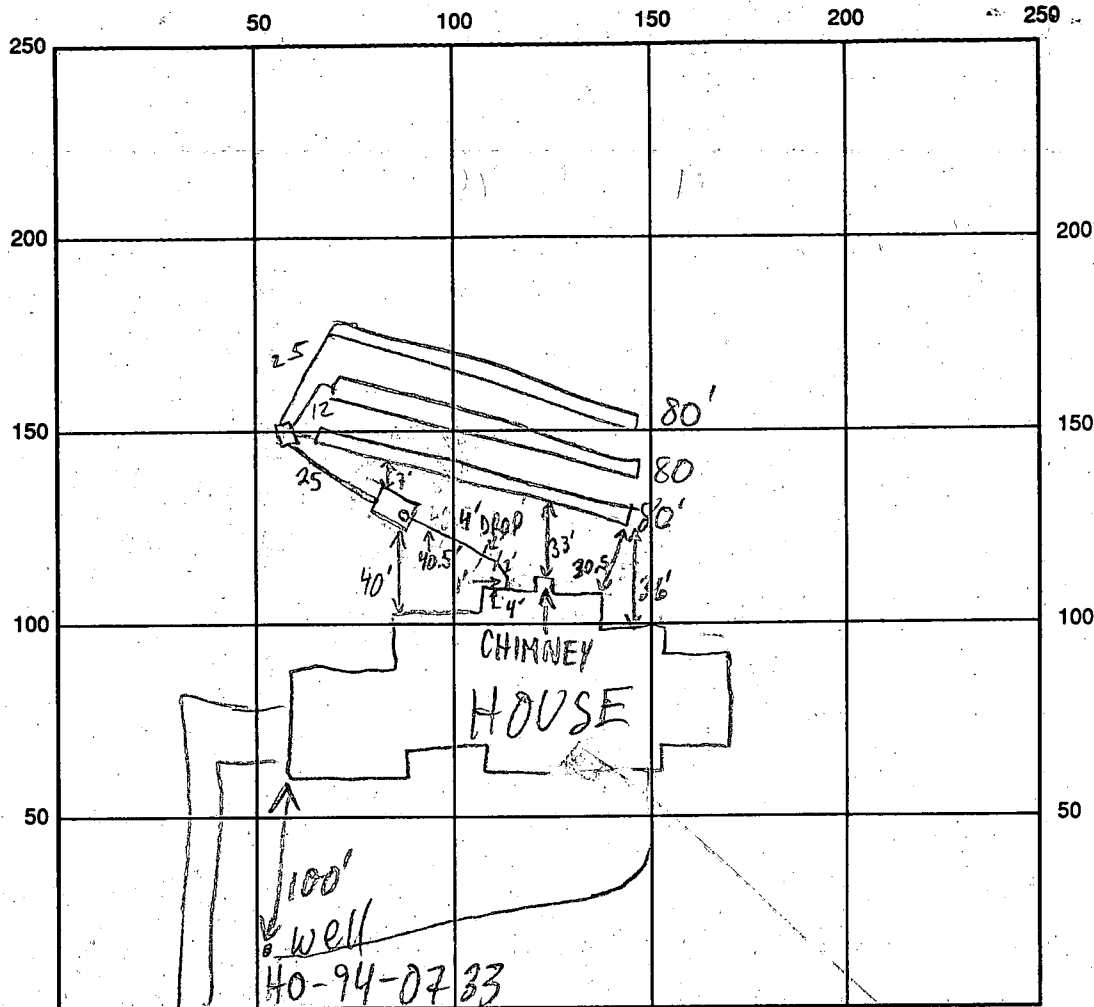

INDICATE NORTH - NAME ADJOINING ROADWAY AS BASE LINE

SEPTIC TANK LEVEL 1500 GAL - OK

CLEANOUTS S.T. - OK

DISTRIBUTION BOX LEVEL _____

DRAIN FIELD/TITLE DEPTH 5 FT.

TRENCH WIDTH 3 FT.

INLET DEPTH 3 FT.

EFFECTIVE GRAVEL DEPTH 2 FT.

TOTAL LENGTH 3 @ 80 FT.

NUMBER OF TRENCHES 3

ONE-SIDEWALL/BOTTOM AREA 3 @ 240 SQ. FT.

DRYWALL INSIDE DIAMETER _____ FT.

EFFECTIVE DEPTH BELOW INLET _____ FT.

ABSORBENT AREA 720 SQ. FT.

REMARKS: 9/3/96 NO WORK DONE, NO ONE PRESENT; HOUSE APPEARS TO HAVE
SLID 25' BACK (BASED ON 100' DISTANCE TO WELL); HOUSE FOOT-
PRINT NOT PER PLAN MR 9/11/96 RECEIPT OF ACCEPTABLE REVISED
SITE PLAN. 10/11/96 OK TO DIG ALL TRENCHES, LEAVE ENDS
OPEN MR 10/11/96 TRENCHES FINISHED UNEXPECTEDLY - OK TO
COVER TRENCHES & ALL WORK (VIATK) MR/CW 10/15/96 WPT OK PLAN

DATE SYSTEM APPROVED 10/11/96

INSPECTOR M. Riskin

APPLICATION

PERCOLATION TESTING

HOWARD COUNTY HEALTH DEPARTMENT
BUREAU OF ENVIRONMENTAL HEALTH
P.O. BOX 476 ELLICOTT CITY, MARYLAND 21043
TELEPHONE: 461-9933

A 44259

P _____

DISTRICT 4th

DATE _____

TO: THE COUNTY HEALTH OFFICER
ELLICOTT CITY, MARYLAND

I, HEREBY, APPLY FOR THE NECESSARY TEST IN ORDER TO CONSTRUCT (OR RECONSTRUCT) A SEWAGE DISPOSAL SYSTEM.

PROPERTY OWNER Pettit and Griffin, Inc. NU Homes.

ADDRESS 48205-D Flower Hill Way 2200 Defense Hwy.
Gaithersburg, Maryland 20879 Clifton, MD, 21114 PHONE 301-975-1020

PROSPECTIVE BUYER _____

ADDRESS _____ PHONE 30

PROPERTY LOCATION:

SUBDIVISION McKendree Estates Gwynndyl L80. LOT NO. 32 29 Lot 30

ROAD AND DESCRIPTION McKendree Road and Route 97 2852 Rolling Fork Wy.

BLDG. PERMIT SIGNED

AND RETURNED 4-12-96

Serial # 64181

TAX MAP 14 PARCEL # 123

SIZE OF LOT 3 AC. + TYPE BLDG. Single Family - 4 BRMS
(SINGLE FAMILY DWELLING OR COMMERCIAL)

THE SYSTEM INSTALLED UNDER THIS APPLICATION IS ACCEPTABLE ONLY UNTIL PUBLIC FACILITIES BECOME AVAILABLE. I FULLY UNDERSTAND THE

FEE CONNECTED WITH THE FILING OF THIS PERC TEST APPLICATION IS NON-REFUNDABLE UNDER ANY CIRCUMSTANCES. I ALSO AGREE TO COMPLY

WITH ALL M.O.S.H.A. REQUIREMENTS IN TESTING THIS LOT. _____

(SIGNATURE OF APPLICANT)

APPROVED BY _____ FOR _____ DATE _____

REJECTED BY _____ FOR _____ DATE _____

HOLD PENDING FURTHER TESTS _____ DATE _____

REASONS FOR REJECTION OR HOLDING _____

HD-216

THIS IS NOT A PERMIT

OKellerman Jr
J D A

C 1 915

SEQUENCE NO.
(DENV USE ONLY)STATE OF MARYLAND
WELL COMPLETION REPORTFILL IN THIS FORM COMPLETELY
PLEASE PRINT OR TYPETHIS REPORT MUST BE SUBMITTED WITHIN
45 DAYS AFTER WELL IS COMPLETED.COUNTY
NUMBER

A 44259

ST/CO USE ONLY
DATE Received

8 13

DATE WELL COMPLETED

03 27 96

Depth of Well

22 20 5 26
(TO NEAREST FOOT)PERMIT NO.
FROM "PERMIT TO DRILL WELL"

H0-94-0733

OWNER Pettit & Griffin Inc.

STREET OR RFD *Rolling Fork Way* TOWN *Rolling Fork*SUBDIVISION *Gandy Oak Estates*

SECTION

LOT

30

WELL LOG

Not required for driven wells

STATE THE KIND OF FORMATIONS
PENETRATED, THEIR COLOR, DEPTH,
THICKNESS AND IF WATER BEARING

DESCRIPTION (Use additional sheets if needed)	FEET		Check if water bearing
	FROM	TO	
dirt	0	10	
hard gray/tan rock	10	24	
hard gray rock	24	41	
med tan (chips)	41	42	
hard gray rock	42	46	
med hard tan rock	46	47	
hard gray rock	47	49	
med tan rock	49	50	X
hard gray rock	50	52	
med tan rock	52	53	X
hard gray rock	53	69	
med hard/tan/gray	69	85	
med hard/hard tan	85	205	X

GROUTING RECORD

WELL HAS BEEN GROUTED
(Circle Appropriate Box)yes ☒ Y no ☐ N

TYPE OF GROUTING MATERIAL

CEMENT ☒ CM BENTONITE CLAY ☒ BC

NO. OF BAGS 6 NO. OF POUNDS 600

GALLONS OF WATER 35

DEPTH OF GROUT SEAL (to nearest foot)

from 0 ft. to 9 ft.
(enter 0 if from surface)

CASING RECORD

casing
types
insert
appropriate
code
belowST CO
STEEL CONCRETE
PL OT
PLASTIC OTHERMAIN
CASING
TYPENominal diameter
top (main) casing
(nearest inch)Total depth
of main casing
(nearest foot)

P L

6

20

EACH
CASINGOTHER CASING (if used)
diameter depth (feet)
inch from toscreen type
or open holeinsert
appropriate
code
below

SCREEN RECORD

ST
STEELBR
BRASSHO
OPEN
HOLEPL
BRONZEOT
OTHER

C 2

EACH
SCREEN

DEPTH (nearest ft.)

S T

18

60

H O

60

205

C 3

1 2

PUMPING TEST

HOURS PUMPED (nearest hour)

3

PUMPING RATE (gal. per min.
to nearest gal.)

1 3 15

METHOD USED TO
MEASURE PUMPING RATE

timer

WATER LEVEL (distance from land surface)

BEFORE PUMPING

3 5 20

WHEN PUMPING

1 0 25

TYPE OF PUMP USED (for test)

A air

P piston

T turbine

C centrifugal

R rotary

O other
(describe
below)

J jet

S submersible

PUMP INSTALLED

DRILLER WILL INSTALL PUMP

YES NO

IF DRILLER INSTALLS PUMP, THIS SECTION
MUST BE COMPLETED FOR ALL WELLS
EXCEPT HOME USE
TYPE OF PUMP INSTALLED
PLACE (A,C,J,P,R,S,T,O)
IN BOX - SEE ABOVE:CAPACITY:
GALLONS PER MINUTE
(to nearest gallon)

31 35

PUMP HORSE POWER

37 41

PUMP COLUMN LENGTH
(nearest ft.)

43 47

CASING HEIGHT (circle appropriate box
and enter casing height)

+ above

- below

LAND SURFACE

1 (nearest
foot)

LOCATION OF WELL ON LOT

SHOW PERMANENT STRUCTURE SUCH AS
BUILDING, SEPTIC TANKS, AND/OR
LANDMARKS AND INDICATE NOT LESS
THAN TWO DISTANCES
(MEASUREMENTS TO WELL)Drilled on
improved stakeCIRCLE APPROPRIATE LETTER
A A WELL WAS ABANDONED AND SEALED
WHEN THIS WELL WAS COMPLETED

E ELECTRIC LOG OBTAINED

P TEST WELL CONVERTED TO PRODUCTION
WELLI HEREBY CERTIFY THAT THIS WELL HAS BEEN CONSTRUCTED IN
ACCORDANCE WITH COMAR 26.04.04 "WELL CONSTRUCTION"
AND IN CONFORMANCE WITH ALL CONDITIONS STATED IN THE
ABOVE CAPTIONED PERMIT, AND THAT THE INFORMATION PRE-
SENTED HEREIN IS ACCURATE AND COMPLETE TO THE BEST OF
MY KNOWLEDGE.

DRILLERS IDENT. NO. 304

DRILLERS SIGNATURE
(MUST MATCH SIGNATURE ON APPLICATION)SITE SUPERVISOR (sign. of driller or journeyman
responsible for sitework if different from permittee)GRAVEL PACK
IF WELL DRILLED WAS
FLOWING WELL INSERT
F IN BOX 68OEP USE ONLY
(NOT TO BE FILLED IN BY DRILLER)

T

(E.R.O.S.)

W Q

70

72

74 75 76

TELESCOPE
CASINGLOG
INDICATOR

OTHER DATA

COUNTY

Ground work
complete

HOWARD COUNTY HEALTH DEPARTMENT
Bureau of Environmental Health
3525-H Ellicott Mills Drive
Ellicott City, MD 21043

Fax 313-2648 313-2640

APPLICATION FOR PITLESS ADAPTER, WELL PUMP AND PRESSURE TANK INSTALLATION

New Installation ☒
Replacement ☐

Receipt #

Date

10/16/96

Name of Installer

ROBERT L. FEEZER CO., INC.

Telephone

781-4653

License Number

2122

Certified Well Pump Installer ☒

Well Driller ☐

Registered Plumber ☒

Name of Property Owner

NV-HOMES

Telephone

795-1405

Subdivision

MCKENDEE ESTATES

Lot #

30

Well Tag #

40-94-0733

Site Address

2852 ROLLING PARKWAY

GWYNOLY OAKS EST.

Pump

1. Type

a. Deep well jet

b. Shallow well jet

c. Submersible ☒

2. Make

PURTE WATLINE

3. Model #

4P07C05301

4. Capacity

7

GPM

5. Pump exceeds well capacity Yes ☐ No ☐

6. If Yes, is low pressure cutoff switch installed? Yes ☐ No ☒

7. What methods are used to protect the pump and electrical wiring from vibrations? Torque arrestors ☐ Cable guards ☒ Other ☐

Motor

1. Horsepower

1/2

2. RPM

3450

3. Voltage

a. 110

b. 220 ☒

Pitless Adapter

1. Make

HAYWARD

2. Model #

XT800

3. Depth

42' +

Tank

1. Capacity

36 GALS.

2. Pressure relief valve? ☒

Piping

1. Type

Poly.

2. Size

1"

3. NSF and/or BOCA Code approved ☒

4. Depth of supply line

42'

Well data

1. Depth

200 ft.

2. Yield

GPM

3. Static water level

ft.

4. Will water supply be disinfected by installer? ☒

I understand that it is my responsibility to notify the Howard County Health Department when the installation is ready for inspection (otherwise this permit is null and void).

All information given above is true to the best of my knowledge.

Signature of Applicant

Robert L. Feezer

Date:

10/16/96

Note: A sticker indicating approval/status of the installation will be placed on the well casing at the time of the inspection.

Notes:


4th ELEC. DIST. HOWARD CO., MD
July 10, 1996 1"=50'

1. Lot shown contains 54,843 s.f. of land and recorded at plat # 11552 among the Land Records of Howard County, Maryland.
2. Prepared by Gutschick, Little and Weber, P.A.
3. Grading around house may vary due to field conditions.
4. No construction stockpiling refuse or excess material shall be buried in septic easement.
5. Wells shown per SP-93-15.
6. Install sediment controls as required by Site Inspector. See Sediment Control Plan # GP-95-26.
7. Disturbed area shown is 20,090 s.f.
8. Pile excavated material on high side of trench when installing septic field prior to disposal of excess material.
9. Length of trench for septic system to be determined and specified by Howard County Department of Health.

2852 Rolling forkway

ROLLING FORK WAY

permit
64181

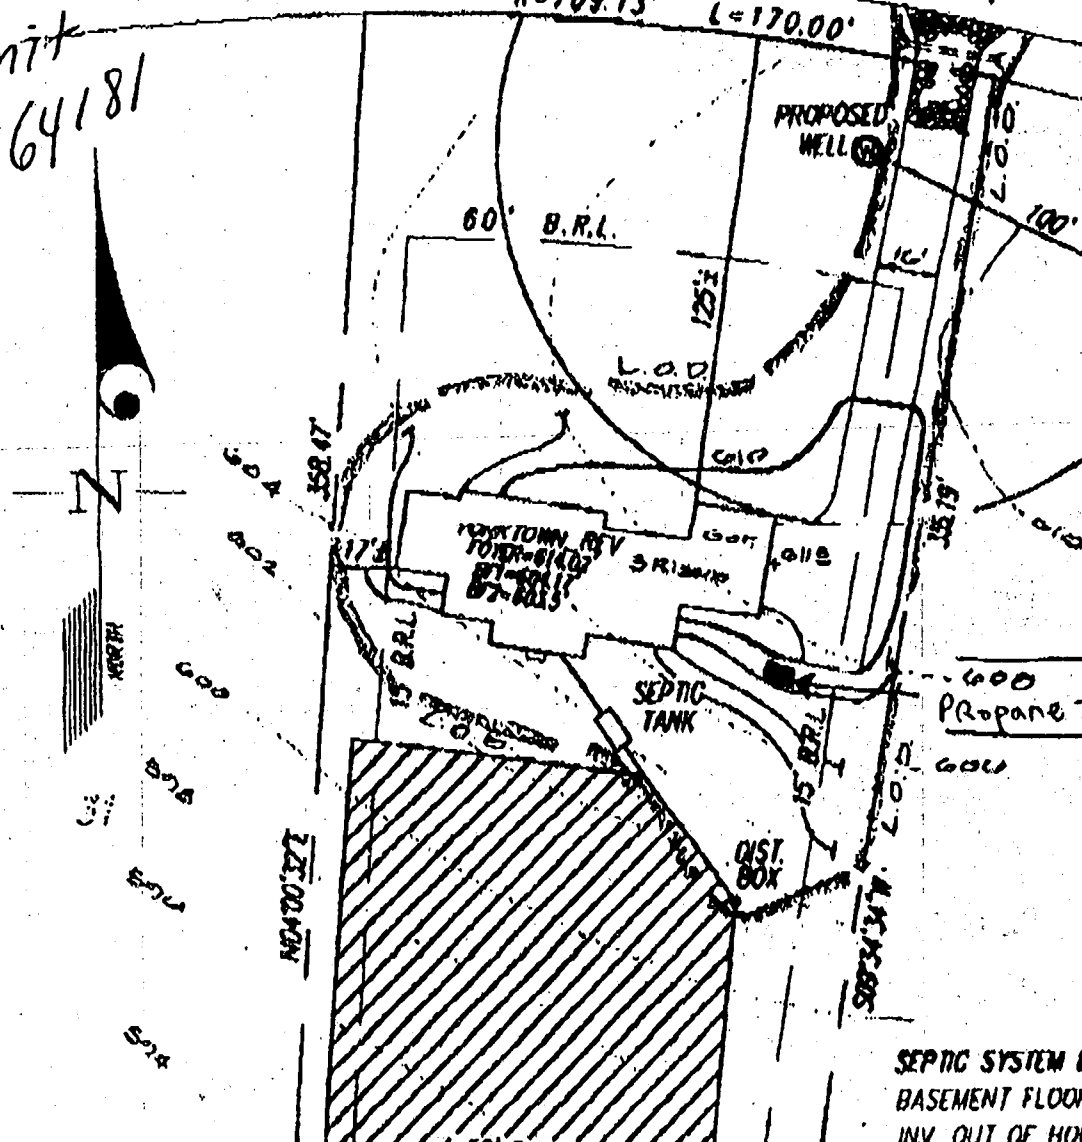

11/14/96
Prepare @
tank location
OK / OK as shown
(DLS)

SEPTIC SYSTEM DATA:
BASEMENT FLOOR AREA = 603.5'/604.1'
INV. OUT OF HOUSE = 601.15'

Approved Septic System Plan
Howard County Health Department

REVISED PLAN
SUBMITTED 9-11-96
THIS PLAN FOR
RECORDS ONLY - DISCARD
AFTER FINAL



Notes:

1. Lot shown contains 54,843 s.f. of land and recorded at plat # 11552 among the Land Records of Howard County, Maryland.
2. Prepared by Gutschick, Little and Weber, P.A.
3. Grading around house may vary due to field conditions.
4. No construction stockpiling refuse or excess material shall be buried in septic easement.
5. Wells shown per SP-93-15.
6. Install sediment controls as required by Site Inspector. See Sediment Control Plan # GP-95-26.
7. Disturbed area shown is 18,250 s.f.
8. Pile excavated material on high side of trench when installing septic field prior to disposal of excess material.
9. Length of trench for septic system to be determined and specified by Howard County Department of Health.

SEPTIC SYSTEM DATA:

BASEMENT FLOOR AREA = 604.33'
INV. OUT OF HOUSE = 602.97'
INV. IN AT SEPTIC TANK = 602.25'
INV. OUT AT SEPTIC TANK = 602.0'
EX. ELEV. AT SEPTIC TANK = 605.0'±
PROP. ELEV. AT SEPTIC TANK = 604.0'±
INV. IN AT DIST. BOX = 599.00'
EX. ELEV. AT DIST. BOX = 602.0'±

LOT 30
GWYNDYL OAK ESTATES
4th ELEC. DIST. HOWARD CO., MD
March 7, 1996 1"=50'

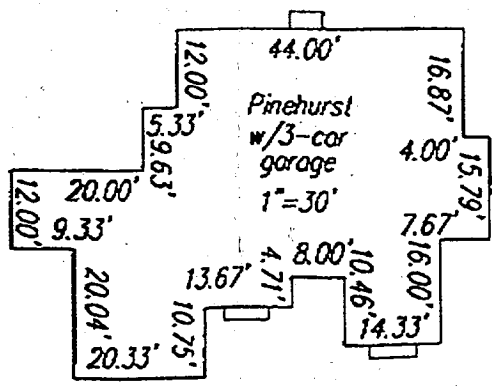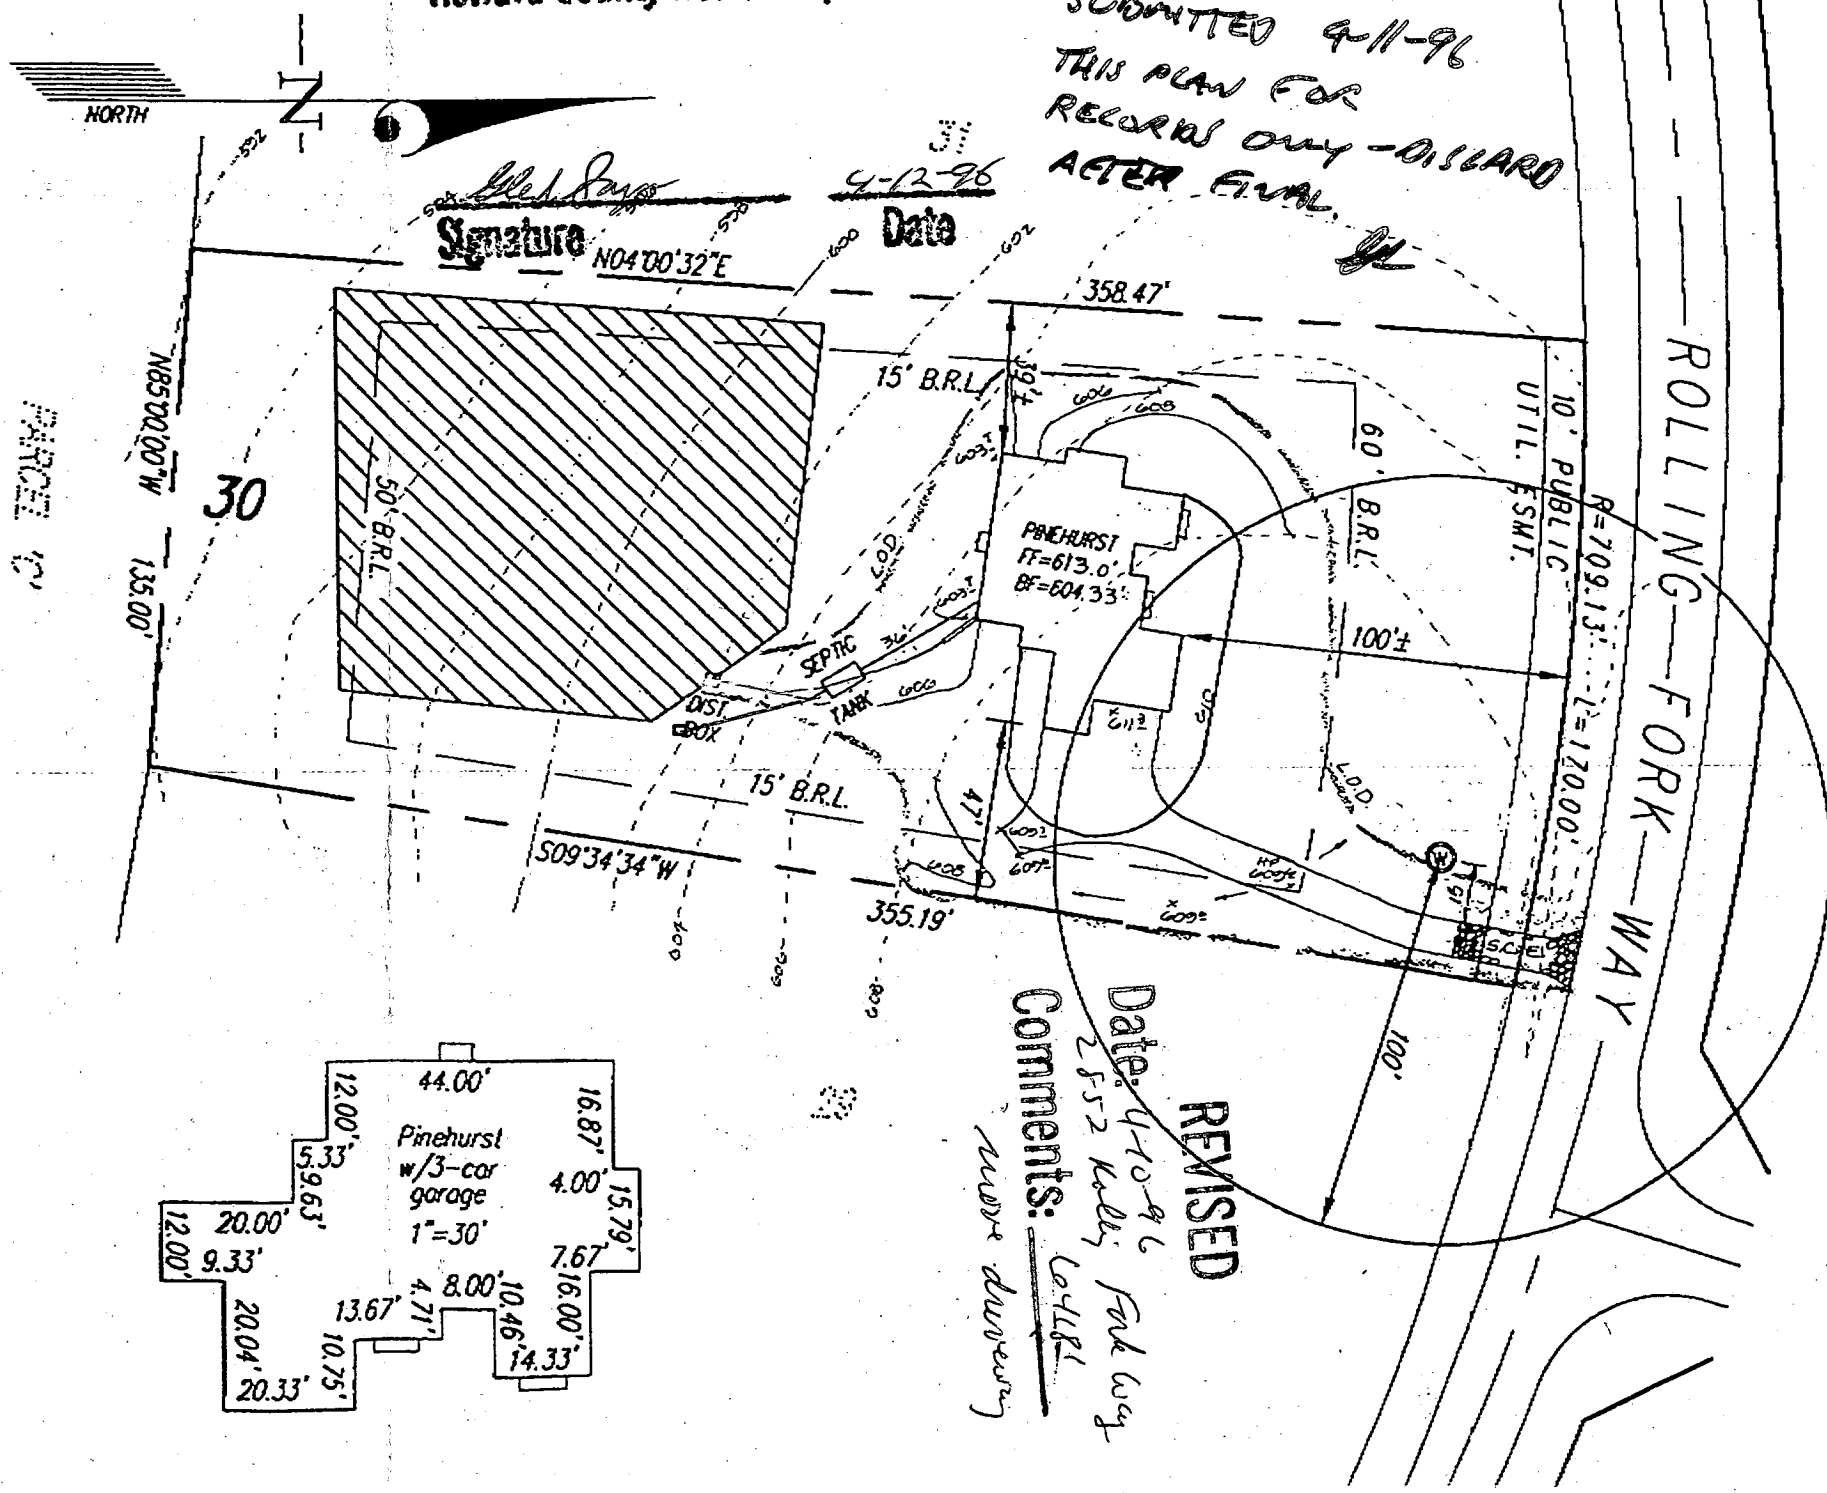

REVISED
Date: 4-10-96
Comments: 2552 Kelly's Field way
more driveway

APR 3 1996 TUE 7:05 PM GUTSCHICK LITTLE WEBER PLA NO. 2014214100

584.5
X


Preliminary Plan
SP 93-15


AREA C

ROAD

COURT

11

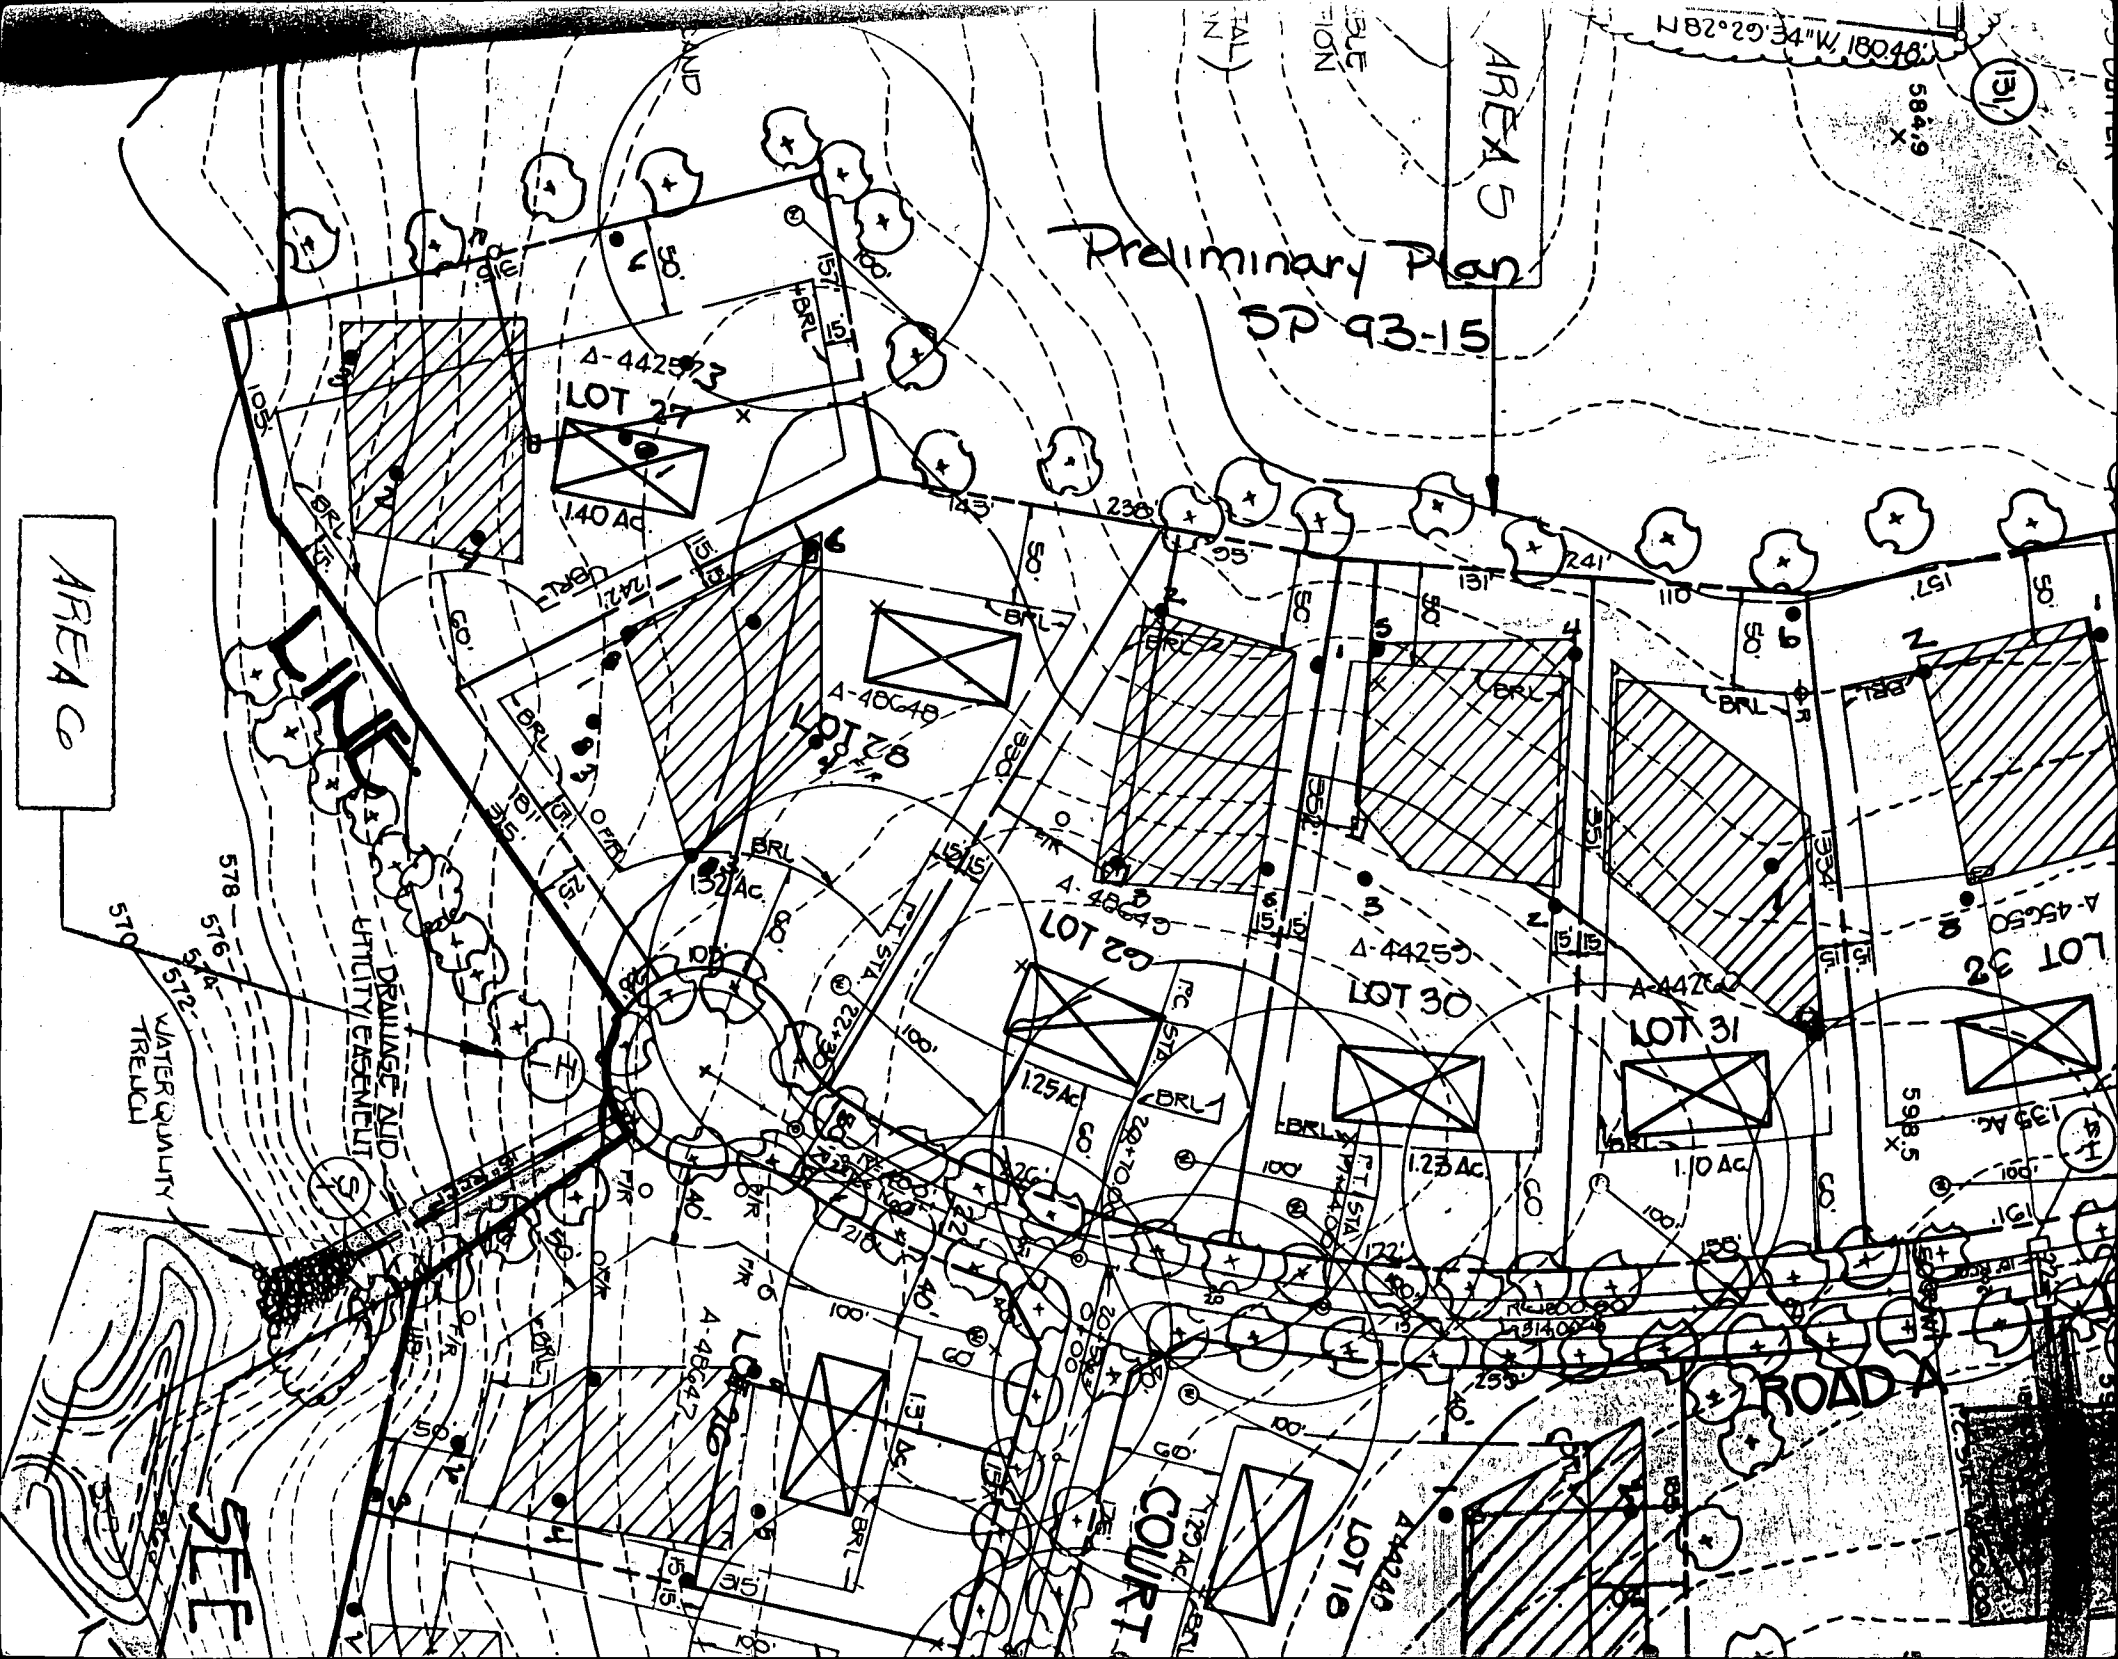

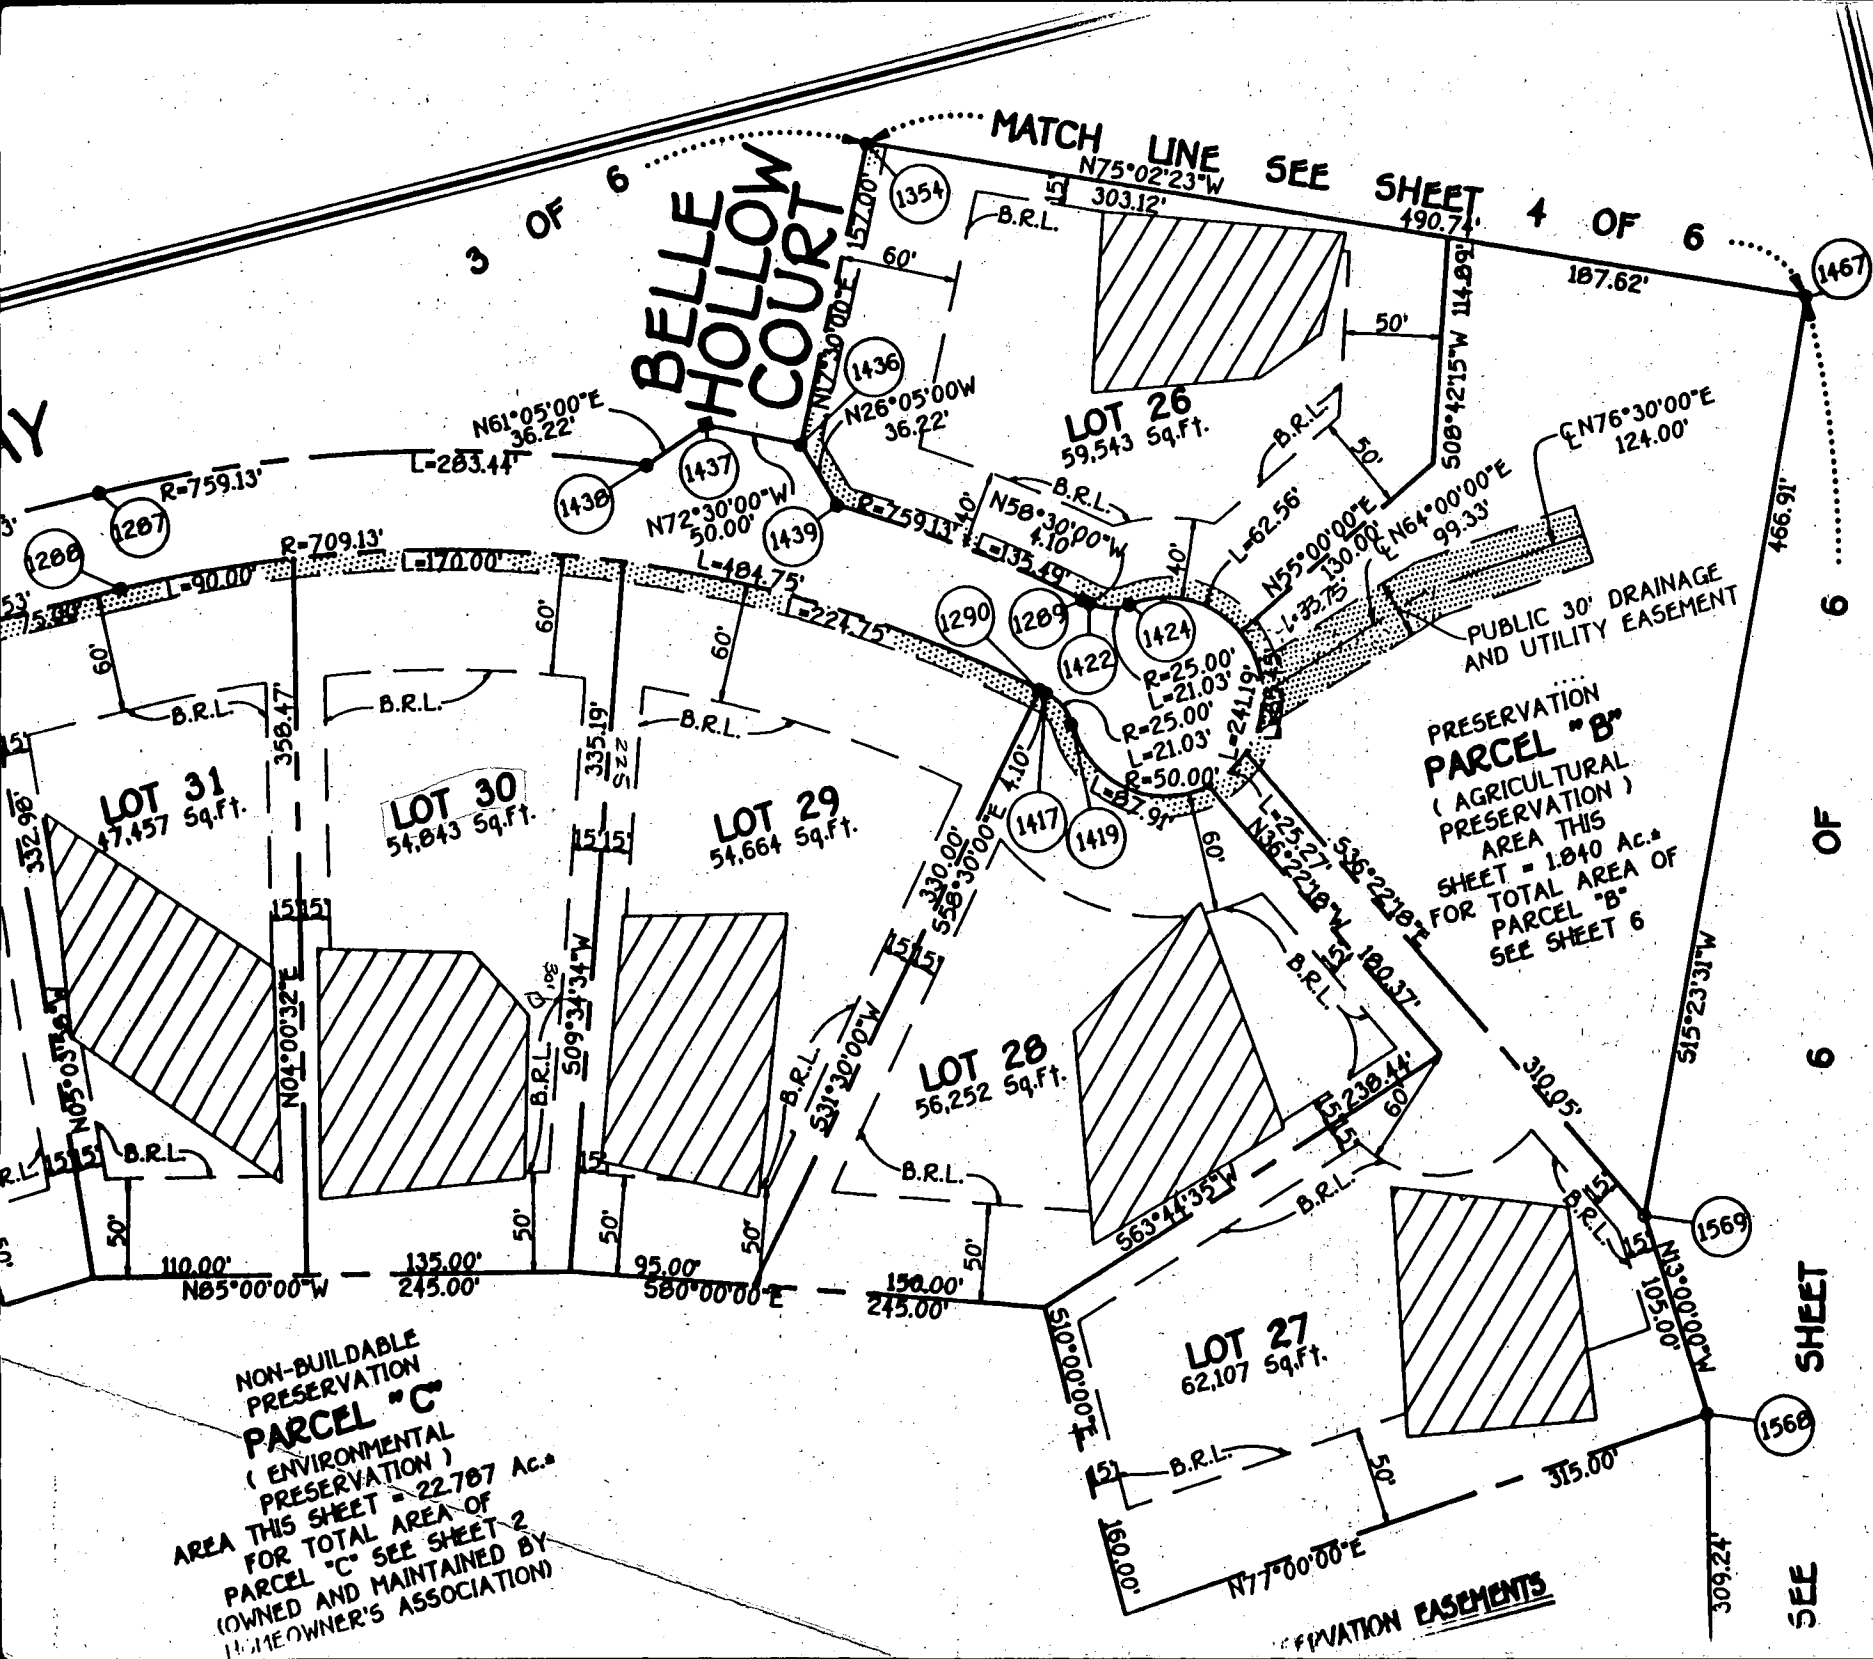

DEPARTMENT OF INSPECTIONS, LICENSES AND PERMITS
3430 COURT HOUSE DRIVE
ELLICOTT CITY, MD 21043
PERMITS (410)313-2466 INSPECTIONS (410)313-1810
AUTOMATED INFORMATION (410) 313-3800

HOWARD COUNTY
PERMIT APPLICATION

PERMIT NUMBER
157059444257
B00124549

Building Address 2852 Rolling Fork Way
Glenwood MD 21738

Suite/Apt. #: SDP/WP/Petition #: Census/Tract 604B Subdivision Gwynedd/Glen Estates
Section 6040 Lot 308
Tax Map 141A Parcel 1423 Grid 11
Zoning RCH Map Coordinates 1403 Lot size

Existing Use SED
Proposed Use Storage/Dock
Estimated Construction Cost \$ 9000
Description of Work Deck on Rear of House
14 x 20 w/ steps

Property Owner's Name 2852 Rolling Fork Way
Address Ram D Spiran

City Glenwood State MD Zip Code 21738

Home Phone 410-489-9102 Work Phone
Applicant's Name & Mailing Address, (if other than stated hereon):

Phone Fax

Contractor Company Chesapeake Deck & Patio
Contact Person Danny Burns
Address 3134 Cardinal Dr
City Westminister State MD Zip Code 21157
License No. 69904
Phone 410-635-6374 Fax

Occupant or Tenant
Contact Name
Address
City State Zip Code
Phone Fax

Engineer or Architect Company
Contact Person
Address
City State Zip Code
Phone Fax

BUILDING DESCRIPTION - COMMERCIAL		BUILDING DESCRIPTION - RESIDENTIAL	
Building Characteristics Height: No. of stories: 2 Gross area, sq. ft. per floor: Use group: Construction type: Reinforced Concrete Structural Steel Masonry Wood Frame State Certified Modular	Utilities Water Supply: Public Private Sewage Disposal: Public Private Electric Yes ☐ No ☐ Gas Yes ☐ No ☐ Heating System: Electric ☐ Oil ☐ Natural Gas ☒ Propane Gas ☐ Sprinkler system: N/A ☐ Full Partial Other Suppression # of Heads	Building Characteristics SF Dwelling ☒ SF Townhouse ☐ Depth Width 1st floor: 2nd floor: Basement: Finished Basement ☐ Unfinished Basement ☒ Crawl space ☐ Slab on Grade ☐ No. of Bedrooms Multi-family dwellings: No. of efficiency units: No. of 1 BR units: No. of 2 BR units: No. of 3 BR units: Other Structure: Dimensions: Footings: Roof: State Certified Modular Manufactured Home	Utilities Water Supply: Public Private Sewage Disposal: Public Private Electric Yes ☐ No ☐ Gas Yes ☐ No ☐ Heating System: Electric ☐ Oil ☐ Natural Gas ☐ Propane Gas ☐ Sprinkler system: N/A ☐ NFPA #13D NFPA #13R Other:

THE UNDERSIGNED HEREBY CERTIFIES AND AGREES AS FOLLOWS: (1) THAT HE/SHE IS AUTHORIZED TO MAKE THIS APPLICATION; (2) THAT THE INFORMATION IS CORRECT; (3) THAT HE/SHE WILL COMPLY WITH ALL REGULATIONS OF HOWARD COUNTY WHICH ARE APPLICABLE THERE TO; (4) THAT HE/SHE WILL PERFORM NO WORK ON THE ABOVE REFERENCED PROPERTY NOT SPECIFICALLY DESCRIBED IN THIS APPLICATION; (5) THAT HE/SHE GRANTS COUNTY OFFICIALS THE RIGHT TO ENTER ONTO THIS PROPERTY FOR THE PURPOSE OF INSPECTING THE WORK PERMITTED AND POSTING NOTICES.


Applicant's Signature
Chesapeake Deck & Patio
Title/Company

Print Name
DANNY BURNS
Date
6-1-00

Checks payable to: DIRECTOR OF FINANCE OF HOWARD COUNTY
** PLEASE WRITE NEATLY AND LEGIBLY **
- FOR OFFICE USE ONLY -

AGENCY	DATE	SIGNATURE APPROVAL	DPZ SETBACK INFORMATION	PROPERTY ID#
X Land Development DPZ			Front:	116825
State Highways			Rear:	Filing fee \$
X Building Official	5/31/00	[Signature]	Side:	Permit fee \$ 30
Dev. Engineering DPZ			Side St.:	Excise tax \$
X Health	5/3/00	[Signature]	All minimum setbacks met?	Sub-total paid \$
Fire Protection			YES ☐ NO ☐	Add'l permit fee \$
Is Sediment Control approval required prior to issuance?			Is Entrance Permit required?	TOTAL FEES \$ 30
YES ☐ NO ☐			YES ☐ NO ☐	Balance due \$
CONTINGENCY CONSTRUCTION START: ☐			Historic District?	Check # 1281
ONE STOP SHOP: ☐			YES ☐ NO ☐	Validation # 32408
			Lot Coverage for New Town Zone	Accepted by [Signature]
			SDP/Red-line approval date	

ROLLING FORK WAY
00' 50' R/W

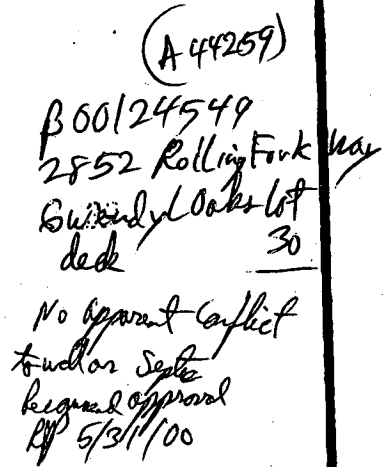

95-052