

PERMIT

SEWAGE DISPOSAL SYSTEM

MARYLAND STATE DEPARTMENT OF HEALTH

HOWARD COUNTY

BUREAU OF ENVIRONMENTAL HEALTH

461-9933

04-312066

INDEXED

P 44603

A REPAIR

DISTRICT 4th

DATE 6/28/89

DATE SYSTEM APPROVED 5-4-89

INSPECTOR Sabl

Jack Fyock

IS PERMITTED TO INSTALL ALTER X

ADDRESS _____ PHONE 988-9270

SUBDIVISION _____ ROAD 1380 Route 97 LOT 2

PROPERTY OWNER D. M. Rehs
1380 Route 97

ADDRESS _____

IF GARBAGE GRINDER IS USED INCREASE SEPTIC TANK CAPACITY BY 50% AND ABSORPTION AREA BY 22%.

GARBAGE GRINDER? YES _____ NO _____

SEPTIC TANK CAPACITY _____ GALLONS NUMBER OF BEDROOMS _____

REPAIR - CALL FOR INSPECTION WHEN GROUND IS OPENED UP SO SANITARIAN CAN RECOMMEND REPAIR.

PLANS APPROVED BY C. Williams DATE 5/03/89

COVER NO WORK UNTIL INSPECTED AND APPROVED

NEITHER THE HOWARD COUNTY COUNCIL NOR THE HEALTH DEPARTMENT IS RESPONSIBLE FOR THE SUCCESSFUL OPERATION OF ANY SYSTEM.

NOTE: CLEANOUT REQUIRED EVERY 70 FEET OF SEWER LINE AND/OR AT 90° SWEEPS IN LINES FROM HOUSE TO DRAIN FIELDS

NOTE: ALL PARTS OF SEPTIC SYSTEMS (I.E., TANK, DISTRIBUTION BOX, TRENCHES) TO BE 100 FEET FROM WELL (UNLESS OTHERWISE SPECIFICALLY AUTHORIZED)

NOTE: IF DEEP TRENCHES ARE USED CALL FOR INSPECTION BEFORE AND AFTER PLACING GRAVEL IN TRENCHES

NOTE: NO DRY WELL SHALL EXCEED 15 FOOT IN DIAMETER NO ABSORPTION TRENCH TO EXCEED 100 FEET IN LENGTH

NOTE: ALL PIPE FROM HOUSE TO SEPTIC TANK MUST BE CAST IRON OR SCHEDULE 40 PVC OR ABS

PERMIT VOID AFTER TWO YEARS


NOTE: INSTALL STAND PIPE ON SEPTIC TANK AND DRY WELL. STAND PIPES MUST BE 6 INCHES IN DIAMETER. CAST IRON, CONCRETE OR TERRA COTTA OR PVC OR ABS ACCEPTED. IF TOP OF SEPTIC TANK IS DEEPER THAN 3 FEET, MANHOLE TO GRADE REQUIRED

NOTE: DISTRIBUTION BOXES MUST HAVE BAFFLES

***INSTALLER IS RESPONSIBLE FOR OBTAINING FINAL APROVAL ON THIS PERMIT**

***CALL 461-9933 FOR INSPECTION OF SEPTIC SYSTEMS.**

P 44603

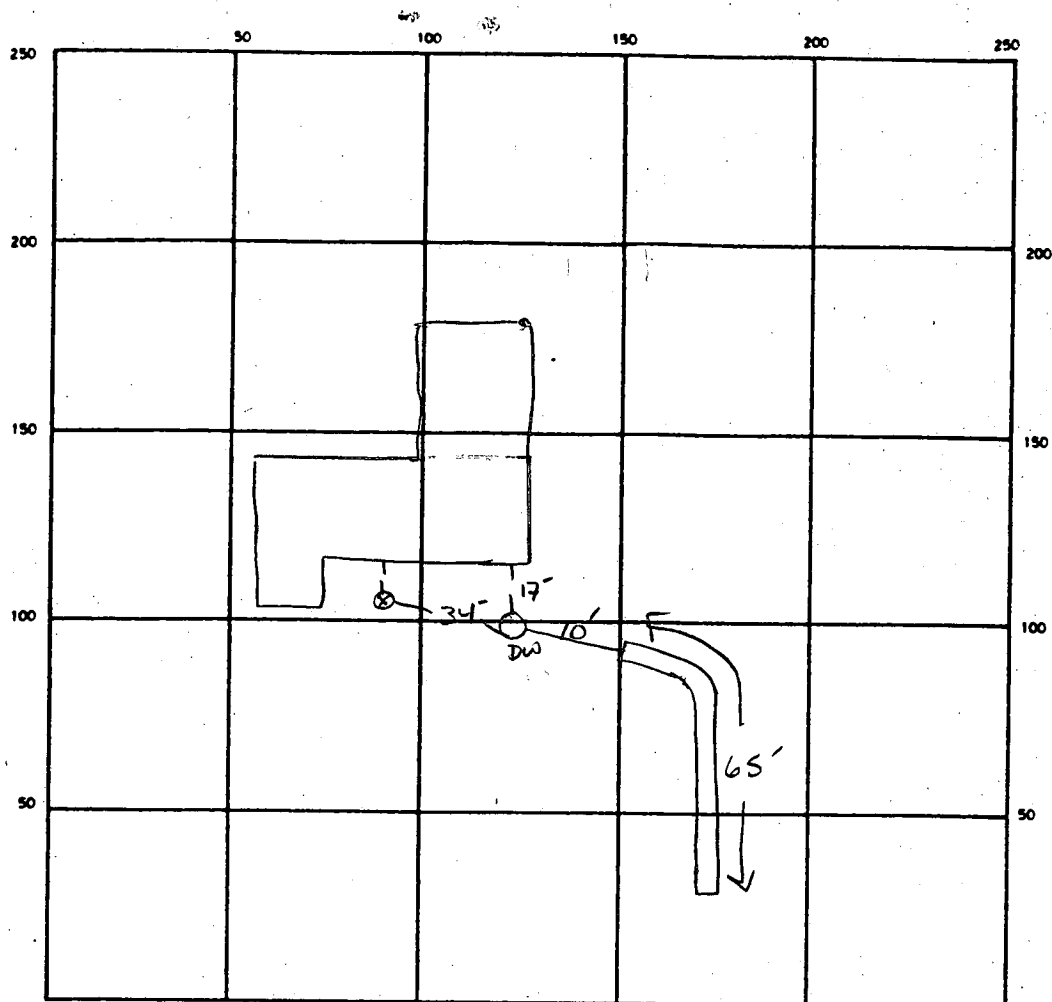

INDICATE NORTH - NAME ADJOINING ROADWAY AS BASE LINE

Rt97

SEPTIC TANK. LEVEL EXISTING

CLEANOUTS EXISTING DW/ST ^{below grade}

DISTRIBUTION BOX. LEVEL N/A

DRAIN FIELD/TILE FIELD. DEPTH 11' FT. TRENCH WIDTH 2 FT. INLET DEPTH 4.0' FT.

EFFECTIVE GRAVEL DEPTH 7' FT. TOTAL LENGTH 65 FT.

NUMBER OF TRENCHES 1 ONE SIDEWALL BOTTOM AREA 45.5 SQ. FT.

DRYWELL INSIDE DIAMETER EXISTING FT. EFFECTIVE DEPTH BELOW INLET EXISTING FT.

ABSORBENT AREA 455+ SQ. FT.

REMARKS _____

DATE SYSTEM APPROVED 5-4-89 INSPECTOR S. Abel

PERMIT

SEWAGE DISPOSAL SYSTEM

MARYLAND STATE DEPARTMENT OF HEALTH*

HOWARD COUNTY

ELLICOTT CITY

DISTRICT 4th

INDEXED

DATE 4/3/78

P 27755

A 17667

Pat Lendrim

IS PERMITTED TO INSTALL X ALTER

ADDRESS 14010 Forsythe Road, Sykesville, Md. 21784

PHONE 442-2416

SUBDIVISION _____ ROAD 1380 Route 97

LOT 2

PROPERTY OWNER D. H. Rehsi

ADDRESS 4724 Aldgrade Green, Baltimore, Md. 21227

Phone: 242-8407

SPECIFICATIONS 3 bedrooms

SEPTIC TANK CAPACITY 1000 GALLONS

DRAIN FIELD _____ DEPTH _____ FEET, BOTTOM AREA _____ SQ. FT.

DEEP TRENCH _____ DEPTH _____ FEET, BOTTOM AREA _____ SQ. FT.

SEEPAGE PITS _____ ABSORBENT SIDE-WALL AREA 125 SQ. FT. absorbent sidewall area per bedroom

INLET PIPE 3 1/2 FT. BELOW ORIGINAL GRADE. MAXIMUM DEPTH 11 1/2 FT. BELOW ORIGINAL GRADE

EFFECTIVE DEPTH AT _____ FT. BELOW ORIGINAL GRADE.

LOCATE DISPOSAL AREA 120 FT. FROM front LOT LINE AND 20 FT. FROM right LOT LINE AS SEEN WHEN
FACING LOT FROM the road (perc hole 4 & 5).

PLANS APPROVED BY Charles B. Streaker

DATE 5/16/74

COVER NO WORK UNTIL INSPECTED AND APPROVED.

NEITHER THE HOWARD COUNTY COUNCIL NOR THE HEALTH DEPARTMENT IS RESPONSIBLE FOR THE SUCCESSFUL OPERATION OF ANY SYSTEM.

NOTE: IF TRENCH IS USED CALL FOR INSPECTION BEFORE PLACING GRAVEL IN TRENCH.

NOTE: NO DRY WELL SHALL EXCEED 15 FOOT IN DIAMETER.

NOTE: ALL PIPE FROM HOUSE TO DISPOSAL AREA MUST BE CAST IRON.

PERMIT VOID AFTER THREE YEARS.

NOTE: INSTALL STAND PIPE ON SEPTIC TANK AND DRY WELL. STAND PIPES MUST BE 6 INCHES IN DIAMETER. CAST IRON, CONCRETE OR TERRA
COTTA ACCEPTED.

BLDG. PERMIT SIGNED

AND RETURNED 7/17/84

for pool # 59981


*INSTALLER IS RESPONSIBLE FOR OBTAINING FINAL APPROVAL ON THIS PERMIT.

BLDG. PERMIT SIGNED

AND RETURNED 7/17/84

for pool # 59981

17667

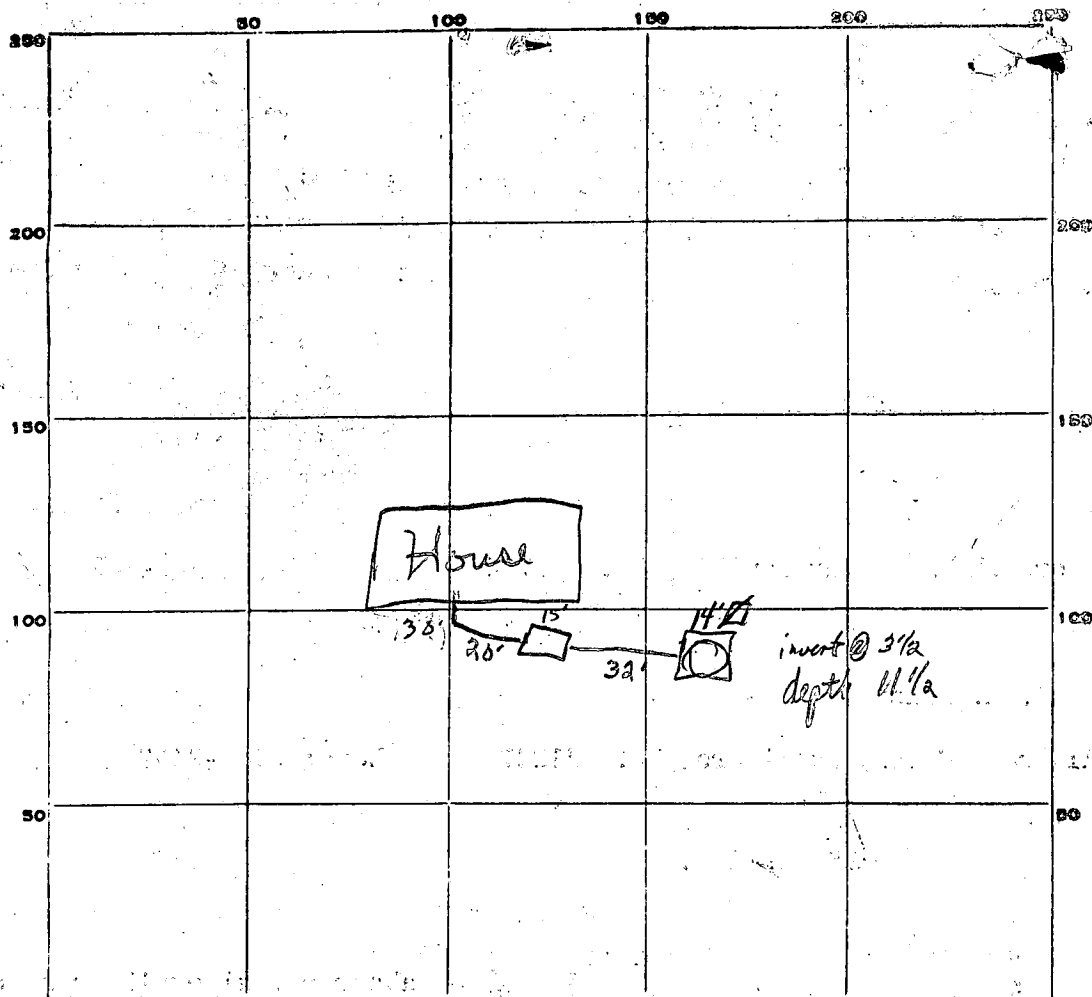

INDICATE NORTH. - NAME ADJOINING ROADWAY AS BASE LINE.

Rt. 97

PERMIT CARD ☒

SEPTIC TANK, LEVEL ☒

CLEANOUTS ST/DW

DISTRIBUTION BOX, LEVEL _____

TILE FIELD, DEPTH _____ FT. TRENCH WIDTH _____ FT.

GRAVEL DEPTH _____ IN. TOTAL LENGTH _____ FT.

NUMBER OF TRENCHES _____ TOTAL BOTTOM AREA _____

SEEPAGE PITS, INSIDE DIAMETER perimeter 56 FT. DEPTH BELOW INLET 8 FT.

ABSORBENT AREA 448 SQ. FT.

REMARKS _____

DATE SYSTEM APPROVED

5/2/78

INSPECTOR

F.S. Oja

APPLICATION

SEWAGE DISPOSAL TESTING

MARYLAND STATE DEPARTMENT OF HEALTH

HOWARD COUNTY

ELLICOTT CITY

DISTRICT 4

DATE 11/22/72

TO: THE COUNTY HEALTH OFFICER
ELLICOTT CITY, MARYLAND

I, HEREBY, APPLY FOR THE NECESSARY TESTS IN ORDER TO CONSTRUCT (OR RECONSTRUCT) A SEWAGE DISPOSAL SYSTEM.

PROPERTY OWNER

THOMAS G. OYSTER

ADDRESS

2419 REGGIE DRIVE

PHONE

PROPERTY LOCATION:

SUBDIVISION

LOT NO.

LOT 2

ROAD AND DESCRIPTION

HANDS MILL RD (R. #97) SOUTH
OF FORSYTHE RD

OCCUPANT

PHONE

PERSON TO CONSTRUCT SYSTEM

ADDRESS

PHONE

SIZE OF LOT

1.0 ACRE.

TYPE BLDG.

4
NUMBER OF BEDROOMS

IF NOT SINGLE RESIDENCE DESCRIBE

SIGNATURE OF APPLICANT

John W. Lewis for Thomas G. Oyster

APPROVED BY

FOR

(KIND OF SYSTEM)

DATE

REJECTED BY

FOR

(KIND OF SYSTEM)


DATE

HOLD PENDING FURTHER TESTS

DATE

REASONS FOR REJECTION OR HOLDING

THIS IS NOT A PERMIT

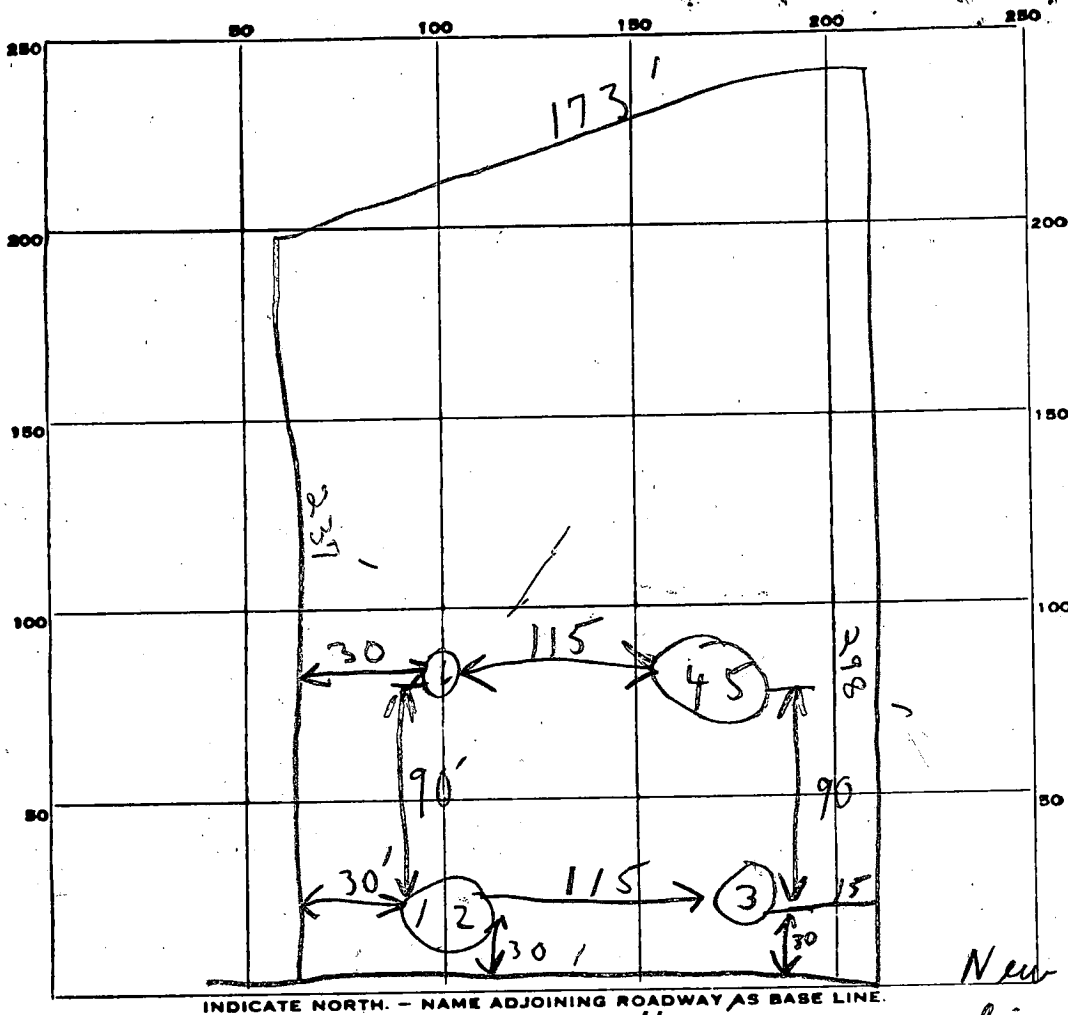

RX 97 162

DATE	TEST NO.	DEPTH	PRE-WET		TEST - 1" DROP		TIME
			START	STOP	START	STOP	
4/29/92	1	11'	10:46	10:48	10:48	10:52	4 min
	2	5' 5"	10:46	10:50	10:50	10:58	8 min
	3	10 1/2'	loose sandy soil				
	4	4'	11:00	11:02	11:02	11:08	6 min
	5	11 1/2'	11:00	11:02	11:02	11:10	8 min
	6	11'	loose sandy soil				

Lot 2

New property line

12

14

26 8 min

erled 4'

SOIL AUGER FINDING

TESTED BY

B.S.

Use 4 & 3

REMARKS

4-14' holes
100ft. apart
on 12' x 12' ft.

APPLICATION

SEWAGE DISPOSAL TESTING

A 17667

P _____

MARYLAND STATE DEPARTMENT OF HEALTH

HOWARD COUNTY

Septic Tank {

1-3 Bedroom - 1000 gallons
4 Bedroom - 1250 gallons

ELLICOTT CITY

DISTRICT 4

DATE 11/22/72

Dry Well to have 125 sq. ft. effective
absorbent sidewall area per bedroom below inlet.
Inlet to be $3\frac{1}{4}'$ below original grade and maximum
depth $11\frac{1}{2}'$. Location 120' from front lot line
& 20' in from right property line when
facing lot from road. (Per hole 4+5)

TO: THE COUNTY HEALTH OFFICER
ELLICOTT CITY, MARYLAND

I, HEREBY, APPLY FOR THE NECESSARY TESTS IN ORDER TO CONSTRUCT (OR RECONSTRUCT) A SEWAGE DISPOSAL SYSTEM.

PROPERTY OWNER

Thomas G. Oyster N.S. Rehe

ADDRESS

2419 REEDIE DRIVE

PHONE

4724 Aldgate Green, Balto. 21227

PROPERTY LOCATION:

#1380 Rt. 97

Phone 242-8407

SUBDIVISION

LOT NO.

LOT 2

ROAD AND DESCRIPTION

HEADS AVE B (Rt. #97) SOUTH

OF FORSYTHE RD 1380 Route 97

OCCUPANT

PHONE

PERSON TO CONSTRUCT SYSTEM

ADDRESS

PHONE

SIZE OF LOT

1.0 ACRE.

TYPE BLDG.

4
NUMBER OF BEDROOMS

IF NOT SINGLE RESIDENCE DESCRIBE

BLDG. PERMIT SIGNED

AND RETURNED 10/27/77

Series No. 33788

SIGNATURE OF APPLICANT

John W. Lewis for Thomas G. Oyster

APPROVED BY

C. Oyster

FOR

Dry Well
(KIND OF SYSTEM)

DATE

8/16/74

REJECTED BY

FOR

(KIND OF SYSTEM)

DATE

HOLD PENDING FURTHER TESTS



DATE

REASONS FOR REJECTION OR HOLDING

THIS IS NOT A PERMIT

Approved:
For private water and private sewer
Blazey MD 2/9/73
Dr. J. BRETT LAZAR
County Health Officer

Approved:
Office of Planning and Zoning
THOMAS G. HARRIS Jr.
Planning Director

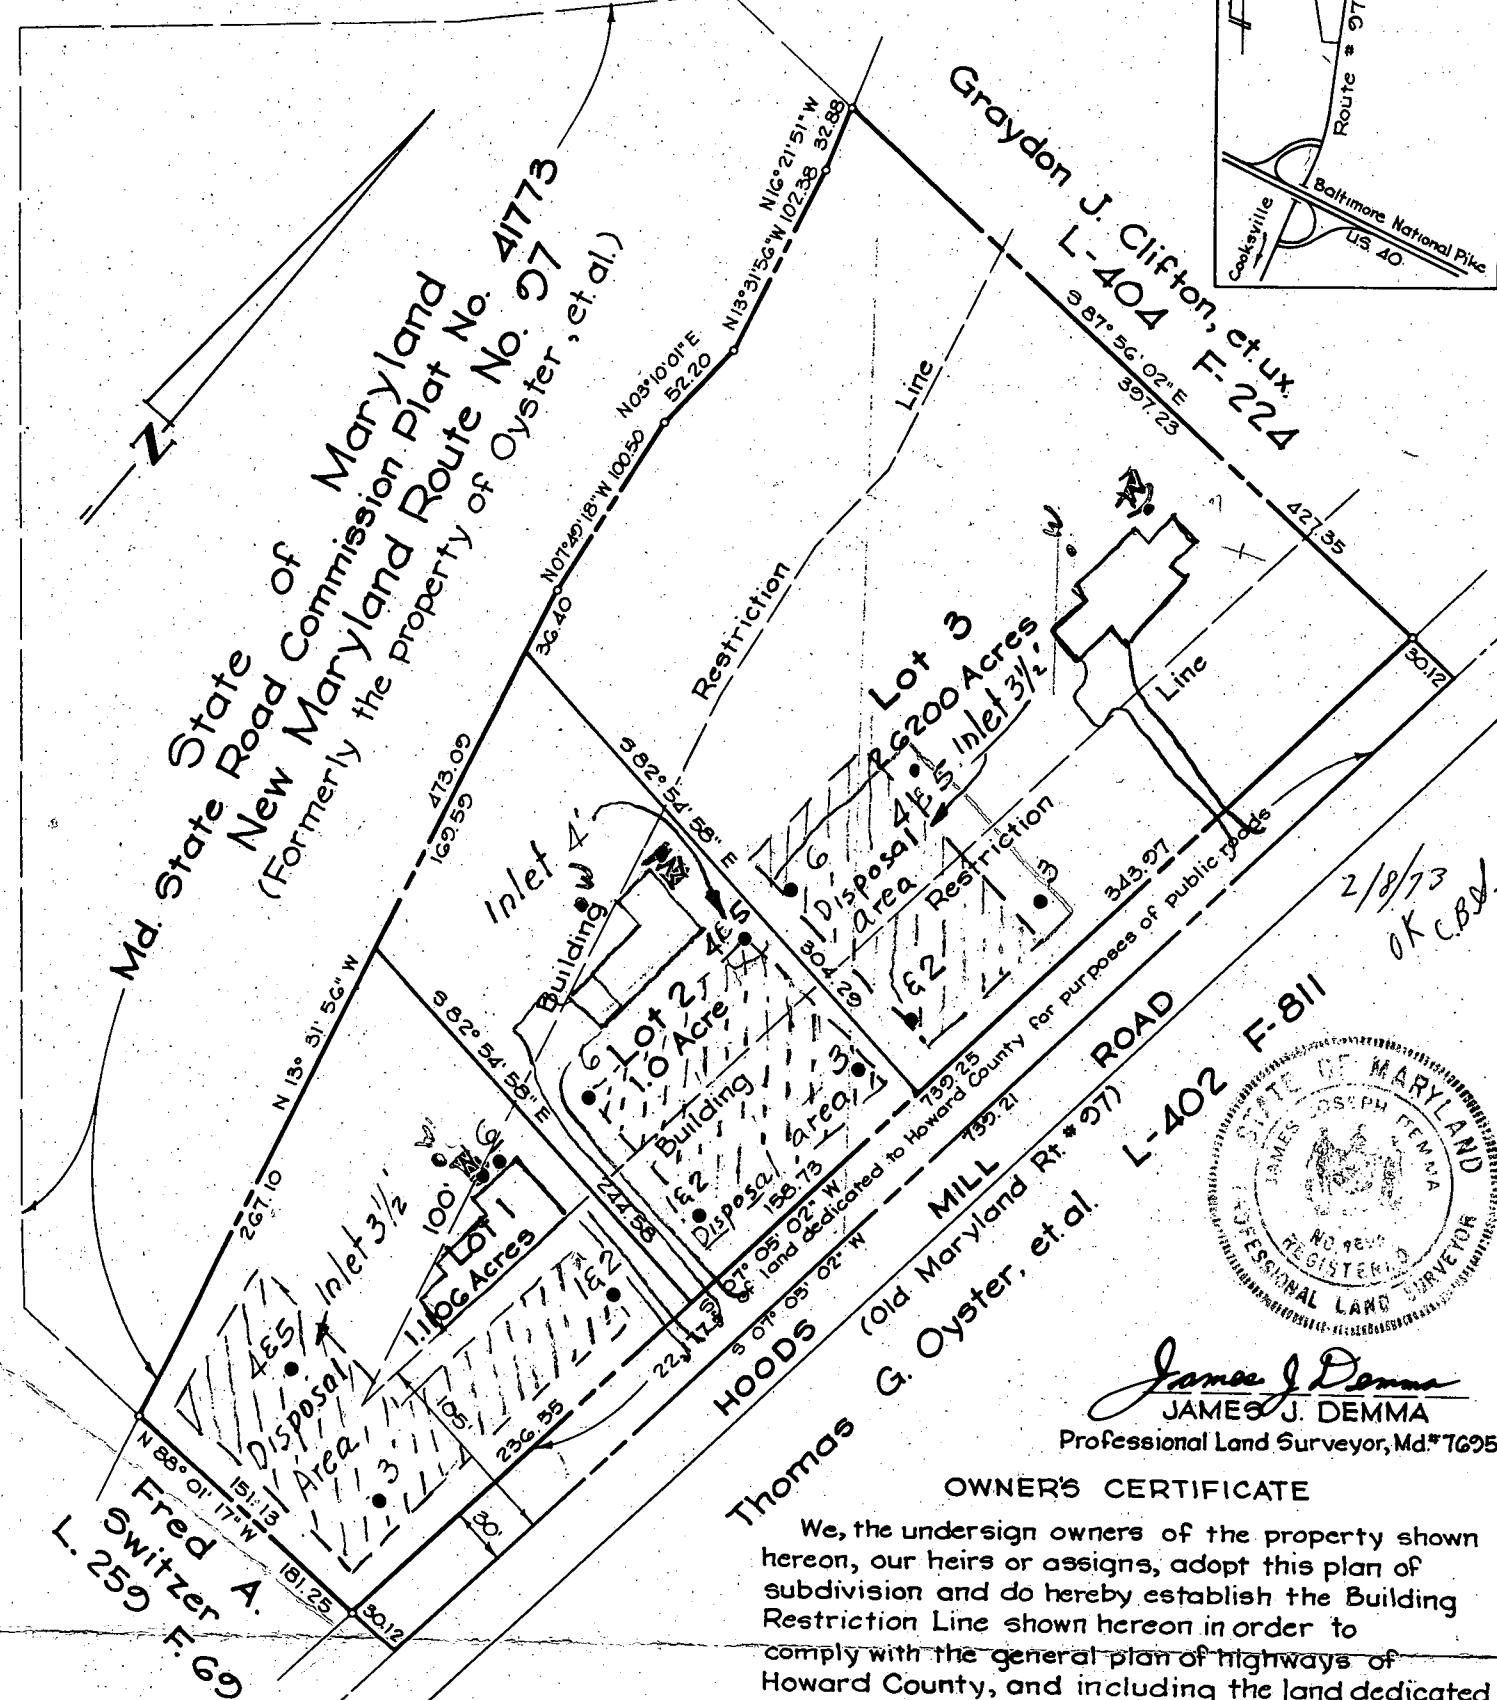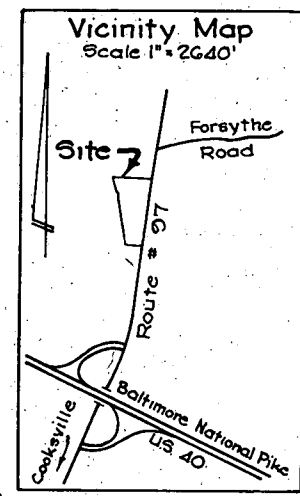

NOTE:
The lots shown hereon comply with minimum ownership width and lot area as required by Maryland State Department of Health Regulations.
Total number of lots - 3
Total area of lots - 4.7306 Acres
Total area of widening - 0.5091 Acre
Property shown hereon located on Tax Map 8
Title reference Liber 445 Folio 619.

Owner:
Thomas G. Oyster, et al.
2415 Reddie Drive
Wheaton, Md. 20902

OWNER'S CERTIFICATE
We, the undersign owners of the property shown hereon, our heirs or assigns, adopt this plan of subdivision and do hereby establish the Building Restriction Line shown hereon in order to comply with the general plan of highways of Howard County, and including the land dedicated hereon for the widening of Route # 97.
Thomas G. Oyster *Glenn Dye*
Thomas G. Oyster Glenn Dye
Dorothy D. Oyster *Percy E. Dye*
Dorothy D. Oyster Percy E. Dye



Oyster, et al. Property
4th Election District - Howard County - Maryland
Scale 1" = 100'
November, 1972

Oyster, Imus & Associates, Inc.
Civil Engineers • Land Planners • Land Surveyors
2415 Reddie Drive • Wheaton, Maryland • 20902
REV 2/7/73 REV 1/31/73 REV 11/29/72 1701 A-1



James J. Demma
JAMES J. DEMMA
Professional Land Surveyor, Md. #7695

M. Dick Reck
 Lot #2 Hawk Mill Rd
 Permit # 33788

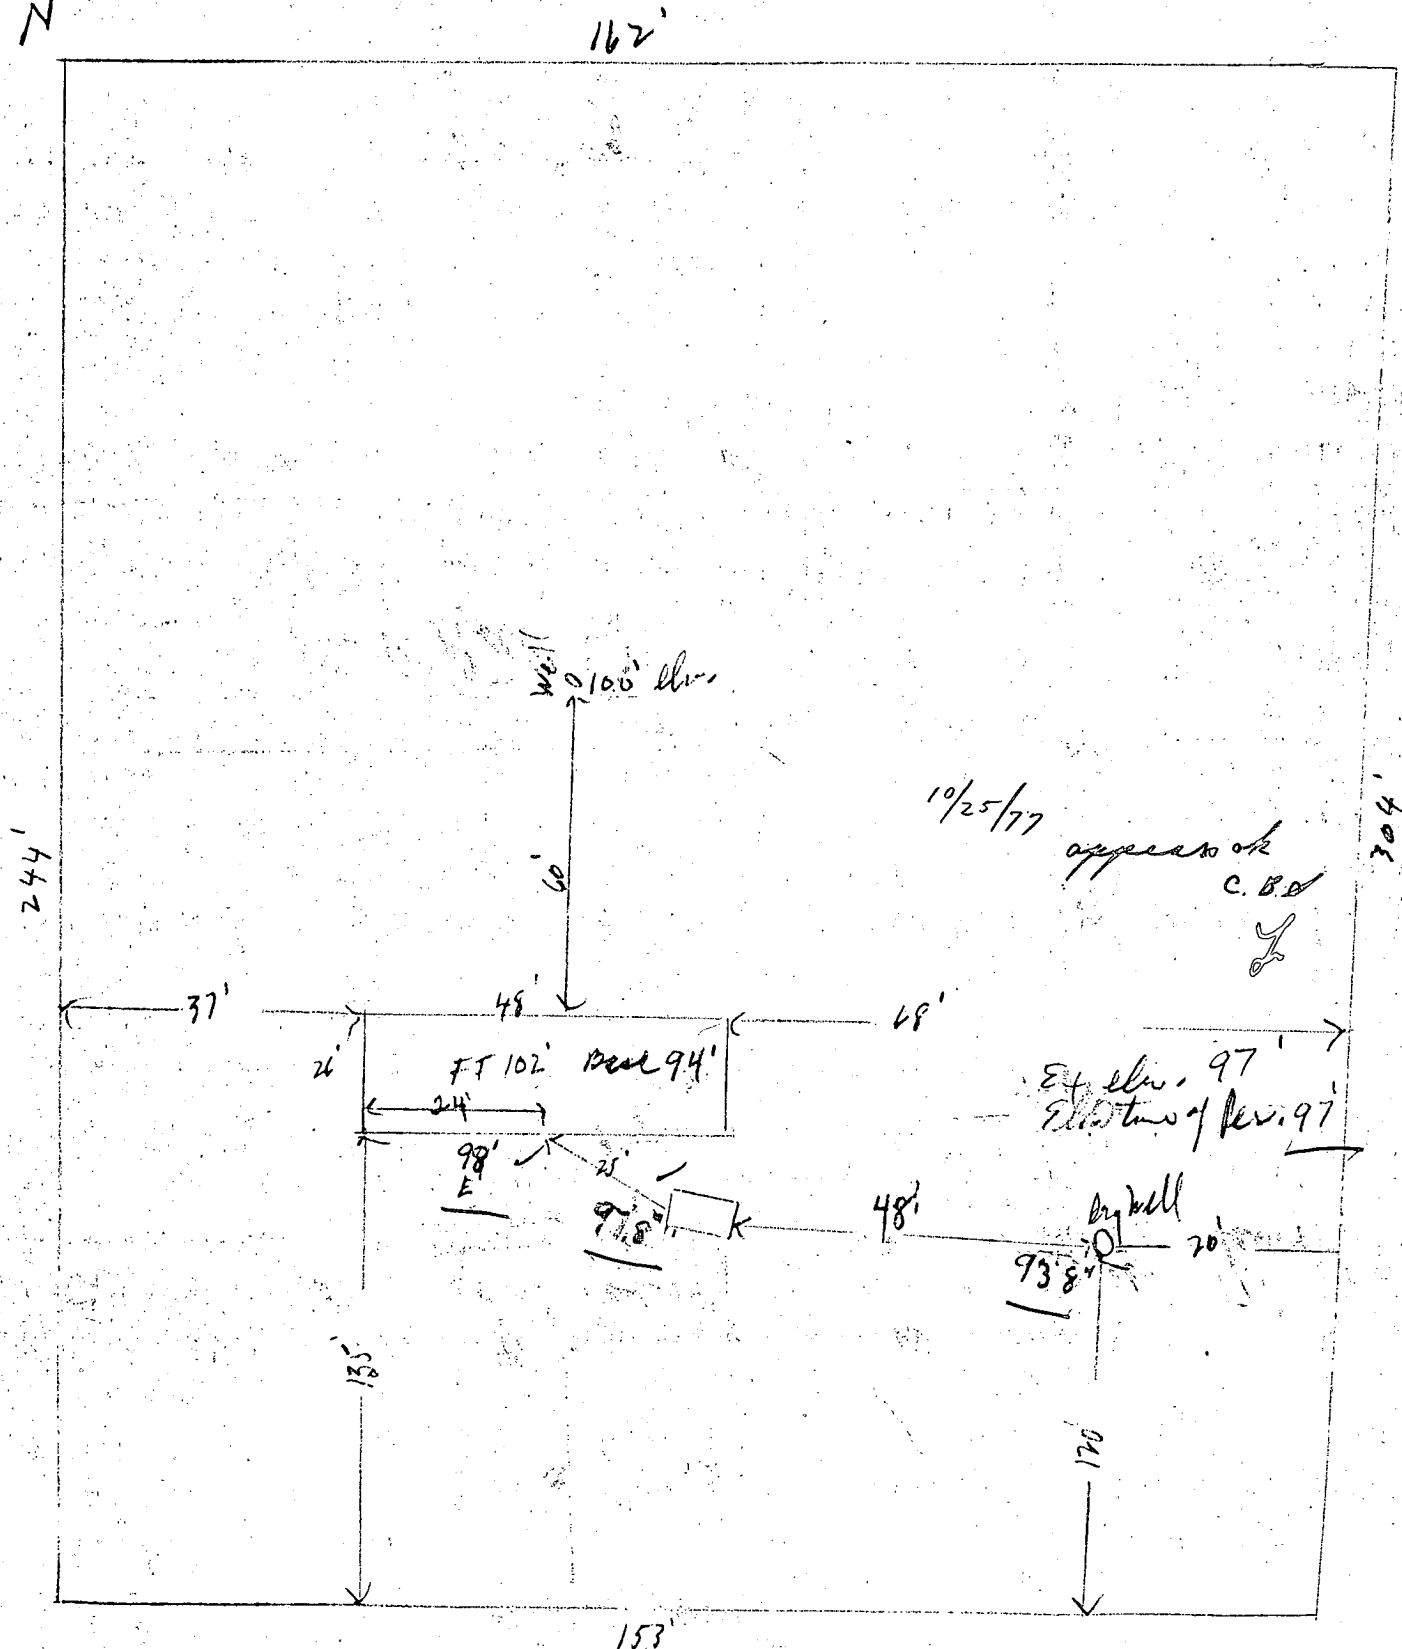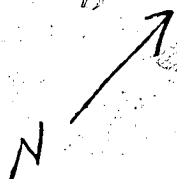

Hawk Mill Rd

I certify that the above information is correct
 D. T. Korman

