

7-29-91
3:30 pm cancelled
due to rain
7-30-91
8/26/91 WPT
2:00 pm

8/26/91 WPT NO 1-5 P.
1 ax ID- ?

PERMIT

SEWAGE DISPOSAL SYSTEM

MARYLAND STATE DEPARTMENT OF HEALTH

P 47329

A 45289

HOWARD COUNTY

BUREAU OF ENVIRONMENTAL HEALTH

461-9933

INDEXED

DISTRICT

DATE

DATE SYSTEM APPROVED

INSPECTOR

K & K Excavating

IS PERMITTED TO INSTALL ☒ ALTER

ADDRESS 14960 Frederick Road, Woodbine, Md. 21797

PHONE 442-1336

SUBDIVISION Dennis B. Malcolm Property ROAD 12044 Scaggsville Road LOT 2

PROPERTY OWNER Mr. Kimber Burley

ADDRESS

GARBAGE GRINDER IS USED INCREASE SEPTIC TANK CAPACITY BY 100% AND ABSORPTION AREA BY 50% XXX

GARBAGE GRINDER XXX YES XXXXXXXXXXXXXXXX

SEPTIC TANK CAPACITY 1250 GALLONS

NUMBER OF BEDROOMS 4

240' TRENCH

TRENCHES - 180 sq. ft. per bedroom. Trench to be 3 feet wide. Inlet 3 feet below original grade. Bottom maximum depth 5 feet below original grade. Effective area begins at 3 feet below original grade. 2 feet of stone below distribution pipe.

LOCATION - Place the distribution box 560' from lot line that borders Pindell School Rd. and 85' from the north lot line. Run trenches along contour toward the north lot line.

NOTE - No trench to exceed 100 feet in length. Provide 6" - 8" diameter cleanout and cap to grade or above on septic tank. 7-27-90 JEN

PLANS APPROVED BY

Craig Williams

cm

DATE 03/30/90

COVER NO WORK UNTIL INSPECTED AND APPROVED

NEITHER THE HOWARD COUNTY COUNCIL NOR THE HEALTH DEPARTMENT IS RESPONSIBLE FOR THE SUCCESSFUL OPERATION OF ANY SYSTEM.

NOTE: CLEANOUT REQUIRED EVERY 70 FEET OF SEWER LINE AND/OR AT 90° SWEEPS IN LINES FROM HOUSE TO DRAIN FIELDS

NOTE: ALL PARTS OF SEPTIC SYSTEMS (I.E. TANK, DISTRIBUTION BOX, TRENCHES) TO BE 100 FEET FROM WELL (UNLESS OTHERWISE SPECIFICALLY AUTHORIZED)

NOTE: IF DEEP TRENCH(ES) ARE USED CALL FOR INSPECTION BEFORE AND AFTER PLACING GRAVEL IN TRENCH(ES)

NOTE: NO DRY WELL SHALL EXCEED 15 FOOT IN DIAMETER, NO ABSORPTION TRENCH TO EXCEED 100 FEET IN LENGTH

NOTE: ALL PIPE FROM HOUSE TO SEPTIC TANK MUST BE CAST IRON OR SCHEDULE 40 PVC OR ABS

PERMIT VOID AFTER TWO YEARS


NOTE: INSTALL STAND PIPE ON SEPTIC TANK AND DRY WELL. STAND PIPES MUST BE 6 INCHES IN DIAMETER - CAST IRON, CONCRETE OR TERRA COTTA OR PVC OR ABS ACCEPTED. IF TOP OF SEPTIC TANK IS DEEPER THAN 3 FEET, MANHOLE TO GRADE REQUIRED

NOTE: DISTRIBUTION BOXES MUST HAVE BAFFLES

*INSTALLER IS RESPONSIBLE FOR OBTAINING FINAL APPROVAL ON THIS PERMIT.

*CALL 461-9933 FOR INSPECTION OF SEPTIC SYSTEMS.

A 45289

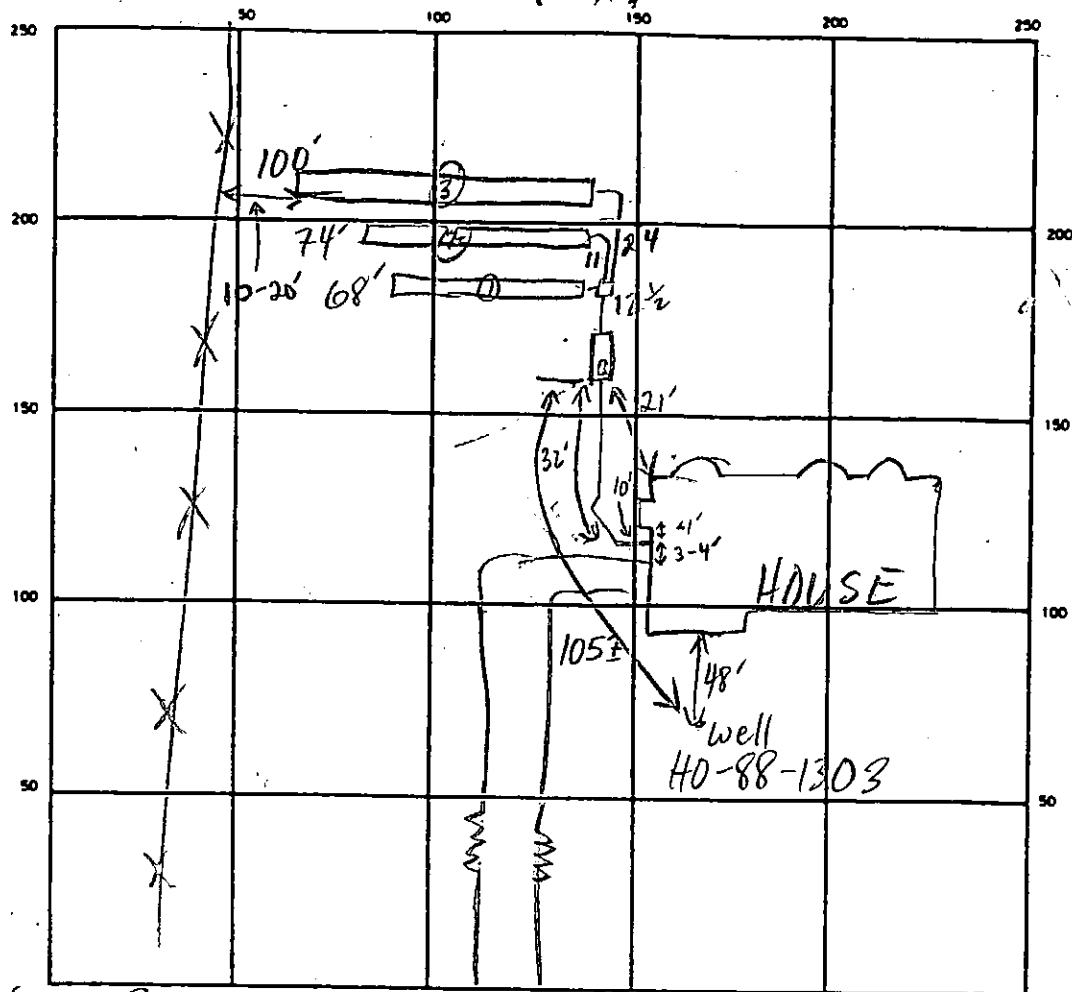

Rt- 216

INDICATE NORTH - NAME ADJOINING ROADWAY AS BASE LINE

SEPTIC TANK. LEVEL 2000 GAL - OK CLEANOUTS OK

DISTRIBUTION BOX. LEVEL OK - BAFFLE IN

DRAIN FIELD/TILE FIELD. DEPTH 556 FT. TRENCH WIDTH 3 FT. INLET DEPTH 3-4 FT.

EFFECTIVE GRAVEL DEPTH 2± FT. TOTAL LENGTH 068 074 0100 FT.
NUMBER OF TRENCHES 3 ONE SIDEWALL/BOTTOM AREA 0204 0222 0300 SQ. FT.

DRYWELL INSIDE DIAMETER FT. EFFECTIVE DEPTH BELOW INLET FT.

ABSORBENT AREA 726 SQ. FT.

REMARKS 7/30/91 OK TO FINISH & COVER MR

DATE SYSTEM APPROVED

7/30/91

INSPECTOR

M. Rifkin

12/12/89
10:00

APPLICATION

PERCOLATION TESTING

A 45289

P _____

HOWARD COUNTY HEALTH DEPARTMENT
BUREAU OF ENVIRONMENTAL HEALTH
P.O. BOX 476 ELLICOTT CITY, MARYLAND 21043
TELEPHONE 461-9933

11-28-89

Preview ok. 1 A lot.
Farmland Preservation
DEN

DISTRICT _____

DATE 11/27/89

TO: THE COUNTY HEALTH OFFICER
ELLICOTT CITY, MARYLAND

I HEREBY APPLY FOR THE NECESSARY TEST IN ORDER TO CONSTRUCT (OR RECONSTRUCT) A SEWAGE DISPOSAL SYSTEM.

PROPERTY OWNER DENNIS B MALCOLM

ADDRESS 2001 BRIGGS CHANEY RD, S.S. MD 20904 PHONE 284-9172

PROSPECTIVE BUYER KIMBER + DIANE BURLEY

ADDRESS 12402 FELDON ST., WHEATON, MD, 20906 PHONE (301) 933-6592

PROPERTY LOCATION: MALCOLM PROPERTY

SUBDIVISION _____ LOT NO. 2 Tenant House

ROAD AND DESCRIPTION RT. 216 (Scaggsville Rd.) and PINDELL SCHOOL RD.

TAX MAP 41 PARCEL # 67

SIZE OF LOT 53.3174 Acres TYPE BLDG SFD
(SINGLE FAMILY DWELLING OR COMMERCIAL)

THE SYSTEM INSTALLED UNDER THIS APPLICATION IS ACCEPTABLE ONLY UNTIL PUBLIC FACILITIES BECOME AVAILABLE. I FULLY UNDERSTAND THE FEE CONNECTED WITH THE FILING OF THIS PERC. TEST APPLICATION IS NON-REFUNDABLE UNDER ANY CIRCUMSTANCES. I ALSO AGREE TO COMPLY WITH ALL M.O.S.H.A. REQUIREMENTS IN TESTING THIS LOT.

(SIGNATURE OF APPLICANT)

APPROVED BY _____ FOR _____ DATE _____

REJECTED BY _____ FOR _____ DATE _____

HOLD PENDING FURTHER TESTS Hold for wet season testing DATE 12-12-89 DEN

REASONS FOR REJECTION OR HOLDING 2/27/90 WET SEASON TEST OK FOR

SHALLOW DRAIN FIELD RTH

BLDG. PERMIT SIGNED
AND RETURNED 1/10/90

Serial #33687-
Tenant House - 2 car garage

HD-216

THIS IS NOT A PERMIT

A 45289

①
SOIL PROFILE

0-4.5 Rd-br si
cl 1m
4.5-12.0 Rd-br
sa si
1m some
broken
rock 45%
12.0 Bottom

④

0-5.5 Rd-br si
cl 1m
5.5-8.5 Rd-br sa
si 1m
Water
at 7.5 ft
8.5 Bottom


② ⑥

10-5.5 Rd-br si
cl 1m
5.5-12.5 Rd-yellow
sa si 1m
12.5 Bottom

⑦

YELLOW
BROWN CLAY

PINK
BROWN
SAND
CLAY

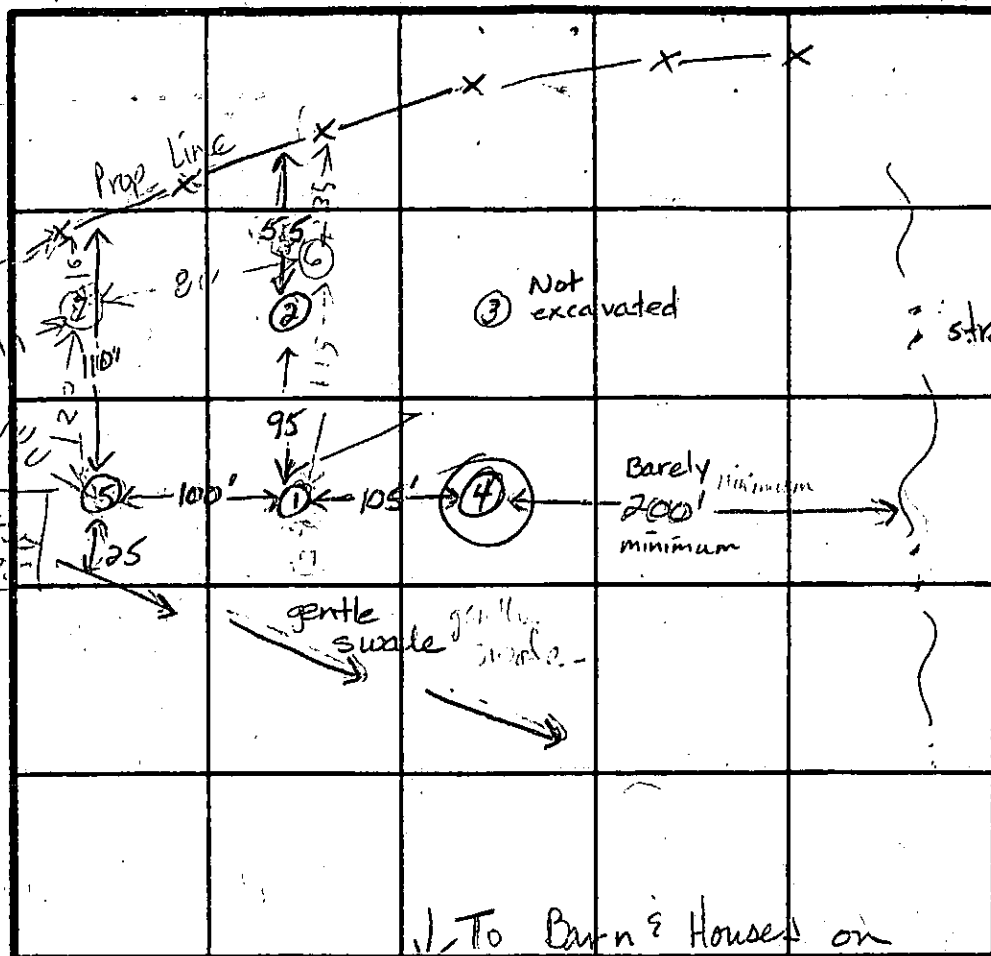

INDICATE NORTH - NAME ADJOINING ROADWAY AS BASE LINE.

Rt - 216

DATE	TEST NO.	DEPTH	PRE-WET		TEST - 1" DROP		TIME
			START	STOP	START	STOP	
12/27/89	1	4.6 S 26.0 M	11:05	11:26	1/2 inch	slow	4 min
		12.0 D	Bottom	(see profile)		for	Hold wet
	④	8.5" V	Water	at 7.5 ft			1 season Failed
	2	6.0' S 12.5 D	11:45	11:50	11:50	11:55	Smiling
		5.0 S	Bottom	(see profile)			Hold for wet season
	5	13.0 D	12:14	12:16	12:16	12:18	2 min OK
2/27/90	6	14	WATER	13	F7		
	1 M	5	115	1117	1117	1120	3
	REDUG	13 1/2	WATER	13 FT			
	7 D	7	1127	1128	1128	1129	11
	4 S	4	1137	1138	1138	1140	2
	TV	13 1/2	OK				

REMARKS

Holes must be held for wet season testing.

TYPE OF SOIL

0-5 Rd-br si cl 1m, 5-12.5 Rd-yellow sa si 1m, 45% rx

TESTED BY

Jane Nadeau

ALSO PRESENT

K. Burley

R 11/27/89

K BURLEY
LEON BURLEY

Leon

⑤

0-5.5 Rd si cl
1m

5.5-13.0 Rd sa
si 1m,
little
decomp
rx
45%
13.0 Bottom

13.0 Bottom

Priden
streetDeadend
off
Pridell
School RdX
Smiling
Hold for wet
seasonINLET
3 FTBOTTOM
5 FT2 FT
SOME

3 MIN

190 out
ph BR

rx

IND RTE 26]

ROAD


660.00'

N 1° 41' 23" W

528.00'

S 22° 03' 38" W

HOWARD CO. DATUM

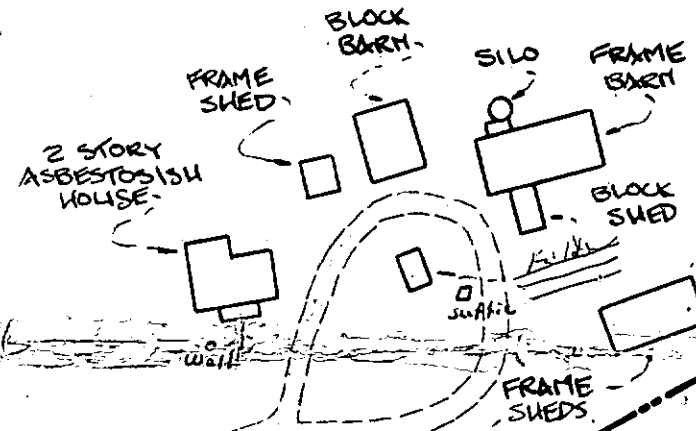

CHURCH

Contract Contingent
Howard County Health Department upon well


To: Inspector

Look For gravel drive
at red mailbox ^{OR 12/24} 12/28 ^{Rt.} 216
follow gravel to "P" & bear
right onto dirt road, then
bear quick Left ~600'
straight back along fence

From: MR E



Date: _____

HD-170

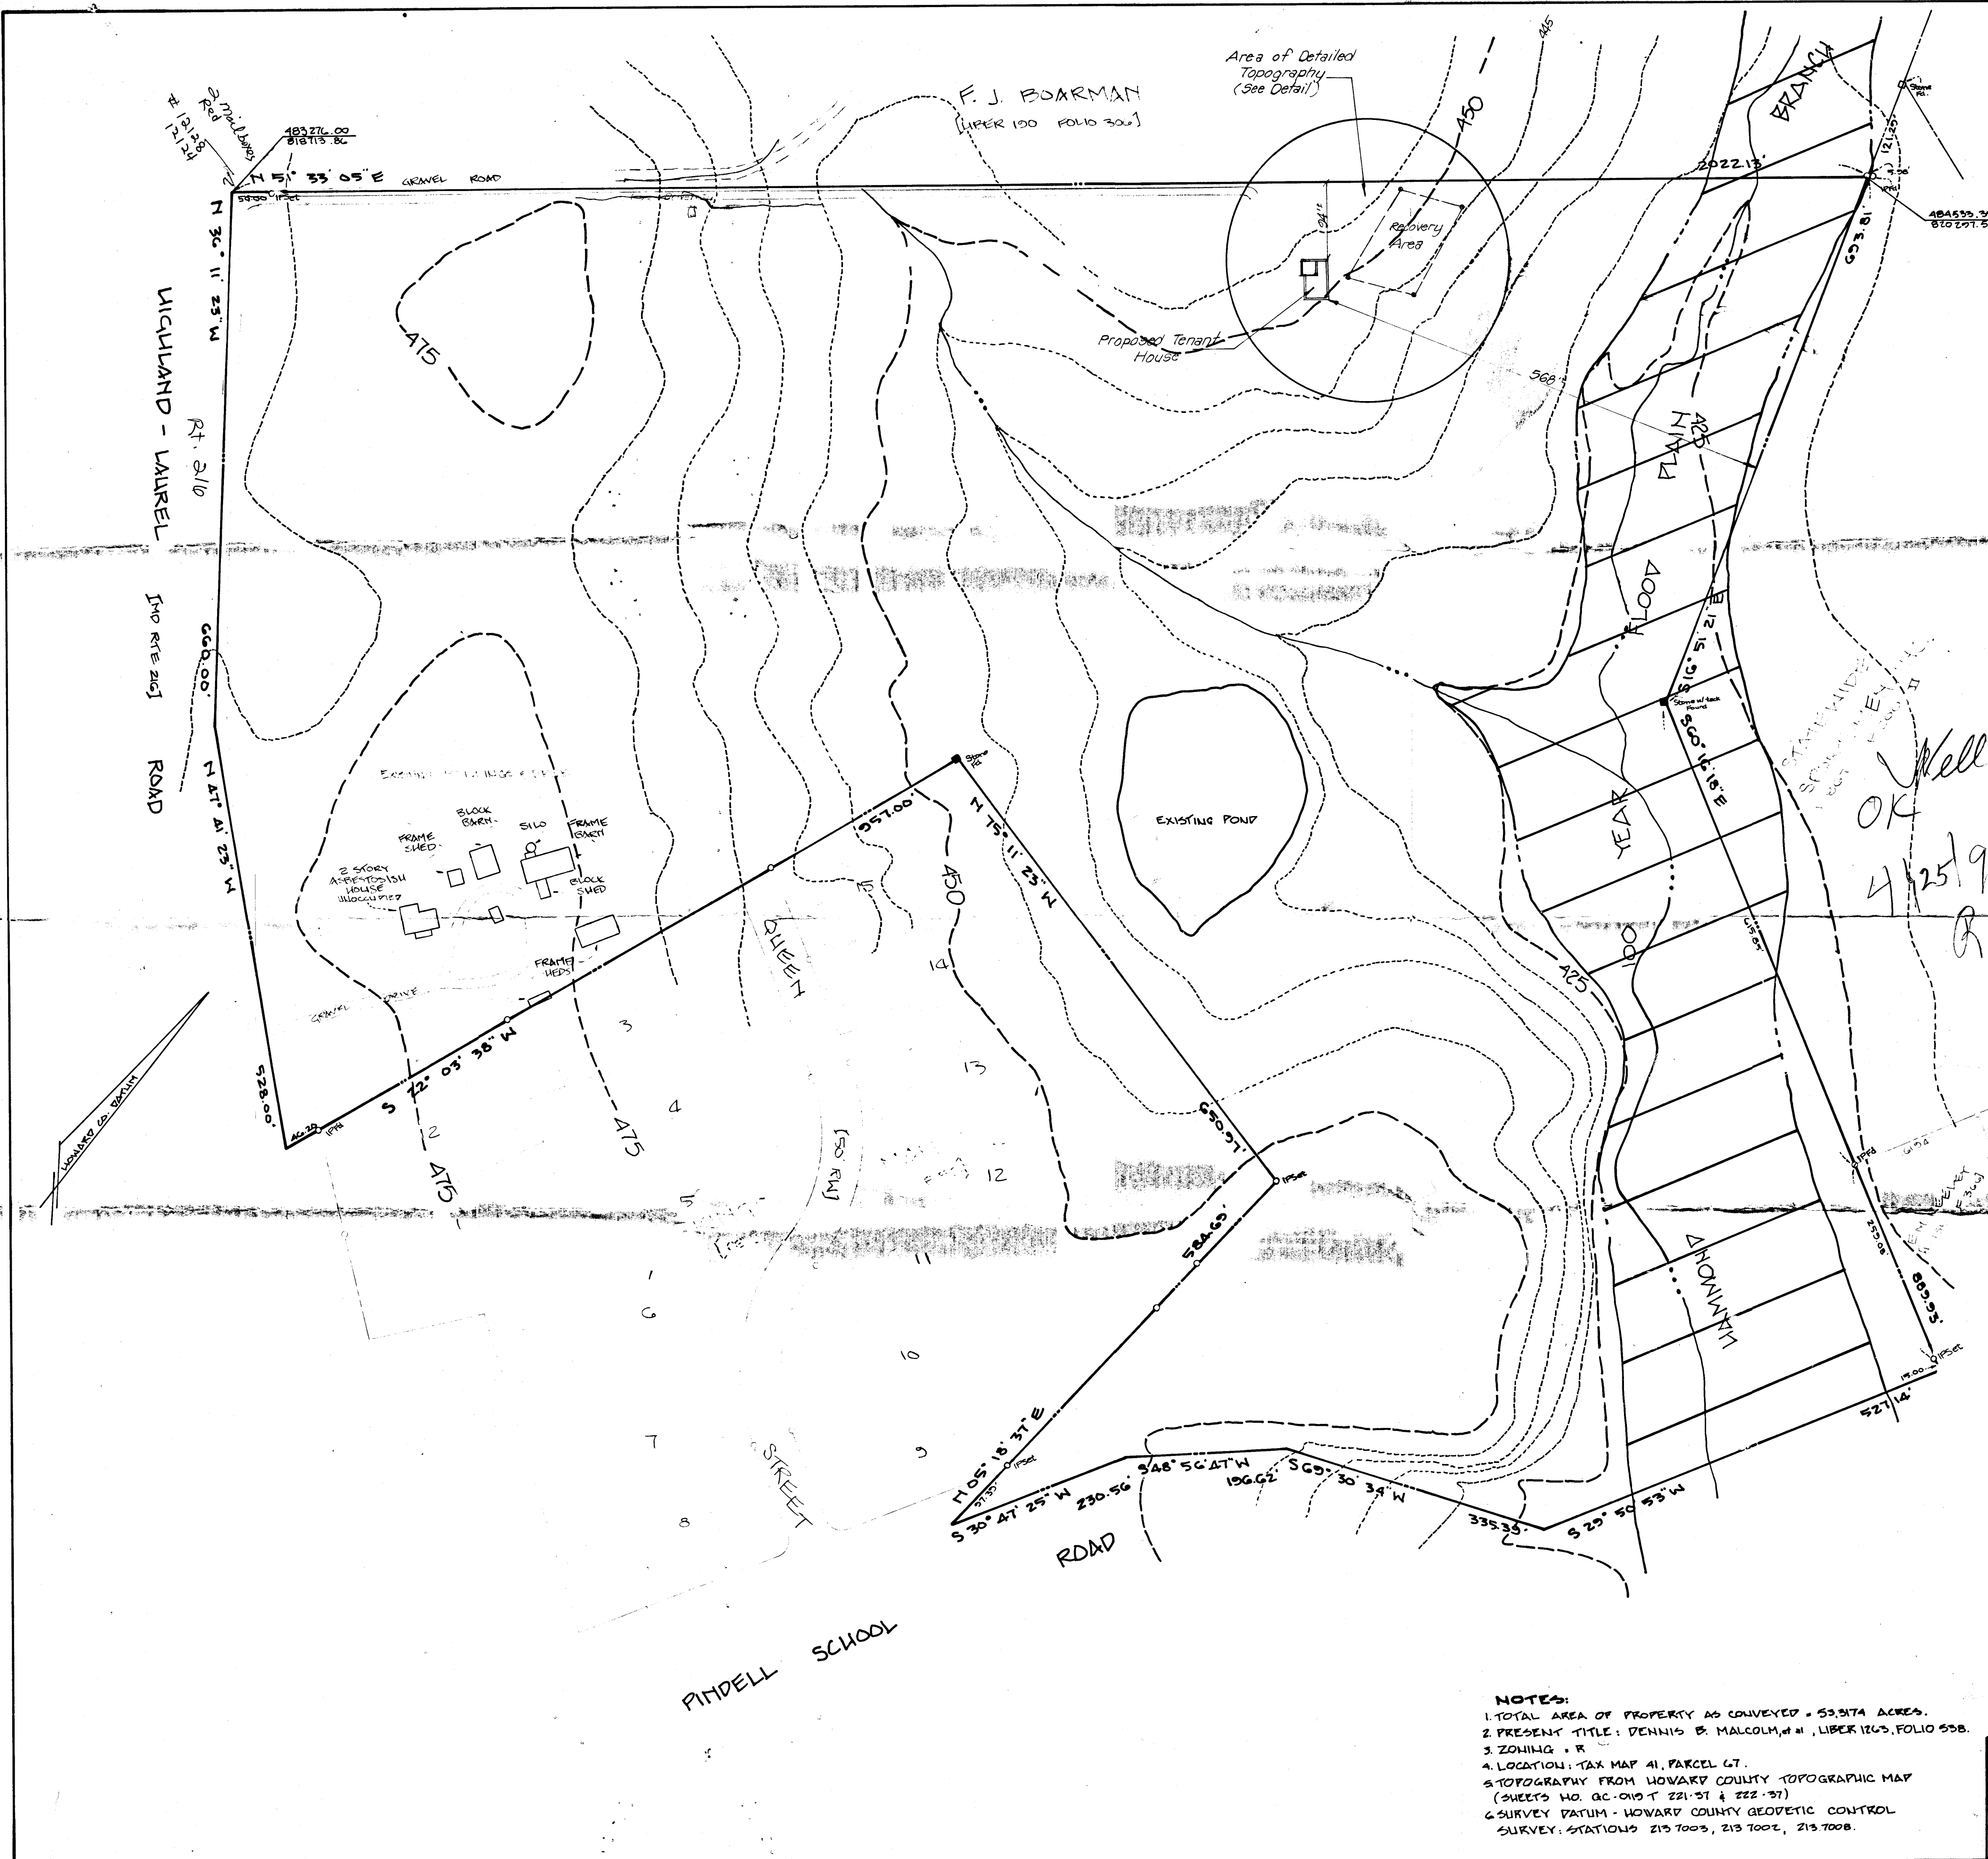

Elevations Required	
Basement elevation	449.5
First floor elevation	450.5
Invert out of house	454.23
Invert into septic tank	453.27
Invert out of septic tank	453.23
Invert into distribution box	452.8
Invert into trench(s)	452.8
Existing grade at septic tank	454.2
Existing grade at distribution box	453.5
Existing grade at trench(s)	453.52
Elevation of well at grade	457.23

NOTE: Length and detail of trenches to be determined by Howard County Health Department.

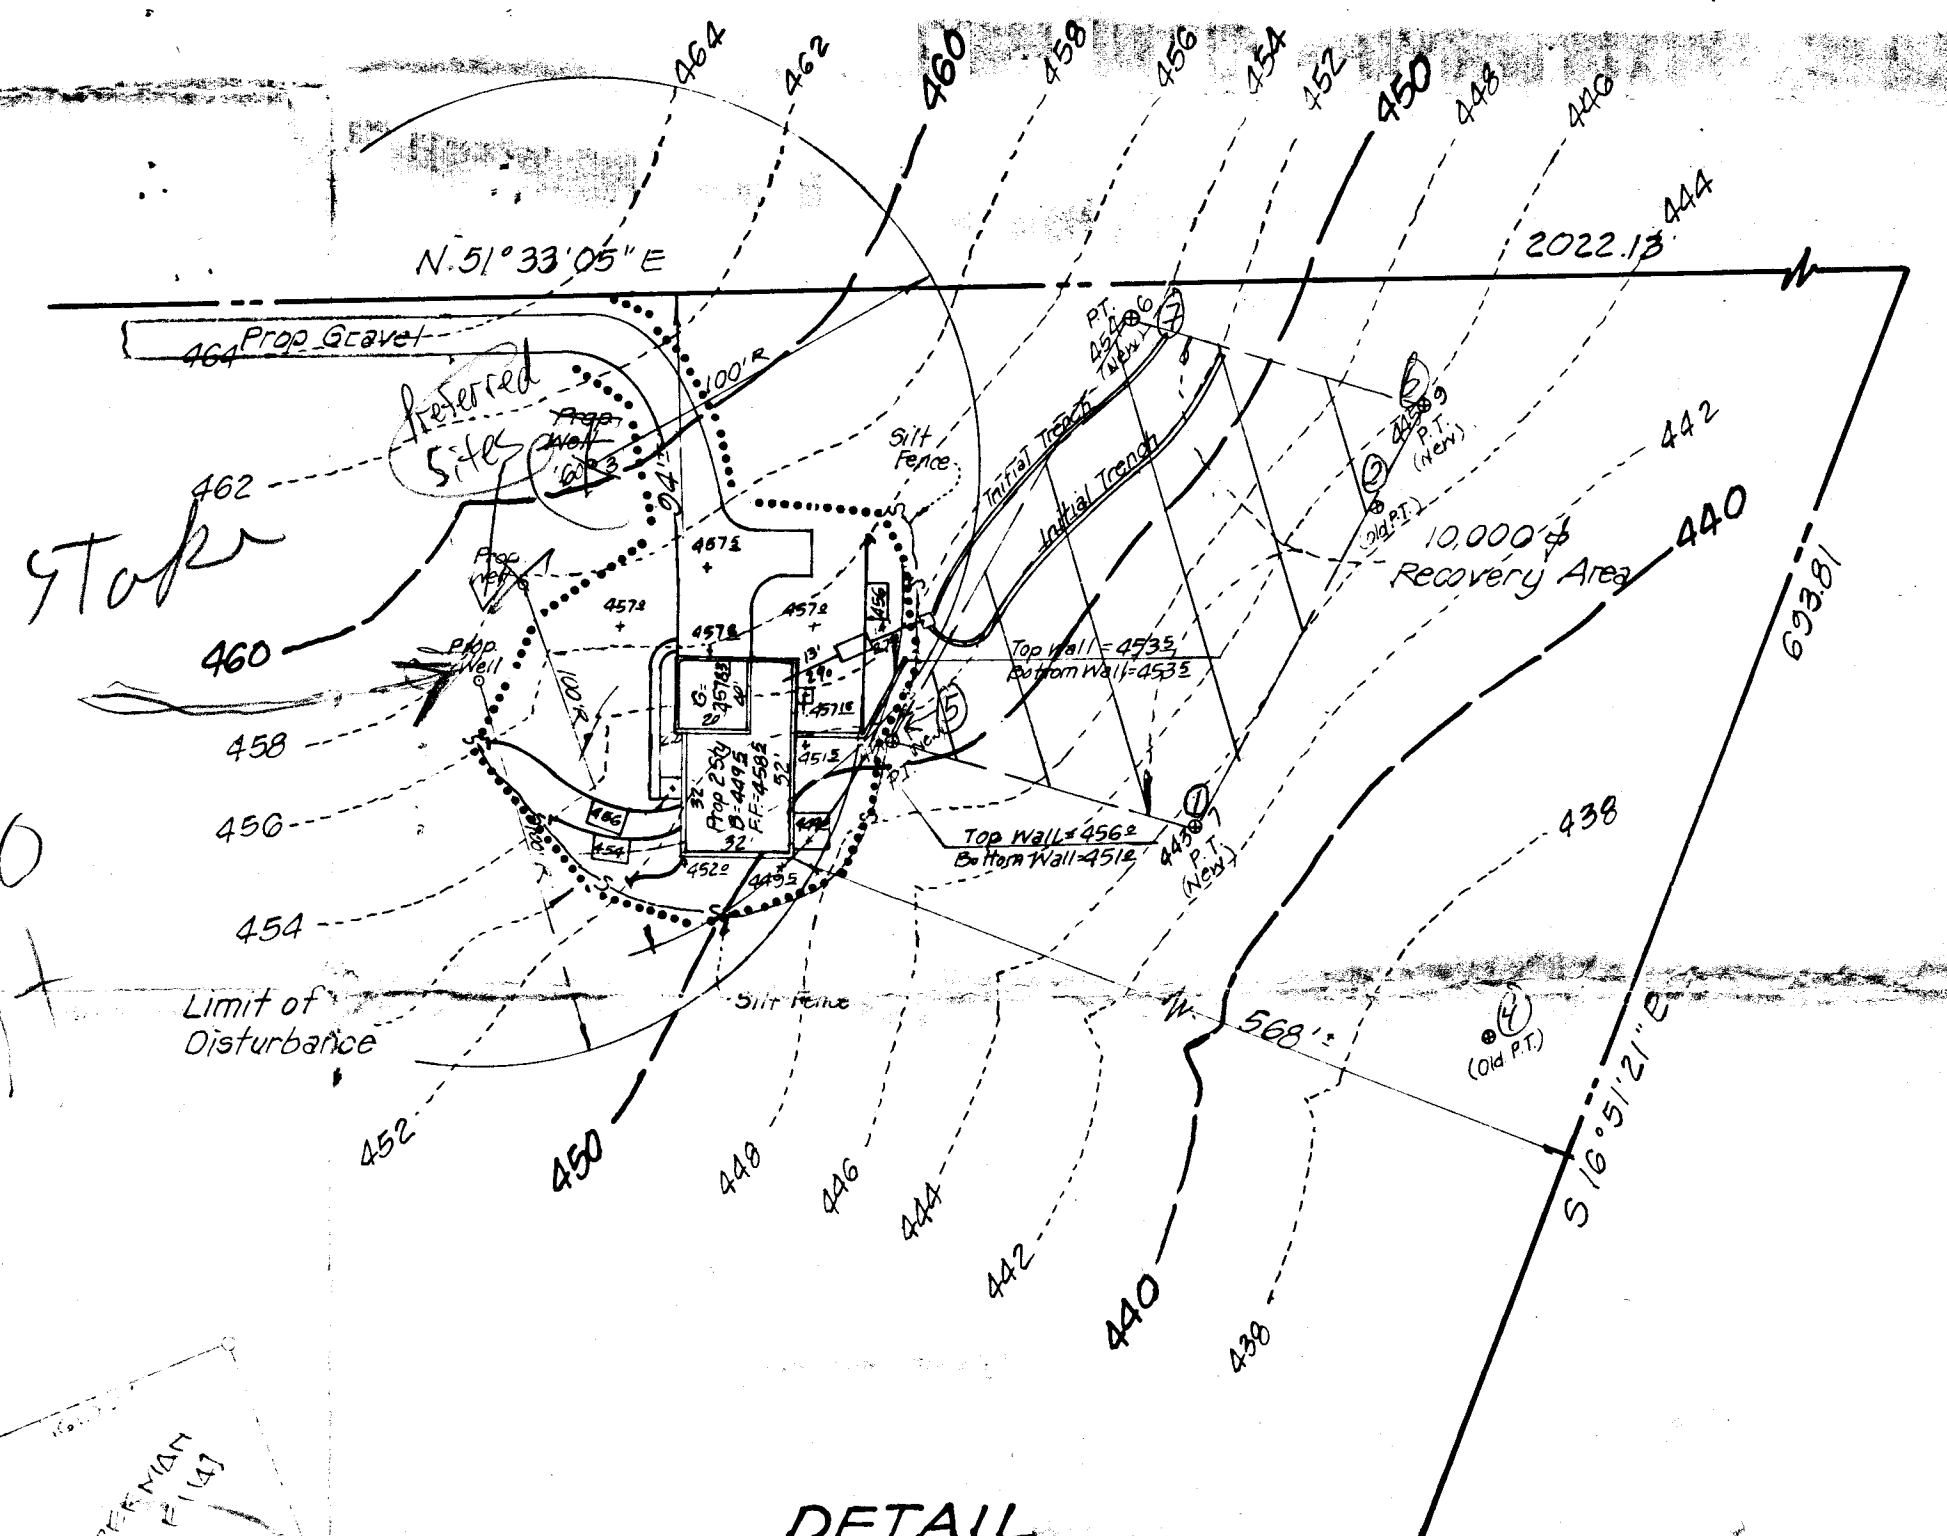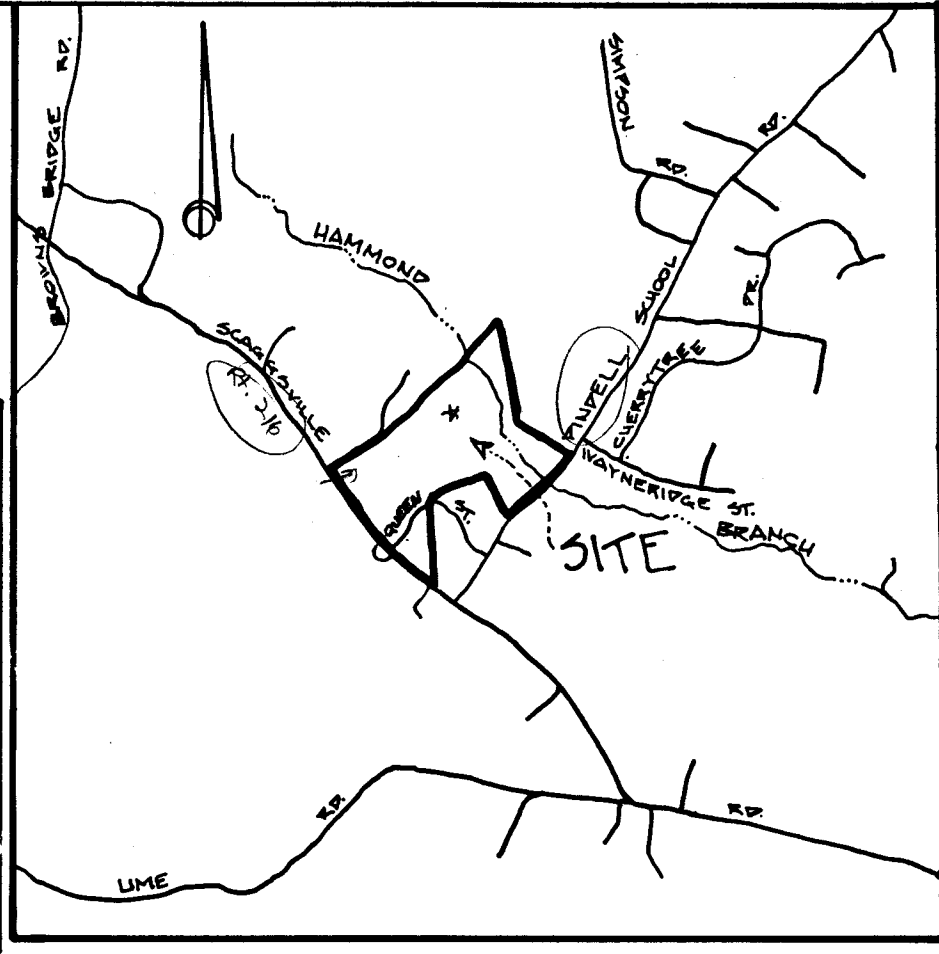

DETAIL
Scale: 1" = 50'

This area designates a private sewage easement of 10,000 sq ft as required by the Maryland State Department of Health and Mental Hygiene for individual sewage disposal. Improvements of any nature in this area are restricted until public sewage is available. These easements shall become null and void upon connection to a public sewage system. The County Health Officer shall have the authority to grant variances for encroachments into private sewage easement. Recordation of a modified sewage easement shall not be necessary.

Rev. Show detail top. site plan for tenant house 3/16/90 227-50
Rev. Move driveway and old park lot

SURVEYOR'S CERTIFICATE

I hereby certify that I have carefully surveyed the property as shown hereon in accordance with recorded descriptions, that corners are as shown and that there are no other encroachments except as indicated.

7-5-84
Date

NEERSON BOOK, JR.
Registered Professional Surveyor
Maryland #8144


PLAN OF SURVEY
MALCOLM PROPERTY
MARYLAND RIE 216 AT PINDELL SCHOOL ROAD
CLARKSVILLE DISTRICT
HOWARD COUNTY, MD.

DESIGNED BY	SCALE 1" = 100'	DATE	5-11-84	PHONE	422-6080
DRAWN BY	Light, Elliott, & Associates				
APPROVED BY	ENGINEERS - PLANNERS - SURVEYORS				
8508 ADELPHI ROAD - ADELPHI MARYLAND 20783				JOB NO. MD-403	
151-44				FILE NO. LS-1761	

- NOTES:**
1. TOTAL AREA OF PROPERTY AS CONVEYED - 53.9174 ACRES.
 2. PRESENT TITLE: DENNIS E. MALCOLM, JR., LIBER 1263, FOLIO 558.
 3. ZONING - R
 4. LOCATION: TAX MAP 41, PARCEL G7.
 5. TOPOGRAPHY FROM HOWARD COUNTY TOPOGRAPHIC MAP (SHEETS NO. GC-0105 T 221-31 & 222-37)
 6. SURVEY DATUM - HOWARD COUNTY GEODETIC CONTROL SURVEY: STATIONS 213 7003, 213 7002, 213 7008.



APPROVED: For private water and private sewage systems, Howard County Department.

Joyce M. Boyd, Under 4/3/90
Howard County Health Officer, c.w. Date

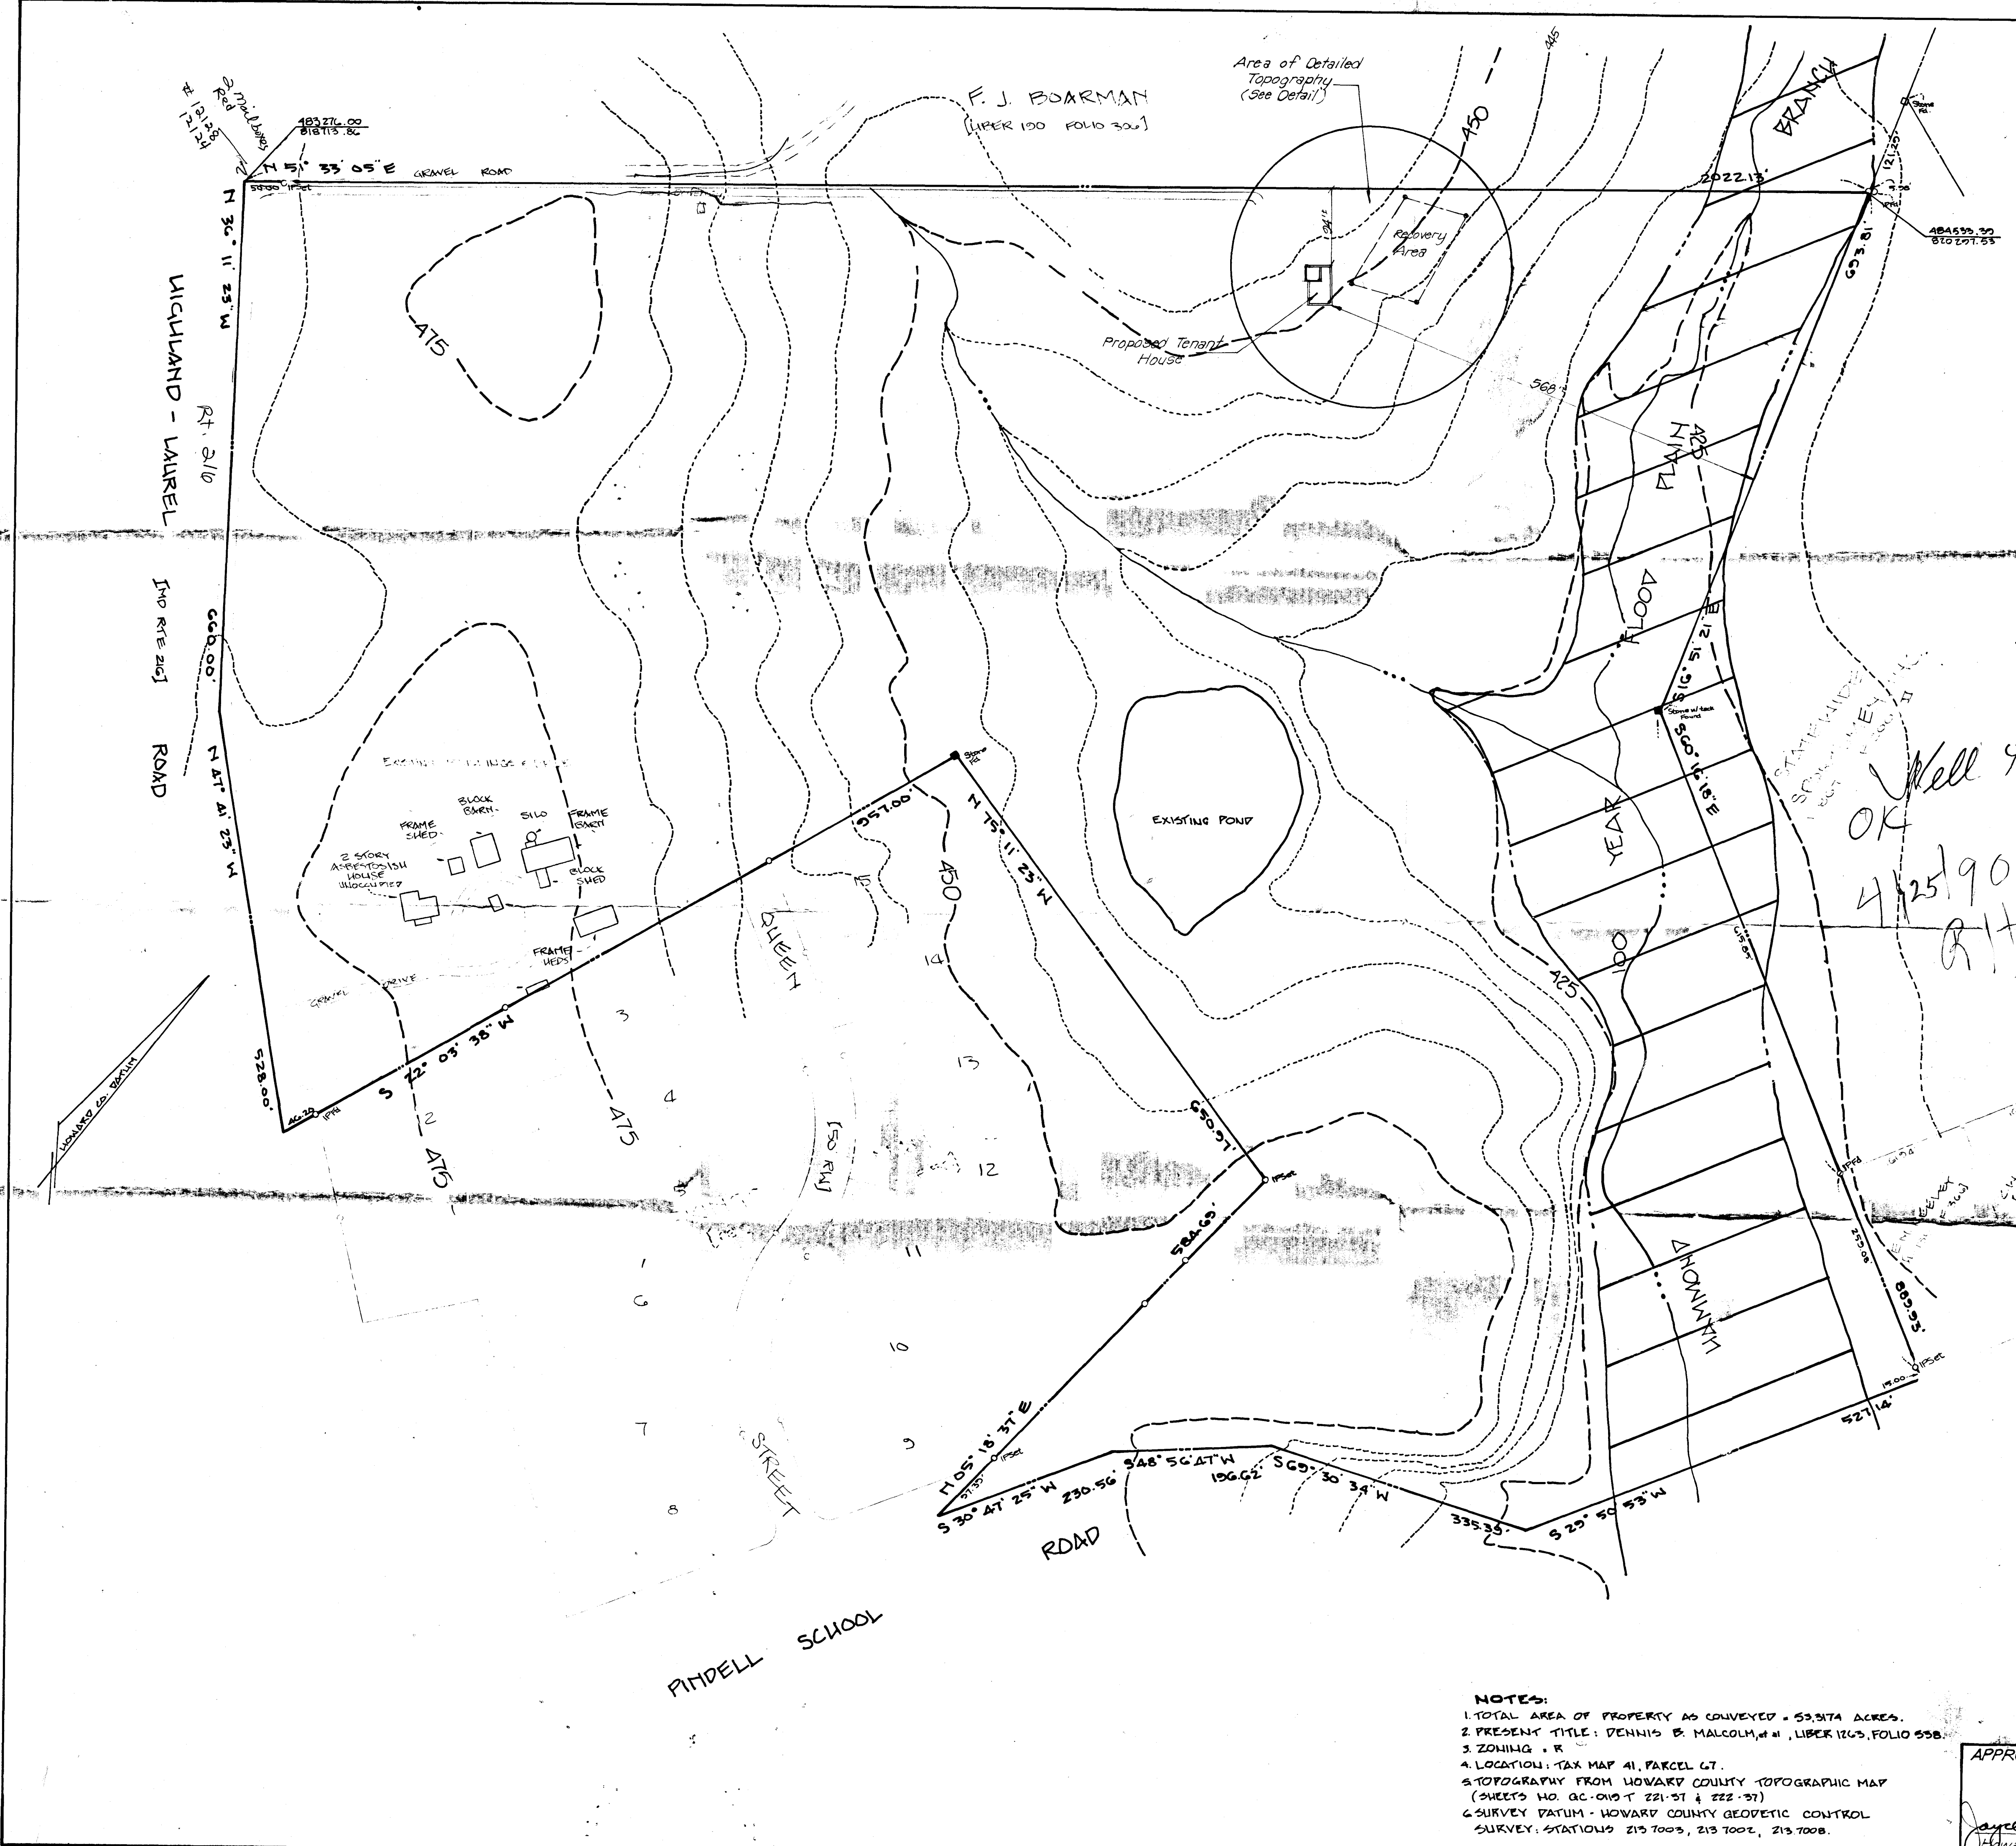

Elevations Required	
Basement elevation	449.5
First floor elevation	450.5
Invert out of house	454.2
Invert into septic tank	453.27
Invert out of septic tank	453.72
Invert into distribution box	452.8
Invert into trench(s)	452.2
Existing grade at septic tank	454.8
Existing grade at distribution box	453.5
Existing grade at trench(s)	453.52
Elevation of well at grade	457.42

NOTE: Length and detail of trenches to be determined by Howard County Health Department.

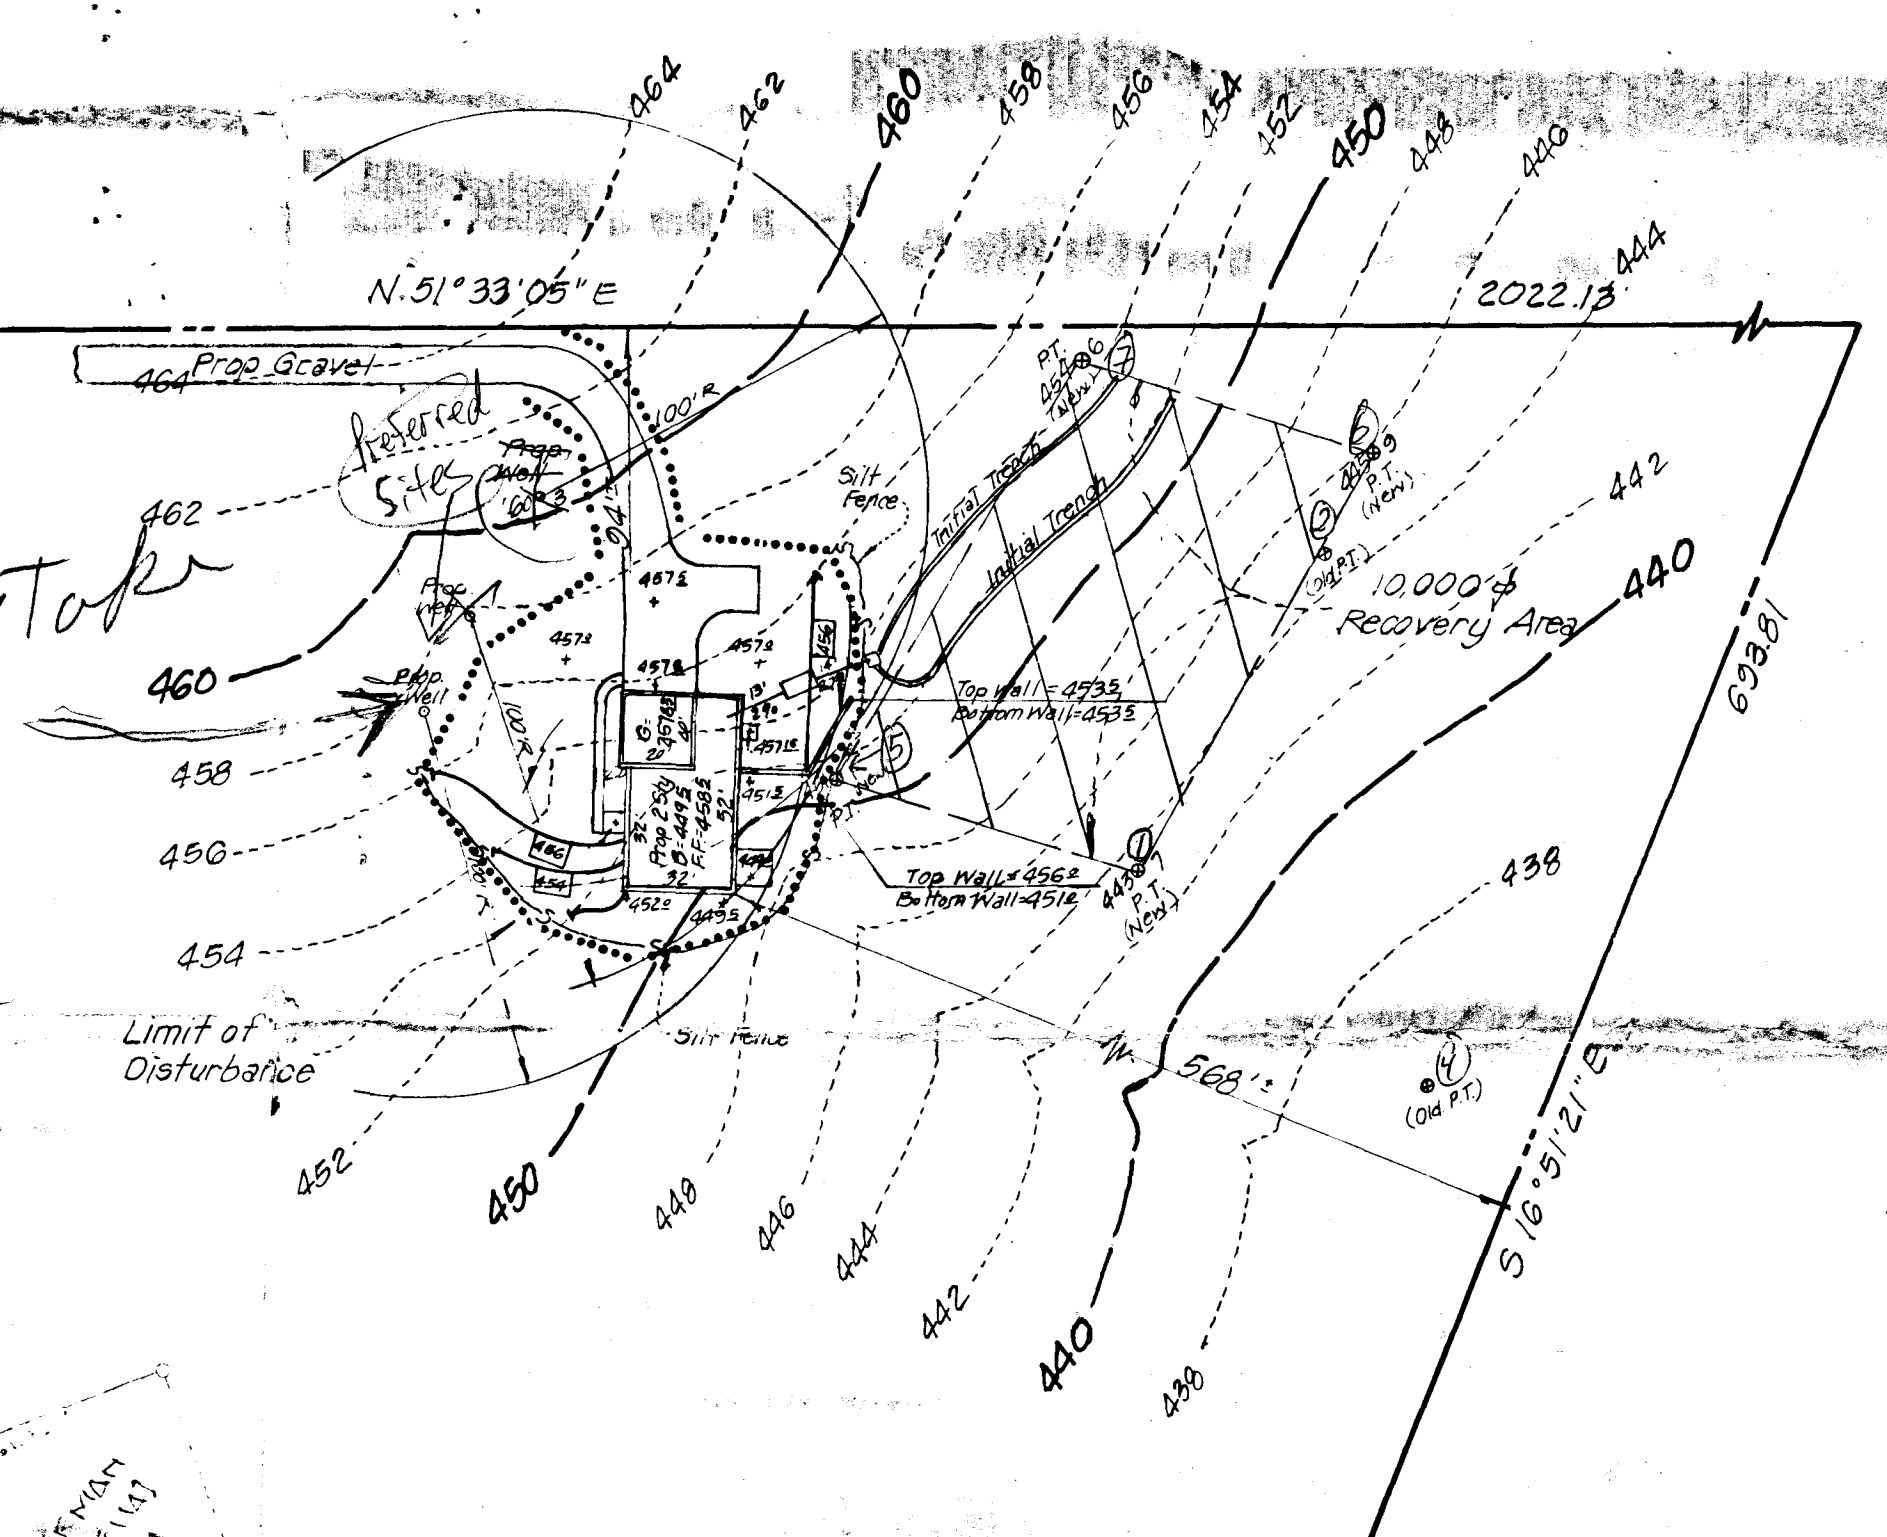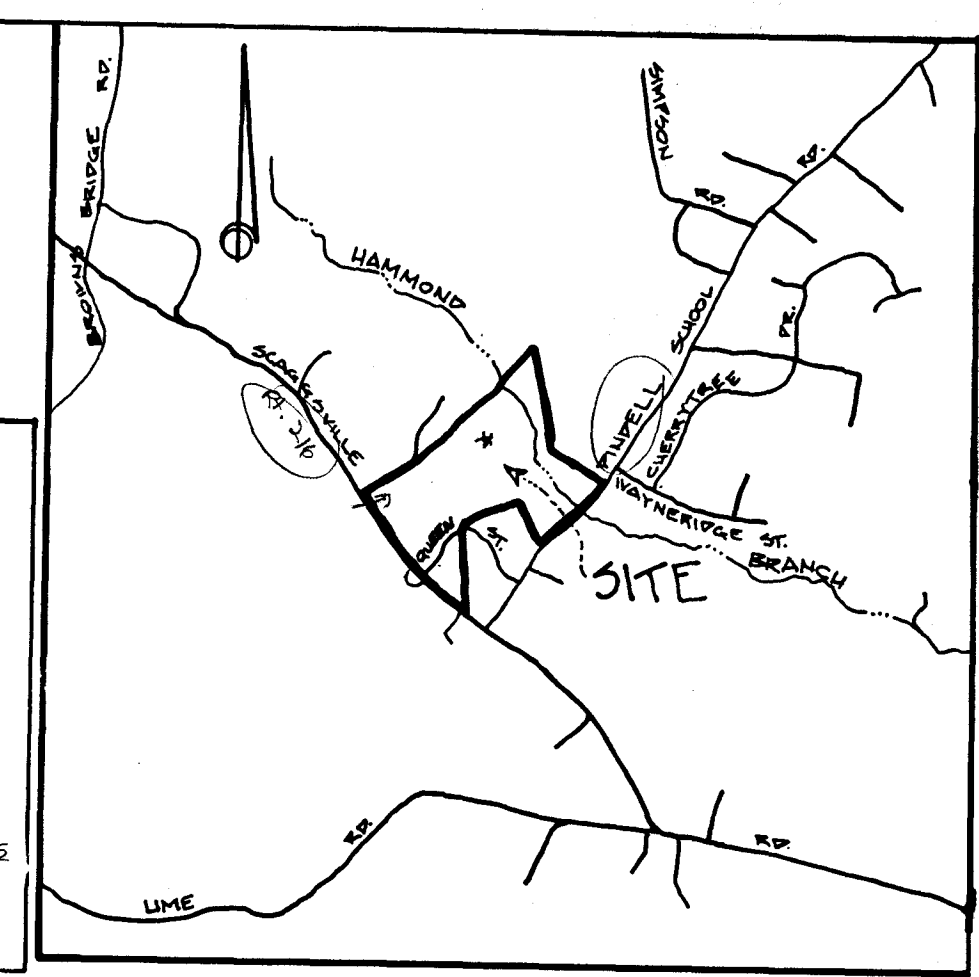

DETAIL
Scale: 1" = 50'

This area designates a private sewage easement of 10,000 sq. ft. as required by the Maryland State Department of Health and Mental Hygiene for individual sewage disposal. Improvements of any nature in this area are restricted until public sewage is available. These easements shall become null and void upon connection to a public sewage system. The County Health Officer shall have the authority to grant variances for encroachments into private sewage easement. Recordation of a modified sewage easement shall not be necessary.

Rev. Show detail topo, site plan for tenant house 9/16/00 1/4 227-50
Rev. Move driveway and old perk test

SURVEYOR'S CERTIFICATE

I hereby certify that I have carefully surveyed the property as shown herein in accordance with recorded associations, that corners are as shown and that there are no other encroachments except as indicated.

Date 7-5-84
JESSON BOOK, JR.
Registered Professional Surveyor
Maryland #8144

PLAN OF SURVEY
MALCOLM PROPERTY
MARYLAND RTE. 216 AT PINDELL SCHOOL ROAD
CLARKSVILLE DISTRICT
HOWARD COUNTY, MD.

DESIGNED BY SCALE 1" = 100' DATE 5-11-84 PHONE 422-6086

DRAWN BY JSC
MUL
APPROVED BY 181-44

Light, Elliott, & Associates
ENGINEERS PLANNERS SURVEYORS
8508 ADELPHI ROAD • ADELPHI MARYLAND 20783

JOB NO. MD-408
FILE NO. LS-1761

NOTES:
1. TOTAL AREA OF PROPERTY AS CONVEYED = 53.9174 ACRES.
2. PRESENT TITLE: DENNIS B. MALCOLM, et al., LIBER 1263, FOLIO 558.
3. ZONING: R
4. LOCATION: TAX MAP 41, PARCEL 67.
5. TOPOGRAPHY FROM HOWARD COUNTY TOPOGRAPHIC MAP (SHEETS NO. 40-010-T 221-31 & 222-31)
6. SURVEY DATUM - HOWARD COUNTY GEODETIC CONTROL SURVEY: STATIONS 213 7003, 213 7002, 213 7008.

APPROVED: For private water and private sewage systems, Howard County Department.
Jaye M. Boyd, Director 8/3/90
Howard County Health Officer, c.w. Date



HOWARD COUNTY HEALTH DEPARTMENT

Joyce M. Boyd, M.D., County Health Officer

October 21, 1991

Reply to:

Name: *Mr. KIMBER BURLEY*

Address: *12064 RX 216*

City, State and Zip Code:

Fulton, Md. 20759

RE: Subdivision *Malcolm LOT-2*
Address *12064 RX 216*
Well Tag No. *HO-88-1303*

Dear:



This is to advise you that the septic system was installed, inspected and approved on *07/30/91*.

The water sample recently submitted for testing was free of coliform and fecal coliform bacteria at the time of sampling and is bacteriologically safe for drinking.

The nitrate sample result was previously documented to be *10.4* parts per million. A nitrate device has not been installed to treat the excessive nitrate contamination.

COMAR 26.04.04.09 prohibits approval of any water supply with a nitrate-nitrogen contaminant level in excess of 10 parts per million. This department will grant a temporary deviation to that section of the regulation on condition that the nitrate removal system is installed within a period of 30 days and the nitrate removal system effectively maintains the nitrate-nitrogen contaminant level below the 10 parts per million requirement.

Furthermore, it will be necessary for you to comply with the following conditions:

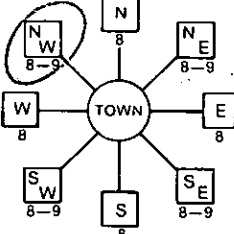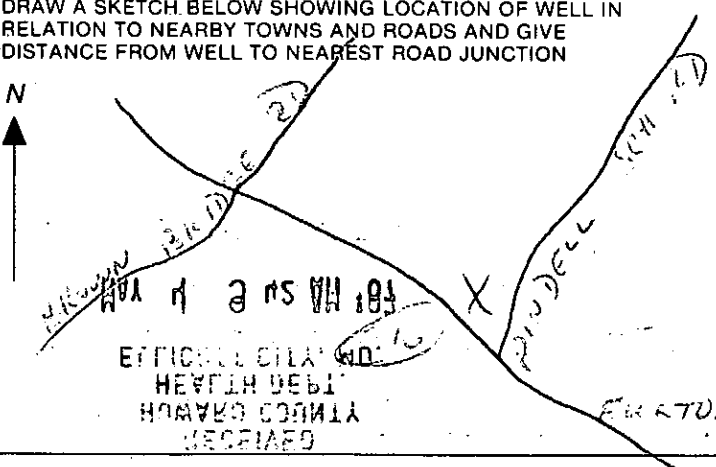B 1 0235 SEQUENCE NO. (OEP USE ONLY) (THIS NUMBER IS TO BE PUNCHED IN COLS. 3-6 ON ALL CARDS)	STATE OF MARYLAND PERMIT TO-DRILL WELL 6/11/87 please print or type	OEP PERMIT NUMBER 40-81-2068 fill in this form completely
Date Received: 6/11/87 OWNER INFORMATION MA. L. D. M. BROTHERS 2001 BRIGGS CHASEY R SILVER SPRING 20904 Town State Zip	LOCATION OF WELL 40 W. F. D. 8 COUNTY MAP 41 Q 13 P. 07 23 SUBDIVISION SECTION 44 48 LOT 48 50 FULTON 52 NEAREST TOWN MILES FROM TOWN (enter 0 if in town) 1 MI 73 76 77 78	
DRILLER INFORMATION George F. Easterday Driller's Name 9265 BR. Ch. RD., Mt. Airy, Md. 21771 Firm Name L. Franklin Easterday, Inc. Address Signature: <i>George F. Easterday</i> Date: 5/12/87	B 4 DIRECTION OF WELL FROM TOWN (CIRCLE BOX)  NEAR WHAT ROAD 12044 ON WHICH SIDE OF ROAD (CIRCLE APPROPRIATE BOX) NORTH [] WEST [] EAST [] SOUTH [] DISTANCE FROM ROAD 500 ENTER FT or MI FT	
B 2 WELL INFORMATION APPROX. PUMPING RATE (GAL. PER MIN.) 5 AVERAGE DAILY QUANTITY NEEDED (GAL. PER DAY) 5000 USE FOR WATER (CIRCLE APPROPRIATE BOX) ☒ HOME (SINGLE OR DOUBLE HOUSEHOLD UNIT ONLY) ☐ FARMING (LIVESTOCK WATERING & AGRICULTURAL IRRIGATION) ☐ INDUSTRIAL, COMMERCIAL, STATE AND FEDERAL GOV. OTHER (REQUIRES APPROPRIATION PERMIT) ☐ PUBLIC OR PRIVATE WATER COMPANY (REQUIRES APPROPRIATION PERMIT AND STATE HEALTH DEPARTMENT APPROVAL) ☐ TEST, OBSERVATION, MONITORING (MAY REQUIRE APPROPRIATION PERMIT)	NOT TO BE FILLED IN BY DRILLER HEALTH DEPARTMENT APPROVAL COUNTY NAME HOWARD COUNTY NO. A 39315-W OEP SIGNATURE _____ STATE HEALTH INSERT S ☐ DATE ISSUED 05/11/87 CO SIGNATURE B. Wilson EXP. DATE 11/11/87 NORTH GRID 482000 EAST GRID 0819000 SHOW MAJOR FEATURES OF BOX & LOCATE WELL WITH AN X SOURCES OF DRILLING WATER 1. WELL 2. 3. WRITE THE BOX NUMBER FROM THE MAP HERE E 820 19 N 480 2 DRAW A SKETCH BELOW SHOWING LOCATION OF WELL IN RELATION TO NEARBY TOWNS AND ROADS AND GIVE DISTANCE FROM WELL TO NEAREST ROAD JUNCTION 	
APPROXIMATE DEPTH OF WELL 200 FEET APPROXIMATE DIAMETER OF WELL 6 INCH METHOD OF DRILLING (circle one) BORED (or Augered) ☒ JETTED ☐ Jetted & DRIVEN ☐ AIR-ROTARY ☒ AIR-PERCussion ☐ ROTARY (Hydraulic Rotary) ☐ CABLE ☐ REVERSE-ROTARY ☐ Drive-POINT ☐ other _____	REPLACEMENT OR DEEPEMED WELLS (CIRCLE APPROPRIATE BOX) ☐ THIS WELL WILL NOT REPLACE AN EXISTING WELL ☐ THIS WELL WILL REPLACE A WELL THAT WILL BE ABANDONED AND SEALED ☒ THIS WELL WILL REPLACE A WELL THAT WILL BE USED AS A STANDBY ☐ THIS WELL WILL DEEPEAN AN EXISTING WELL PERMIT NUMBER OF WELL TO BE REPLACED OR DEEPEMED (IF AVAILABLE) 40-81-2068 Not to be filled in by driller (OEP USE ONLY) APPROP. PERMIT NUMBER 40-81-2068 FORCE 1 WRITE INITIALS IN BOX 40-81-2068 SPECIAL CONDITIONS	

C1 2425	SEQUENCE NO. (OEP USE ONLY)	STATE OF MARYLAND WELL COMPLETION REPORT FILL IN THIS FORM COMPLETELY PLEASE PRINT OR TYPE	THIS REPORT MUST BE SUBMITTED WITHIN 45 DAYS AFTER WELL IS COMPLETED.																																		
(THIS NUMBER IS TO BE PUNCHED IN COLS. 3-6 ON ALL CARDS)		COUNTY NUMBER A-39315-W	PERMIT NO. FROM "PERMIT TO DRILL WELL" 110-81-2068																																		
DATE Received 	DATE WELL COMPLETED 06/11/87	Depth of Well 360 (TO NEAREST FOOT)																																			
OWNER BROTHERS STREET OR RFD 1344 SCAGGSVILLE RD SUBDIVISION MAP 41 A13 P 67		last name MALCOLM first name AL TOWN FULTON SECTION 1 LOT 1																																			
WELL LOG Not required for driven wells STATE THE KIND OF FORMATIONS PENETRATED, THEIR COLOR, DEPTH, THICKNESS AND IF WATER BEARING		GROUTING RECORD WELL HAS BEEN GROUTED (Circle Appropriate Box) Y N TYPE OF GROUTING MATERIAL CEMENT CM BENTONITE CLAY BC NO. OF BAGS 16 NO. OF POUNDS 1600 GALLONS OF WATER 64 DEPTH OF GROUT SEAL (to nearest foot) from 0 ft. to 63 ft. (enter 0 if from surface)																																			
<table border="1" style="width:100%; border-collapse: collapse;"> <thead> <tr> <th rowspan="2">DESCRIPTION (Use additional sheets if needed)</th> <th colspan="2">FEET</th> <th rowspan="2">Check if water bearing</th> </tr> <tr> <th>FROM</th> <th>TO</th> </tr> </thead> <tbody> <tr> <td>Top Soil</td> <td>0</td> <td>2</td> <td></td> </tr> <tr> <td>Clay</td> <td>2</td> <td>6</td> <td></td> </tr> <tr> <td>Shale</td> <td>6</td> <td>15</td> <td></td> </tr> <tr> <td>Sand Stone</td> <td>15</td> <td>60</td> <td></td> </tr> <tr> <td>Mica</td> <td>60</td> <td>75</td> <td></td> </tr> <tr> <td>Sand Stone</td> <td>75</td> <td>95</td> <td>✓</td> </tr> <tr> <td>Mica</td> <td>95</td> <td>360</td> <td></td> </tr> </tbody> </table>		DESCRIPTION (Use additional sheets if needed)	FEET		Check if water bearing	FROM	TO	Top Soil	0	2		Clay	2	6		Shale	6	15		Sand Stone	15	60		Mica	60	75		Sand Stone	75	95	✓	Mica	95	360		CASING RECORD casing types insert appropriate code below ST STEEL CO CONCRETE PL PLASTIC OT OTHER MAIN CASING TYPE ST Nominal diameter top (main) casing (nearest inch) 6 Total depth of main casing (nearest foot) 70	
DESCRIPTION (Use additional sheets if needed)	FEET		Check if water bearing																																		
	FROM	TO																																			
Top Soil	0	2																																			
Clay	2	6																																			
Shale	6	15																																			
Sand Stone	15	60																																			
Mica	60	75																																			
Sand Stone	75	95	✓																																		
Mica	95	360																																			
OTHER CASING (if used) diameter inch 6 depth (feet) from 0 to 70		PUMPING TEST HOURS PUMPED (nearest hour) 2 PUMPING RATE (gal. per min. to nearest gal.) 4 METHOD USED TO MEASURE PUMPING RATE Bucket WATER LEVEL (distance from land surface) BEFORE PUMPING 95 WHEN PUMPING 360 TYPE OF PUMP USED (for test) A air P piston T turbine C centrifugal R rotary O other (describe below) J jet S submersible																																			
SCREEN RECORD screen type or open hole insert appropriate code below ST STEEL BR BRASS BRONZE HO OPEN HOLE PL PLASTIC OT OTHER		PUMP INSTALLED DRILLER WILL INSTALL PUMP YES NO (CIRCLE) (YES or NO) IF DRILLER INSTALLS PUMP, THIS SECTION MUST BE COMPLETED FOR ALL WELLS EXCEPT HOME USE TYPE OF PUMP INSTALLED PLACE (A,C,J,P,R,S,T,O) IN BOX - SEE ABOVE: A CAPACITY: GALLONS PER MINUTE (to nearest gallon) 4 PUMP HORSE POWER 37 PUMP COLUMN LENGTH (nearest ft.) 43 CASING HEIGHT (circle appropriate box and enter casing height) + above - below } LAND SURFACE 2 (nearest foot)																																			
CIRCLE APPROPRIATE LETTER A A WELL WAS ABANDONED AND SEALED WHEN THIS WELL WAS COMPLETED E ELECTRIC LOG OBTAINED P TEST WELL CONVERTED TO PRODUCTION WELL		DEPTH (nearest ft.) from 0 to 360 SLOT SIZE 1 2 2 3 DIAMETER OF SCREEN 6 (NEAREST INCH)																																			
I HEREBY CERTIFY THAT THIS WELL HAS BEEN CONSTRUCTED IN ACCORDANCE WITH COMAR 10.17.13 "WELL CONSTRUCTION" AND IN CONFORMANCE WITH ALL CONDITIONS STATED IN THE ABOVE CAPTIONED PERMIT, AND THAT THE INFORMATION PRESENTED HEREIN IS ACCURATE AND COMPLETE TO THE BEST OF MY KNOWLEDGE.		GRAVEL PACK IF WELL DRILLED WAS FLOWING WELL INSERT F IN BOX 68 68																																			
DRILLERS IDENT. NO. 40 DRILLERS SIGNATURE John R. Eustace (MUST MATCH SIGNATURE ON APPLICATION)		OEP USE ONLY (NOT TO BE FILLED IN BY DRILLER) T TELESCOPE CASING LOG LOG INDICATOR WQ OTHER DATA																																			
SITE SUPERVISOR (sign. of driller or journeyman responsible for sitework if different from permittee) John R. Eustace		LOCATION OF WELL ON LOT SHOW PERMANENT STRUCTURE SUCH AS BUILDING, SEPTIC TANKS, AND/OR LANDMARKS AND INDICATE NOT LESS THAN TWO DISTANCES (MEASUREMENTS TO WELL) Well 10' 500' Scaggsville Rd Drive Way																																			