

PERMIT

05-425352

P 511303

SEWAGE DISPOSAL SYSTEM

A 45760-B

DEPARTMENT OF HEALTH AND MENTAL HYGIENE

DISTRICT 5th

HOWARD COUNTY HEALTH DEPARTMENT

DATE 12/14/98

BUREAU OF ENVIRONMENTAL HEALTH
XXXXXXX 410-313-2640

INDEVEN

DATE SYSTEM APPROVED 1/4/99

INSPECTOR DKS

Jack Fyock Septic Service IS PERMITTED TO INSTALL ☒ ALTER ☐

ADDRESS 13775 Triadelphia Road Glenelg, Maryland 21737 PHONE (410) 988-9270

SUBDIVISION Cashmark LOT 2 ROAD 7590 Sanner Road

PROPERTY OWNER Hamilton Reed

ADDRESS

SEPTIC TANK CAPACITY 1250 GALLONS

NUMBER OF BEDROOMS 4

180 SQUARE FEET PER BEDROOM

LINEAR FEET OF TRENCH REQUIRED 240

PUMPED SEPTIC SYSTEM

INSTALL: 1-1250 Gallon Pump Tank
NOTES: - Septic pump detail to be provided by installer prior to issuance of septic permit.
- Pump performance test is necessary prior to Health Department approval of pumped septic system.

TRENCHES - Trench to be 3 feet wide. Inlet 3 feet below original grade. Bottom maximum depth 5 feet below original grade. Effective area begins at 3 feet below original grade. 2 feet of stone below distribution pipe.

LOCATION - Place the distribution box 55 feet from the breakpoint in the left lot line (290.15' / 157.77' intersection) and 45 feet off the right lot line. Run trenches on contour to left side of lot.

NOTES - No trench to exceed 100 feet in length. Provide 6" - 8" diameter cleanout and cap to grade or above on septic tank. OK/MR

12/23/98 HOUSE PLUMBING RAISED 10' ± (FIRST FLOOR SERVICE ONLY); NO PUMPING REQ'D (MR)

PER T/C W/BLDR. Mark Rifkin PLANS APPROVED BY **BUILDING PERMIT SIGNED** DATE 8/18/98

COVER NO WORK UNTIL INSPECTED AND APPROVED **AND RETURNED 11-13-02**
600139348-DECK

NEITHER THE HOWARD COUNTY COUNCIL NOR THE HEALTH DEPARTMENT IS RESPONSIBLE FOR THE SUCCESSFUL OPERATION OF ANY SYSTEM

NOTE: CLEANOUT REQUIRED EVERY 70 FEET OF SEWER LINE AND/OR AT 90° SWEEPS IN LINES FROM HOUSE TO DRAIN FIELDS. 90° ELBOWS NOT ACCEPTABLE.

NOTE: ALL PARTS OF SEPTIC SYSTEMS (I.E. TANK, DISTRIBUTION BOX TRENCHES) TO BE 100 FEET FROM WELL (UNLESS OTHERWISE SPECIFICALLY AUTHORIZED)

NOTE: IF DEEP TRENCH(ES) ARE USED CALL FOR INSPECTION BEFORE AND AFTER PLACING GRAVEL IN TRENCH(ES)

NOTE: NO DRY WELL SHALL EXCEED 15 FOOT IN DIAMETER NO ABSORPTION TRENCH TO EXCEED 100 FEET IN LENGTH

NOTE: ALL PIPE FROM HOUSE TO SEPTIC TANK MUST BE CAST IRON OR SCHEDULE 35/40 PVC OR ABS


PERMIT VOID AFTER TWO YEARS

NOTE: INSTALL STAND PIPE ON SEPTIC TANK AND DRY WELL STAND PIPES MUST BE 6 INCHES IN DIAMETER CAST IRON, CONCRETE OR TERRA COTTA OR PVA OR ABS ACCEPTED. IF TOP OF SEPTIC TANK IS DEEPER THAN 3 FEET, MANHOLE TO GRADE REQUIRED.

NOTE: DISTRIBUTION BOXES MUST HAVE BAFFLES

*INSTALLER IS RESPONSIBLE FOR OBTAINING FINAL APPROVAL ON THIS PERMIT
*CALL 481-9933 FOR INSPECTION OF SEPTIC SYSTEM.

NOT TO SCALE

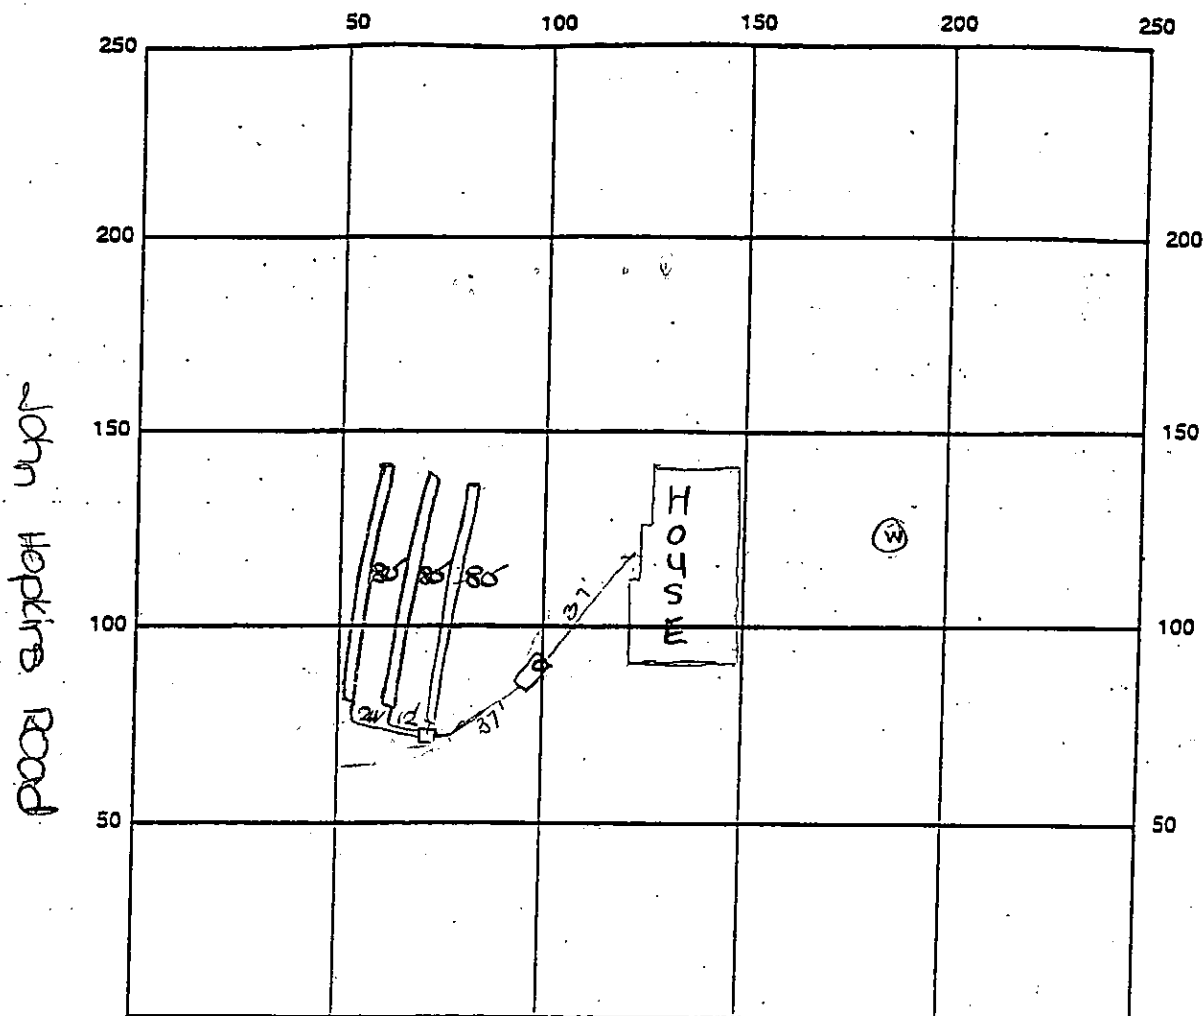

INDICATE NORTH - NAME ADJOINING ROADWAY AS BASE LINE

Sanner Road

SEPTIC TANK LEVEL OK - 1250 gal CLEANOUTS one on site

DISTRIBUTION BOX LEVEL OK

DRAIN FIELD/TITLE DEPTH 5 FT. TRENCH WIDTH 3 FT. INLET DEPTH 3 FT.

EFFECTIVE GRAVEL DEPTH 2 FT. ~~TOTAL LENGTH~~ 37 FT. 6240 SQ. FT.
NUMBER OF TRENCHES 3 ONE SIDEWALL BOTTOM AREA 720 SQ. FT.

DRYWALL INSIDE DIAMETER — FT. EFFECTIVE DEPTH BELOW INLET — FT.

ABSORBENT AREA — SQ. FT.

REMARKS: 1/4/99 P.M. OK to continue. ALM
1/4/99 P.M. FINAL INSP - OK to cover all work as completed.
Sufficient materials at the site. DKS

DATE SYSTEM APPROVED 1/4/99 INSPECTOR [Signature]

APPLICATION

PERCOLATION TESTING

A 45760

P _____

HOWARD COUNTY HEALTH DEPARTMENT
BUREAU OF ENVIRONMENTAL HEALTH
P.O. BOX 476 ELLICOTT CITY, MARYLAND 21043
TELEPHONE 461-9933

PROVIDED OK

DISTRICT _____

TEST CIRCLED HOLDS

DATE 4/3/90

OTHER AS NECESSARY

DEPENDENDING UPON SOIL CONDITIONS.

STANDARD DUMP RETAIL CENTER, NO FAST FOOD.

RE-ZONING PENDING

TO: THE COUNTY HEALTH OFFICER
ELLICOTT CITY, MARYLAND

I HEREBY APPLY FOR THE NECESSARY TEST IN ORDER TO CONSTRUCT OR RECONSTRUCT A SEWAGE DISPOSAL SYSTEM.

PROPERTY OWNER JOHN CASHMAREK & DAVID PATTON HAMILTON REED

ADDRESS C/O JOHN'S HOPKINS PLAZA ASSOCIATES PHONE 461-5482

ATTN: JOHN REUWER

740-2100

PROSPECTIVE BUYER _____

ADDRESS 10805 HICKORY RIDGE ROAD PHONE _____

COLUMBIA, MD. 21046

BLDG. PERMIT _____

PROPERTY LOCATION: ONE RETURNED 8-18-98

Serial # 67113115

SUBDIVISION COMMERCIAL SITE LOT NO. SFD-4B

ROAD AND DESCRIPTION CORNER OF JOHN'S HOPKINS ROAD AND SAWNER RD

NORTH OF JOHN'S HOPKINS, WEST OF SAWNER

TAX MAP 41 PARCEL # 121

45,000 SQ FT POTENTIAL
SEPTIC AREA

SIZE OF LOT APP. 5 ACRES TYPE BLDG COMMERCIAL

(SINGLE FAMILY DWELLING OR COMMERCIAL)

THE SYSTEM INSTALLED UNDER THIS APPLICATION IS ACCEPTABLE ONLY UNTIL PUBLIC FACILITIES BECOME AVAILABLE. I FULLY UNDERSTAND THE

FEE CONNECTED WITH THE FILING OF THIS PERC TEST APPLICATION IS NON-REFUNDABLE UNDER ANY CIRCUMSTANCES. I ALSO AGREE TO COMPLY

WITH ALL M.O.S.H.A. REQUIREMENTS IN TESTING THIS LOT.

(SIGNATURE OF APPLICANT)

APPROVED BY _____ FOR _____ DATE _____

REJECTED BY _____ FOR _____ DATE _____

HOLD PENDING FURTHER TESTS _____ DATE _____

REASONS FOR REJECTION OR HOLDING 5/7/90 PERC OK - HOLD FOR PLAT MIR

* ORIGINAL PERC NOTES IN LOT 1 PROPERTY FILE *

THIS IS NOT A PERMIT

(P1/3)
A 45760

(18)
SOIL PROFILE

4m +
org. clay
+ clay loam

S

org +
brn
silty
sand loam
5-9% frags
hi mica
SOME
MOTTLED

12

at 12'

(20)

org + vel

clay +

clay

loam

pink


org

sand

loam

5-9% frags

hi mica

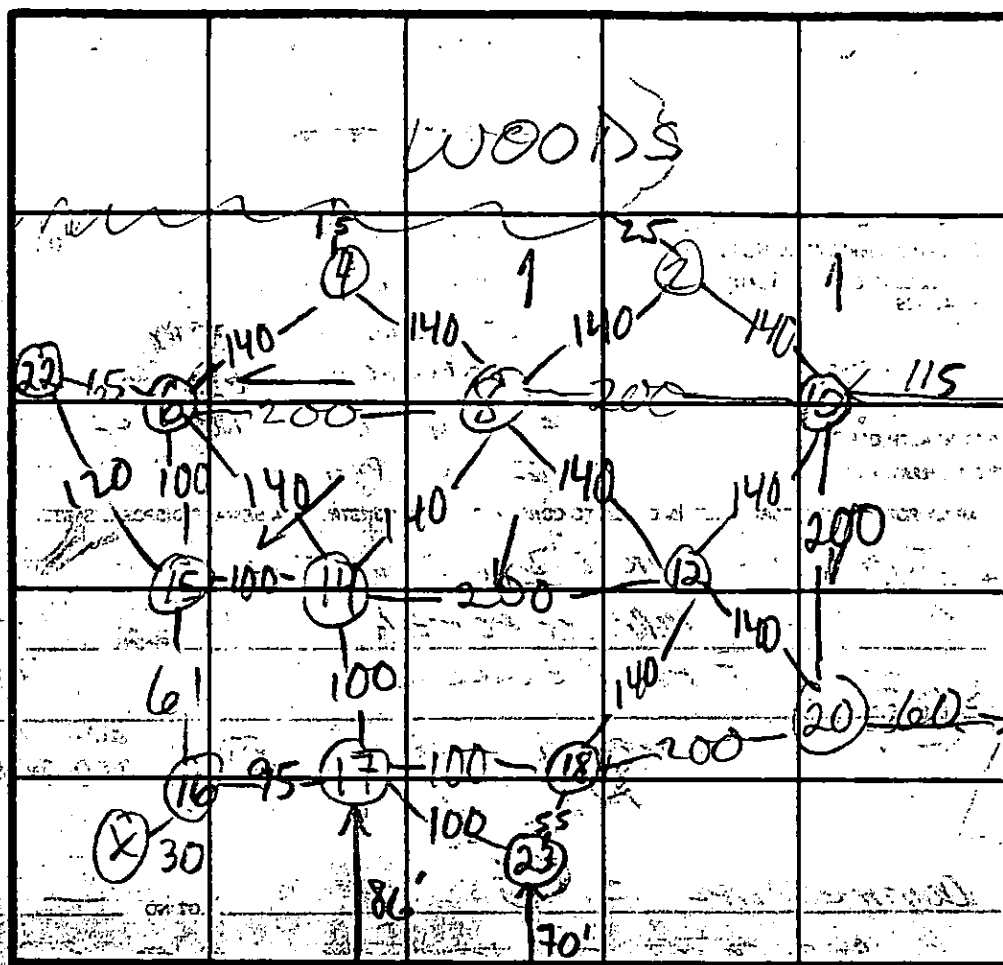

INDICATE NORTH - NAME ADJOINING ROADWAY AS BASE LINE.

DATE	TEST NO.	DEPTH	PRE-WET		TEST - 1" DROP		TIME
			START	STOP	START	STOP	
5/1/88	18 S	7	10:55	11:01	11:01	11:14	13
	18 V	12	see	profile			
	12 S	5 1/2	11:09	11:24	11:24	11:47	23
	12 V	11 1/2	sim to 18	bright org sand loam			NO MOTTLE
	20 S	5 1/2	11:11	11:16	11:16	11:22	6
	20 V	11 1/2	see	profile			
	10 S	6 1/2	11:30	11:35	11:35	11:45	10 EST
	10 V	12	sim to 20	more org sand loam			
	2 S	7	11:32	11:37	11:37	11:42	10 EST
	2 V	12 1/2	sim to 20	see profile			

REMARKS

ALL HOLES DUG PER PLAT EXC. (16) (22) + (23)

TYPE OF SOIL

TESTED BY


M. Ripkin

ALSO PRESENT

OK + Dad

42/13 A45760

4
SOIL PROFILE

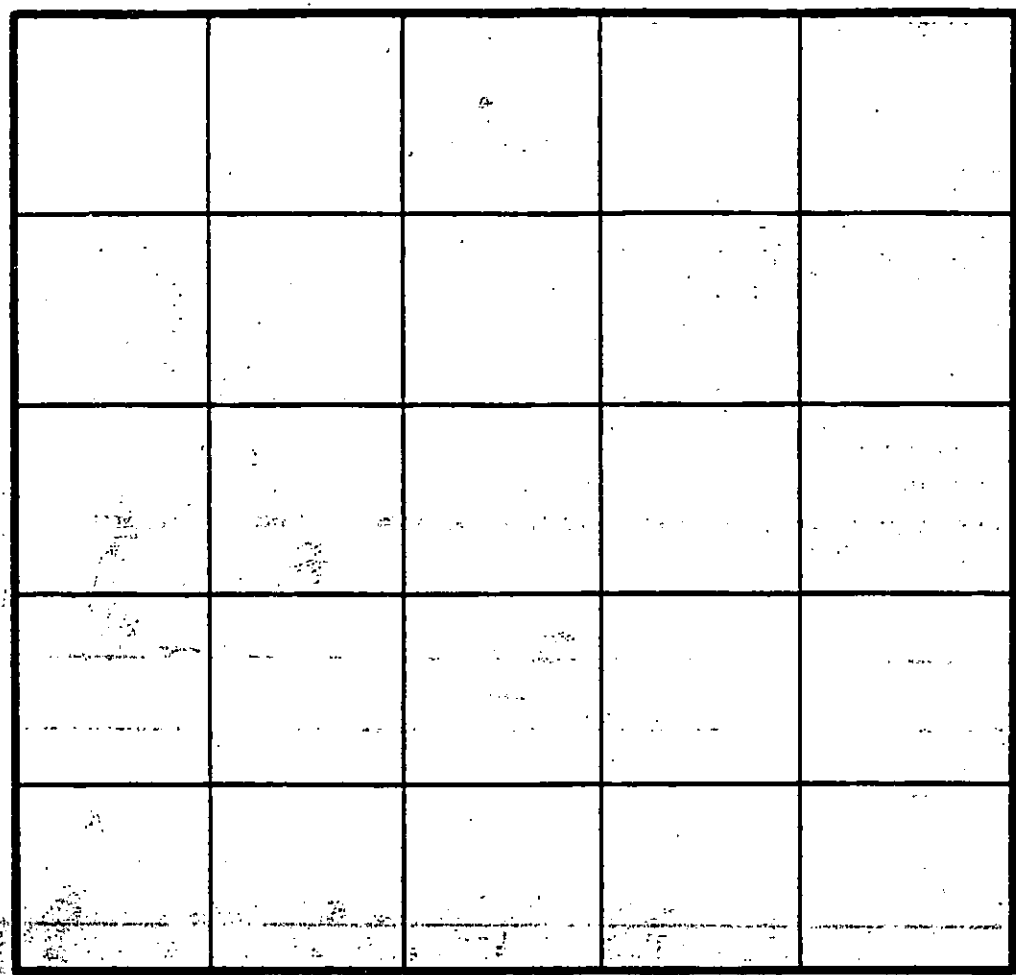

51-26
12
org clay
org tan
yel, beige
sand
loam
5-15%
frags
liq quartz
mica
rotten
rocks, ↑
w/depth

INDICATE NORTH--NAME ADJOINING ROADWAY AS BASE LINE.

DATE	TEST NO.	DEPTH	PRE-WET		TEST - 1" DROP		TIME
			START	STOP	START	STOP	
5/4/90	8 S	6	11:58	12:05	12:05	12:13	8 EST
	8 V	9	11:58	12:05	12:05	12:14	9 EST
	8 V	12	sim to	18	more org	w/dec	NO MOTTLES
	4 S	7	12:02	12:06	12:06	12:11	5
	4 V	12	see	profile			
	14 S	7	12:19	12:21	12:21	12:25	4
	14 V	12 1/2	sim to	18	some scattered	rx at	
	6 S	6 1/2	12:29	12:33	12:33	12:42	10
	6 V	13 1/2	sim to	18	NO MOTTLES	more brn	
	15	7	12:47	FAIL	NO PERC		
	15	12	sim to	18	clay to 6-	7 L	

REMARKS

TYPE OF SOIL



TESTED BY

ALSO PRESENT

P3/3 A45760



24

SOIL PROFILE

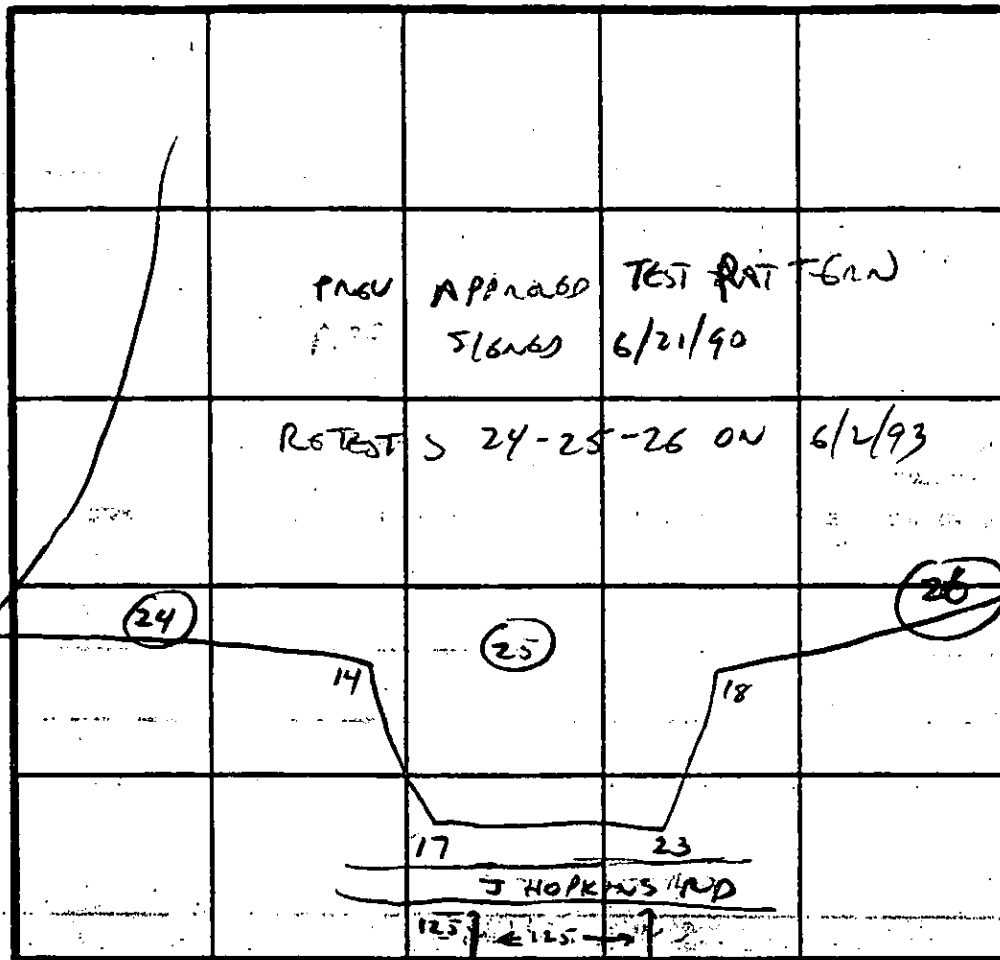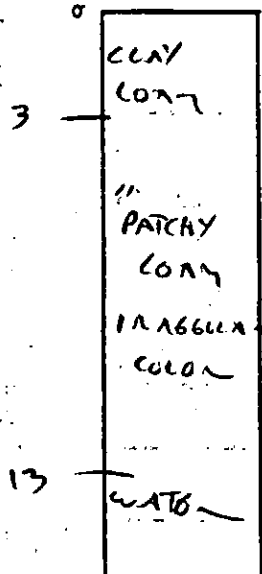

20

25 26

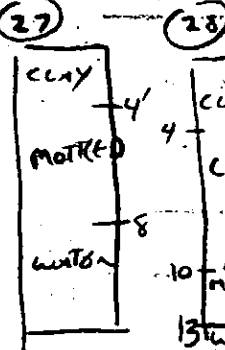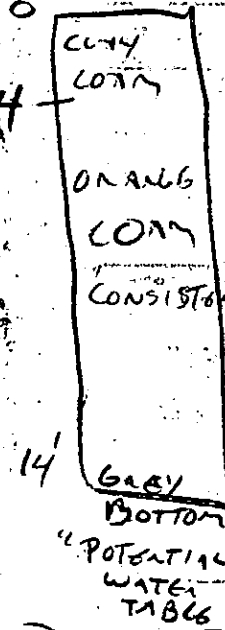

INDICATE NORTH - NAME JOINING ROADWAY AS BASE LINE

DATE	TEST NO.	DEPTH	PRE-WET		TEST - 1" DROP		TIME
			START	STOP	START	STOP	
5/4/90	16 V	3	ALL	ROCK		FAIL	
	22 V	11	sim to	4			
	17 V	14	DRY	OK sim to	18	clay to 6-6 1/2	
	23 V	12 1/2	DRY	sim to (4)	clay to 5-	6 NO	
6/2/93	24						
		VIS	OK 3-13'	WATER AT 13'	AFTER 2 HRS		
	25						
		VIS	OK 4-14'	NO WATER	AFTER 2 HRS		
	26		VIS	OK 4-14'	POTENTIAL WATER AT 14'		

6 1/2
NO
MOTT
SEE

3 LOW
HOLDS
CASHM
"PROPER
CONFIRM
V. GOOD
6/2/93

REMARKS

TYPE OF SOIL

TESTED BY

27 } INFORTAL EVALUATION FOR POTENTIAL FUTURE USE
28 } #27 FAILS - WATER; #28 LIKELY OK 4-10'

(POTENTIAL 10,000-20,000 SQUARE FT AT HIGHEST GROUND, SOUTH SIDE

Cweller (HOLDS 24-28)

ALSO PRESENT

OK, JA, MARK REICH

DAVID W. PATTON DATE 7/6/96

BRIAN KNAUFF DATE 9-5-96

PROPERTY OF
BERNARD L. MAUCK & WIFE
180/251
P.119
ZONED-RR

PROPERTY OF
ARTHUR J. ADKINS & WIFE
478/184
P.335
ZONED-RR

PROPERTY OF
JOHN E. LORENZ
1199/120
P.130
ZONED-RR

COPY of approved
F-96-78

24' INGRESS/EGRESS EASEMENT
TO PRESERVATION PARCEL "A"
24' USE IN COMMON INGRESS/EGRESS
EASEMENT TO LOTS 1, 2 & 3
N 85°51'45" E

20' DRAINAGE AND UTILITY EASEMENT

PRESERVATION PARCEL "A"
(BUILDABLE)
582,244.27 S.F.
13.366 ACRES

LOT 1
60,000 S.F.

LOT 2
47,859.60 S.F.


LOT 3
50,424.71 S.F.

6500A W/BARRIER LINE

SANNER ROAD

VEHICULAR INGRESS AND EGRESS IS RESTRICTED

RR-MXD-3

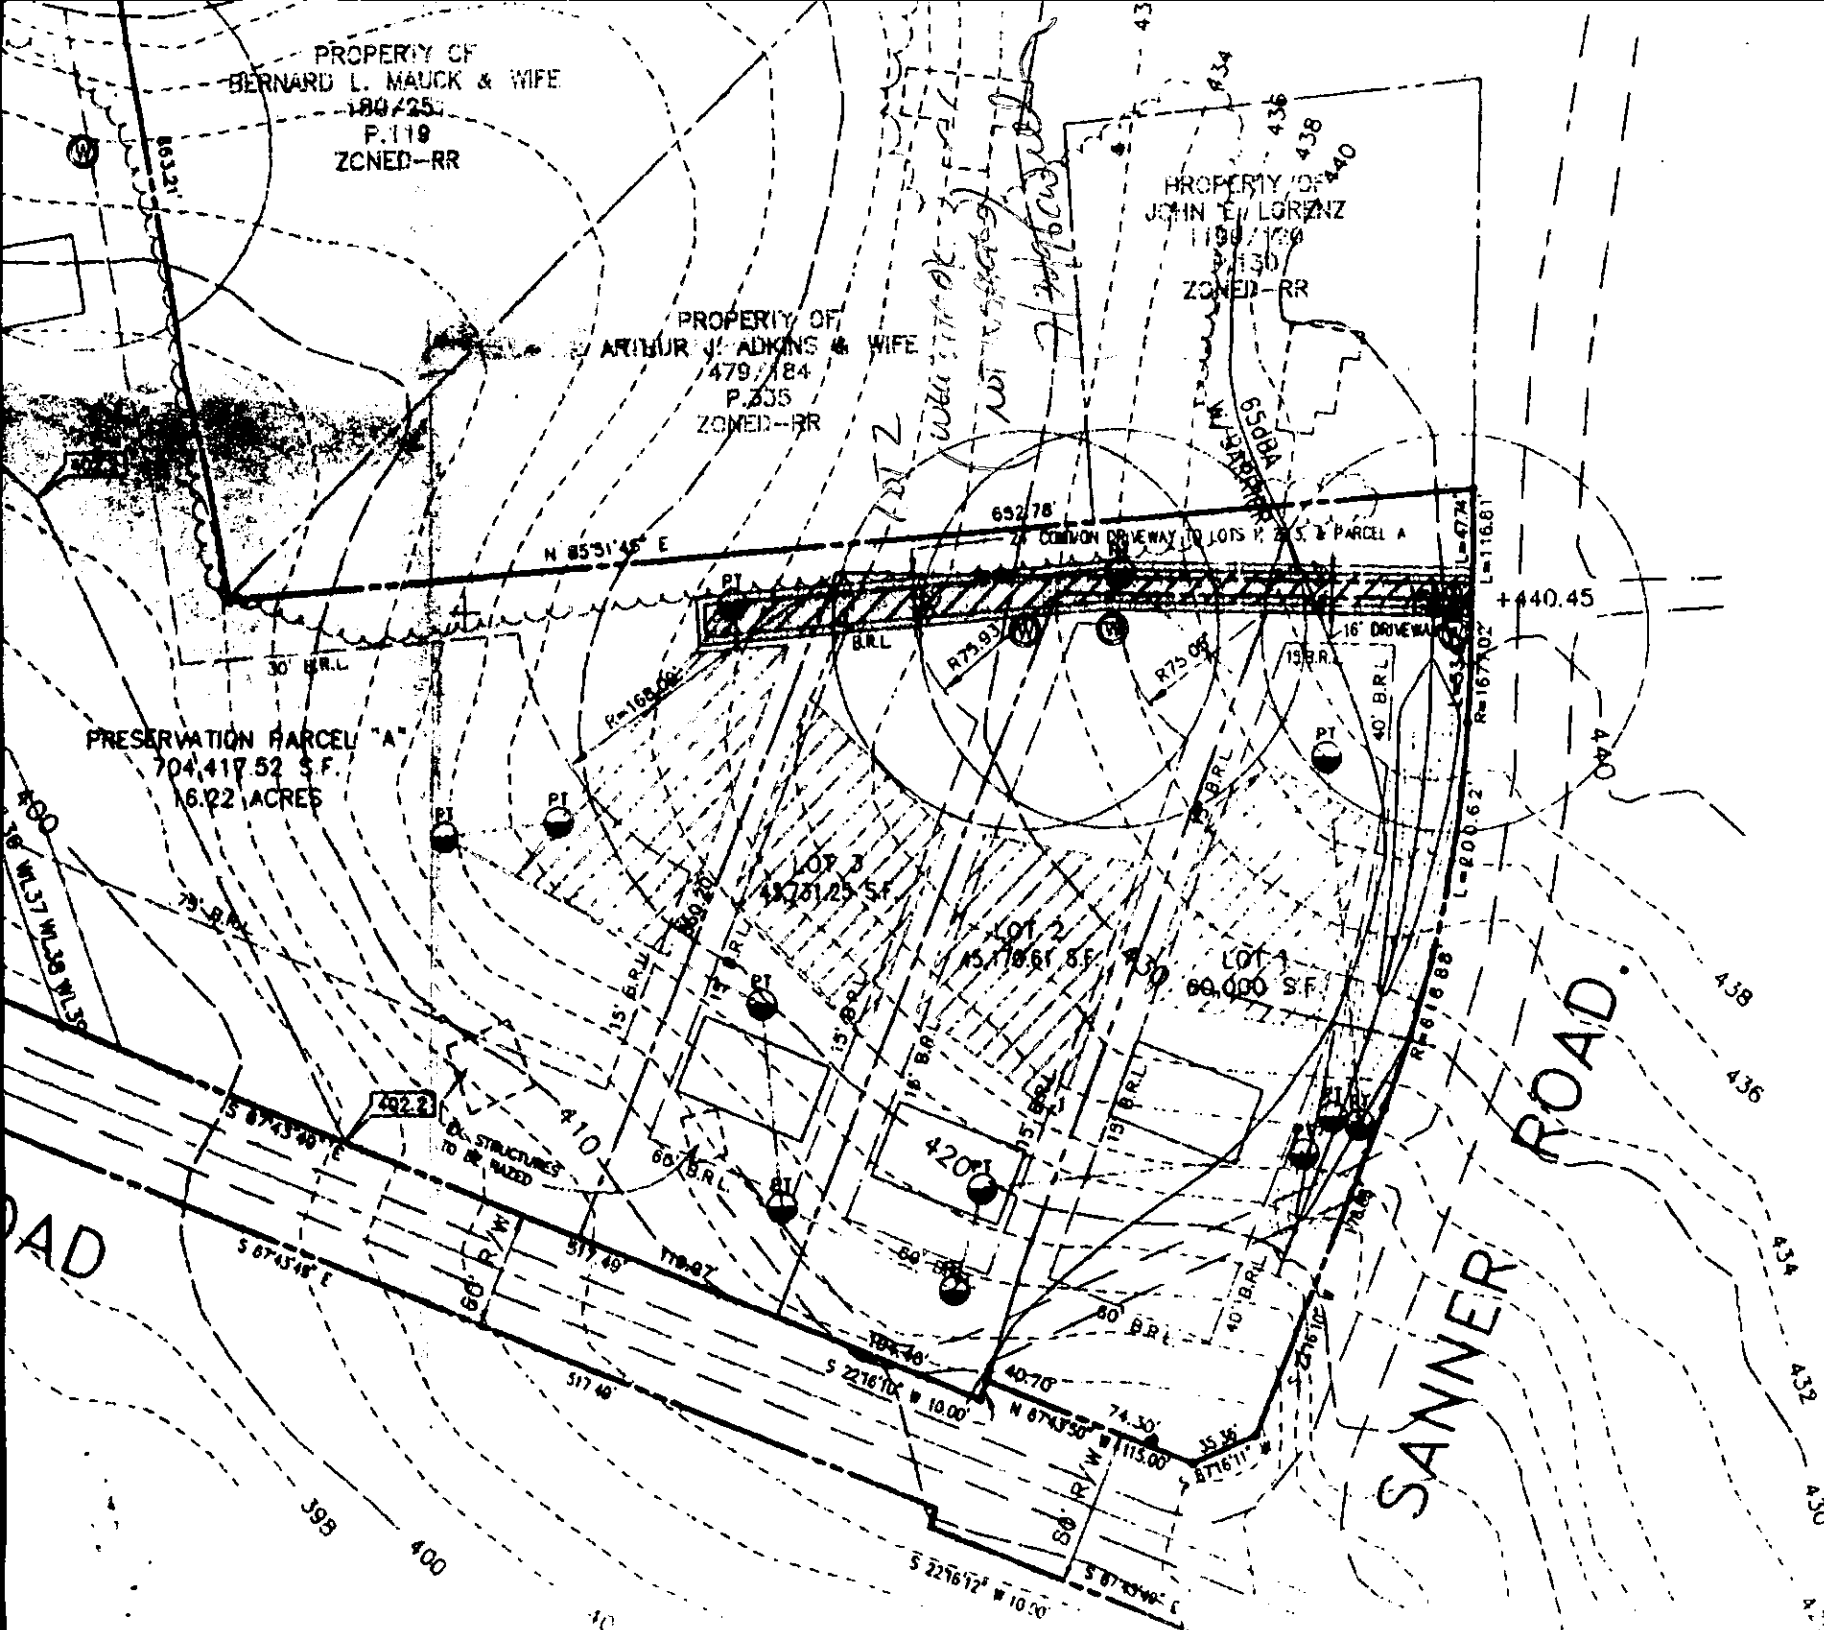

copy of original
percolation plan

12-1-95

Total linear feet of trench
required 240 feet

Width of trench(es) 3 feet

Depth of trench(es) 5 feet

Depth of stone required below
distribution pipe 2 feet

FIRST FLOOR ELEV.	= 437.37
INV. OUT OF HOUSE	= 426.26
INV. IN SEPTIC TANK	= 424.86
INV. OUT SEPTIC TANK	= 424.61
INV. IN PUMP PIT	= 424.47
INV. IN DIST. BOX	= 422.40
EXIST. ELEV. @ SEPTIC TANK	= 430.90
PROP. ELEV. @ SEPTIC TANK	= 432.50
EXIST. ELEV. @ DIST. BOX	= 430.40

PLAN BY MBA

JOHNS HOPKINS ROAD

12/23/98 HOUSE PLUMBING
RAISED 10' - PUMPING NOT REQ'D

MR.

Approved Septic System Plan
Howard County Health Department


Signature Mark E. Miller
Date 8/8/98

SITE PLAN
SCALE: 1" = 50'

TO SANNER
ROAD

ALL LINES WILL BE SHOWN
THE PARCEL.

Copy of signed
perc. cert. for
Shared Septic
System
6-21-90

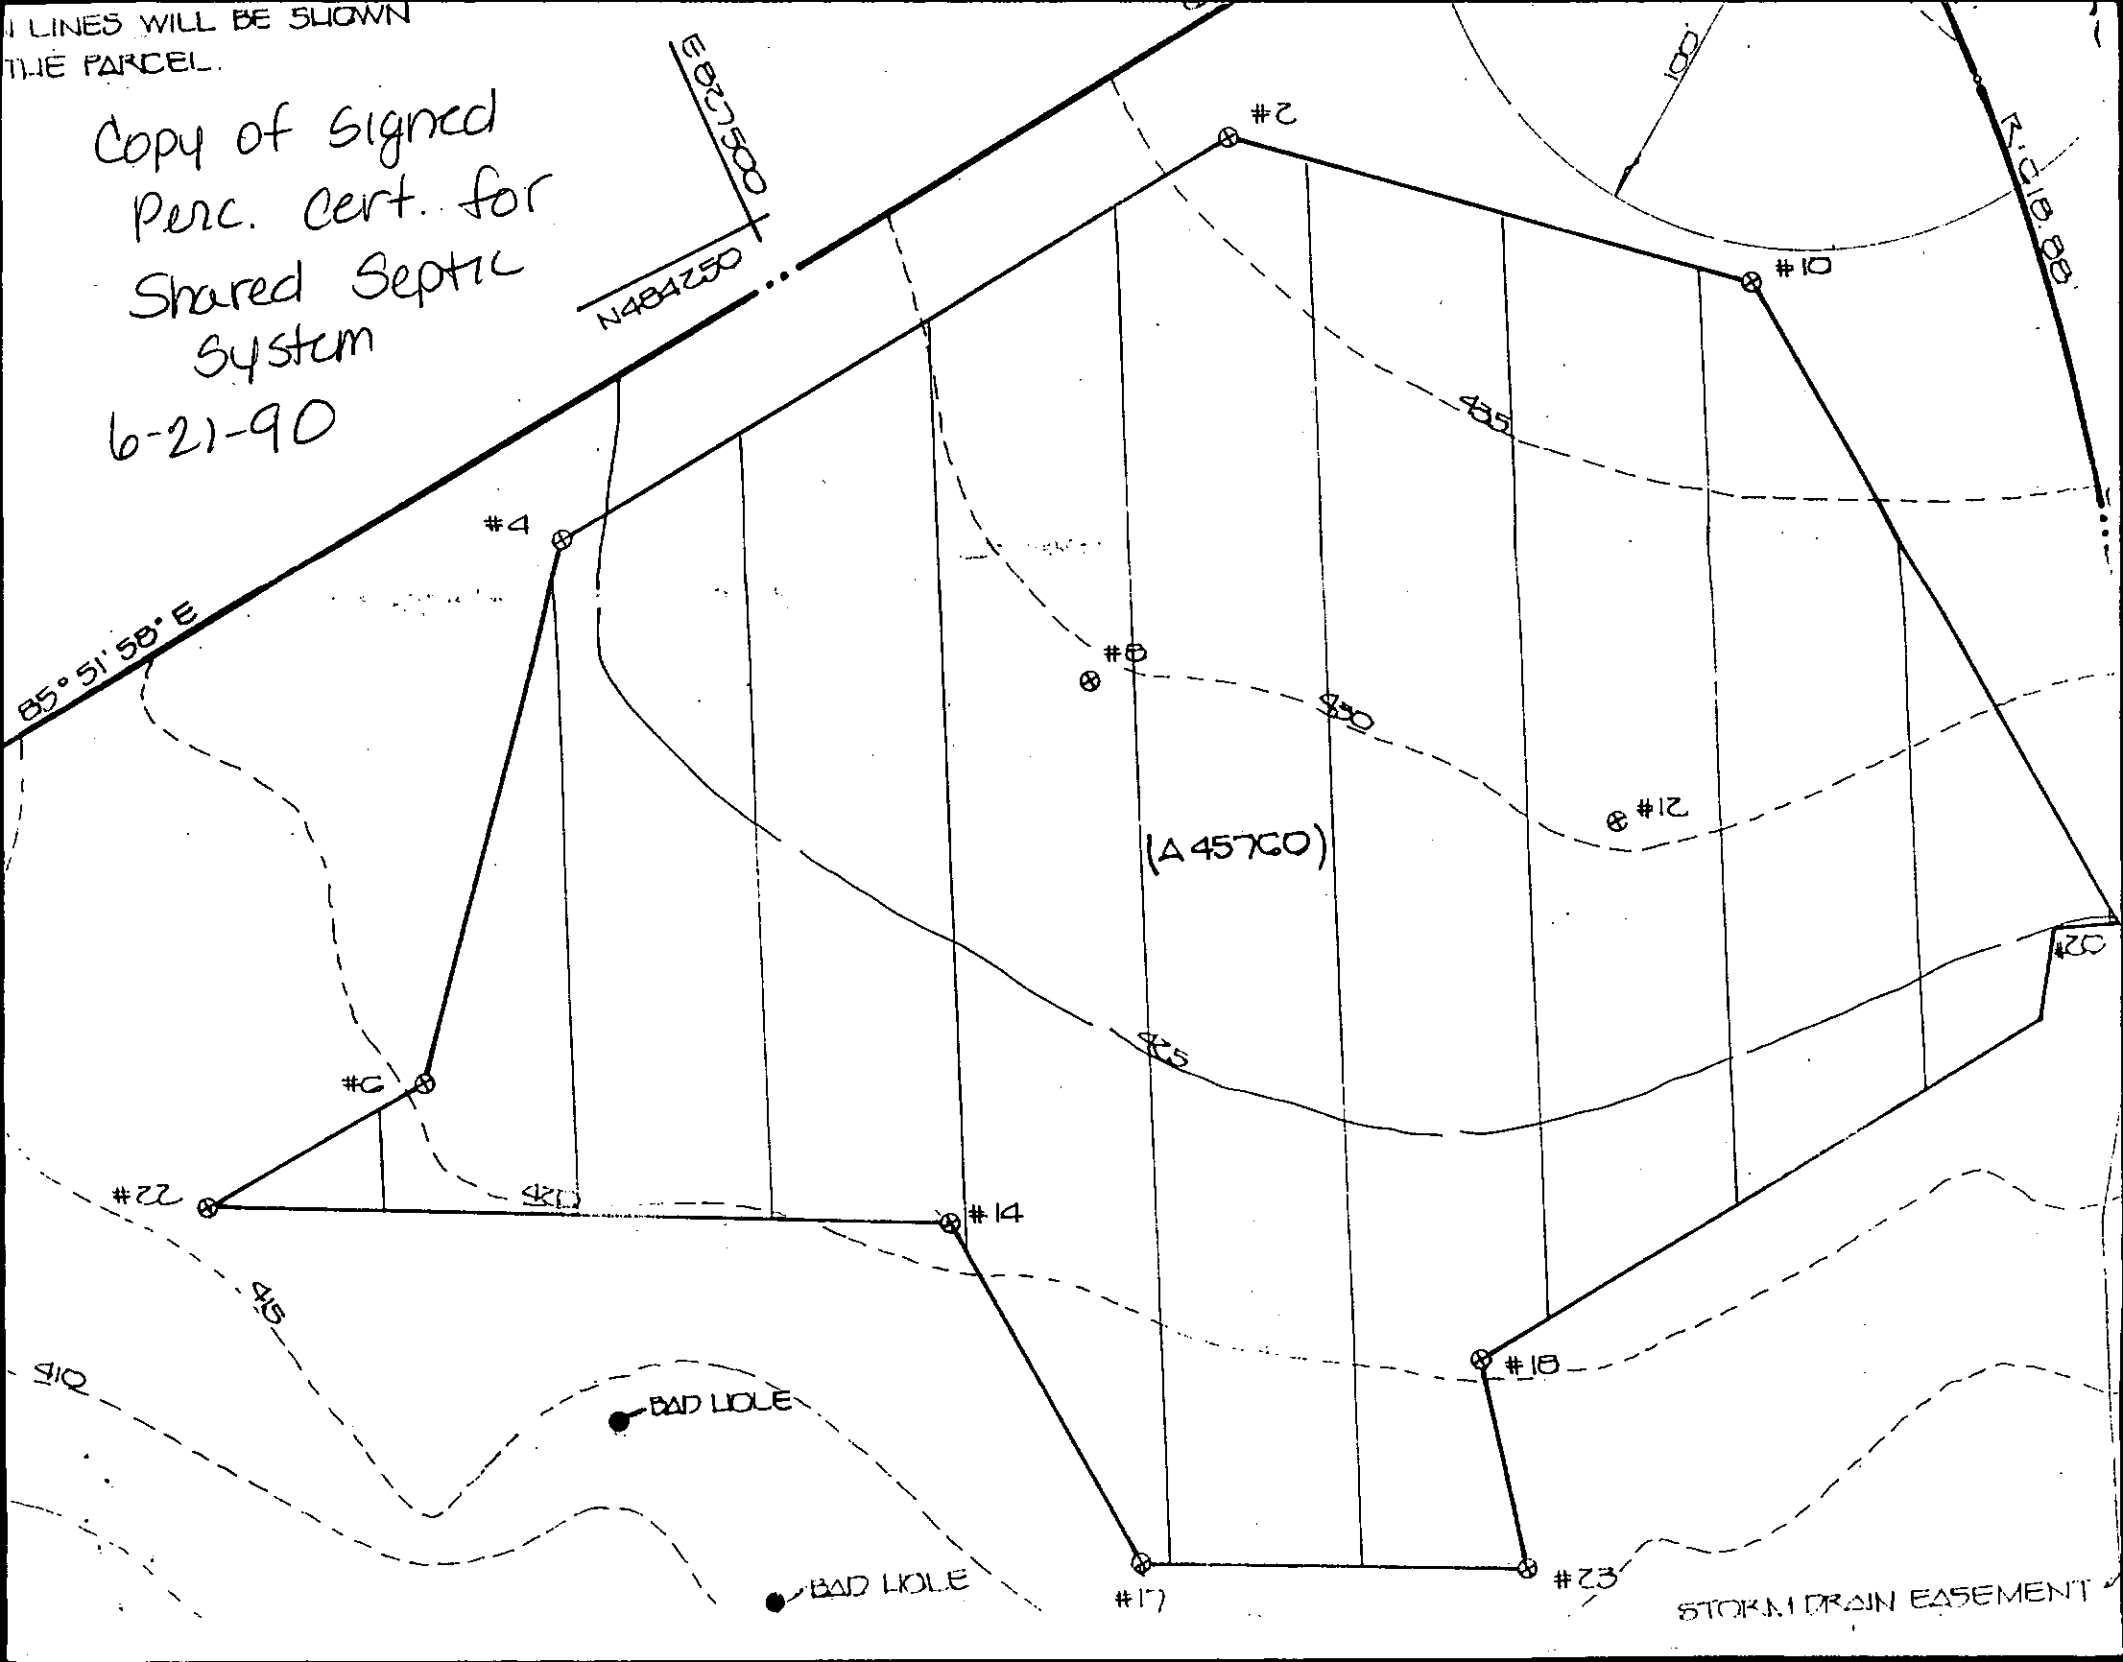

C1 7985 SEQUENCE NO. (MDE USE ONLY)

STATE OF MARYLAND
WELL COMPLETION REPORTFILL IN THIS FORM COMPLETELY
PLEASE PRINT OR TYPETHIS REPORT MUST BE SUBMITTED WITHIN
45 DAYS AFTER WELL IS COMPLETED.COUNTY
NUMBER A45760BST/CO. USE ONLY
DATE Received

082696

DATE WELL COMPLETED

081496

Depth of Well

22 325 26
(TO NEAREST FOOT)PERMIT NO.
FROM "PERMIT TO DRILL WELL"

H0-99-0875

OWNER H.P. PARTNERSHIP
STREET OR RFD last name SANNER RD. first name TOWN SCAGGSVILLE
SUBDIVISION CASHMARK SECTION LOT 2

WELL LOG

Not required for driven wells

STATE THE KIND OF FORMATIONS
PENETRATED, THEIR COLOR, DEPTH,
THICKNESS AND IF WATER BEARINGDESCRIPTION (Use
additional sheets if needed)

FEET

FROM

TO

check
if water
bearing

Topsoil

0 2

Sandy

2 20

Sandstone

20 25

MICKA

25 95

Sandstone

95 100

MICKA

100 325

GROUTING RECORD

WELL HAS BEEN GROUTED
(Circle Appropriate Box)

TYPE OF GROUTING MATERIAL (Circle one)

CEMENT C M BENTONITE CLAY B C

NO. OF BAGS 19 NO. OF POUNDS 1700

GALLONS OF WATER 114

DEPTH OF GROUT SEAL (to nearest foot)

from 0 ft. to 30 ft.

(enter 0 if from surface)

CASING RECORD

casing
types
insert
appropriate
code
below

S T

STEEL

C O

CONCRETE

P L

PLASTIC

O T

OTHER

MAIN
CASING
TYPENominal diameter
top (main) casing
(nearest inch)Total depth
of main casing
(nearest foot)

P L

6 63 64

80 66 70

OTHER CASING (if used)

diameter

depth (feet)

inch

from to

screen type
or open hole
insert
appropriate
code
below

SCREEN RECORD

S T

STEEL

B R

BRASS

BRONZE

P L

PLASTIC

H O

OPEN

HOLE

O T

OTHER

C 2

DEPTH (nearest ft.)

H0 28 325

8 9 11 15 17 21

23 24 26 30 32 36

38 39 41 45 47 51

SLOT SIZE 1 2 3

DIAMETER OF SCREEN 56 60

(NEAREST INCH)

GRAVEL PACK

IF WELL DRILLED WAS

FLOWING WELL INSERT

F IN BOX 68

MDE USE ONLY

(NOT TO BE FILLED IN BY DRILLER)

T (E.R.O.S.) W Q

70 72 74 75 76

TELESCOPE CASING LOG INDICATOR OTHER DATA

C 3

PUMPING TEST

HOURS PUMPED (nearest hour) 3

PUMPING RATE (gal. per min.) 4

METHOD USED TO MEASURE PUMPING RATE Bulk

WATER LEVEL (distance from land surface)

BEFORE PUMPING 27 ft.

WHEN PUMPING 105 ft.

TYPE OF PUMP USED (for test)

A air P piston T turbine

C centrifugal R rotary O other (describe below)

J jet S submersible

PUMP INSTALLED

DRILLER WILL INSTALL PUMP (CIRCLE) (YES OR NO) YES NO

IF DRILLER INSTALLS PUMP, THIS SECTION
MUST BE COMPLETED FOR ALL WELLS.TYPE OF PUMP INSTALLED
PLACE (A,C,J,P,R,S,T,O)
IN BOX 29CAPACITY:
GALLONS PER MINUTE
(to nearest gallon)

PUMP HORSE POWER

PUMP COLUMN LENGTH
(nearest ft.)CASING HEIGHT (circle appropriate box
and enter casing height)

+ above

- below

LAND SURFACE

(nearest foot)

LOCATION OF WELL ON LOT

SHOW PERMANENT STRUCTURE SUCH AS
BUILDING, SEPTIC TANKS, AND /OR
LANDMARKS AND INDICATE NOT LESS
THAN TWO DISTANCES
(MEASUREMENTS TO WELL)

Prop Line

300'

well

NUMBER OF UNSUCCESSFUL WELLS: 0

WELL HYDROFRACTURED- YES Y NO N

CIRCLE APPROPRIATE LETTER

- A A WELL WAS ABANDONED AND SEALED
WHEN THIS WELL WAS COMPLETED
- E ELECTRIC LOG OBTAINED
- P TEST WELL CONVERTED TO PRODUCTION
WELL

I HEREBY CERTIFY THAT THIS WELL HAS BEEN CONSTRUCTED IN
ACCORDANCE WITH COMAR 26.04.04 "WELL CONSTRUCTION" AND
IN CONFORMANCE WITH ALL CONDITIONS STATED IN THE ABOVE
CAPTIONED PERMIT, AND THAT THE INFORMATION PRESENTED
HEREIN IS ACCURATE AND COMPLETE TO THE BEST OF MY
KNOWLEDGE.TYPE: MWD/MSD/MGD
DRILLERS LIC. NO. 116



DRILLERS SIGNATURE

(MUST MATCH SIGNATURE ON APPLICATION)

LIC. NO. 117



SITE SUPERVISOR (sign. of driller or journeyman
responsible for sitework if different from permittee)

COUNTY

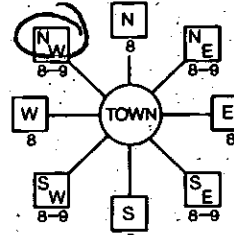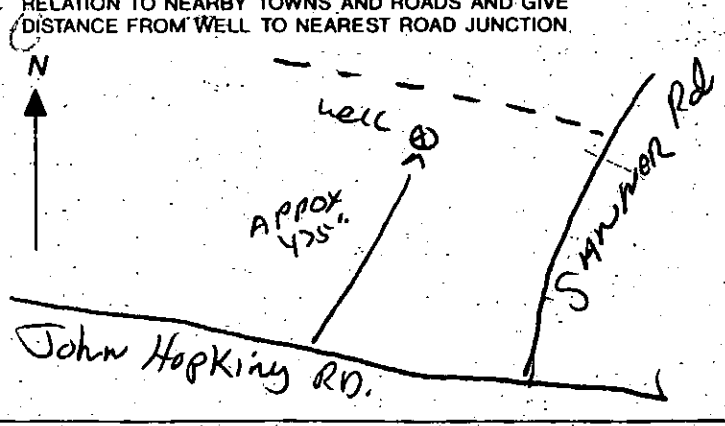B 1 3299 (THIS NUMBER IS TO BE PUNCHED IN COLS. 3-6 ON ALL CARDS)	SEQUENCE NO. (MDE USE ONLY)	STATE OF MARYLAND PERMIT TO DRILL WELL please print or type	STATE PERMIT NUMBER H0-94-0875 70 fill in this form completely 78
OWNER INFORMATION Date Received (APA) 062296 HOPKINS PLAZA PART 15 Last Name 34 Owner First Name 10805 HICKORY RIDGE 36 Street or RFD 65 COLUMBIA MO 21044 57 Town 70 State 72 Zip 76		B 3 LOCATION OF WELL HOWARD 8 COUNTY 21 CASHMARK PROPERTY 23 SUBDIVISION 42 SECTION 11 LOT 2 44 46 48 50 SCAGGSVILLE 52 NEAREST TOWN 71 MILES FROM TOWN (enter 0 if in town) 2 M I 73 76 77 78	
DRILLER INFORMATION CIRCLE: MSD / MGD / MWD Ralph MAYNE Driller's Name 77 License No. 80 Ralph MAYNE Well Drilling Firm Name 9120 Brown Church Rd. Mt. Airy Address Ralph Mayne 6/13/96 Signature Date		B 4 DIRECTION OF WELL FROM TOWN (CIRCLE BOX)  NEAR WHAT ROAD John Hopkins Rd. 11 30 ON WHICH SIDE OF ROAD (CIRCLE APPROPRIATE BOX) WEST ☒ EAST ☐ NORTH ☐ SOUTH ☐ DISTANCE FROM ROAD 475 34 37 ENTER FT OR MI FT 38 39 TAX MAP: 41 BLK: _____ PARCEL: 121	
B 2 WELL INFORMATION APPROX. PUMPING RATE (GAL. PER MIN.) 5 2 8 12 AVERAGE DAILY QUANTITY NEEDED (GAL. PER DAY) 500 14 20		NOT TO BE FILLED IN BY DRILLER HEALTH DEPARTMENT APPROVAL Howard A 75760-B COUNTY NAME COUNTY NO. STATE SIGNATURE _____ INSERT S ☐ DATE ISSUED 073096 C. Wheeler 7/29/97 43 48 CO SIGNATURE EXP. DATE NORTH GRID 483000 EAST GRID 083000 50 55 57 63	
USE FOR WATER (CIRCLE APPROPRIATE BOX) ☒ D HOME (SINGLE OR DOUBLE HOUSEHOLD UNIT ONLY) ☐ F FARMING (LIVESTOCK WATERING & AGRICULTURAL IRRIGATION) ☐ I INDUSTRIAL, COMMERCIAL, STATE AND FEDERAL GOV. OTHER (REQUIRES APPROPRIATION PERMIT) ☐ P PUBLIC OR PRIVATE WATER COMPANY (REQUIRES APPROPRIATION PERMIT AND STATE HEALTH DEPARTMENT APPROVAL) ☐ T TEST, OBSERVATION, MONITORING (MAY REQUIRE APPROPRIATION PERMIT)		SHOW MAJOR FEATURES OF BOX & LOCATE WELL WITH AN X SOURCES OF DRILLING WATER 1. well 2. 3. WRITE THE BOX NUMBER FROM THE MAP HERE 830 E 820 N 4803 000 000	
APPROXIMATE DEPTH OF WELL 150 FEET 24 28 APPROXIMATE DIAMETER OF WELL 6" NEAREST INCH		8/14/96 325' 9:50 am 520 CASINGS PER 30 ORIENT } DRILLED 19 SACS (+) LOCATION OK SAMPLE CLEAR at 10:50 [Signature]	
METHOD OF DRILLING (circle one) BORED (or Augered) ☒ JETTED ☐ Jetted & DRIVEN ☐ AIR-ROTARY ☒ AIR-PERCussion ☐ ROTARY (Hydraulic Rotary) ☐ CABLE ☐ REVERSE-ROTARY ☐ DRIVE-POINT ☐ other _____		DRAW A SKETCH BELOW SHOWING LOCATION OF WELL IN RELATION TO NEARBY TOWNS AND ROADS AND GIVE DISTANCE FROM WELL TO NEAREST ROAD JUNCTION. 	
REPLACEMENT OR DEEPEMED WELLS (CIRCLE APPROPRIATE BOX) ☒ N THIS WELL WILL NOT REPLACE AN EXISTING WELL ☐ Y THIS WELL WILL REPLACE A WELL THAT WILL BE ABANDONED AND SEALED ☐ S THIS WELL WILL REPLACE A WELL THAT WILL BE USED AS A STANDBY-CONTACT LOCAL APPROVING AUTHORITY FOR POLICY ON STANDBY WELLS ☐ D THIS WELL WILL DEEPEMED AN EXISTING WELL PERMIT NUMBER OF WELL TO BE REPLACED OR DEEPEMED (IF AVAILABLE) _____		Not to be filled in by driller (MDE OR COUNTY USE ONLY) APPROX. PERMIT NUMBER _____ 54 63 FORCE CW WRITE INITIALS IN BOX PERMIT No. H0-94-0875 67 68 70 71 72 73 74 75 76 77 78 79	
SPECIAL CONDITIONS NOTE - APPROVING AUTHORITIES SHOULD USE SEPARATE SHEET IF NEEDED			

LINE TABLE		
LINE	BEARING	DISTANCE
1	N85°51'45"E	32.75
2	N87°58'39"W	21.41

CURVE TABLE					
CURVE	RADIUS	LENGTH	DELTA	CHRD.BEAR.	CHRD.DIST.
2	1677.02	8.00	00°16'24"	N01°53'09"E	8.00
1	108.00	28.56	15°08'02"	N86°33'44"W	28.47

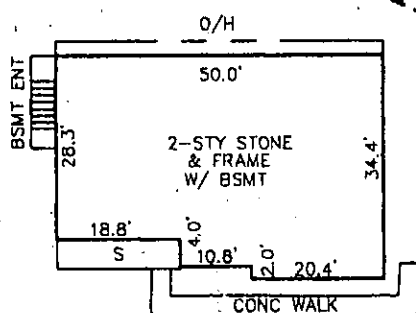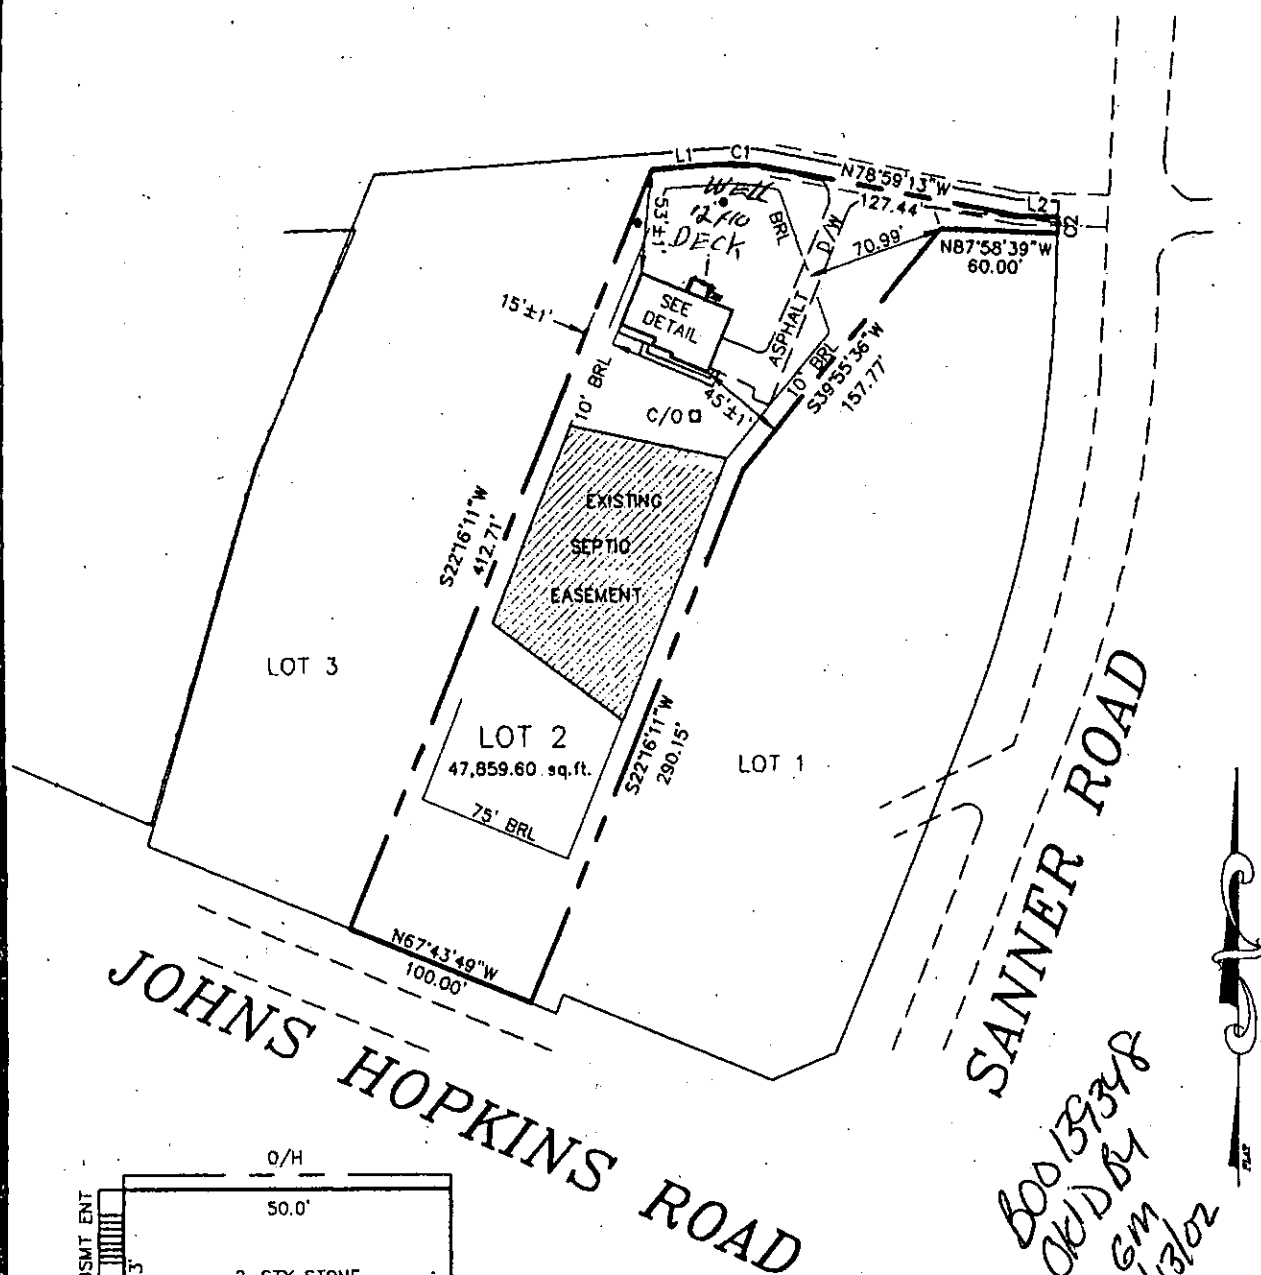

DETAIL
SCALE: 1" = 30'
TOP OF WALL ELEV. = 437.4'±
FIRST FLOOR ELEV. = 438.57

LEGEND

O/H = OVERHANG
H/P = HEAT PUMP/AIR COND.
G/M = GAS METER
E/M = ELECTRIC METER
F/P = FIREPLACE
B/W = BAY WINDOW
D/W = DRIVEWAY
CONC = CONCRETE
S = CONC STOOP
C/O = SEWER CLEANOUT

CASHMARK PROPERTY

LOTS 1 THRU 3 & PRES. PARCEL 'A'

PLAT No. 12405
ELECTION DISTRICT No. 5
HOWARD COUNTY, MARYLAND

THE INFORMATION SHOWN HAS BEEN ESTABLISHED BY CURRENT ACCEPTABLE SURVEY PROCEDURES AND FROM AVAILABLE RECORD INFORMATION. THIS DRAWING IS TO BE USED FOR TITLE TRANSFER FINANCING, OR REFINANCING ONLY AND IS NOT TO BE USED FOR THE ESTABLISHMENT OF PROPERTY LINES, LOCATION OF FENCES, GARAGES, BUILDINGS, OR OTHER EXISTING OR FUTURE IMPROVEMENTS.



**MILDENBERG
BOENDER, & ASSOC., INC.**

Engineers Planners Surveyors
5072 Dorsey Hall Drive, Suite 202, Ellicott City, Maryland 21042
(410) 997-0298 Balt. (301) 621-5521 Wash. (410) 997-0298 Fax

FOUNDATION	DATE: 10/06/98	FINAL	DATE: 05/13/99
DRAWN BY: T. HILL	SCALE: 1" = 100'		
PROJECT NO.: 97114	LOCATION DRAWING		

JOHN MILDENBERG
PROF. LAND SURVEYOR
MARYLAND NO. 10718