

01-176471

PERMIT

SEWAGE DISPOSAL SYSTEM

MARYLAND STATE DEPARTMENT OF HEALTH

HOWARD COUNTY
BUREAU OF ENVIRONMENTAL HEALTH
461-9933

P 45596

A REPAIR

DISTRICT 1stDATE 2/23/90DATE SYSTEM APPROVED 2/23/90INSPECTOR RH

INDEXED

John H. Charney

IS PERMITTED TO INSTALL ☒ ALTER ☐ADDRESS 3801 Offutt Road, Randallstown, Maryland 21133PHONE 521-5547SUBDIVISION _____ ROAD 4851 Wharff Lane

LOT _____

PROPERTY OWNER John C. Pickett4851 Wharff LaneADDRESS Ellicott City, Maryland

IF GARBAGE GRINDER IS USED INCREASE SEPTIC TANK CAPACITY BY 50% AND ABSORPTION AREA BY 22%.

GARBAGE GRINDER? YES _____ NO _____

SEPTIC TANK CAPACITY 7 GALLONSNUMBER OF BEDROOMS 3

REPAIR - CALL FOR INSPECTION WHEN GROUND IS OPENED SO SANITARIAN CAN RECOMMEND REPAIR.

3/4/90 LIGHT SITUATION - TILE FIELD - 3-4 FT DEEP 1 1/2 TO 2 FT - 3 FT WIDE

STONE 125 FT LONG RUN NEW TRENCHES OFF

OLD ~~PIPE~~ BE PLACE OLD DISTRIBUTION BOX (RH)

3/23/90 - OK TO CHANGE SYSTEM TO 5 FT DEEP

3 FT OR STONE 3 FT WIDE & 90 FT LONG

PLANS APPROVED BY

C. Williams

GOOD SOIL ROUND

DATE 2/16/90

COVER NO WORK UNTIL INSPECTED AND APPROVED

AT DEEPER DEPTH

NEITHER THE HOWARD COUNTY COUNCIL NOR THE HEALTH DEPARTMENT IS RESPONSIBLE FOR THE SUCCESSFUL OPERATION OF ANY SYSTEM

NOTE: CLEANOUT REQUIRED EVERY 70 FEET OF SEWER LINE AND/OR AT 90° SWEEPS IN LINES FROM HOUSE TO DRAIN FIELDS

NOTE: ALL PARTS OF SEPTIC SYSTEMS (I.E. TANK, DISTRIBUTION BOX, TRENCHES) TO BE 100 FEET FROM WELL (UNLESS OTHERWISE SPECIFICALLY AUTHORIZED)

NOTE: IF DEEP TRENCHES ARE USED CALL FOR INSPECTION BEFORE AND AFTER PLACING GRAVEL IN TRENCHES

NOTE: NO DRY WELL SHALL EXCEED 15 FOOT IN DIAMETER NO ABSORPTION TRENCH TO EXCEED 100 FEET IN LENGTH.

NOTE: ALL PIPE FROM HOUSE TO SEPTIC TANK MUST BE CAST IRON OR SCHEDULE 40 PVC OR ABS

PERMIT VOID AFTER TWO YEARS

NOTE: INSTALL STAND PIPE ON SEPTIC TANK AND DRY WELL. STAND PIPES MUST BE 6 INCHES IN DIAMETER. CAST IRON, CONCRETE OR TERRA COTTA OR PVC OR ABS ACCEPTED. IF TOP OF SEPTIC TANK IS DEEPER THAN 3 FEET, MANHOLE TO GRADE REQUIRED

NOTE: DISTRIBUTION BOXES MUST HAVE BAFFLES

*INSTALLER IS RESPONSIBLE FOR OBTAINING FINAL APPROVAL ON THIS PERMIT

*CALL 461-9933 FOR INSPECTION OF SEPTIC SYSTEMS.

P 45596

10/22/68

PERMIT

SEWAGE DISPOSAL SYSTEM

MARYLAND STATE DEPARTMENT OF HEALTH

HOWARD COUNTY

ELLICOTT CITY

DISTRICT 1

INDEXED

DATE 10/15/68

Richard Lowe

IS PERMITTED TO INSTALL X ALTER

ADDRESS Ilchester Road, Ellicott City, Md. PHONE RI 7-7598

A SEWAGE DISPOSAL SYSTEM LOCATED AT _____

SUBDIVISION _____ ROAD Wharff Lane - LOT _____
(See application for directions)

PROPERTY OWNER John C. Pickett & wife

ADDRESS _____

SPECIFICATIONS - 3 bedrooms

DRAIN FIELD _____ DEPTH _____ FEET, BOTTOM AREA _____ SQ. FT.

SEEPAGE PITS _____ ABSORBENT SIDE-WALL AREA _____ SQ. FT.

SEPTIC TANK CAPACITY 750 GALLONS

FOR GARBAGE GRINDER, INCREASE DISPOSAL AREA 22% & TANK CAPACITY 50%.

OTHER Tile field to be 300 sq. ft. bottom area. Place drain field in area
between 20 ft. and 80 ft. from front lot line and between 110 and 170 ft. from
right side line, as seen from facing lot from Wharff Lane. Max. depth 3½ ft.
from original grade.

PERMIT VOID AFTER THREE YEARS.


PLANS APPROVED BY James T. wright DATE 7/9/68

FILL SEPTIC TANK AND DISTRIBUTION BOX WITH WATER BEFORE CALLING FOR AN INSPECTION. COVER NO WORK UNTIL INSPECTED AND APPROVED.

NEITHER THE HOWARD COUNTY COMMISSIONERS NOR THE HEALTH DEPARTMENT IS RESPONSIBLE FOR THE SUCCESSFUL OPERATION OF ANY SYSTEM.

**NOTIFY THE HEALTH DEPARTMENT 48 HOURS
BEFORE EXCAVATIONS ARE TO BE BACK FILLED.**

A 13707

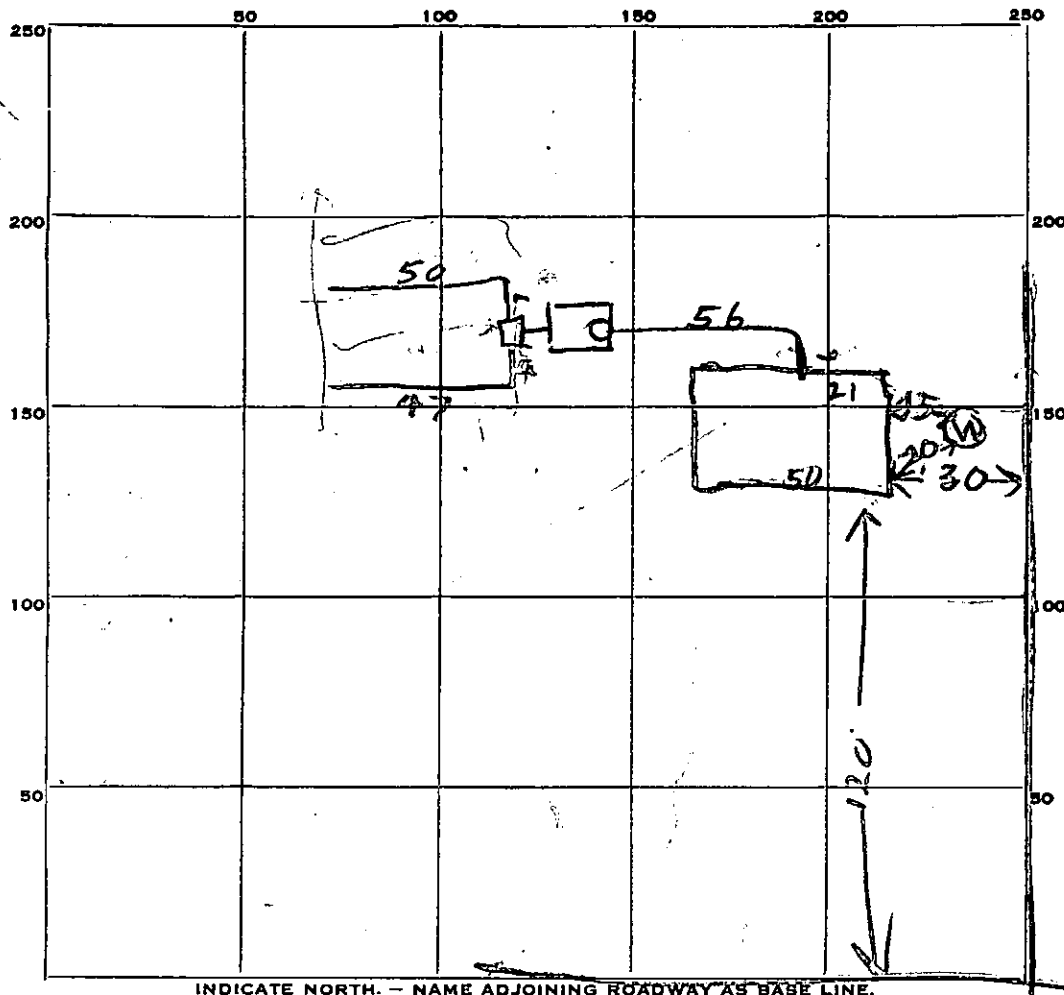

PERMIT CARD OK

SEPTIC TANK, LEVEL OK 750 concrete

CLEANOUTS OK

DISTRIBUTION BOX, LEVEL Top about 1 FT below original grade

TILE FIELD, DEPTH 3-4 1/2 FT. TRENCH WIDTH 3 FT.

GRAVEL DEPTH 24 IN. TOTAL LENGTH 103 FT.

NUMBER OF TRENCHES 2 TOTAL BOTTOM AREA 3.09



SEEPAGE PITS, INSIDE DIAMETER _____ FT. DEPTH BELOW INLET _____ FT.

ABSORBENT AREA _____ SQ. FT.

REMARKS _____

DATE SYSTEM APPROVED 10/23/68

INSPECTOR Raymond Hayes

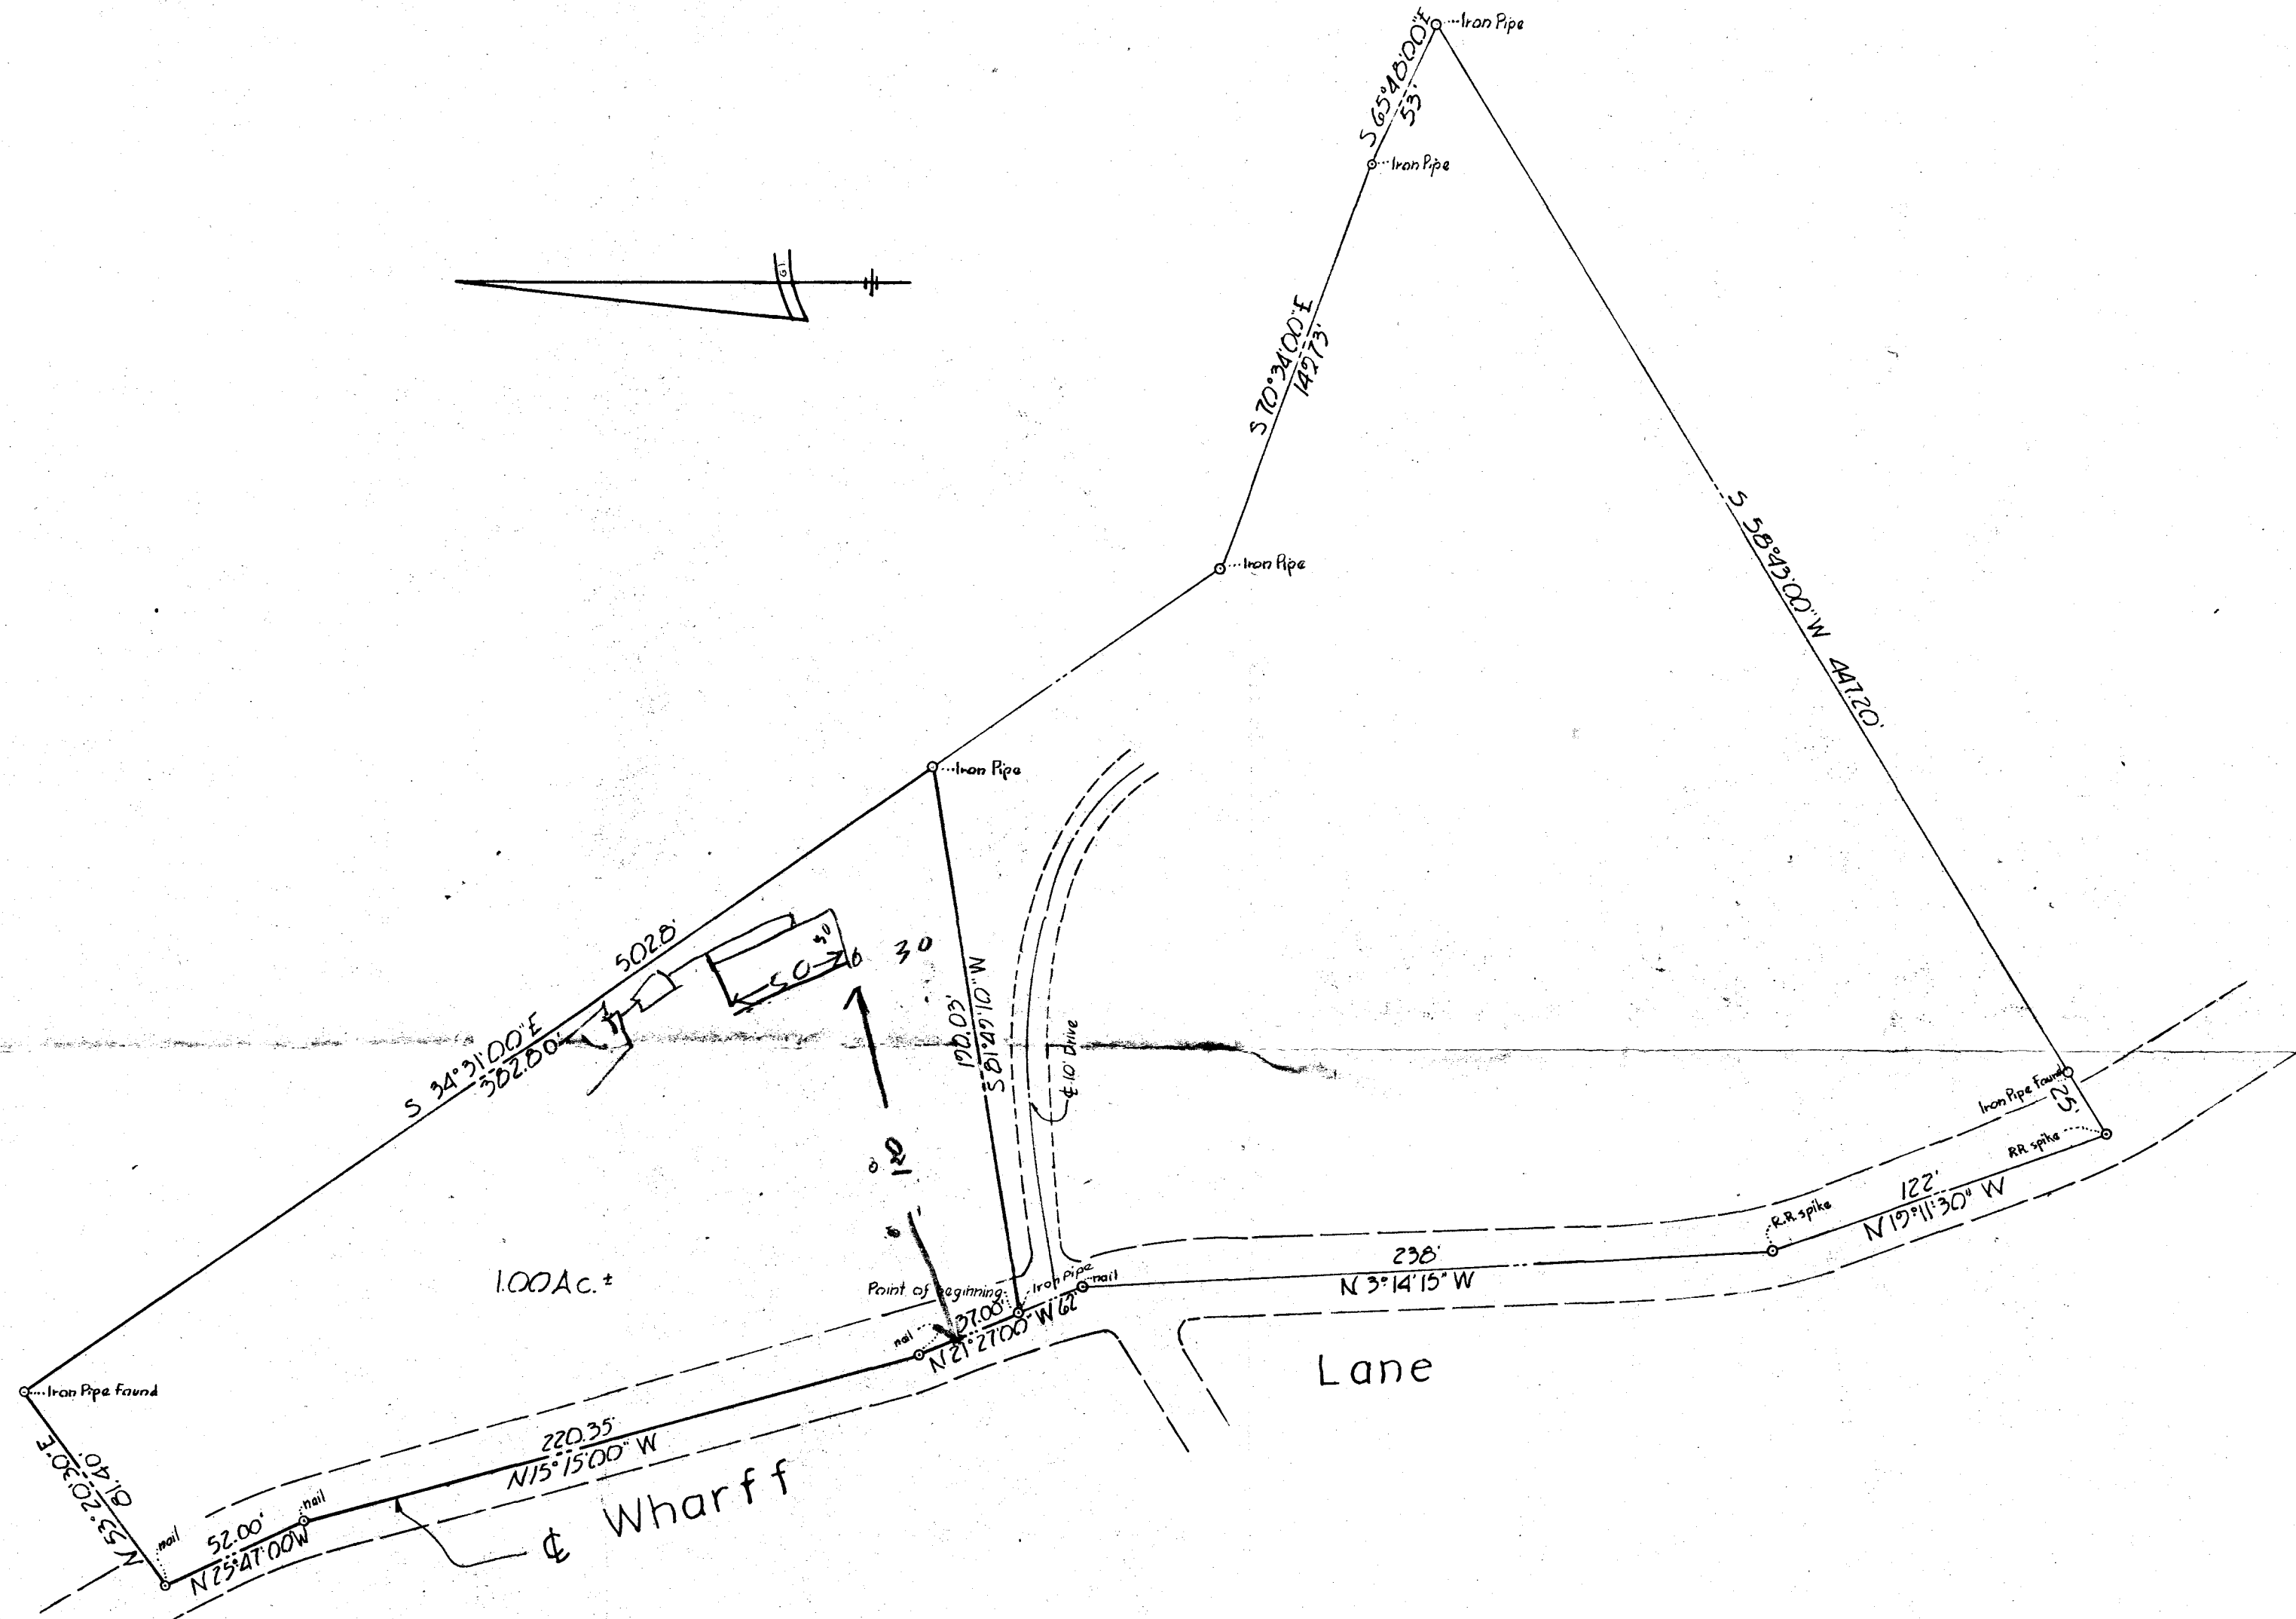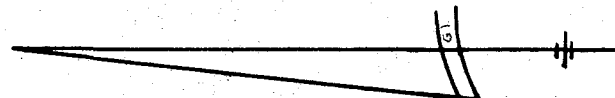

W. J. Purdum
Purdum & Jeschke
Engineers & Land Surveyors
24 Park Avenue
Ellicott City, Maryland 21043

Property of
MILTON AGETSTEIN ET UX
1st Election District
Howard County, Maryland
April 12, 1968
Scale 1" = 50'

APPLICATION

SEWAGE DISPOSAL TESTING

A 13707

P

MARYLAND STATE DEPARTMENT OF HEALTH

HOWARD COUNTY

ELLICOTT CITY

DISTRICT 1

DATE 7/3/68

*Septic to be 750 gall
Tile field to be ~~300~~ 300 ft between area, etc.
Place Drain field in area between 20 ft and 80 ft
from front lot line and between 110 and 170 from Right
side line. as seen from facing lot from Wharff Lane.*

TO: THE COUNTY HEALTH OFFICER
ELLICOTT CITY, MARYLAND

I, HEREBY, APPLY FOR THE NECESSARY TESTS IN ORDER TO CONSTRUCT (OR RECONSTRUCT) A SEWAGE DISPOSAL SYSTEM.

PROPERTY OWNER John C. Pickett & wife

ADDRESS 29 Montrose Manor Court, Baltimore 21228 PHONE 744-4003

PROPERTY LOCATION:

SUBDIVISION _____ LOT NO. _____

ROAD AND DESCRIPTION Wharff Lane - off Ilchester Rd. - next road beyond Richard
turn left -
Lowe's Riding Academy - ~~right side~~ approx. 1/4 mile back
right side - test in back

OCCUPANT _____ PHONE _____

PERSON TO CONSTRUCT SYSTEM _____

ADDRESS _____ PHONE _____

SIZE OF LOT 1 acre TYPE BLDG. 3

(Single Family Dwllg.)

IF NOT SINGLE RESIDENCE DESCRIBE _____

SIGNATURE OF APPLICANT John C. Pickett

APPROVED BY James T. Wright FOR Drain Field DATE 7/8/68

(KIND OF SYSTEM)

REJECTED BY _____ FOR _____ DATE _____

(KIND OF SYSTEM)

HOLD PENDING FURTHER TESTS _____ DATE _____

REASONS FOR REJECTION OR HOLDING _____

THIS IS NOT A PERMIT

