

04-352629

PERMIT

File

SEWAGE DISPOSAL SYSTEM

DEPARTMENT OF HEALTH AND MENTAL HYGIENE

HOWARD COUNTY HEALTH DEPARTMENT

BUREAU OF ENVIRONMENTAL HEALTH

461-9933

INDEXED

P 47815

A 46074

DISTRICT 4th

DATE 3/6/92

DATE SYSTEM APPROVED 3/25/92

INSPECTOR C.B.D.

CHARLES SHAW & CO.

IS PERMITTED TO INSTALL ☒ ALTER

ADDRESS 7040 ROUTE 32 - CLARKSVILLE PHONE 531-5405

SUBDIVISION Scarlett Ridge LOT 4 ROAD 14943 Roxbury Road

PROPERTY OWNER Mr. & Mrs. Harold Clark

ADDRESS

SEPTIC TANK CAPACITY 1000 GALLONS

NUMBER OF BEDROOMS 3

180 SQUARE FEET PER BEDROOM

LINEAR FEET OF TRENCH REQUIRED 180

TRENCHES - Trench to be 3.0 feet wide. Inlet 5.5 feet below original grade. Bottom maximum depth 7.5 feet below original grade. Effective area begins at 5.5 feet below original grade. 2.0 feet of stone below distribution pipe.

LOCATION - Beginning at the front right lot corner, as seen from Roxbury Road, place the distribution box 260 feet down the right (212.91'/430.38') lot line and 150 feet off the same lot line. Run trenches along contour toward the right lot line. Maintain a minimum of 100 feet from the well. P.B. 30' off right lot line.

NOTE - No trench to exceed 100 feet in length. Provide 6" - 8" diameter cleanout and cap to grade or above on septic tank. 10/11/91 OK RIT

PLANS APPROVED BY Jane E. Nadeau cm DATE 7/25/91

COVER NO WORK UNTIL INSPECTED AND APPROVED

NEITHER THE HOWARD COUNTY COUNCIL NOR THE HEALTH DEPARTMENT IS RESPONSIBLE FOR THE SUCCESSFUL OPERATION OF ANY SYSTEM

NOTE: CLEANOUT REQUIRED EVERY 70 FEET OF SEWER LINE AND/OR AT 90° SWEEPS IN LINES FROM HOUSE TO DRAIN FIELDS, 90° ELBOWS NOT ACCEPTABLE.

NOTE: ALL PARTS OF SEPTIC SYSTEMS (I.E. TANK, DISTRIBUTION BOX TRENCHES) TO BE 100 FEET FROM WELL (UNLESS OTHERWISE SPECIFICALLY AUTHORIZED)

NOTE: IF DEEP TRENCH(ES) ARE USED CALL FOR INSPECTION BEFORE AND AFTER PLACING GRAVEL IN TRENCH(ES)

NOTE: NO DRY WELL SHALL EXCEED 15 FOOT IN DIAMETER NO ABSORPTION TRENCH TO EXCEED 100 FEET IN LENGTH

NOTE: ALL PIPE FROM HOUSE TO SEPTIC TANK MUST BE CAST IRON OR SCHEDULE 35/40 PVC OR ABS

PERMIT VOID AFTER TWO YEARS

NOTE: INSTALL STAND PIPE ON SEPTIC TANK AND DRY WELL STAND PIPES MUST BE 6 INCHES IN DIAMETER CAST IRON. CONCRETE OR TERRA COTTA OR PVA OR ABS ACCEPTED. IF TOP OF SEPTIC TANK IS DEEPER THAN 3 FEET. MANHOLE TO GRADE REQUIRED.

NOTE: DISTRIBUTION BOXES MUST HAVE BAFFLES

*INSTALLER IS RESPONSIBLE FOR OBTAINING FINAL APPROVAL ON THIS PERMIT

HD-260(6-90)

*CALL 461-9933 FOR INSPECTION OF SEPTIC SYSTEM.

46074

15:58 FISHER, COLLINS & CARTER P. 92

APPLICATION

PERCOLATION TESTING

A 46074

P _____

HOWARD COUNTY HEALTH DEPARTMENT
BUREAU OF ENVIRONMENTAL HEALTH
P.O. BOX 476 ELLICOTT CITY MARYLAND 21043
TELEPHONE 461-9933

DISTRICT _____

DATE _____

TO: THE COUNTY HEALTH OFFICER
ELLICOTT CITY, MARYLAND

I, HEREBY, APPLY FOR THE NECESSARY TEST IN ORDER TO CONSTRUCT OR RECONSTRUCT A SEWAGE DISPOSAL SYSTEM.

PROPERTY OWNER Edgewood Farms Inc.

ADDRESS P.O. Box 189 Glenelg, MD 21737 PHONE 531-3455

PROSPECTIVE BUYER None

ADDRESS NA PHONE NA

PROPERTY LOCATION:

SUBDIVISION Clark Property ~~SCARLET~~ Ridge LOT NO 10 4 (Final F-91-119)

ROAD AND DESCRIPTION Roxbery Mill Road. One mile South of Triadelphia
Property on Left.

TAX MAP 21 PARCEL # 63

SIZE OF LOT 3. TYPE BLDG Single

(SINGLE FAMILY DWELLING OR COMMERCIAL)

THE SYSTEM INSTALLED UNDER THIS APPLICATION IS ACCEPTABLE ONLY UNTIL PUBLIC FACILITIES BECOME AVAILABLE. I FULLY UNDERSTAND THE FEE CONNECTED WITH THE FILING OF THIS PERC TEST APPLICATION IS NON-REFUNDABLE UNDER ANY CIRCUMSTANCES. I ALSO AGREE TO COMPLY WITH ALL M.O.S.H.A. REQUIREMENTS IN TESTING THIS LOT.

Harold L. Clark
(SIGNATURE OF APPLICANT)

APPROVED BY _____ FOR _____ DATE _____

REJECTED BY _____ FOR _____ DATE _____

HOLD PENDING FURTHER TESTS _____ DATE _____

REASONS FOR REJECTION OR HOLDING _____

SEAL PERMIT REQUIRED

RECEIVED 10/1/96
Serial 39828-SFD-

3 Bedrooms

THIS IS NOT A PERMIT

A-46074

LOT 10

①

SOIL PROFILE


RED
BROWN
CLAYLIGHT
RED
BROWN
SILTY
LOAM

12 BOTTOM

③

RED
BROWN
clayRED
BROWN
SILTY
LOAM

BED ROCK

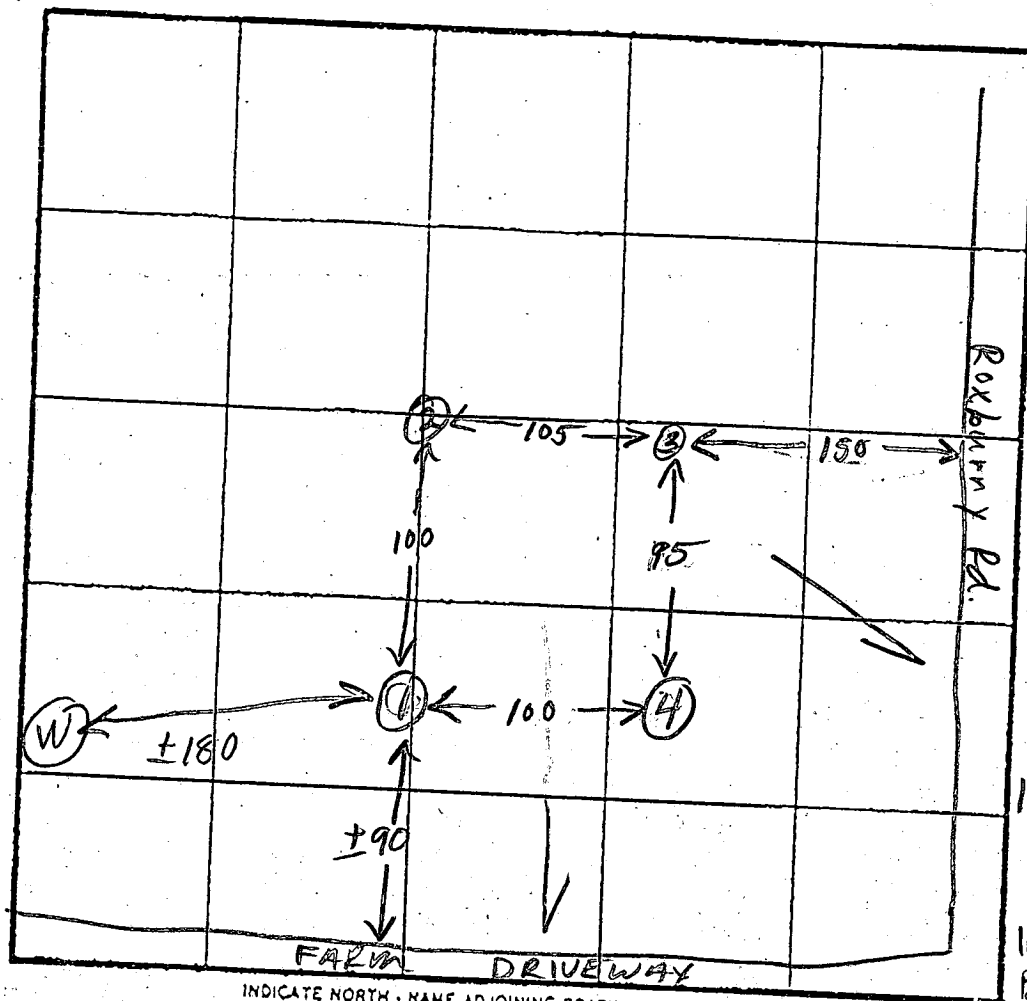

INDICATE NORTH - NAME ADJOINING ROADWAY AS BASE LINE.

$\bar{x} = 2 \text{ min}$
 Inlet = 5.5 ft
 Bottom 7.5 ft
 180 sq ft/bdrm

④

ORANGE
BROWN
CLAYRED
BROWN
SILTY
LOAM

13 BOTTOM

DATE	TEST NO.	DEPTH	PRE-WET		TEST - 1" DROP		TIME
			START	STOP	START	STOP	
6/21/90	1S	5	11:18:00		11:19:30	11:21:30	Failed
	1M	7 1/2	11:18:30	11:19:30	11:19:30	11:21:30	2 min
	1V	12	see Profile ①				
	2V	12	ORANGE BROWN CLAY to 6 see profile ①				
	3S	5	11:44	11:46	11:46	11:49	3 min
	3V	12	see Profile ③				
	4S	5	11:29	11:31	11:31	11:33	2 min
	4V	13	see Profile ④				
	15a	6	11:52	11:53	11:53	11:55	2 min

Rock at 12.0'

REMARKS


TYPE OF SOIL

TESTED BY

B. Adams

ALSO PRESENT

Copy of Prelim
Sent for Sig

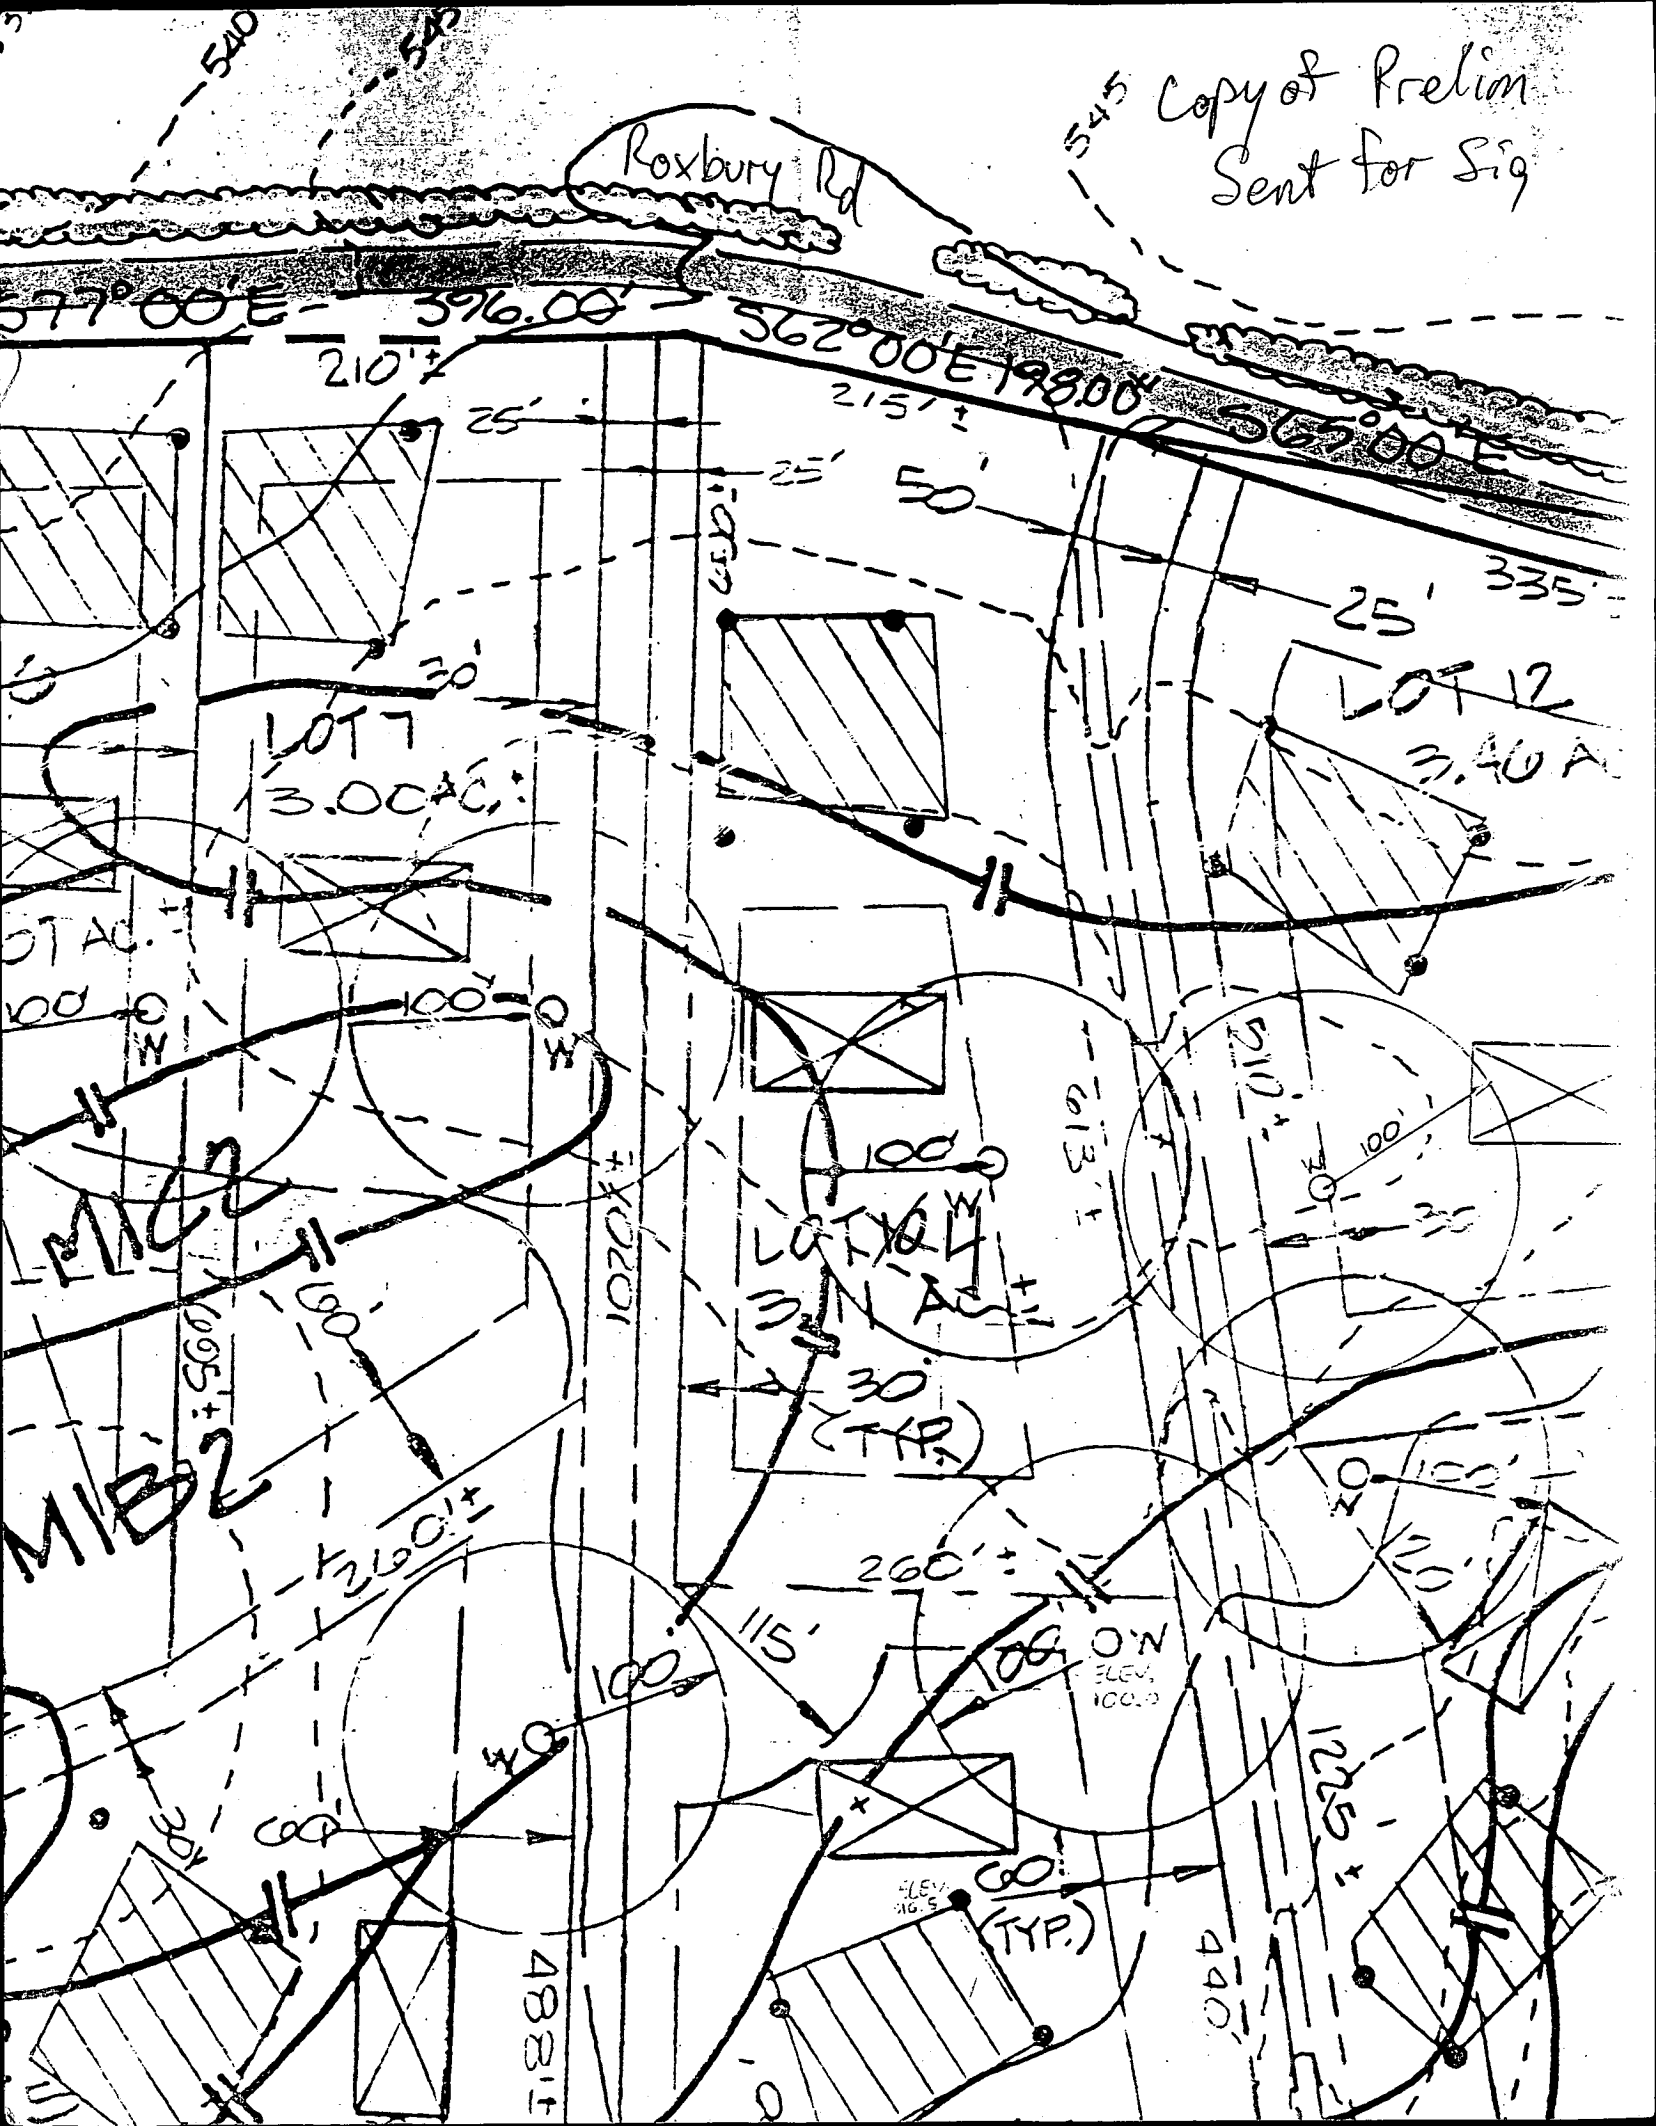

ROXBURY ROAD

TRENCH LENGTH TO BE
DETERMINED AT TIME OF
SEPTIC PERMIT ISSUANCE
BY HOWARD COUNTY


DISTRIBUTION BOX
INLET = 557.0
3'-0" BELOW GRADE

SEPTIC TANK
OUT = 558.0
IN = 558.25


SANITARY LINE
@ EXIT = 558.75'

FIRST FL = 564.17
BSMT = 554.0
(EJECT BSMT ONLY)

3 BED ROOMS
BP 39828

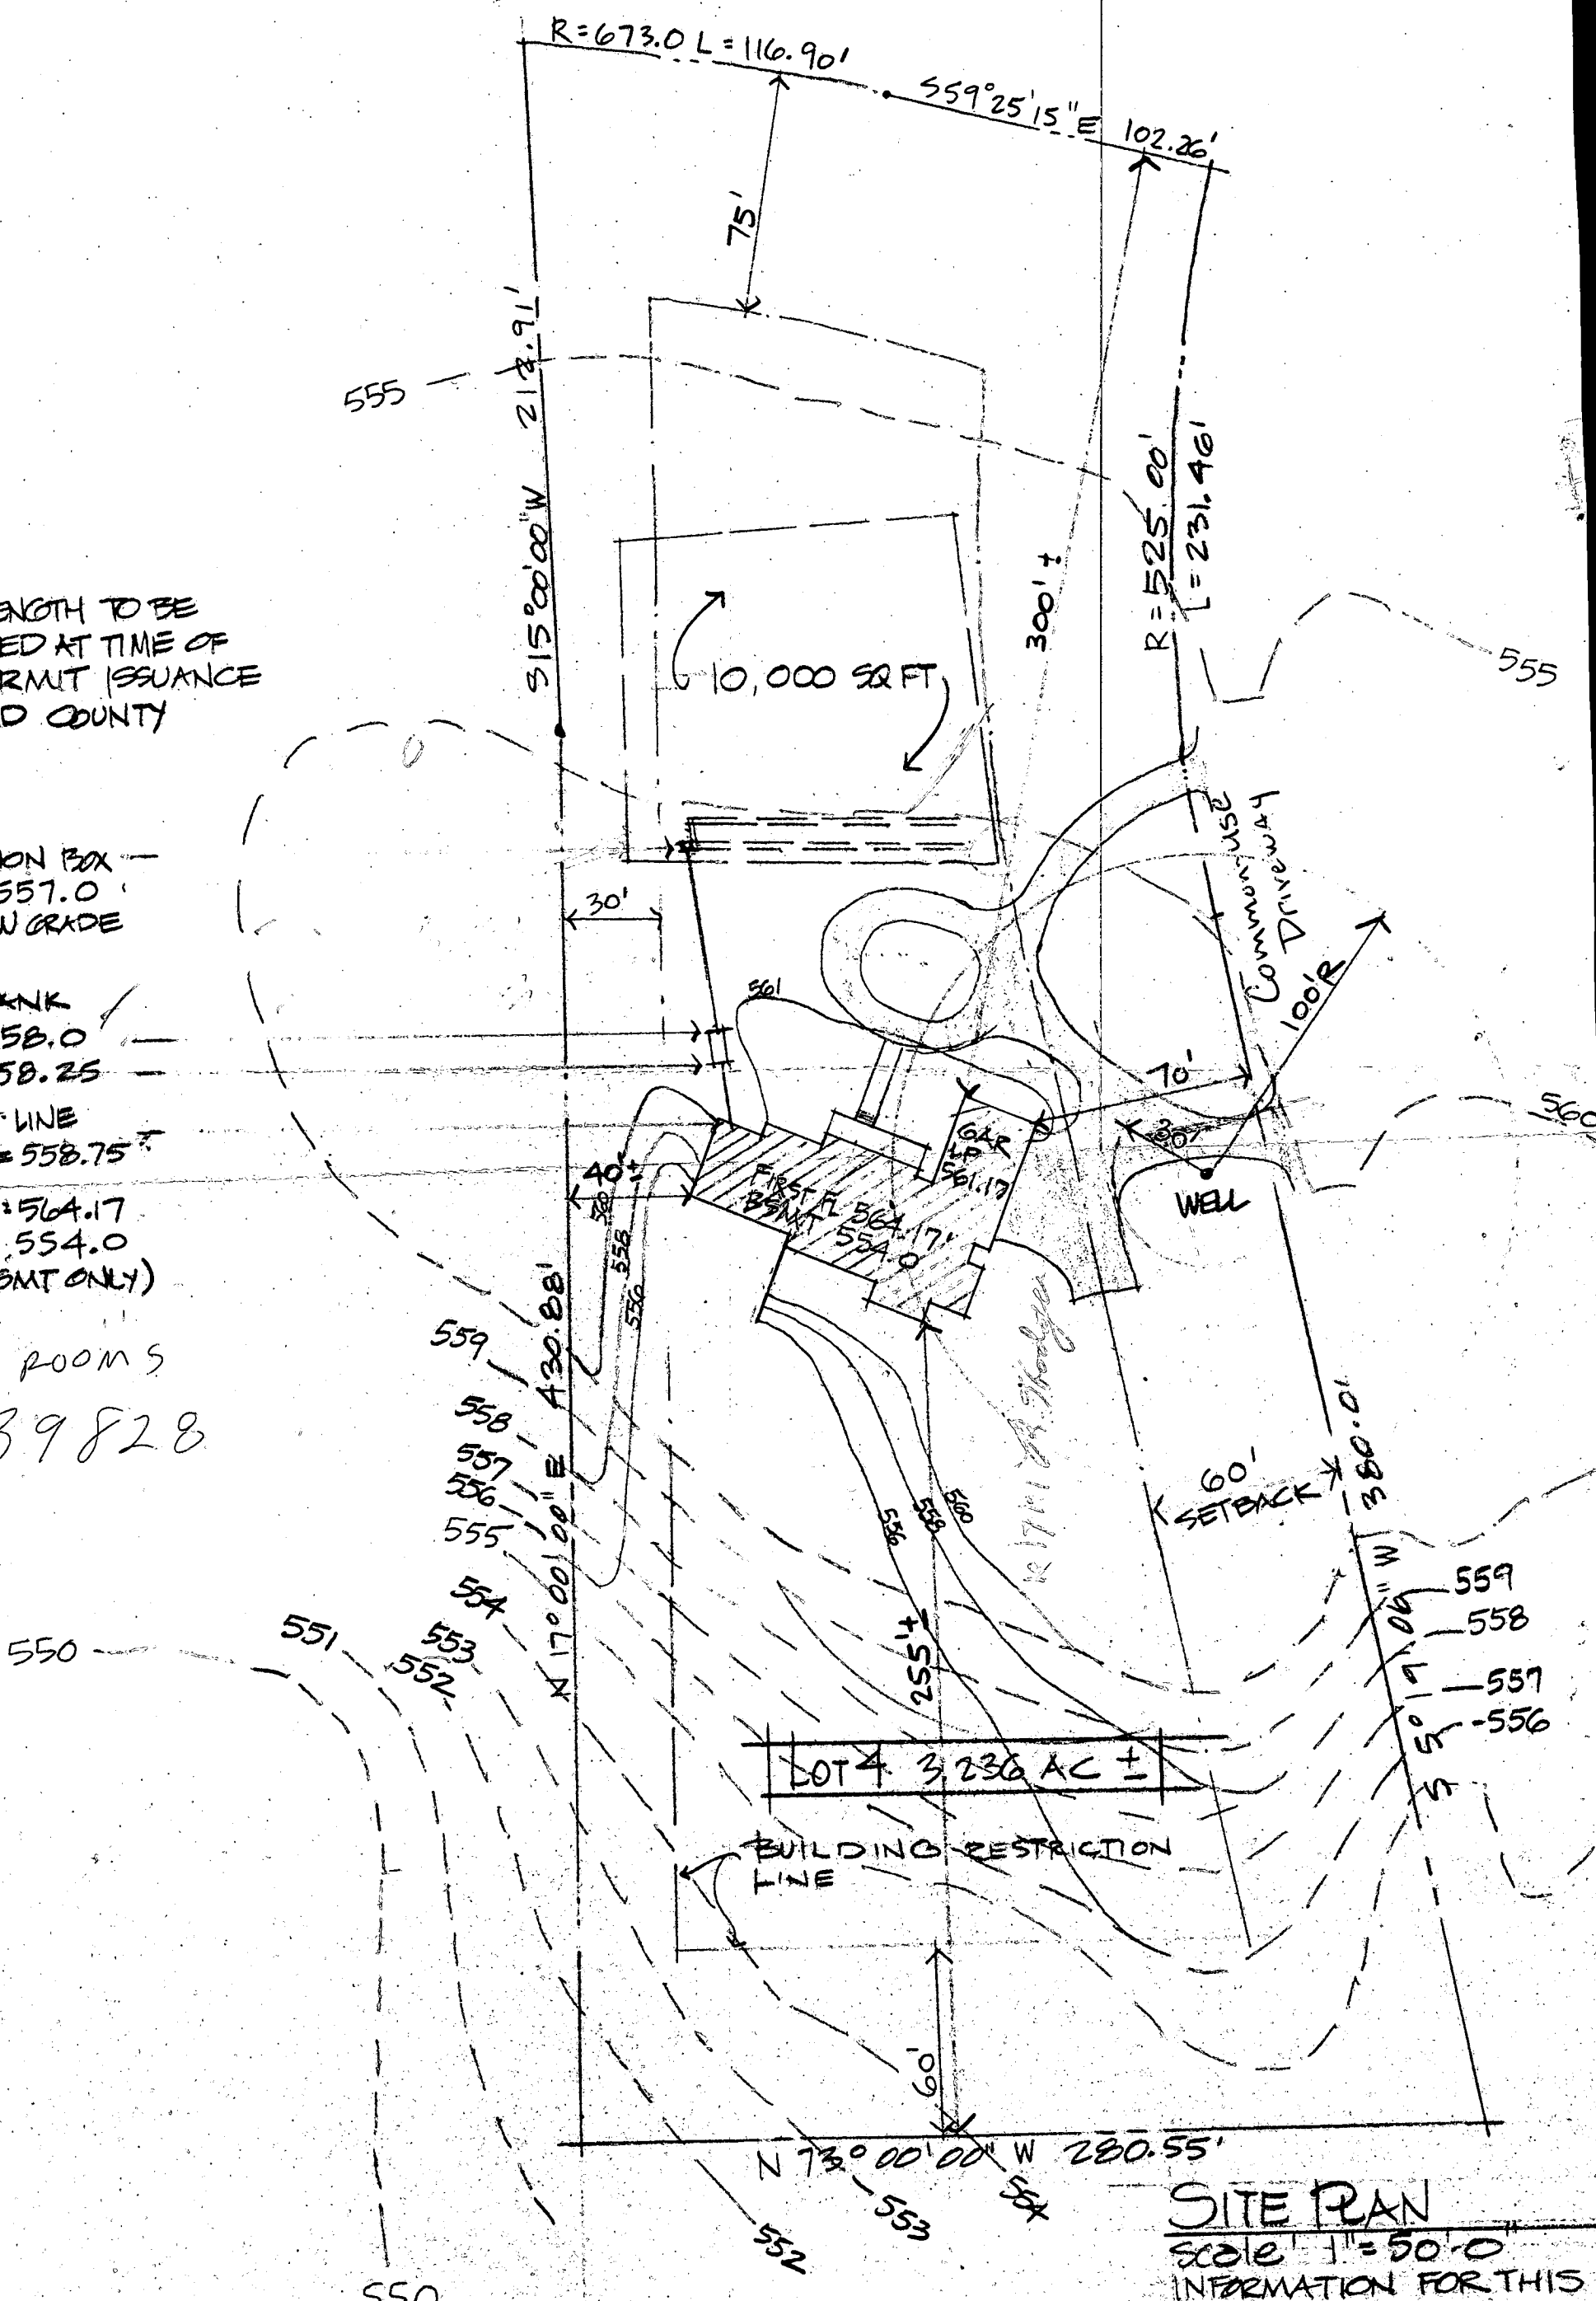

SITE PLAN
SCALE 1" = 50'-0"
INFORMATION FOR THIS
FROM PLAT NO 9905 DA
"RIDGE" LOTS 1-4 PREPAR

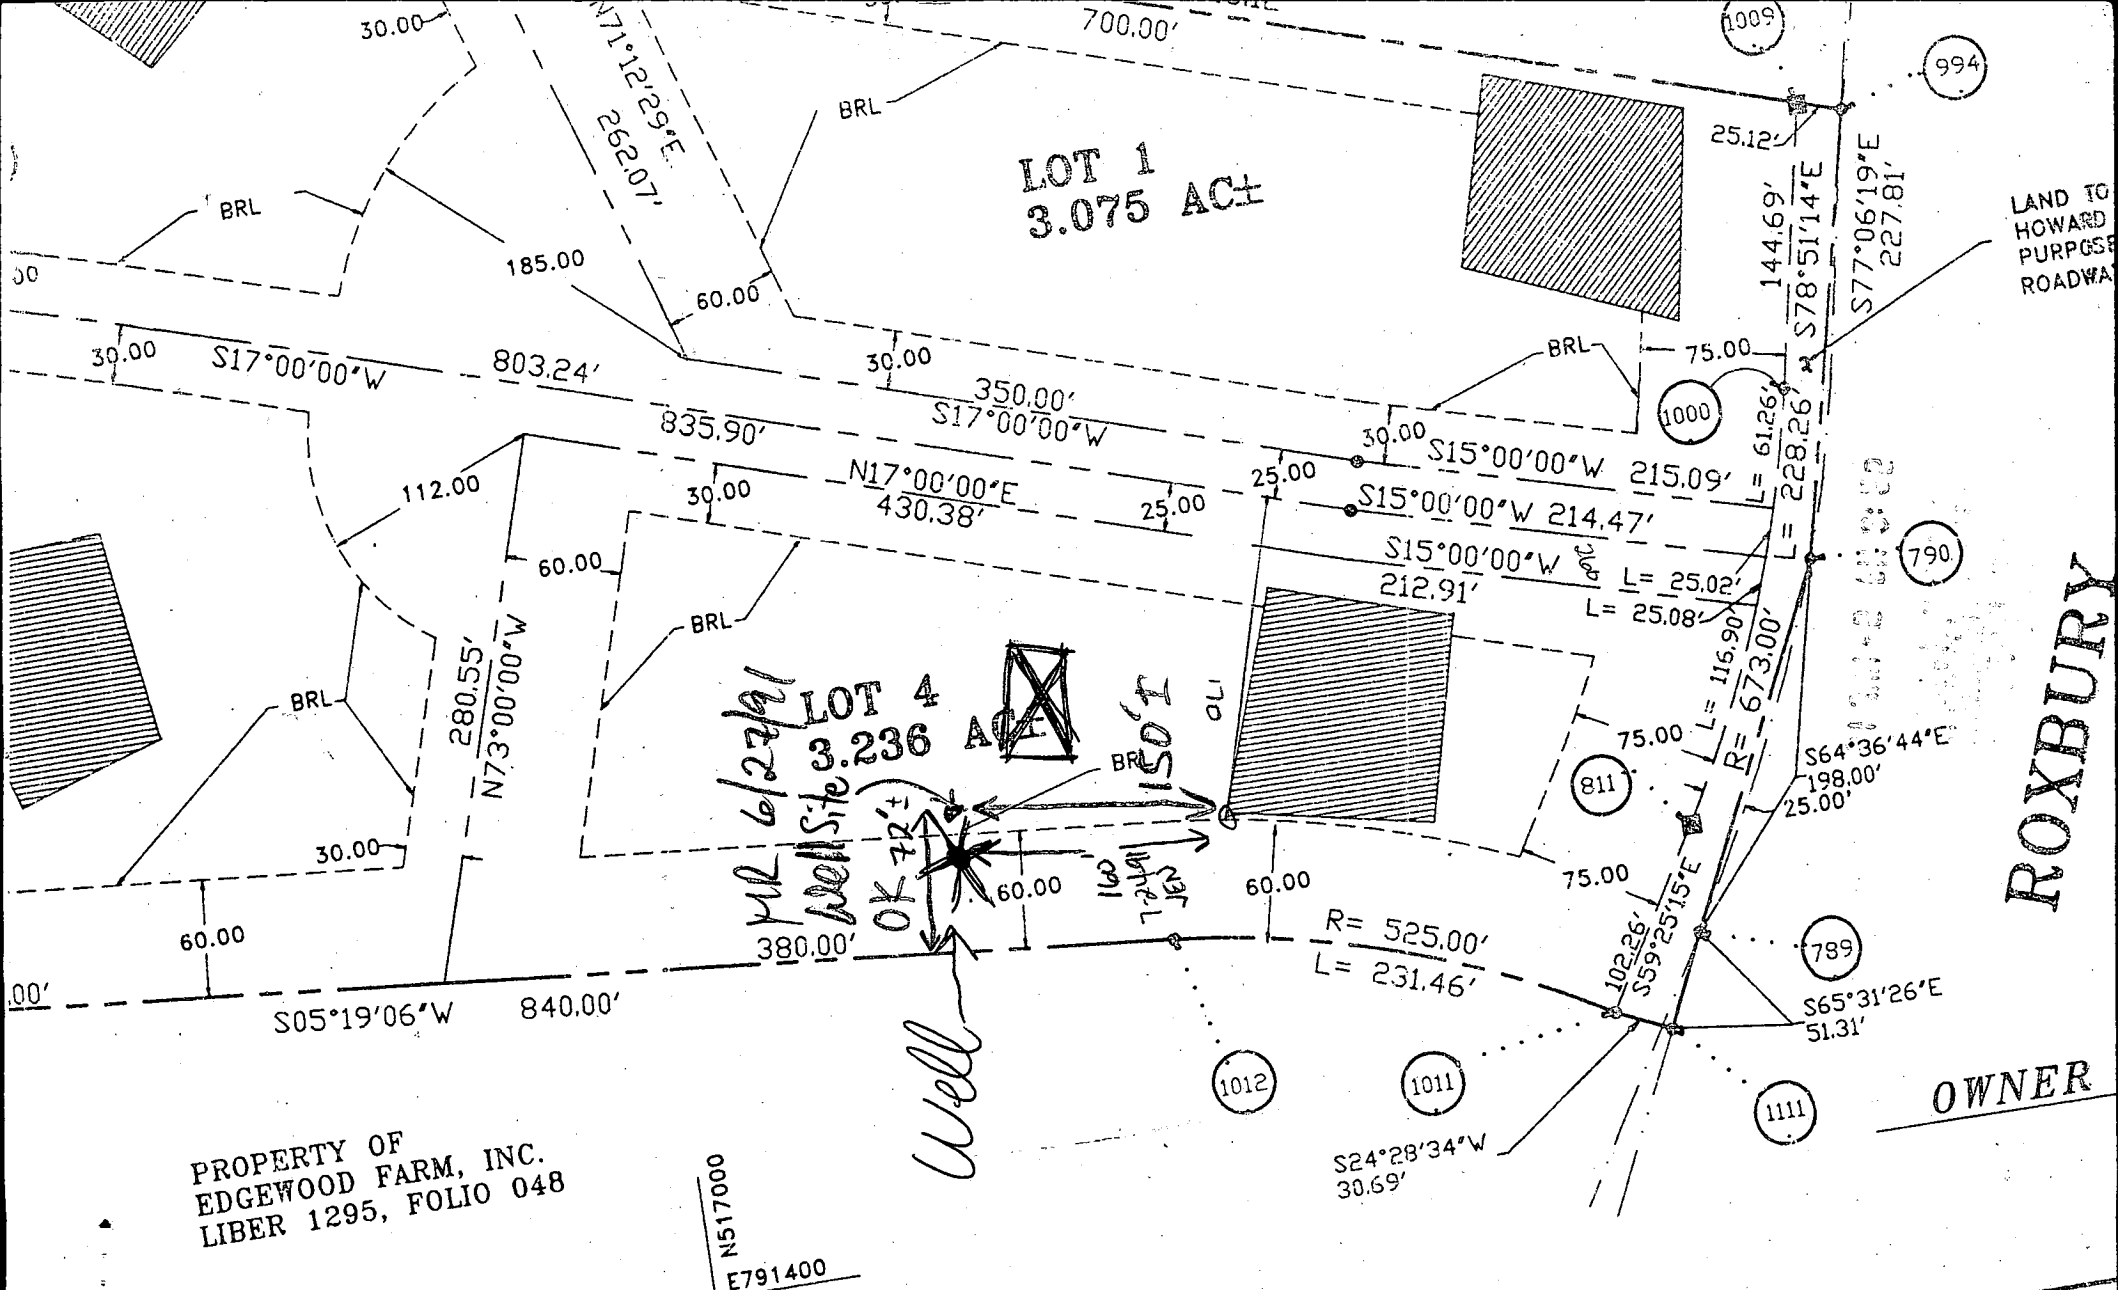

C1 4590 SEQUENCE NO. (DENY USE ONLY)

(THIS NUMBER IS TO BE PUNCHED IN COLUMNS 3-6 ON ALL CARDS)

STATE OF MARYLAND
WELL COMPLETION REPORT
FILL IN THIS FORM COMPLETELY
PLEASE PRINT OR TYPE

THIS REPORT MUST BE SUBMITTED WITHIN 45 DAYS AFTER WELL IS COMPLETED.

COUNTY NUMBER A46074

ST/CO USE ONLY
DATE RECEIVED

DATE WELL COMPLETED

Depth of Well

PERMIT NO.
FROM "PERMIT TO DRILL WELL"

1 2 3 4 5 6 7 8 9 10 11 12 13

14 15 16 17 18 19 20

21 22 23 24 25 26
(TO NEAREST FOOT)

27 28 29 30 31 32 33 34 35 36 37
H0-88-1723

OWNER Clark last name Harold first name
STREET OR RD Roxbury Rd TOWN Glenelg
SUBDIVISION SCARLET RIDGE SECTION Lot 4

WELL LOG

Not required for driven wells

STATE THE KIND OF FORMATIONS
PENETRATED, THEIR COLOR, DEPTH,
THICKNESS AND IF WATER BEARING

DESCRIPTION (Use additional sheets if needed)	FEET		Check if water bearing
	FROM	TO	
Top Soil	0	2	
Clay	2	8	
Silt Sand	8	65	
Clay	65	75	
Sand Stone	75	90	
Mica	90	95	✓
Mica Flint Mixed	95	110	
Mica	110	112	✓
Sand Stone	112	160	
Mica			

GROUTING RECORD

WELL HAS BEEN GROUTED
(Circle Appropriate Box)

yes (Y) no (N)
44 44

TYPE OF GROUTING MATERIAL

CEMENT (CM) BENTONITE CLAY (BC)

NO. OF BAGS 30 NO. OF POUNDS 300

GALLONS OF WATER 150

DEPTH OF GROUT SEAL (to nearest foot)

from 0 ft. to 46 ft.
(enter 0 if from surface)

CASING RECORD

casing types insert appropriate code below

ST CO
STEEL CONCRETE
PL OT
PLASTIC OTHER

MAIN CASING TYPE Nominal diameter top (main) casing (nearest inch) Total depth of main casing (nearest foot)

ST 6 86
60 61 63 64 66 70

OTHER CASING (if used)

diameter inch depth (feet) from to

SCREEN RECORD

screen type or open hole insert appropriate code below

ST BR HO
STEEL BRASS OPEN HOLE
PL OT
PLASTIC OTHER

C2

DEPTH (nearest ft.)

1 H0 89 160
2 23 24 26 30 32 36
3 38 39 41 45 47 51

SLOT SIZE 1 2 3
DIAMETER OF SCREEN (NEAREST INCH)

from to

GRAVEL PACK IF WELL DRILLED WAS FLOWING WELL INSERT F IN BOX 68

OEP USE ONLY (NOT TO BE FILLED IN BY DRILLER)

T (E.R.O.S.) W Q
70 72 74 75 76

TELESCOPE CAGING LOG INDICATOR OTHER DATA

C3

PUMPING TEST

HOURS PUMPED (nearest hour) 3

PUMPING RATE (gal. per min. to nearest gal.) 10

METHOD USED TO MEASURE PUMPING RATE Bucket

WATER LEVEL (distance from land surface)

BEFORE PUMPING 35

WHEN PUMPING 54

TYPE OF PUMP USED (for test)

A air P piston T turbine
C centrifugal R rotary O other (describe below)
J jet S submersible

PUMP INSTALLED

DRILLER WILL INSTALL PUMP YES NO

IF DRILLER INSTALLS PUMP, THIS SECTION MUST BE COMPLETED FOR ALL WELLS EXCEPT HOME USE

TYPE OF PUMP INSTALLED

PLACE (A,C,J,P,R,S,T,O)

IN BOX - SEE ABOVE

CAPACITY: GALLONS PER MINUTE (to nearest gallon)

PUMP HORSE POWER

PUMP COLUMN LENGTH (nearest ft.)

CASING HEIGHT (circle appropriate box and enter casing height)

LAND SURFACE 4 (nearest foot)

LOCATION OF WELL ON LOT

SHOW PERMANENT STRUCTURE SUCH AS BUILDING, SEPTIC TANKS, AND/OR LANDMARKS AND INDICATE NOT LESS THAN TWO DISTANCES (MEASUREMENTS TO WELL)

CIRCLE APPROPRIATE LETTER
A A WELL WAS ABANDONED AND SEALED WHEN THIS WELL WAS COMPLETED

E ELECTRIC LOG OBTAINED

P TEST WELL CONVERTED TO PRODUCTION WELL

I HEREBY CERTIFY THAT THIS WELL HAS BEEN CONSTRUCTED IN ACCORDANCE WITH COMAR 26.04.04 "WELL CONSTRUCTION" AND IN CONFORMANCE WITH ALL CONDITIONS STATED IN THE ABOVE CAPTIONED PERMIT, AND THAT THE INFORMATION PRESENTED HEREIN IS ACCURATE AND COMPLETE TO THE BEST OF MY KNOWLEDGE.

DRILLERS IDENT. NO. 40

DRILLERS SIGNATURE (MUST MATCH SIGNATURE ON APPLICATION)

SITE SUPERVISOR (sign of driller or journeyman responsible for sitework if different from permittee)

COUNTY

No Final
 Not ok C. Rod.
 Water + mud
 in hole
 covered
 lining &
 PLACED
 LATION

3/27/92 left card at casing to clear mud & water & call; Hold for a call. C.B.S.