

6/29/90 AM

PERMIT

SEWAGE DISPOSAL SYSTEM

MARYLAND STATE DEPARTMENT OF HEALTH

HOWARD COUNTY
BUREAU OF ENVIRONMENTAL HEALTH
461-9933

OS-353750
INDEXED

P 46129

A REPAIR

DISTRICT _____

DATE 7/6/90

DATE SYSTEM APPROVED 7-3-90

INSPECTOR JEN

Jack Fyock Septic Service IS PERMITTED TO INSTALL _____ ALTER X

ADDRESS 13775 Triadelphia Road, Glenelg, Maryland 21737 PHONE 988-9270

SUBDIVISION _____ ROAD 11706 Terry Lynn Drive LOT _____

PROPERTY OWNER _____ Hodge Residence

ADDRESS _____

~~IF GARBAGE GRINDER IS USED INCREASE SEPTIC TANK CAPACITY BY 60% AND ABSORPTION AREA BY 25%~~

~~GARBAGE GRINDER~~ YES ~~NO~~

SEPTIC TANK CAPACITY _____ GALLONS NUMBER OF BEDROOMS 4

REPAIR - CALL FOR INSPECTION WHEN GROUND IS OPENED SO SANITARIAN CAN RECOMMEND REPAIR.

130 sq ft / bdrm, Inlet 4.5 ft, Bottom 11 ft, 6.5 ft stone. Effective depth starts at 4.5 ft. 80 ft trench. JEN 6-29-90

BUILDING PERMIT SIGNED

AND RETURNED

11-2002 800 135454 - ADD GREAT ROOM

PLANS APPROVED BY Craig Williams DATE 06/27/90

COVER NO WORK UNTIL INSPECTED AND APPROVED

NEITHER THE HOWARD COUNTY COUNCIL NOR THE HEALTH DEPARTMENT IS RESPONSIBLE FOR THE SUCCESSFUL OPERATION OF ANY SYSTEM.

NOTE: CLEANOUT REQUIRED EVERY 70 FEET OF SEWER LINE AND/OR AT 90° SWEEPS IN LINES FROM HOUSE TO DRAIN FIELDS

NOTE: ALL PARTS OF SEPTIC SYSTEMS (I.E. TANK, DISTRIBUTION BOX, TRENCHES) TO BE 100 FEET FROM WELL (UNLESS OTHERWISE SPECIFICALLY AUTHORIZED)

NOTE: IF DEEP TRENCHES ARE USED CALL FOR INSPECTION BEFORE AND AFTER PLACING GRAVEL IN TRENCHES

NOTE: NO DRY WELL SHALL EXCEED 15 FOOT IN DIAMETER NO ABSORPTION TRENCH TO EXCEED 100 FEET IN LENGTH.

NOTE: ALL PIPE FROM HOUSE TO SEPTIC TANK MUST BE CAST IRON OR SCHEDULE 40 PVC OR ABS

PERMIT VOID AFTER TWO YEARS


NOTE: INSTALL STAND PIPE ON SEPTIC TANK AND DRY WELL. STAND PIPES MUST BE 6 INCHES IN DIAMETER. CAST IRON, CONCRETE OR TERRA COTTA OR PVC OR ABS ACCEPTED. IF TOP OF SEPTIC TANK IS DEEPER THAN 3 FEET, MANHOLE TO GRADE REQUIRED

NOTE: DISTRIBUTION BOXES MUST HAVE BAFFLES

*INSTALLER IS RESPONSIBLE FOR OBTAINING FINAL APROVAL ON THIS PERMIT

*CALL 461-9933 FOR INSPECTION OF SEPTIC SYSTEMS.

46129

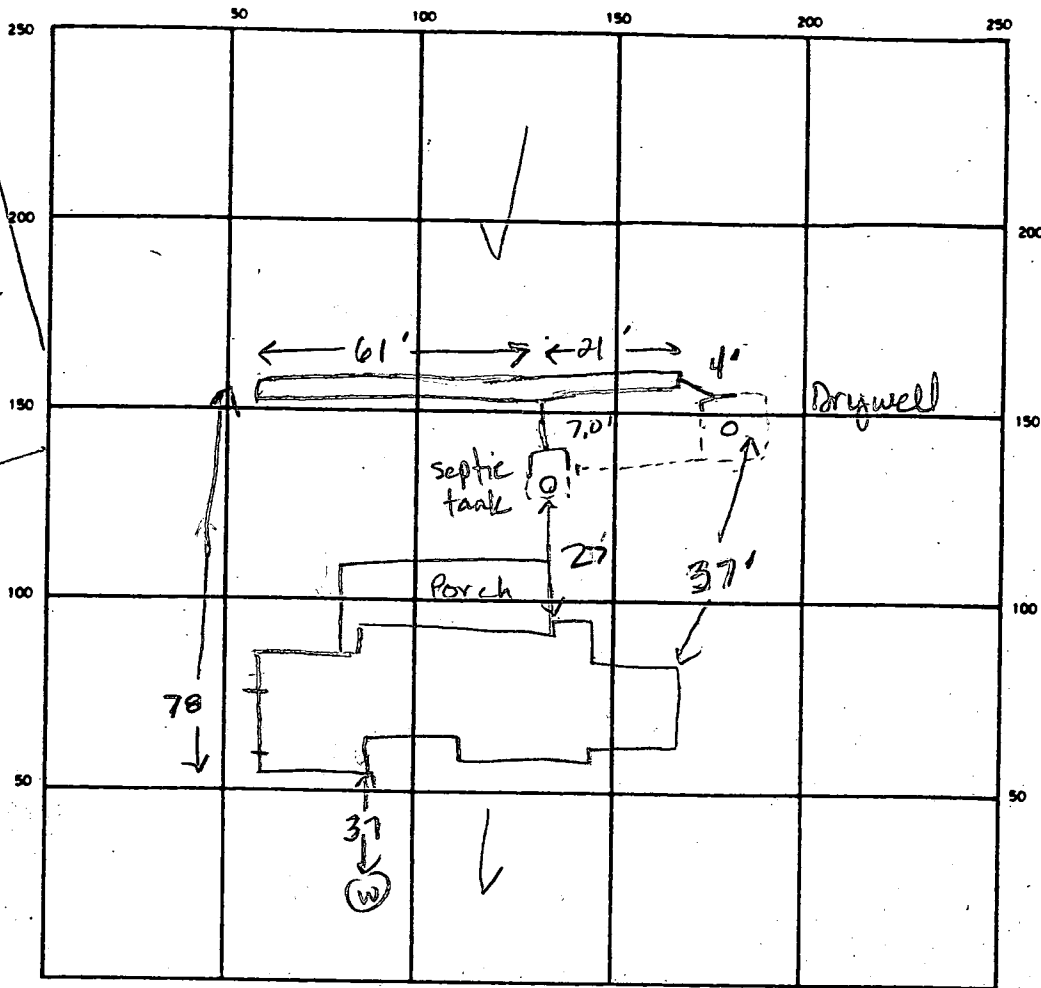

INDICATE NORTH — NAME ADJOINING ROADWAY AS BASE LINE

Teri Lynn Drive

SEPTIC TANK LEVEL 1250 ± CLEANOUTS 1 on s tank and 1 on main line

DISTRIBUTION BOX LEVEL N/A **AND RETURNED**

Existing DRAIN FIELD/TILE FIELD DEPTH 11.0 FT. TRENCH WIDTH 2 FT. INLET DEPTH 4.5 FT.

EFFECTIVE GRAVEL DEPTH 6.5 FT. TOTAL LENGTH 82 FT. NUMBER OF TRENCHES 1 ONE SIDEWALL/BOTTOM AREA 533 SQ. FT.

Existing DRYWELL INSIDE DIAMETER 12' x 12' FT. EFFECTIVE DEPTH BELOW INLET 7.5 FT.
(Drywell 450 sq ft) + 533 SQ. FT. ABSORBENT AREA

REMARKS 6-29-90 OK to add stone, pipe and paper. Old line to drywell abandoned. JEN 7-3-90 OK to cover all work. JEN

DATE SYSTEM APPROVED 7-3-90

INSPECTOR

Jane E. Madigan

PERMIT

SEWAGE DISPOSAL SYSTEM

MARYLAND STATE DEPARTMENT OF HEALTH

HOWARD COUNTY

ELLICOTT CITY

DISTRICT 5

DATE 2/19/71

INDEXED

Gordon Walker

IS PERMITTED TO INSTALL X ALTER

ADDRESS Hall Shop Road, Fulton, Md.

PHONE 286-2306

A SEWAGE DISPOSAL-SYSTEM LOCATED AT _____

SUBDIVISION Mooresfield

ROAD Terri Lynn Lane

LOT 7, Sec. 4

PROPERTY OWNER Arch C. Hodge

ADDRESS _____

SPECIFICATIONS - 4 bedrooms

DRAIN FIELD _____ DEPTH _____ FEET, BOTTOM AREA _____ SQ. FT.

SEEPAGE PITS _____ ABSORBENT SIDE-WALL AREA _____ SQ. FT.

SEPTIC TANK CAPACITY 1,200 GALLONS

FOR GARBAGE GRINDER, INCREASE DISPOSAL AREA 22% & TANK CAPACITY 50%.

OTHER Dry well - 400 sq. ft. absorbent sidewall area below inlet pipe. Inlet to
be no deeper than 4 ft. below original grade.

Locate dry well 135 ft. from the front lot line and 32 ft. from the right side line
as lot is seen when facing it from Terri Lynn Lane.

NOTE: ALL PIPE FROM HOUSE TO SEPTIC TANK MUST BE CAST IRON.


PERMIT VOID AFTER THREE YEARS.

PLANS APPROVED BY R. Fletcher DATE 11/9/65

FILL SEPTIC TANK AND DISTRIBUTION BOX WITH WATER BEFORE CALLING FOR AN INSPECTION. COVER NO WORK UNTIL INSPECTED AND APPROVED.

NEITHER THE HOWARD COUNTY COMMISSIONERS NOR THE HEALTH DEPARTMENT IS RESPONSIBLE FOR THE SUCCESSFUL OPERATION OF ANY SYSTEM.

A
09948

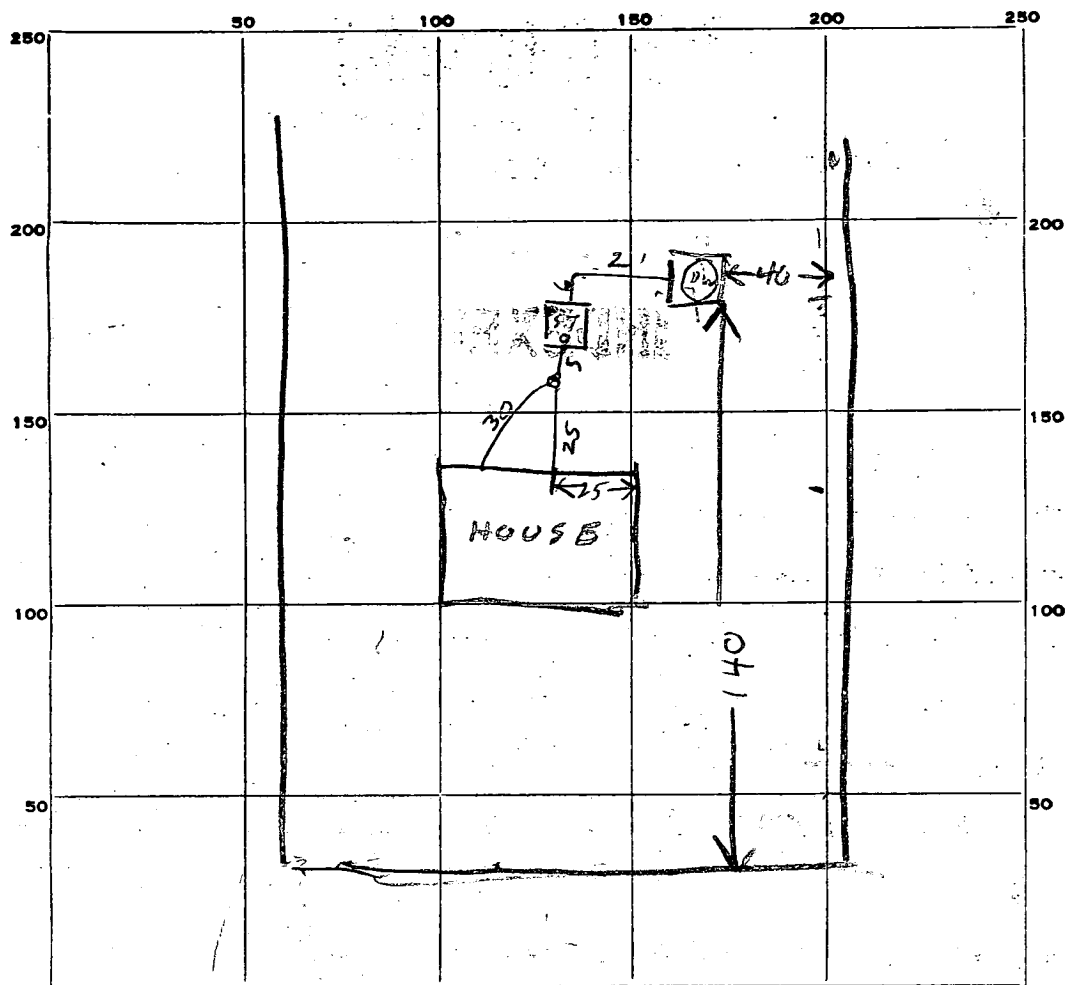

INDICATE NORTH. - NAME ADJOINING ROADWAY AS BASE LINE

27, Sec 4

PERMIT CARD

SEPTIC TANK, LEVEL OK 1200

DISTRIBUTION BOX, LEVEL

TILE FIELD, DEPTH _____ FT. TRENCH WIDTH _____ FT.

GRAVEL DEPTH _____ IN. TOTAL LENGTH _____ FT.

NUMBER OF TRENCHES _____ TOTAL BOTTOM AREA _____

SEEPAGE PITS, INSIDE DIAMETER 12 FT. DEPTH BELOW INLET 7 1/2 FT.

ABSORBENT AREA 450 SQ. FT. Soft sidewall and counting down

REMARKS: 11/11 Dry Well 15' below grade
Perimeter of Dry Well is 60 FT

DATE SYSTEM APPROVED

INSPECTOR

APPLICATION

A 09948

P

SEWAGE DISPOSAL TESTING

MARYLAND STATE DEPARTMENT OF HEALTH

HOWARD COUNTY

ELLICOTT CITY

DISTRICT 5

DATE 4/2/65

Septic Tank - 750 gal.
Drywell - 300 sq. ft. absorbent
sidewall area below inlet pipe. Inlet to be no
deeper than 4 ft. below original grade.
Locate drywell 135 ft. from the front lot line
and 32 ft. from the right side line as lot is
seen when facing it from Terri Lynn Lane.

TO: THE COUNTY HEALTH OFFICER
ELLICOTT CITY, MARYLAND

I, HEREBY, APPLY FOR THE NECESSARY TESTS IN ORDER TO CONSTRUCT (OR RECONSTRUCT) A SEWAGE DISPOSAL SYSTEM.

PROPERTY OWNER Claude D. Krumm

ADDRESS Clarksville, Maryland PHONE AT 6-3152

PROPERTY LOCATION:

SUBDIVISION Mooresfield LOT NO. 7, Sec. 4

ROAD AND DESCRIPTION Terri Lynn Lane

OCCUPANT PHONE

PERSON TO CONSTRUCT SYSTEM PHONE

ADDRESS PHONE

SIZE OF LOT 148' x 302' x 278' TYPE BLDG. 3

NUMBER OF BEDROOMS

IF NOT SINGLE RESIDENCE DESCRIBE

SIGNATURE OF APPLICANT /s/ P. T. McHenry


APPROVED BY R. F. Altman FOR D. R. McHenry DATE 4/9/65

REJECTED BY FOR DATE

HOLD PENDING FURTHER TESTS DATE

REASONS FOR REJECTION OR HOLDING

THIS IS NOT A PERMIT

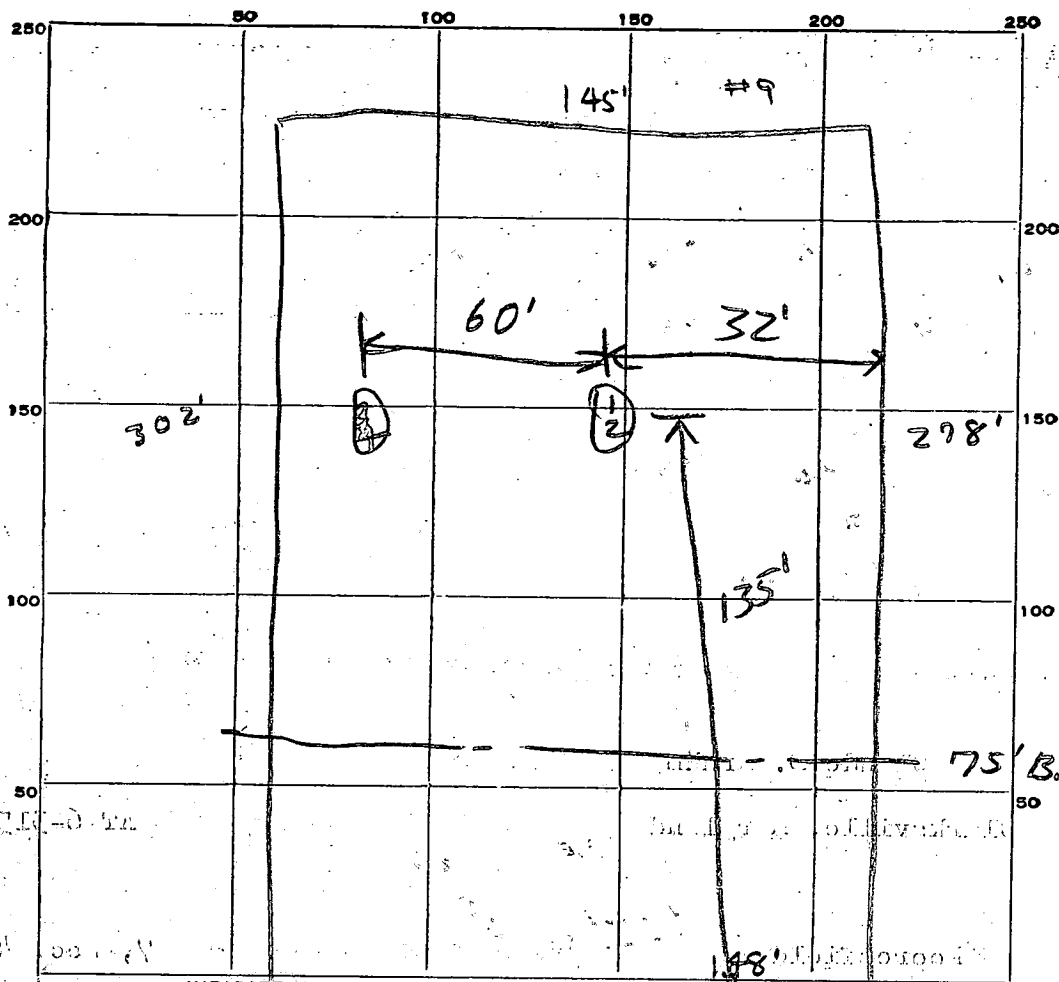

Toni Lynn Lane → to Cherry Tree Dr.

DATE	TEST NO.	DEPTH	PRE-WET		TEST - 1" DROP		TIME
			START	STOP	START	STOP	
4/7/65	1	5 ft.	246	248	248	253	5 min.
	2	9 1/2 ft.	247	249	249	252	3 min.
	3	4 1/2 ft.	251	252	252	255	3 min.
	4	9 1/2 ft.	252	253	253	256	3 min.


3 1/2
av.
3 min.
3 min.

SOIL AUGER FINDING 1st & 2nd clayish

TESTED BY R.D.F. 4/7/65

REMARKS Eluvial fragments

Lot 7, Sec. 4

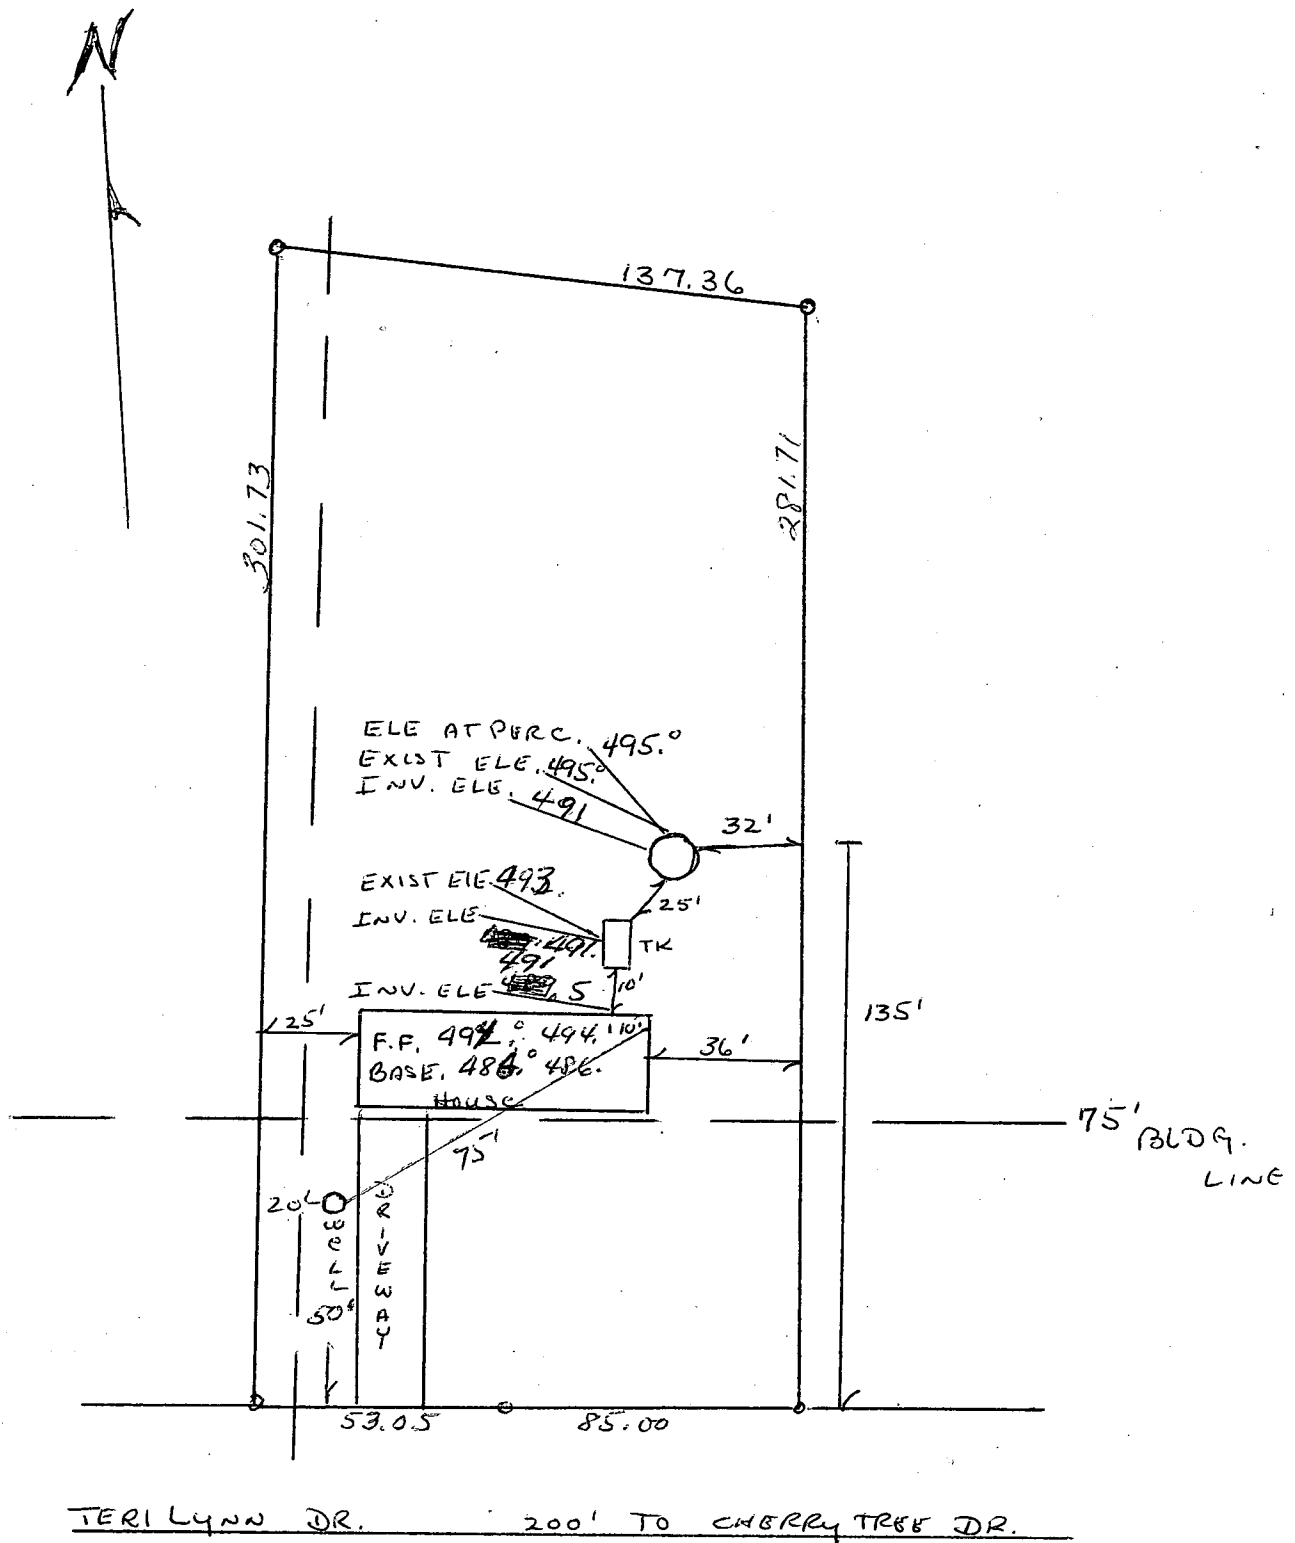



SCALE: 1" = 50'

I certify the above to be actual and correct;
 Gordon Waker, Bldr.
 Arch C. Hodge, Owner.
 Ingen

LOCATION DRAWING
SECTION 4
MOORESFIELD
LOT 7
HOWARD COUNTY, MARYLAND

11/20/02
O.K. for addition

NORTH

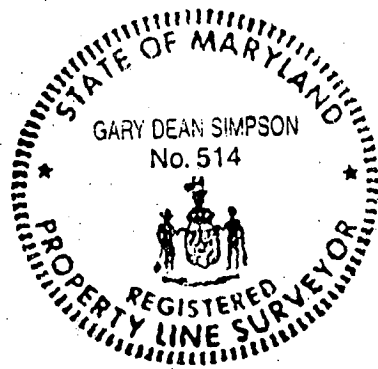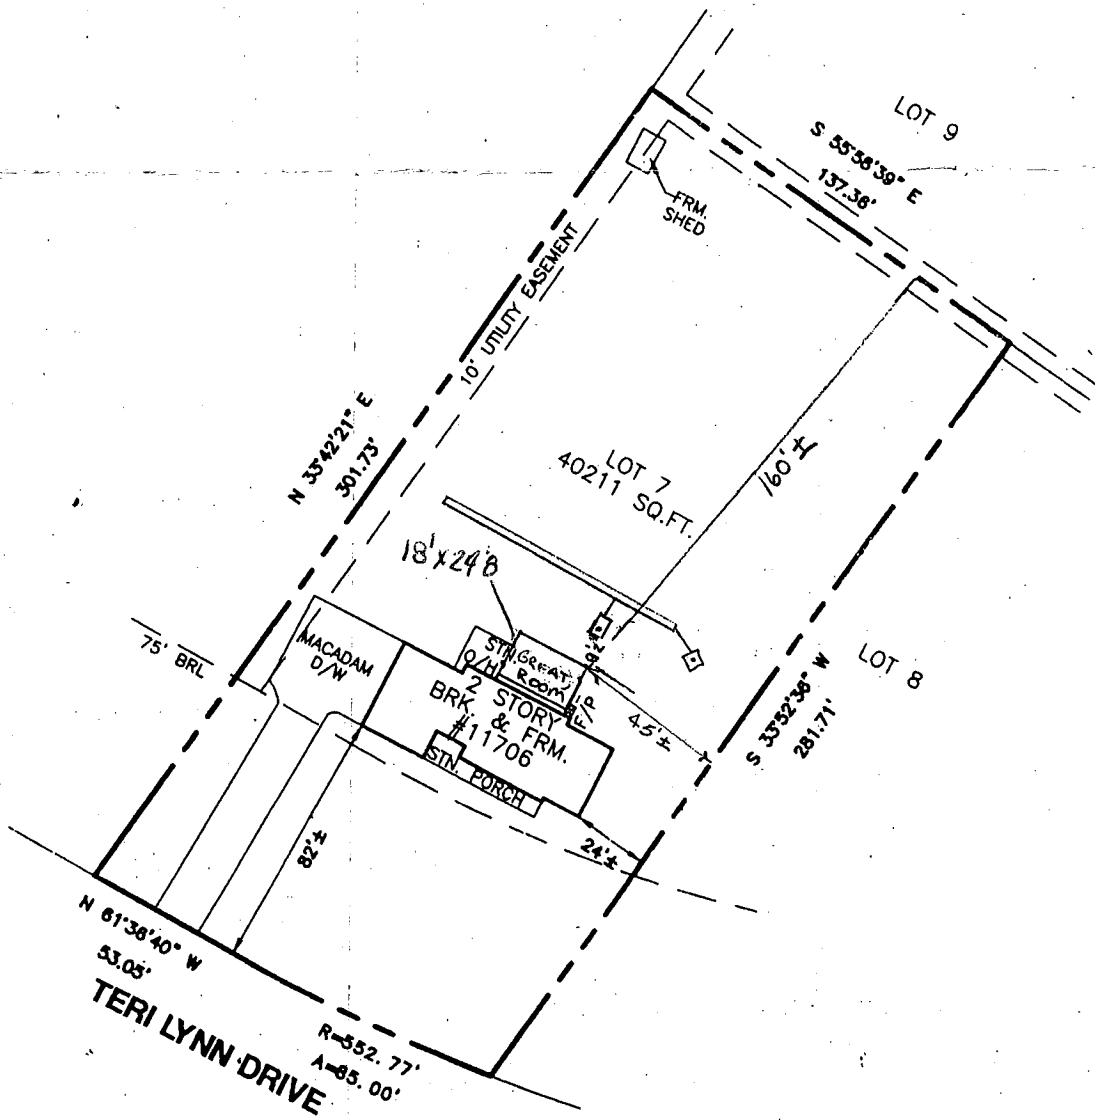

THE PROPERTY SHOWN HEREON IS LOCATED IN ZONE C (AREA OF MINIMAL

NO REPRODUCTION WITHOUT EXPRESSED
WRITTEN PERMISSION BY CMS, INC.

DEPARTMENT OF INSPECTIONS, LICENSES AND PERMITS 3430 COURT HOUSE DRIVE ELLICOTT CITY, MD 21043 PERMITS (410)313-2455 INSPECTIONS (410)313-1810 AUTOMATED INFORMATION (410) 313-3800	HOWARD COUNTY PERMIT APPLICATION	PERMIT NUMBER 3001394541
---	-------------------------------------	-----------------------------

Building Address 11706 Tossell Lane Dr FULTON, MD 20759 Suite/Apt. #: _____ SDP/WP/Petition #: _____ Census Tract 605102 Subdivision MIDDLEFIELD Section 4 Area _____ Lot 7 Tax Map _____ Parcel _____ Grid _____ Zoning _____ Map Coordinates 17J2 Lot size _____ Existing Use SED Proposed Use _____ Estimated Construction Cost \$ 20,000 Description of Work ADD GARAGE ROOM ATTACHED TO REAR OF HOUSE Occupant or Tenant _____ Contact Name _____ Address _____ City _____ State _____ Zip Code _____ Phone _____ Fax _____	Property Owner's Name EDWARD S. SULLIVAN Address 11716 Tossell Lane Dr City FULTON State MD Zip Code 20759 Home Phone 301-604-7329 Work Phone 301-604-6920 Applicant's Name & Mailing Address, (if other than stated hereon): _____ Phone _____ Fax _____ Contractor Company SULLIVAN BUILDING Contact Person DANIEL SULLIVAN Address 6015 SULLIVAN CT City FULTON, MD State MD Zip Code 21704 License No. 4424 Phone _____ Fax _____ Engineer or Architect Company _____ Contact Person _____ Address _____ City _____ State _____ Zip Code _____ Phone _____ Fax _____
--	---

BUILDING DESCRIPTION - COMMERCIAL		BUILDING DESCRIPTION - RESIDENTIAL	
Building Characteristics Height: _____ No. of stories: _____ Gross area, sq. ft. per floor: _____ Use group: _____ Construction type: ____ Reinforced Concrete ____ Structural Steel ____ Masonry ____ Wood Frame ____ State Certified Modular	Utilities Water Supply: ____ Public ____ Private Sewage Disposal: ____ Public ____ Private Electric Yes ☐ No ☐ Gas Yes ☐ No ☐ Heating System: Electric ☐ Oil ☐ Natural Gas ☐ Propane Gas ☐ Sprinkler system: N/A ☐ ____ Full ____ Partial ____ Other Suppression ____ # of Heads	Building Characteristics SF Dwelling ☐ SF Townhouse ☐ Depth Width 1st floor: _____ 2nd floor: _____ Basement: _____ Finished Basement ☐ Unfinished Basement ☐ Crawl space ☐ Slab on Grade ☐ No. of Bedrooms _____ Multi-family dwellings: No. of efficiency units: _____ No. of 1 BR units: _____ No. of 2 BR units: _____ No. of 3 BR units: _____ Other Structure: _____ Dimensions: _____ Footings: _____ Roof: _____ ____ State Certified Modular ____ Manufactured Home	Utilities Water Supply: ____ Public ____ Private Sewage Disposal: ____ Public ____ Private Electric Yes ☒ No ☐ Gas Yes ☐ No ☐ Heating System: Electric ☐ Oil ☒ Natural Gas ☐ Propane Gas ☐ Sprinkler system: N/A ☐ ____ NFPA #13D ____ NFPA #13R ____ Other:

THE UNDERSIGNED HEREBY CERTIFIES AND AGREES AS FOLLOWS: (1) THAT HE/SHE IS AUTHORIZED TO MAKE THIS APPLICATION; (2) THAT THE INFORMATION IS CORRECT; (3) THAT HE/SHE WILL COMPLY WITH ALL REGULATIONS OF HOWARD COUNTY WHICH ARE APPLICABLE THERETO; (4) THAT HE/SHE WILL PERFORM NO WORK ON THE ABOVE REFERENCED PROPERTY NOT SPECIFICALLY DESCRIBED IN THIS APPLICATION; (5) THAT HE/SHE GRANTS COUNTY OFFICIALS THE RIGHT TO ENTER ONTO THIS PROPERTY FOR THE PURPOSE OF INSPECTING THE WORK PERMITTED AND POSTING NOTICES.

Applicant's Signature [Signature] Title/Company	Print Name DANIEL SULLIVAN Date 11-20-02
---	---

Checks payable to: DIRECTOR OF FINANCE OF HOWARD COUNTY

** PLEASE WRITE NEATLY AND LEGIBLY **

FOR OFFICE USE ONLY

AGENCY	DATE	SIGNATURE APPROVAL	DPZ-SETBACK INFORMATION	PROPERTY ID#
Land Development, DPZ			Front: _____	Filing fee \$ _____
State Highways			Rear: _____	Permit fee \$ _____
Building Official			Side: _____	Excise tax \$ _____
Dev. Engineering, DPZ			Side St: _____	Add'l per. fee \$ _____
Health	11/20/02	[Signature]	All minimum setbacks met? YES ☐ NO ☐	TOTAL FEES \$ 449.00
Fire Protection			Is Entrance Permit required? YES ☐ NO ☐	Sub-total paid \$ _____
Is Sediment Control approval required prior to issuance? YES ☐ NO ☐			Historic District? YES ☐ NO ☐	Balance due \$ _____
CONTINGENCY CONSTRUCTION START: ☐			Lot Coverage for New Town Zone _____	Check # 141976
ONE STOP SHOP: ☐			SDP/Red-line approval date _____	Validation # 141671
				Accepted by [Signature]

Distribution of Copies: White: Building Official Green: LDD, DPZ Yellow: DED, DPZ Pink: Health Gold: SHA