

8/6/90 10:00 8/7/90 10:00 Twp ID - 04-320999 Filed

8/8/90 ASAP

PERMIT

SEWAGE DISPOSAL SYSTEM

MARYLAND STATE DEPARTMENT OF HEALTH DISTRICT

HOWARD COUNTY
BUREAU OF ENVIRONMENTAL HEALTH
461-9933

P 46222
A REPAIR

DATE 8/9/90

DATE SYSTEM APPROVED 8/8/90

INSPECTOR C R D

INDEXED

Arnold Backhoe & Septic Services, Inc. IS PERMITTED TO INSTALL ALTER X
ADDRESS P. O. Box 15, Woodbine, Maryland 21797 PHONE 795-7873
SUBDIVISION ROAD 1120 St. Michael's Rd LOT
PROPERTY OWNER Nicholas Dawson Donald & Pamela Dressel
ADDRESS 1120 St. Michael's Road

~~EXISTING SEWAGE SYSTEMS ARE TO INCREASE SEPTIC TANK CAPACITY BY 50% AND ABSORPTION AREA BY 25%~~

~~SEWAGE CHIMNEY XXXXX~~

SEPTIC TANK CAPACITY 1500 GALLONS NUMBER OF BEDROOMS 5

REPAIR - PURPOSE - TO EXPAND SEPTIC SYSTEM FOR THE PROPOSED ADDITION (TOTAL - 5 BEDROOMS).

HOUSE HAS 3 BR & 600 GAL TANK. ADD 1000 TANK TO
OLD 600 GALL TANK OR REPLACE OLD TANK WITH 1500 GAL TANK
TRENCH OFF OLD D.W. FOR EXTRA BR - 170 FT LONG 9 FT DEEP
INLET 5 FT DEEP 4 FT STONE 2 FT WIDE, PLACE THE BOX
16.5 FT FROM THE BACK LINE AND 12.7 FT FROM THE LEFT SIDE
OF THE LOT AS SEEN WHEN FACING THE LOT

PLANS APPROVED BY C. Williams DATE 8/03/90
COVER NO WORK UNTIL INSPECTED AND APPROVED FROM ST MICHAELS RD RUN THE TRENCH
TOWARD THE BACK

- NEITHER THE HOWARD COUNTY COUNCIL NOR THE HEALTH DEPARTMENT IS RESPONSIBLE FOR THE SUCCESSFUL OPERATION OF ANY SYSTEM
- NOTE: CLEANOUT REQUIRED EVERY 70 FEET OF SEWER LINE AND/OR AT 90° SWEEPS IN LINES FROM HOUSE TO DRAIN FIELDS 6 AUG 90
- NOTE: ALL PARTS OF SEPTIC SYSTEMS (I.E. TANK, DISTRIBUTION BOX, TRENCHES) TO BE 100 FEET FROM WELL (UNLESS OTHERWISE SPECIFICALLY AUTHORIZED)
- NOTE: IF DEEP TRENCHES ARE USED CALL FOR INSPECTION BEFORE AND AFTER PLACING GRAVEL IN TRENCHES
- NOTE: NO DRY WELL SHALL EXCEED 15 FOOT IN DIAMETER NO ABSORPTION TRENCH TO EXCEED 100 FEET IN LENGTH
- NOTE: ALL PIPE FROM HOUSE TO SEPTIC TANK MUST BE CAST IRON OR SCHEDULE 40 PVC OR ABS
- PERMIT VOID AFTER TWO YEARS
- NOTE: INSTALL STAND PIPE ON SEPTIC TANK AND DRY WELL. STAND PIPES MUST BE 6 INCHES IN DIAMETER. CAST IRON, CONCRETE OR TERRA COTTA OR PVC OR ABS ACCEPTED. IF TOP OF SEPTIC TANK IS DEEPER THAN 3 FEET, MANHOLE TO GRADE REQUIRED
- NOTE: DISTRIBUTION BOXES MUST HAVE BAFFLES

*INSTALLER IS RESPONSIBLE FOR OBTAINING FINAL APPROVAL ON THIS PERMIT

*CALL 461-9933 FOR INSPECTION OF SEPTIC SYSTEMS.

PERMIT SIGNED
AND RETURNED 9-8-1999
Serial # B00120280
P. R. B.

46222

APPLICATION

PERCOLATION TESTING

A REPAIR

P _____

HOWARD COUNTY HEALTH DEPARTMENT
BUREAU OF ENVIRONMENTAL HEALTH
P.O. BOX 476 ELLICOTT CITY, MARYLAND 21043
TELEPHONE: 461-9933

DISTRICT _____

DATE _____

REPAIR PERC

SBB YELLOW REPAIR SHEET

TO: THE COUNTY HEALTH OFFICER
ELLICOTT CITY, MARYLAND

I, HEREBY, APPLY FOR THE NECESSARY TEST IN ORDER TO CONSTRUCT (OR RECONSTRUCT) A SEWAGE DISPOSAL SYSTEM.

PROPERTY OWNER NICHOLAS DAWSON

ADDRESS 1120 ST MICHAELS RD PHONE _____

PROSPECTIVE BUYER _____

ADDRESS _____ PHONE _____

PROPERTY LOCATION:

SUBDIVISION _____ LOT NO. _____

ROAD AND DESCRIPTION _____

TAX MAP _____ PARCEL # _____

SIZE OF LOT _____ TYPE BLDG. _____
(SINGLE FAMILY DWELLING OR COMMERCIAL)

THE SYSTEM INSTALLED UNDER THIS APPLICATION IS ACCEPTABLE ONLY UNTIL PUBLIC FACILITIES BECOME AVAILABLE. I FULLY UNDERSTAND THE
FEE CONNECTED WITH THE FILING OF THIS PERC TEST APPLICATION IS NON-REFUNDABLE UNDER ANY CIRCUMSTANCES. I ALSO AGREE TO COMPLY
WITH ALL M.O.S.H.A. REQUIREMENTS IN TESTING THIS LOT. _____

(SIGNATURE OF APPLICANT)

APPROVED BY _____ FOR _____ DATE _____


REJECTED BY _____ FOR _____ DATE _____

HOLD PENDING FURTHER TESTS _____ DATE _____

REASONS FOR REJECTION OR HOLDING _____

HD-216

THIS IS NOT A PERMIT

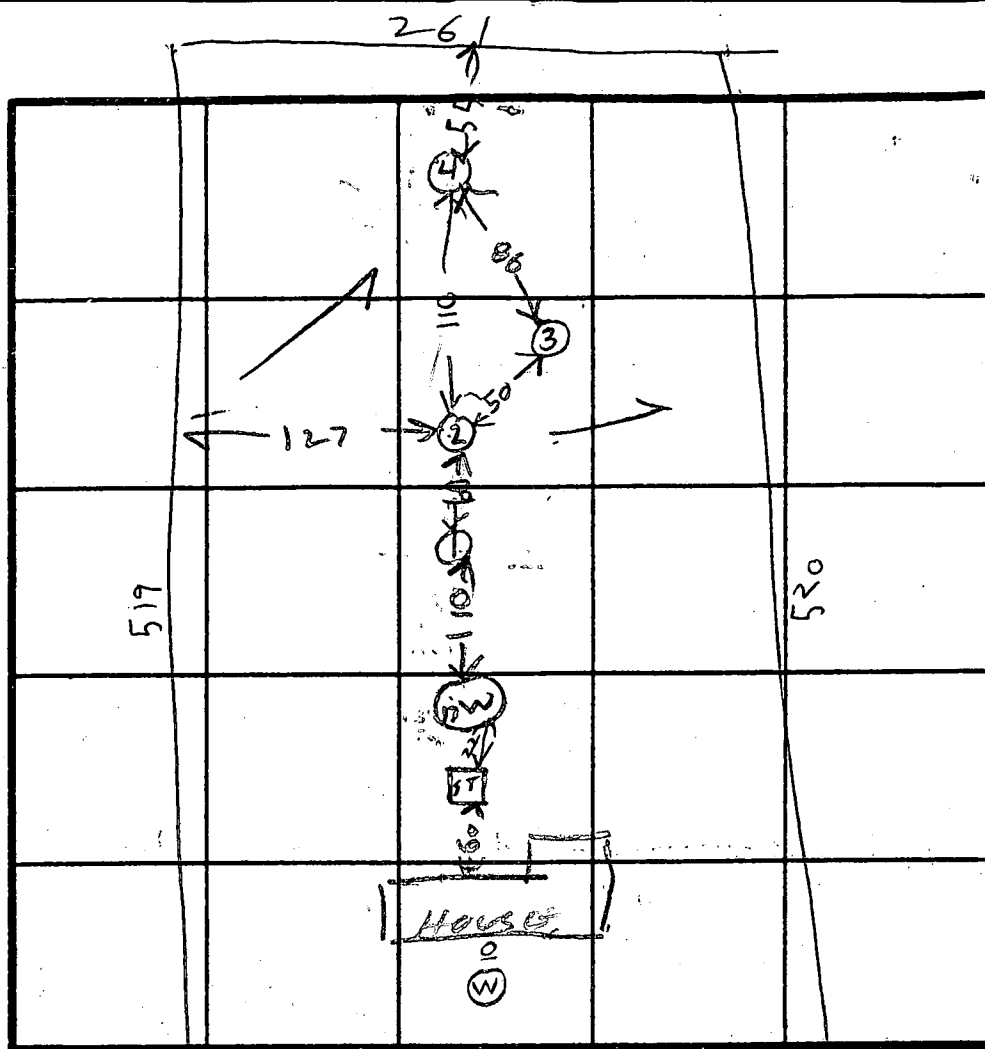

INDICATE NORTH - NAME ADJOINING ROADWAY AS BASE LINE

ST MICHAEL RD

DATE		TEST NO.	DEPTH	PRE-WET		TEST - 1" DROP		TIME
				START	STOP	START	STOP	
8/6/90	1 S	3	1036	1152	1054	1154	60	
	1 D	7	1036	1054	1054	1154		
	1 V	11	FAIL					
	2 S	3	1045	1049	1049	1100	11	
	2 D	7	1043	1051	1057	1108	17	
	2 V	12	OK					
	3 S	3.5	1110	1150	1108	125	17	
	3 D	8	1058	1108	1108	125		
	3 V	13	OK Deep Trench					
	4 S	5	1130	1149	1149	1124	20	
	4 D	8.5	1120	1127	1127	1147		
	4 V	12.5	OK Deep Trench					

REMARKS RAIN DELAY

TYPE OF SOIL

TESTED BY

RAYMOND HODGES

ARNOLD BACKHOE
ALSO PRESENT WAYNE
MR DAWSON

10/12/72

PERMIT

SEWAGE DISPOSAL SYSTEM

MARYLAND STATE DEPARTMENT OF HEALTH

HOWARD COUNTY

ELLICOTT CITY

DISTRICT 4th

DATE 10/10/72

INDEXED

Herman Sirk

IS PERMITTED TO INSTALL ALTER X

ADDRESS Florence Road, Woodbine, Md. 21797 PHONE 489-4724

A SEWAGE DISPOSAL SYSTEM LOCATED AT _____

SUBDIVISION _____ ROAD St. Michael's Road - LOT _____
white house directly across from St. Michael's Church

PROPERTY OWNER Douglas M. Tabler

ADDRESS Route #3, St. Michael's Road, Mt. Airy, Md. 21771

SPECIFICATIONS

DRAIN FIELD _____ DEPTH _____ FEET, BOTTOM AREA _____ SQ. FT.

SEEPAGE PITS _____ ABSORBENT SIDE-WALL AREA _____ SQ. FT.

SEPTIC TANK CAPACITY _____ GALLONS

FOR GARBAGE GRINDER, INCREASE DISPOSAL AREA 22% & TANK CAPACITY 50%.

OTHER REPAIR - Call for inspection when ground is opened up and Sanitarian
will recommend repair system.


10/12/72 - trench 9ft deep - 50ft long - 5ft of gravel
under pipe. Call for ins of trench before gravel is installed

PLANS APPROVED BY Palmer F. Wine DATE 10/10/72

FILL SEPTIC TANK AND DISTRIBUTION BOX WITH WATER BEFORE CALLING FOR AN INSPECTION. COVER NO WORK UNTIL INSPECTED AND APPROVED.

NEITHER THE HOWARD COUNTY COMMISSIONERS NOR THE HEALTH DEPARTMENT IS RESPONSIBLE FOR THE SUCCESSFUL OPERATION OF ANY SYSTEM.

17554

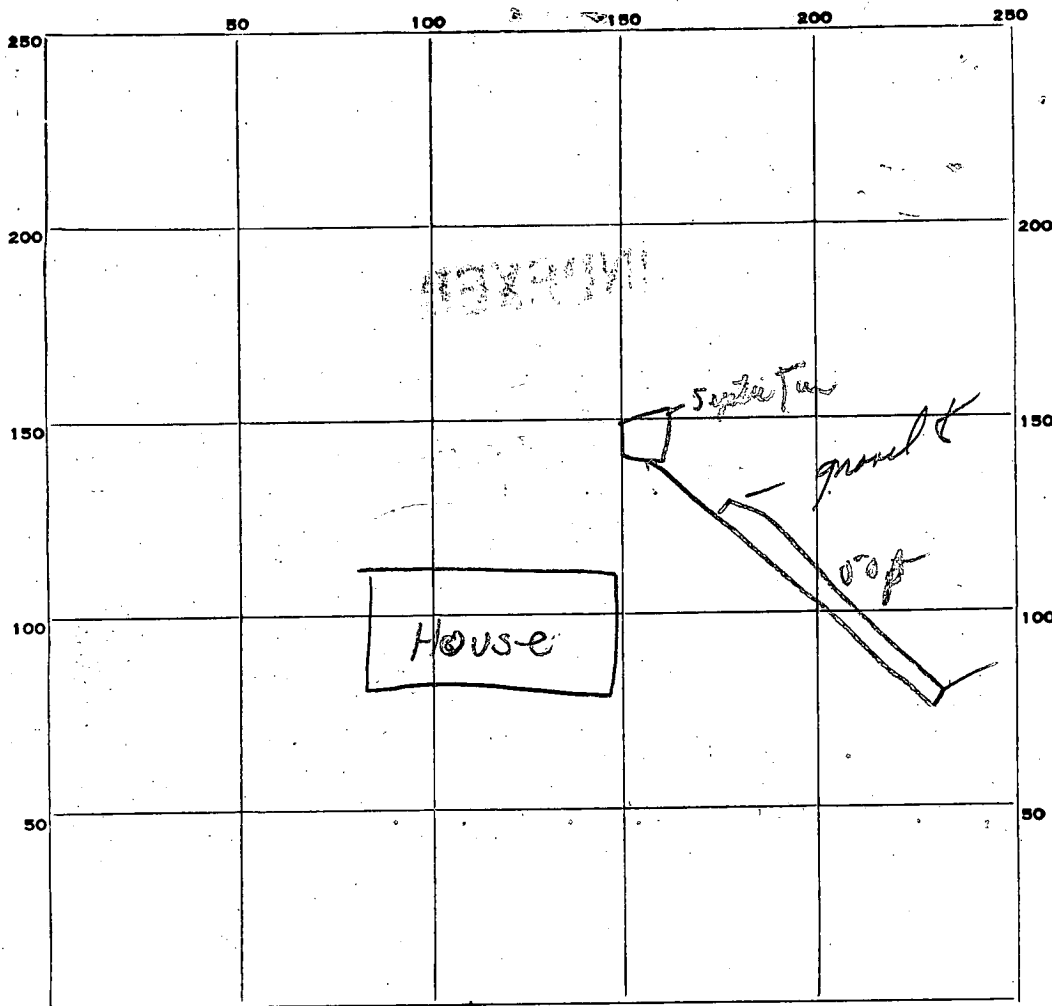

INDICATE NORTH - NAME ADJOINING ROADWAY AS BASE LINE.
ST Michaels

PERMIT CARD OK

SEPTIC TANK, LEVEL _____

CLEANOUTS _____

DISTRIBUTION BOX, LEVEL _____

TILE FIELD, DEPTH 9 FT. TRENCH WIDTH 2 FT.

GRAVEL DEPTH 60 IN. TOTAL LENGTH 50 FT.

NUMBER OF TRENCHES 1 TOTAL BOTTOM AREA 100

SEEPAGE PITS, INSIDE DIAMETER _____ FT. DEPTH BELOW INLET _____ FT.

ABSORBENT AREA 500 SQ. FT.

REMARKS

AM 10/2/75 OK I put gravel in trench


DATE SYSTEM APPROVED

10/12/72

INSPECTOR

Don M...

B00/20288
 1120 St. Michael's Rd
 (BPL for Pole Barn)
 No Conflict with Septic or
 well - recommend approval
 AP 9/8/99

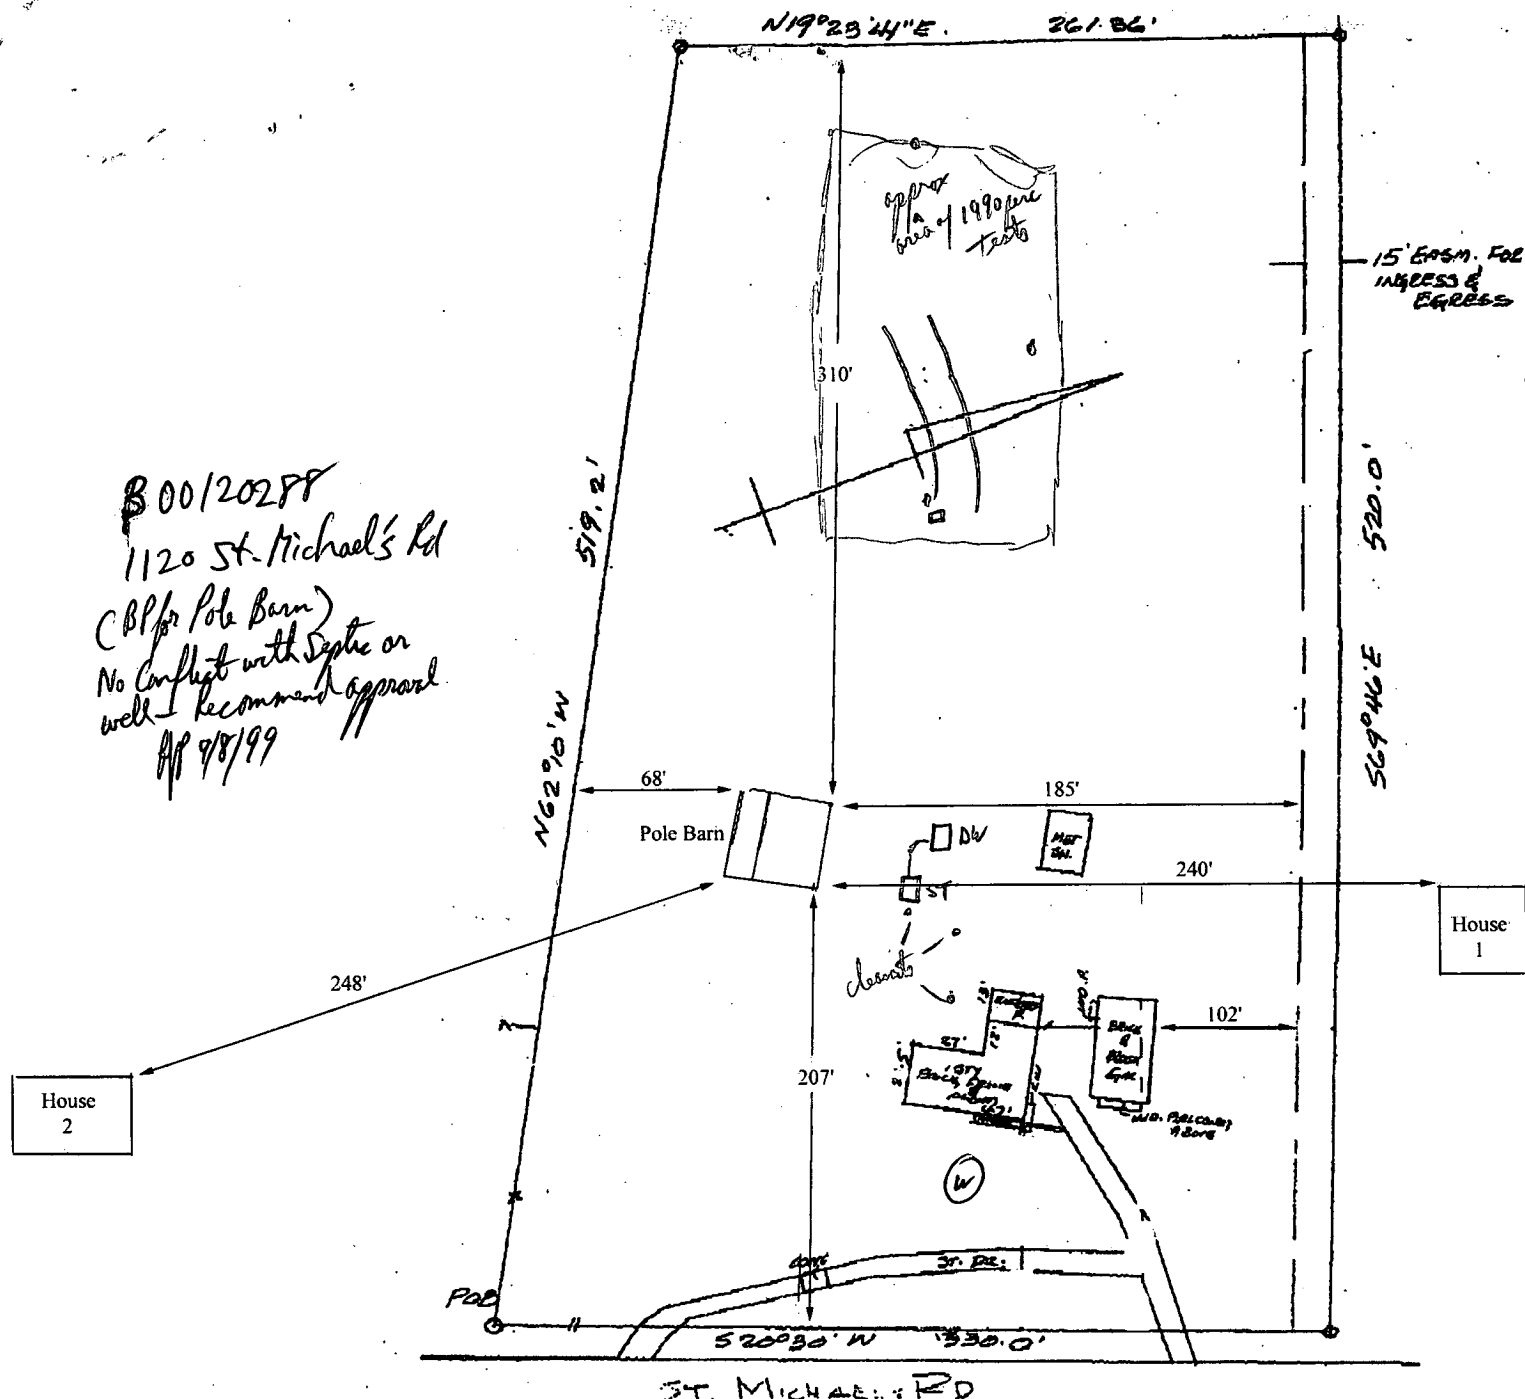

The plat is of benefit to a consumer only insofar as it is required by a lender or title insurance company or its agent in connection with contemplated transfer, financing or refinancing. The plat is not to be relied upon for the establishment or location of fences, garages, buildings, or other existing or future improvements. The plat does not provide for the accurate identification of property boundary lines, but such identification may not be required for the transfer of title or securing financing or refinancing.

THE LOT SHOWN HEREON IS IN FLOOD ZONE C PER F.E.M.A. LOOD INSURANCE RATE MAP PANEL # 2400430001D

#1120 SAINT MICHAELS ROAD
 TITLE DEED 4162-500
 HOWARD CO. MD.

out of scale
 somewhere between
 80 & 90 scale
 due to magnification

SCALE	1"=60'
DATE	10-1-99
JOB No.	98-1807

LOCATION CERTIFICATION	
WITZ & ASSOCIATES GENERAL SURVEYING CO.	
7222 KENNEBUNK ROAD BALTIMORE, MD 21244 (410) 597-9995	4131 KAHLSTON ROAD BALTIMORE, MD 21238 (410) 256-8428

