

Tax ID 03-291340

PERMIT

SEWAGE DISPOSAL SYSTEM

DEPARTMENT OF HEALTH AND MENTAL HYGIENE

P 46692

A REPAIR

DISTRICT

DATE 12/13/90

HOWARD COUNTY HEALTH DEPARTMENT

BUREAU OF ENVIRONMENTAL HEALTH

461-9933

DATE SYSTEM APPROVED 12/26/91

INSPECTOR [Signature]

INDEXED

Naylor Plumbing & Heating

IS PERMITTED TO INSTALL ☒ ALTER ☐

ADDRESS 831 Wesley Road, Finksburg, Maryland 21048 PHONE 239 8141

SUBDIVISION River Park Estates LOT 10 ROAD 1035 River Road

PROPERTY OWNER Mr. David P. Smith

ADDRESS

SEPTIC TANK CAPACITY 750 GALLONS USE OLD TANK INSTALL MANHOLE ON IT
NUMBER OF BEDROOMS 3 HOLDING TANK 350 GAL INSTALL MANHOLE & PUMP

1800 SQUARE FEET PER BEDROOM

LINEAR FEET OF TRENCH REQUIRED 540

REPAIR - TO REPAIR FAILING SEPTIC SYSTEM. CALL FOR INSPECTION WHEN GROUND IS OPENED SO
SANITARIAN CAN RECOMMEND REPAIR.

PLACE TRENCH IN BACK YARD 40 FT FROM THE POOL
& BETWEEN THE POOL & THE BACK LINE TRENCH TO BE
3 FT WIDE, 1 1/2 TO 2 FT DEPTH OF STONE & 3-4 FT DEEP
180 FT LONG

PLANS APPROVED BY Craig Williams cm DATE 12/13/90

COVER NO WORK UNTIL INSPECTED AND APPROVED

NEITHER THE HOWARD COUNTY COUNCIL NOR THE HEALTH DEPARTMENT IS RESPONSIBLE FOR THE SUCCESSFUL OPERATION OF ANY SYSTEM

NOTE: CLEANOUT REQUIRED EVERY 70 FEET OF SEWER LINE AND/OR AT 90° SWEEPS IN LINES FROM HOUSE TO DRAIN FIELDS, 90° ELBOWS NOT ACCEPTABLE.

NOTE: ALL PARTS OF SEPTIC SYSTEMS (I.E. TANK, DISTRIBUTION BOX TRENCHES) TO BE 100 FEET FROM WELL (UNLESS OTHERWISE SPECIFICALLY AUTHORIZED)

NOTE: IF DEEP TRENCH(ES) ARE USED CALL FOR INSPECTION BEFORE AND AFTER PLACING GRAVEL IN TRENCH(ES)

NOTE: NO DRY WELL SHALL EXCEED 15 FOOT IN DIAMETER NO ABSORPTION TRENCH TO EXCEED 100 FEET IN LENGTH

NOTE: ALL PIPE FROM HOUSE TO SEPTIC TANK MUST BE CAST IRON OR SCHEDULE 35/40 PVC OR ABS

PERMIT VOID AFTER TWO YEARS

NOTE: INSTALL STAND PIPE ON SEPTIC TANK AND DRY WELL STAND PIPES MUST BE 6 INCHES IN DIAMETER CAST IRON, CONCRETE OR TERRA COTTA OR PVA OR ABS ACCEPTED. IF TOP OF SEPTIC TANK IS DEEPER THAN 3 FEET, MANHOLE TO GRADE REQUIRED.

NOTE: DISTRIBUTION BOXES MUST HAVE BAFFLES

*INSTALLER IS RESPONSIBLE FOR OBTAINING FINAL APPROVAL ON THIS PERMIT

P 46692

9/14/62 7:00
9/25/62

PERMIT

SEWAGE DISPOSAL SYSTEM

MARYLAND STATE DEPARTMENT OF HEALTH

HOWARD COUNTY

ELLICOTT CITY

DISTRICT 3

INDEXED
DATE 9/11/62

~~is supposed to be retested~~
INDEXED
Carl Williams

IS PERMITTED TO INSTALL ☒ ALTER ☐

ADDRESS _____ PHONE _____

A SEWAGE DISPOSAL-SYSTEM LOCATED AT _____

SUBDIVISION River Park Estates ROAD 1035 River Road LOT 10

PROPERTY OWNER Wm. Brookhart Edward P. Smith

ADDRESS _____

SPECIFICATIONS

DRAIN FIELD ☒ DEPTH _____ FEET, BOTTOM AREA 300 SQ. FT.

SEEPAGE PITS _____ ABSORBENT SIDE-WALL AREA _____ SQ. FT.

SEPTIC TANK CAPACITY 750 GALLONS

FOR GARBAGE GRINDER, INCREASE DISPOSAL AREA 22% & TANK CAPACITY 50%.

OTHER

Place the tile field about 130 to 180 feet from rear of lot and about 40 to 90 feet from right side of lot (determined as you face lot from River Rd.).

Retested 14 Sept 62 Place a 300 sq ft tile field between Lot # 11 and the house


PLANS APPROVED BY DWM DATE 4/6/62

FILL SEPTIC TANK AND DISTRIBUTION BOX WITH WATER BEFORE CALLING FOR AN INSPECTION. COVER NO WORK UNTIL INSPECTED AND APPROVED.

NEITHER THE HOWARD COUNTY COMMISSIONERS NOR THE HEALTH DEPARTMENT IS RESPONSIBLE FOR THE SUCCESSFUL OPERATION OF ANY SYSTEM.

BLDG. PERMIT SIGNED
AND RETURNED 9/14/62
Serial # 70447

A 04939

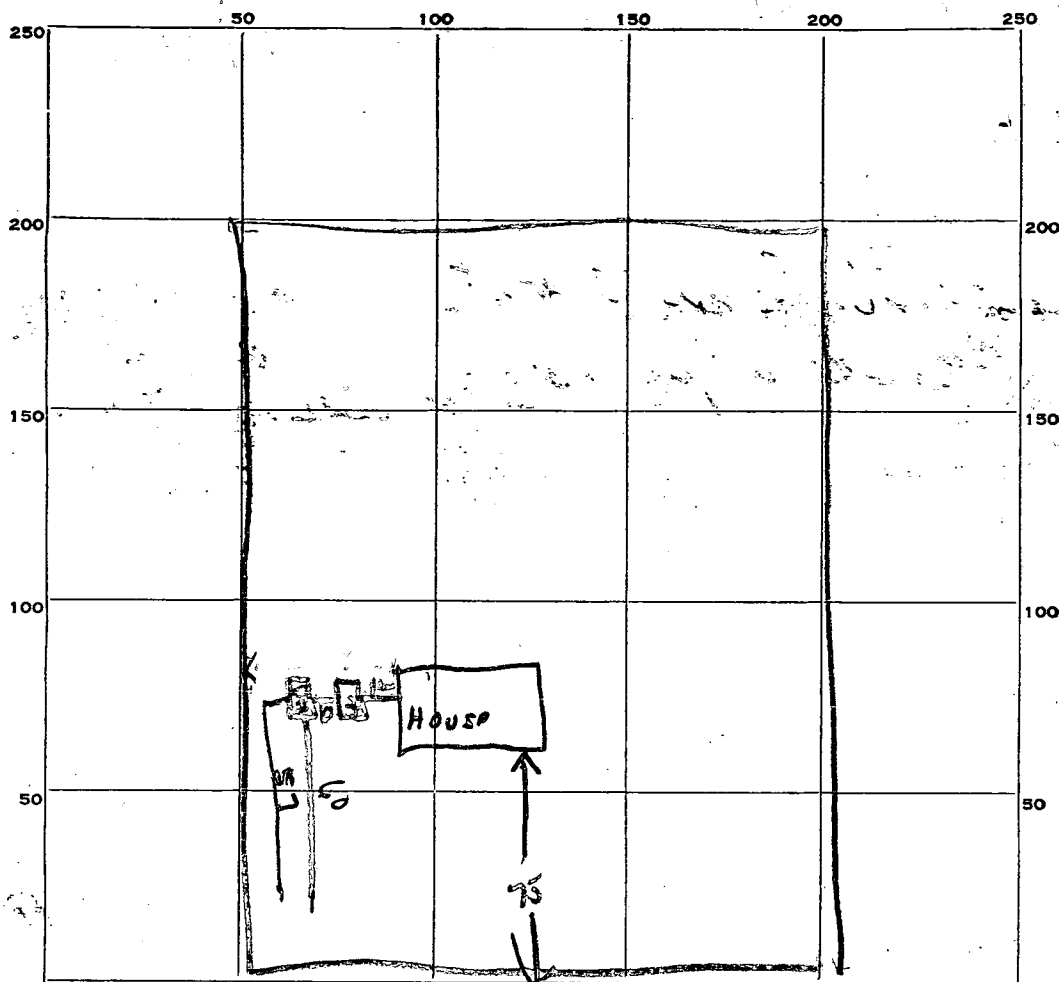

INDICATE NORTH. - NAME ADJOINING ROADWAY AS BASE LINE.

River Road

PERMIT CARD OK

SEPTIC TANK, LEVEL OK

CLEANOUTS OK

DISTRIBUTION BOX, LEVEL OK

TILE FIELD, DEPTH 2 1/4 to 3 1/2 FT. TRENCH WIDTH 3 FT.

GRAVEL DEPTH 12 IN. TOTAL LENGTH 117 FT.

NUMBER OF TRENCHES 2 TOTAL BOTTOM AREA 35 sq ft

SEEPAGE PITS, INSIDE DIAMETER _____ FT. DEPTH BELOW INLET _____ FT.

ABSORBENT AREA _____ SQ. FT.

REMARKS _____

DATE SYSTEM APPROVED

9/34/62

INSPECTOR

DW Monaghan

9/14/62
1:00

APPLICATION

Retest

A 05774

P _____

SEWAGE DISPOSAL TESTING

MARYLAND STATE DEPARTMENT OF HEALTH

HOWARD COUNTY

ELLICOTT CITY

DISTRICT 3

DATE 9/14/62

*14 Sept 62 - See permit for
new tile field location*

TO: THE COUNTY HEALTH OFFICER
ELLICOTT CITY, MARYLAND

I, HEREBY, APPLY FOR THE NECESSARY TESTS IN ORDER TO CONSTRUCT (OR RECONSTRUCT) A SEWAGE DISPOSAL SYSTEM.

PROPERTY OWNER

Wm. Brookhart

ADDRESS

PHONE

PROPERTY LOCATION:

SUBDIVISION

River Park Estates

LOT NO.

10

ROAD AND DESCRIPTION

River Rd.

OCCUPANT

PHONE

PERSON TO CONSTRUCT SYSTEM

ADDRESS

PHONE

SIZE OF LOT

140' X 315'

TYPE BLDG.

3

NUMBER OF BEDROOMS

IF NOT SINGLE RESIDENCE DESCRIBE

SIGNATURE OF APPLICANT

Carl A W Williams

APPROVED BY

R/T

FOR

Tile Field

(KIND OF SYSTEM)

DATE

19 Sept 62

REJECTED BY

FOR

(KIND OF SYSTEM)


DATE

HOLD PENDING FURTHER TESTS

DATE

REASONS FOR REJECTION OR HOLDING

THIS IS NOT A PERMIT

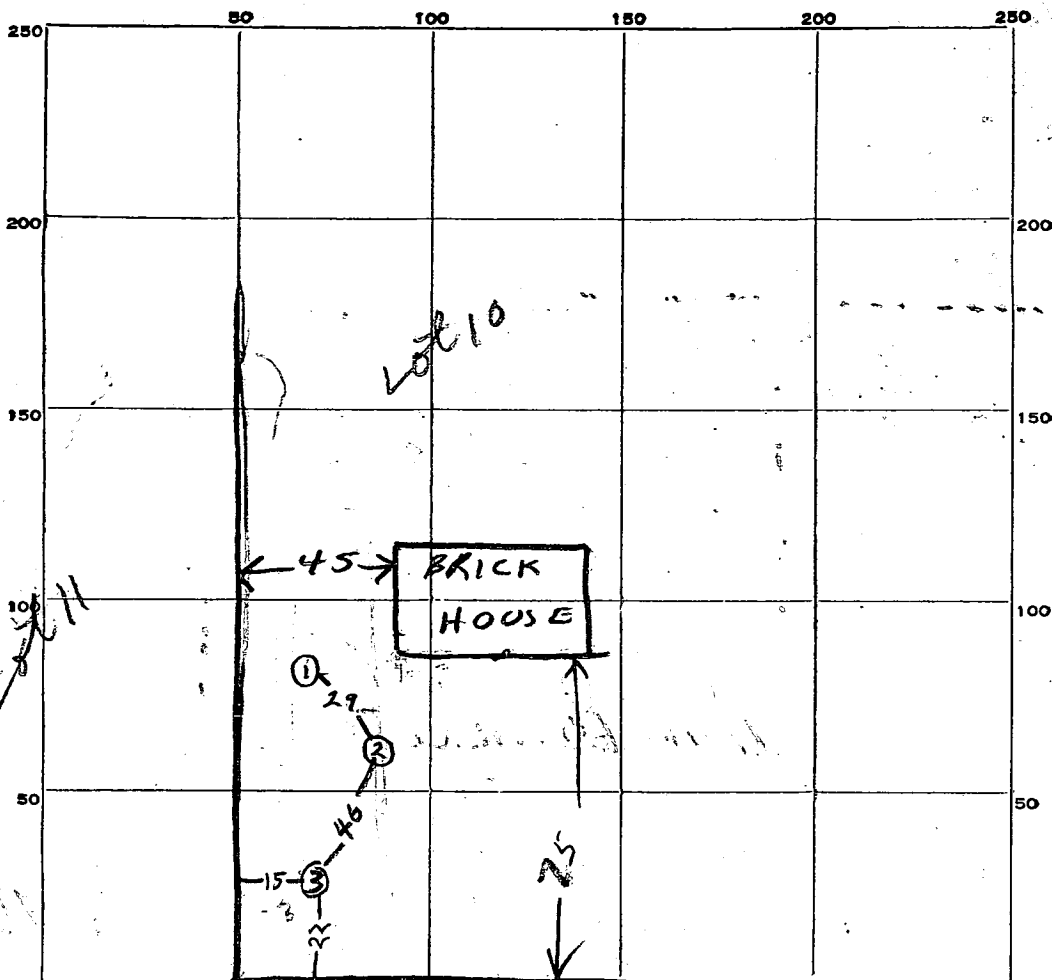

INDICATE NORTH. - NAME ADJOINING ROADWAY AS BASE LINE.

River Road

to Route 32

DATE	TEST NO.	DEPTH	PRE-WET		TEST - 1" DROP		TIME
			START	STOP	START	STOP	
14 Sept 69	1	3	102	103	103	104	1 min
" "	2	3	106	107	107	108	1 min
" "	3	3	111	112	112	113	1 min

SOIL AUGER FINDING

TESTED BY

Raymond Hodges

REMARKS

ALSO PRESENT

LOT NO.

APPLICATION

SEWAGE DISPOSAL TESTING

MARYLAND STATE DEPARTMENT OF HEALTH

HOWARD COUNTY

ELLICOTT CITY

DISTRICT 3

DATE 4/3/62

Septic Tank - 750 gal

Tile Field - 300 sq ft absorbent bottom area

*Place Tile Field about 130 ft to 180 ft from rear of lot
and about 40 to 90 ft from right side of lot. Right side
is determined as you face lot from Brown Rd*

TO: THE COUNTY HEALTH OFFICER
ELLICOTT CITY, MARYLAND

I, HEREBY, APPLY FOR THE NECESSARY TESTS IN ORDER TO CONSTRUCT (OR RECONSTRUCT) A SEWAGE DISPOSAL SYSTEM.

PROPERTY OWNER WM. Brookhart

ADDRESS 937 Homestead Rd.

Balt

PHONE

PROPERTY LOCATION:

SUBDIVISION River Park Estates

LOT NO.

*10 Chicago
Bum
4-1-62*

ROAD AND DESCRIPTION River Road

OCCUPANT

PHONE

PERSON TO CONSTRUCT SYSTEM

ADDRESS

PHONE

SIZE OF LOT 140' X 315'

TYPE BLDG

NUMBER OF BEDROOMS 3

IF NOT SINGLE RESIDENCE DESCRIBE

SIGNATURE OF APPLICANT

Robert E. McKeen

APPROVED BY

Donald W. Monaghan

FOR

Tile Field
(KIND OF SYSTEM)

DATE

4-6-62

REJECTED BY

FOR

(KIND OF SYSTEM)


DATE

HOLD PENDING FURTHER TESTS

DATE

REASONS FOR REJECTION OR HOLDING

THIS IS NOT A PERMIT

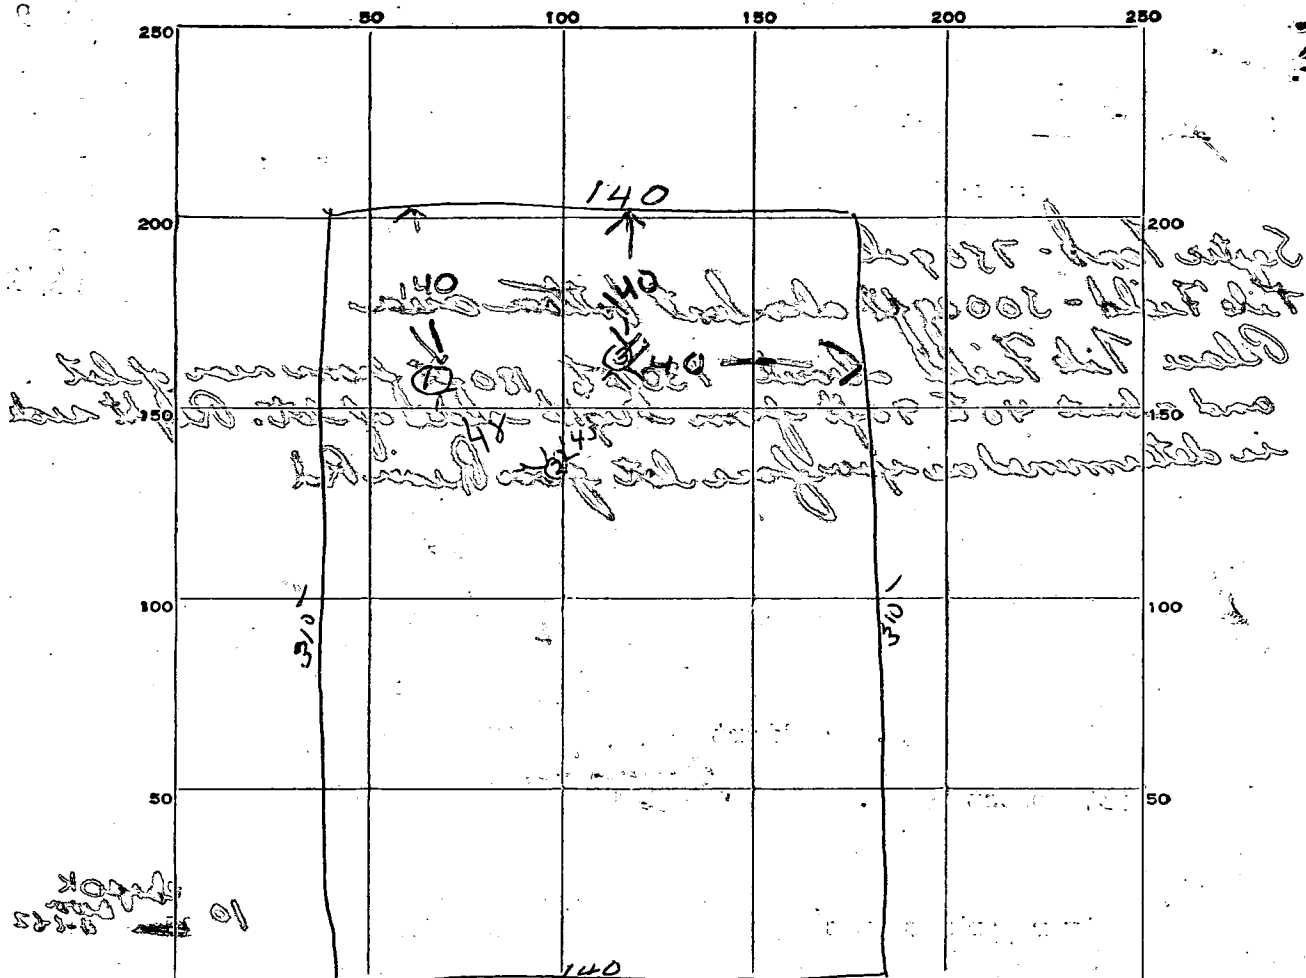

INDICATE NORTH. - NAME ADJOINING ROADWAY AS BASE LINE.

DATE	TEST NO.	DEPTH	PRE-WET		TEST - 1" DROP		TIME
			START	STOP	START	STOP	
4	1	3 1/2	1259	100	100	105	5 min
	2	3 1/2	100	103	103	108	5 min
	3	3 1/2	102	105	105	112	7 min

SOIL AUGER FINDING

TESTED BY

JWM-4-6-62

REMARKS


ALSO PRESENT

Robert E. McNamee LOT NO. 10

Property known as LOT 10
SECTION 2
RIVER PARK ESTATES PB B/51
3RD ELECTION DISTRICT
HOWARD COUNTY, MD

THIS PLAT CAN NOT BE USED TO ESTABLISH PROPERTY
LINES OR CORNERS.

RIVER ROAD

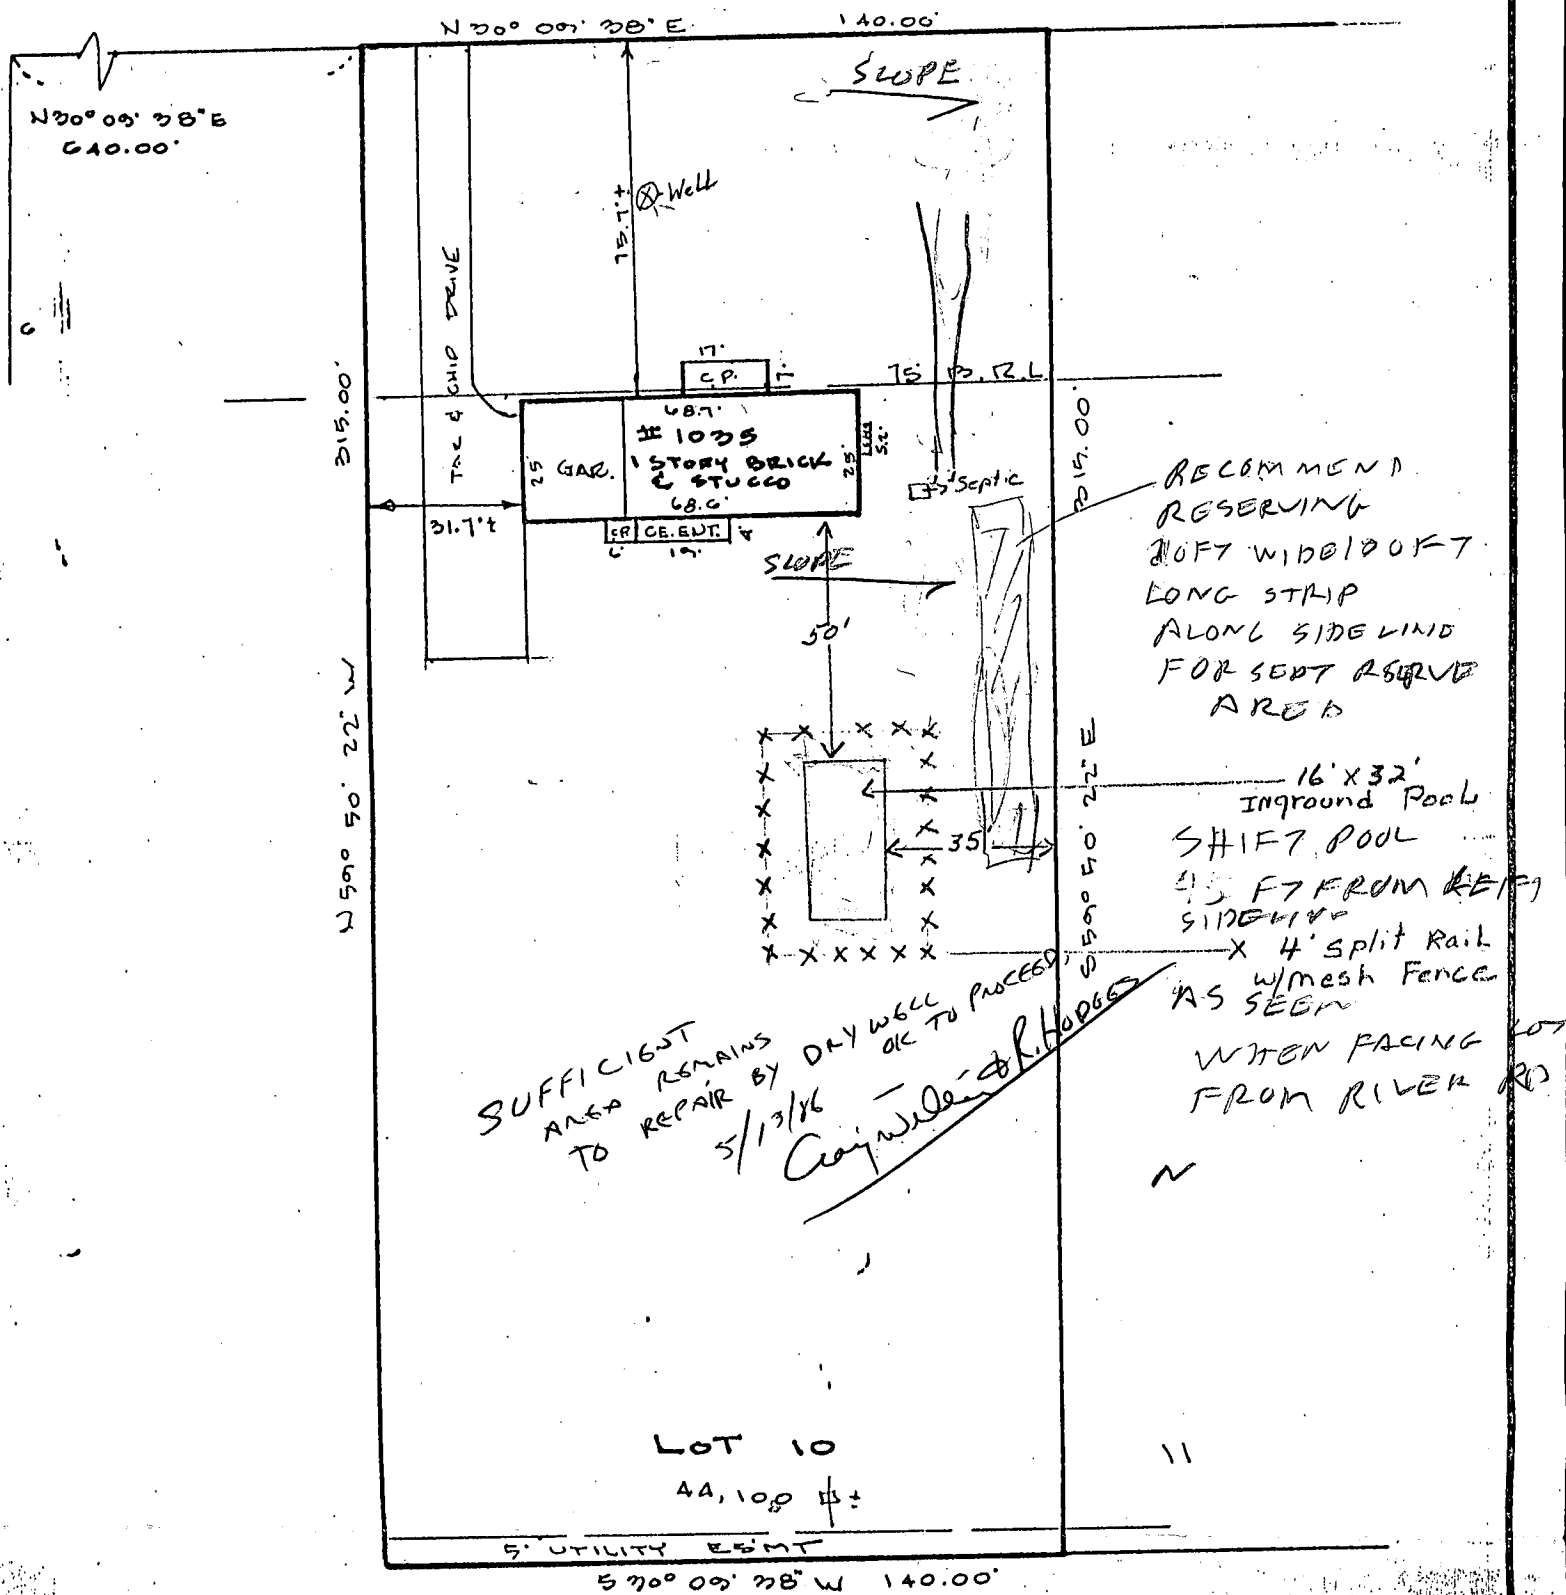

LOCATION SURVEY PLAT

CERTIFICATION

This is to certify that I have surveyed
the property known as:
1035 RIVER ROAD

for the purpose of locating the im-
provements thereon, and the improvements
are located as shown.

SEAL



Walter Park

SCALE 1" = 40'

DATE 4-28-1986

PHONE
828-9060 TOWSON
730-9060 COLUMBIA

HUDKINS ASSOCIATES, INC.
Surveyors and Subdivision Designers

SUITE 231, JOSEPH SQUARE
5485 HARPERS FARM ROAD
WALTER PARK, L.S. COLUMBIA, MARYLAND 21044
5539