

12/18/00
Copy to [unclear] 10:00 + [unclear]

PERMIT

SEWAGE DISPOSAL SYSTEM

HOWARD COUNTY HEALTH DEPARTMENT
BUREAU OF ENVIRONMENTAL HEALTH
410-313-2640

P 514671

A 47050

ISSUE DATE 11/27/2000

APPROVAL DATE 12/18/00

INDEXED

#3556D

South Carroll Backhoe, Inc.

IS PERMITTED TO INSTALL X ALTER

ADDRESS 4410 Salem Bottom Road, Westminster, MD 21157

PHONE 410-875-4197

SUBDIVISION Scott's Delight

LOT NUMBER 3

ADDRESS 1280 St. Michaels Road

PROPERTY OWNER Knudsen Building Co., Inc.

PROPERTY OWNER'S ADDRESS 8455 Baltimore Natl Pike

SEPTIC TANK CAPACITY 2000 GALLONS

Ellicott City, MD 21043

PUMP CHAMBER CAPACITY N/A GALLONS

NUMBER OF BEDROOMS 6

*** TOP SEAMED SEPTIC TANK REQUIRED ***

SQUARE FEET PER BEDROOM 210

LINEAR FEET OF TRENCH REQUIRED 420

OLD PERMITS
AND REVISIONS

10-24-01
300132927
BUD 16x24 DECK

TRENCHES: Trenches to be 2 feet wide. Inlet 4 feet below original grade. Bottom maximum depth 7 feet below original grade. 3 feet of stone below distribution box.

LOCATION: Begin trenches 205 feet off the front lot line and 85 feet off the right lot line as seen when facing the lot from St. Michaels Road. Run trenches on contour in both directions.

TRENCHES MUST STAY 8' EDGE TO EDGE TO CONSERVE
FUTURE REPAIR AREA - CONTRACTOR SHOULD CALL AND SET UP
LAYOUT INSP TO VERIFY THIS CAN BE DONE AS PER CONTOUR

PLANS APPROVED Amy McMillen

OK SRK 8/4/00

DATE 7/10/2000

PERMIT VOID AFTER 2 YEARS

(NOTE) CONTRACTOR RESPONSIBLE FOR SCHEDULING A PRE-CONSTRUCTION INSPECTION FOR ALL INSTALLATIONS

NOTE: TOP OF SEPTIC TANKS ARE TO BE NO DEEPER THAN 3.0 FEET BELOW FINISH GRADE

NOTE: WATERTIGHT SEPTIC TANKS REQUIRED

NOTE: CLEANOUT REQUIRED EVERY 70 FEET OF SEWER LINE AND/OR AT 90° SWEEPS IN LINES FROM HOUSE TO DRAIN FIELDS, 90° ELBOWS ARE NOT ACCEPTABLE

NOTE: ALL PARTS OF SEPTIC SYSTEMS (I.E. TANK, DISTRIBUTION BOX, DRAINFIELDS) TO BE 100 FEET FROM ANY WATER BODY UNLESS OTHERWISE SPECIFICALLY AUTHORIZED

NOTE: NO ABSORPTION TRENCH TO EXCEED 100 FEET IN LENGTH UNLESS SPECIFICALLY AUTHORIZED

NOTE: ALL PIPE FROM HOUSE TO SEPTIC TANK MUST BE CAST IRON OR SCHEDULE 35/40 PVC OR ABS

NOTE: MANHOLE RISERS REQUIRED ON ALL SEPTIC TANKS AND PUMP CHAMBERS

NOTE: DISTRIBUTION BOXES MUST HAVE BAFFLES

NOTE: IF PUMPED SEPTIC SYSTEM REQUIRED, (1) SEPTIC PUMP DETAIL TO BE PROVIDED BY INSTALLER PRIOR TO ISSUANCE OF SEPTIC PERMIT (2) PUMP PERFORMANCE TEST IS NECESSARY PRIOR TO HEALTH DEPARTMENT APPROVAL OF SEPTIC PERMIT

NEITHER THE HOWARD COUNTY COUNCIL NOR THE HEALTH DEPARTMENT IS RESPONSIBLE FOR THE
SUCCESSFUL OPERATION OF ANY SYSTEM

PERMITTEE RESPONSIBLE FOR OBTAINING FINAL APPROVAL ON THIS PERMIT


CALL 410-313-2640 FOR INSPECTION OF SEPTIC SYSTEM

BUILDING PERMIT SIGNED
AND RETURNED

6-18-03 BODIN 248-DECK

A 47050

NOT TO SCALE

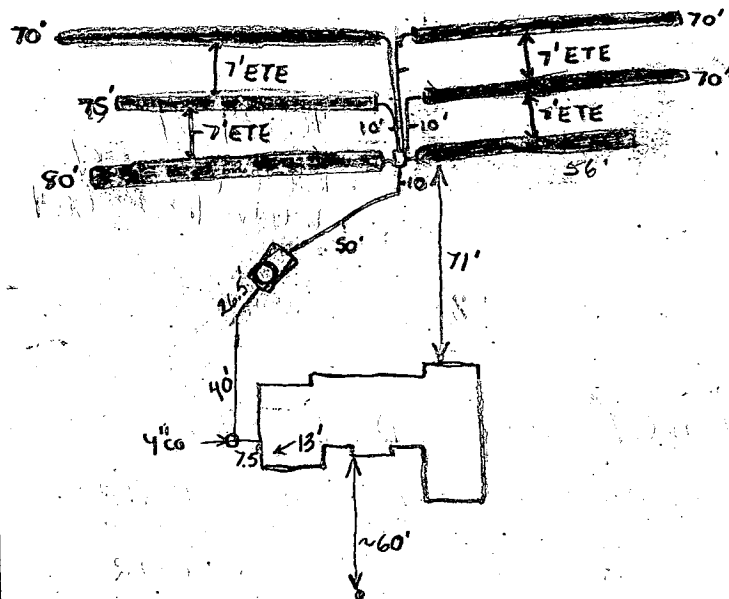

TRENCH DATA

TRENCH WIDTH 2'
 TRENCH INLET DEPTH 4'
 TRENCH BOTTOM DEPTH 7'
 DEPTH OF STONE 3'
 NUMBER OF TRENCHES 6
 TOTAL TRENCH LENGTH 421'
 ABSORBENT AREA 1263 ft²
 DISTRIBUTION BOX LEVEL ✓
 BAFFLE IN DISTRIBUTION BOX ✓

SEPTIC TANK DATA

SEPTIC TANK 2000 TS GALLONS
 MANHOLE RISER on Front
 6 INCH INSPECTION PORT NA

PUMP CHAMBER DATA

PUMP CHAMBER GALLONS NA
 MANHOLE RISER NA
 ALARM NA
 PUMP PERFORMANCE TEST NA

PRE-CONSTRUCTION INSPECTION: 12/15/00 6-70' trenches with box in center of easement,
 7' spacing between trenches (BB)

INSPECTION COMMENTS: 12/15/00 HRD O.K. Hit excessive rock at end of first trench. To try to make up remaining length from other 5 trenches (BB)
12/18/00 - OK TO COVER ALL WORK - (SRW)

INSPECTOR Steven R. Krieg

DATE SYSTEM APPROVED 12/18/00

403.86'

Total linear feet of trench
required 420 feet

Width of trench(es) 3.0 feet

Depth of trench(es) 4.0 feet


Depth of stone required below
distribution pipe 2.0 feet


Approved Septic System Plan
Howard County Health Department


Amey M. Hill 7/10/00
Signature Date

NORTH

7/10/00
Field Elev.
different
than
Preliminary
plan elevations
Elevations on
plan adjusted
accordingly
AK

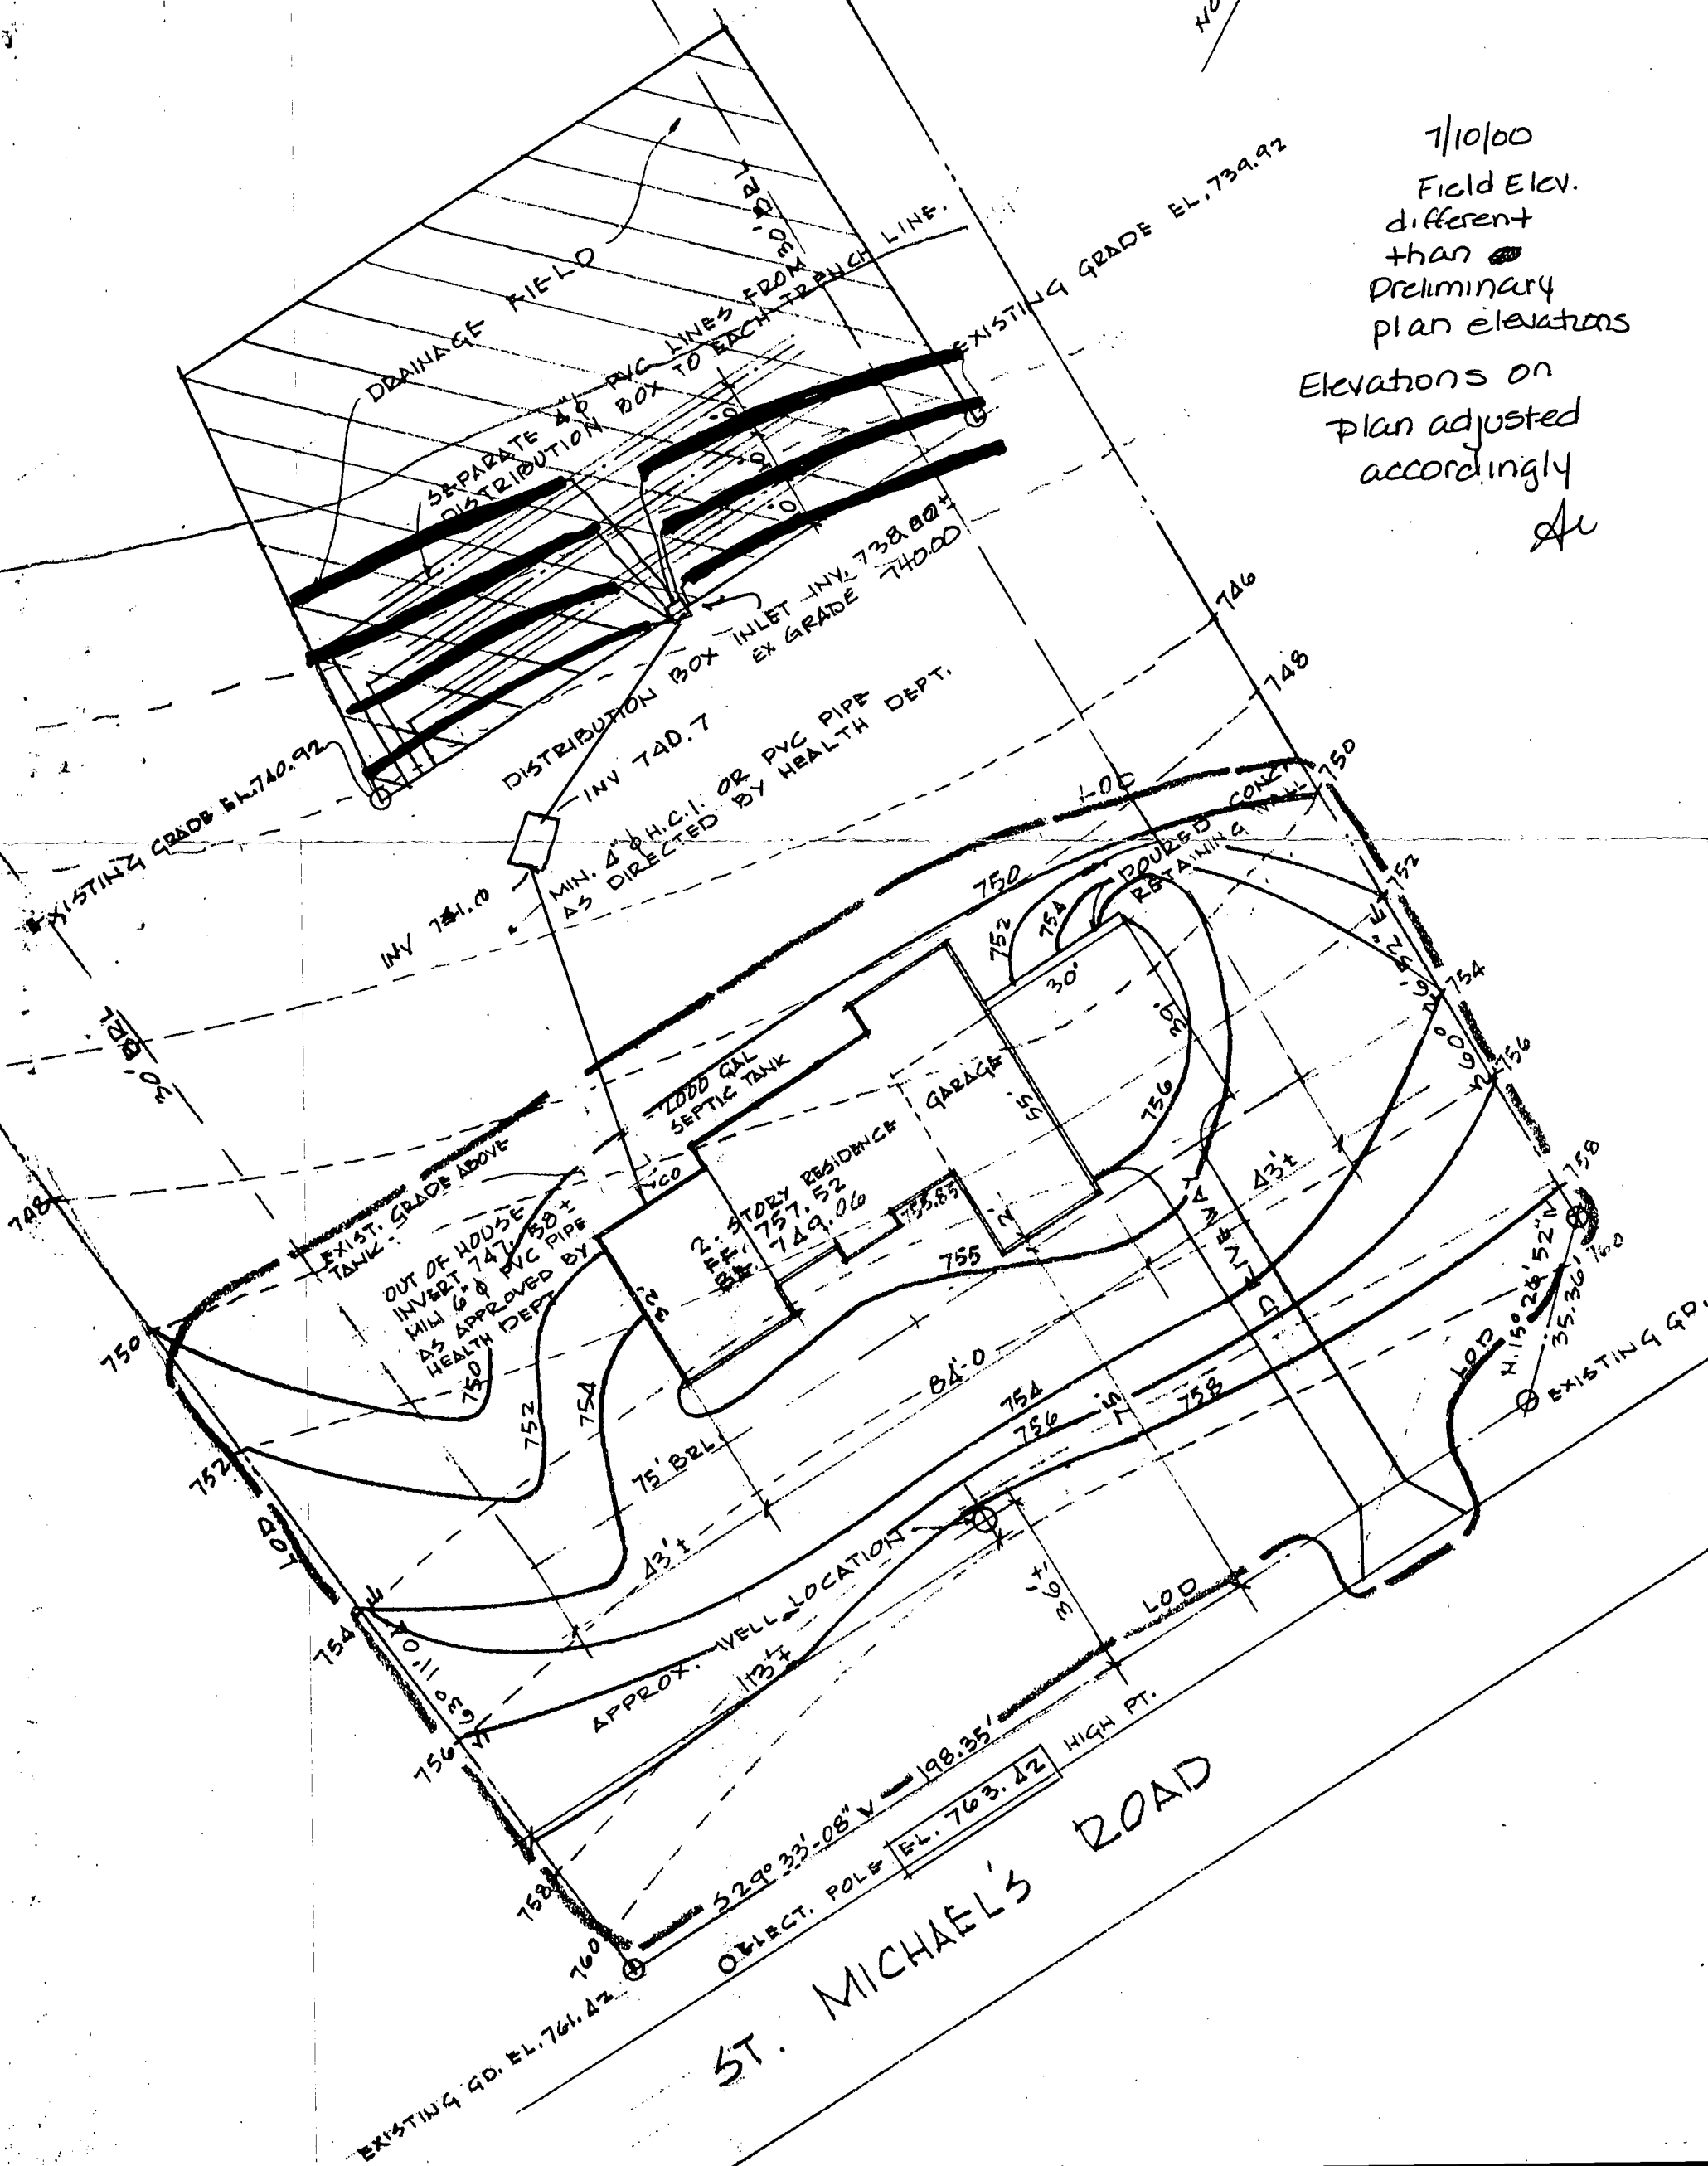

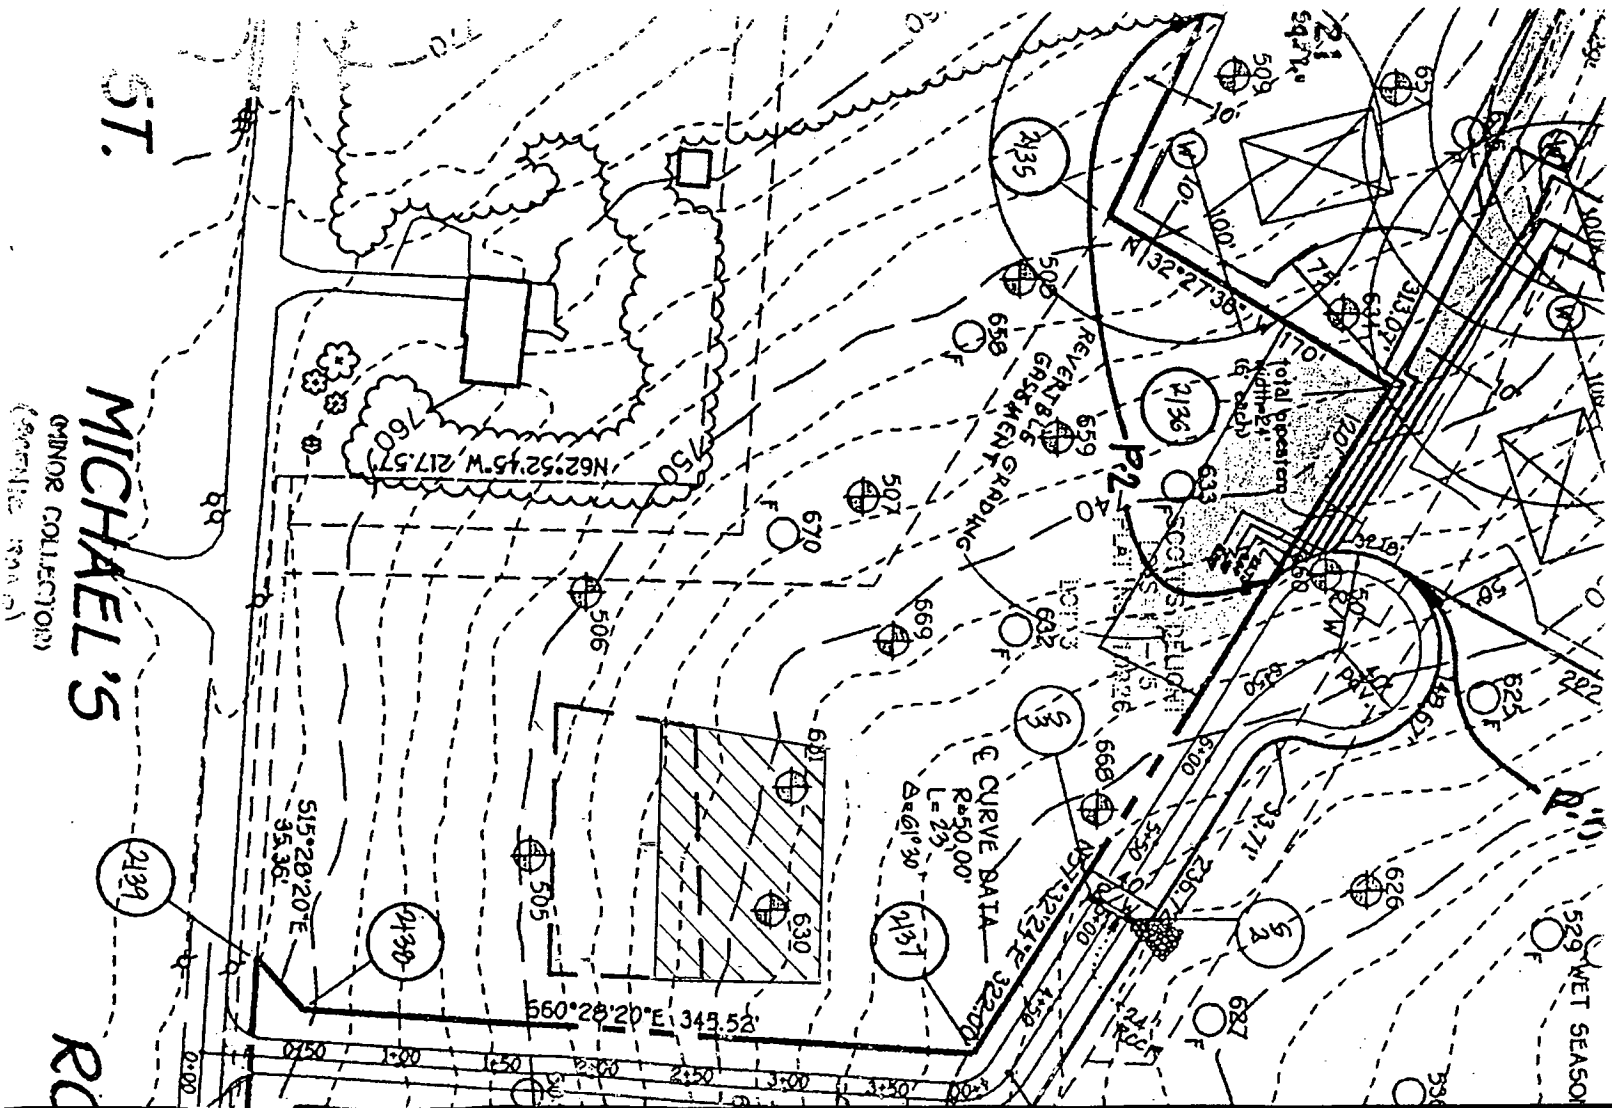

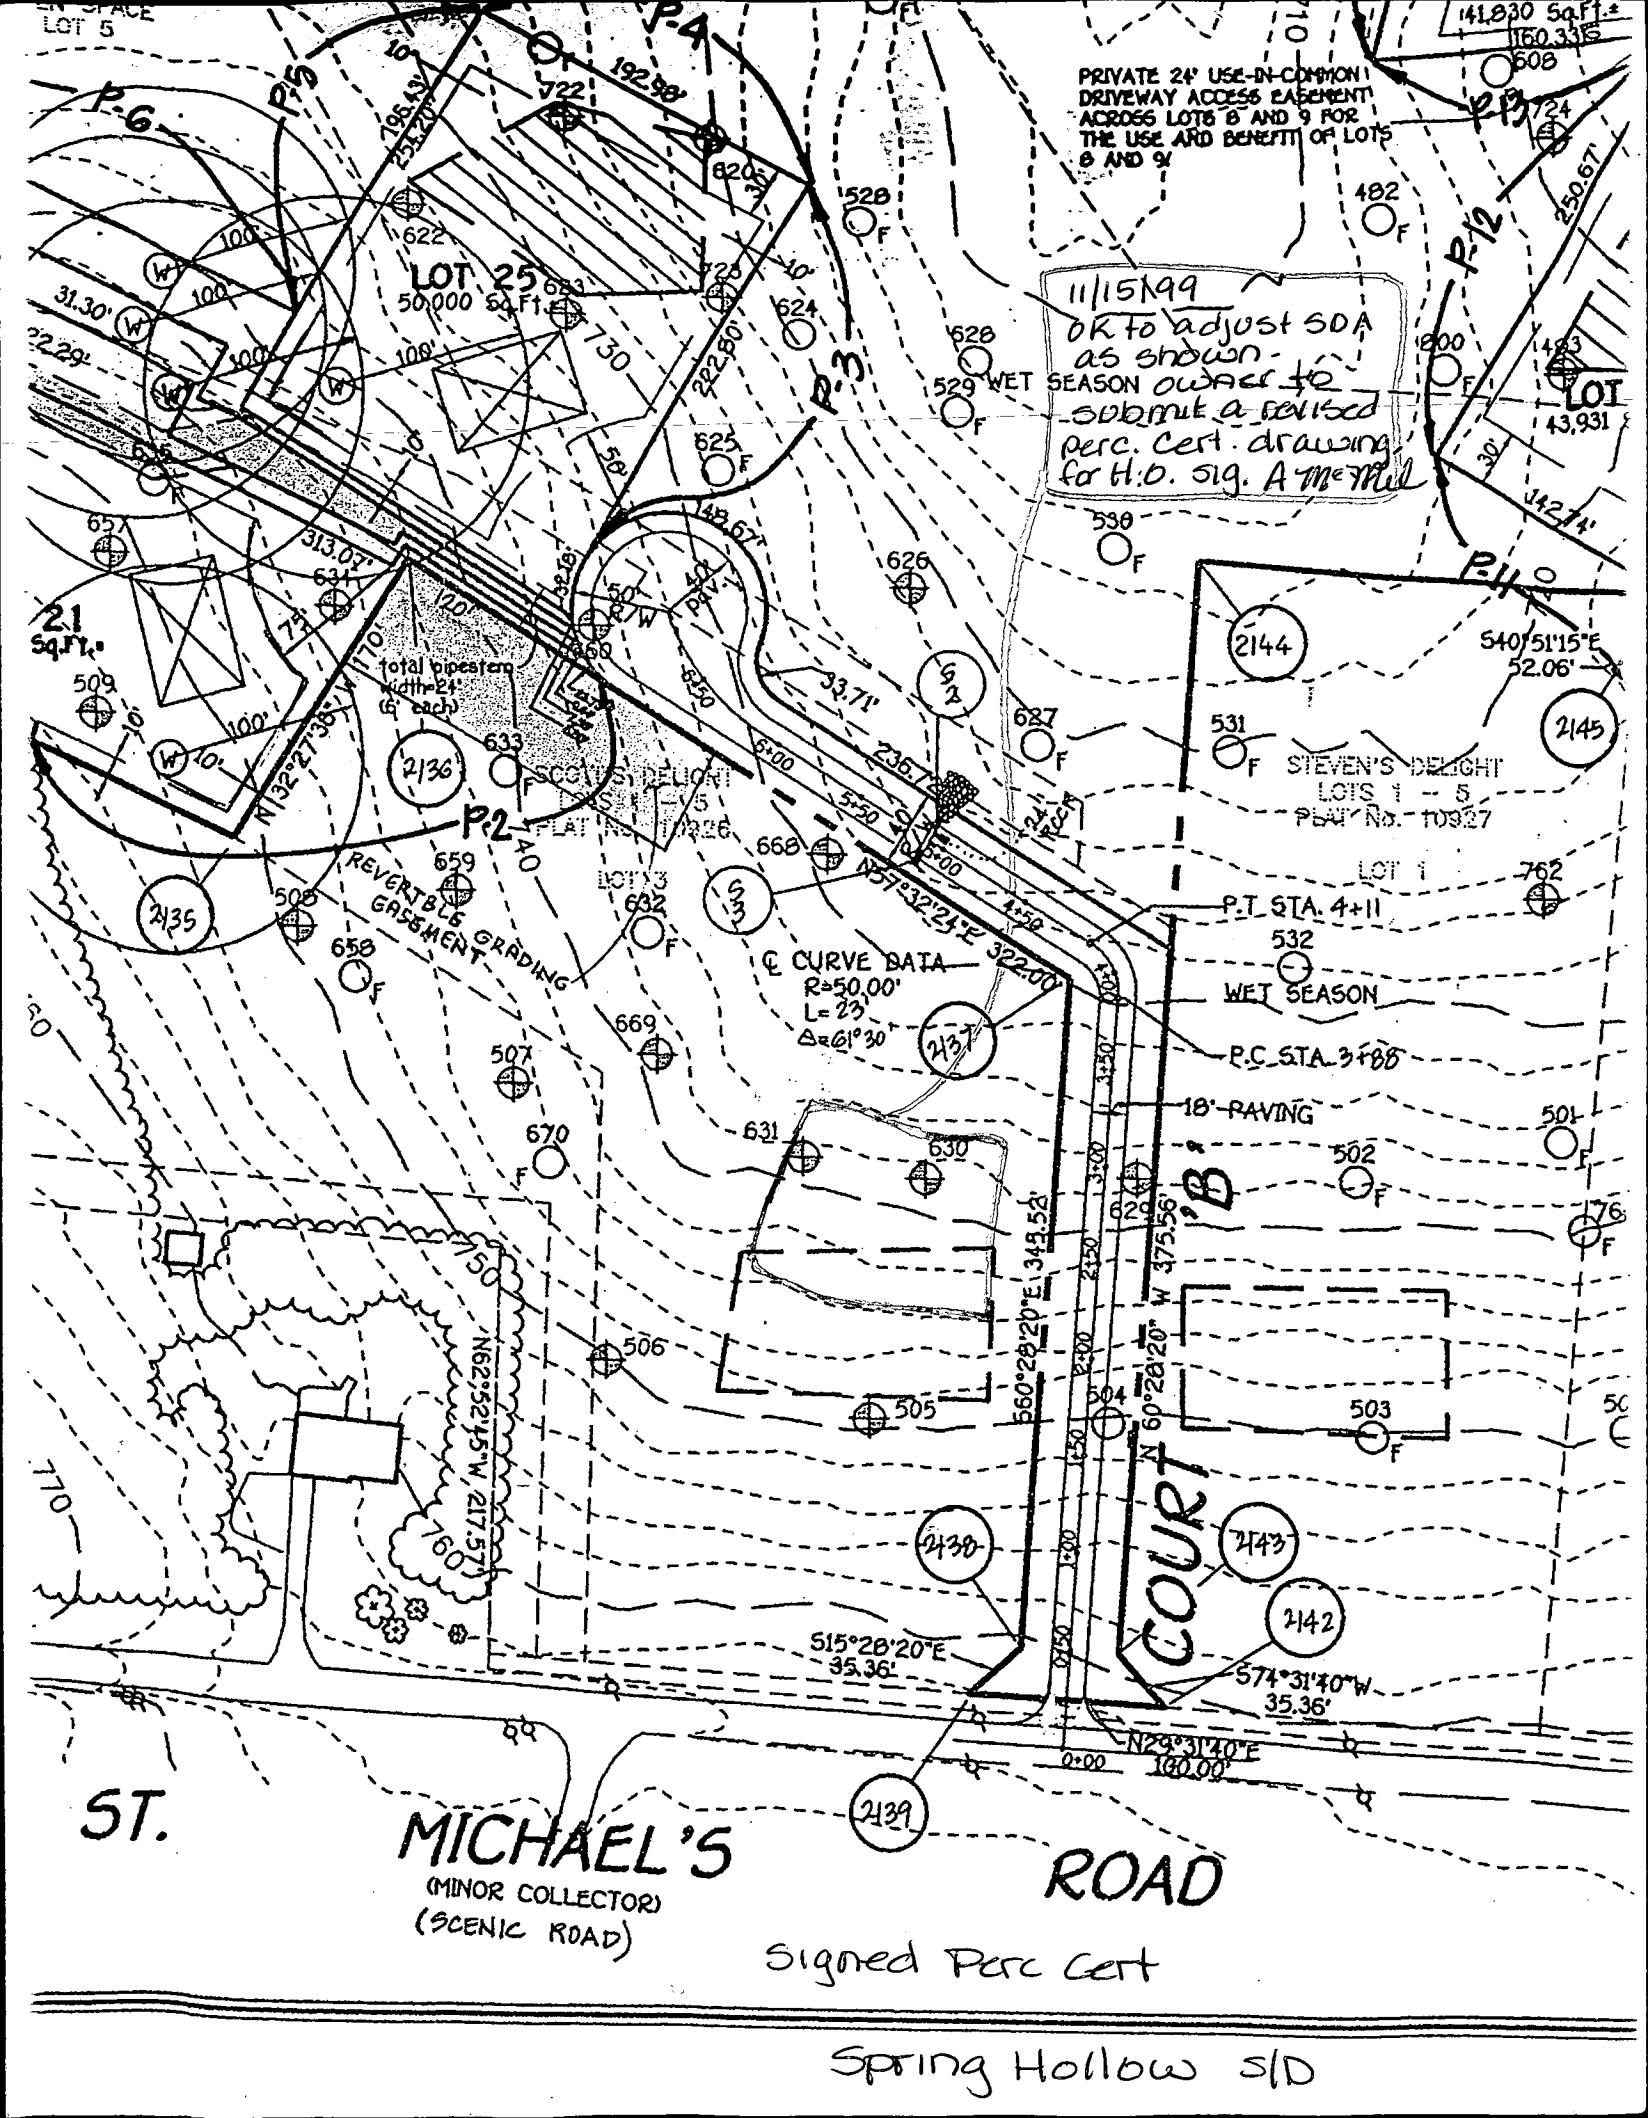

APPLICATION

PERCOLATION TESTING

A _____

P _____

HOWARD COUNTY HEALTH DEPARTMENT
BUREAU OF ENVIRONMENTAL HEALTH
PO BOX 476 ELLICOTT CITY, MARYLAND 21043
TELEPHONE 461-9933

DISTRICT _____

DATE _____

TO: THE COUNTY HEALTH OFFICER
ELLICOTT CITY, MARYLAND

I, HEREBY, APPLY FOR THE NECESSARY TEST IN ORDER TO CONSTRUCT (OR RECONSTRUCT) A SEWAGE DISPOSAL SYSTEM.

PROPERTY OWNER Lambert Cissel

ADDRESS 3425 Hipsley Mill Road, Woodbine, MD 21797 PHONE (410) 442-5671

PROSPECTIVE BUYER Developer, Land Marketing Consultants, Inc., Timothy W. Feaga

ADDRESS 3243 Bethany Lane, Ellicott City, MD 21042 PHONE (410) 313-8808

PROPERTY LOCATION:

SUBDIVISION Cissel Property LOT NO _____

ROAD AND DESCRIPTION Intersection of Hardy & St. Michael's Road

TAX MAP 7 PARCEL # 394, 4, 341, 144

SIZE OF LOT 1 Acre TYPE BLDG _____
(SINGLE FAMILY DWELLING OR COMMERCIAL)

THE SYSTEM INSTALLED UNDER THIS APPLICATION IS ACCEPTABLE ONLY UNTIL PUBLIC FACILITIES BECOME AVAILABLE. I FULLY UNDERSTAND THE

FEE CONNECTED WITH THE FILING OF THIS PERC TEST APPLICATION IS NON-REFUNDABLE UNDER ANY CIRCUMSTANCES. I ALSO AGREE TO COMPLY

WITH ALL M.O.S.H.A. REQUIREMENTS IN TESTING THIS LOT. Willis Lambert Cissel JR

(SIGNATURE OF APPLICANT)

APPROVED BY _____ FOR _____ DATE _____

REJECTED BY _____ FOR _____ DATE _____

HOLD PENDING FURTHER TESTS _____ DATE _____

REASONS FOR REJECTION OR HOLDING _____

THIS IS NOT A PERMIT

43

COUNTY #

SOIL PROFILE


0' 507
orange
red
Sicilm
20%
Shale
4.0
lgt
yellow
red
Silm
25%
Shale
11.0

506 505

3.0 dark
orange
Sicilm
30% Rx
dark
orange
Silm
30% Rx
6.0 yellow
red
Silm
25%
Shale
11.0

630 903

3.0 dark
orange
brown
Sicilm
20% Rx
7.0 15-20%
rock
dark
orange
Silm
9.5 30% Rx
dark
or.
Silm

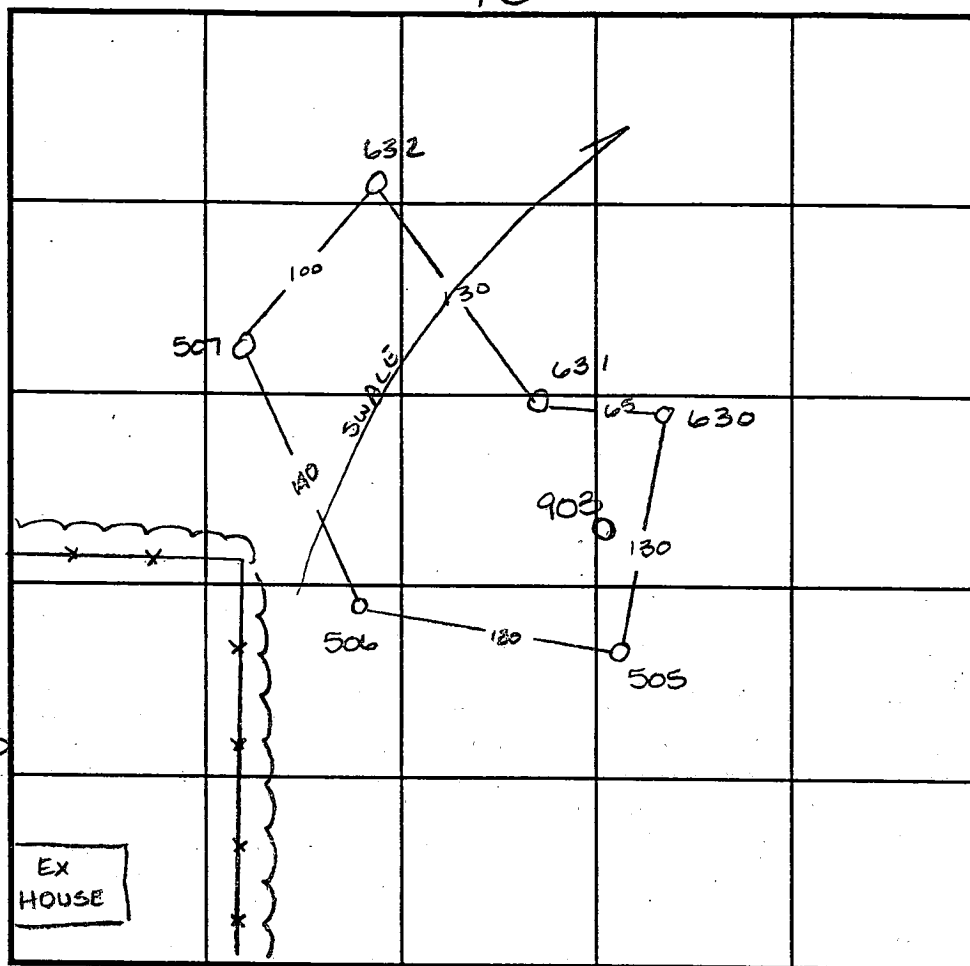

INDICATE NORTH - NAME ADJOINING ROADWAY AS BASE LINE.

ST MICHAELS ROAD

SOIL PROFILE

0' 631
dark
orange
Sicilm
3.0 dark
red
Sicilm
10%
Shale
12.0 yellow
orange
clay
at
10.0
11.0 632
<50%
rock
at
5.0
orange
red
Sicilm
to
5.0

DATE	TEST NO.	DEPTH	PRE-WET		TEST - 1" DROP		TIME
			START	STOP	START	STOP	
8-22-96	507	3.0 V11.0	7:31	7:40	7:40	7:58	18min
	632	insuff	icient depth to bedrock				F
8-21-96	506	3.0 V11.0	11:58	12:00	12:00	12:04	4min
8-21-96	505	3.5 V12.0	12:05	> 30 min			Slow
	505	4.5 V12.0	1:04	1:06	1:06	1:08 ¹⁵	2 1/4 min
	630	3.0 V9.5	11:26 ³⁰	11:27 ³⁰	11:27 ³⁰	11:29 ¹⁵	1 3/4 min
	631	3.0 V11.0	11:34	11:35 ¹⁵	11:35 ³⁰	11:38	2 1/2 min
	631	7.5 V11.0	12:17 ³⁰	12:24 ³⁰	12:24 ³⁰	12:42	12 1/2 min
6-6-97	903	Visual	to 100 - see profile - OK				

REMARKS 631 H=0 season testing

TYPE OF SOIL

TESTED BY Amy McMillen ALSO PRESENT Tim Feaga

TRENCH DESIGN DATA: AVERAGE PERCOLATION TIME TRENCH WIDTH

INLET DEPTH MAXIMUM BOTTOM DEPTH SQ. FT./BEDROOM

APPLICATION

PERCOLATION TESTING

HOWARD COUNTY HEALTH DEPARTMENT
BUREAU OF ENVIRONMENTAL HEALTH
P.O. BOX 476 ELLICOTT CITY, MARYLAND 21043
TELEPHONE 461-9933

A _____

P _____

DISTRICT _____

DATE _____

TO: THE COUNTY HEALTH OFFICER
ELLICOTT CITY, MARYLAND

I HEREBY APPLY FOR THE NECESSARY TEST IN ORDER TO CONSTRUCT (OR RECONSTRUCT) A SEWAGE DISPOSAL SYSTEM.

PROPERTY OWNER Lambert Cissel

ADDRESS 3425 Hipsley Mill Road, Woodbine, MD 21797 PHONE (410) 442-5671

PROSPECTIVE BUYER Developer, Land Marketing Consultants, Inc., Timothy W. Feaga

ADDRESS 3243 Bethany Lane, Ellicott City, MD 21042 PHONE (410) 313-8808

PROPERTY LOCATION:

SUBDIVISION Cissel Property LOT NO. _____

ROAD AND DESCRIPTION Intersection of Hardy & St. Michael's Road

TAX MAP 7 PARCEL # 394, 4, 341, 144

SIZE OF LOT 1 Acre TYPE BLDG. _____
(SINGLE FAMILY DWELLING OR COMMERCIAL)

THE SYSTEM INSTALLED UNDER THIS APPLICATION IS ACCEPTABLE ONLY UNTIL PUBLIC FACILITIES BECOME AVAILABLE. I FULLY UNDERSTAND THE

FEE CONNECTED WITH THE FILING OF THIS PERC TEST APPLICATION IS NON-REFUNDABLE UNDER ANY CIRCUMSTANCES. I ALSO AGREE TO COMPLY

WITH ALL M.O.S.H.A. REQUIREMENTS IN TESTING THIS LOT. Willis Lambert Cissel JR

(SIGNATURE OF APPLICANT)

APPROVED BY _____ FOR _____ DATE _____

REJECTED BY _____ FOR _____ DATE _____

HOLD PENDING FURTHER TESTS _____ DATE _____

REASONS FOR REJECTION OR HOLDING _____

THIS IS NOT A PERMIT

COUNTY #

SOIL PROFILE

0' 629
dark
orange
SiClm
25%
Shale
5.0 band of
lgt yellow
SiClm
6.0 bright
red
SiClm
25%
Shale
11.5


630

dark
orange
SiClm
20% Rx

3.0 15-20%
rock
dark
orange
SiClm
7.0 30%
rock
dark
orange
SiClm
9.5

505
dark
orange
SiClm
3.0

dark
orange
SiClm
30%
Shale
6.0
yellow
red
SiClm
25% shale
11.0

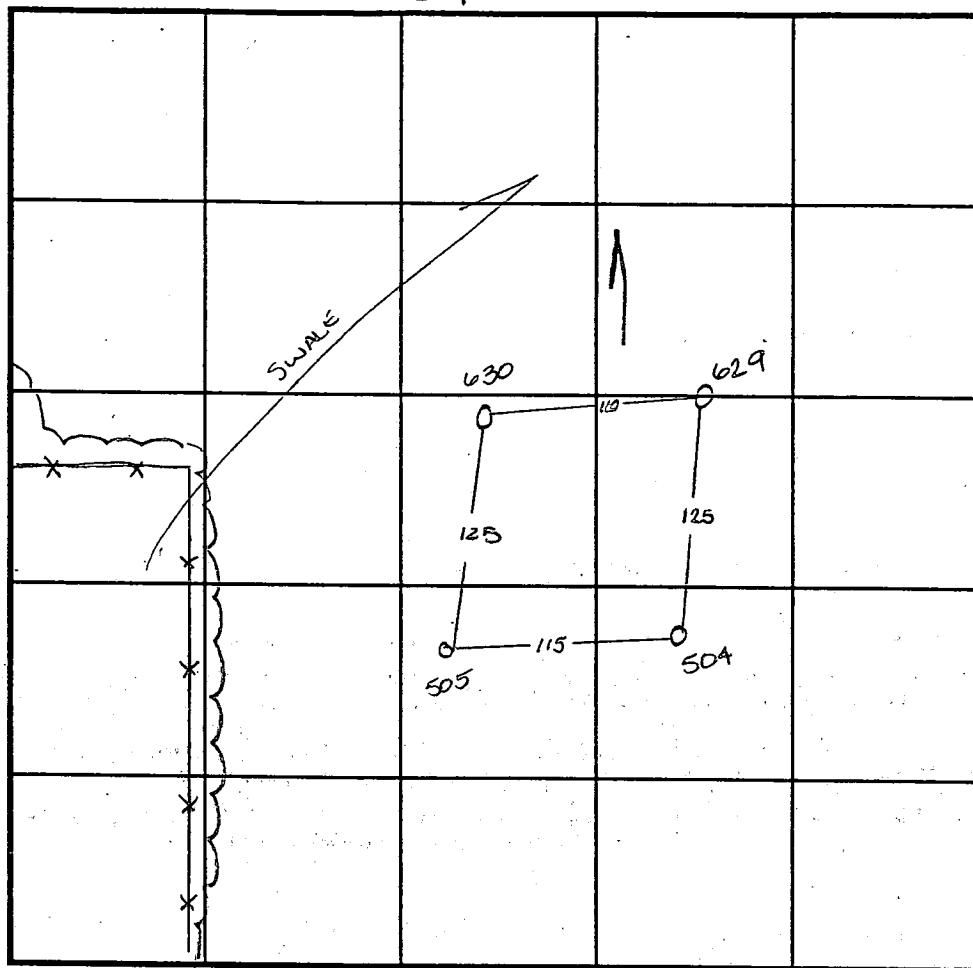

INDICATE NORTH - NAME ADJOINING ROADWAY AS BASE LINE.

SOIL PROFILE

0' 304
50%
rock
at
5.0
refusal
at
9.0

DATE	TEST NO.	DEPTH	PRE-WET		TEST - 1" DROP		TIME
			START	STOP	START	STOP	
8-21-96	629	3.0 V11.5	11:25	11:29	11:29	11:32	3min
	630	3.0 V9.5	11:26 ³⁰	11:27 ³⁰	11:27 ³⁰	11:29 ¹⁵	1 3/4 min
	505	3.5 V12.0	12:05 ³⁰	>30 min	—	—	slow
	505	4.0 V12.0	1:04 ³⁰	1:06	1:06	1:08 ¹⁵	2 1/4 min
	504	Insufficient	depth to bedrock				F

REMARKS 505 needs wet season

TYPE OF SOIL

TESTED BY Amy McMillen

ALSO PRESENT Tim Feaga

TRENCH DESIGN DATA: AVERAGE PERCOLATION TIME

TRENCH WIDTH

INLET DEPTH

MAXIMUM BOTTOM DEPTH

SQ. FT./BEDROOM

APPLICATION

PERCOLATION TESTING

HOWARD COUNTY HEALTH DEPARTMENT
BUREAU OF ENVIRONMENTAL HEALTH
PO BOX 476 ELLICOTT CITY MARYLAND 21043
TELEPHONE 461-9933

A 47050

P _____

DISTRICT 4th

DATE 10/1/91

5/7/91

TO: THE COUNTY HEALTH OFFICER
ELLICOTT CITY, MARYLAND

I HEREBY APPLY FOR THE NECESSARY TEST IN ORDER TO CONSTRUCT (OR RECONSTRUCT) A SEWAGE DISPOSAL SYSTEM

PROPERTY OWNER W. Lambert Cissel, Jr.

ADDRESS 3425 Hipsley Mill Road, Woodbine, MD 21797 PHONE 301-442-2463

PROSPECTIVE BUYER Same Newburn 455-0920/997-3815 (OSA)

ADDRESS _____ PHONE _____

PROPERTY LOCATION:

SUBDIVISION Scott's Delight LOT NO 3

ROAD AND DESCRIPTION 1400 St. Michael's Rd.

TAX MAP 7 PARCEL # 38

SIZE OF LOT 3.5 acres ± TYPE BLDG Single Family Dwelling
(SINGLE FAMILY DWELLING OR COMMERCIAL)

THE SYSTEM INSTALLED UNDER THIS APPLICATION IS ACCEPTABLE ONLY UNTIL PUBLIC FACILITIES BECOME AVAILABLE. I FULLY UNDERSTAND THE

FEE CONNECTED WITH THE FILING OF THIS PERC TEST APPLICATION IS NON-REFUNDABLE UNDER ANY CIRCUMSTANCES. I ALSO AGREE TO COMPLY

WITH ALL M.O.S.H.A. REQUIREMENTS IN TESTING THIS LOT. Christine A. Richards
(SIGNATURE OF APPLICANT)

APPROVED BY _____ FOR _____ DATE _____

REJECTED BY _____ FOR _____ DATE _____

HOLD PENDING FURTHER TESTS _____ DATE _____


REASONS FOR REJECTION OR HOLDING PERC OK - HOLD FOR PLAT 6/91

HD-216

THIS IS NOT A PERMIT

Lot 3
A 47050

Lot 4

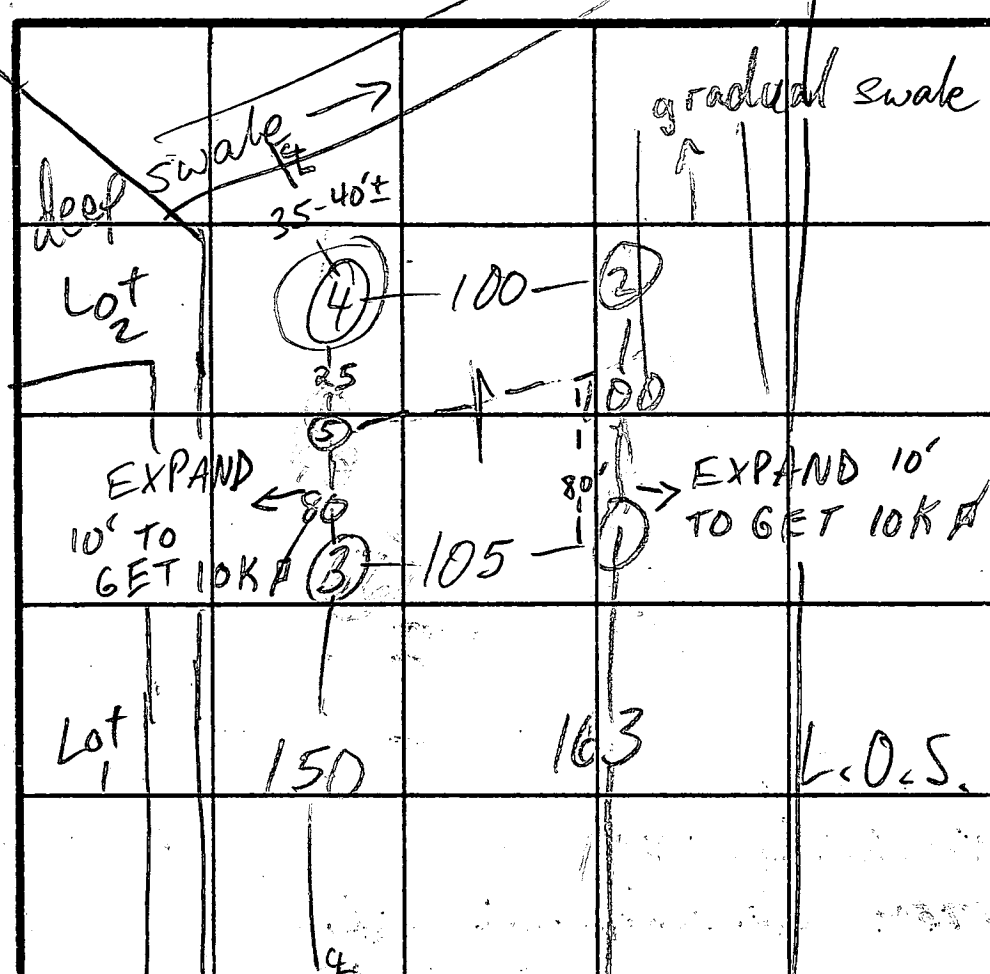

$\bar{x} = 12$
210 ϕ BR
Inlet 4'
Bottom 7'

SOIL PROFILE
0
org brn
sa cl
loam
10% Frags
3 1/2
brn
sand
loam
30-35%
solid
shale Frags
some
large
11 1/2

(2)-(5)
red
org brn
sa cl
loam
10%
frags
5 1/2
red
brn
sand
loam
15-20%
shale
frags
12 1/2


ST. MICHAEL RD

DATE	TEST NO.	DEPTH	PRE-WET		TEST - 1" DROP		TIME
			START	STOP	START	STOP	
6/6/91	1S	5	11:24	11:30	11:30	11:42	12
	1V	11 1/2	see profile				
	2S	7	11:46	11:51	11:51	12:01	10
	2V	12 1/2	see profile				
	3S	6	4:34	4:39	4:39	4:50	11
	3V	12 1/2	sim to (2)		clay 4 to 5' 20% Frags		
	4S	(5)	12:40	12:50	NO MOVEMENT		REDIG
			2:08	SLOW	FAIL		
	4V	11 1/2	sim to (2)		more pin E 20% Frags		
6/24/91	5S	6	10:58	11:05	11:05	11:18	13
	5V	13	sim to (3)		15% Frags in clay		

REMARKS HOLES ①-④ PER PLAN, USE ①(3), ⑤

TYPE OF SOIL

TESTED BY M. Riskin ALSO PRESENT

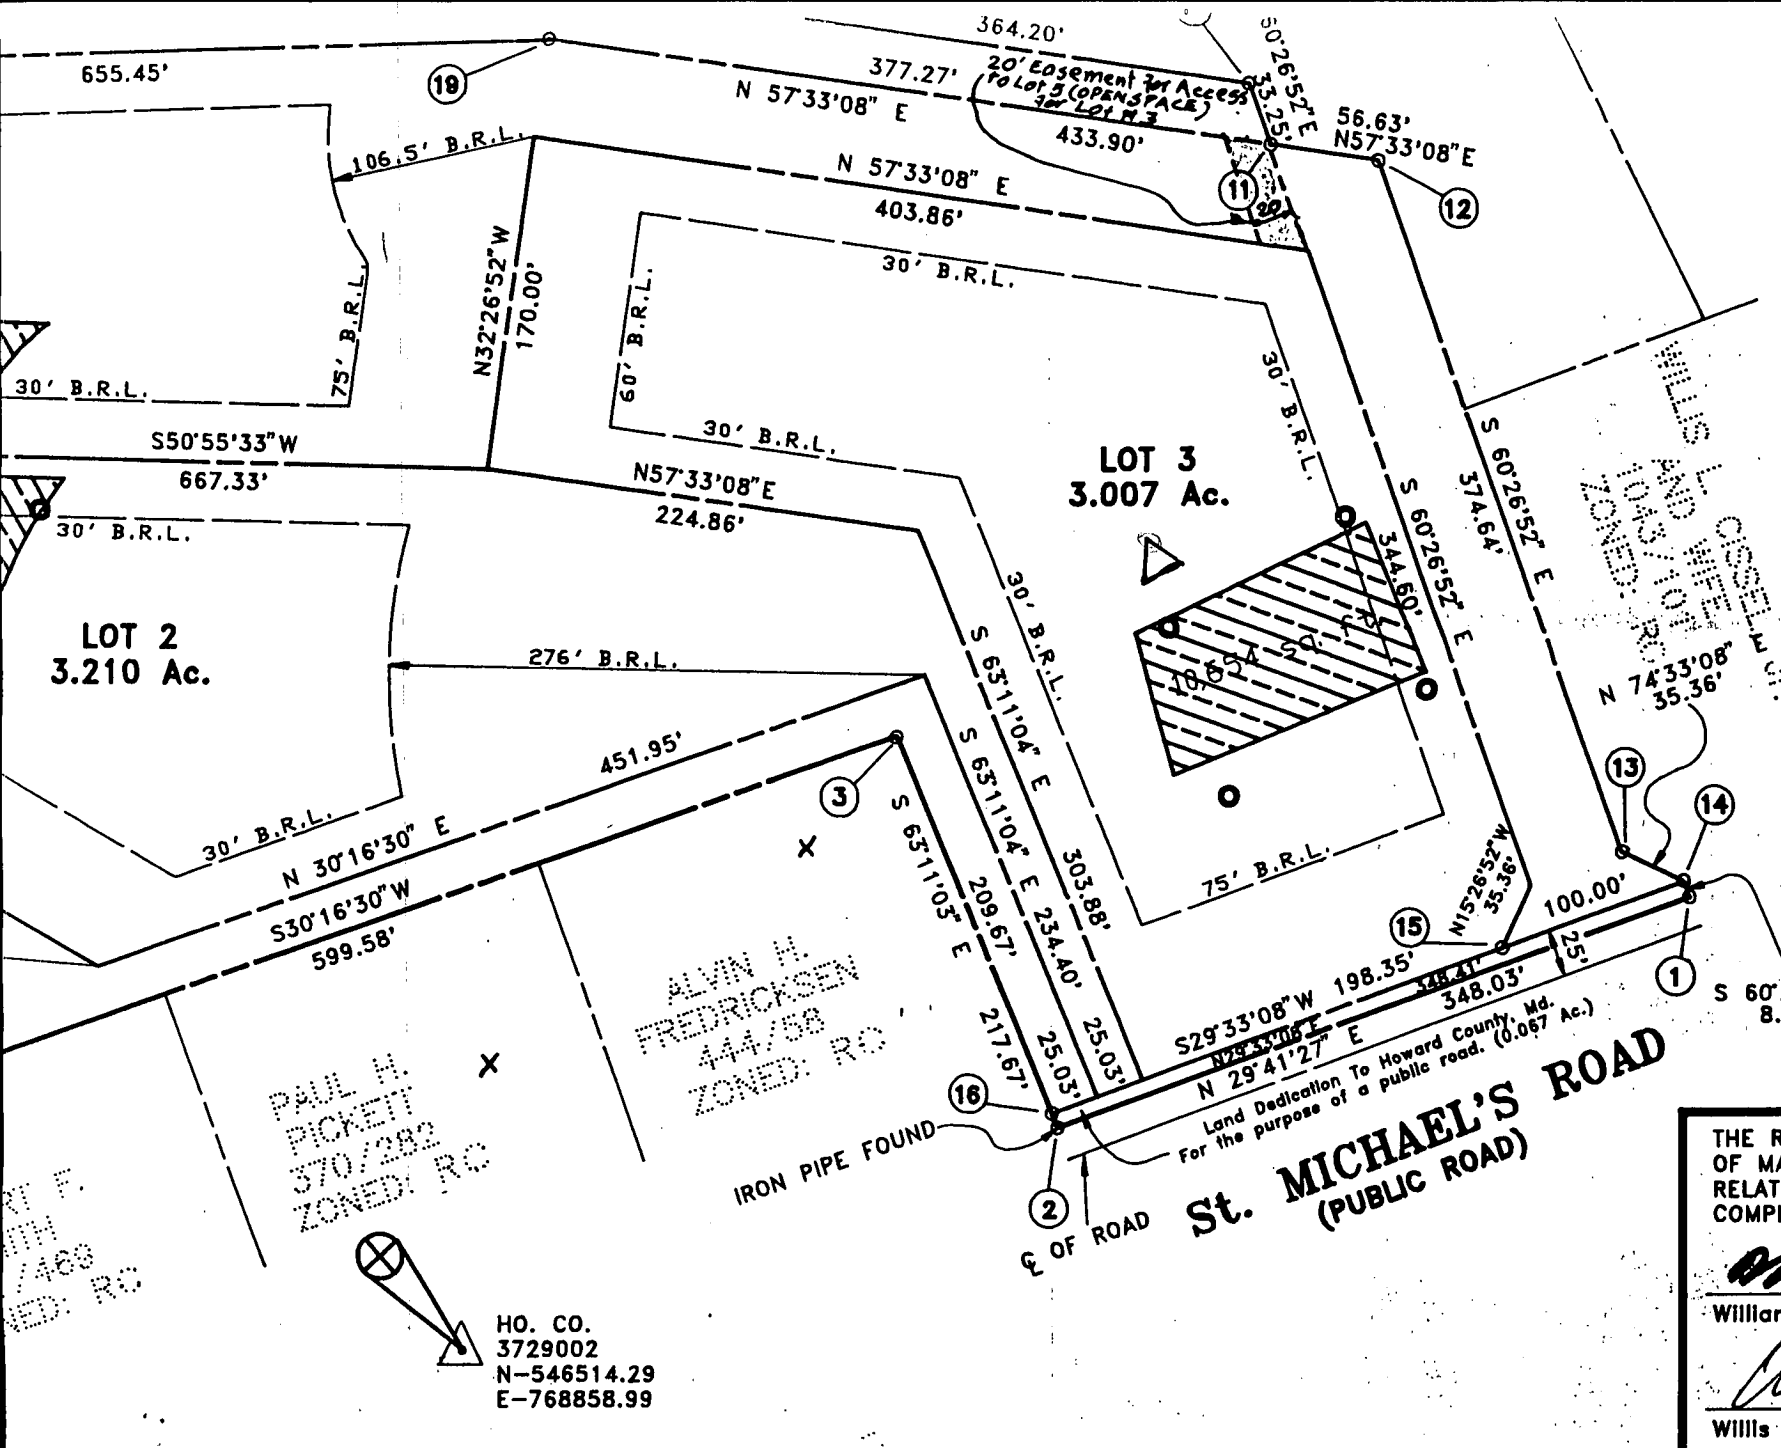

- 4) Subject property
- 5) O - Designates
- 6) The lots shown h and lot area req
- 7) This a m Department of En Improvements of public sewerage structures constru easements shall public sewage sy the authority to private sewer eas easement shall n
- 8) All percolation tes and shown thus:
- 9) For Flag or pipes road maintenance pipestem and the or pipestem lot d
- 10) Flag or pipestem lots accommodati can be construct fifty (50) foot rig
- 11) BRL - Denotes Bu
- 12) Open Space Lot 5 Green Home recorded with the September 9, 1992 1993, Scott's Deliv Green. Receipt #
- 13) X - denotes exist

THE REQUIREMENTS SECTION 3-1 OF MARYLAND, 1988 REPLACEMENT RELATE TO THE MAKING OF THIS COMPLIED WITH.

William G. Hartel
 William G. Hartel, Professional L

Willis L. Cissel, Jr.
 Willis L. Cissel, Jr.

STATEMENT


sel, owners of the property shown and described hereon, consideration of the approval of this final plat

SURVEYOR'S CERTIFICATE

I hereby certify that the final plat shown hereon is correct; that it is a subdivision of part of the lands conveyed by Gladhill Properties, Inc. to Willis L. Cissel, Jr. and Marjorie S. Cissel

RECORDED AS PLAT 10926 ON

SCOTT

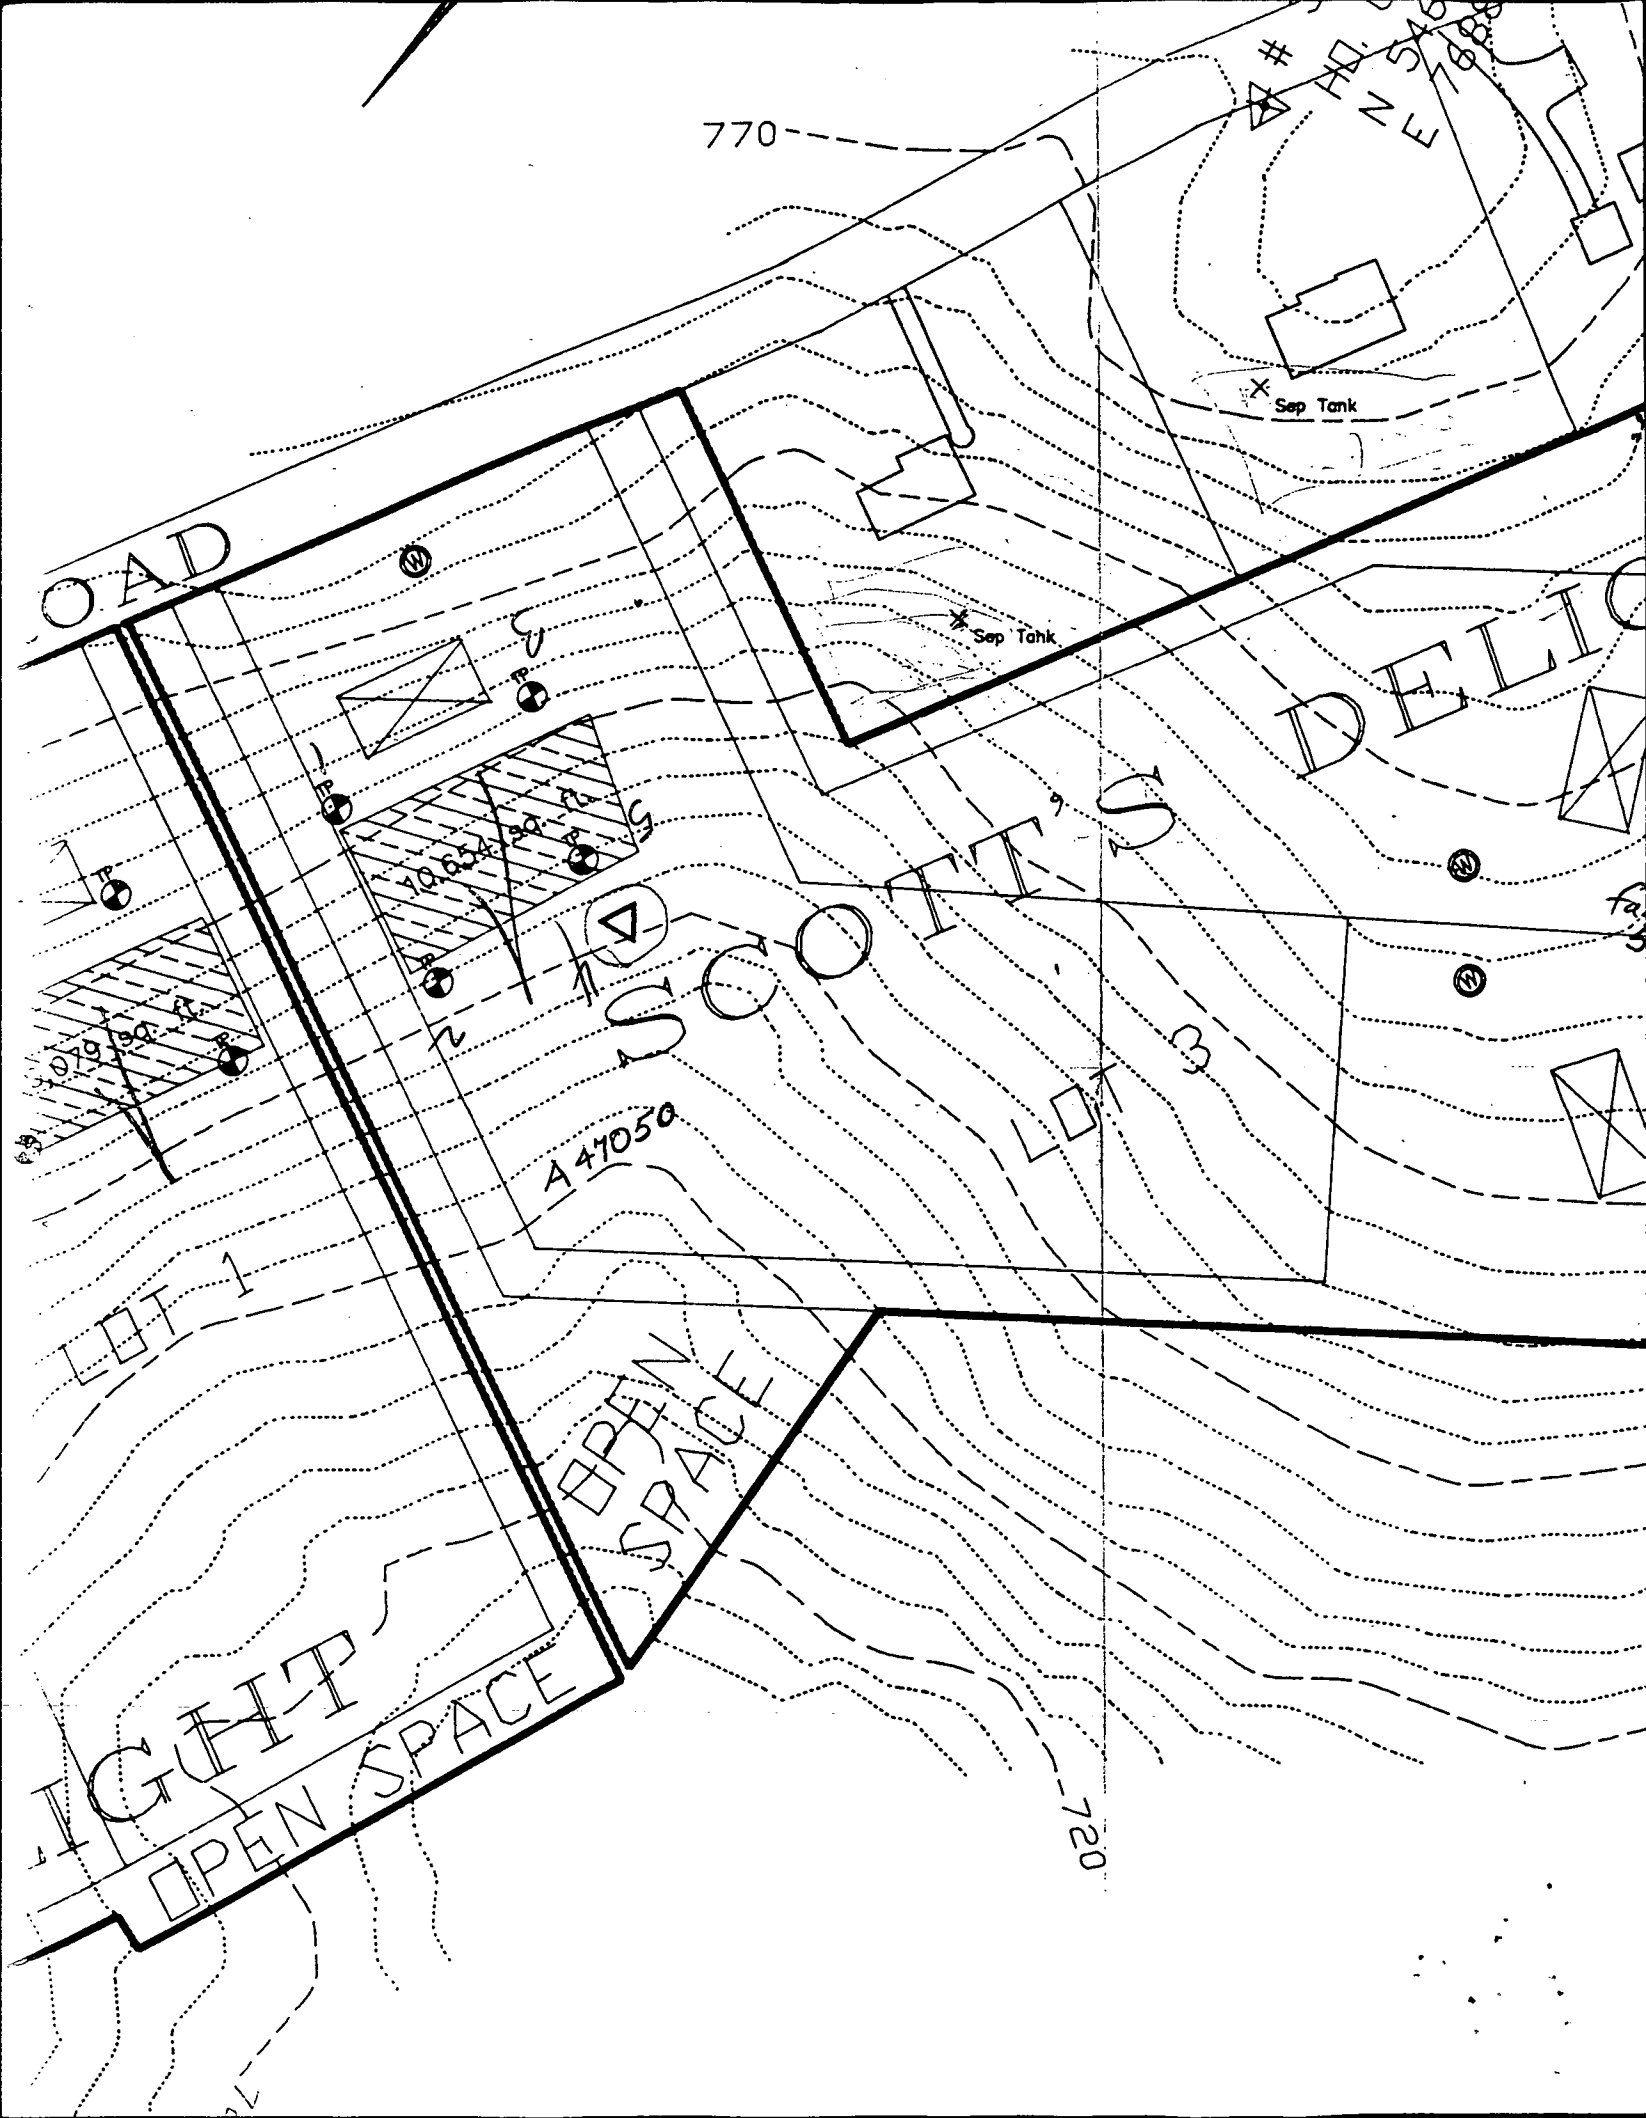

C106766

SEQUENCE NO.
(MDE USE ONLY)

STATE OF MARYLAND
WELL COMPLETION REPORT
FILL IN THIS FORM COMPLETELY
PLEASE PRINT OR TYPE

THIS REPORT MUST BE SUBMITTED WITHIN
45 DAYS AFTER WELL IS COMPLETED.
COUNTY
NUMBERA47050

ST/CD USE ONLY
DATE RECEIVED
MMDDYY
813

DATE WELL COMPLETED
MMDDYY
072895

Depth of Well
2240026
(TO NEAREST FOOT)

PERMIT NO.
FROM "PERMIT TO DRILL WELL"
40-94-2266

OWNERCisselLambert

STREET OR RFD1400 St. Michaels Rd.TOWNPoplar Springs

SUBDIVISIONScott's DelightSECTIONLOT3

WELL LOG		
Not required for driven wells		
STATE THE KIND OF FORMATIONS PENETRATED, THEIR COLOR, DEPTH, THICKNESS AND IF WATER BEARING		
DESCRIPTION (Use additional sheets if needed)	FEET FROMTO	check if water bearing
Top Soil	02	
Brown Shale	211	
Brown Slate	1115	
Blue Slate	1545	
Brown Slate	4550	
Blue Slate	50400	

GROUTING RECORD

WELL HAS BEEN GROUTED
(Circle Appropriate Box)
YES(Y)NO(N)
4444

TYPE OF GROUTING MATERIAL (Circle one)
CEMENT(CM)BENTONITE CLAY(BC)

NO. OF BAGS45466NO. OF POUNDS4546600

GALLONS OF WATER36

DEPTH OF GROUT SEAL (to nearest foot)
from0ft. to22ft.
48TOP5254BOTTOM58
(enter 0 if from surface)

CASING RECORD

casing types insert appropriate code below
(ST)STEEL(CO)CONCRETE
(PL)PLASTIC(OT)OTHER

MAIN CASING TYPE
PL

Nominal diameter top (main) casing (nearest inch)!
6

Total depth of main casing (nearest foot)
23

6061636466670

OTHER CASING (if used)

EACH CASING
diameter inchdepth (feet) fromto

SCREEN RECORD

screen type or open hole
(insert appropriate code below)
(ST)STEEL(BR)BRASS
(PL)PLASTIC(HO)OPEN HOLE
(OT)OTHER

NUMBER OF UNSUCCESSFUL WELLS:0

WELL HYDROFRACTURED
YES(Y)NO(N)

CIRCLE APPROPRIATE LETTER

A A WELL WAS ABANDONED AND SEALED WHEN THIS WELL WAS COMPLETED

E ELECTRIC LOG OBTAINED

P TEST WELL CONVERTED TO PRODUCTION WELL

I HEREBY CERTIFY THAT THIS WELL HAS BEEN CONSTRUCTED IN ACCORDANCE WITH COMAR 26.04.04 "WELL CONSTRUCTION" AND IN CONFORMANCE WITH ALL CONDITIONS STATED IN THE ABOVE CAPTIONED PERMIT, AND THAT THE INFORMATION PRESENTED HEREIN IS ACCURATE AND COMPLETE TO THE BEST OF MY KNOWLEDGE.

DRILLERS LIC. NO.1MSD116

DRILLERS SIGNATURE

LIC. NO.1MSD117

SITE SUPERVISOR (sign. of driller or journeyman responsible for sitework if different from permittee)

C2

DEPTH (nearest ft.)

12HO21400

8911151721

232426303236

383941454751

SLOT SIZE 123

DIAMETER OF SCREEN (NEAREST INCH)
5660

fromto

GRAVEL PACK
IF WELL DRILLED
WAS FLOWING WELL
INSERT F IN BOX 68

MDE USE ONLY
(NOT TO BE FILLED IN BY DRILLER)
T(E.R.O.S.)W.Q

7072747576

TELESCOPE CASINGLOG INDICATOROTHER DATA

C3

PUMPING TEST

HOURS PUMPED (nearest hour)6

PUMPING RATE (gal. per min.)I.

METHOD USED TO MEASURE PUMPING RATEbucket

WATER LEVEL (distance from land surface)
BEFORE PUMPING48ft.
WHEN PUMPING195ft.

TYPE OF PUMP USED (for test)
AairPpistonTturbine
CcentrifugalRrotaryOother (describe below)
JjetSsubmersible

PUMP INSTALLED

DRILLER WILL INSTALL PUMP (CIRCLE) (YES or NO)YESNO

IF DRILLER INSTALLS PUMP, THIS SECTION MUST BE COMPLETED FOR ALL WELLS.


TYPE OF PUMP INSTALLED PLACE (A,C,J,P,R,S,T,O) IN BOX 2929

CAPACITY: GALLONS PER MINUTE (to nearest gallon)3135

PUMP HORSE POWER3741

PUMP COLUMN LENGTH (nearest ft.)4347

CASING HEIGHT (circle appropriate box and enter casing height)
+above
-below
LAND SURFACE
2(nearest foot)
5051

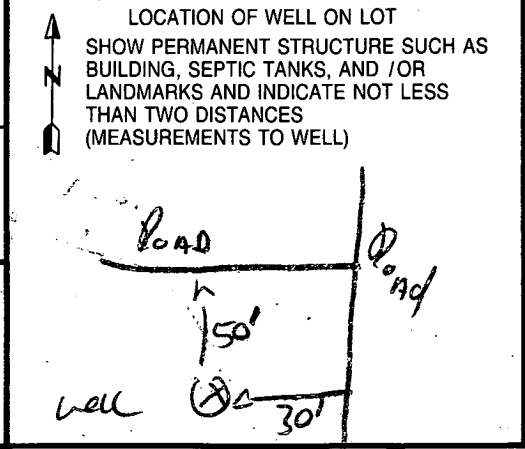

LOT 5
42,281 Sq. Ft.

540° 51' 15" E
52.06'

2145

2127

531

P.T. STA. 4+11

532

WET SEASON

STA. 3+03

Hole's
Court

LOT 1

Steven's Delight

W

Lo
STE

2143

2142

571° 31' 40" W
35.35'

129° 31' 40" E
100.00'

ROAD

MICHAEL'S
(MINOR COLLECTOR)

ST.

LOT 3
Scott's Delight

*

95° 28' 20" E
32.35'

2129

2125

L.O.D.

CURVE DATA
R=50.00
L=77
Δ=61° 30'
T=

CHD=

REVERTIBLE
GRADING EASEMENT

659

632

669

631

630

570

507

658

508

2135

2136

LOT 21
60,401 Sq. Ft.

W

total pipe
width 24"
6" each

100'



N 32° 21' 33"

N 62° 32' 55" W 217.57'

770

760

B 1	1901	SEQUENCE NO. (MDE USE ONLY)	STATE OF MARYLAND PERMIT TO DRILL WELL please print or type	STATE PERMIT NUMBER HO-94-2266 <small>fill in this form completely</small>
Date Received (APA) 12 18 98 <small>8 MM DD YY 13</small>		OWNER INFORMATION		
15 Last Name CISSELL		Owner First Name Lambert		
36 Street or RFD Woolbrine Rd		55		
57 Town MDA		72 Zip 21797		
DRILLER INFORMATION				
Driller's Name Ralph Mayne		M S D 116		
Firm Name Ralph Mayne Well Drilling		76 License No. 81		
Address 9120 Brown Church Rd Mt Airy				
Signature <i>Ralph Mayne</i>		Date 12-9-98		
B 2	WELL INFORMATION			
2	APPROX. PUMPING RATE (GAL. PER MIN.)		5	
AVERAGE DAILY QUANTITY NEEDED (GAL. PER DAY)		14 500 20		
USE FOR WATER (CIRCLE APPROPRIATE BOX)				
<input checked="" type="checkbox"/> DOMESTIC POTABLE SUPPLY & RESIDENTIAL IRRIGATION				
<input type="checkbox"/> FARMING (LIVESTOCK WATERING & AGRICULTURAL IRRIGATION)				
<input type="checkbox"/> INDUSTRIAL, COMMERCIAL, DEWATERING				
<input type="checkbox"/> PUBLIC WATER SUPPLY WELL				
<input type="checkbox"/> TEST, OBSERVATION, MONITORING				
<input type="checkbox"/> GEO-THERMAL				
NOT TO BE FILLED IN BY DRILLER HEALTH DEPARTMENT APPROVAL				
Howard A47050				
COUNTY NAME COUNTY NO.				
STATE SIGNATURE INSERT S →				
DATE ISSUED 05/27/99 Mark E. Ripkin 5/27/00				
43 MM DD YY 48 CO SIGNATURE EXP. DATE				
NORTH GRID 549 000 EAST GRID 0769 000				
50 55 57 63				
SHOW MAJOR FEATURES OF BOX & LOCATE WELL WITH AN X				
7/21/99 11:00 ±				
SOURCES OF DRILLING WATER				
1. well				
2.				
3.				
WRITE THE BOX NUMBER FROM THE MAP HERE				
E 549				
N 549				
DRAW A SKETCH BELOW SHOWING LOCATION OF WELL IN RELATION TO NEARBY TOWNS AND ROADS AND GIVE DISTANCE FROM WELL TO NEAREST ROAD JUNCTION				
REPLACEMENT OR DEEPEMED WELLS (CIRCLE APPROPRIATE BOX)				
<input checked="" type="checkbox"/> THIS WELL WILL NOT REPLACE AN EXISTING WELL				
<input type="checkbox"/> THIS WELL WILL REPLACE A WELL THAT WILL BE ABANDONED AND SEALED				
<input type="checkbox"/> THIS WELL WILL REPLACE A WELL THAT WILL BE USED AS A STANDBY-CONTACT LOCAL APPROVING AUTHORITY FOR POLICY ON STANDBY WELLS				
<input type="checkbox"/> THIS WELL WILL DEEPEMED AN EXISTING WELL				
PERMIT NUMBER OF WELL TO BE REPLACED OR DEEPEMED (IF AVAILABLE) 41 _____ 52				
Not to be filled in by driller (MDE OR COUNTY USE ONLY)				
APPROP. PERMIT NUMBER 54 _____ 63				
PERMIT No. HO-94-2266				
70 71 72 73 74 75 76 77 78 79				
SPECIAL CONDITIONS				
NOTE - APPROVING AUTHORITIES SHOULD USE SEPARATE SHEET IF NEEDED -				

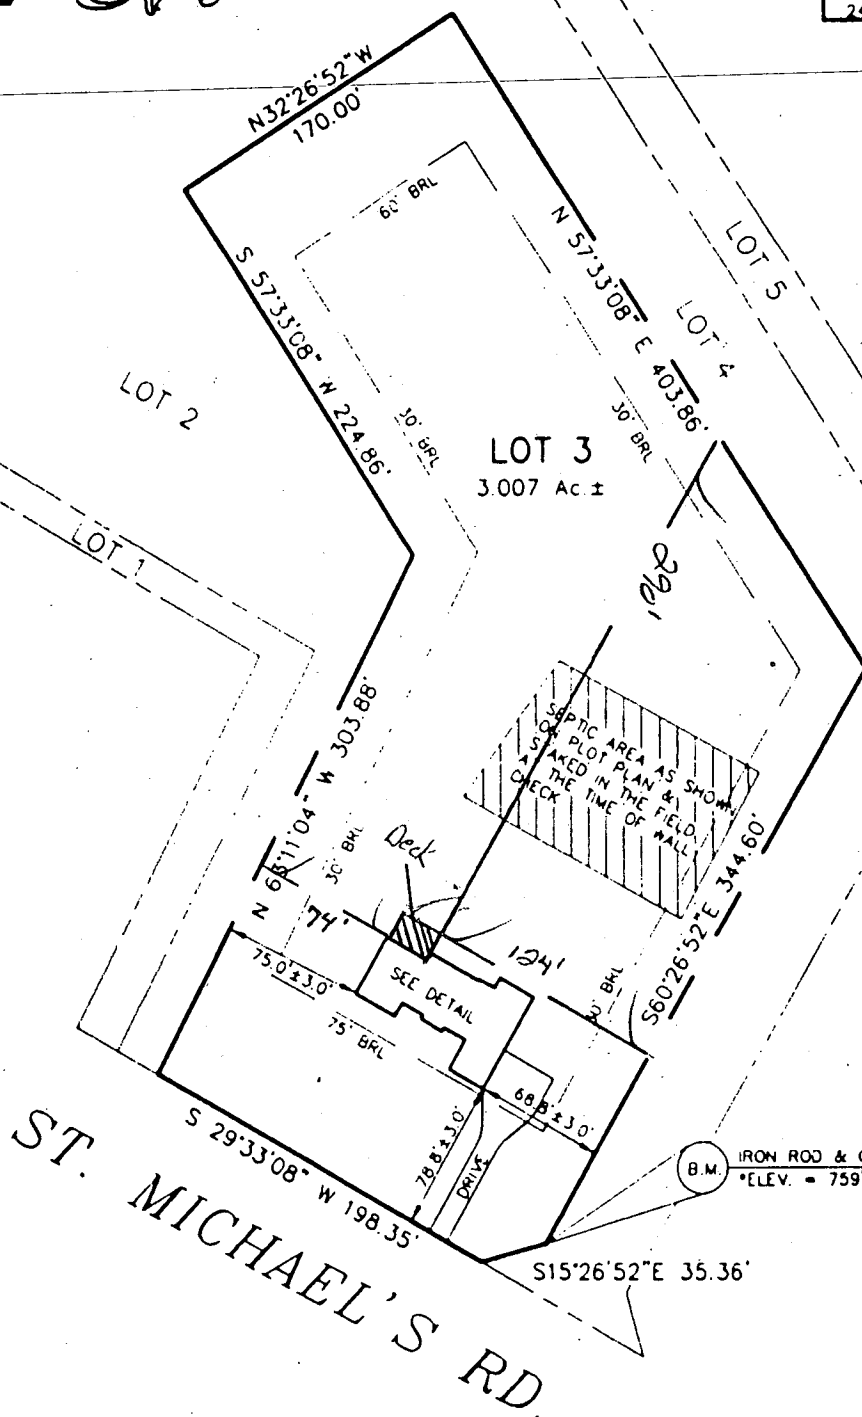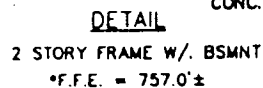

10/24/01 16' x 24'
Deck O.K.

BB

B.M. IRON ROD & CAP FOUND
•ELEV. = 759' (ASSUMED ELEV. FROM PLOT PLAN)

O/H = OVERHANG
A/C = AIR COND./HEAT PUMP
G/M = GAS METER
E/M = ELECTRIC METER
CH = CHIMNEY
B/W = BAY WINDOW
D/W = DRIVEWAY
CONC = CONCRETE

LOTS 3
SCOTT'S DELIGHT
LOTS 1 - 5

PLAT No. 10926
ELECTION DISTRICT No. 4
HOWARD COUNTY, MARYLAND

THE INFORMATION SHOWN HAS BEEN ESTABLISHED BY CURRENT ACCEPTABLE SURVEY PROCEDURES AND FROM AVAILABLE RECORD INFORMATION. THIS DRAWING IS TO BE USED FOR TITLE TRANSFER FINANCING, OR REFINANCING ONLY AND IS NOT TO BE USED FOR THE ESTABLISHMENT OF PROPERTY LINES, LOCATION OF FENCES, GARAGES, BUILDINGS, OR OTHER EXISTING OR FUTURE IMPROVEMENTS.

OPEN SPACE LOT 5
5.064 a.c.
DEDICATED TO HOMEOWNER'S ASSOCIATION

WELLS (GISSSEL, Jr
WIFE
1043/103
ZONED: R4C

6/18/03

Proposed
Deck O.K.

BB

rent for Access to
(space) for Lot 142

N 47°41'06" E

655.45'

30' B.R.L.

LOT 4
3.957 Ac.

73-8881-1

S50°55'33"W
667.33'

LOT 2
3.210 Ac.

Lot B

LOT 1
.436 Ac.

IRON PIPE
FOUND

ALVIN H.
FREDRICKSEN
444/58
ZONED: RO

52° 33' 08" W 190
N 29° 41' 27" E 348.03
Land Dedication To Howard County, Md.
purpose of a public road. (0.087)

REFITAG= 4104824754

05/20/00 12:21 PM JCB 282

100

EL'S F