

2/1/96
2/7/96 12:10

PERMIT

SEWAGE DISPOSAL SYSTEM

DEPARTMENT OF HEALTH AND MENTAL HYGIENE

03-318907

HOWARD COUNTY HEALTH DEPARTMENT

BUREAU OF ENVIRONMENTAL HEALTH

461-9933

313-2640

INDEXED

P 56420B

A 47201B

DISTRICT 3rd

DATE 1/26/94

DATE SYSTEM APPROVED 2-7-96

INSPECTOR *HS*

Olen Ketterman

IS PERMITTED TO INSTALL ☒ ALTER ☐

ADDRESS 14960 Route 144 Woodbine, Maryland 21797 PHONE 442-1336

SUBDIVISION West Friendship Estates LOT 31 ROAD 3140 River Valley Chase

PROPERTY OWNER ~~Kelly & Susan Brenner Selfridge Builders, Inc.~~

ADDRESS *Paul & Mary Glagola*

SEPTIC TANK CAPACITY 1250 GALLONS

NUMBER OF BEDROOMS 4

180 SQUARE FEET PER BEDROOM

LINEAR FEET OF TRENCH REQUIRED 240

TRENCHES - Trench to be 3 feet wide. Inlet 3 feet below original grade. Bottom maximum depth 5 feet below original grade. Effective area begins at 3 feet below original grade. 2 feet of stone below distribution pipe.

LOCATION - Place distribution box 155' down the right (366.58') lot line and 40' off that same lot line as seen when facing the lot from River Valley Chase.

NOTES - Run trenches on contour toward the back right lot corner.
- No trench to exceed 100 feet in length. Provide 6" - 8" diameter cleanout and cap to grade or above on septic tank. OK 12/11/95 DKS

BUILDING PERMIT SIGNED

PLANS APPROVED BY Amy McMillen AND RETURNED 6/27/02 DATE 8/28/95

B00137189 DECK

COVER NO WORK UNTIL INSPECTED AND APPROVED

NEITHER THE HOWARD COUNTY COUNCIL NOR THE HEALTH DEPARTMENT IS RESPONSIBLE FOR THE SUCCESSFUL OPERATION OF ANY SYSTEM

NOTE: CLEANOUT REQUIRED EVERY 70 FEET OF SEWER LINE AND/OR AT 90° SWEEPS IN LINES FROM HOUSE TO DRAIN FIELDS, 90° ELBOWS NOT ACCEPTABLE.

NOTE: ALL PARTS OF SEPTIC SYSTEMS (I.E. TANK, DISTRIBUTION BOX TRENCHES) TO BE 100 FEET FROM WELL (UNLESS OTHERWISE SPECIFICALLY AUTHORIZED)

NOTE: IF DEEP TRENCH(ES) ARE USED CALL FOR INSPECTION BEFORE AND AFTER PLACING GRAVEL IN TRENCH(ES)

NOTE: NO DRY WELL SHALL EXCEED 15 FOOT IN DIAMETER NO ABSORPTION TRENCH TO EXCEED 100 FEET IN LENGTH

NOTE: ALL PIPE FROM HOUSE TO SEPTIC TANK MUST BE CAST IRON OR SCHEDULE 35/40 PVC OR ABS

PERMIT VOID AFTER TWO YEARS

NOTE: INSTALL STAND PIPE ON SEPTIC TANK AND DRY WELL STAND PIPES MUST BE 6 INCHES IN DIAMETER CAST IRON. CONCRETE OR TERRA COTTA OR PVA OR ABS ACCEPTED. IF TOP OF SEPTIC TANK IS DEEPER THAN 3 FEET. MANHOLE TO GRADE REQUIRED.

NOTE: DISTRIBUTION BOXES MUST HAVE BAFFLES

*INSTALLER IS RESPONSIBLE FOR OBTAINING FINAL APPROVAL ON THIS PERMIT

HD-260(6-90)


*CALL 461-9933 FOR INSPECTION OF SEPTIC SYSTEM.

ALL PLANS SIGNED

AND RETURNED 3-4-2002

B00134617 26018 DECK

47201B
47201B

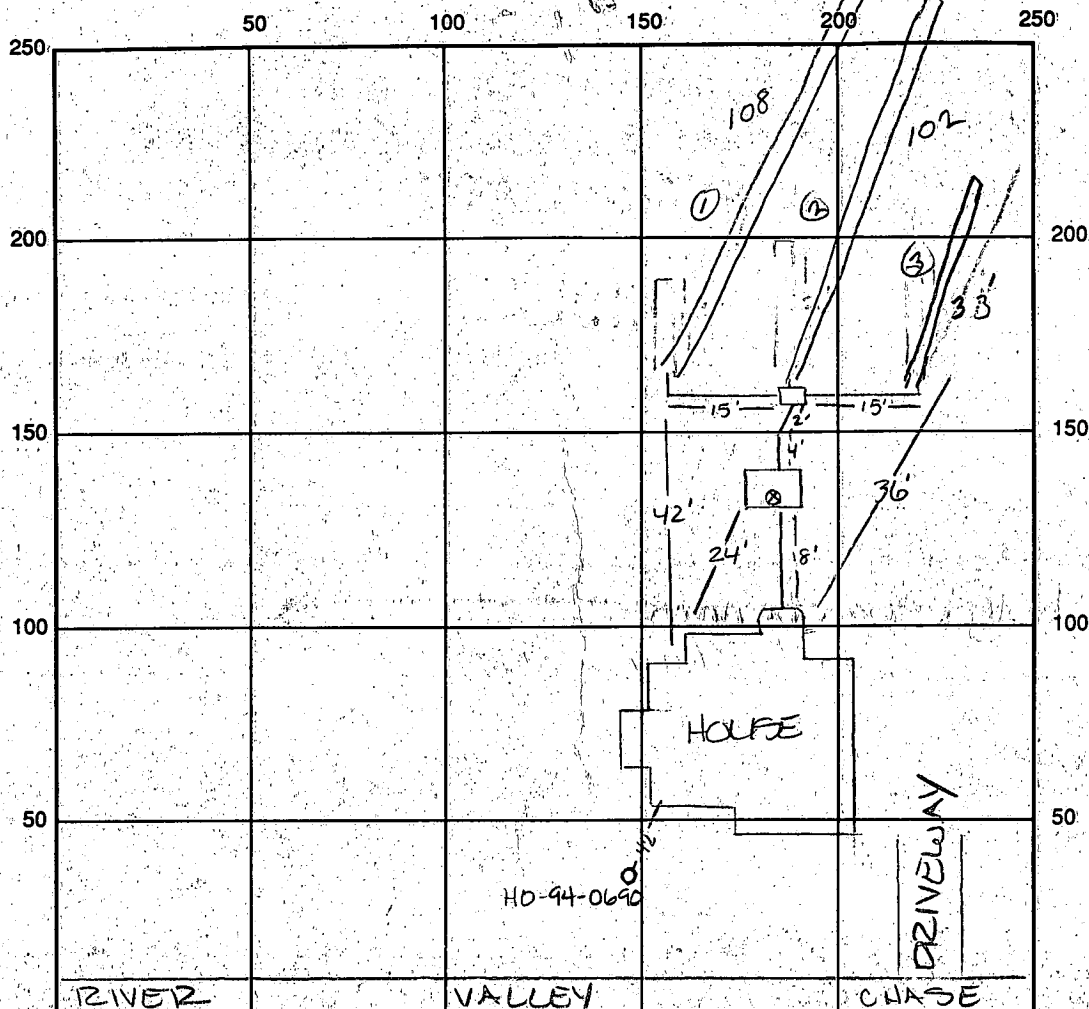

INDICATE NORTH - NAME ADJOINING ROADWAY AS BASE LINE

SEPTIC TANK LEVEL YES CLEANOUTS YES / 1 NOTED

DISTRIBUTION BOX LEVEL YES / BAFFLE NOT NOTED, LID CLOSED

DRAIN FIELD/TITLE DEPTH 5 ~~FOOT~~ TRENCH WIDTH 24 INCHES INLET DEPTH 3 FT.

EFFECTIVE GRAVEL DEPTH 2 FT. TOTAL LENGTH 213 FT.

NUMBER OF TRENCHES 3 ONE SIDEWALL/BOTTOM AREA 729 SQ. FT.

DRYWALL INSIDE DIAMETER — FT. EFFECTIVE DEPTH BELOW INLET — FT.

ABSORBENT AREA — SQ. FT.

REMARKS: Permit could not signed, locked in box.
Trenches must be extended to adequate length. 2/1/96
CONTRACTOR WILL REQUEST INSP. WHEN TRENCHES ARE COMPLETE. 2/2/96 (CW)
2-7-96 OK TO COVER ALL WORK, CONTRACTOR UNABLE TO BACKFILL
Ground FROZEN. 2/7

DATE SYSTEM APPROVED 2-7-96 INSPECTOR [Signature]

APPLICATION

PERCOLATION TESTING

A 47201

P _____

HOWARD COUNTY HEALTH DEPARTMENT
BUREAU OF ENVIRONMENTAL HEALTH
P.O. BOX 476 ELLICOTT CITY, MARYLAND 21043
TELEPHONE 461-9933

DISTRICT _____

DATE 6/12/91

TO: THE COUNTY HEALTH OFFICER
ELLICOTT CITY, MARYLAND

I, HEREBY, APPLY FOR THE NECESSARY TEST IN ORDER TO CONSTRUCT (OR RECONSTRUCT) A SEWAGE DISPOSAL SYSTEM.

PROPERTY OWNER PERCONTEE, INC.

ADDRESS 11900 TECH RD, SILVER SPRING MD. 20904 PHONE JOHN REUWER 740-2100 X291

PROSPECTIVE BUYER N/A

ADDRESS _____ PHONE _____

PROPERTY LOCATION:

SUBDIVISION WEST FRIENDSHIP ESTATES Section III Lot NO Lot 120
31

ROAD AND DESCRIPTION WEST IVORY RD. & RT 32, SOUTH OF RT. 70

TAX MAP 15 PARCEL # 42

SIZE OF LOT 3.00 AC. +/- TYPE BLDG SFD
(SINGLE FAMILY DWELLING OR COMMERCIAL)

BLDG. PERMIT SIGNED
AND RETURNED 11-14-95
Serial #61912

THE SYSTEM INSTALLED UNDER THIS APPLICATION IS ACCEPTABLE ONLY UNTIL PUBLIC FACILITIES BECOME AVAILABLE. I FULLY UNDERSTAND THE FEE CONNECTED WITH THE FILING OF THIS PERC TEST APPLICATION IS NON-REFUNDABLE UNDER ANY CIRCUMSTANCES. I ALSO AGREE TO COMPLY WITH ALL M.O.S.H.A. REQUIREMENTS IN TESTING THIS LOT.

(SIGNATURE OF APPLICANT)

APPROVED BY John C. Reuer FOR PERCONTEE, INC. DATE _____

REJECTED BY _____ FOR _____ DATE _____

HOLD PENDING FURTHER TESTS _____ DATE _____

REASONS FOR REJECTION OR HOLDING _____

HD-216

THIS IS NOT A PERMIT

Lot 120
A 47201
See Sheet A 47198

SOIL PROFILE

0'

INDICATE NORTH - NAME ADJOINING ROADWAY AS BASE LINE.

DATE	TEST NO.	DEPTH	PRE-WET		TEST - 1" DROP		TIME
			START	STOP	START	STOP	

REMARKS _____

TYPE OF SOIL _____

TESTED BY _____ ALSO PRESENT _____

BROWN
CLAY
BROWN
GREEN
Lumpy
SAND
SAND
SAND
HARD

ONLINE 2


LOWDOWN
CLAY
BROWN
GABB
LUMPY
SAND
LOWDOWN

③

BROWN
LA
BROWN
LUMPY
SAND
LOAN

⊕

BROWN
CH
BROWN
GREEN
LUMA
SAND
LON
HARD

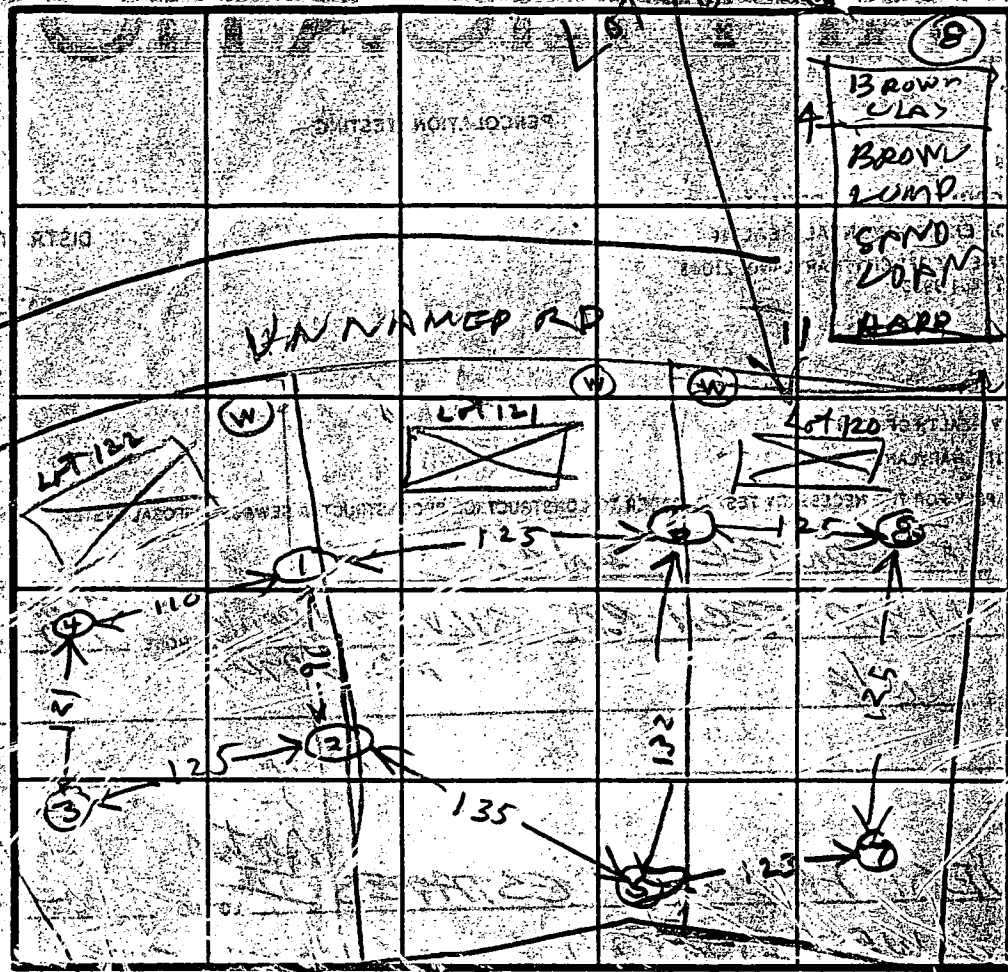

INDICATE NORTH: NAME ADJOINING ROADWAY AS BASE LINE

DATE	TEST NO.	DEPTH	PRE-WET		TEST - 1" DROP		TIME	
			START	STOP	START	STOP		
7/12/1	1	7.5	1020	1024	1024	1030	6	LOT #1
	1.5	3	1021	1024	1024	1030	6	LOT #1
	IV	10.5	OK SHALLOW					LOT #1
	2.5	2.5	1030	1036	1036	1042	6	ON LINE
	2V	9	OK SHALLOW					LOT #1
	3.5	3.5	1042	1053	1053	1104	9	LOT #1
	3V	11.5	OK SHALLOW					LOT #1
7/12/1	4V	9	OK SHALLOW					LOT #1
	5.5	3.5	1114	1119	1119	1128	4	ON LINE
	5V	11	OK SHALLOW					LOT #1
	6.5	3.5	1124	1128	1128	1138	10	ON LINE
	6V	7	1124	1126	1126	1129	3	LOT #1
	6V	11	OK SHALLOW					LOT #1
	7.5	4	1142	1143	1143	1146	3	LOT #1
	7V	10	OK SHALLOW					LOT #1
	8V	11	OK SHALLOW					LOT #1

REMARKS NO SURVEY OR STAKED HOLES

TYPE OF SOIL

TESTED BY

R. HODGES

JOHN REMVEK


ALSO PRESENT


HUGH
OKETTERMAN

*well permit transferred to R. Mayne

9-29-95
Location of well stake
OK.
not natural
then build earth
berm - called 41m
Selfridge - it is
not a storm water
management
device. 1 1/2-2' in
height - will have
no impact to
septic area.
OK to drill
well.

Amy McMillan
10-11-95 2:00pm
spoke w/Mr. Selfridge -
he reports dry hole
at approved well site.
I gave verbal approval
for 2nd site 40' from 1st site
and no closer to road. *Don't work*

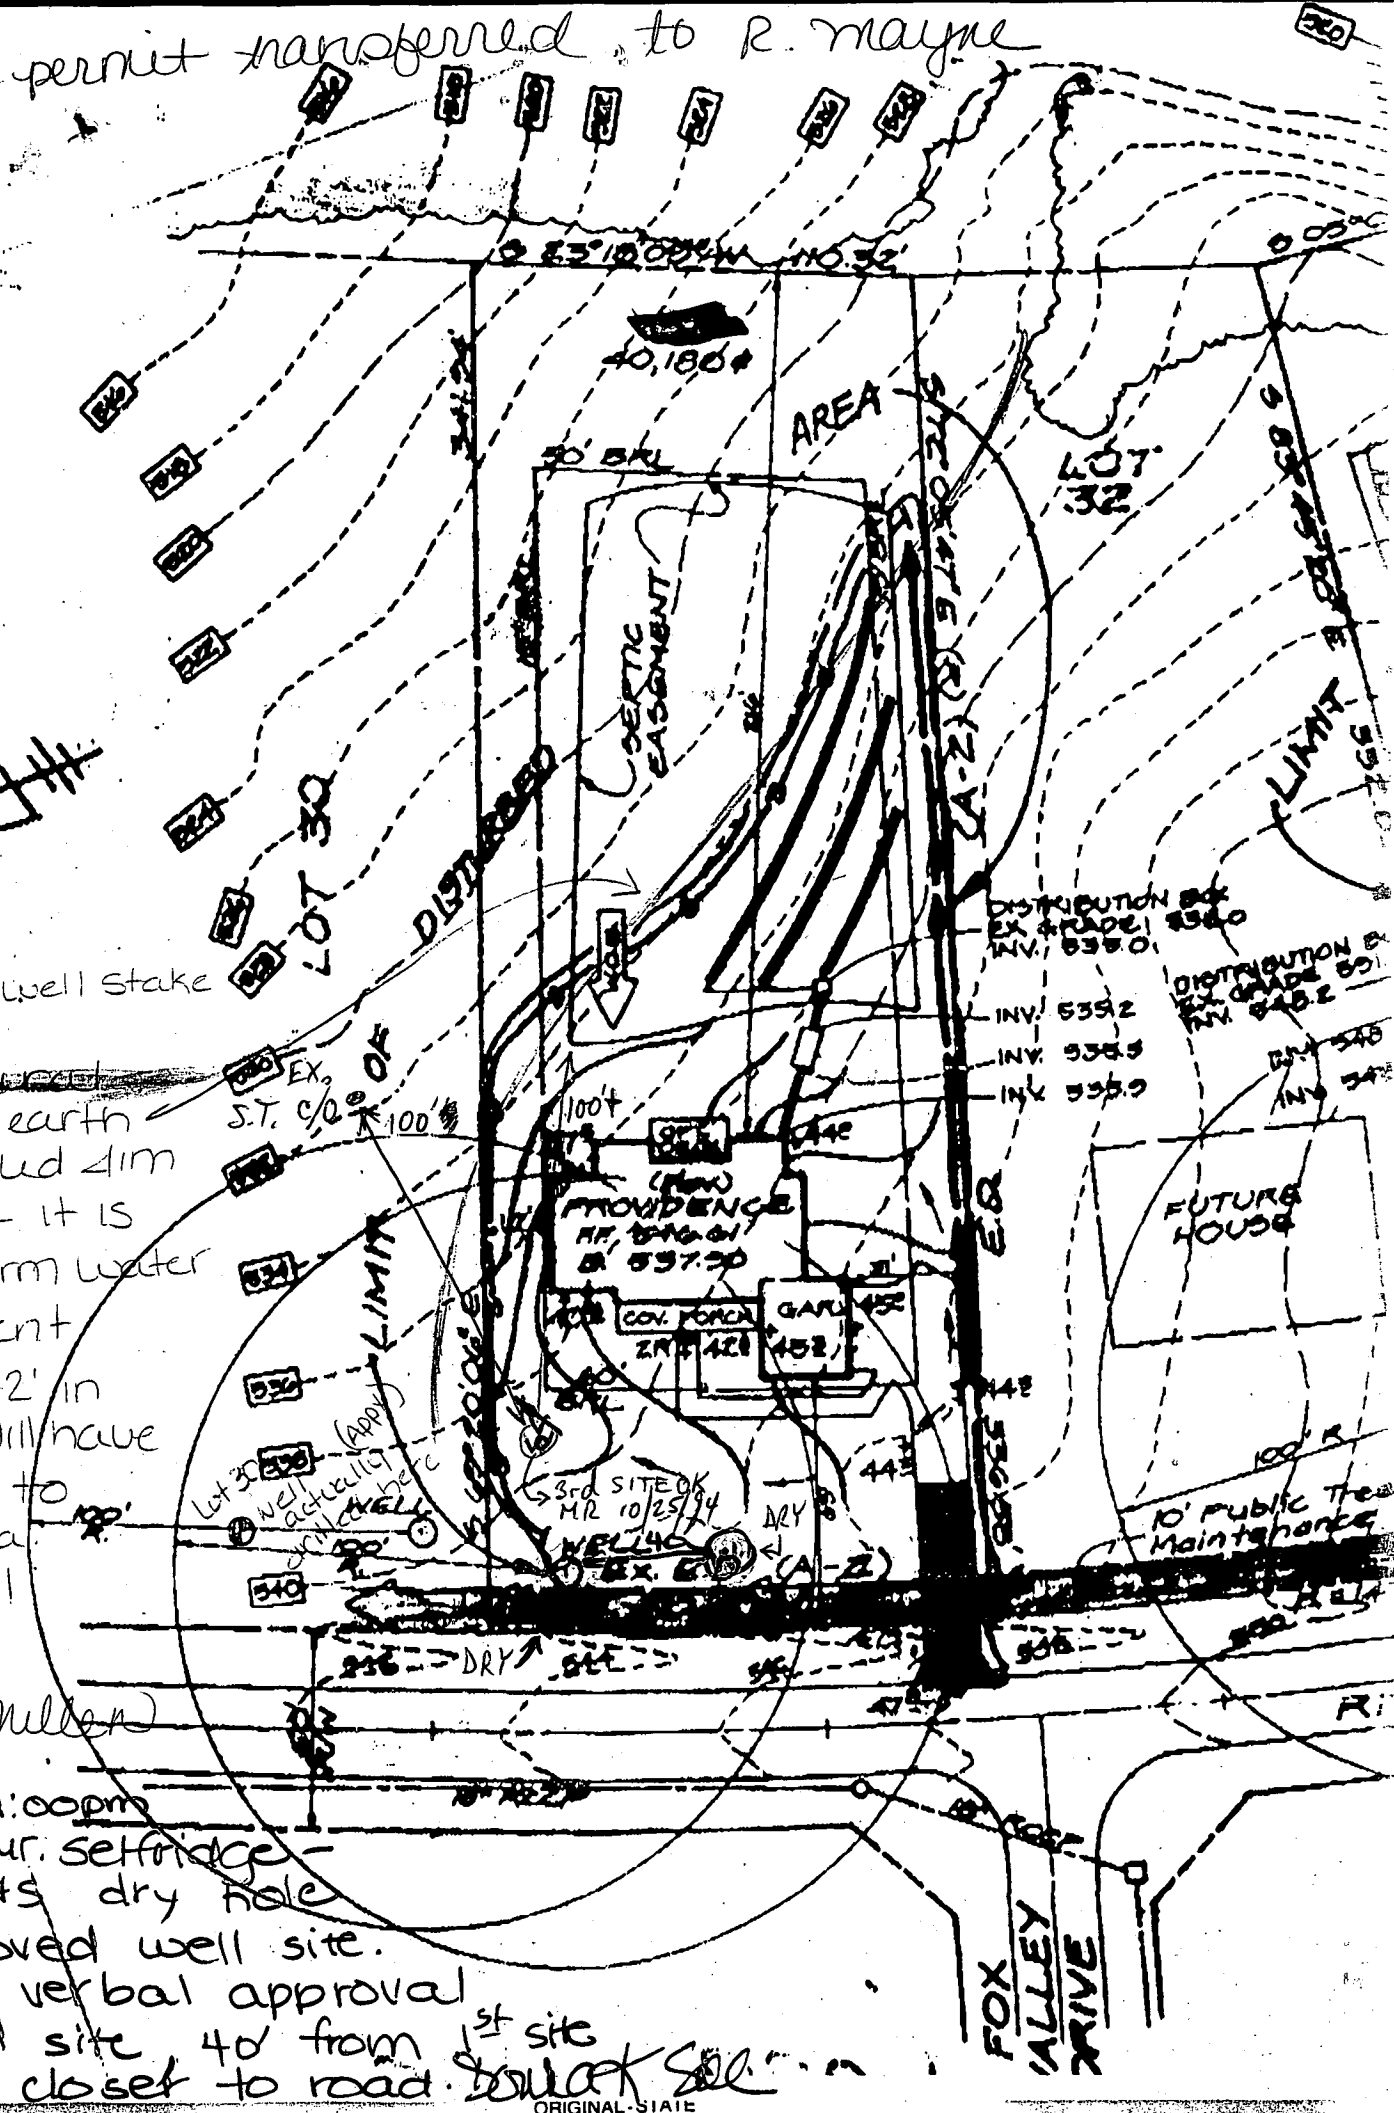

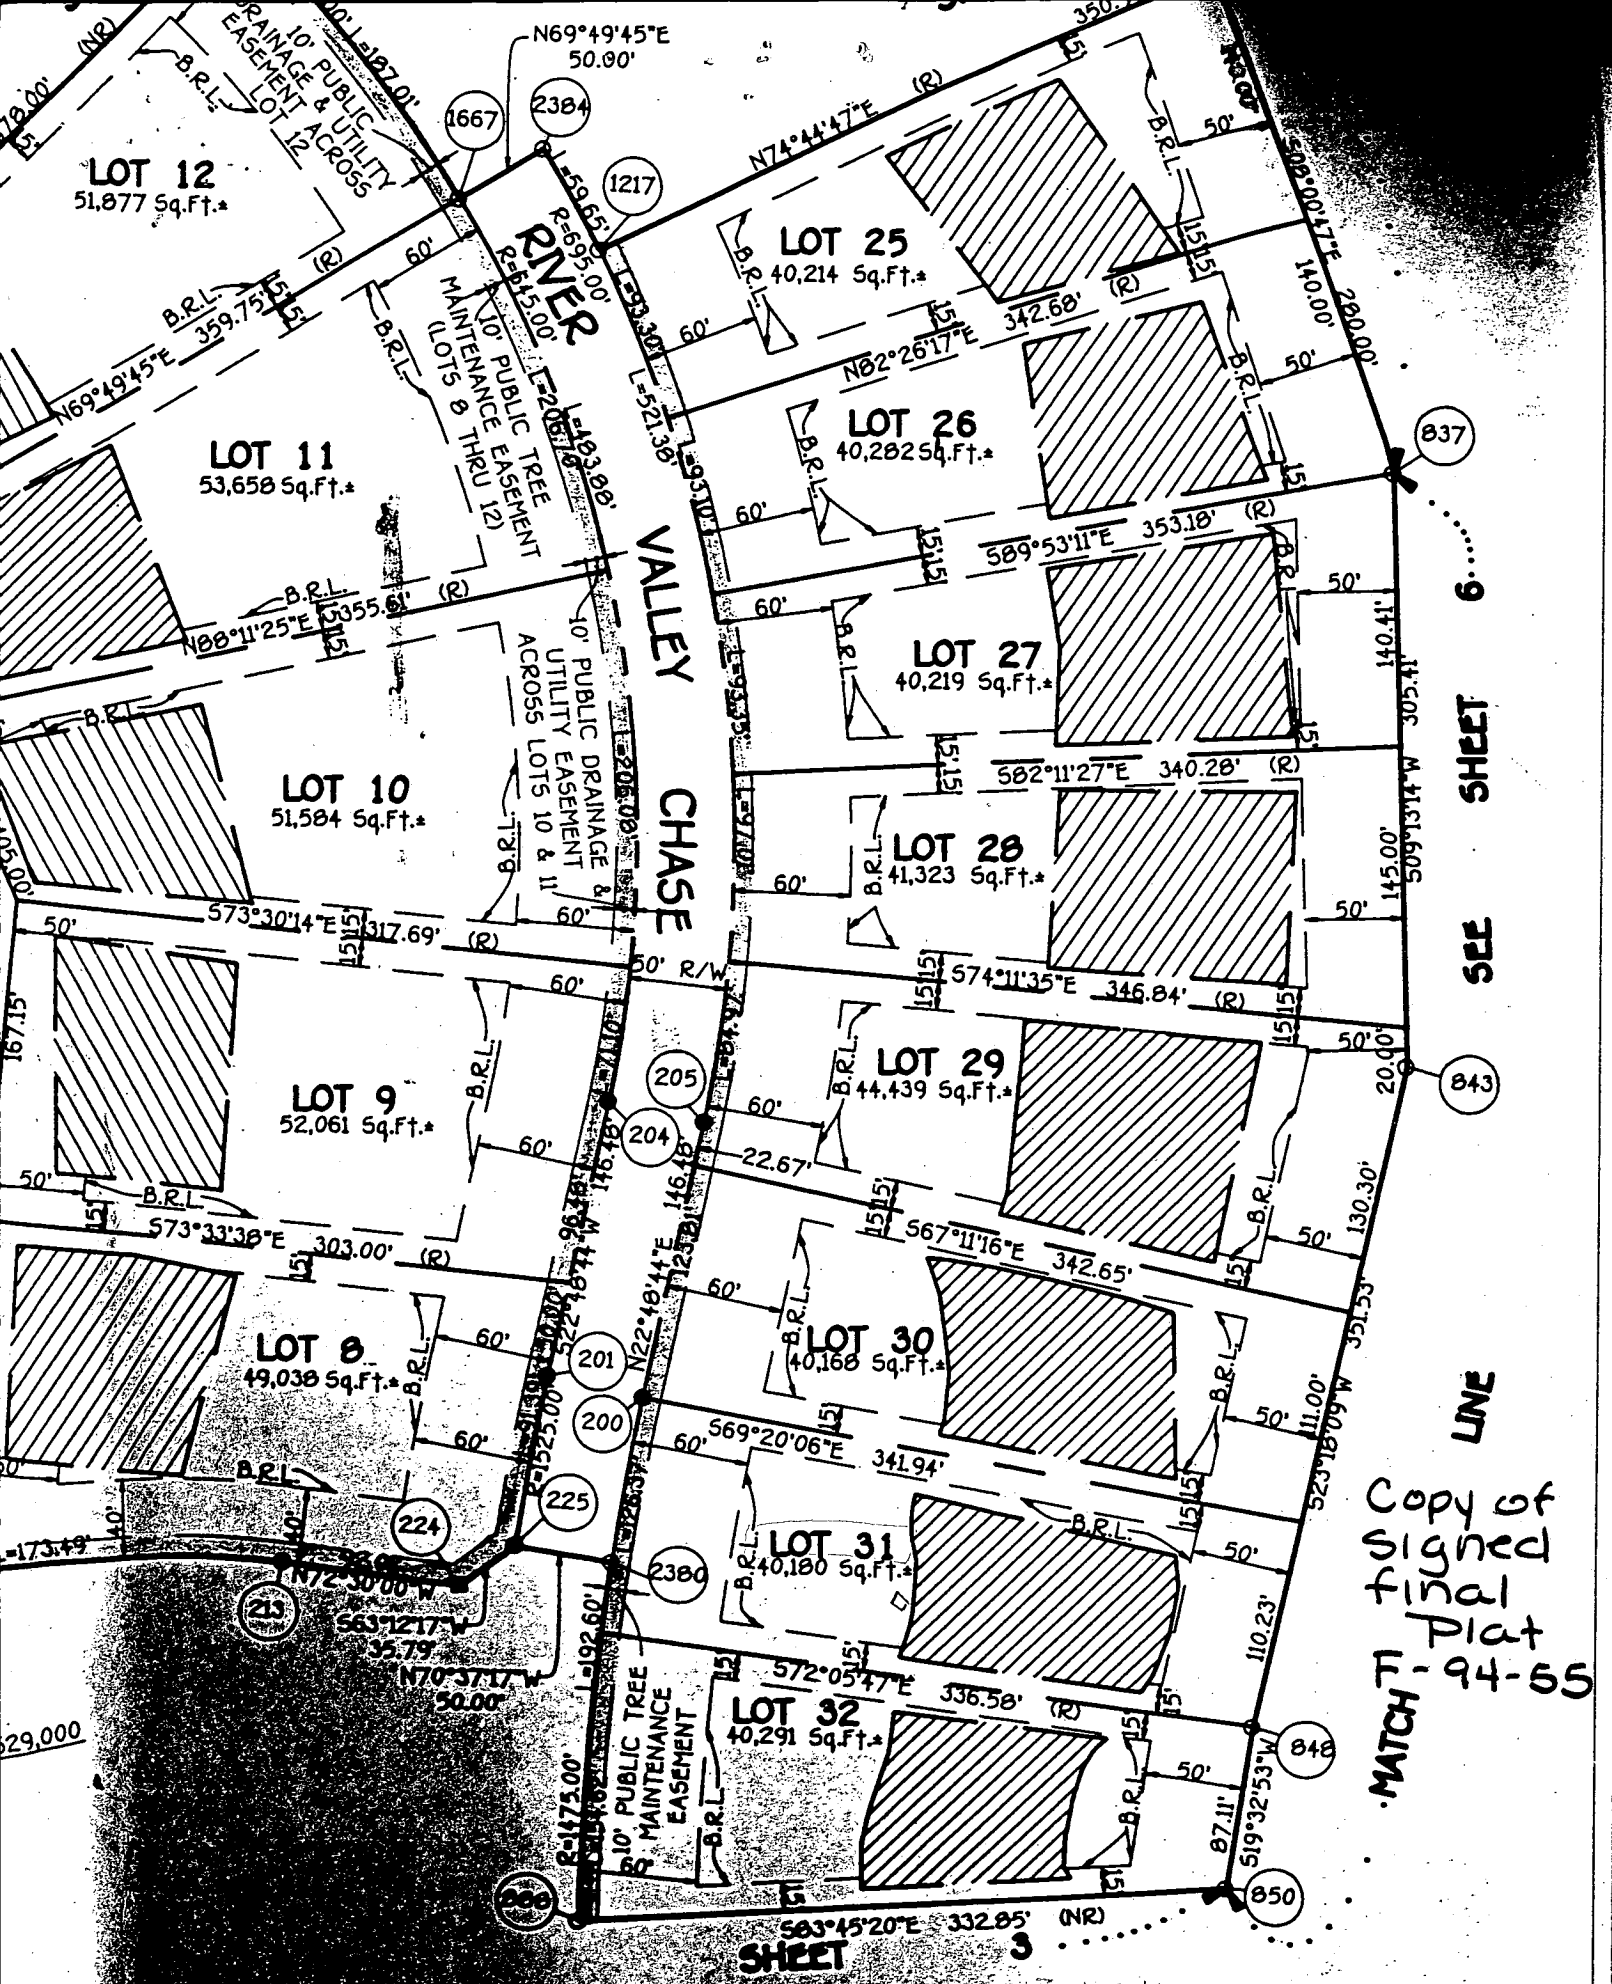

C1	2847	SEQUENCE NO. (MDE USE ONLY)	STATE MARYLAND WELL COMPLETION REPORT FILL IN THIS FORM COMPLETELY PLEASE PRINT OR TYPE	THIS REPORT MUST BE SUBMITTED WITHIN 45 DAYS AFTER WELL IS COMPLETED.
(THIS NUMBER IS TO BE PUNCHED IN COLS. 3-6 ON ALL CARDS)		COUNTY NUMBER A47201		
ST/CO USE ONLY DATE RECEIVED	DATE WELL COMPLETED	Depth of Well	PERMIT NO. FROM "PERMIT TO DRILL WELL"	
0911395	101095	22 245 26 (TO NEAREST FOOT)	H0-94-0690	

OWNER James Selfridge
STREET OR RFD Fox Valley Chase TOWN West Friendship
SUBDIVISION West Friendship Est. SECTION I LOT 31

WELL LOG Not required for driven wells			GROUTING RECORD WELL HAS BEEN GROUTED (Circle Appropriate Box) YES ☒ Y NO ☐ N TYPE OF GROUTING MATERIAL (Circle one) CEMENT ☒ CM BENTONITE CLAY ☐ BC NO. OF BAGS 10 NO. OF POUNDS 1000 GALLONS OF WATER 60 DEPTH OF GROUT SEAL (to nearest foot) from 0 ft. to 34 ft. TOP BOTTOM (enter 0 if from surface)			C 3 PUMPING TEST HOURS PUMPED (nearest hour) 3 PUMPING RATE (gal. per min.) 6 METHOD USED TO MEASURE PUMPING RATE Bucket WATER LEVEL (distance from land surface) BEFORE PUMPING 29 ft. WHEN PUMPING 85 ft. TYPE OF PUMP USED (for test) ☒ A air ☐ P piston ☐ T turbine ☒ C centrifugal ☐ R rotary ☐ O other (describe below) ☐ J jet ☒ S submersible		
STATE THE KIND OF FORMATIONS PENETRATED, THEIR COLOR, DEPTH, THICKNESS AND IF WATER BEARING			CASING RECORD casing types insert appropriate code below ☒ ST STEEL ☐ CO CONCRETE ☒ PL PLASTIC ☐ OT OTHER MAIN CASING TYPE Nominal diameter top (main) casing (nearest inch) 6 Total depth of main casing (nearest foot) 38 OTHER CASING (if used) diameter inch depth (feet) from to			PUMP INSTALLED DRILLER WILL INSTALL PUMP (CIRCLE) (YES OR NO) YES ☐ NO ☒ IF DRILLER INSTALLS PUMP, THIS SECTION MUST BE COMPLETED FOR ALL WELLS. TYPE OF PUMP INSTALLED PLACE (A,C,J,P,R,S,T,O) IN BOX 29 CAPACITY: GALLONS PER MINUTE (to nearest gallon) PUMP HORSE POWER PUMP COLUMN LENGTH (nearest ft.) CASING HEIGHT (circle appropriate box and enter casing height) LAND SURFACE (nearest foot)		
DESCRIPTION (Use additional sheets if needed)			SCREEN RECORD screen type or open hole insert appropriate code below ☒ ST STEEL ☐ BR BRASS ☒ HO OPEN HOLE ☐ PL PLASTIC ☐ OT OTHER SLOT SIZE 1 2 3 DIAMETER OF SCREEN (NEAREST INCH) 56 60 GRAVEL PACK IF WELL DRILLED WAS FLOWING WELL INSERT F IN BOX 68 MDE USE ONLY (NOT TO BE FILLED IN BY DRILLER) T (E.R.O.S.) W Q 70 72 74 75 76 TELESCOPE CASING LOG INDICATOR OTHER DATA			LOCATION OF WELL ON LOT SHOW PERMANENT STRUCTURE SUCH AS BUILDING, SEPTIC TANKS, AND /OR LANDMARKS AND INDICATE NOT LESS THAN TWO DISTANCES (MEASUREMENTS TO WELL) well 15' 40' 40' 120' dry hole 20' 40' 120' dry hole 20' 40' 120' Road		
NUMBER OF UNSUCCESSFUL WELLS: 2			C 2 DEPTH (nearest ft.) H0 36 245 A 8 9 11 15 17 21 C 23 24 26 30 32 36 S 38 39 41 45 47 51 E 56 60 N					
WELL HYDROFRACTURED YES ☐ NO ☒ N								
CIRCLE APPROPRIATE LETTER A A WELL WAS ABANDONED AND SEALED WHEN THIS WELL WAS COMPLETED E ELECTRIC LOG OBTAINED P TEST WELL CONVERTED TO PRODUCTION WELL I HEREBY CERTIFY THAT THIS WELL HAS BEEN CONSTRUCTED IN ACCORDANCE WITH COMAR 26.04.04 "WELL CONSTRUCTION" AND IN CONFORMANCE WITH ALL CONDITIONS STATED IN THE ABOVE CAPTIONED PERMIT, AND THAT THE INFORMATION PRESENTED HEREIN IS ACCURATE AND COMPLETE TO THE BEST OF MY KNOWLEDGE. TYPE: MWDMSD/MGD DRILLERS LIC. NO. 116 Ralph Mayne DRILLERS SIGNATURE (MUST MATCH SIGNATURE ON APPLICATION) LIC. NO. 117 Ralph E. Mayne SITE SUPERVISOR (sign. of driller or journeyman responsible for sitework if different from permittee)								

EXISTING
ELEMENT
ATH
LE BERM
D)

EXISTING
ELEMENT


equivalent.
single resi-

depth at
placing of stone.
construction
impractical.
in which will
away. This may
tions demand
ment. All
hts-of-way must
o entrance onto
done on an area
ment trapping
after each rain.


RANCE (SCE)

LEGEND

- Contour interval 2 Ft.
- Proposed Contour - - - - - 448
- Existing Contour - - - - - 448
- Spot Elevation +482
- Direction of Drainage - - - - -
- Silt Fence - S-S-S-
- Stabilized Construction Entrance w/ Mountable Berm
- Ex. Earth Dike - - - - - Ex. E.D. (A-1)
- Earth Dike - - - - - E.D. (A-1)
- Limit of Disturbance - - - - -

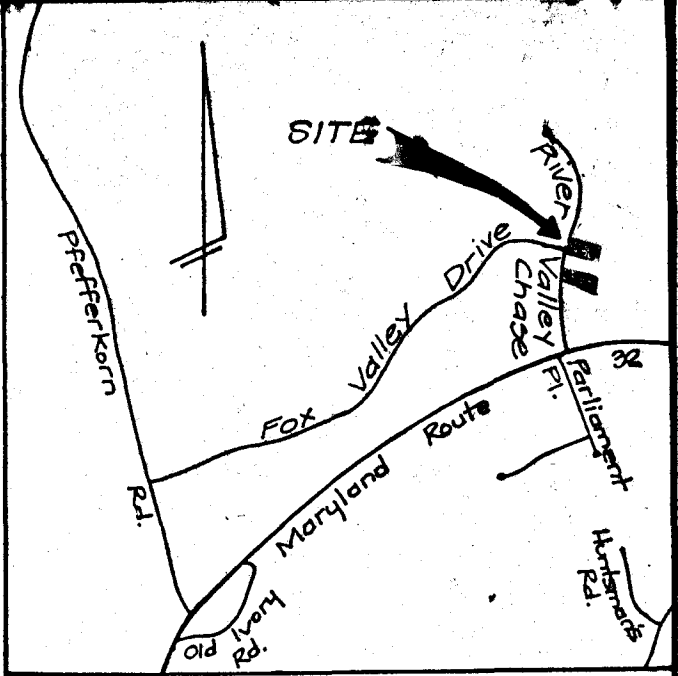

VICINITY MAP
Scale: 1" = 2000'

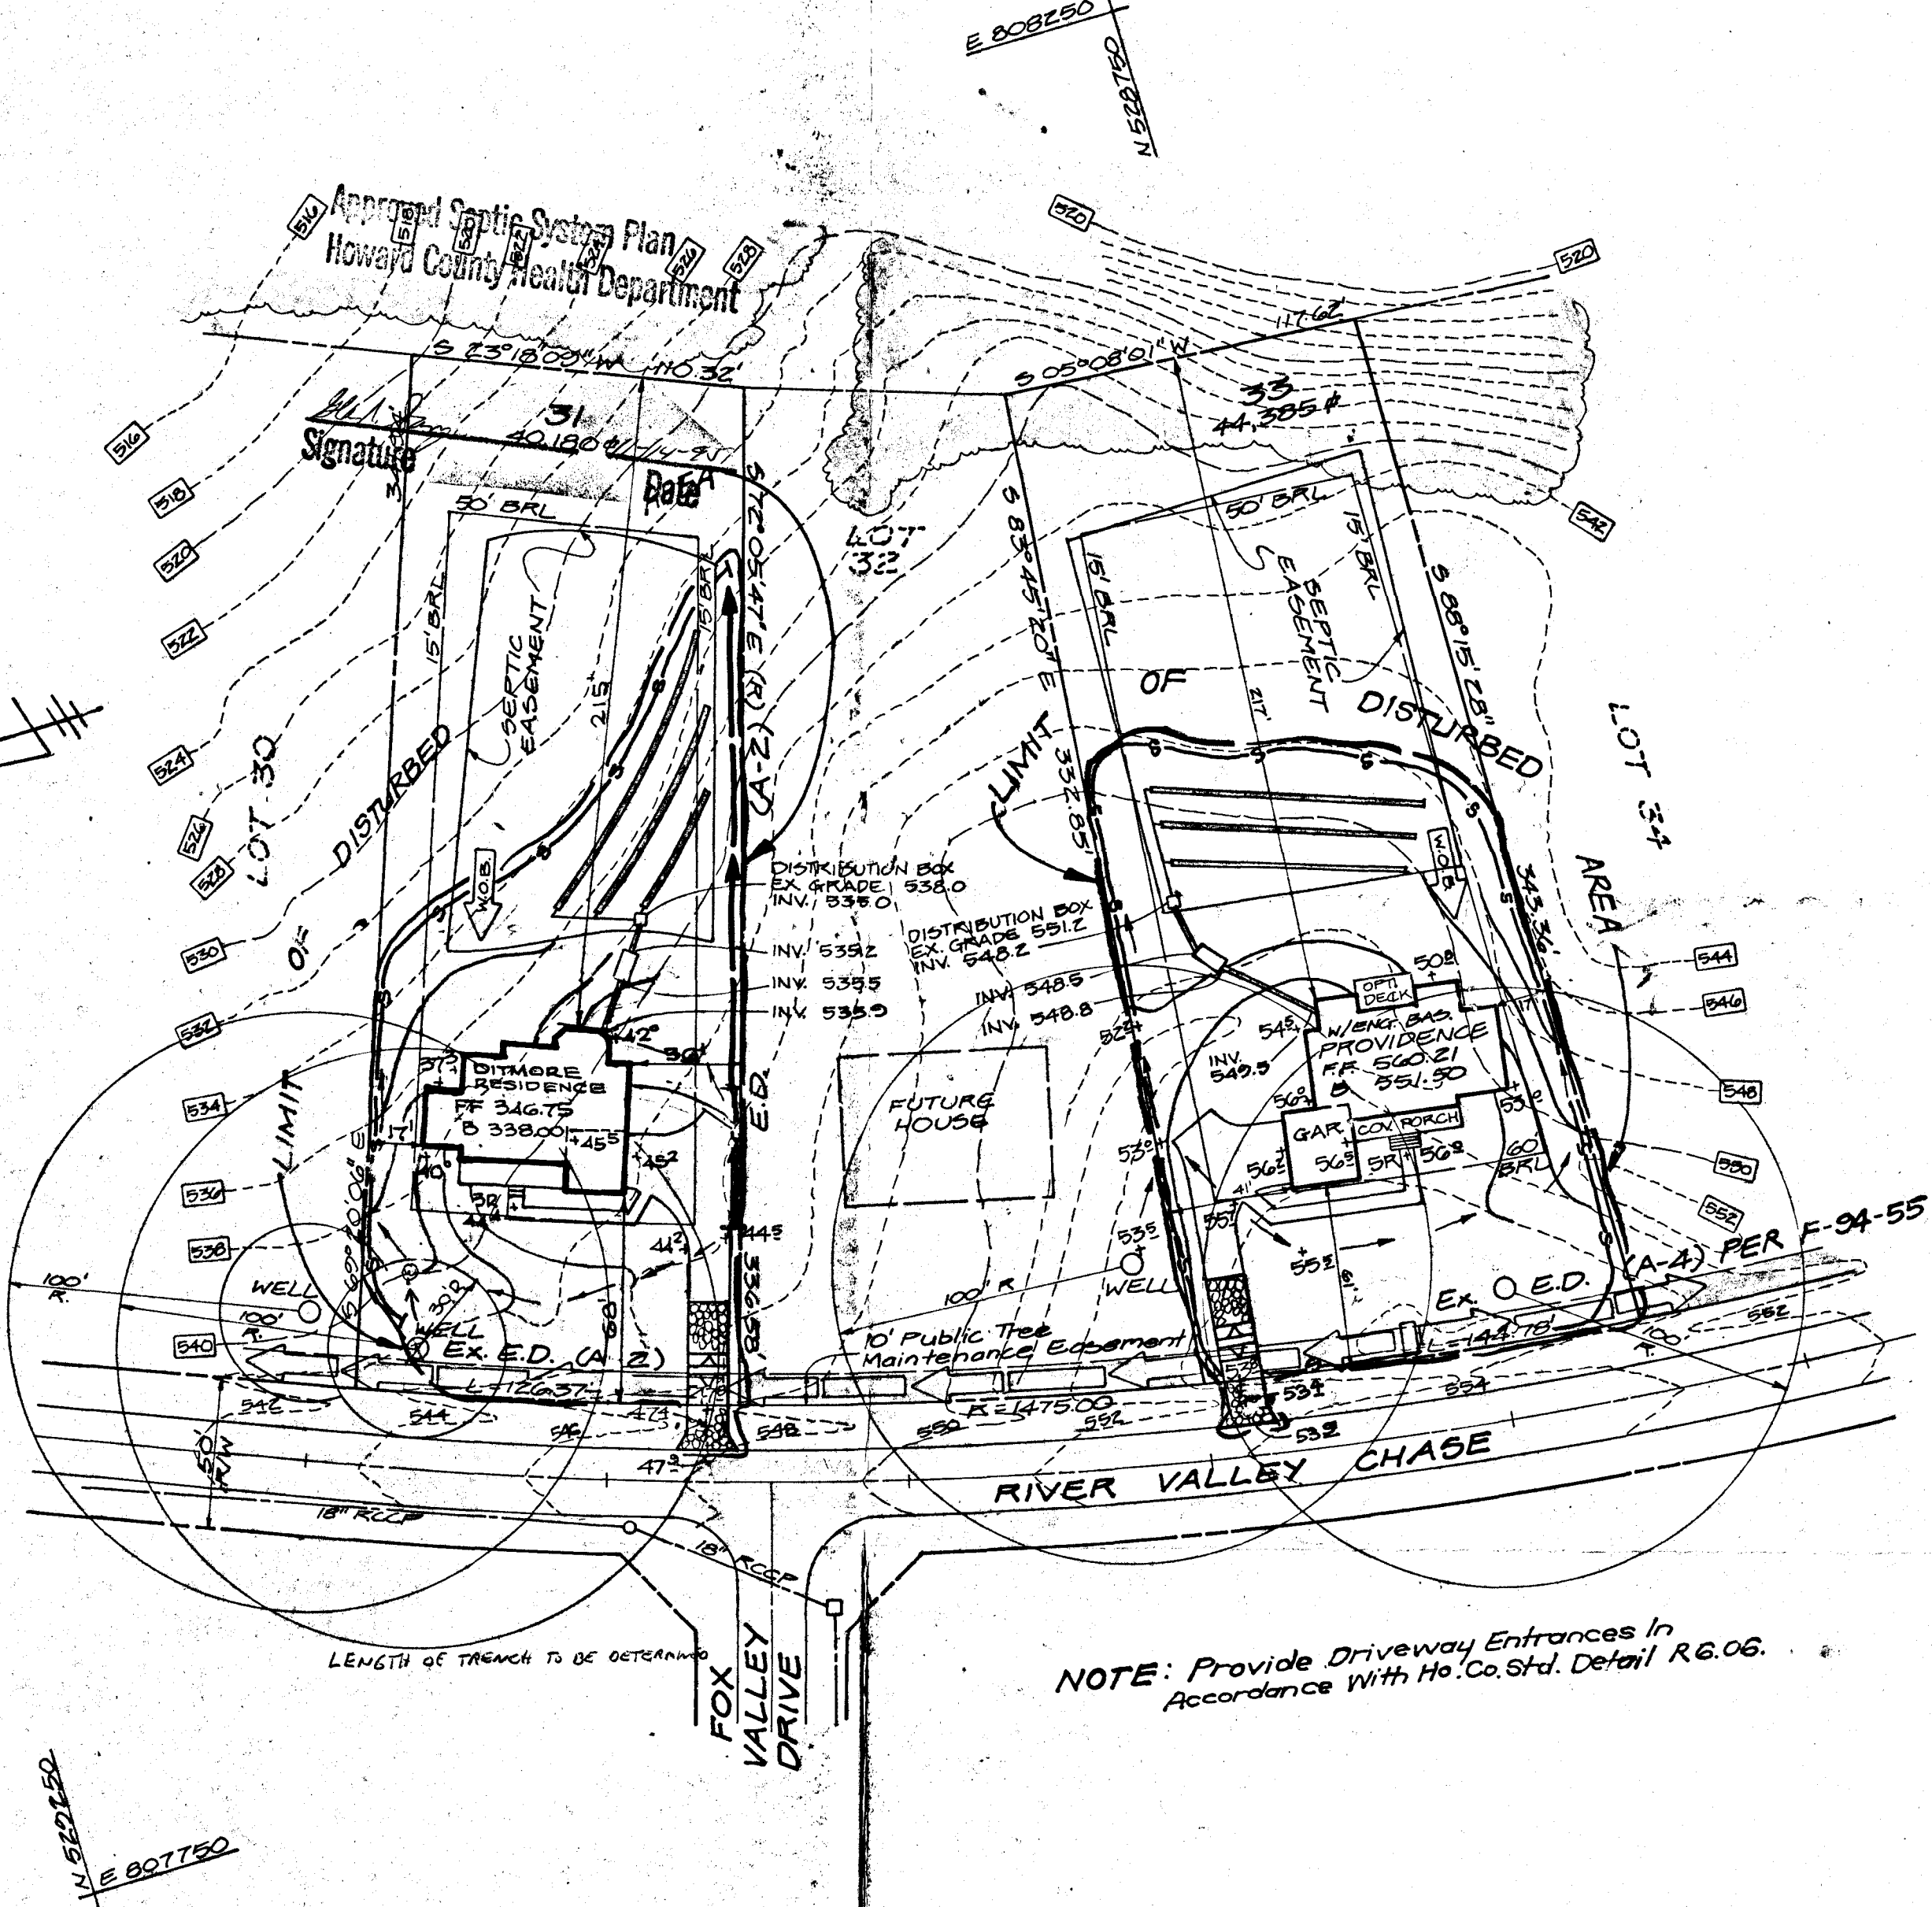

NOTE: Provide Driveway Entrances In
Accordance With Ho. Co. Std. Detail R6.06.

will be done according
nt and erosion control and
struction project will have a
Environment Approved.
Erosion before beginning
section by the Howard
ts, as are deemed

ENGINEER'S CERTIFICATE

I hereby certify that this plan for Sediment and
Erosion Control represents a practical and workable
plan based on my personal knowledge of the site
conditions and that it was prepared in accordance
with the requirements of the Howard Soil Conserva-
tion District.



8-2-94

8-2-94

 CLARK • FINEFROCK & SACKETT, INC. ENGINEERS • PLANNERS • SURVEYORS 7135 MINSTREL WAY • COLUMBIA, MD. 21045 • (410) 381-7500 - BALTO. • (301) 621-8100 - WASH.		
DESIGNED ZAL RMT	SITE DEVELOPMENT, SEDIMENT AND EROSION CONTROL PLAN LOTS 31 & 33 WEST FRIENDSHIP ESTATES SECTION I 3RD ELECTION DISTRICT HOWARD COUNTY, MARYLAND For JAMES H. SELFRIDGE BLDGS, INC. 8131 Dorsey Run Road Jessup, Maryland 20794	SCALE 1" = 50'
DRAWN MCR		DRAWING 1 OF 1
CHECKED JME		JOB NO. 94-144
DATE 8-2-94		FILE NO. 94-144X
GP-95-08		

FOX VALLEY DRIVE

DEPARTMENT OF INSPECTIONS, LICENSES AND PERMITS 3430 COURT HOUSE DRIVE ELLCOTT CITY, MD 21043 PERMITS (410)313-2465 INSPECTIONS (410)313-1810 AUTOMATED INFORMATION (410) 313-3800		HOWARD COUNTY PERMIT APPLICATION		PERMIT NUMBER B00134617	
Building Address <u>3140 River Valley Chase Dr</u>			Property Owner's Name <u>KELLY SUSAN BRENNAN</u>		
Suite/Apt. # <u>W. Friendship</u>			Address <u>3140 RIVER VALLEY CHASE DRIVE</u>		
Census Tract <u>6030</u> Subdivision <u>Fox Valley</u>			City <u>W. FRIENDSHIP</u> State <u>MD</u> Zip Code <u>21794</u>		
Section <u>15</u> Area <u>1</u> Lot <u>31</u> Est. <u>EST.</u>			Home Phone <u>410-488-6641</u> Work Phone <u>410-780-1570</u>		
Tax Map <u>15</u> Parcel <u>1</u> Grid <u>21</u>			Applicant's Name & Mailing Address, (if other than stated hereon): <u>N/A</u>		
Zoning <u>RC</u> Map Coordinates <u>9K6</u> Lot size <u>1</u>			Phone <u>N/A</u> Fax <u>N/A</u>		
Existing Use <u>SINGLE FAMILY HOME</u>			Contractor Company <u>CUNEL</u>		
Proposed Use <u>WITH DECK</u>			Contact Person <u>KELLY BRENNAN</u>		
Estimated Construction Cost <u>\$8800</u>			Address <u></u>		
Description of Work <u>ADD 28' x 18' TREATED DECK WITH STAIRS</u>			City <u></u> State <u></u> Zip Code <u></u>		
Occupant or Tenant <u></u>			Engineer or Architect Company <u></u>		
Contact Name <u></u>			Contact Person <u></u>		
Address <u></u>			Address <u></u>		
City <u></u> State <u></u> Zip Code <u></u>			City <u></u> State <u></u> Zip Code <u></u>		
Phone <u></u> Fax <u></u>			Phone <u></u> Fax <u></u>		
BUILDING DESCRIPTION - COMMERCIAL			BUILDING DESCRIPTION - RESIDENTIAL		
Building Characteristics			Building Characteristics		
Height: <u></u>			SF Dwelling ☒ SF Townhouse ☐		
No. of stories: <u></u>			Depth <u></u> Width <u></u>		
Gross area, sq. ft. per floor: <u></u>			1st floor: <u></u>		
Use group: <u></u>			2nd floor: <u></u>		
Construction type: <u></u>			Basement: <u></u>		
Reinforced Concrete ☐			Finished Basement ☒ Unfinished Basement ☐		
Structural Steel ☐			Crawl space ☐ Slab on Grade ☐		
Masonry ☐			No. of Bedrooms <u>5</u>		
Wood Frame ☐			Multi-family dwellings: <u></u>		
State Certified Modular ☐			No. of efficiency units: <u></u>		
Utilities			No. of 1 BR units: <u></u>		
Water Supply: <u></u>			No. of 2 BR units: <u></u>		
Public ☐			No. of 3 BR units: <u></u>		
Private ☐			Other Structure: <u></u>		
Sewage Disposal: <u></u>			Dimensions: <u></u>		
Public ☐			Footings: <u></u>		
Private ☐			Roof: <u></u>		
Electric Yes ☐ No ☐			State Certified Modular ☐		
Gas Yes ☐ No ☐			Manufactured Home ☐		
Heating System: <u></u>			Water Supply: <u></u>		
Electric ☐ Oil ☐			Public ☐		
Natural Gas ☐			Private ☒		
Propane Gas ☐			Sewage Disposal: <u></u>		
Sprinkler system: <u>N/A</u>			Public ☐		
Full ☐			Private ☒		
Partial ☐			Electric Yes ☒ No ☐		
Other Suppression ☐			Gas Yes ☒ No ☐		
# of Heads <u></u>			Heating System: <u></u>		
			Electric ☐ Oil ☐		
			Natural Gas ☒		
			Propane Gas ☐		
			Sprinkler system: <u>N/A</u>		
			NFPA #13D ☐		
			NFPA #13R ☐		
			Other: <u></u>		

THE UNDERSIGNED HEREBY CERTIFIES AND AGREES AS FOLLOWS: (1) THAT HE/SHE IS AUTHORIZED TO MAKE THIS APPLICATION; (2) THAT THE INFORMATION IS CORRECT; (3) THAT HE/SHE WILL COMPLY WITH ALL REGULATIONS OF HOWARD COUNTY, WHICH ARE APPLICABLE THERE TO; (4) THAT HE/SHE WILL PERFORM NO WORK ON THE ABOVE REFERENCED PROPERTY NOT SPECIFICALLY DESCRIBED IN THIS APPLICATION; (5) THAT HE/SHE GRANTS COUNTY OFFICIALS THE RIGHT TO ENTER ON THIS PROPERTY FOR THE PURPOSE OF INSPECTING THE WORK PERMITTED AND POSTING NOTICES.

Applicant's Signature Susan M Brennan Print Name SUSAN M BRENNAN
Date 2-28-02


Title/Company

Checks payable to: DIRECTOR OF FINANCE OF HOWARD COUNTY
** PLEASE WRITE NEATLY AND LEGIBLY **

AGENCY: <u>DPZ</u> DATE: <u>2/28/02</u> SIGNATURE APPROVAL: <u>[Signature]</u>		FOR OFFICE USE ONLY		PROPERTY ID: <u>166623</u>	
Land Development ☒ DPZ		DPZ SETBACK INFORMATION		Filing fee: <u>\$100</u>	
State Highways ☒ DPZ		Front: <u></u>		Permit fee: <u>\$100</u>	
Building Official ☒ DPZ		Rear: <u></u>		Excise tax: <u>\$100</u>	
Dev. Engineering ☒ DPZ		Side: <u></u>		Add'l. per fee: <u>\$100</u>	
Health ☒ DPZ		Side St. <u></u>		TOTAL FEES: <u>\$300</u>	
Fire Protection ☒ DPZ		All minimum setbacks met? ☒		Sub-total paid: <u>\$300</u>	
Is Sediment Control approval required prior to issuance? ☐		Is Entrance Permit required? ☐		Balance due: <u>\$0</u>	
YES ☐ NO ☐		Historic District? ☐		Check <u>2/28/02</u>	
CONTINGENCY CONSTRUCTION START ☐		YES ☐ NO ☐		Validation <u>2/28/02</u>	
ONE STOP SHOP ☐		Lot Coverage for New Town Zone <u></u>		Accepted by <u>[Signature]</u>	
Distribution of Copies: White: Building Official Green: LDD, DPZ Yellow: DED, DPZ Pink: Health Gold: SHA		SDP/Red-line approval date: <u>2/28/02</u>			

447203
NEW # 940680

Deck needs to be pushed away another 3' at least for BP signature

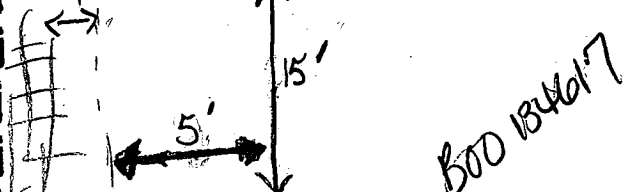

3/4/02
Deck - flagged out - Now 8' dist from deck to S.T. CLO

(KG)


2/29/02

~ 3:15
Called to share an option - move S.T.

1-40

The S.T. CLO is 5' away from proposed addition. Told Kelly & Susan there needs to be 10' separation but Mark would allow 8' separation. Explained that a distance is needed so that a backhoe could reach the shore on the side closest to deck to replace S.T. if necessary & also room for equipment to pump out the tank.

Susan will call the deck installer for revisions on deck designs. Kelly will submit new plan for us to OK

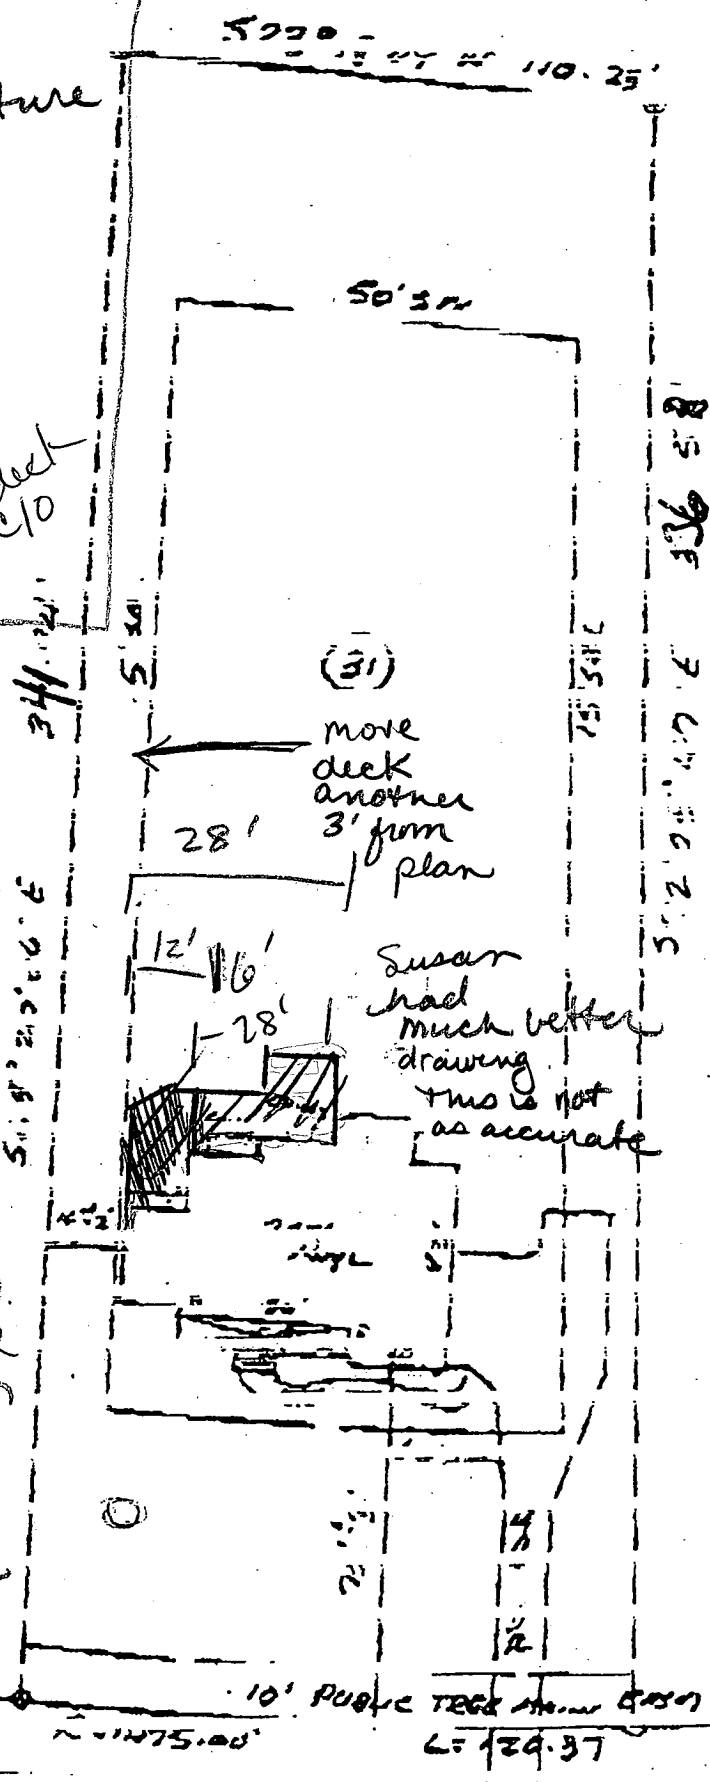


RIVER VALLEY CHURCH 50' NW


Brennan

--- Beams
X Posts

3
1

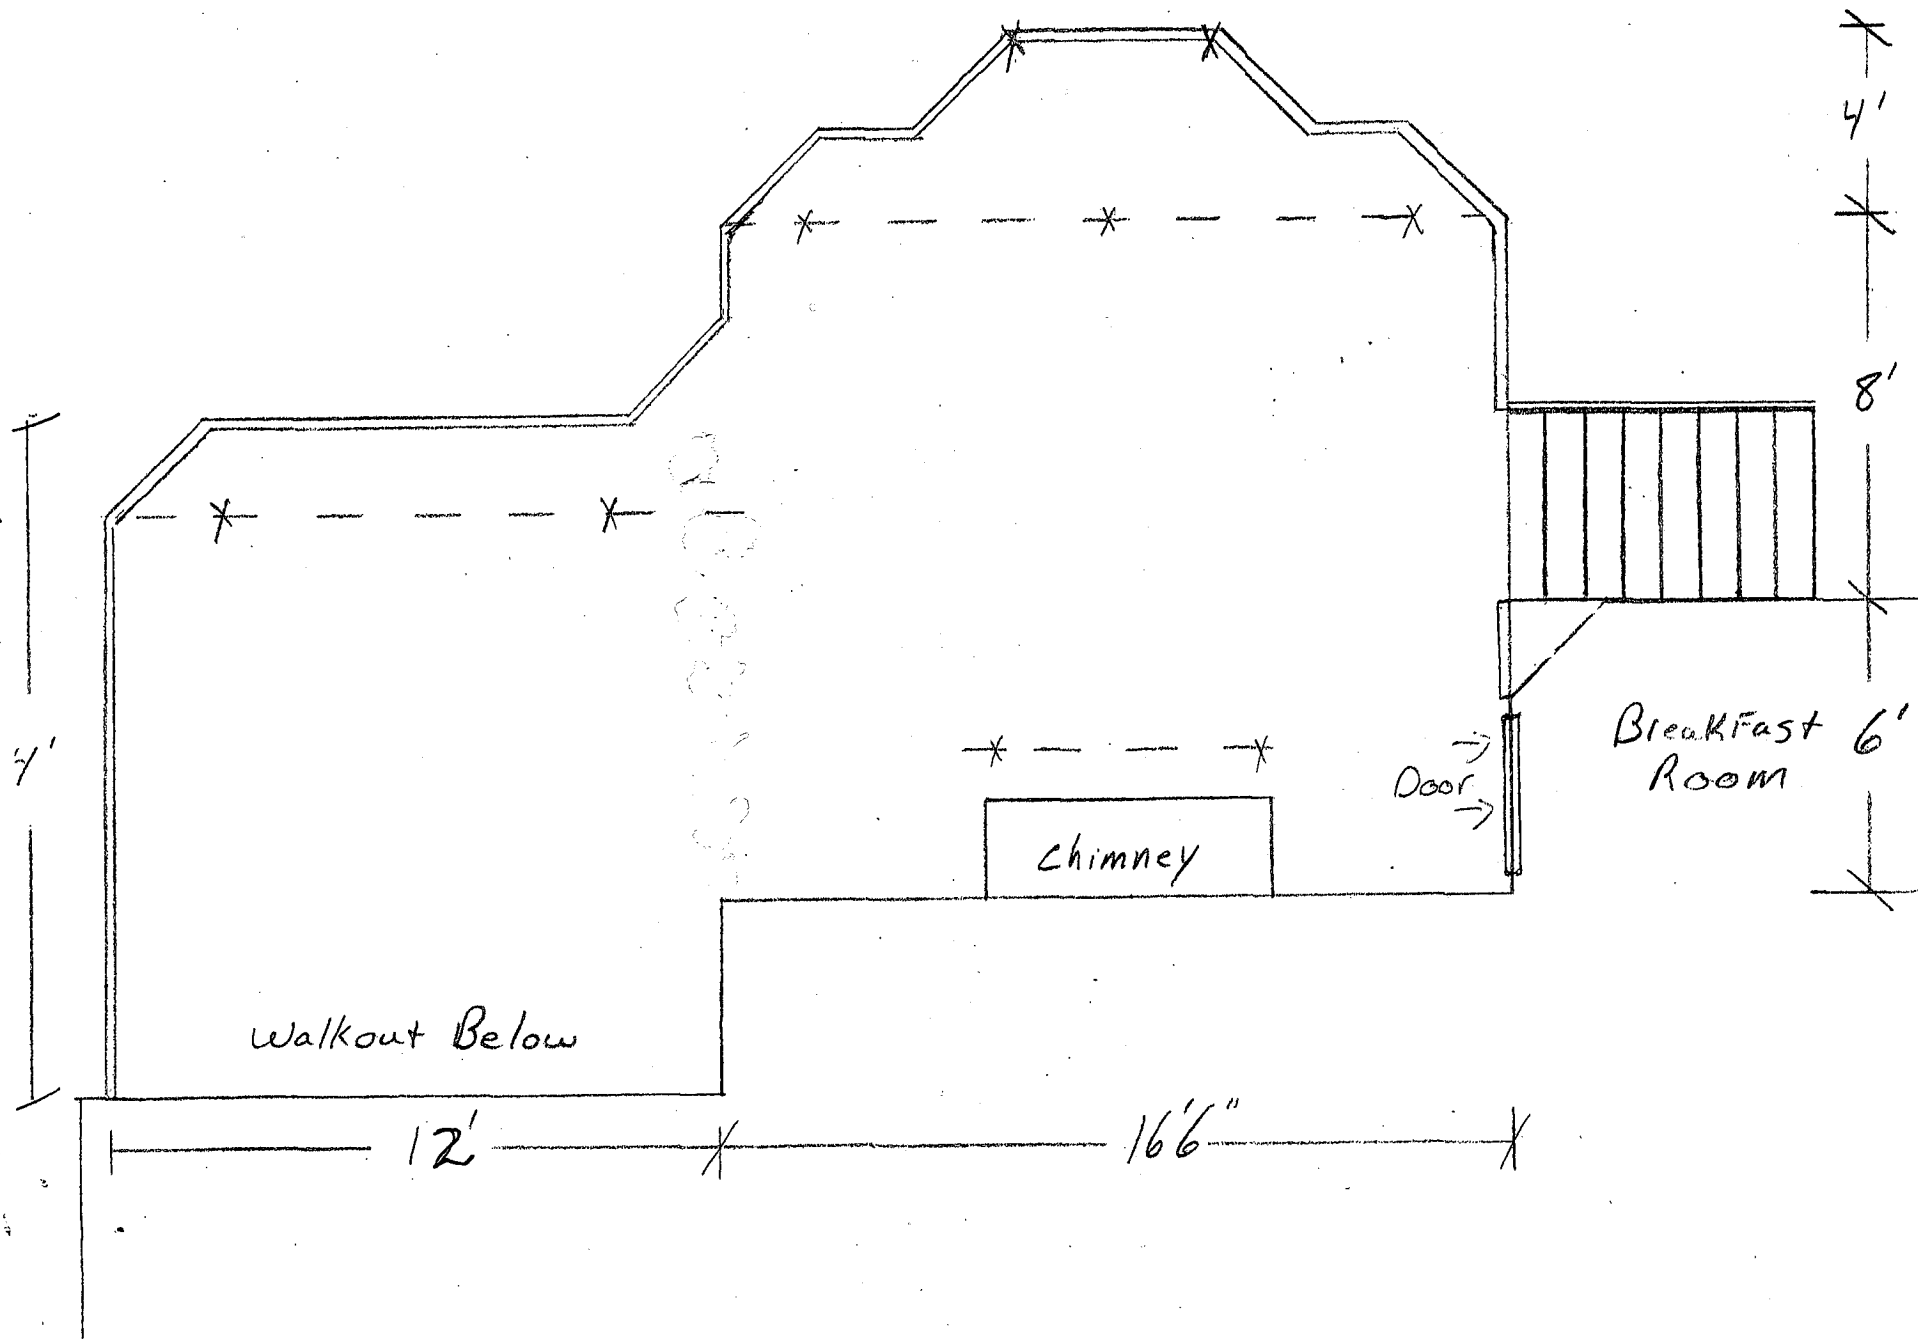

Scale

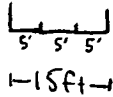


Subdivision: Fox Valley
Tax Map: 15
Lot: 31
Block: 21
ID# : 0000-0001-6623
Total Area: 0.91

6/27/02 (MR)

DECK BP RE-ISSUED
TO NEW OWNER
(DECK SHORTENED
SLIGHTLY FROM FRONT TO REAR)

OK

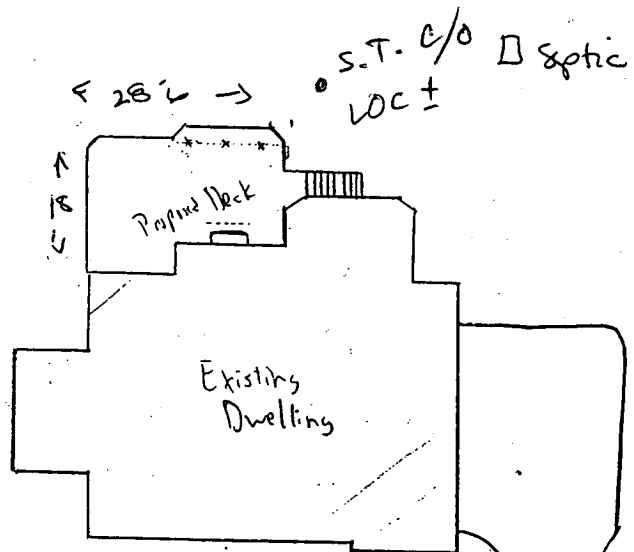

River Valley Chase Dr.

1:30

DEPARTMENT OF INSPECTIONS, LICENSES AND PERMITS 3430 COURT HOUSE DRIVE ELLICOTT CITY, MD 21043 PERMITS (410) 313-2455 INSPECTIONS (410) 313-1810 AUTOMATED INFORMATION (410) 313-3800	HOWARD COUNTY -PERMIT APPLICATION-	PERMIT NUMBER <u>300137189</u>
---	---	--

Building Address: <u>3140 River Valley Chase</u> Suite/Apt. #: _____ SDP/WP/Petition #: _____ Census Tract: <u>6030</u> Subdivision: <u>Fox Valley</u> Section: _____ Area: _____ Lot: <u>31</u> Tax Map: <u>15</u> Parcel: _____ Grid: <u>21</u> Zoning: <u>RL</u> Map Coordinates: <u>9166</u> Lot size: <u>11</u>	Property Owner's Name: <u>Paul & Mary Giagola</u> Address: <u>3140 River Valley Chase</u> City: <u>N. Friendship</u> State: <u>MD</u> Zip Code: <u>21794</u> Home Phone: <u>410 442 3705</u> Work Phone: <u>410 884 1763</u> Applicant's Name & Mailing Address, (if other than stated hereon): _____ Phone: _____ Fax: _____
---	--

Existing Use: <u>SF</u> Proposed Use: <u>Shop</u> Estimated Construction Cost: \$ <u>8000</u> Description of Work: <u>Finish Deck on existing</u> <u>Frontage 26' x 18' / 18' x 18'</u> <u>See PSN# B00134617</u>	Contractor Company: <u>Dunbar</u> Contact Person: _____ Address: _____ City: _____ State: _____ Zip Code: _____ License No.: _____ Phone: _____ Fax: _____
--	---

Occupant or Tenant: _____ Contact Name: _____ Address: _____ City: _____ State: _____ Zip Code: _____ Phone: _____ Fax: _____	Engineer or Architect Company: _____ Contact Person: _____ Address: _____ City: _____ State: _____ Zip Code: _____ Phone: _____ Fax: _____
---	--

BUILDING DESCRIPTION - <u>COMMERCIAL</u>		BUILDING DESCRIPTION - <u>RESIDENTIAL</u>	
Building Characteristics Height: _____ No. of stories: _____ Gross area, sq. ft. per floor: _____ Use group: _____ Construction type: ☐ Reinforced Concrete ☐ Structural Steel ☐ Masonry ☐ Wood Frame ☐ State Certified Modular	Utilities Water Supply: ☐ Public ☐ Private Sewage Disposal: ☐ Public ☐ Private Electric Yes ☐ No ☐ Gas Yes ☐ No ☐ Heating System: Electric ☐ Oil ☐ Natural Gas ☐ Propane Gas ☐ Sprinkler system: N/A ☐ ☐ Full ☐ Partial ☐ Other Suppression # of Heads: _____	Building Characteristics SF Dwelling ☐ SF Townhouse ☐ <u>Depth</u> <u>Width</u> 1st floor: _____ 2nd floor: _____ Basement: _____ Finished Basement ☐ Unfinished Basement ☐ Crawl space ☐ Slab on Grade ☐ No. of Bedrooms: _____ Multi-family dwellings: No. of efficiency units: _____ No. of 1 BR units: _____ No. of 2 BR units: _____ No. of 3 BR units: _____ Other Structure: _____ Dimensions: _____ Footings: _____ Roof: _____ ☐ State Certified Modular ☐ Manufactured Home	Utilities Water Supply: ☐ Public ☐ Private Sewage Disposal: ☐ Public ☐ Private Electric Yes ☐ No ☐ Gas Yes ☐ No ☐ Heating System: Electric ☐ Oil ☐ Natural Gas ☐ Propane Gas ☐ Sprinkler system: N/A ☐ ☐ NFPA #13D ☐ NFPA #13R Other: _____

THE UNDERSIGNED HEREBY CERTIFIES AND AGREES AS FOLLOWS: (1) THAT HE/SHE IS AUTHORIZED TO MAKE THIS APPLICATION; (2) THAT THE INFORMATION IS CORRECT; (3) THAT HE/SHE WILL COMPLY WITH ALL REGULATIONS OF HOWARD COUNTY WHICH ARE APPLICABLE THERETO; (4) THAT HE/SHE WILL PERFORM NO WORK ON THE ABOVE REFERENCED PROPERTY NOT SPECIFICALLY DESCRIBED IN THIS APPLICATION; (5) THAT HE/SHE GRANTS COUNTY OFFICIALS THE RIGHT TO ENTER ON TO THE PROPERTY FOR THE PURPOSE OF INSPECTING THE WORK PERMITTED AND POSTING NOTICES.

<u>MKG</u> Applicant's Signature	<u>Mary Giagola</u> Print Name <u>6/27/02</u> Date
Title/Company: <u>MKG 6/27/02</u> Checks payable to: DIRECTOR OF FINANCE OF HOWARD COUNTY ** PLEASE WRITE NEATLY AND LEGIBLY **	