

9/26/74 Hold for call!!
app 10/24/74
JEW

10/18/74 after 12 noon

PERMIT

SEWAGE DISPOSAL SYSTEM

MARYLAND STATE DEPARTMENT OF HEALTH

HOWARD COUNTY

ELLICOTT CITY

DISTRICT 4

DATE 9/24/74

INDEXED

10/24/74

Partial OK

A 47549-B

Robert Douglas

IS PERMITTED TO INSTALL ALTER X

ADDRESS 9316 Annapolis Road, Lanham, Md.

PHONE

A SEWAGE DISPOSAL SYSTEM LOCATED AT

Map 14, Parcel 217
Lot 3

SUBDIVISION

ROAD 2525 Route 97, Glenwood, LOT

Maryland

PROPERTY OWNER

~~Robert Douglas~~ William Walk

ADDRESS

SPECIFICATIONS - 4 bedrooms

(existing)

DRAIN FIELD DEPTH FEET, BOTTOM AREA SQ. FT.

SEEPAGE PITS ABSORBENT SIDE-WALL AREA SQ. FT.

SEPTIC TANK CAPACITY GALLONS

FOR GARBAGE GRINDER, INCREASE DISPOSAL AREA 22% & TANK CAPACITY 50%.

OTHER REPAIR - Call for inspection when ground is opened up so Sanitarian can recommend repair system.

{ 2 inspections on trench }

→ { needed }

Note they are to call us.

PLANS APPROVED BY Charles B. Streaker


DATE 9/24/74

FILL SEPTIC TANK AND DISTRIBUTION BOX WITH WATER BEFORE CALLING FOR AN INSPECTION. COVER NO WORK UNTIL INSPECTED AND APPROVED.

NEITHER THE HOWARD COUNTY COMMISSIONERS NOR THE HEALTH DEPARTMENT IS RESPONSIBLE FOR THE SUCCESSFUL OPERATION OF ANY SYSTEM.

Index 11/9/74

47549-B
P 20729

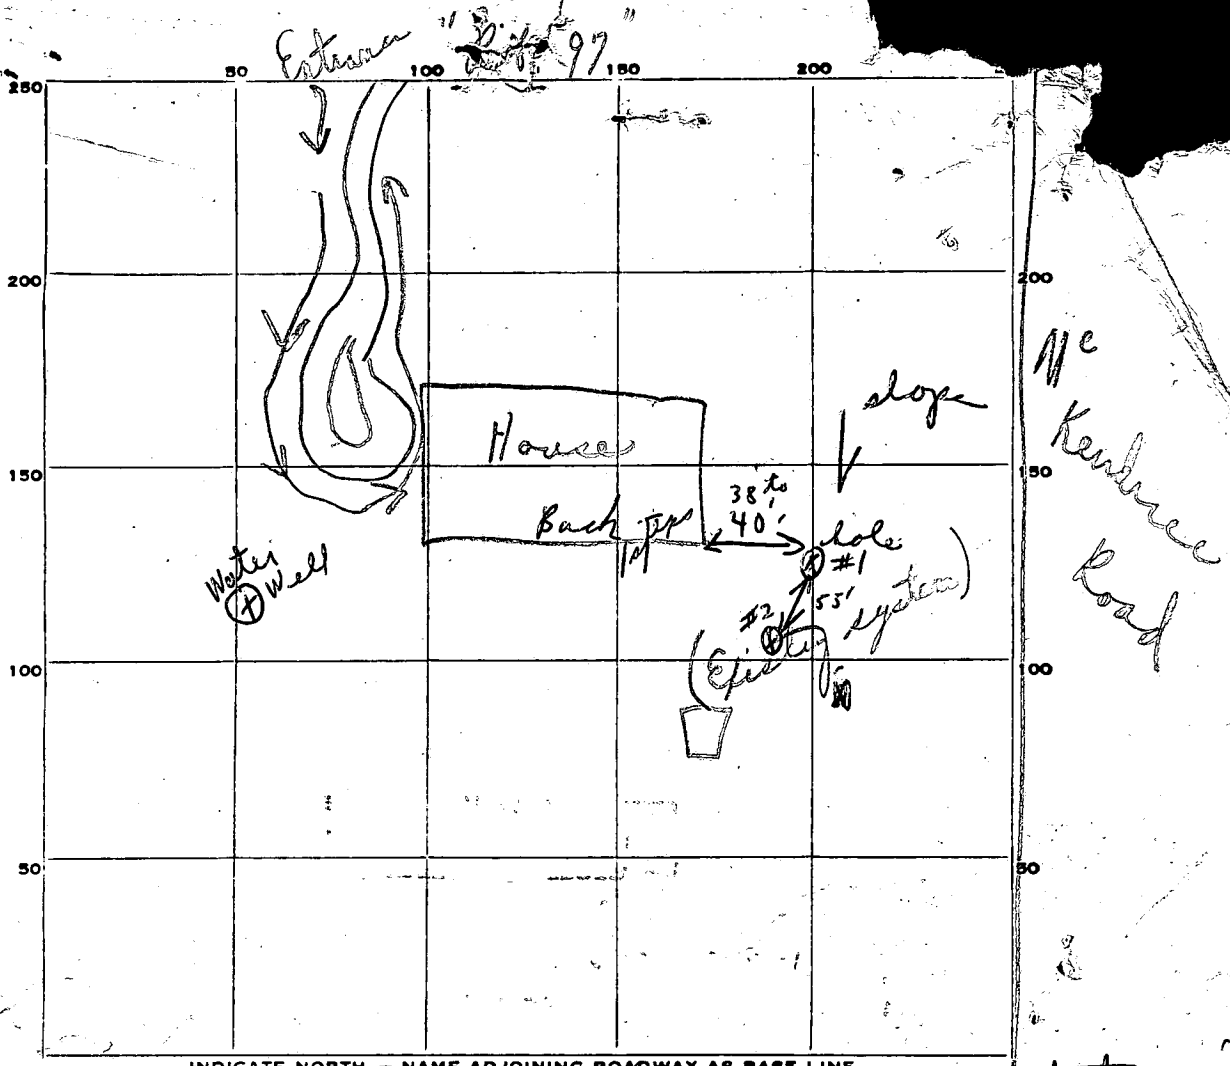

INDICATE NORTH. - NAME ADJOINING ROADWAY AS BASE LINE.

PERMIT CARD

Yes affixed on tree (Noted recommendations)

SEPTIC TANK, LEVEL

OK

CLEANOUTS

S.T. N/A OK / D.W. N/A

DISTRIBUTION BOX, LEVEL

TILE FIELD, DEPTH

11 1/2

FT. TRENCH WIDTH

2

FT.

GRAVEL DEPTH

84

IN

TOTAL LENGTH

61

FT.

NUMBER OF TRENCHES

1

TOTAL BOTTOM AREA

122

SEEPAGE PITS, INSIDE DIAMETER

18

FT.

DEPTH BELOW INLET

18

FT.

side wall

ABSORBENT AREA

427

SQ. FT.

REMARKS

9/26/74


Cut now from house to tank
Need new tank - move closer to house
part in trench 11-12' deep, 6' long; Tank needed 1250 gallons
(Down 12' no water) (But Septic Tank approx
25' from house; start trench 40' from back of house
& go towards tree & #2 hole!!)
#2 hole 6' 13' 11' 13' 14' 13'
avg to 11 1/2

DATE SYSTEM APPROVED

10/24/74

INSPECTOR

OW Murray


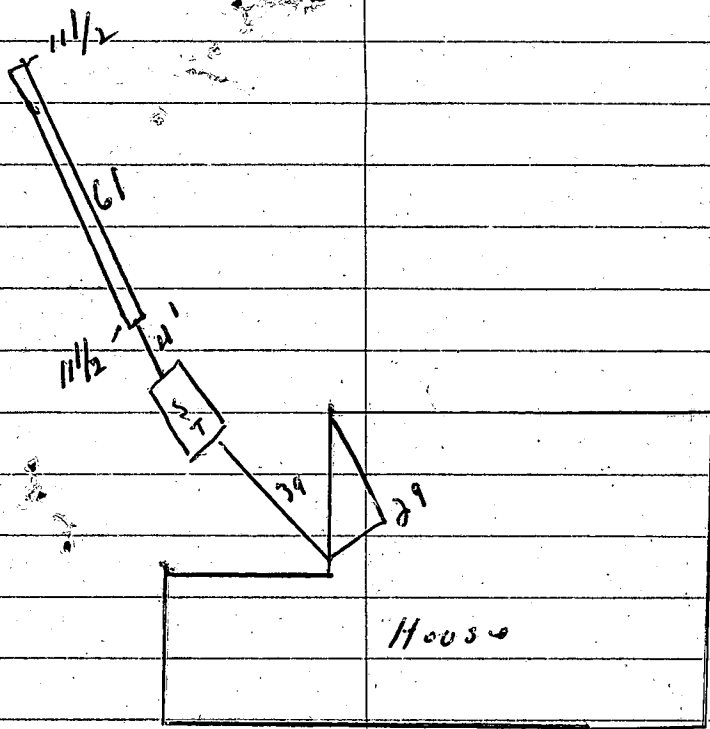


10/27/74 - out put gravel in trench - Tank not in - no lines

undated

10/24/74 system P

RT. 97

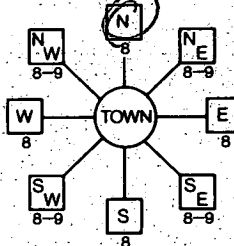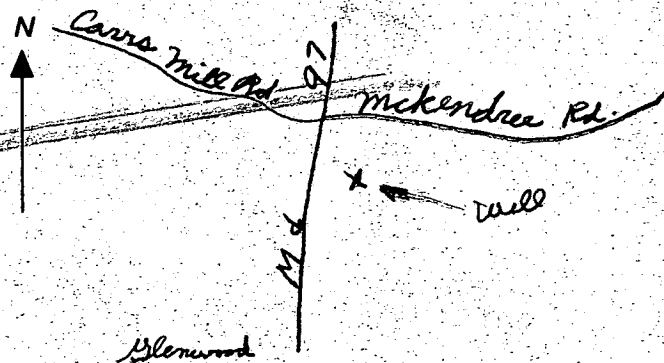B 1 1982 (THIS NUMBER IS TO BE PUNCHED IN COLS. 3-6 ON ALL CARDS)	SEQUENCE NO. (MDE USE ONLY) 111395	STATE OF MARYLAND PERMIT TO DRILL WELL please print or type	STATE PERMIT NUMBER HC-93-0289 fill in this form completely
OWNER INFORMATION Date Received (APA) 1/1/395 WALK 15 Last Name PO BOX 118 36 GLENWOOD 57 Town BILLY 34 First Name MD 21738 70 State 72 Zip 76		LOCATION OF WELL HOWARD 8 COUNTY GREEN MEADOWS 23 SUBDIVISION SECTION 44 46 LOT 3 48 50 GLENWOOD 52 NEAREST TOWN MILES FROM TOWN (enter 0 if in town) 1 73 76 77 78	
DRILLER INFORMATION Joseph L. Mayne 77 License No. 80 Joseph L. Mayne Well Drilling Co. 77 5512 Ridge Rd. Mt. Airy, Md. 21771 Joseph L. Mayne 11/13/95 Signature Date		B 3 2524 Md. 97 DIRECTION OF WELL FROM TOWN (CIRCLE BOX)  NEAR WHAT ROAD ON WHICH SIDE OF ROAD (CIRCLE APPROPRIATE BOX) 140 34 37 DISTANCE FROM ROAD ENTER FT. OR MI FT 38 39 TAX MAP: _____ BLK: _____ PARCEL: _____	
B 2 WELL INFORMATION APPROX. PUMPING RATE (GAL. PER MIN.) 5 8 12 AVERAGE DAILY QUANTITY NEEDED (GAL. PER DAY) 500 14 20		NOT TO BE FILLED IN BY DRILLER HEALTH DEPARTMENT APPROVAL Howard A 18160 COUNTY NAME COUNTY NO. STATE SIGNATURE DATE ISSUED INSERT S 022696 DONALD K. SELL 2/25/97 NORTH GRID 534000 EAST GRID 0794000 50 55 57 63	
USE FOR WATER (CIRCLE APPROPRIATE BOX) ☒ HOME (SINGLE OR DOUBLE HOUSEHOLD UNIT ONLY) ☐ FARMING (LIVESTOCK WATERING & AGRICULTURAL IRRIGATION) ☐ INDUSTRIAL, COMMERCIAL, STATE AND FEDERAL GOV. OTHER (REQUIRES APPROPRIATION PERMIT) ☐ PUBLIC OR PRIVATE WATER COMPANY (REQUIRES APPROPRIATION PERMIT AND STATE HEALTH DEPARTMENT APPROVAL) ☐ TEST, OBSERVATION, MONITORING (MAY REQUIRE APPROPRIATION PERMIT)		SHOW MAJOR FEATURES OF BOX & LOCATE WELL WITH AN X SOURCES OF DRILLING WATER 1. WELL 2. 3. WRITE THE BOX NUMBER FROM THE MAP HERE E 7924 N 5324 000 000	
APPROXIMATE DEPTH OF WELL 240 24 28 FEET APPROXIMATE DIAMETER OF WELL 6 NEAREST INCH		3/18/96 11:00 GROUT LOCATION OK SAMPLE TAKEN @ 11:00 240' DEEP 86 CASING 68 OPEN 28 BAGS GROUT	
METHOD OF DRILLING (circle one) BORED (or Augered) JETTED Jetted & DRIVEN AIR-ROTARY AIR-PERCussion ROTARY (Hydraulic Rotary) CABLE REVERSE-ROTARY DRIVE-POINT other:		DRAW A SKETCH BELOW SHOWING LOCATION OF WELL IN RELATION TO NEARBY TOWNS AND ROADS AND GIVE DISTANCE FROM WELL TO NEAREST ROAD JUNCTION 	
REPLACEMENT OR DEEPENED WELLS (CIRCLE APPROPRIATE BOX) ☒ THIS WELL WILL NOT REPLACE AN EXISTING WELL ☐ THIS WELL WILL REPLACE A WELL THAT WILL BE ABANDONED AND SEALED ☐ THIS WELL WILL REPLACE A WELL THAT WILL BE USED AS A STANDBY-CONTACT LOCAL APPROVING AUTHORITY FOR POLICY ON STANDBY WELLS ☐ THIS WELL WILL DEEPEEN AN EXISTING WELL PERMIT NUMBER OF WELL TO BE REPLACED OR DEEPEENED (IF AVAILABLE) 41 42 43 44 45 46 47 48 49 50		Not to be filled in by driller (MDE OR COUNTY USE ONLY) APPROX. PERMIT NUMBER 54 55 56 57 58 59 60 61 62 63 FORCE DS WRITE INITIALS IN BOX PERMIT No. HC-93-0289 70 71 72 73 74 75 76 77 78 79	
SPECIAL CONDITIONS NOTE - APPROVING AUTHORITIES SHOULD USE SEPARATE SHEET IF NEEDED			

C 1 0261 SEQUENCE NO. (MDE USE ONLY)

STATE OF MARYLAND
WELL COMPLETION REPORTTHIS REPORT MUST BE SUBMITTED WITHIN
45 DAYS AFTER WELL IS COMPLETED.(THIS NUMBER IS TO BE PUNCHED
IN COLS. 3-6 ON ALL CARDS)FILL IN THIS FORM COMPLETELY
PLEASE PRINT OR TYPECOUNTY
NUMBER

A 18160

ST/CO USE ONLY
DATE RECEIVED

DATE WELL COMPLETED

Depth of Well

PERMIT NO.
FROM "PERMIT TO DRILL WELL"

8 13

03 13 96

22 240 26
(TO NEAREST FOOT)H0-93-0289
28 29 30 31 32 33 34 35 36 37

OWNER

STREET OR RFD

SUBDIVISION

WALK

2525 ROUTE 97

Bill

TOWN

Glenwood

SECTION

LOT

3

WELL LOG

Not required for driven wells

STATE THE KIND OF FORMATIONS
PENETRATED, THEIR COLOR, DEPTH,
THICKNESS AND IF WATER BEARINGDESCRIPTION (Use
additional sheets if needed)

FEET

FROM

TO

check
if water
bearing

Sand

0 82

Gray Mica
Rock

82 240

GROUTING RECORD

WELL HAS BEEN GROUTED
(Circle Appropriate Box)

TYPE OF GROUTING MATERIAL (Circle one)

CEMENT ☒ CMBENTONITE CLAY ☐ BC

NO. OF BAGS

28

NO. OF POUNDS

2632

GALLONS OF WATER

168

DEPTH OF GROUT SEAL (to nearest foot)

from

0

ft. to

68

ft.

48 TOP 52 54 BOTTOM 58
(enter 0 if from surface)

CASING RECORD

casing
types
insert
appropriate
code
below☒ ST☐ CO

STEEL

CONCRETE

☐ PL☐ OT

PLASTIC

OTHER

MAIN

CASING

TYPE

Nominal diameter

top (main) casing

(nearest inch)

Total depth

of main casing

(nearest foot)

☒ S

6

86

OTHER CASING (if used)

E

C

H

C

A

S

I

N

diameter

inch

depth (feet)

from

to

screen type
or open hole
insert
appropriate
code
below

SCREEN RECORD

☒ ST☐ BR☐ HO

STEEL

BRASS

OPEN

☐ PL☐ OT

PLASTIC

OTHER

C 2

1

2

E

C

H

C

S

2

C

R

E

3

E

N

DEPTH (nearest ft.)

H

0

8

9

11

15

17

21

23

24

25

30

32

36

38

39

41

45

47

51

SLOT SIZE 1

2

3

DIAMETER

OF SCREEN

56

60

from

to

GRAVEL PACK

IF WELL DRILLED WAS

FLOWING WELL INSERT

F IN BOX 68

68

MDE USE ONLY

(NOT TO BE FILLED IN BY DRILLER)

T

(E.R.O.S.)

W Q

74 75 76

70

72

74 75 76

TELESCOPE

LOG

OTHER DATA

CASING

INDICATOR

PUMPING TEST

HOURS PUMPED (nearest hour)

3

PUMPING RATE (gal. per min.)

008.5

METHOD USED TO

MEASURE PUMPING RATE

Bucket

WATER LEVEL (distance from land surface)

BEFORE PUMPING

10

ft.

WHEN PUMPING

174

ft.

TYPE OF PUMP USED (for test)

☐ A

air

☐ P

piston

☐ T

turbine

☐ C

centrifugal

☐ R

rotary

☐ O

other

☐ J

jet

☒ S

submersible

PUMP INSTALLED

DRILLER WILL INSTALL PUMP
(CIRCLE) (YES or NO)

YES

NO

IF DRILLER INSTALLS PUMP, THIS SECTION
MUST BE COMPLETED FOR ALL WELLS.

TYPE OF PUMP INSTALLED

PLACE (A,C,J,P,R,S,T,O)

IN BOX 29

CAPACITY:

GALLONS PER MINUTE

(to nearest gallon)

PUMP HORSE POWER

PUMP COLUMN LENGTH

(nearest ft.)

CASING HEIGHT

(circle appropriate box
and enter casing height)☒ +

above

LAND SURFACE


☐ -

below

(nearest

foot)

LOCATION OF WELL ON LOT

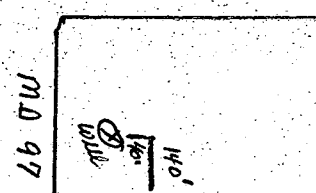SHOW PERMANENT STRUCTURE SUCH AS
BUILDING, SEPTIC TANKS, AND /OR
LANDMARKS AND INDICATE NOT LESS
THAN TWO DISTANCES
(MEASUREMENTS TO WELL)

COUNTY

Gayle P. Little

Y 76-3871

William W. Little

Bill WALK

(410) 489-3619

LOCATION SURVEY



2525 Route 97

LOT 3

Glenwood, Md
21738

GREEN MEADOWS

4TH ELECTION DISTRICT; HOWARD COUNTY, MD.

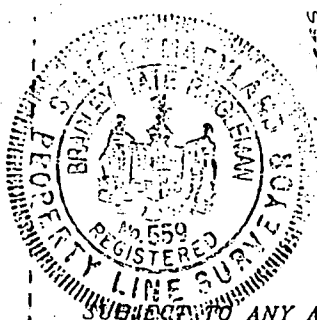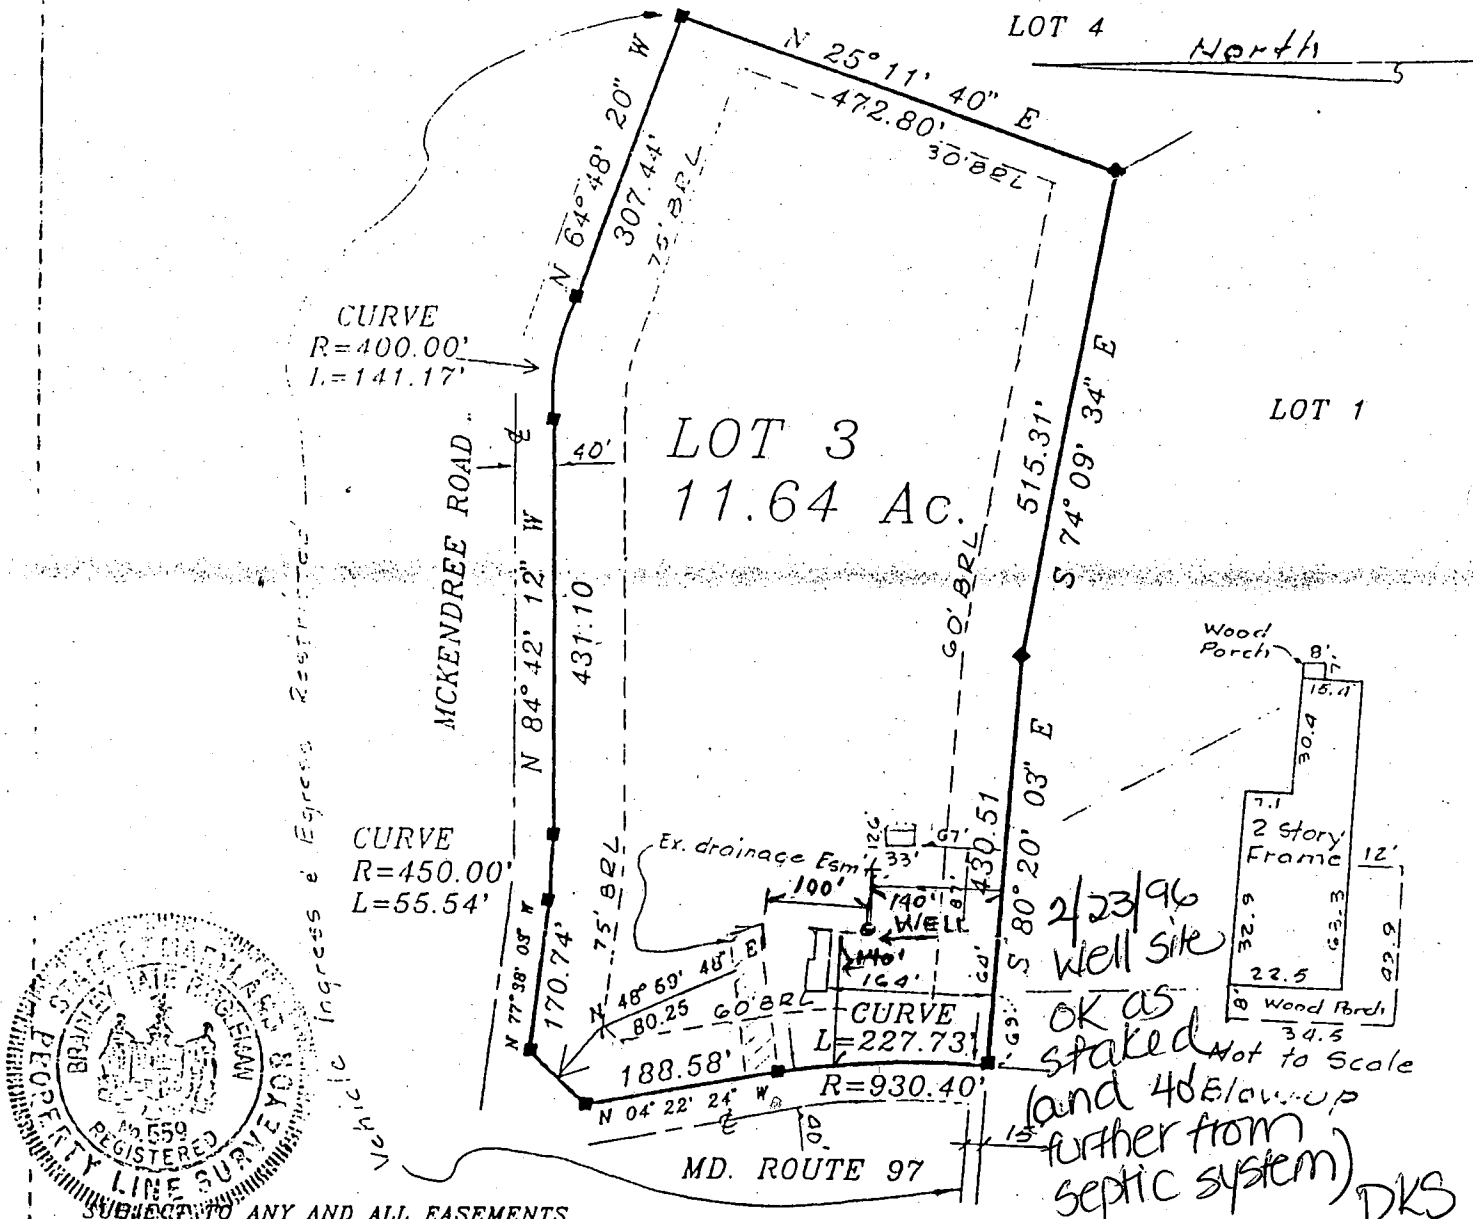

SUBJECT TO ANY AND ALL EASEMENTS OF RECORD OR AS REQUIRED BY LAW

SURVEYOR'S CERTIFICATE

I HEREBY CERTIFY THAT THE POSITION OF EXISTING IMPROVEMENTS SHOWN ON THE ABOVE DESCRIBED PROPERTY HAVE BEEN CAREFULLY ESTABLISHED BY AN ON THE GROUND SURVEY AND THAT UNLESS OTHERWISE SHOWN THERE ARE NO ENCROACHMENTS. LOT CORNERS HAVE NOT BEEN SET BY THIS SURVEY NOR IS IT INTENDED FOR USE IN THE ESTABLISHMENT OF PROPERTY LINES.

Bradley Tate Little 3-15-93

BRL = Building Restriction Line

AES INCORPORATED

6904 TURNBERRY COURT
FREDERICK, MD 21701

REFERENCE	SCALE: 1"=200'	
PLAT BOOK		DRAWN BY <i>Joe Carta</i>
PLAT NO.	FINAL 3-15-93	COMPUTED BY <i>Brad Little</i>
3994	WALL CHECK	CHECKED BY <i>B. L.</i>

2/23/96
Well site
OK as staked
(and 40' down-up
further from
septic system)
DKS