

Line Insp - 1/11/02 1:00

Tax ID - 05-433339

LAYOUT

4/8/02 1:00

INSP 4

4/11/02 Anytime

INSP 2

4/9/02 1pm

INSP 5

INSP 3

4/10/02 12-1

INSP 6

ISSUE DATE:

1/11/2002

APPROVAL DATE:

4/15/02

**PERMIT
INDEXED**

P 516464

A 47965

**ON-SITE SEWAGE DISPOSAL SYSTEM
HOWARD COUNTY HEALTH DEPARTMENT
BUREAU OF ENVIRONMENTAL HEALTH**

(Tolley Enterprises, Inc.) (301) 748-7725

Legends, Inc.

Dave Tolley

IS PERMITTED TO INSTALL ☒ ALTER ☐

ADDRESS: PO Box 511, Burtonsville 20866

PHONE NUMBER: 301-490-3651

SUBDIVISION: Malcolm Property

LOT NUMBER: 6

ADDRESS: 12064 Scaggsville Road

PROPERTY OWNER: Van & Evelyn Malcolm

SEPTIC TANK CAPACITY (GALLONS): 1250

OUTLET BAFFLE FILTER REQUIRED ☐

PUMP CHAMBER CAPACITY (GALLONS): N/A

COMPARTMENTED TANK REQUIRED ☐

NUMBER OF BEDROOMS: 4

SQUARE FEET PER BEDROOM: 210

LINEAR FEET OF TRENCH REQUIRED: 210

TRENCHES:	Trench to be 2.0 feet wide. Inlet 4.5 feet below original grade. Bottom maximum depth 8.5 feet below original grade. Effective area begins at 4.5 feet below original grade. 4.0 feet of stone below distribution pipe.
LOCATION:	Place the distribution box 110' off the right lot line and 120' off the front lot line. Run (3) trenches on contour to left side of lot as shown on plan.
NOTES:	

PLANS APPROVED: MER 1/11/02 OK (BA)

DATE: 12/4/01

NOTE: PERMIT VOID AFTER 2 YEARS

NOTE: CONTRACTOR RESPONSIBLE FOR SCHEDULING A PRE-CONSTRUCTION INSPECTION FOR ALL INSTALLATIONS

NOTE: WATERTIGHT SEPTIC TANKS REQUIRED

NOTE: ALL PARTS OF SEPTIC SYSTEM SHALL BE 100 FEET FROM ANY WATER WELL

NOTE: MANHOLE RISERS REQUIRED ON ALL SEPTIC TANKS AND PUMP CHAMBERS UNLESS SPECIFICALLY AUTHORIZED

**NEITHER THE HOWARD COUNTY COUNCIL NOR THE HEALTH DEPARTMENT IS
RESPONSIBLE FOR THE SUCCESSFUL OPERATION OF ANY SYSTEM**

PERMITTEE RESPONSIBLE FOR OBTAINING FINAL APPROVAL ON THIS PERMIT

BUILDING PERMIT SIGNED


AND RETURNED

6/17/02
800 136 931-46 LP TMK

CALL 410-313-2640 FOR INSPECTION OF SEPTIC SYSTEM

447965

NOT TO SCALE

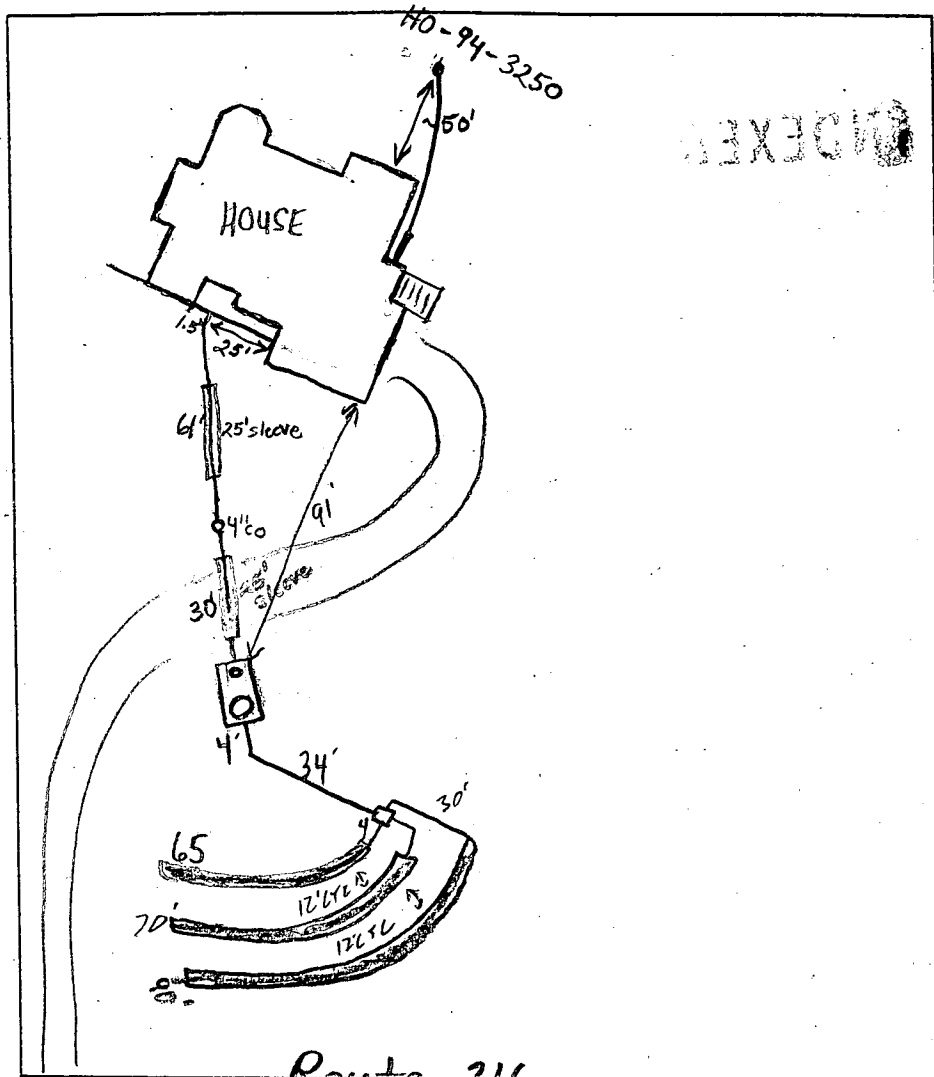

Route 216

TRENCH DATA

TRENCH WIDTH 2
 TRENCH INLET DEPTH 4'9 1/2 1/3
 TRENCH BOTTOM DEPTH 8'9 1/2 1/3
 DEPTH OF STONE 4
 NUMBER OF TRENCHES 3
 TOTAL TRENCH LENGTH 225'
 ABSORBENT AREA 675
 DISTRIBUTION BOX LEVEL ☒
 BAFFLE IN DISTRIBUTION BOX ☒

SEPTIC TANK DATA

SEPTIC TANK 1500 T.S. GALLONS
 MANHOLE RISER Back
 6 INCH INSPECTION PORT Front


PUMP CHAMBER DATA

PUMP CHAMBER
 GALLONS _____
 MANHOLE RISER _____
 ALARM _____
 PUMP PERFORMANCE TEST _____

PRE-CONSTRUCTION INSPECTION: 1/11/02 Easement not staked. (BB)

INSPECTION COMMENTS: 1/11/02 Septic line cleared at driveway location. (BB)
4/8/02 - SDA STAKED, INSTALL PER PLAN (SRK) 4/9/02 Tank set, has 4.5' of cover,
contr. said they are grading 2' of cover over tank. 1st trench started (SO)
4/10/02 CONTRACTOR REPORTS HOUSE NOW HAS GRAVITY BSMT. SVCE =>
TRENCHES 3-9" LOWER THAN SPECS, 1ST TRENCH DONE, 2ND STARTED,
CONTINUE MR 4/11/02 OK to cover all trenches, need manhole on st,
need to confirm trench length (SO) 4/12/02 Contr. to install manhole on st.
 INSPECTOR [Signature] DATE SYSTEM APPROVED 4/15/02
4/15/02 Manhole installed (SO)

← PEPCO RIGHT-OF-WAY →

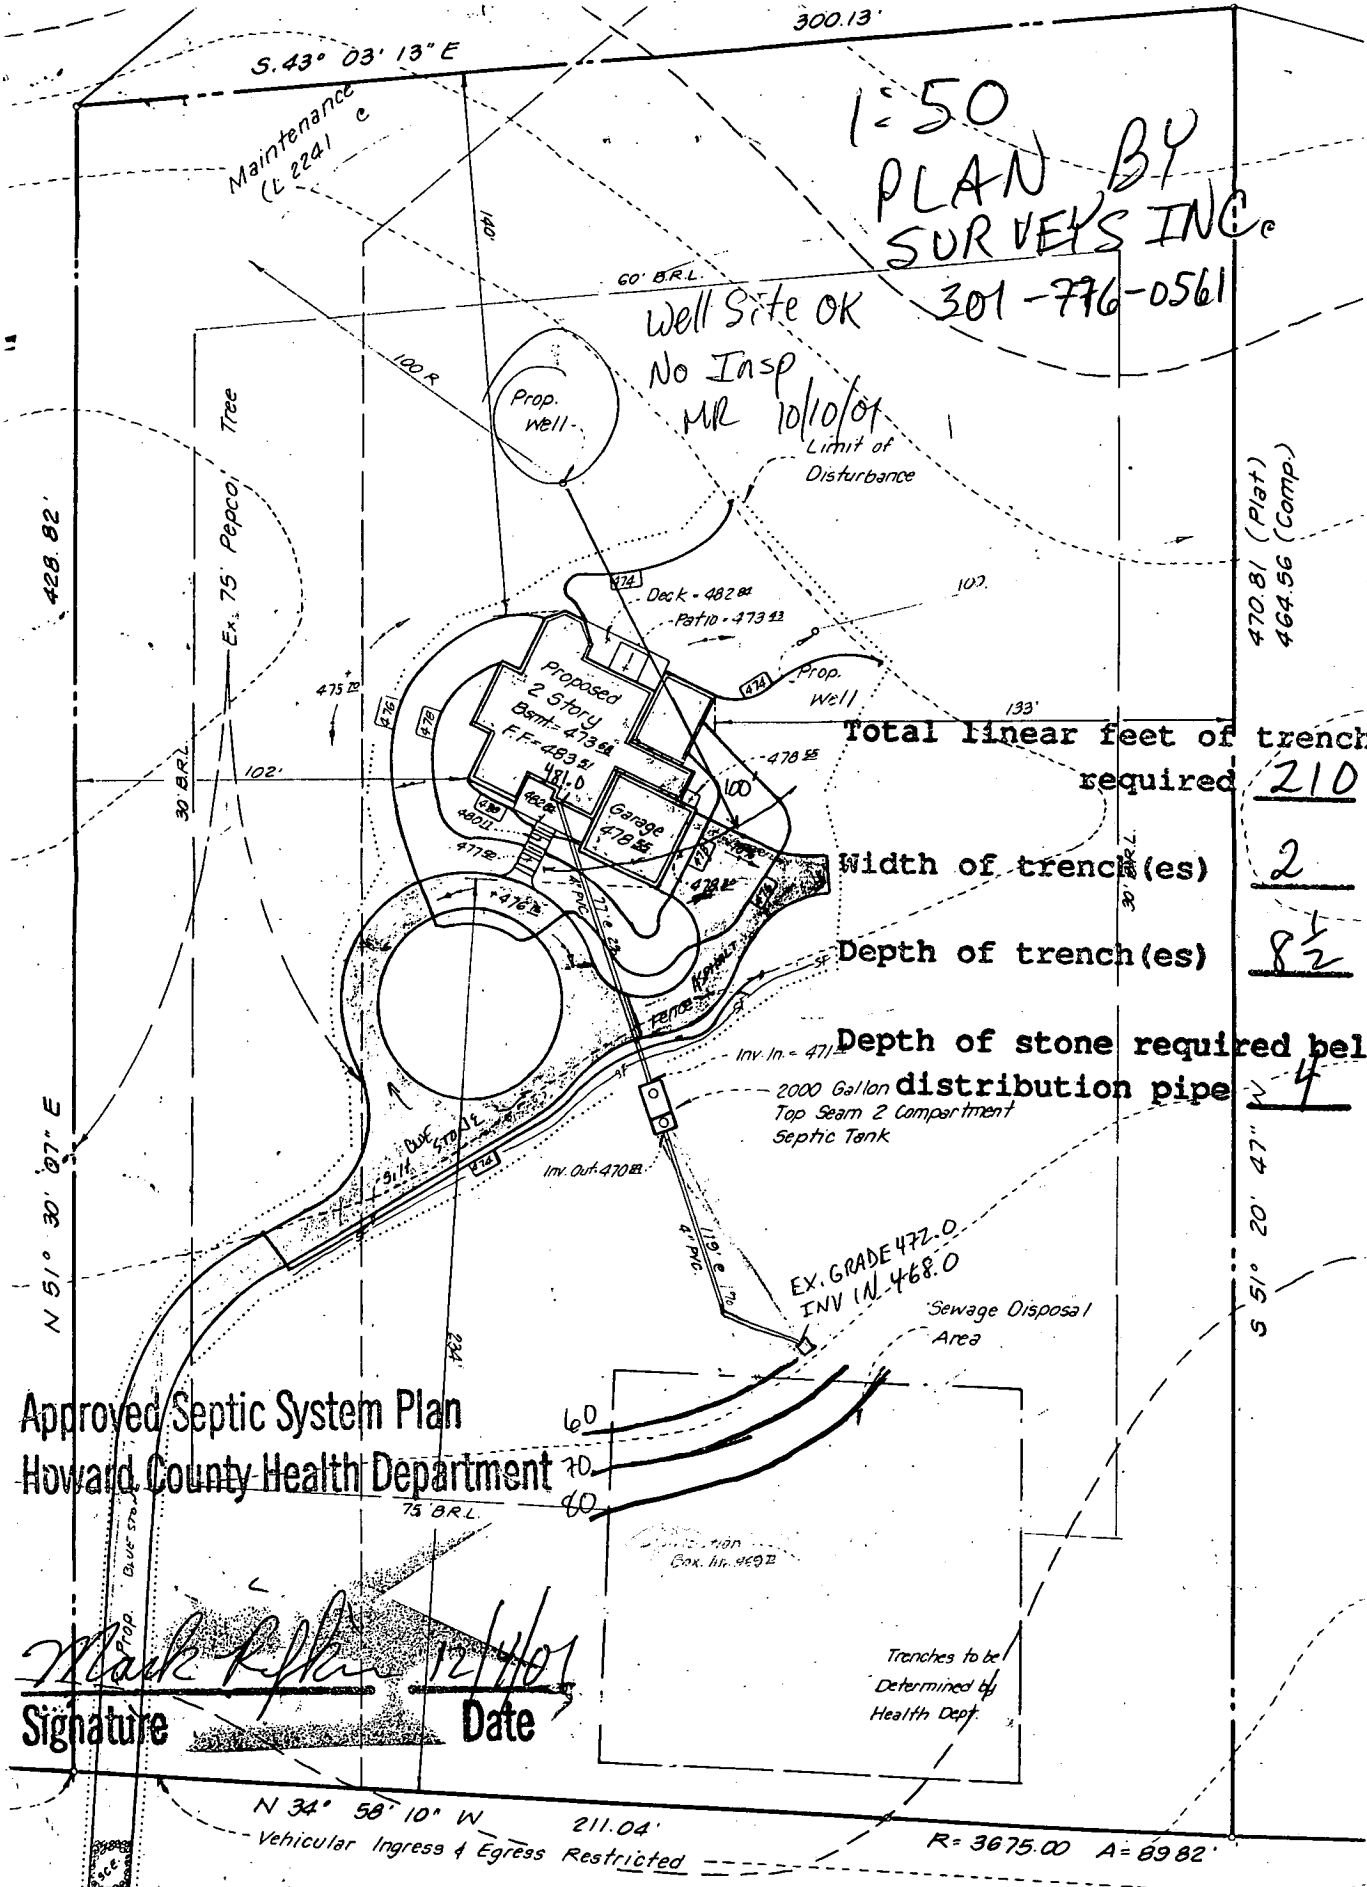


1:50
PLAN BY
SURVEYS INC.
301-776-0561

Well Site OK
No Insp
MR 10/10/01
Limit of Disturbance

Total linear feet of trench required 210 feet
Width of trench(es) 2 feet
Depth of trench(es) 8 1/2 feet
Depth of stone required below distribution pipe 4 feet

Approved Septic System Plan
Howard County Health Department

Mark R. [Signature]
Signature Date 12/4/01

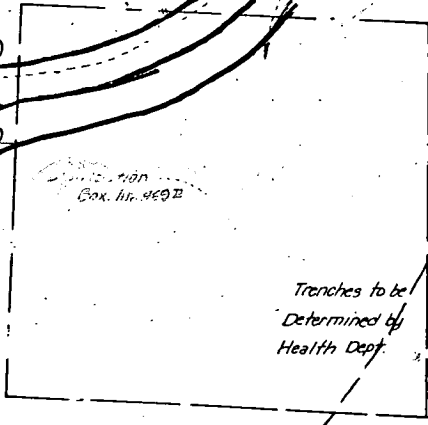

MARYLAND ROUTE #216

DEPARTMENT OF INSPECTIONS, LICENSES AND PERMITS 3430 COURT HOUSE DRIVE ELLICOTT CITY, MD 21043 PERMITS (410) 313-2466 INSPECTIONS (410) 313-1810 AUTOMATED INFORMATION (410) 313-3800	HOWARD COUNTY PERMIT APPLICATION	PERMIT NUMBER X133 000131944
---	---	--

Building Address <u>12064 SARGSVILLE RD.</u> <u>FULTON, MD 20757</u> Suite/Apt. #: <u>N/A</u> SDP/WP/Petition #: <u>F-97-172</u> Census Tract <u>11818</u> Subdivision <u>MALCOLM I ROBE RT</u> Section <u>N/A</u> Area <u>N/A</u> Lot <u>6</u> Tax Map <u>411</u> Parcel <u>67</u> Grid <u>13</u> Zoning <u>SEB</u> Map Coordinates <u>18 F3</u> Lot size <u>3.07 AC</u> Existing Use <u>VACANT LOT</u> Proposed Use <u>SFD</u> Estimated Construction Cost \$ <u>100,000</u> Description of Work <u>CONSTRUCT 25514</u> <u>RESIDENCE w/ DECK -</u> <u>PLANS ATTACHED</u> Occupant or Tenant <u>SAME AS OWNER</u> Contact Name _____ Address _____ City _____ State _____ Zip Code _____ Phone _____ Fax _____	Property Owner's Name <u>VAN + EVELYN MALCOLM</u> Address <u>301 BELKISS CHURCH RD.</u> City <u>SILVER SPRING</u> State <u>MD</u> Zip Code <u>20705</u> Home Phone _____ Work Phone _____ Applicant's Name & Mailing Address, (if other than stated hereon): <u>TOM COLLINS</u> <u>13109 HOLLY CT.</u> <u>BELTSVILLE, MD 20705</u> Phone <u>301/572-5109</u> Fax <u>301/572-5109</u> Contractor Company <u>LEGENDS, INC.</u> Contact Person <u>MIKE COLLINS or Tom Collins</u> Address <u>13109 HOLLY CT.</u> <u>301-572-5109</u> City <u>BELTSVILLE</u> State <u>MD</u> Zip Code <u>20705</u> License No. <u>337006</u> Phone <u>410/707-2777</u> Fax <u>301/470-3651</u> Engineer or Architect Company <u>SURVEYS, INC.</u> Contact Person <u>GENE BENEFIELD</u> Address <u>350 MAIN ST</u> City <u>LAUREL</u> State <u>MD</u> Zip Code <u>20707</u> Phone <u>301/776-0561</u> Fax <u>SAME</u>
--	---

BUILDING DESCRIPTION - <u>COMMERCIAL</u>		BUILDING DESCRIPTION - <u>RESIDENTIAL</u>	
Building Characteristics Height: _____ No. of stories: _____ Gross area, sq. ft. per floor: _____ Use group: _____ Construction type: ☐ Reinforced Concrete ☐ Structural Steel ☐ Masonry ☐ Wood Frame ☒ State Certified Modular	Utilities Water Supply: ☐ Public ☐ Private Sewage Disposal: ☐ Public ☐ Private Electric Yes ☐ No ☐ Gas Yes ☐ No ☐ Heating System: Electric ☐ Oil ☐ Natural Gas ☐ Propane Gas ☐ Sprinkler system: <u>N/A</u> ☐ ☐ Full ☐ Partial ☐ Other Suppression ☐ # of Heads	Building Characteristics SF Dwelling ☒ SF Townhouse ☐ <u>Depth</u> <u>Width</u> 1st floor: _____ 2nd floor: _____ Basement: _____ Finished Basement ☐ Unfinished Basement ☒ Crawl space ☐ Slab on Grade ☐ No. of Bedrooms <u>4</u> Multi-family dwellings: No. of efficiency units: _____ No. of 1 BR units: _____ No. of 2 BR units: _____ No. of 3 BR units: _____ Other Structure: _____ Dimensions: _____ Footings: _____ Roof: _____ ☐ State Certified Modular ☐ Manufactured Home	Utilities Water Supply: ☐ Public ☒ Private Sewage Disposal: ☐ Public ☒ Private Electric Yes ☒ No ☐ Gas Yes ☐ No ☐ Heating System: Electric ☐ Oil ☐ Natural Gas ☐ Propane Gas ☒ Sprinkler system: <u>N/A</u> ☒ ☐ NFPA #13D ☐ NFPA #13R ☐ Other:

THE UNDERSIGNED HEREBY CERTIFIES AND AGREES AS FOLLOWS: (1) THAT HE/SHE IS AUTHORIZED TO MAKE THIS APPLICATION; (2) THAT THE INFORMATION IS CORRECT; (3) THAT HE/SHE WILL COMPLY WITH ALL REGULATIONS OF HOWARD COUNTY WHICH ARE APPLICABLE THERETO; (4) THAT HE/SHE WILL PERFORM NO WORK ON THE ABOVE REFERENCED PROPERTY NOT SPECIFICALLY DESCRIBED IN THIS APPLICATION; (5) THAT HE/SHE GRANTS COUNTY OFFICIALS THE RIGHT TO ENTER ONTO THE PROPERTY FOR THE PURPOSE OF INSPECTING THE WORK PERMITTED AND POSTING NOTICES.

Applicant's Signature <u>Tom Collins</u> Title/Company _____	Print Name <u>TOM COLLINS</u> Date <u>8/10/01</u>
---	--

Checks payable to: **DIRECTOR OF FINANCE OF HOWARD COUNTY**
 ** PLEASE WRITE NEATLY AND LEGIBLY **
 - FOR OFFICE USE ONLY -

AGENCY ☒ Land Development, DPZ ☒ State Highways ☒ Building Official ☒ Dev. Engineering, DPZ ☒ Health ☒ Fire Protection ☒ Is Sediment Control approval required prior to issuance? YES ☒ NO ☐ CONTINGENCY CONSTRUCTION START: ☐ ONE STOP SHOP: ☐	DATE <u>12/4/01</u> SIGNATURE APPROVAL <u>Mark R. Ph</u> DPZ SETBACK INFORMATION Front: _____ Rear: _____ Side: _____ Side St.: _____ All minimum setbacks met? YES ☐ NO ☐ Is Entrance Permit required? YES ☐ NO ☐ Historic District? YES ☐ NO ☐ Lot Coverage for New Town Zone _____ SDP/Red-line approval date _____	PROPERTY ID# <u>51860</u> Filing fee \$ <u>110</u> Permit fee \$ _____ Excise tax \$ _____ Add'l per. fee \$ _____ TOTAL FEES \$ _____ Sub-total paid \$ _____ Balance due \$ _____ Check # <u>41244</u> Validation # <u>44328</u> Accepted by _____
---	--	---

Distribution of Copies: White: Building Official Green: LDD, DPZ Yellow: DED, DPZ Pink: Health Gold: SHA

Attn: Tom

Please Fill Out
completely and
return to usHOWARD COUNTY HEALTH DEPARTMENT
BUREAU OF ENVIRONMENTAL HEALTH
WATER AND SEWERAGE PROGRAM
TEL: (410)313-2640 FAX: (410)313-2648You can fax
it back to us

Information Form for the Installation of the Well Pump, Pitless Adapter, and Supply Piping

NOTE: The installer is responsible for requesting an inspection prior to 9 am on the day of the desired inspection. No work is to be covered until approved by the Health Department. All installations must comply with the National Standard Plumbing Code (NSPC, as amended locally) and COMAR 26.04.04 (MD Well Construction Regulations). Submission of a complete form is required prior to Use and Occupancy approval.

Company Name: W & W Plumbing & Htg. Telephone #: 410-239-8390Address: 1202 Allview Dr.
Hampstead MD 21074

(Must circle one) Licensed Plumber

Licensed Well Driller

Licensed Well Pump Installer

License # and name of individual responsible for the field installation:

Name (Print): Thomas WollenweberLicense# 3314

*A licensed individual must perform the actual installation. Apprentices must be under the direct supervision of a licensed journeyman or master plumber, pump installer or well driller. Licenses may be subjected to field verification.

Name of Property Owner: Van & Evelyn Malcolm Telephone #: _____Subdivision: MalcolmLot #: 6 Well Tag #: HO 94-3a50Site Address: 2064 Scaggsville Rd.
Fulton MD 20759

Submersible Pump Data

Make: GOULDS-5GS10422Model #: 5GS10422Pump Capacity: 5 GPMWell Yield: 60 GPMDepth of well encountered at time of pump installation: 500 feet

If pump capacity exceeds well yield, a low water cut off switch is required by NSPC 1990 Section 17.8.4

Torque arrestors or cable guards are required - Must circle one

Safety rope, if used, attached to inside of well casing with eye bolt yes

Pitless Adapter

Make: MARCINSONModel #: B10KDepth: 48" (36" min)NSF approved: yes

Well Cap and Electric Conduit

Two piece watertight cap: yesScreened vent to well cap: yesCap secured to casing: yesConduit min 18" B.G.: yesConduit secured to well cap: yes

Piping to house

Type: 1" Black Poly-200 lb. testPSI: 200 (160 psi min)Depth of supply line: 48" (36" min)

House Connection

PVC sleeved to undisturbed soil at well penetration: yesApproximate length of sleeve: 10 feetSleeve caulked and sealed properly: yes

The water supply line is required to be at least ten feet from the septic tank, pump chamber, sewage piping, distribution box, drainfields, and sewage reserve area. If this cannot be accomplished, contact this office for approval prior to installation.

Signature of company representative responsible for installation: Thomas Wollenweberdate: 8/28/02

For Health Department Use Only - Not to be completed by Installer

Date Insp. Requested: 6/17/02Date Insp. Approved: 6/17/02

Inspection Data: Pitless adapter and water supply line at least 36" below grade

Two piece cap installed and attached to casing securely

Elec. conduit extends at least 18" below grade attached to cap properly

Safety rope installed inside of well casing

Correct well tag attached properly and casing 8" above finished grade

Water supply line sleeved adequately at house connection

Adequate grout observed below pitless adapter


Lot 3
A47965

①-④

SOIL PROFILE

3-5
yell org
sa cl
loam
tan yell
sa lm
hi micro
w/pink
tint in
① & ③
15%
frags

13

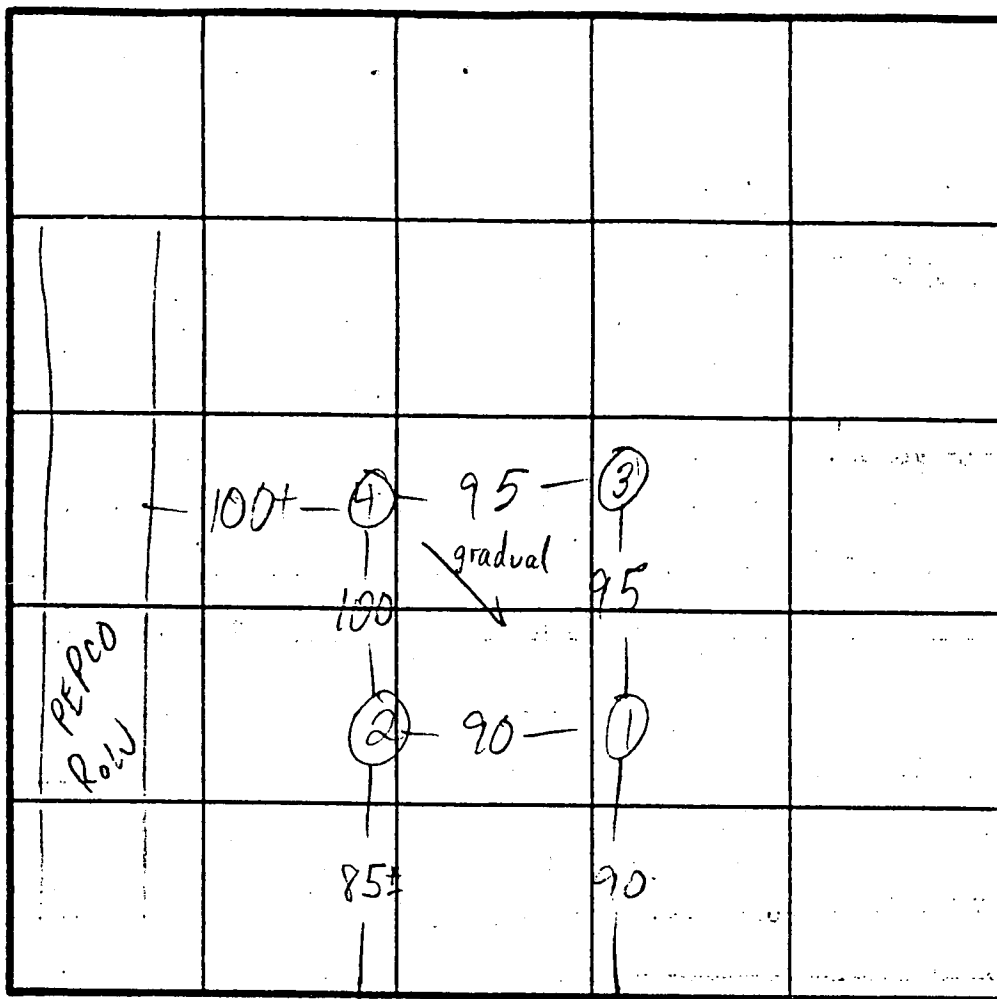

$\bar{x} = 10$
210' BR
Inlet 4 1/2
Bottom 8 1/2

RT. 216

INDICATE NORTH - NAME ADJOINING ROADWAY AS BASE LINE.

DATE	TEST NO.	DEPTH	PRE-WET		TEST - 1" DROP		TIME
			START	STOP	START	STOP	
4/23/92	1 S	4	12:38	12:39	12:39	12:41	2
	1 V	13	see profile				
	2 S	5	12:39:30	12:42	12:42	12:52	10
	2 V	13	see profile				
	3 S	4	12:41	12:57	12:57	1:00	9
	3 S	6	12:19	2:23	2:23	2:32	9
	3 M	8	4:23	4:24	4:24	4:25	1
	3 V	13	see profile				
	4 S	4 1/2	12:44:30	12:58	12:58	1:25	27 ± EST
	4 V	13	see profile				

210'
4 BR

REMARKS

HOLES OK & PER PLAN

TYPE OF SOIL

TESTED BY M. Rifkin


ALSO PRESENT

owner, hoe man

Post-Net brand fax transmittal memo 7671 # of pages 1

To BRIAN	From
Co.	Co.
Dept.	Phone #
Fax #	Fax #

1/14/02
 House moved toward Rt. 216 and
 toward right
 lot line.
 No effect on well or septic.

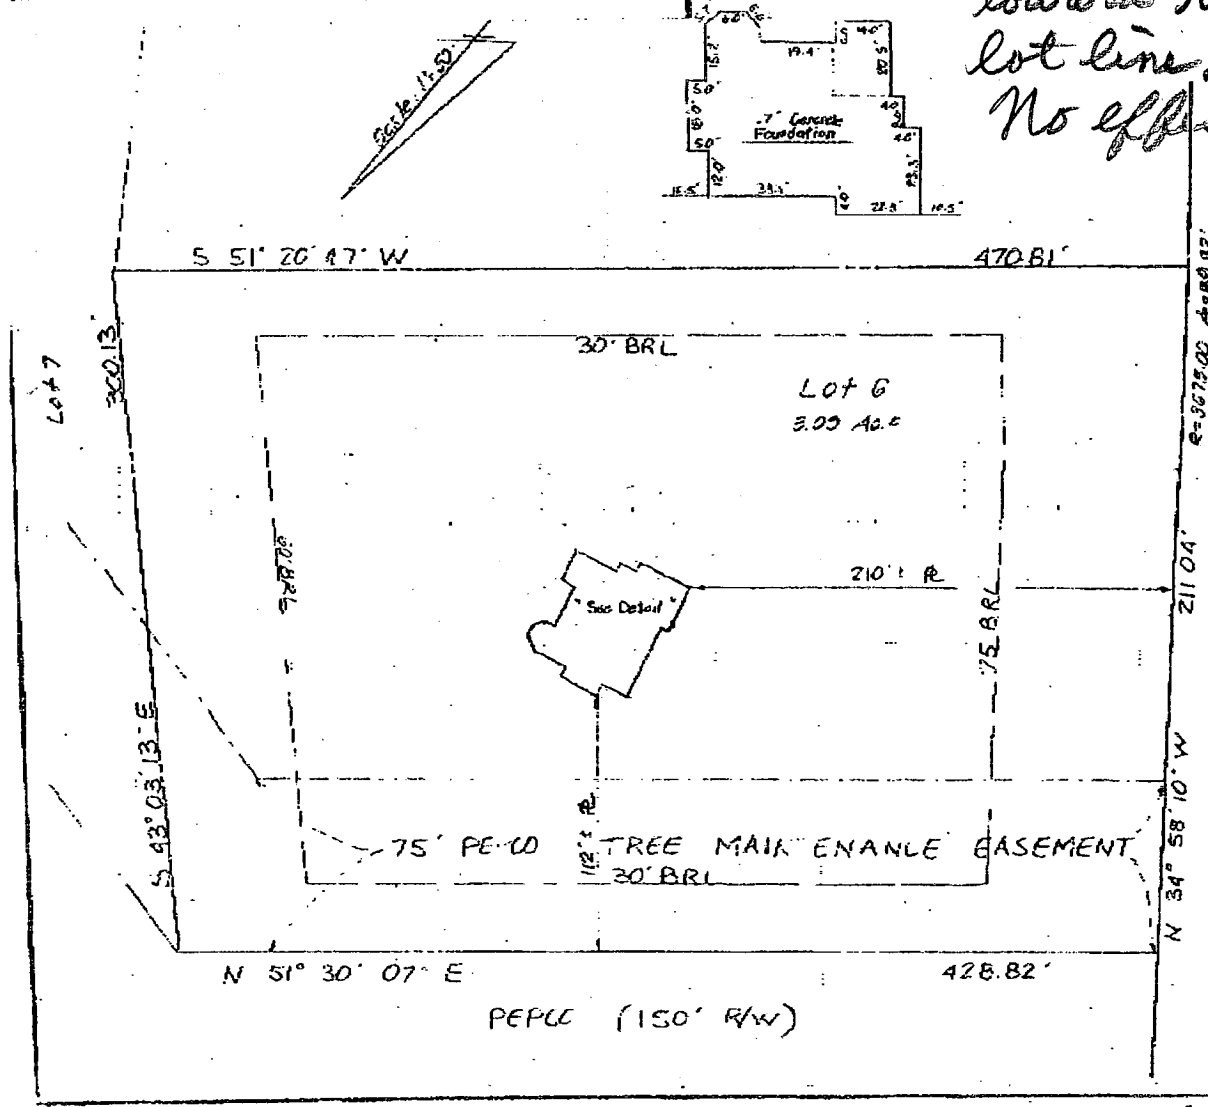

- House Stakeout - Hub & Tack set as indicated. Cut & Fills are to finished bsmt & 6' elevation. B-16-2001
- Re-stake House - 5-18-01 cut/fills all to finished bsmt elevation.
- Walk Check - 1-4-01

Job No 01-90

SURVEYS INC.
 350 MAIN STREET
 LAUREL, MARYLAND 20707
 301 776-3568
 SURVEYING • ENGINEERING • LAND PLANNING
 PERMIT SERVICES

SURVEYOR'S CERTIFICATE
 I hereby certify that the position of all the existing improvements shown on the above described property has been carefully surveyed and shown or directly under my supervision and that they are located as shown. THIS IS NOT A BOUNDARY SURVEY.
 DATE: 1-18-01
 Signature: [Signature]
 Gregory E. Bortel
 Registered Professional
 Land Surveyor, No. 810994

HOUSE LOCATION PLAN
 Scaggsville Road
 Lot 6, Block, Sec./Plan
"MALCOLM PROPERTY"
 Clarksville (SR) Election District
 Howard County, Maryland
 Plat Book, Page 14672
 Lib. No. 14672-1 MS-253

12064 SCAGGSVILLE RD.

S 51° 20' 17" W

470.81'

Lot 7

300.13'

S 43° 03' 13" E

30' BRL

30' BRL

Lot 6
3.09 Ac.

210' R

See Detail

75' BRL

75' PE-10

112' R

TREE MAINTENANCE EASEMENT
30' BRL

N 51° 30' 07" E

428.82'

PEPCC (150' R/W)

N 34° 58' 10" W

211.04'

R=5075.00 A=89.82'

MARYLAND ROUTE 216 - SCAGGSVILLE R

(Variable R/W)



Job

S

Lot


"

Plant

Lib.

~ 1" = 60'

12064 SCAGGSVILLE

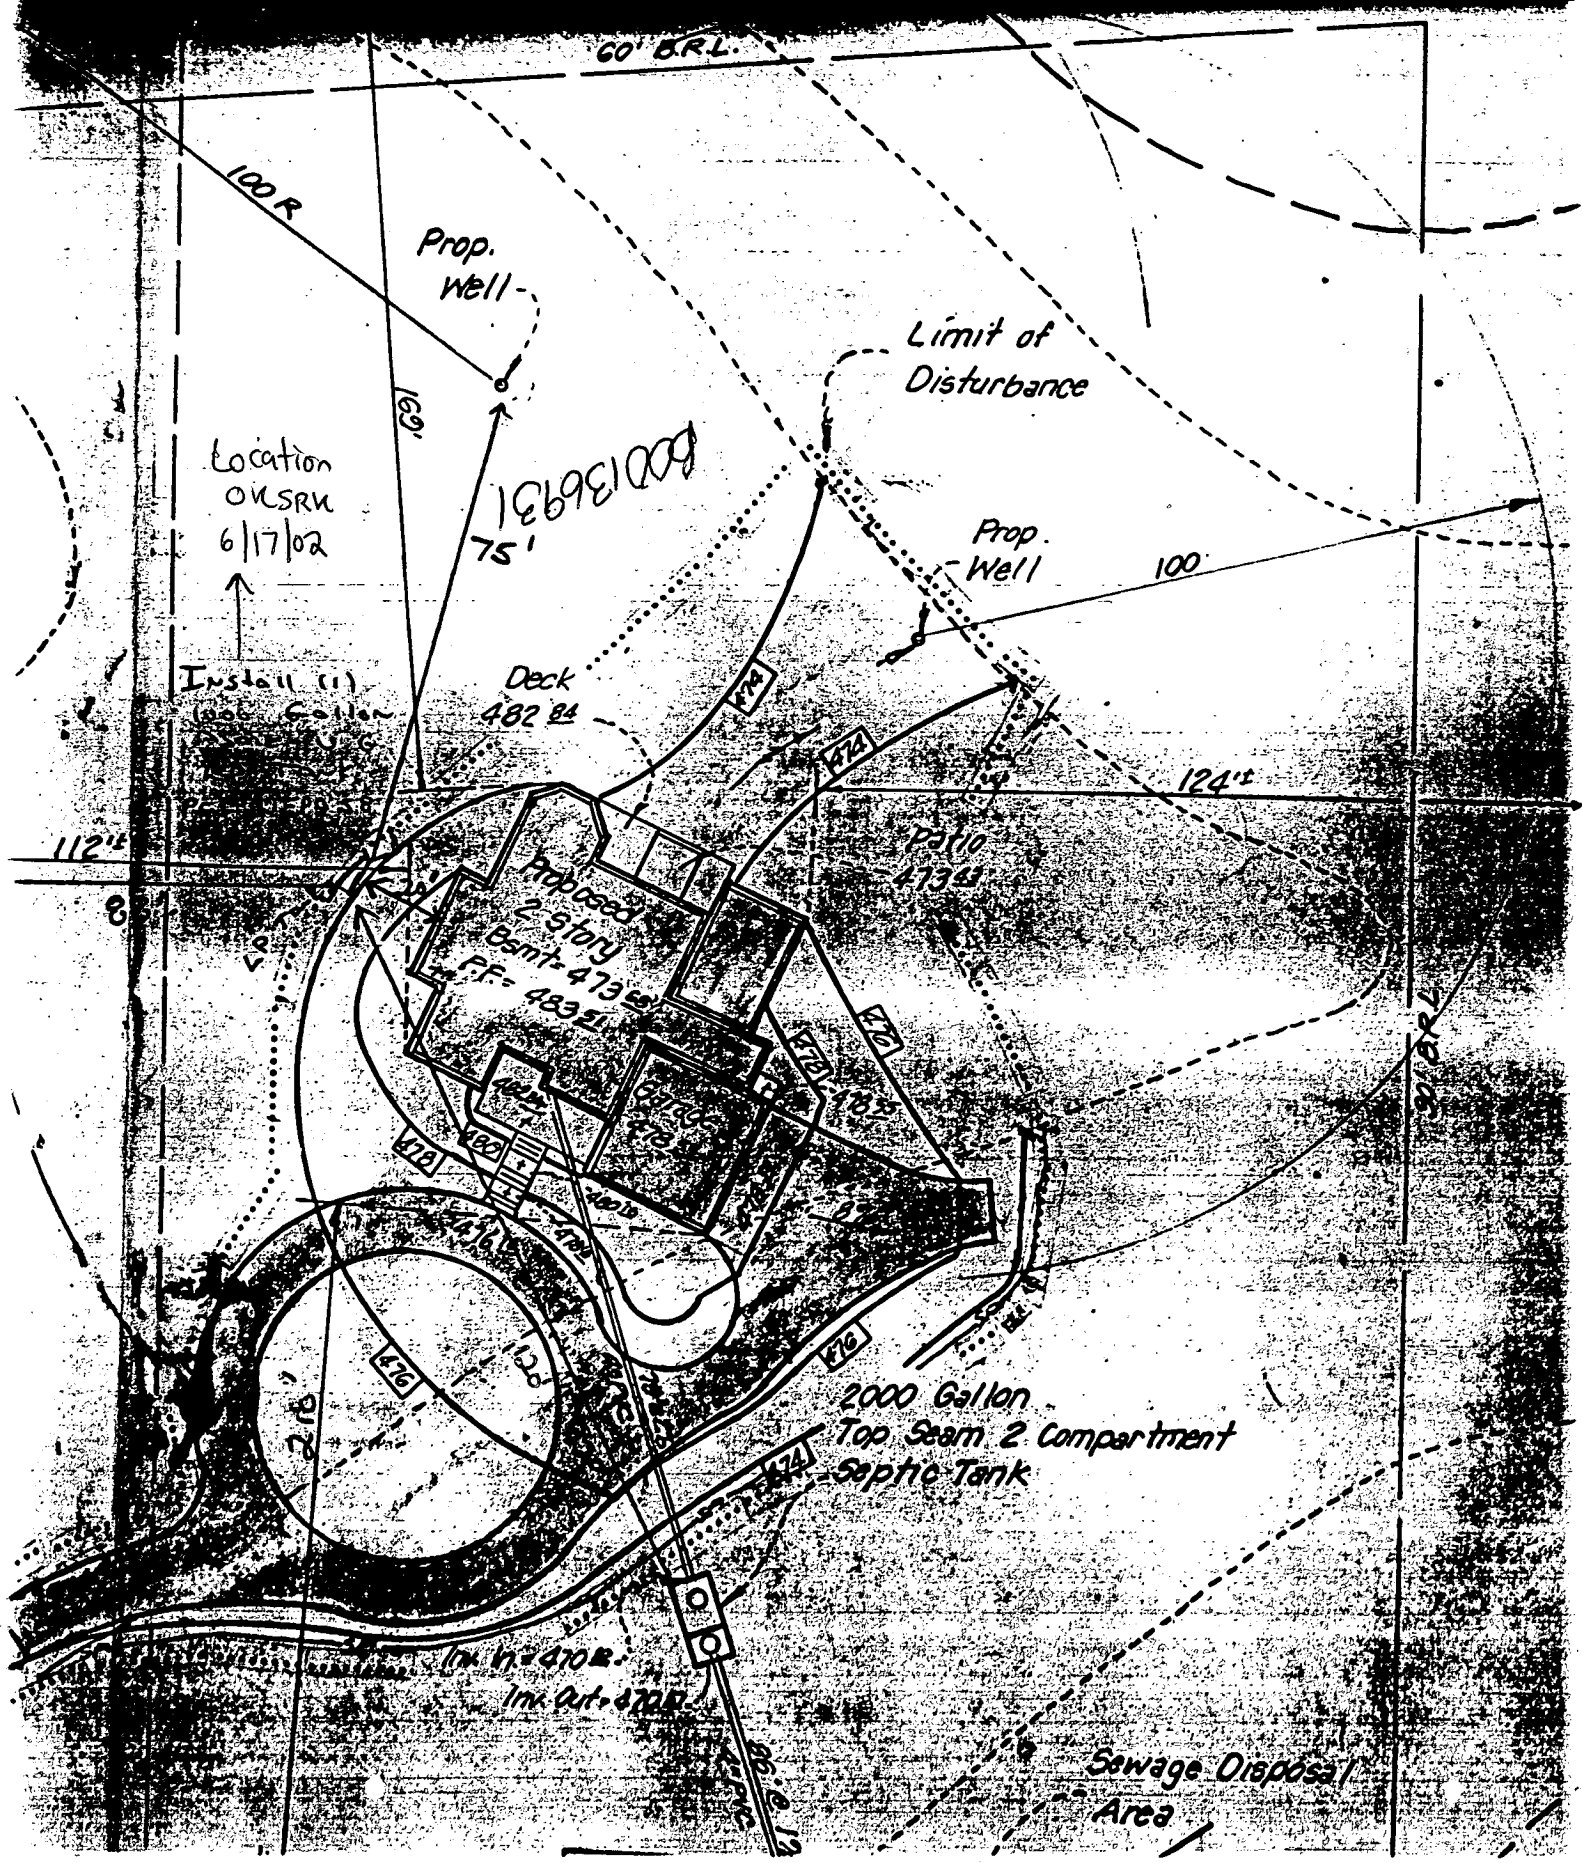

Depth of well 500' 2 1/2 gpm
Distance of measuring point (M.P.) above ground 2 FT
Static water level (S.W.L.) below M.P. 29 FT



HD-224

Review

Depth of well _____
Distance of measuring point (M.P.) above ground _____
Static water level (S.W.L.) below M.P. _____

Time pump started _____ Pumping rate _____
Total time _____ to reach pumping water level _____ ft. below M.P.

HD-224

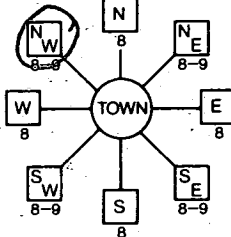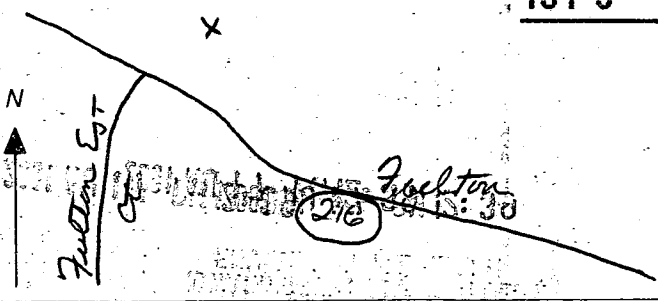B 1 5038 1 2 3 6	SEQUENCE NO. (MDE USE ONLY)	STATE OF MARYLAND PERMIT TO DRILL WELL 515991 please print or type	STATE PERMIT NUMBER HO-94-3250 70 fill in this form completely 79
Date Received (APA) 08/17/01 8 MM DD YY 13 Legends Builders, Inc. 15 Last Name Owner First Name 34 P. O. Box 511 36 Street or RFD 55 Burtonsville, Md 20866 57 Town 70 State 72 Zip 76		B 3 LOCATION OF WELL Howard CC# 8 COUNTY 21 Malcolm Property 23 SUBDIVISION 42 SECTION 44 46 LOT 48 50 6 Fulton 52 NEAREST TOWN 71 MILES FROM TOWN (enter 0 if in town) 1 M I 73 76 77 78	
DRILLER INFORMATION George F. Easterday M W D 040 Driller's Name 76 License No. 81 L. Franklin Easterday, Inc. Firm Name 9265 Brown Church Rd., MT. Airy, Md. 21771 Address <i>George F. Easterday</i> 8/16/2001 Signature Date		B 4 DIRECTION OF WELL FROM TOWN (CIRCLE BOX) 	
B 2 WELL INFORMATION APPROX. PUMPING RATE 5 1 2 (GAL. PER MIN.) 8 12 AVERAGE DAILY QUANTITY NEEDED 500 (GAL. PER DAY) 14 20		Scaggsville Rd 11 NEAR WHAT ROAD 30 ON WHICH SIDE OF ROAD (CIRCLE APPROPRIATE BOX) 34 350 37 DISTANCE FROM ROAD FL ENTER FT OR MI 38 39 TAX MAP: 41 BLK: 13 PARCEL 67	
USE FOR WATER (CIRCLE APPROPRIATE BOX) ☒ DOMESTIC POTABLE SUPPLY & RESIDENTIAL IRRIGATION ☐ FARMING (LIVESTOCK WATERING & AGRICULTURAL IRRIGATION) 22 ☐ INDUSTRIAL, COMMERCIAL, DEWATERING ☐ PUBLIC WATER SUPPLY WELL ☐ TEST, OBSERVATION, MONITORING ☐ GEO-THERMAL		NOT TO BE FILLED IN BY DRILLER HEALTH DEPARTMENT APPROVAL <i>Howard</i> A47965 COUNTY NAME COUNTY NO. STATE SIGNATURE DATE ISSUED 10/05/01 <i>Mark E. Tulkin</i> 10/05/02 43 MM DD YY 48 CO SIGNATURE EXP. DATE NORTH GRID 483 000 EAST GRID 0819 000 50 55 57 63	
APPROXIMATE DEPTH OF WELL 300 FEET 24 28 APPROXIMATE DIAMETER OF WELL 6 NEAREST INCH		SHOW MAJOR FEATURES OF BOX & LOCATE WELL WITH AN X SOURCES OF DRILLING WATER 1. 2. wells 3. WRITE THE BOX NUMBER FROM THE MAP HERE E 4803 N 8109 000 000	
METHOD OF DRILLING (circle one) BORED (or Augered) JETTED Jetted & DRIVEN 30 AIR-ROTARY AIR-PERCussion ROTARY (Hydraulic Rotary) 37 CABLE REVERSE-ROTARY Drive-POINT other		DRAW A SKETCH BELOW SHOWING LOCATION OF WELL IN RELATION TO NEARBY TOWNS AND ROADS AND GIVE DISTANCE FROM WELL TO NEAREST ROAD JUNCTION: 	
REPLACEMENT OR DEEPEENED WELLS (CIRCLE APPROPRIATE BOX) ☒ THIS WELL WILL NOT REPLACE AN EXISTING WELL ☐ THIS WELL WILL REPLACE A WELL THAT WILL BE ABANDONED AND SEALED 39 ☐ THIS WELL WILL REPLACE A WELL THAT WILL BE USED AS A STANDBY-CONTACT LOCAL APPROVING AUTHORITY FOR POLICY ON STANDBY WELLS ☐ THIS WELL WILL DEEPEEN AN EXISTING WELL PERMIT NUMBER OF WELL TO BE REPLACED OR DEEPEENED (IF AVAILABLE) 41 _____ 52		18 F 3	
Not to be filled in by driller (MDE OR COUNTY USE ONLY) APPROP. PERMIT NUMBER _____ G _____ PERMIT No. HO-94-3250 70 71 72 73 74 75 76 77 78 79			
SPECIAL CONDITIONS NOTE - APPROVING AUTHORITIES SHOULD USE SEPARATE SHEET IF NEEDED			

C1 0516		SEQUENCE NO. (MODE USE ONLY)		STATE OF MARYLAND WELL COMPLETION REPORT FILL IN THIS FORM COMPLETELY PLEASE TYPE				THIS REPORT MUST BE SUBMITTED WITHIN 45 DAYS AFTER WELL IS COMPLETED.			
1 2 3 6 (THIS NUMBER IS TO BE PUNCHED IN COLS. 3-6 ON ALL CARDS)		DATE WELL COMPLETED MM DD YY 11/17/01		Depth of Well 22 500 26 (TO NEAREST FOOT)		COUNTY NUMBER A 47965 1128 01 26		PERMIT NO. FROM "PERMIT TO DRILL WELL" HO-44-3250			
ST/CO USE ONLY DATE Received MM DD YY 8 13		OWNER Legends Builders		STREET OR RFD Scaggsville Rd		TOWN Fulton		SUBDIVISION MALCOLM PROPS			
WELL LOG Not required for driven wells		GROUTING RECORD WELL HAS BEEN GROUTED (Circle Appropriate Box) yes ☒ no ☐ TYPE OF GROUTING MATERIAL (Circle one) CEMENT ☒ BENTONITE CLAY ☐ NO. OF BAGS 21 NO. OF POUNDS 2100 GALLONS OF WATER 126 DEPTH OF GROUT SEAL (to nearest foot) from 0 ft. to 75 ft. (enter 0 if from surface)		C3 PUMPING TEST HOURS PUMPED (nearest hour) 3 PUMPING RATE (gal. per min.) 4 METHOD USED TO MEASURE PUMPING RATE Bucket WATER LEVEL (distance from land surface) BEFORE PUMPING 29 ft. WHEN PUMPING 222 ft. TYPE OF PUMP USED (for test) A air P piston T turbine C centrifugal R rotary O other (describe below) J jet S submersible							
STATE THE KIND OF FORMATIONS PENETRATED, THEIR COLOR, DEPTH, THICKNESS AND IF WATER BEARING		DESCRIPTION (Use additional sheets if needed)		FEET FROM TO Top soil 0 2 Red clay 2 17 Brown mica 17 68 Brown slate 68 74 Gray slate 74 87 Blue slate 87 110 Blue/gray slate 110 392 Quartz gravel 392 396 Blue/gray slate 396 500		CASING RECORD casing types insert appropriate code below MAIN CASING TYPE ST Nominal diameter top (main) casing (nearest inch) 6 Total depth of main casing (nearest foot) 80 OTHER CASING (if used) diameter inch depth (feet) from to		PUMP INSTALLED DRILLER INSTALLED PUMP YES NO IF DRILLER INSTALLS PUMP, THIS SECTION MUST BE COMPLETED FOR ALL WELLS. TYPE OF PUMP INSTALLED PLACE (A,C,J,P,R,S,T,O) IN BOX 29 CAPACITY: GALLONS PER MINUTE (to nearest gallon) 31 35 PUMP HORSE POWER 37 41 PUMP COLUMN LENGTH (nearest ft.) 43 47 CASING HEIGHT (circle appropriate box and enter casing height) + above LAND SURFACE - below 2 (nearest foot)			
NUMBER OF UNSUCCESSFUL WELLS: 0		WELL HYDROFRACTURED yes ☒ no ☐		C2 DEPTH (nearest ft.) 1 2 3 100 H0 78 500		LOCATION OF WELL ON LOT SHOW PERMANENT STRUCTURE SUCH AS BUILDING, SEPTIC TANKS, AND /OR LANDMARKS AND INDICATE NOT LESS THAN TWO DISTANCES (MEASUREMENTS TO WELL)					
CIRCLE APPROPRIATE LETTER A A WELL WAS ABANDONED AND SEALED WHEN THIS WELL WAS COMPLETED E ELECTRIC LOG OBTAINED P TEST WELL CONVERTED TO PRODUCTION WELL		I HEREBY CERTIFY THAT THIS WELL HAS BEEN CONSTRUCTED IN ACCORDANCE WITH COMAR 26.04.04 "WELL CONSTRUCTION" AND IN CONFORMANCE WITH ALL CONDITIONS STATED IN THE ABOVE CAPTIONED PERMIT, AND THAT THE INFORMATION PRESENTED HEREIN IS ACCURATE AND COMPLETE TO THE BEST OF MY KNOWLEDGE.		DRILLERS LIC. NO. MJD 040 George F. Eschenburg DRILLERS SIGNATURE (MUST MATCH SIGNATURE ON APPLICATION) LIC. NO. MJD 727 SITE SUPERVISOR (sign. of driller or journeyman responsible for sitework if different from permittee)		GRAVEL PACK IF WELL DRILLED WAS FLOWING WELL INSERT F IN BOX 68 MDE USE ONLY (NOT TO BE FILLED IN BY DRILLER) T (E.R.O.S.) W Q TELESCOPE CASING 70 6pm 72 500' 74 75 76 OTHER DATA					