

PERMIT

SEWAGE DISPOSAL SYSTEM

DEPARTMENT OF HEALTH AND MENTAL HYGIENE

HOWARD COUNTY HEALTH DEPARTMENT
BUREAU OF ENVIRONMENTAL HEALTH

461-9933

#382106
INDEXED

P 47118

A REPAIR

DISTRICT _____

DATE 5/20/91

DATE SYSTEM APPROVED _____

INSPECTOR _____

Jack Fyock Septic Service

IS PERMITTED TO INSTALL _____ ALTER X

ADDRESS 13775 Triadelphia Road, Glenelg, Maryland 21737 PHONE 988-9270

SUBDIVISION Wesley Hills LOT 20 ROAD 11440 Rowley Road

PROPERTY OWNER McQueeney

ADDRESS _____

SEPTIC TANK CAPACITY N/A GALLONS OLD TANK USED

NUMBER OF BEDROOMS 4

125 SQUARE FEET PER BEDROOM 500 SQ FT FOR 4 BEDROOMS

LINEAR FEET OF TRENCH REQUIRED 163

REPAIR - DRYWELL IS FULL. CALL FOR INSPECTION WHEN GROUND OPENED SO SANITARIAN CAN

4/26/91 RECOMMEND REPAIR.

SOIL OK RUN TRENCH OFF OLD DRY WELL TOWARD FRONT LINE

12 FT DEEP INLET 3 FT BELOW GRADE

2 FT WIDE 8 FT OF STONE R14

PLANS APPROVED BY Craig Williams cm DATE 04/15/91

COVER NO WORK UNTIL INSPECTED AND APPROVED

NEITHER THE HOWARD COUNTY COUNCIL NOR THE HEALTH DEPARTMENT IS RESPONSIBLE FOR THE SUCCESSFUL OPERATION OF ANY SYSTEM

NOTE: CLEANOUT REQUIRED EVERY 70 FEET OF SEWER LINE AND/OR AT 90° SWEEPS IN LINES FROM HOUSE TO DRAIN FIELDS. 90° ELBOWS NOT ACCEPTABLE.

NOTE: ALL PARTS OF SEPTIC SYSTEMS (I.E. TANK, DISTRIBUTION BOX TRENCHES) TO BE 100 FEET FROM WELL (UNLESS OTHERWISE SPECIFICALLY AUTHORIZED)

NOTE: IF DEEP TRENCH(ES) ARE USED CALL FOR INSPECTION BEFORE AND AFTER PLACING GRAVEL IN TRENCH(ES)

NOTE: NO DRY WELL SHALL EXCEED 15 FOOT IN DIAMETER NO ABSORPTION TRENCH TO EXCEED 100 FEET IN LENGTH

NOTE: ALL PIPE FROM HOUSE TO SEPTIC TANK MUST BE CAST IRON OR SCHEDULE 35/40 PVC OR ABS

PERMIT VOID AFTER TWO YEARS


NOTE: INSTALL STAND PIPE ON SEPTIC TANK AND DRY WELL STAND PIPES MUST BE 6 INCHES IN DIAMETER CAST IRON. CONCRETE OR TERRA COTTA OR PVA OR ABS ACCEPTED. IF TOP OF SEPTIC TANK IS DEEPER THAN 3 FEET. MANHOLE TO GRADE REQUIRED.

NOTE: DISTRIBUTION BOXES MUST HAVE BAFFLES

*INSTALLER IS RESPONSIBLE FOR OBTAINING FINAL APPROVAL ON THIS PERMIT

47118

①
BROWN
CLAY
3
BROWN
SAND
MICA
LOAM
12

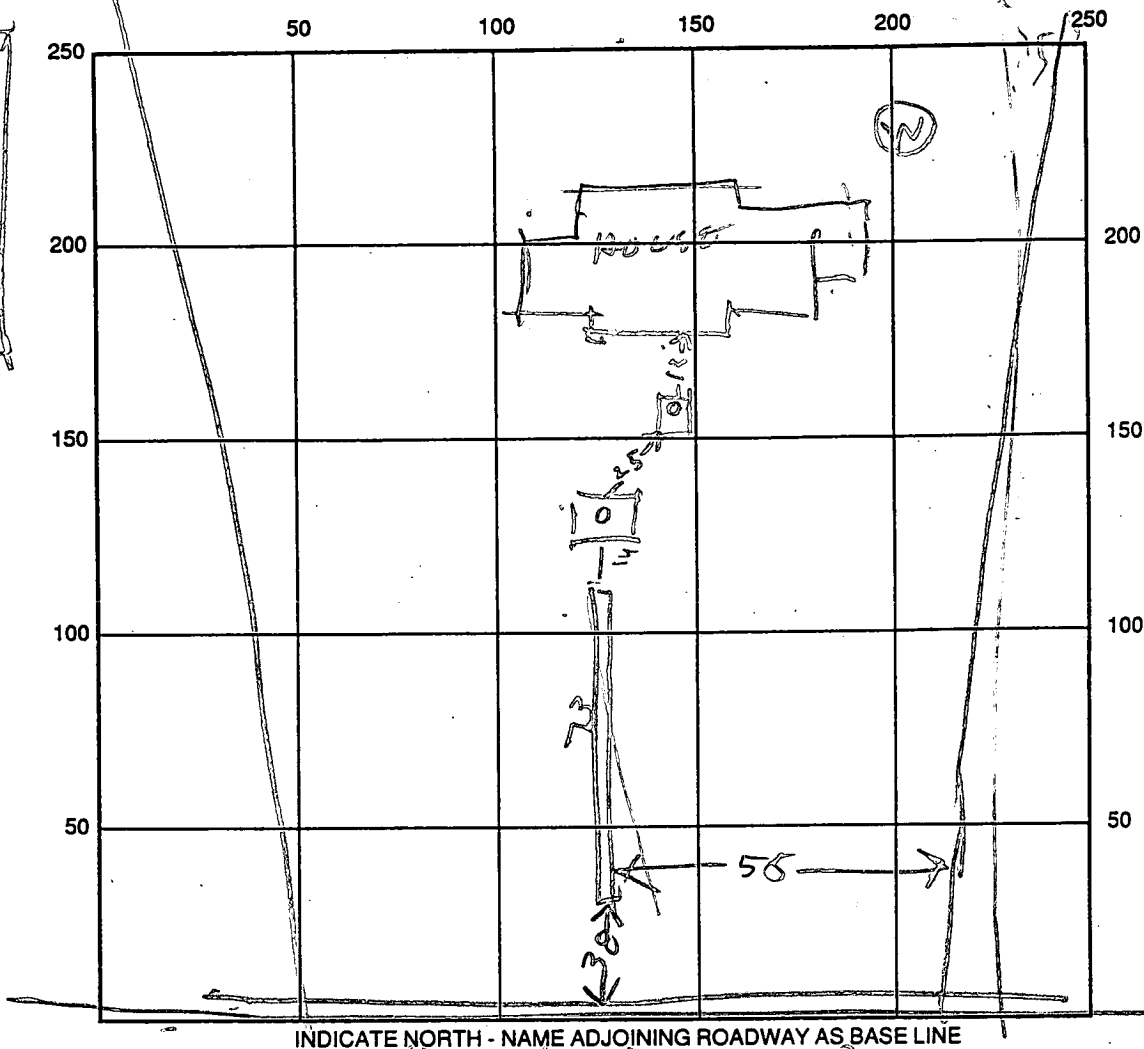

SEPTIC TANK LEVEL _____ (W) CLEANOUTS _____

DISTRIBUTION BOX LEVEL _____

DRAIN FIELD/TITLE DEPTH 13 FT. TRENCH WIDTH 2 FT. INLET DEPTH 3 FT.

EFFECTIVE GRAVEL DEPTH 8 FT. TOTAL LENGTH 73 FT.

NUMBER OF TRENCHES 1 ONE SIDEWALL/BOTTOM AREA 564 SQ. FT.

DRYWALL INSIDE DIAMETER _____ FT. EFFECTIVE DEPTH BELOW INLET _____ FT.

ABSORBENT AREA _____ SQ. FT.

REMARKS: 4/25/91 - TRENCH NOT TOO CLOSE TO WELL
ACROSS STREET (130 FT) FINISH ADDING ANOTHER
LOAD OF STONE TO TRENCH & COVER. R.H.

DATE SYSTEM APPROVED 4/26/91 INSPECTOR B. Hodges

app RH

7/9/79

PERMIT

P 29964
A 24889

SEWAGE DISPOSAL SYSTEM

MARYLAND STATE DEPARTMENT OF HEALTH*

HOWARD COUNTY

ELLICOTT CITY

DISTRICT 5th

INDEXED

DATE 7/3/79

Robert L. Orndorff

IS PERMITTED TO INSTALL X ALTER

ADDRESS 13938 Highland Road, Clarksville, Md. 21029 PHONE 596-9394

SUBDIVISION Wesley Hills ROAD 11440 Rowley Road LOT 20

PROPERTY OWNER F. G. Marker Co., Inc.

ADDRESS 5900 Princess Garden Parkway, Lanham, Md. Phone: 459-5586

SPECIFICATIONS 4 bedrooms

SEPTIC TANK CAPACITY 1250 GALLONS

DRAIN FIELD _____ DEPTH _____ FEET, BOTTOM AREA _____ SQ. FT.

DEEP TRENCH _____ DEPTH _____ FEET, BOTTOM AREA _____ SQ. FT.

SEEPAGE PITS X ABSORBENT SIDE-WALL AREA 120 SQ. FT. per bedrooms

INLET PIPE X 5 FT. BELOW ORIGINAL GRADE. MAXIMUM DEPTH 14 FT. BELOW ORIGINAL GRADE

EFFECTIVE DEPTH AT _____ FT. BELOW ORIGINAL GRADE.

LOCATE DISPOSAL AREA 150 FT. FROM front LOT LINE AND 56 FT. FROM right LOT LINE AS SEEN WHEN
FACING LOT FROM Rowley Road.

A manhole type cleanout to grade level will be needed on septic tank.

PLANS APPROVED BY Raymond Hodges DATE 10/21/77

COVER NO WORK UNTIL INSPECTED AND APPROVED.

NEITHER THE HOWARD COUNTY COUNCIL NOR THE HEALTH DEPARTMENT IS RESPONSIBLE FOR THE SUCCESSFUL OPERATION OF ANY SYSTEM.

NOTE: IF TRENCH IS USED CALL FOR INSPECTION BEFORE PLACING GRAVEL IN TRENCH.

NOTE: NO DRY WELL SHALL EXCEED 15 FOOT IN DIAMETER.

NOTE: ALL PIPE FROM HOUSE TO DISPOSAL AREA MUST BE CAST IRON.

PERMIT VOID AFTER THREE YEARS.

NOTE: INSTALL STAND PIPE ON SEPTIC TANK AND DRY WELL. STAND PIPES MUST BE 6 INCHES IN DIAMETER. CAST IRON, CONCRETE OR TERRA


COTTA ACCEPTED.

***INSTALLER IS RESPONSIBLE FOR OBTAINING FINAL APPROVAL ON THIS PERMIT.**

BLDG. PERMIT SIGNED
AND RETURNED 10/10/88
Serial No. 21698
16' x 20' addition

BLDG. PERMIT SIGNED
AND RETURNED 12/3/82
Serial # 57837
Interior Alterations

A24889

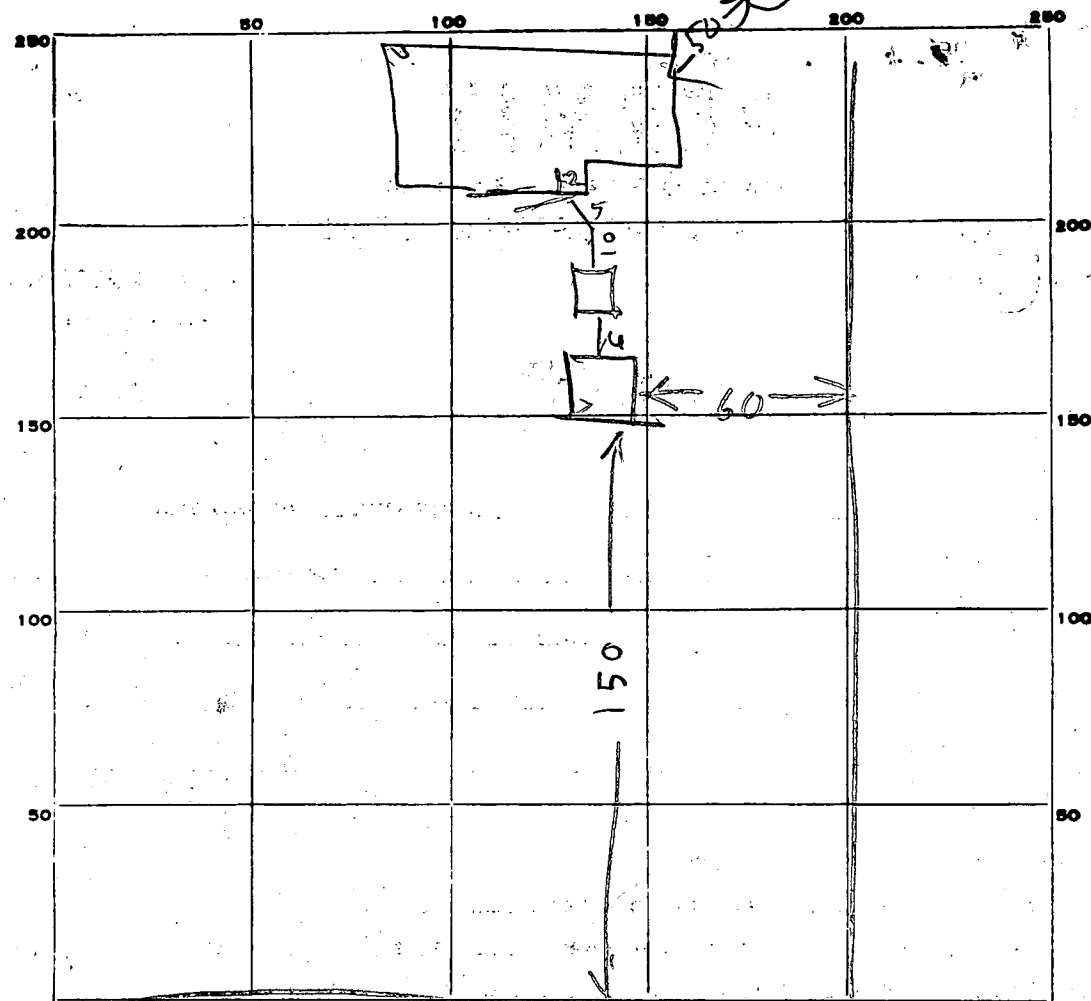

INDICATE NORTH. - NAME ADJOINING ROADWAY AS BASE LINE.

PERMIT CARD _____

SEPTIC TANK, LEVEL OK 1500

CLEANOUTS OK

DISTRIBUTION BOX, LEVEL TOP 2 FT below grade

TILE FIELD, DEPTH _____ FT. TRENCH WIDTH _____ FT.

GRAVEL DEPTH _____ IN. TOTAL LENGTH _____ FT.

NUMBER OF TRENCHES _____

TOTAL BOTTOM AREA _____

SEEPAGE PITS, INSIDE DIAMETER PERIMETER 61

DEPTH BELOW INLET 9 FT.

ABSORBENT AREA 549 SQ. FT.

REMARKS 7/9/79 - DWINLET 4 FT BELOW ORIGINAL 6 PITCH

4 BR 480 SQ FT REQUIRED

DATE SYSTEM APPROVED 7/9/79

INSPECTOR Raymond Bodger

NOTE: This location for title purposes only - not to be used for determining property lines. Property corner Markers Not guaranteed by this location.

ROWLEY ROAD

R=475.00' A=130.97'

BLDG. PERMIT SIGNED
AND RETURNED 10/10/88

Note: HUD Flood Panel # 240044-00388
Flood Zone 'C'

BUILDING LINE AND/OR FLOOD ZONE
INFORMATION IS TAKEN FROM AVAILABLE
SOURCES AND SUBJECT TO INTERPRETATION
OF ORIGINATOR.

PROPOSED 10'x16'
9'x16' SHED

10/10/88 OK TO SIGN R/D

LOCATION OF HOUSE
LOT 20
WESLEY HILLS
HOWARD COUNTY, MD.
RECORDED SEPTEMBER 26, 1977



SURVEYOR'S CERTIFICATE THE PLAN SHOWN HEREON IS PREPARED FROM FIELD MEASUREMENTS OF EXISTING STRUCTURES AND DIMENSIONS, TO THE BEST OF MY KNOWLEDGE AND BELIEF, AS SHOWN OR DESCRIBED, IN P.No. 3821 AND RECORDED AMONG THE LAND RECORDS OF HOWARD CO., MD. <i>Harry B. Blanchard</i> REGISTERED LAND SURVEYOR MD # 7180	REFERENCES	SNIDER, BLANCHARD, LAUGHLAND & TACIK, INC.		
	PLAT BK.	SURVEYORS - ENGINEERS		
	PLAT NO. 3821	LAND PLANNING CONSULTANTS		
		341 W. Patrick Street Frederick, MD 21701 (301) 694-3344	2 Professional Bk., Suite 214 Gaithersburg, MD 20879 (301) 948-5100	
	LIBER	DATE OF LOCATIONS	SCALE: 1" = 50'	
		WALL CHECK:	DRAWN BY: S.D.	
	FOLIO	HSE. LOC: 4-10-87	JOB NO.: F-87-373	
	BOUNDARY:			

APPLICATION

A 24889

SEWAGE DISPOSAL TESTING

P _____

STATE OF MARYLAND - DEPARTMENT OF HEALTH AND MENTAL HYGIENE

HOWARD COUNTY HEALTH DEPARTMENT
ENVIRONMENTAL HEALTH SERVICES

DISTRICT 5th

P. O. BOX 476, ELLICOTT CITY, MARYLAND 21043
TELEPHONE: 465-5000, EXT. 356

DATE 12/2/76

System final

TO: THE COUNTY HEALTH OFFICER
ELLICOTT CITY, MARYLAND

I, HEREBY, APPLY FOR THE NECESSARY TEST IN ORDER TO CONSTRUCT (OR RECONSTRUCT) A SEWAGE DISPOSAL SYSTEM.

PROPERTY OWNER CAPITAL DISTRICT WESLEYAN CHURCH

ADDRESS 10929 PLEASANT ACRES DRIVE, HYATTSVILLE 20783 PHONE 559-2626

PROPERTY LOCATION:

SUBDIVISION WESLEY HILLS

LOT NO. 29

ROAD AND DESCRIPTION KRAUS ROAD

SIZE OF LOT 40,000 sq. feet

TYPE BLDG. 4

NUMBER OF BEDROOMS

IF NOT SINGLE RESIDENCE DESCRIBE _____

THE SYSTEM INSTALLED UNDER THIS APPLICATION IS ACCEPTABLE ONLY UNTIL PUBLIC FACILITIES BECOME AVAILABLE.

SIGNATURE OF APPLICANT /s/ James W. Kraus, President

APPROVED BY

Raymond Hodges

FOR

Dry Well

DATE

10/21/77

(KIND OF SYSTEM)

REJECTED BY _____

FOR _____

(KIND OF SYSTEM)


DATE _____

HOLD PENDING FURTHER TESTS _____

DATE _____

REASONS FOR REJECTION OR HOLDING _____

THIS IS NOT A PERMIT

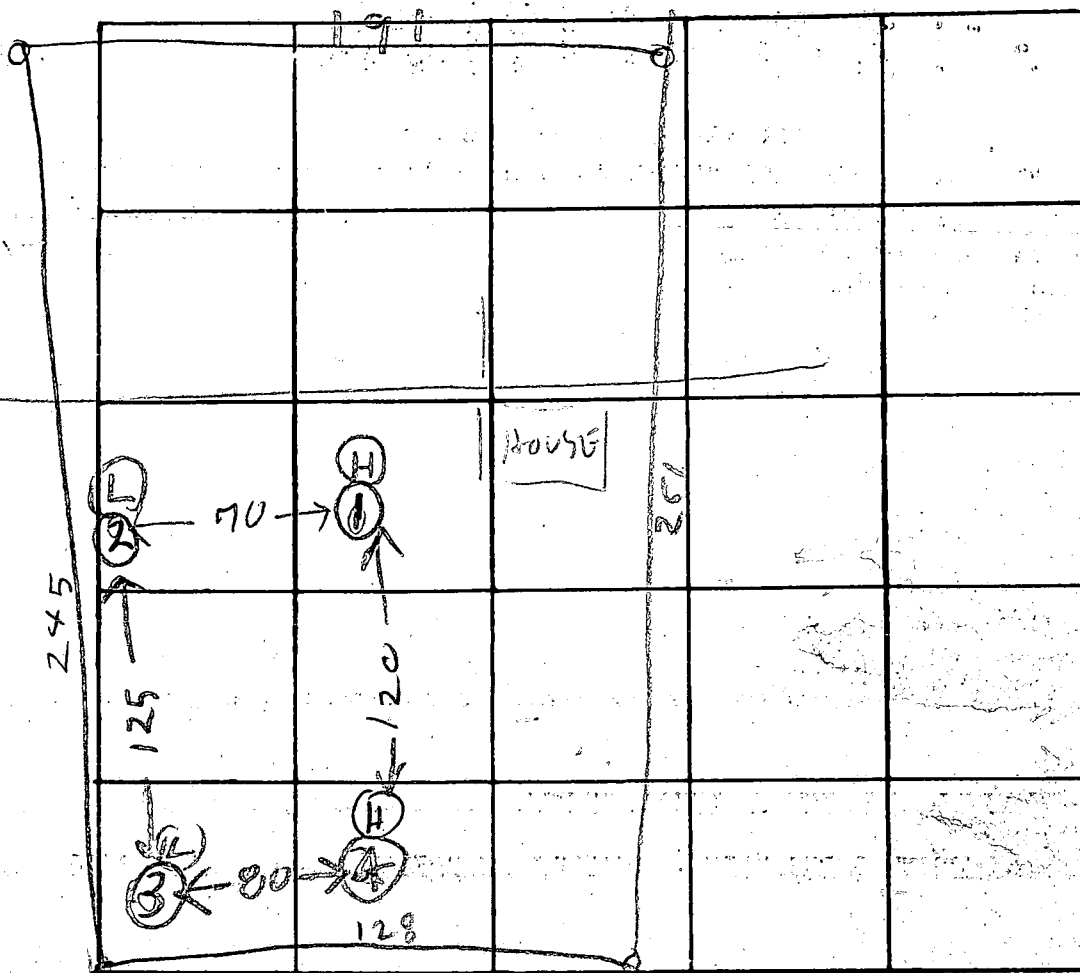

INDICATE NORTH. - NAME ADJOINING ROADWAY AS BASE LINE

PAUL DR

DATE	TEST NO.	DEPTH	PRE-WET		TEST 1" DROP		TIME
			START	STOP	START	STOP	
12/14/76	1 S	6	1122	1126	1126	1130	4
	1 D	14	1122	1124	1124	1136	12
	2 D	13	1127	1132	1132	1139	7
	2 S	3 1/2	1144	1146	1146	1152	6
	3 S	4 1/2	1133	1139	1139	1142	5
12/14/76	3 D	14	1134	1149	1139	1146	8
12/14/76	4 V	13	TOP BOT	AF 7 1	CLAY OF 7	SANDY	

REMARKS

TYPE OF SOIL

TESTED BY

RH & RB

ALSO PRESENT: J. FROCK

av time 7 max depth 5

Lot 27

C 1 0384 1 2 3 (SEQ. NO.) 6 (THIS NUMBER IS TO BE PUNCHED IN COLS. 3-6 ON A-L CARDS)	SEQUENCE NO. (WRA USE ONLY)	STATE OF MARYLAND WATER RESOURCES ADMINISTRATION LAWES STATE OFFICE BLDG., ANNAPOLIS, MD. 21401 WELL COMPLETION REPORT		THIS REPORT MUST BE SUBMITTED WITHIN 30 DAYS AFTER WELL COMPLET FILL IN THIS FORM COMPLETELY COUNTY NUMBER
DATE RECEIVED (WRA USE ONLY)	DATE WELL COMPLETED Mar 30 1978	DEPTH OF WELL 225 22 (TO NEAREST FOOT) 26		PERMIT NO. FROM "PERMIT TO DRILL WELL" HO-73-3046 28 29 30 31 32 33 34 35 36 37
OWNER LAST NAME STREET OR RFD 5900 Primrose Court, Hagerstown		FIRST NAME POST OFFICE San Juan, Md.		
WELL DESCRIPTION				
WELL LOG STATE THE KIND OF FORMATIONS PENETRATED, THEIR COLOR, DEPTH, THICKNESS AND IF WATER BEARING DESCRIPTION (USE ADDITIONAL SHEETS IF NECESSARY) FEET FROM TO CHECK IF WATER BEARING Sand 0 74 Gray mudstone 74 225 ✓		GROUTING RECORD YES NO WELL HAS BEEN GROUTED (CIRCLE APPROPRIATE BOX) Y N TYPE OF GROUTING MATERIAL (CIRCLE BOX) CEMENT CM BENTONITE CLAY BC NO. OF BAGS 19 NO. OF POUNDS 1786 GALLONS OF WATER 114 DEPTH OF GROUT SEAL (TO NEAREST FOOT) FROM 0 FT. TO 66 FT. (ENTER 0 IF FROM SURFACE)		
CASING RECORD INSERT APPROPRIATE CODE BELOW STEEL ST CONCRETE CO PLASTIC PL OTHER OT MAIN CASING TYPE ST NOMINAL DIAMETER TOP (MAIN) CASING (NEAREST INCH) 6 TOTAL DEPTH OF MAIN CASING (NEAREST FOOT) 20		PUMPING TEST C 3 1 2 3 (SEQ. NO.) 6 HOURS PUMPED (TO NEAREST HOUR) 2 PUMPING RATE (GALLONS PER MINUTE TO NEAREST GALLON) 6 METHOD USED TO MEASURE PUMPING RATE WATER LEVEL: (DISTANCE FROM LAND SURFACE) BEFORE PUMPING 63 (NEAREST FOOT) WHEN PUMPING 5 (NEAREST FOOT) TYPE OF PUMP USED (CIRCLE APPROPRIATE BOX) (FOR PUMPING TEST) AIR A PISTON P TURBINE T CENTRIFUGAL C ROTARY R OTHER (DESCRIBE BELOW) O JET J SUBMERSIBLE S		
OTHER CASING (IF USED) DIAMETER (INCH) DEPTH (FEET) FROM TO EACH CASING		PUMP INSTALLED TYPE OF PUMP (WRITE APPROPRIATE LETTER IN BOX - SEE ABOVE: A, C, J, P, R, S, T, O) DRILLER WILL INSTALL PUMP (CIRCLE APPROPRIATE BOX) YES NO CAPACITY: GALLONS PER MINUTE (TO NEAREST GALLON) PUMP HORSE POWER PUMP COLUMN LENGTH (NEAREST FOOT)		
SCREEN RECORD INSERT APPROPRIATE CODE BELOW STEEL ST BRASS OPEN HOLE OR BRONZE BR PLASTIC PL OTHER OT C 2 1 2 3 (SEQ. NO.) 6 DEPTH (NEAREST WHOLE FOOT) FROM TO EACH SCREEN 1 110 78 335 2 23 24 26 30 32 36 3 38 39 41 45 47 51 SLOTSIZE 1. 2. 3.		CASING HEIGHT (CIRCLE APPROPRIATE BOX AND ENTER CASING HEIGHT) ABOVE + BELOW - LAND SURFACE 2 (NEAREST FOOT) LOCATION OF WELL ON LOT SHOW PERMANENT STRUCTURE SUCH AS BUILDINGS, SEPTIC TANKS, AND/OR OTHER LAND MARKS AND INDICATE NOT LESS THAN TWO DISTANCES (MEASUREMENTS TO WELL).		
I HEREBY CERTIFY THAT I HAVE COMPLIED WITH ALL CONDITIONS STATED ON THE ABOVE-CAPTIONED "PERMIT TO DRILL WELL", AND THAT INFORMATION CONTAINED IN THIS REPORT IS TRUE, ACCURATE, AND COMPLETE TO THE BEST OF MY KNOWLEDGE, INFORMATION AND BELIEF.		DRILLERS-NAME (PLEASE PRINT) Joseph J. Moore SIGNATURE Joseph J. Moore		
DRILLERS-NAME (PLEASE PRINT) Joseph J. Moore SIGNATURE Joseph J. Moore		WRA USE ONLY (NOT TO BE FILLED IN BY DRILLER) T E J (E.R.O.S.) W O 70 72 74 75 76 TELESCOPE CASING LOG INDICATOR OTHER DATA AVAILABLE		

