

PERMIT

SEWAGE DISPOSAL SYSTEM

DEPARTMENT OF HEALTH AND MENTAL HYGIENE

TAX ID # 05-359341

INDEXED

HOWARD COUNTY HEALTH DEPARTMENT
BUREAU OF ENVIRONMENTAL HEALTH
461-9933

P 4/12/91

A REPAIR

DISTRICT

DATE 5/20/91

DATE SYSTEM APPROVED 4/23/91

INSPECTOR RH

Jack Fyock

IS PERMITTED TO INSTALL _____ ALTER ☒

ADDRESS _____ PHONE 988-9270

SUBDIVISION Holiday Hills LOT 28 ROAD 10514 Vista Road

PROPERTY OWNER _____ Mauck
ADDRESS 10514 Vista Road

BUILDING PERMIT SIGNED

AND RETURNED

9/30/04 000150575-ADDITION

SEPTIC TANK CAPACITY 1250 GALLONS

NUMBER OF BEDROOMS 4

125 SQUARE FEET PER BEDROOM

LINEAR FEET OF TRENCH REQUIRED 18 PER BEDROOM 73 FT FOR 4 BR

REPAIR - PURPOSE - DRYWELL IS FULL - NEED TO ADD TRENCHES TO EXISTING DRYWELL.
CALL FOR INSPECTION WHEN GROUND IS OPENED SO SANITARIAN CAN RECOMMEND REPAIR.

4/23/91 - TRENCH 11 FT DEEP, INLET 4 FT DEEP
7 FT OF STONE RUN A TRENCH ON THE OLD
DRY WELL TOWARD THE BACK OF THE LOT RH

PLANS APPROVED BY C. Williams DATE 3/27/91

COVER NO WORK UNTIL INSPECTED AND APPROVED

NEITHER THE HOWARD COUNTY COUNCIL NOR THE HEALTH DEPARTMENT IS RESPONSIBLE FOR THE SUCCESSFUL OPERATION OF ANY SYSTEM

NOTE: CLEANOUT REQUIRED EVERY 70 FEET OF SEWER LINE AND/OR AT 90° SWEEPS IN LINES FROM HOUSE TO DRAIN FIELDS, 90° ELBOWS NOT ACCEPTABLE.

NOTE: ALL PARTS OF SEPTIC SYSTEMS (I.E. TANK, DISTRIBUTION BOX TRENCHES) TO BE 100 FEET FROM WELL (UNLESS OTHERWISE SPECIFICALLY AUTHORIZED)

NOTE: IF DEEP TRENCH(ES) ARE USED CALL FOR INSPECTION BEFORE AND AFTER PLACING GRAVEL IN TRENCH(ES)

NOTE: NO DRY WELL SHALL EXCEED 15 FOOT IN DIAMETER NO ABSORPTION TRENCH TO EXCEED 100 FEET IN LENGTH

NOTE: ALL PIPE FROM HOUSE TO SEPTIC TANK MUST BE CAST IRON OR SCHEDULE 35/40 PVC OR ABS

PERMIT VOID AFTER TWO YEARS

NOTE: INSTALL STAND PIPE ON SEPTIC TANK AND DRY WELL STAND PIPES MUST BE 6 INCHES IN DIAMETER CAST IRON, CONCRETE OR TERRA COTTA OR PVA OR ABS ACCEPTED. IF TOP OF SEPTIC TANK IS DEEPER THAN 3 FEET. MANHOLE TO GRADE REQUIRED.


NOTE: DISTRIBUTION BOXES MUST HAVE BAFFLES

*INSTALLER IS RESPONSIBLE FOR OBTAINING FINAL APPROVAL ON THIS PERMIT

*CALL 461-9933 FOR INSPECTION OF SEPTIC SYSTEM.

P 4/12/91

①
BROWN
CLAY
BROWN
SAND
LOAM

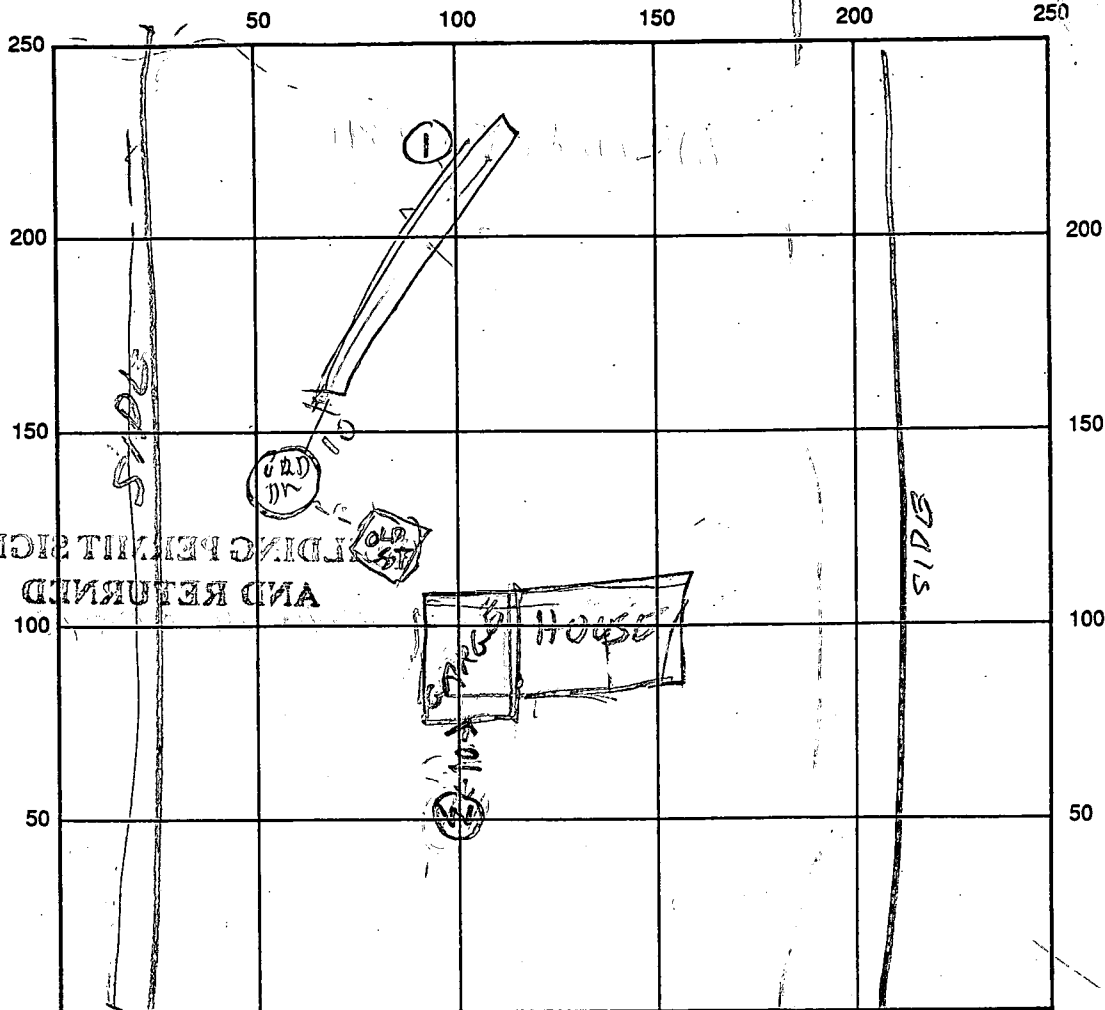

INDICATE NORTH - NAME ADJOINING ROADWAY AS BASE LINE

VISTA RD

SEPTIC TANK LEVEL _____ CLEANOUTS _____

DISTRIBUTION BOX LEVEL _____

DRAIN FIELD/TITLE DEPTH 2 FT. TRENCH WIDTH 2 FT. INLET DEPTH 4 FT.

EFFECTIVE GRAVEL DEPTH 17 FT. TOTAL LENGTH 80 FT.

NUMBER OF TRENCHES 11 ONE SIDEWALL/BOTTOM AREA 560 SQ. FT.

DRYWALL INSIDE DIAMETER _____ FT. EFFECTIVE DEPTH BELOW INLET _____ FT.

ABSORBENT AREA _____ SQ. FT.

REMARKS: 4/23/91 OLD DRY WELL IN USE 33 YEARS RH

DATE SYSTEM APPROVED

4/23/91

INSPECTOR

Raymond Holger

ck out - 10/20/59
App. approved 10/20/59

PERMIT

P 01817

A 00873

SEWAGE DISPOSAL SYSTEM

MARYLAND STATE DEPARTMENT OF HEALTH

HOWARD COUNTY

ELLICOTT CITY

DISTRICT 5

DATE 10/15/59

INDEXED

Tattrie & Levy

IS PERMITTED TO INSTALL ☒ ALTER

ADDRESS Simpsonville

PHONE Atlas 6-3241

A SEWAGE DISPOSAL SYSTEM LOCATED AT

SUBDIVISION Holiday Hills

ROAD Vista

LOT 28

PROPERTY OWNER Tattrie & Levy

ADDRESS Simpsonville

SPECIFICATIONS

DRAIN FIELD DEPTH FEET, BOTTOM AREA SQ. FT.

SEEPAGE PITS ☒ ABSORBENT SIDE-WALL AREA 300 SQ. FT.

SEPTIC TANK CAPACITY 750 GALLONS

FOR GARBAGE GRINDER, INCREASE DISPOSAL AREA 22% & TANK CAPACITY 50%

OTHER Do not include top 3 ft. in computing the sidewall area. Place dry well about 130 ft. from the road and 30 ft. from lot no. 29.

System must be installed in area that passed perc. test.


PLANS APPROVED BY Raymond Hodges

DATE 5/12/59

FILL SEPTIC TANK AND DISTRIBUTION BOX WITH WATER BEFORE CALLING FOR AN INSPECTION. COVER NO WORK UNTIL INSPECTED AND APPROVED.

NEITHER THE HOWARD COUNTY COMMISSIONERS NOR THE HEALTH DEPARTMENT IS RESPONSIBLE FOR THE SUCCESSFUL OPERATION OF ANY SYSTEM.

A00873

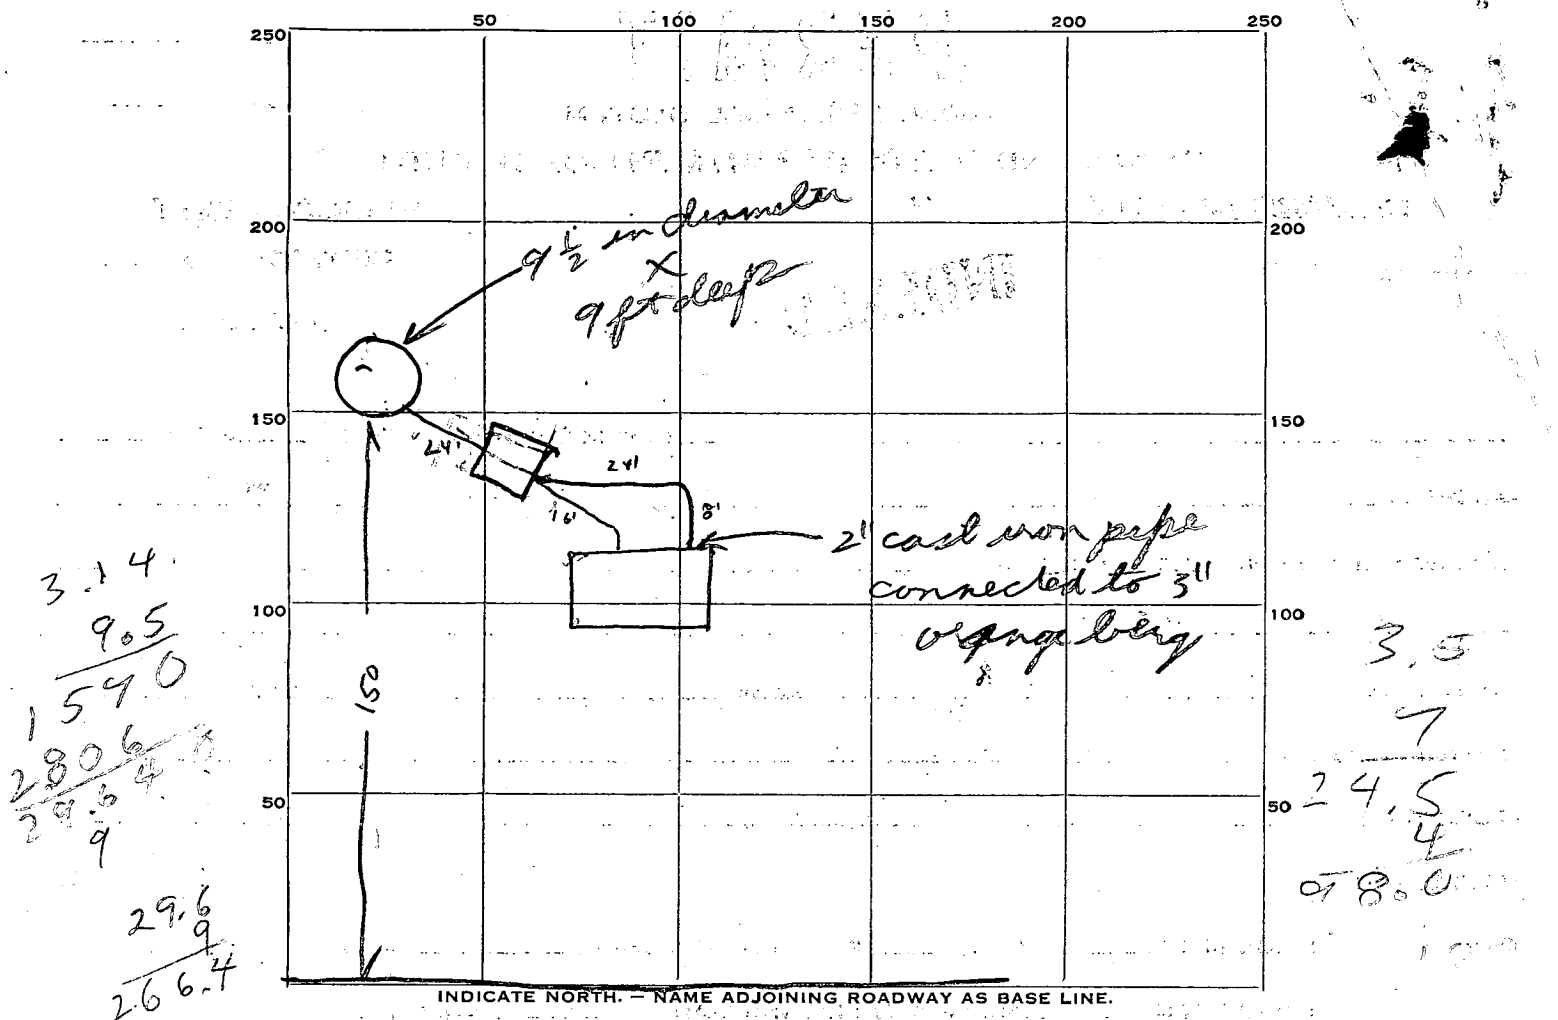

PERMIT CARD Yes

SEPTIC TANK, LEVEL OK 750

CLEANOUTS OK 8" Tank

DISTRIBUTION BOX, LEVEL _____

TILE FIELD, DEPTH _____ FT. TRENCH WIDTH _____ FT.

GRAVEL DEPTH _____ IN. TOTAL LENGTH _____ FT.

NUMBER OF TRENCHES _____ TOTAL BOTTOM AREA _____

SEEPAGE PITS, INSIDE DIAMETER 9 1/2 FT. DEPTH BELOW INLET 9 FT.

ABSORBENT AREA 266 SQ. FT.

REMARKS 1 ft to 4 ft of gravel around the outside of the block should make up for the shortage of sq ft sidewall area
If the 3" house sewer is to be connected to toilets it will have to be replaced with 4 inch pipe

DATE SYSTEM APPROVED 10/20/59

INSPECTOR Raymond Hodges

APPLICATION

A 00873
P 01817

SEWAGE DISPOSAL TESTING

MARYLAND STATE DEPARTMENT OF HEALTH

HOWARD COUNTY

ELLICOTT CITY

750 GALLON TANK

DISTRICT 5

DRY WELL - 300 SQ FT SIDE WALL AREA

DATE 5-4-59

DONOT INCLUDE TOP 3' IN

COMPUTING THE SIDE WALL AREA

PLACE DRY WELL ABOUT 130' FROM

THE ROAD AND 30' FROM LOT #29

TO: THE COUNTY HEALTH OFFICER
ELLICOTT CITY, MARYLAND

I, HEREBY, APPLY FOR THE NECESSARY TESTS IN ORDER TO CONSTRUCT (OR RECONSTRUCT) A SEWAGE DISPOSAL SYSTEM.

PROPERTY OWNER Tattale & Levy

ADDRESS Simpsonville

PHONE Atlas 6-3241

PROPERTY LOCATION:

SUBDIVISION Holiday Hills

LOT NO. 23

ROAD AND DESCRIPTION Vista Rd.

OCCUPANT

PHONE

PERSON TO CONSTRUCT SYSTEM

above

ADDRESS

PHONE

SIZE OF LOT 1 acre

TYPE BLDG. 3

NUMBER OF BEDROOMS

IF NOT SINGLE RESIDENCE DESCRIBE

SIGNATURE OF APPLICANT

Ray A. G. Lattin

APPROVED BY

Raymond Hodges

FOR

Dry Well

(KIND OF SYSTEM)

DATE

5/12/59

REJECTED BY

FOR

(KIND OF SYSTEM)

DATE


HOLD PENDING FURTHER TESTS

DATE

REASONS FOR REJECTION OR HOLDING

THIS IS NOT A PERMIT

ACC 873

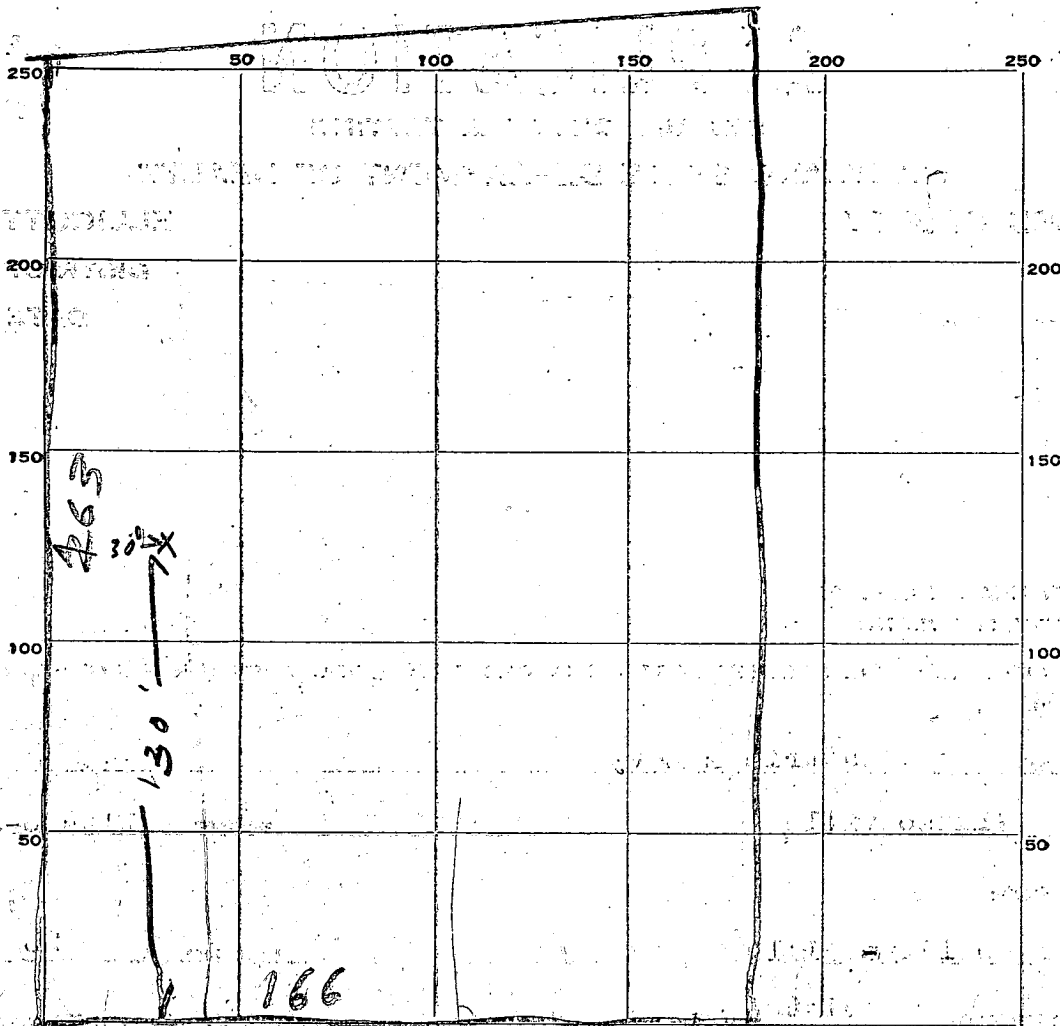


INDICATE NORTH. - NAME ADJOINING ROADWAY AS BASE LINE.
VISTA RD

DATE	TEST NO.	DEPTH	PRE-WET		TEST - 1" DROP		TIME
			START	STOP	START	STOP	
5/12	1	9'	940	946	946	954	8 min

SOIL AUGER FINDING 4' clay on top 5' rotten rock
 TESTED BY Raymond Rogers
 REMARKS
 ALSO PRESENT LOT NO. 28

9/30/04
 Discussed well loc
 & health concerns
 of parked cars over
 well. T says
 manhole over well.
 Recommend
 well testing
 for voc's.

(KN)

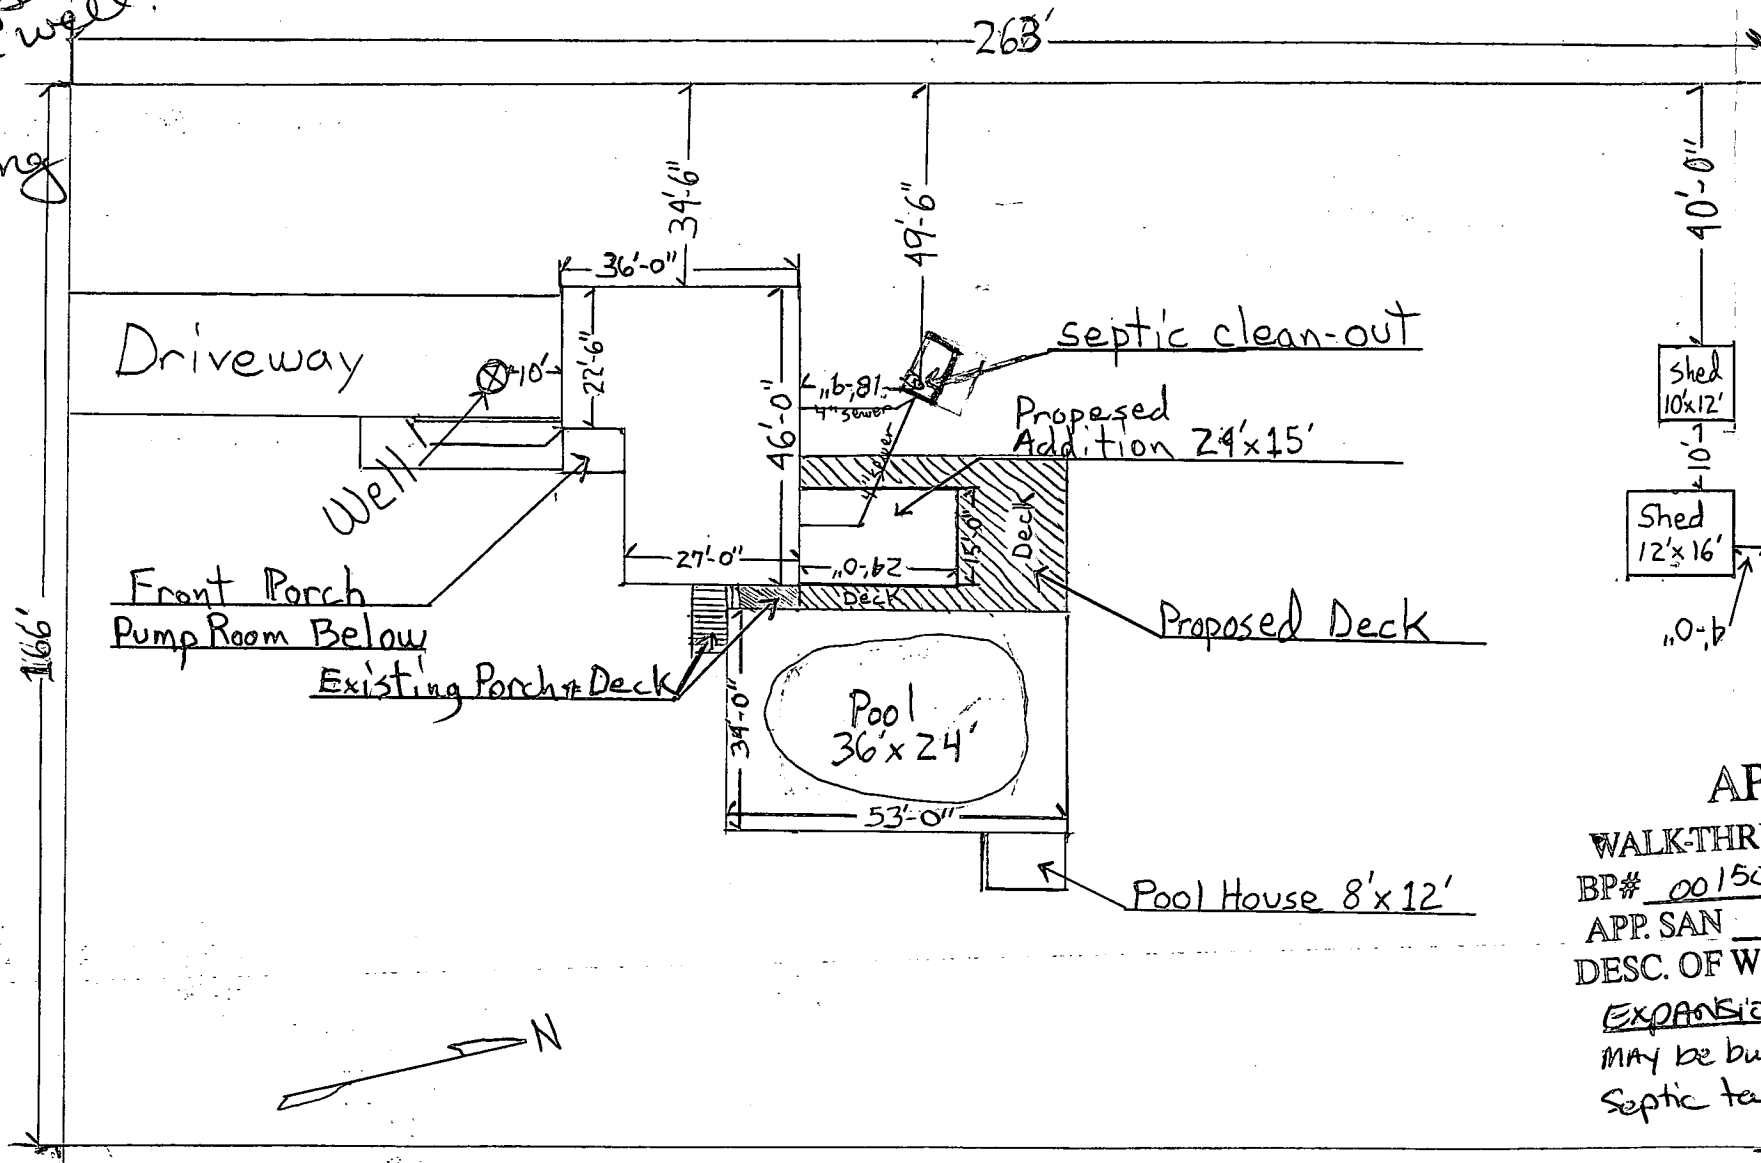

Soils SANDY Loam
 p47121

APPROVED
 WALK-THRU BUILDING PERMIT
 BP# 00150575 A# P47121
 APP. SAN KN DATE: _____
 DESC. OF WORK: LIVING ROOM
 EXPANSION, Deck MAY NOT
 MAY be built, 8 1/2' from edge of
 Septic tank OK

Plat: "Second addition to Holiday Hills Sub"
 division. Lot 28 Scale: 1" = 30'-0"
 Plat book RHM No. 7, Folio 41