

3/4/91 10:00 AM
3/20/91 10 AM
3/22/91 am asap
4/25/91 11
5/16/91 1 PM

1ax ID - 03-299031
PERMIT

SEWAGE DISPOSAL SYSTEM
DEPARTMENT OF HEALTH AND MENTAL HYGIENE

P 47482

A REPAIR

DISTRICT _____

DATE 9/16/91

DATE SYSTEM APPROVED 3/22/91

INSPECTOR M. Rife

HOWARD COUNTY HEALTH DEPARTMENT
BUREAU OF ENVIRONMENTAL HEALTH
461-9933

INDEXED

N. COLLINS
Jenkins Brothers

IS PERMITTED TO INSTALL _____ ALTER X

ADDRESS Route 144, Ellicott City, Maryland 21043 PHONE 465-6646 Mag 10

SUBDIVISION _____ LOT _____ ROAD 1712 Woodstock Road (P. 138)

PROPERTY OWNER Steve Wladkowski 465-0465

ADDRESS 1712 Woodstock Road, Woodstock, Maryland 21163

SEPTIC TANK CAPACITY 1000 GALLONS

NUMBER OF BEDROOMS 2

375 SQUARE FEET PER BEDROOM TOTAL

LINEAR FEET OF TRENCH REQUIRED _____

REPAIR - CALL FOR INSPECTION WHEN GROUND IS OPENED SO SANITARIAN CAN RECOMMEND REPAIR.

15' x 25' LEACHING BED; INLET 1' BOT 2 1/2'; TOPSEAM TANK

4/91 - LEACHING BED, FAILED, DISCONNECTED (H₂O TABLE);

FINAL DISPOSITION: DUAL HOLDING TANK SYSTEM (OLD S.T. & NEW S.T.)

PLANS APPROVED BY Craig Williams cm DATE 03/08/91

COVER NO WORK UNTIL INSPECTED AND APPROVED

NEITHER THE HOWARD COUNTY COUNCIL NOR THE HEALTH DEPARTMENT IS RESPONSIBLE FOR THE SUCCESSFUL OPERATION OF ANY SYSTEM

NOTE: CLEANOUT REQUIRED EVERY 70 FEET OF SEWER LINE AND/OR AT 90° SWEEPS IN LINES FROM HOUSE TO DRAIN FIELDS, 90° ELBOWS NOT ACCEPTABLE.

NOTE: ALL PARTS OF SEPTIC SYSTEMS (I.E. TANK, DISTRIBUTION BOX TRENCHES) TO BE 100 FEET FROM WELL (UNLESS OTHERWISE SPECIFICALLY AUTHORIZED)

NOTE: IF DEEP TRENCH(ES) ARE USED CALL FOR INSPECTION BEFORE AND AFTER PLACING GRAVEL IN TRENCH(ES)

NOTE: NO DRY WELL SHALL EXCEED 15 FOOT IN DIAMETER NO ABSORPTION TRENCH TO EXCEED 100 FEET IN LENGTH

NOTE: ALL PIPE FROM HOUSE TO SEPTIC TANK MUST BE CAST IRON OR SCHEDULE 35/40 PVC OR ABS


PERMIT VOID AFTER TWO YEARS

NOTE: INSTALL STAND PIPE ON SEPTIC TANK AND DRY WELL STAND PIPES MUST BE 6 INCHES IN DIAMETER CAST IRON. CONCRETE OR TERRA COTTA OR PVA OR ABS ACCEPTED. IF TOP OF SEPTIC TANK IS DEEPER THAN 3 FEET. MANHOLE TO GRADE REQUIRED.

NOTE: DISTRIBUTION BOXES MUST HAVE BAFFLES

***INSTALLER IS RESPONSIBLE FOR OBTAINING FINAL APPROVAL ON THIS PERMIT**

047482

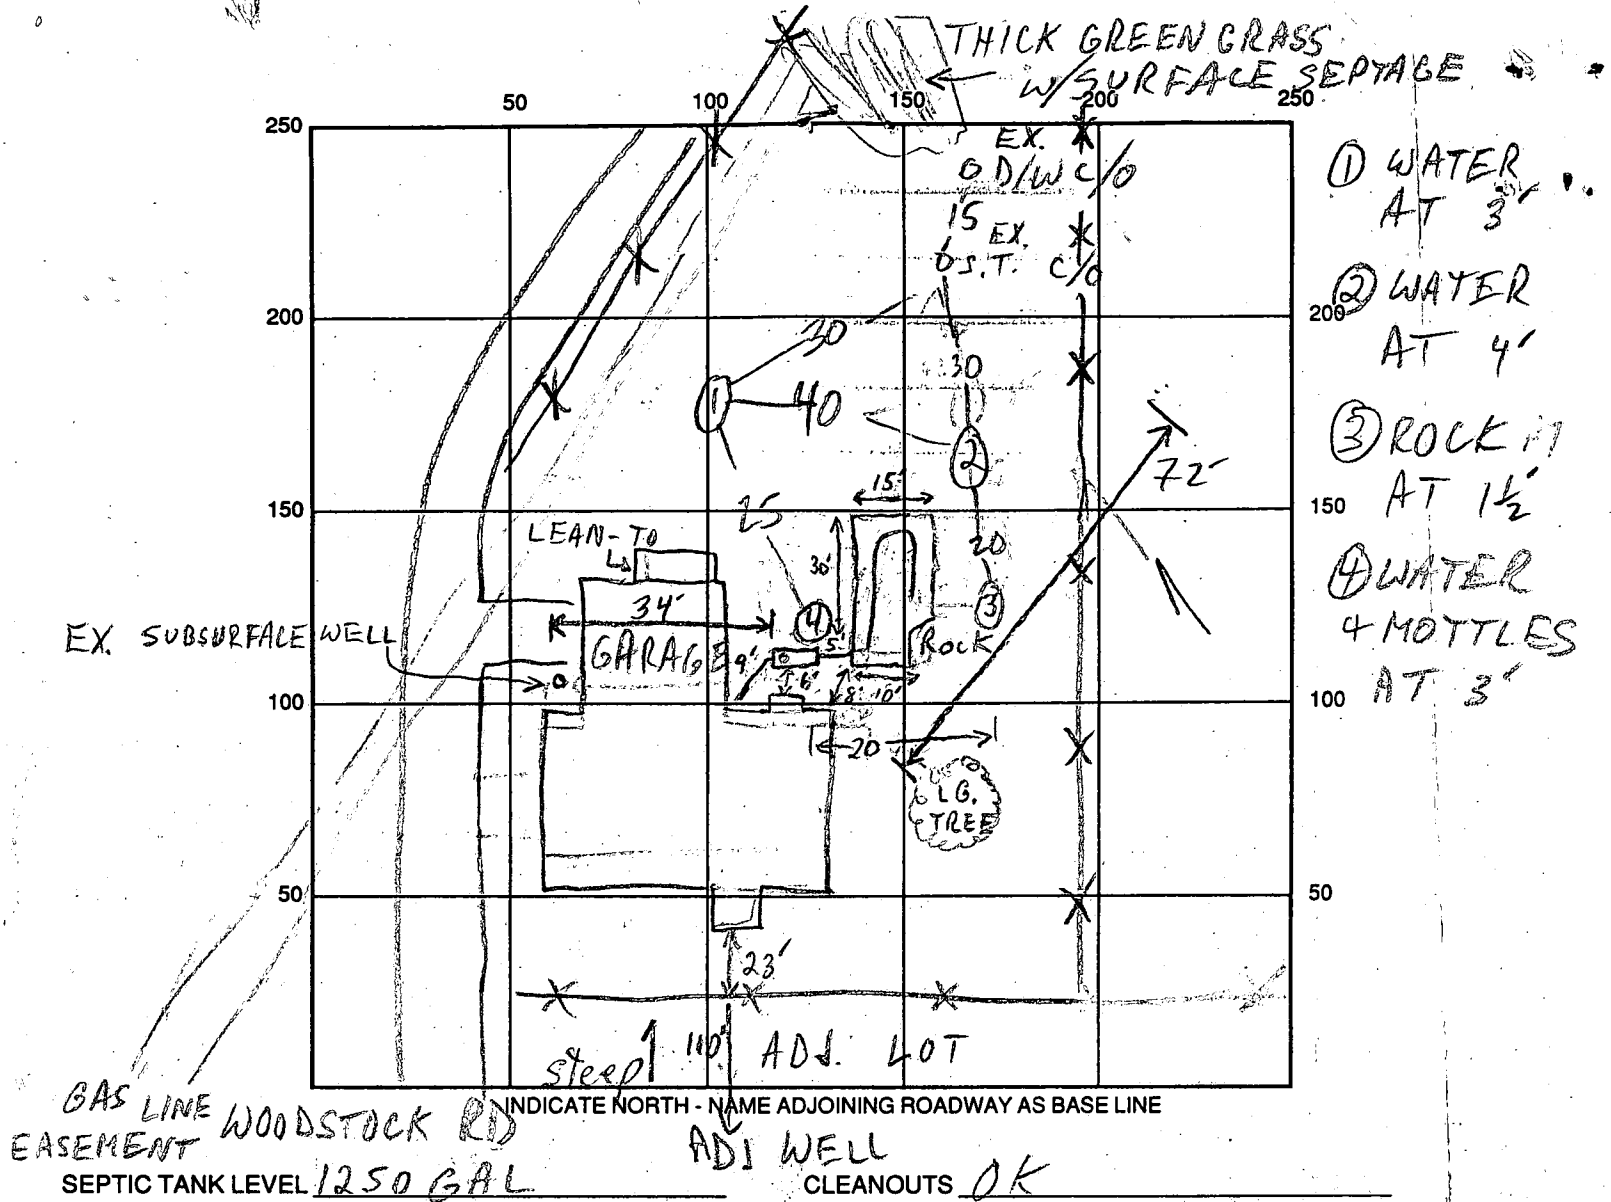

- ① WATER AT 3'
- ② WATER AT 4'
- ③ ROCK AT 1 1/2'
- ④ WATER 4 MOTTLES AT 3'

SITE INSPECTION SHEET

OWNER: Wladkowski

DATE REQUESTED: _____

ADDRESS: 1712 Woodstock Rd


INSTALLER: Collins
DRILLER: _____

WELL TAG # _____

COUNTY # _____

PROPOSAL: New repair failing g/w flooding system

LOCATION DIAGRAM

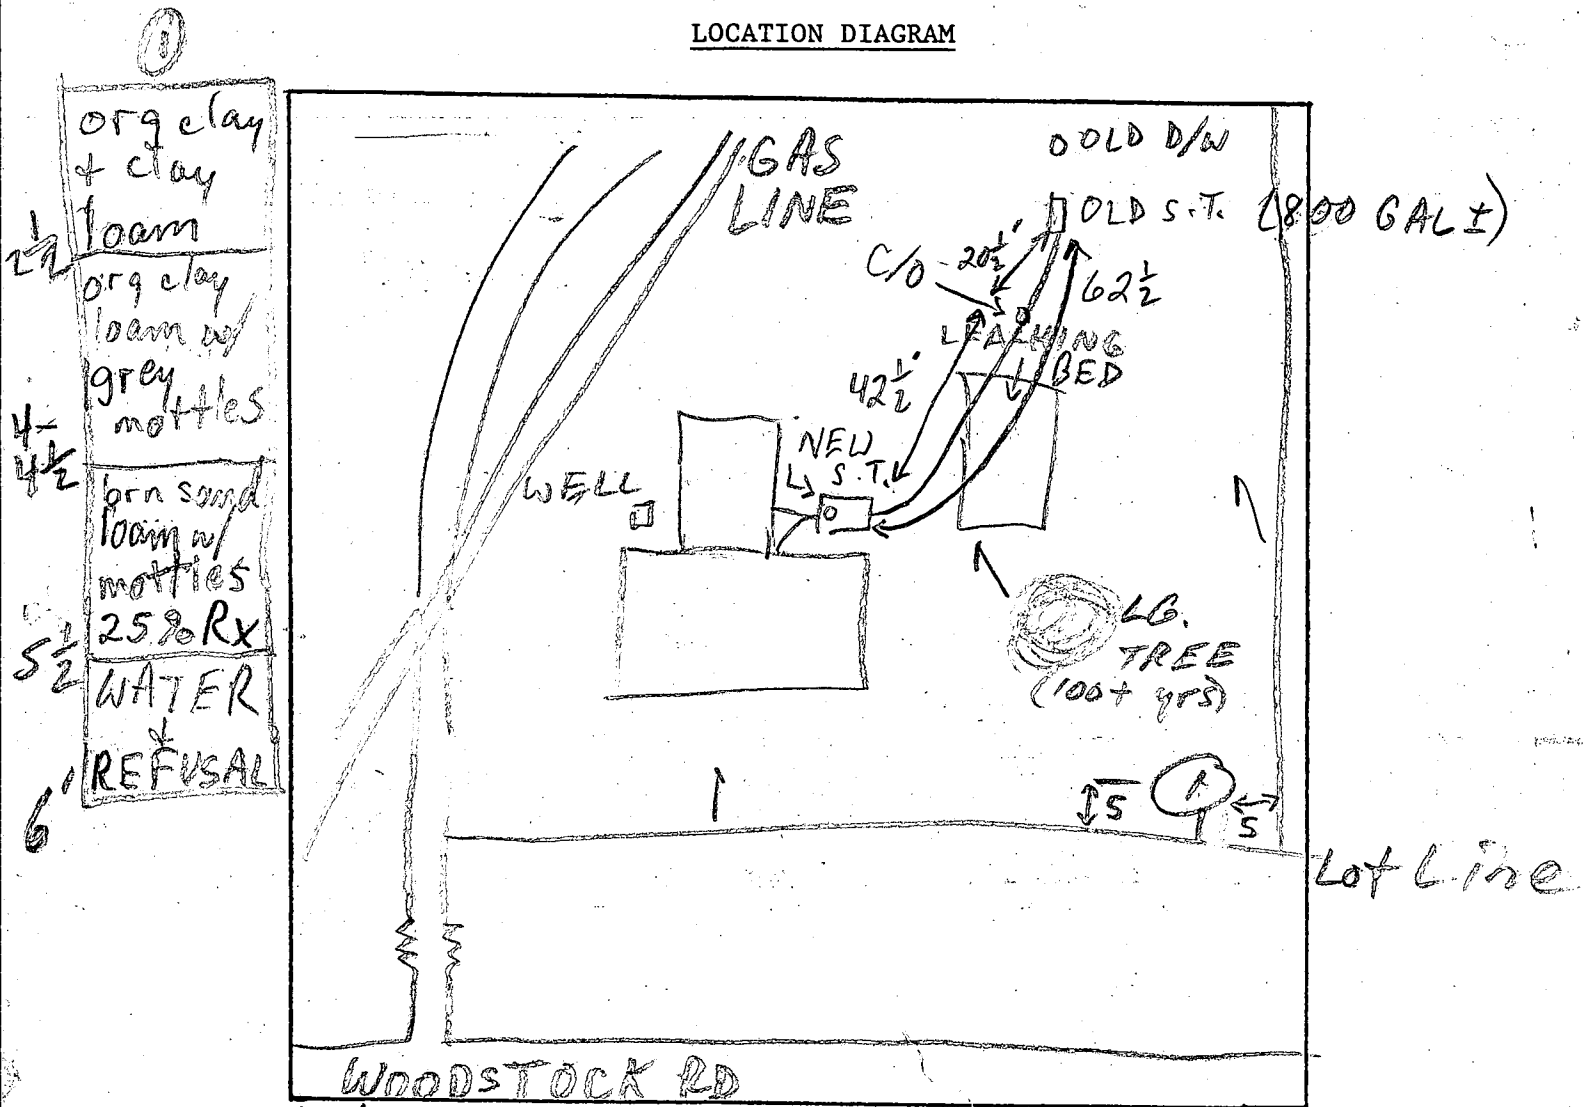

COMMENTS: 4/19/91 S.T. & LEACHING BED FILLED W/ GROUND WATER; ONLY OPTION REMAINING IS HOLDING TANK MR
4/23/91 #1 OLD S.T. PUMPED, RAINWATER REFILLED IT; D/W STILL CONN. TO A WASH. MACH; TOLD THEM TO CONN. TO MAIN SYSTEM MR
4/23/91 #2 OLD S.T. PUMPED 6" H₂O IN TANK MR
4/24/91 CONTRACTOR & OWNER CHECKED NEXT DAY - WATER LEVEL UNCHANGED OVER →
CONCLUSION - TANK DOES NOT LEAK - OK TO KEEP IN SERVICE AS HOLDING TANK G.W.

WATER LEVEL NEXT TO OLD S.T. 2' B.G.; WATER LEVEL
IN TANK ~~2~~ 3½' B.G. - OLD S.T. OK; SCH 40 IN
BETWEEN 2 SEPTIC TANKS; OUTLET PLUGGED IN OLD S.T.;
ALL OK TO COVER; BUT D/W STILL NEEDS SOME
PUMPING & ABANDONMENT MR 4/25/91

4/25/91 COLLINS INDICATES HE WILL TAR OUTLET
ON OLD S.T. MR

5/16/91 COLLINS TARED OLD S.T. OUTLET, COMPLETED
CONN GREY WATER LINE, & COLLAPSED
D/W; ALL WORK OK MR