

Tax ID - 05-360617

PERMIT

SEWAGE DISPOSAL SYSTEM

DEPARTMENT OF HEALTH AND MENTAL HYGIENE

P 47585

A 03624

A REPAIR

DISTRICT _____

DATE 10/28/91

DATE SYSTEM APPROVED 11-5-91

INSPECTOR Randy P. Kelly

HOWARD COUNTY HEALTH DEPARTMENT
BUREAU OF ENVIRONMENTAL HEALTH

461-9933

INDEXED

Fogle's Septic Clean, Inc.

IS PERMITTED TO INSTALL _____ ALTER X

ADDRESS 558 Obrecht Road, Sykesville, Maryland 21784 PHONE 795-5670

SUBDIVISION _____ LOT _____ ROAD 11900 Scaggsville Rd Route 216

PROPERTY OWNER Wallace P. Mitchell

11900 Route 216

ADDRESS Fulton, Maryland 20759

SEPTIC TANK CAPACITY 1250 GALLONS

NUMBER OF BEDROOMS 4

125 SQUARE FEET PER BEDROOM

LINEAR FEET OF TRENCH REQUIRED 72

REPAIR - PURPOSE - TO REPAIR EXISTING FAILING SEPTIC SYSTEM.

Call for inspection when ground is opened so sanitarian can recommend repair.

2 FT WIDE

TRENCH - 500 S OF - 72 FT LONG 11 FT DEEP
INLET 4 FT 7 FT STONE RUN NEW TRENCH
OFF OLD DISTRIBUTION BOX DOWN HILL FROM OLD
DRAINFIELD 4/NOV 91 RH

PLANS APPROVED BY C. Williams DATE 10/22/91

COVER NO WORK UNTIL INSPECTED AND APPROVED

NEITHER THE HOWARD COUNTY COUNCIL NOR THE HEALTH DEPARTMENT IS RESPONSIBLE FOR THE SUCCESSFUL OPERATION OF ANY SYSTEM

NOTE: CLEANOUT REQUIRED EVERY 70 FEET OF SEWER LINE AND/OR AT 90° SWEEPS IN LINES FROM HOUSE TO DRAIN FIELDS, 90° ELBOWS NOT ACCEPTABLE.

NOTE: ALL PARTS OF SEPTIC SYSTEMS (I.E. TANK, DISTRIBUTION BOX TRENCHES) TO BE 100 FEET FROM WELL (UNLESS OTHERWISE SPECIFICALLY AUTHORIZED)

NOTE: IF DEEP TRENCH(ES) ARE USED CALL FOR INSPECTION BEFORE AND AFTER PLACING GRAVEL IN TRENCH(ES)

NOTE: NO DRY WELL SHALL EXCEED 15 FOOT IN DIAMETER NO ABSORPTION TRENCH TO EXCEED 100 FEET IN LENGTH

NOTE: ALL PIPE FROM HOUSE TO SEPTIC TANK MUST BE CAST IRON OR SCHEDULE 35/40 PVC OR ABS

PERMIT VOID AFTER TWO YEARS

NOTE: INSTALL STAND PIPE ON SEPTIC TANK AND DRY WELL STAND PIPES MUST BE 6 INCHES IN DIAMETER CAST IRON. CONCRETE OR TERRA COTTA OR PVA OR ABS ACCEPTED. IF TOP OF SEPTIC TANK IS DEEPER THAN 3 FEET. MANHOLE TO GRADE REQUIRED.


NOTE: DISTRIBUTION BOXES MUST HAVE BAFFLES

*INSTALLER IS RESPONSIBLE FOR OBTAINING FINAL APPROVAL ON THIS PERMIT

HD-260(6-90)

*CALL 461-9933 FOR INSPECTION OF SEPTIC SYSTEM.

P 47585

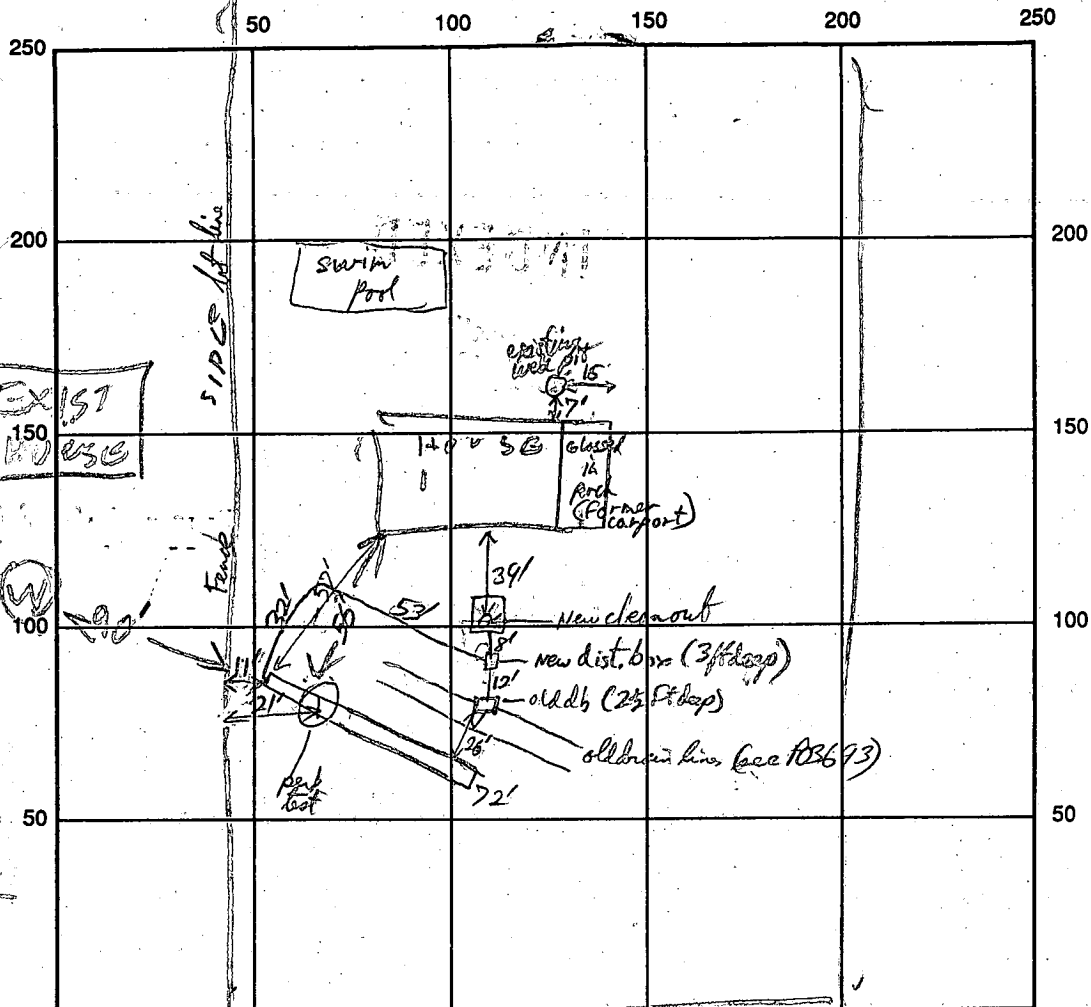

check out - 6/26/61

PERMIT

SEWAGE DISPOSAL SYSTEM

MARYLAND STATE DEPARTMENT OF HEALTH

HOWARD COUNTY

ELLICOTT CITY

INDEXED

DISTRICT 5

DATE 5-8-61

P 03693
A 03624

Calvin Miles

IS PERMITTED TO INSTALL ☒ ALTER

ADDRESS Burtonsville

PHONE _____

A SEWAGE DISPOSAL SYSTEM LOCATED AT Rt. 216 - at Fulton - approximately 1 1/2 miles above Scaggsville on right side road about 200 yards north of Pindell School Rd.

SUBDIVISION _____ ROAD _____ LOT _____

PROPERTY OWNER ~~Miles, Calvin~~ Wallace Mitchell

ADDRESS Burtonsville 11900 Route 216

SPECIFICATIONS

DRAIN FIELD ☒ DEPTH 3 FEET, BOTTOM AREA 570 SQ. FT.

SEEPAGE PITS _____ ABSORBENT SIDE-WALL AREA _____ SQ. FT.

SEPTIC TANK CAPACITY 750 GALLONS

FOR GARBAGE GRINDER, INCREASE DISPOSAL AREA 22% & TANK CAPACITY 50%.

OTHER Place the tile field 30 to 70 ft. from the front lot line near the center of the lot. Septic tank cannot be installed more than 3 feet below original grade.


PLANS APPROVED BY James E. Hennigan DATE 4/26/61

FILL SEPTIC TANK AND DISTRIBUTION BOX WITH WATER BEFORE CALLING FOR AN INSPECTION. COVER NO WORK UNTIL INSPECTED AND APPROVED.

NEITHER THE HOWARD COUNTY COMMISSIONERS NOR THE HEALTH DEPARTMENT IS RESPONSIBLE FOR THE SUCCESSFUL OPERATION OF ANY SYSTEM.

BLDG. PERMIT SIGNED
AND RETURNED 10/13/81
#47935 for action

A03624

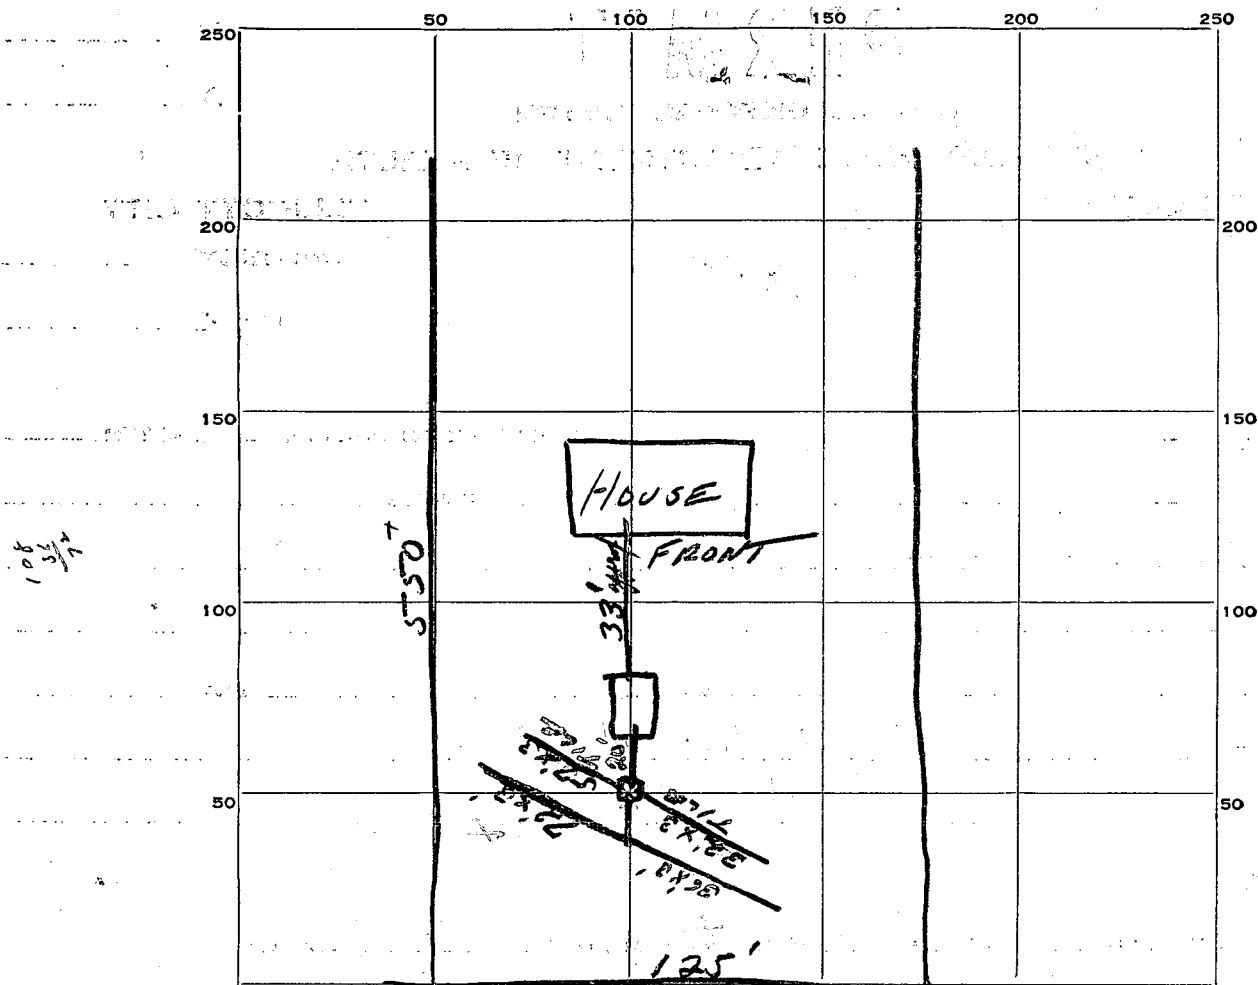

36
72
32
52
197
3
591

PERMIT CARD No

SEPTIC TANK, LEVEL Covered concrete 750 gal. CLEANOUTS Covered tank

DISTRIBUTION BOX, LEVEL _____

TILE FIELD, DEPTH _____ FT. TRENCH WIDTH 3 FT.

GRAVEL DEPTH _____ IN. TOTAL LENGTH 197 FT.

NUMBER OF TRENCHES 4 TOTAL BOTTOM AREA 591

SEEPAGE PITS, INSIDE DIAMETER _____ FT. DEPTH BELOW INLET _____ FT.

ABSORBENT AREA _____ SQ. FT.

REMARKS _____

DATE SYSTEM APPROVED 6-26-61 INSPECTOR J. Henniger

APPLICATION

SEWAGE DISPOSAL TESTING

A 03624

P 03693

MARYLAND STATE DEPARTMENT OF HEALTH

HOWARD COUNTY 750 Gallon Tank

ELLICOTT CITY

DISTRICT 5

DATE 4-25-61

installed no deeper than 3 ft below grade
Tile Field 5' x 70 sq ft bottom area

Place the tile field 30 ft to 70 ft
from the front lot line near the center
of the lot

TO: THE COUNTY HEALTH OFFICER
ELLICOTT CITY, MARYLAND

I, HEREBY, APPLY FOR THE NECESSARY TESTS IN ORDER TO CONSTRUCT (OR RECONSTRUCT) A SEWAGE
DISPOSAL SYSTEM.

PROPERTY OWNER Miles, Calvin

ADDRESS Burtonsville

PHONE Sp. 4-7802

PROPERTY LOCATION:

SUBDIVISION LOT NO.

ROAD AND DESCRIPTION Rt. 216 - at Fulton - approximately 1 1/2 miles above Scaggsville
on right side road 500---600-ft. about 200 yards north of Pindell School Rd.

OCCUPANT PHONE

PERSON TO CONSTRUCT SYSTEM

ADDRESS PHONE

SIZE OF LOT 125 x 550 ft. TYPE BLDG. 3
NUMBER OF BEDROOMS

IF NOT SINGLE RESIDENCE DESCRIBE

SIGNATURE OF APPLICANT

APPROVED BY

FOR

(KIND OF SYSTEM)

DATE

REJECTED BY

FOR

(KIND OF SYSTEM)


DATE

HOLD PENDING FURTHER TESTS

DATE

REASONS FOR REJECTION OR HOLDING

THIS IS NOT A PERMIT

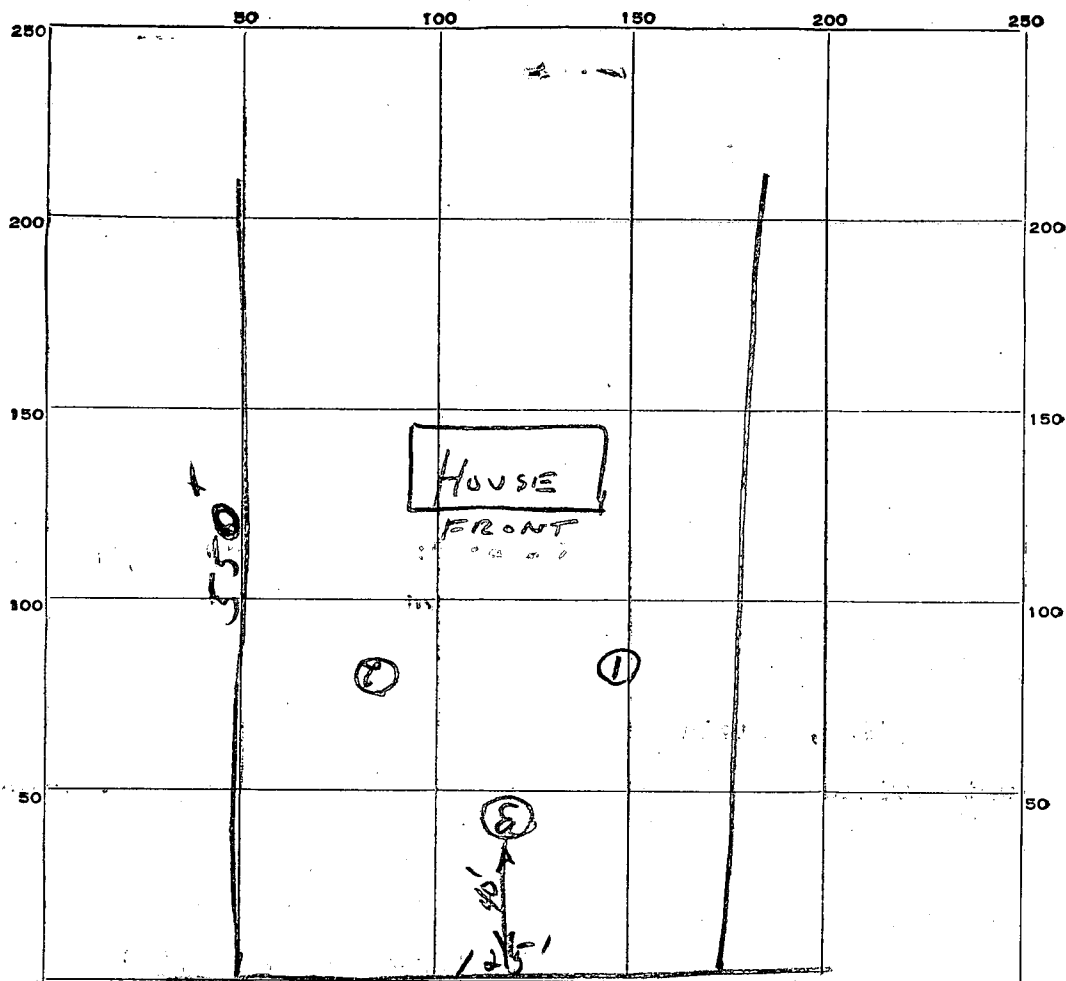

INDICATE NORTH. — NAME ADJOINING ROADWAY AS BASE LINE

BT. 216

[illegible]

SOIL AUGER FINDING

TESTED BY

REMARKS

ALSO PRESENT

LOT NO