

Tax ID-04-314891

File

O.P.C.O.

C.B.O.

PERMIT

SEWAGE DISPOSAL SYSTEM

DEPARTMENT OF HEALTH AND MENTAL HYGIENE

P 47921

A18354

A REPAIR

DISTRICT

DATE

2/10/92

DATE SYSTEM APPROVED

2/10/92

INSPECTOR

C.B.O.

HOWARD COUNTY HEALTH DEPARTMENT

BUREAU OF ENVIRONMENTAL HEALTH

461-9933

INDEXED

Jack Fyock

IS PERMITTED TO INSTALL ☒ ALTER ☒

ADDRESS

PHONE 988-9270

SUBDIVISION Gwenlee Estates

LOT 5

ROAD 3285 Sharp Road

PROPERTY OWNER

Bendon Terry Hammond
3285 Sharp Road

ADDRESS

SEPTIC TANK CAPACITY 1000 GALLONS

NUMBER OF BEDROOMS 3

125⁺ SQUARE FEET PER BEDROOM

LINEAR FEET OF TRENCH REQUIRED 54' +

REPAIR - PURPOSE - Drywell is overflowing. ✓

Call for inspection when ground is opened so sanitarian can recommend repair.

Recommend:

2/10/92 Trench (1) end opened to 11' at initial inspection.
 Note: { Trench 2' wide; 11' + with
 2' of stone in trench D. ok for trench off
 dry well. C.B.O. (See - over) →

PLANS APPROVED BY

C. Williams

DATE 2/04/92

COVER NO WORK UNTIL INSPECTED AND APPROVED

NEITHER THE HOWARD COUNTY COUNCIL NOR THE HEALTH DEPARTMENT IS RESPONSIBLE FOR THE SUCCESSFUL OPERATION OF ANY SYSTEM

NOTE: CLEANOUT REQUIRED EVERY 70 FEET OF SEWER LINE AND/OR AT 90° SWEEPS IN LINES FROM HOUSE TO DRAIN FIELDS, 90° ELBOWS NOT ACCEPTABLE.

NOTE: ALL PARTS OF SEPTIC SYSTEMS (I.E. TANK, DISTRIBUTION BOX TRENCHES) TO BE 100 FEET FROM WELL (UNLESS OTHERWISE SPECIFICALLY AUTHORIZED)

NOTE: IF DEEP TRENCH(ES) ARE USED CALL FOR INSPECTION BEFORE AND AFTER PLACING GRAVEL IN TRENCH(ES)

NOTE: NO DRY WELL SHALL EXCEED 15 FOOT IN DIAMETER NO ABSORPTION TRENCH TO EXCEED 100 FEET IN LENGTH

NOTE: ALL PIPE FROM HOUSE TO SEPTIC TANK MUST BE CAST IRON OR SCHEDULE 35/40 PVC OR ABS

PERMIT VOID AFTER TWO YEARS

NOTE: INSTALL STAND PIPE ON SEPTIC TANK AND DRY WELL STAND PIPES MUST BE 6 INCHES IN DIAMETER CAST IRON. CONCRETE OR TERRA COTTA OR PVA OR ABS ACCEPTED. IF TOP OF SEPTIC TANK IS DEEPER THAN 3 FEET. MANHOLE TO GRADE REQUIRED.


NOTE: DISTRIBUTION BOXES MUST HAVE BAFFLES

*INSTALLER IS RESPONSIBLE FOR OBTAINING FINAL APPROVAL ON THIS PERMIT

HD-260(6-90)

*CALL 461-9933 FOR INSPECTION OF SEPTIC SYSTEM.

47921

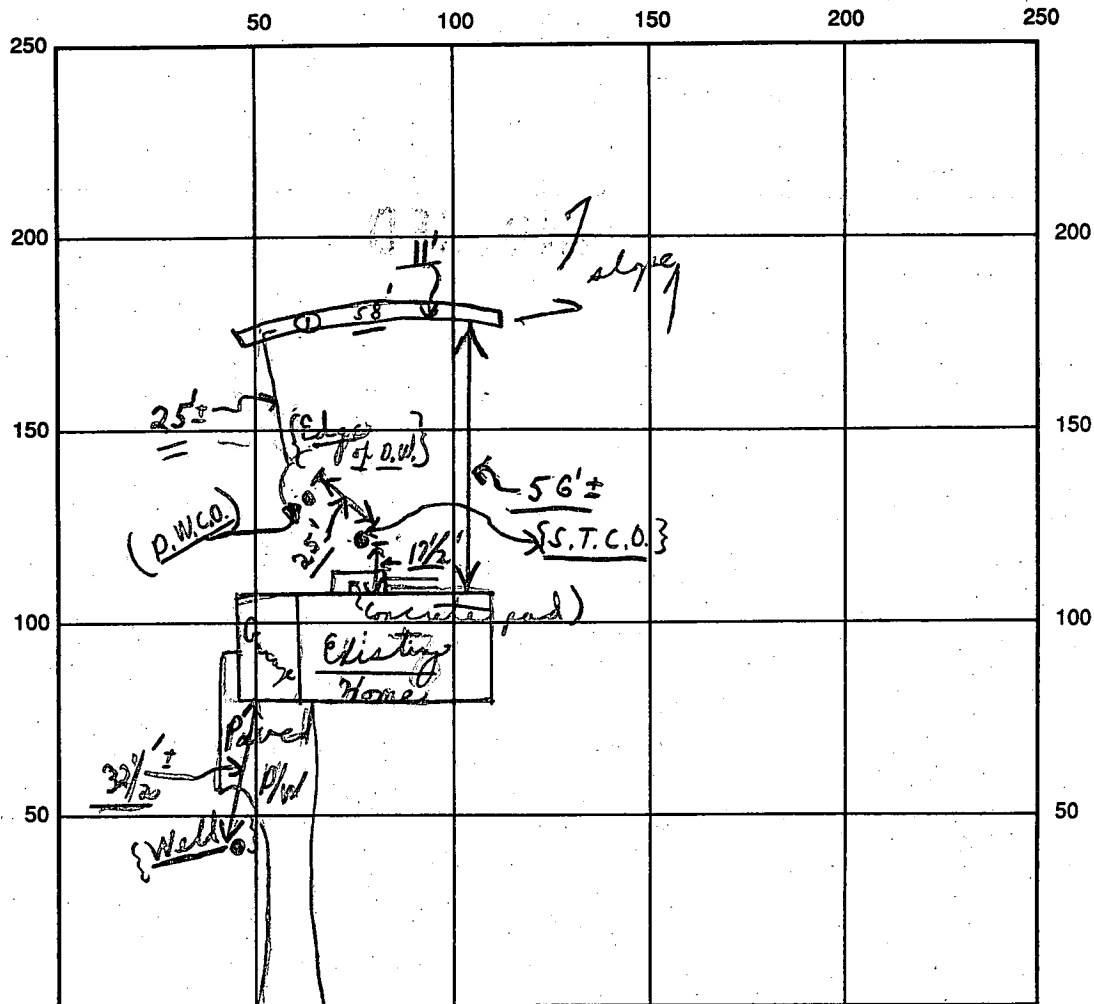

INDICATE NORTH - NAME ADJOINING ROADWAY AS BASE LINE

SEPTIC TANK LEVEL Existing SHARP ROAD Existing
 CLEANOUTS Existing
 DISTRIBUTION BOX LEVEL (Existing off dry well)
 DRAIN FIELD/TITLE DEPTH 11 ^{+(average)} FT. TRENCH WIDTH 2 FT. INLET DEPTH 4 FT.
 EFFECTIVE GRAVEL DEPTH 7 ^{average} FT. TOTAL LENGTH 58 ⁺ FT.
 NUMBER OF TRENCHES 1 ONE SIDEWALL/BOTTOM AREA 406 SQ. FT.
 DRYWELL INSIDE DIAMETER ↔ FT. EFFECTIVE DEPTH BELOW INLET ↔ FT.
 ABSORBENT AREA 406 SQ. FT.

REMARKS: 2/10/92 Partial - ok to continue; Note) line) from
septic tank to dry well covered; 3/10 Finish - ok to cover
as finish - material on site.
 C.B.

DATE SYSTEM APPROVED 2/10/92 INSPECTOR Charles Bryan Streater