

1/28/92
ATAP

Tax ID - 05 - 363993

PERMIT

SEWAGE DISPOSAL SYSTEM

DEPARTMENT OF HEALTH AND MENTAL HYGIENE

P 47922
A09328
A REPAIR

DISTRICT 5th

DATE 3/18/92

DATE SYSTEM APPROVED 1-28-92

INSPECTOR R. Bailey

HOWARD COUNTY HEALTH DEPARTMENT
BUREAU OF ENVIRONMENTAL HEALTH
461-9933

INDEXED

Jack Fyock

IS PERMITTED TO INSTALL _____ ALTER X

ADDRESS _____ PHONE 988-9270

SUBDIVISION Holiday Hills LOT 81, Sec. 6 ROAD 10830 Vista Road

PROPERTY OWNER Vince Pugliese

ADDRESS Columbia, MD. 21044

SEPTIC TANK CAPACITY 1250 GALLONS

NUMBER OF BEDROOMS 4

125 SQUARE FEET PER BEDROOM (Tied into existing Leaching bed)

LINEAR FEET OF TRENCH REQUIRED 80 (2 Trenches, 40 ft long each)

REPAIR - PURPOSE - TO REPAIR EXISTING, FAILING SEPTIC SYSTEM.

CALL FOR INSPECTION WHEN GROUND IS OPENED SO SANITARIAN CAN RECOMMEND REPAIR.

Trenches 10 ft deep below original grade; 2 ft wide; 3 ft inlet, 2 ft of stone
fill. = 560 sq ft about area over req - R. Bailey 1-28-92

PLANS APPROVED BY Craig Williams DATE 1/21/92

COVER NO WORK UNTIL INSPECTED AND APPROVED

NEITHER THE HOWARD COUNTY COUNCIL NOR THE HEALTH DEPARTMENT IS RESPONSIBLE FOR THE SUCCESSFUL OPERATION OF ANY SYSTEM

NOTE: CLEANOUT REQUIRED EVERY 70 FEET OF SEWER LINE AND/OR AT 90° SWEEPS IN LINES FROM HOUSE TO DRAIN FIELDS, 90° ELBOWS NOT ACCEPTABLE.

NOTE: ALL PARTS OF SEPTIC SYSTEMS (I.E. TANK, DISTRIBUTION BOX TRENCHES) TO BE 100 FEET FROM WELL (UNLESS OTHERWISE SPECIFICALLY AUTHORIZED)

NOTE: IF DEEP TRENCH(ES) ARE USED CALL FOR INSPECTION BEFORE AND AFTER PLACING GRAVEL IN TRENCH(ES)

NOTE: NO DRY WELL SHALL EXCEED 15 FOOT IN DIAMETER NO ABSORPTION TRENCH TO EXCEED 100 FEET IN LENGTH

NOTE: ALL PIPE FROM HOUSE TO SEPTIC TANK MUST BE CAST IRON OR SCHEDULE 35/40 PVC OR ABS

PERMIT VOID AFTER TWO YEARS

NOTE: INSTALL STAND PIPE ON SEPTIC TANK AND DRY WELL STAND PIPES MUST BE 6 INCHES IN DIAMETER CAST IRON. CONCRETE OR TERRA COTTA OR PVA OR ABS ACCEPTED. IF TOP OF SEPTIC TANK IS DEEPER THAN 3 FEET. MANHOLE TO GRADE REQUIRED.

NOTE: DISTRIBUTION BOXES MUST HAVE BAFFLES

***INSTALLER IS RESPONSIBLE FOR OBTAINING FINAL APPROVAL ON THIS PERMIT**

47922


Trench 1

Dark Brn
h. loam
somewhat
micaceous
moist

2 1/2'

Too loose
Pine Sandy
Loam
(No rocks
seen)
Soil dry

11'

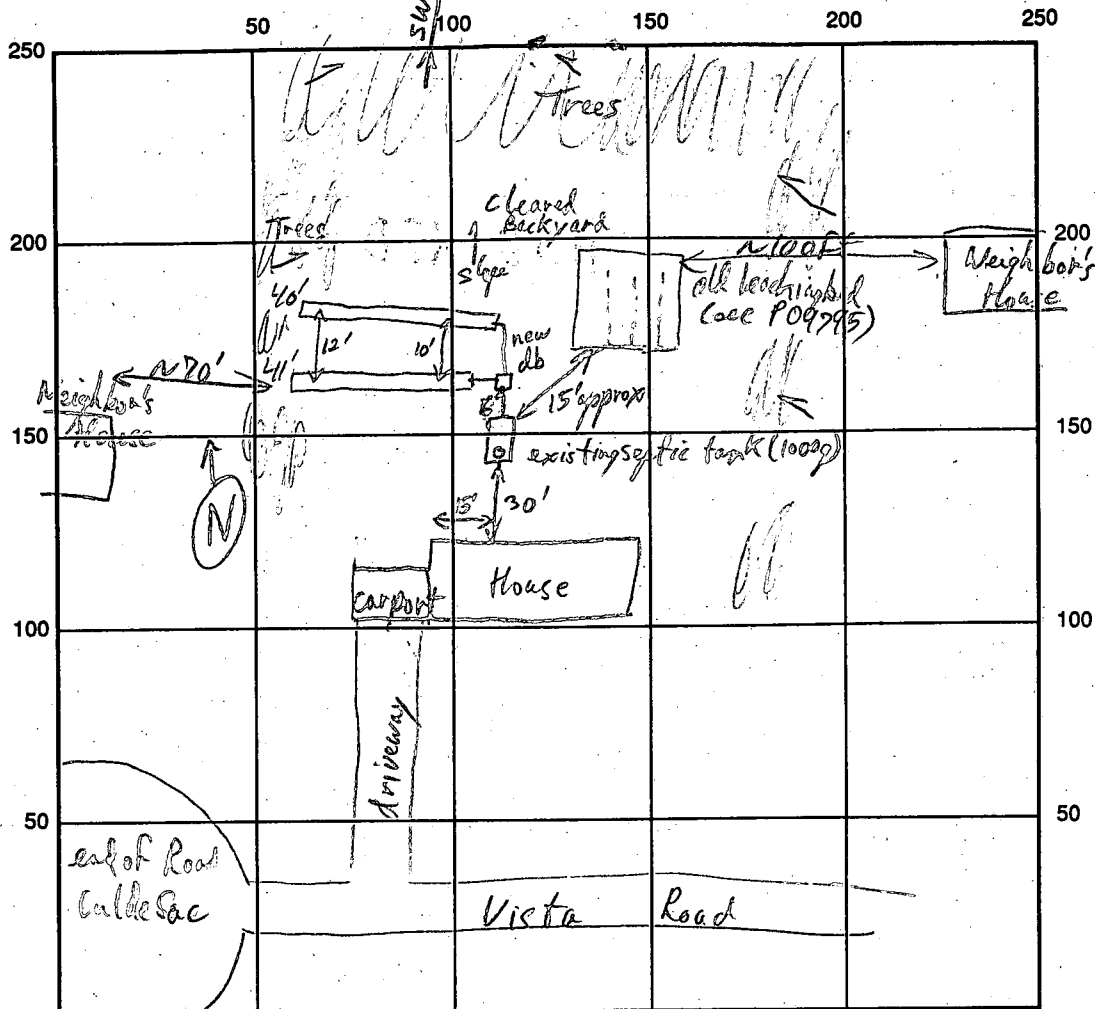

INDICATE NORTH - NAME ADJOINING ROADWAY AS BASE LINE

SEPTIC TANK LEVEL existing 1000 gal (Baffle still) CLEANOUTS existing Terra cotta tank inlet

DISTRIBUTION BOX LEVEL Small 3 hole db (2 1/2 ft cover over box)

DRAIN FIELD/TITLE DEPTH 10' (11 ft below final grade) TRENCH WIDTH 2 FT. INLET DEPTH 3 FT.

EFFECTIVE GRAVEL DEPTH 7 FT. TOTAL LENGTH 40/41 FT.

NUMBER OF TRENCHES 2 ^{Total} ONE SIDEWALL/BOTTOM AREA 567 SQ. FT.

DRYWALL INSIDE DIAMETER _____ FT. EFFECTIVE DEPTH BELOW INLET _____ FT.

ABSORBENT AREA _____ SQ. FT.

REMARKS: Replacing old orangeburg plastic supply line to backing hole with schedule 35 PVC.

New Dist box will favor new trenches with old bed as overflow standby.

OK to proceed when finish laying pipe in last trench. R/P 1-28-92

DATE SYSTEM APPROVED

1-28-92

INSPECTOR

Paul R. R. R.

PERMIT

SEWAGE DISPOSAL SYSTEM

MARYLAND STATE DEPARTMENT OF HEALTH

HOWARD COUNTY

ELLICOTT CITY

DISTRICT 5

DATE 3/19/65

P 09795

A 09328

INDEXED

Frank Robbins

IS PERMITTED TO INSTALL ☒ ALTER

ADDRESS 112 Hunting Lane, Simpsonville, Md. PHONE AT 6-2534

A SEWAGE DISPOSAL-SYSTEM LOCATED AT

SUBDIVISION Holiday Hills ROAD Vista LOT 81, Sec. 6

PROPERTY OWNER same as above

ADDRESS

SPECIFICATIONS - 4 bedrooms

DRAIN FIELD DEPTH FEET, BOTTOM AREA SQ. FT.

SEEPAGE PITS ABSORBENT SIDE-WALL AREA SQ. FT.

SEPTIC TANK CAPACITY 1,000 GALLONS

FOR GARBAGE GRINDER, INCREASE DISPOSAL AREA 22% & TANK CAPACITY 50%.

OTHER Leaching Bed - 25 ft. long by 20 ft. wide located 155 ft. from the front property line and 31 ft. off the right side property line as seen when facing the lot from Vista Road. Depth of bed 5 ft. on shallow side.


NOTE: CALL FOR INSPECTION OF LEACHING BED EXCAVATION BEFORE ANY GRAVEL IS INSTALLED.

PLANS APPROVED BY J. Hennigan DATE 11/5/64

FILL SEPTIC TANK AND DISTRIBUTION BOX WITH WATER BEFORE CALLING FOR AN INSPECTION. COVER NO WORK UNTIL INSPECTED AND APPROVED.

NEITHER THE HOWARD COUNTY COMMISSIONERS NOR THE HEALTH DEPARTMENT IS RESPONSIBLE FOR THE SUCCESSFUL OPERATION OF ANY SYSTEM.

A 09328

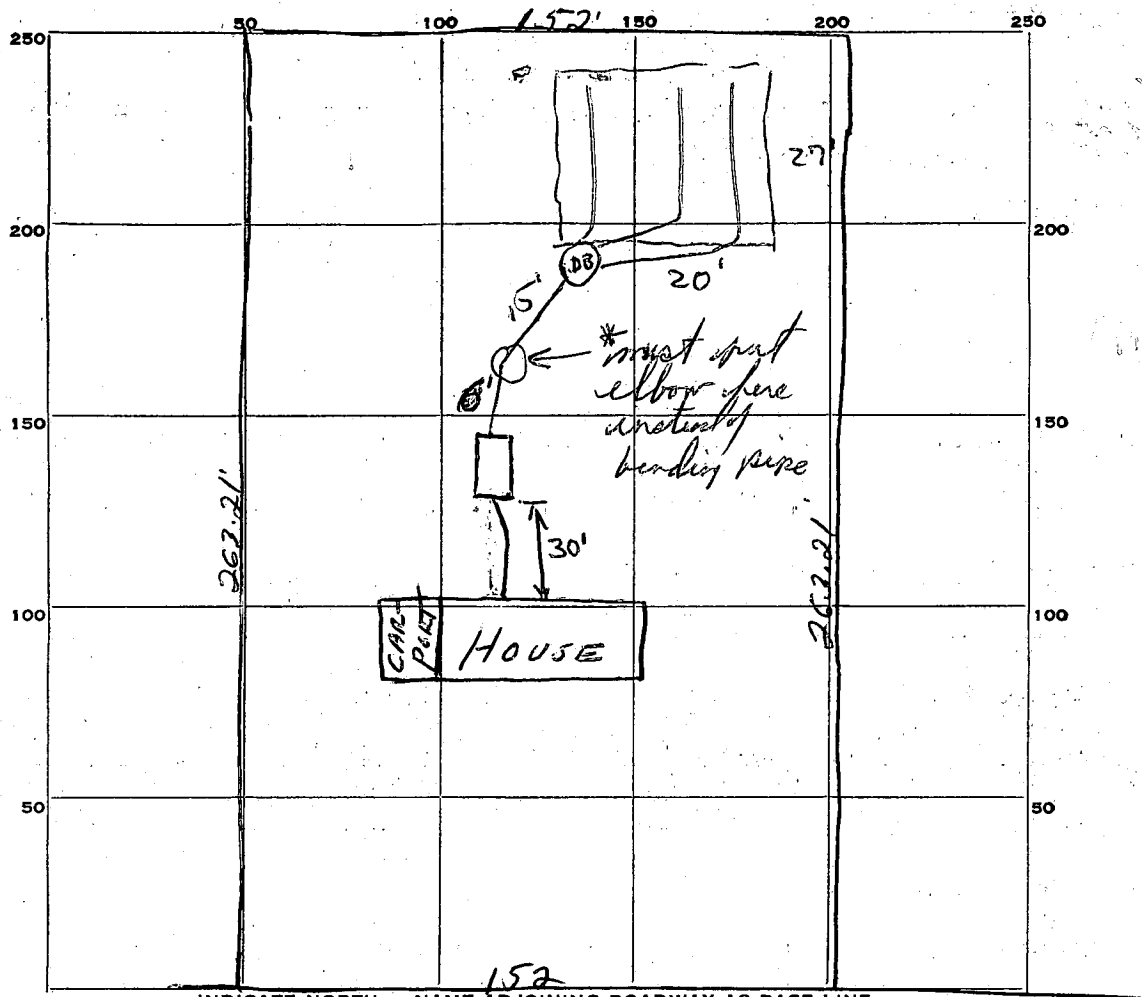

PERMIT CARD

SEPTIC TANK, LEVEL Concrete 100 gal.

CLEANOUTS

DISTRIBUTION BOX, LEVEL

TILE FIELD, DEPTH _____ FT. TRENCH WIDTH _____ FT.

GRAVEL DEPTH _____ IN. TOTAL LENGTH _____ FT.

NUMBER OF TRENCHES _____ TOTAL BOTTOM AREA _____

SEEPAGE PITS, INSIDE DIAMETER _____ FT. DEPTH BELOW INLET _____ FT.

ABSORBENT AREA _____ SQ. FT.

REMARKS 3-24-65 Sandy soil in bottom bed area. Depth 5 FT
on shallow side. J.H.

3/24/65 - No further work completed - R.F.

4/5/65 - needs elbow where noted - R.F.

cover except for area where elbow is to be put in -

4/6/65 - Elbow in - R.F.

DATE SYSTEM APPROVED 4/6/65

INSPECTOR

R.F. Fletcher

APPLICATION

A 09328

P

SEWAGE DISPOSAL TESTING

MARYLAND STATE DEPARTMENT OF HEALTH

HOWARD COUNTY

ELLICOTT CITY

DISTRICT 5

DATE 10/28/64

*Soaking bed 25 ft. long by 20 ft. wide
located 155 ft. from the front property
line and 31 ft. off the right side property
line as seen when facing the lot from Vista road.
Depth of bed 5 ft. on shallow side.*

TO: THE COUNTY HEALTH OFFICER
ELLICOTT CITY, MARYLAND

1000 gal septic tank.

I, HEREBY, APPLY FOR THE NECESSARY TESTS IN ORDER TO CONSTRUCT (OR RECONSTRUCT) A SEWAGE DISPOSAL SYSTEM.

PROPERTY OWNER Frank W. Robbins

ADDRESS 112 Hunting Lane, Simpsonville, Maryland PHONE AT 6-2534

PROPERTY LOCATION:

SUBDIVISION Holiday Hills LOT NO. 81, Sec. 6

ROAD AND DESCRIPTION Vista Rd.

OCCUPANT _____ PHONE _____

PERSON TO CONSTRUCT SYSTEM _____

ADDRESS _____ PHONE _____

SIZE OF LOT 1 acre TYPE BLDG. 34

NUMBER OF BEDROOMS

IF NOT SINGLE RESIDENCE DESCRIBE _____

SIGNATURE OF APPLICANT /s/ Mildred Robbins

APPROVED BY J. Hearnigan FOR Soaking bed DATE 11-5-64

(KIND OF SYSTEM)


REJECTED BY _____ FOR _____ DATE _____

(KIND OF SYSTEM)

HOLD PENDING FURTHER TESTS _____ DATE _____

REASONS FOR REJECTION OR HOLDING _____

THIS IS NOT A PERMIT

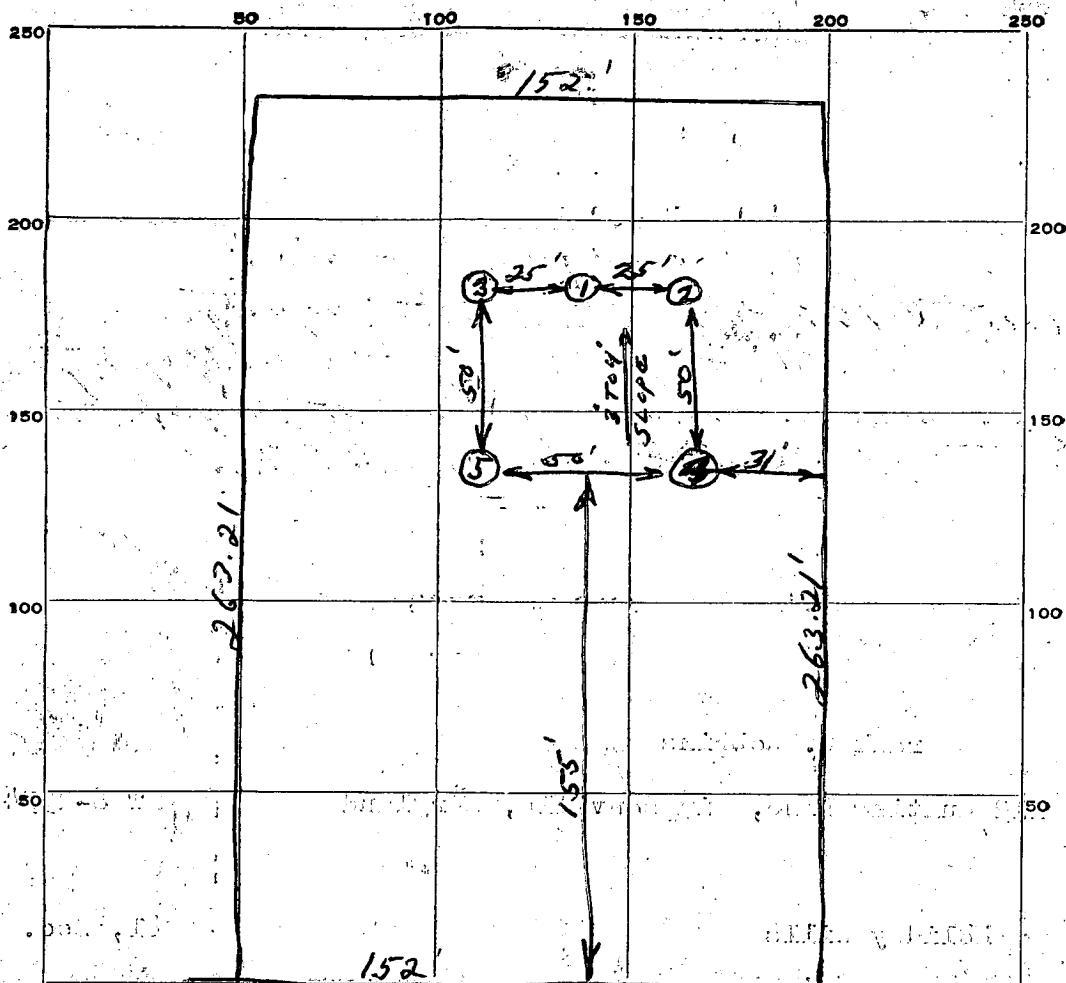

INDICATE NORTH. - NAME ADJOINING ROADWAY AS BASE LINE.

Vista Road

DATE	TEST NO.	DEPTH	PRE-WET		TEST - 1" DROP		TIME
			START	STOP	START	STOP	
11-5-64	1	10'	12:55	12:57	12:57	1:02	5 Min no water
	2	5'	1:26	1:30	1:30	1:35	5 Min
	3	7 1/2'	1:30	Slow overtime			
	4	9	1:39	1:48	1:48	2:08	20 Min
	5	1	1:57	2:00	2:00	2:05	5 Min

SOIL AUGER FINDING

TESTED BY

REMARKS

11-5-64

ALSO PRESENT

Depth of bed 5 FT on shallow side

F. W. Robbins

LOT NO. 81 sec 6

STATE OF MARYLAND
DEPARTMENT OF WATER RESOURCES
State Office Building
ANNAPOLIS, MARYLAND 21401

20.200

APPLICATION FOR PERMIT TO DRILL WELL

An application must be submitted and permit received before drilling a well

Owner Frank Robbins Driller Edward Brown License Number 177
Street or R. F. D. R. 3, Mt. Airy, Md.
Post Office Atherton, Md. Date 3/26/65

Quantity of Water to be Produced 3 G.P.M.
Total Quantity Needed For Use 350 G.P.D.
Use for Water Home
Approximate Depth of Well (feet) 90
Method of Drilling to be used Rotary

Location of Well
County Howard
Nearest Town Atherton
Distance from Town 3 mile
Direction from Town West

PERMIT TO DRILL WELL
(Permit to be returned to Driller)

NOT TO BE FILLED IN BY DRILLER

Permit No. Ho-65-W-364

Samples of Cuttings
Required by Department ☒ Yes ☐ No

Owner Requires Permit
to Appropriate Water ☒ Yes ☐ No

Owner Has Permit
to Appropriate Water ☒ Yes ☐ No

The applicant is herewith granted a permit to drill this well
subject to the conditions stipulated.

Paul W. McKee

Director

Date 3-3-65

Special conditions that may apply:

Description of Location of Well

(This information should be definite enough to permit
locating well on a county map).

Near what road RT. 29On which side of road North
(North, East, South, West)

Distance from road

Draw a sketch below showing location of well in relation
to nearby towns, roads and streams with north in the
direction of the arrow, and give distance from well to
nearest road junction or stream crossing shown on the
sketch.

NORTH

Holiday Hills Sub.
Lot 81
Section 6

Health Department Approval of Application

Howard County Department of Healthor ☐ State Department of HealthApproved by Philip F. WilsonTitle Chief SanitarianDate 3/26/65