

PERMIT

SEWAGE DISPOSAL SYSTEM

MARYLAND STATE DEPARTMENT OF HEALTH

HOWARD COUNTY

ELLICOTT CITY

DISTRICT 5DATE 7/14/64

INDEXED

Elwood ScaggsIS PERMITTED TO INSTALL X ALTERADDRESS Laurel, Maryland

PHONE _____

A SEWAGE DISPOSAL SYSTEM LOCATED AT _____

SUBDIVISION Kings ManorROAD Pindell School Rd. LOT 8PROPERTY OWNER Richard Burton11901 Queen St.ADDRESS RFD 1 - LaurelSPECIFICATIONS 4 bedrooms

DRAIN FIELD _____ DEPTH _____ FEET, BOTTOM AREA _____ SQ. FT.

SEEPAGE PITS _____ ABSORBENT SIDE-WALL AREA _____ SQ. FT.

SEPTIC TANK CAPACITY 1000 GALLONS

FOR GARBAGE GRINDER, INCREASE DISPOSAL AREA 22% & TANK CAPACITY 50%.

OTHER Dry well - 400 sq. ft. side wall area to begin below inlet pipe.
Inlet pipe must be 4 ft. below original grade.
Place dry well about 33 ft. from front lot line and about 33 ft.
from left side as seen when facing lot from Queen St.


PLANS APPROVED BY D. W. MonaghanDATE 2/13/64

FILL SEPTIC TANK AND DISTRIBUTION BOX WITH WATER BEFORE CALLING FOR AN INSPECTION. COVER NO WORK UNTIL INSPECTED AND APPROVED.

NEITHER THE HOWARD COUNTY COMMISSIONERS NOR THE HEALTH DEPARTMENT IS RESPONSIBLE FOR THE SUCCESSFUL OPERATION OF ANY SYSTEM.

48193-D
A-08021

3.14
 13
 942
 314
 4082

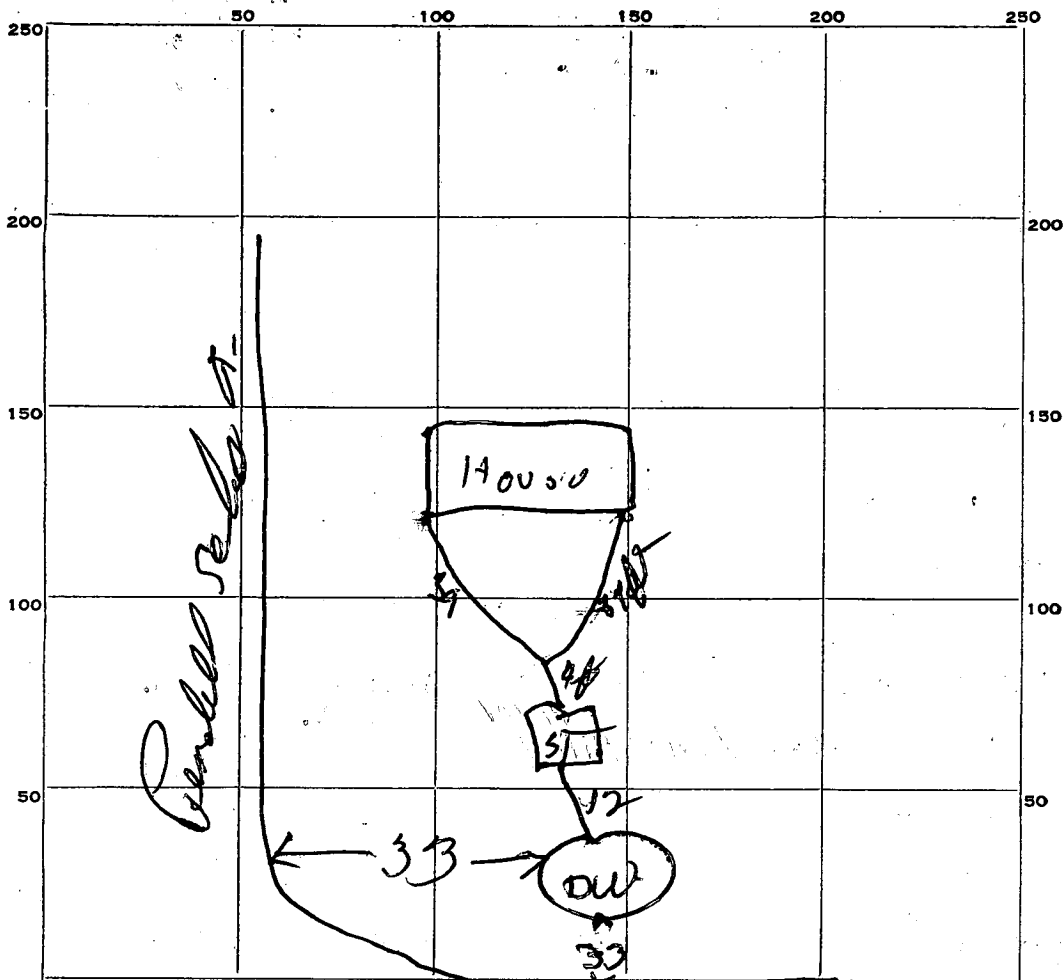

INDICATE NORTH. NAME ADJOINING ROADWAY AS BASE LINE.

PERMIT CARD OK

SEPTIC TANK, LEVEL OK

CLEANOUTS OK

DISTRIBUTION BOX, LEVEL _____

TILE FIELD, DEPTH _____ FT. TRENCH WIDTH _____ FT.

GRAVEL DEPTH _____ IN. TOTAL LENGTH _____ FT.

NUMBER OF TRENCHES _____ TOTAL BOTTOM AREA _____

SEEPAGE PITS, INSIDE DIAMETER 12 FT. DEPTH BELOW INLET 10 FT.

ABSORBENT AREA 376 SQ. FT.

REMARKS 8/14/64 Wall to wall diameter 13ft x 10ft depth = 408.2 sq ft

DATE SYSTEM APPROVED 8/14/64

INSPECTOR Dev. Manager

APPLICATION

SEWAGE DISPOSAL TESTING

MARYLAND STATE DEPARTMENT OF HEALTH

A 08021

P _____

HOWARD COUNTY

ELLICOTT CITY

DISTRICT 5

DATE 2-10-64

Septic Tank - ¹⁰⁰⁰~~750~~ gal
4' 0"

Dry Well - ~~500~~ sq. ft. sidewall area to begin below inlet pipe. Inlet pipe must be 4' ϕ below original grade.

Place Dry Well about 33 ft from front lot line and about 33 ft from left side as seen from facing lot from E. 50'

TO: THE COUNTY HEALTH OFFICER
ELLICOTT CITY, MARYLAND

I, HEREBY, APPLY FOR THE NECESSARY TESTS IN ORDER TO CONSTRUCT (OR RECONSTRUCT) A SEWAGE DISPOSAL SYSTEM.

PROPERTY OWNER

Richard Burton

ADDRESS

RFD 1 Laurel

PHONE _____

PROPERTY LOCATION:

SUBDIVISION

Kings Manor

LOT NO.

8

ROAD AND DESCRIPTION

Pindell School Rd & Queen St.

OCCUPANT

PHONE _____

PERSON TO CONSTRUCT SYSTEM

ADDRESS

PHONE _____

SIZE OF LOT

1 acre

TYPE BLDG.

4

NUMBER OF BEDROOMS

IF NOT SINGLE RESIDENCE DESCRIBE _____

SIGNATURE OF APPLICANT

David Seagrass

APPROVED BY

W. Monaghan

FOR

Dry Well
(KIND OF SYSTEM)

DATE

2/13/64

REJECTED BY

FOR

(KIND OF SYSTEM)


DATE

HOLD PENDING FURTHER TESTS

DATE

REASONS FOR REJECTION OR HOLDING

THIS IS NOT A PERMIT

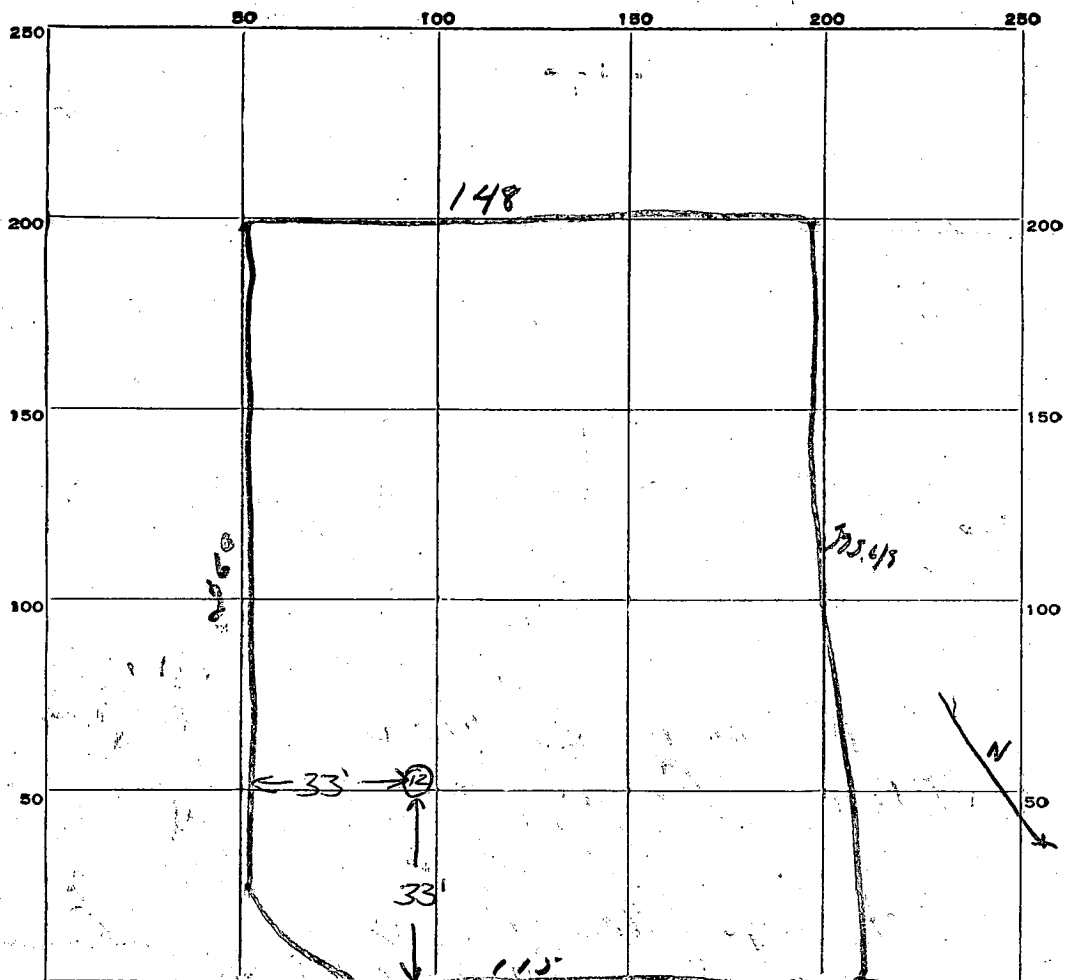

INDICATE NORTH - NAME ADJOINING ROADWAY AS BASE LINE.

DATE	TEST NO.	DEPTH	PRE-WET		TEST - 1" DROP		TIME
			START	STOP	START	STOP	
2/13/64	1	9 1/4'	9:55	9:56	9:56	10:02	6 min.
2/13/64	2	4 1/2'	9:55	10:00	10:00	10:05	5 min.

SOIL AUGER FINDING

TESTED BY RDF DWM 2/13/64

REMARKS

ALSO PRESENT Elwood Slaggs LOT NO. 8

J.W. - per your request

7/13/92

LOUIS RILEY
11901 QUEEN ST.
Fulton RE PONTIS

ORIGINAL WELL KEPT FOR ILLUMINATION

EASTERN DAY MADE SEPARATE CONNECTION EAST DAY
7-1092

Cy-

New well Hb-92-0094

REPLACEMENT WELL SITE INSPECTION

OWNER Louis Riley ³⁰¹ 953-2494

DATE REQUESTED 6/16/92

ADDRESS 11901 DUGGON ST

DRILLER EASTEN DAY


KINGS MANOR LOT 8?

WELL TAG#

CORNER DUGGON ST + PINDALL SCHOOL RD

COUNTY# A08021

LOCATION DIAGRAM

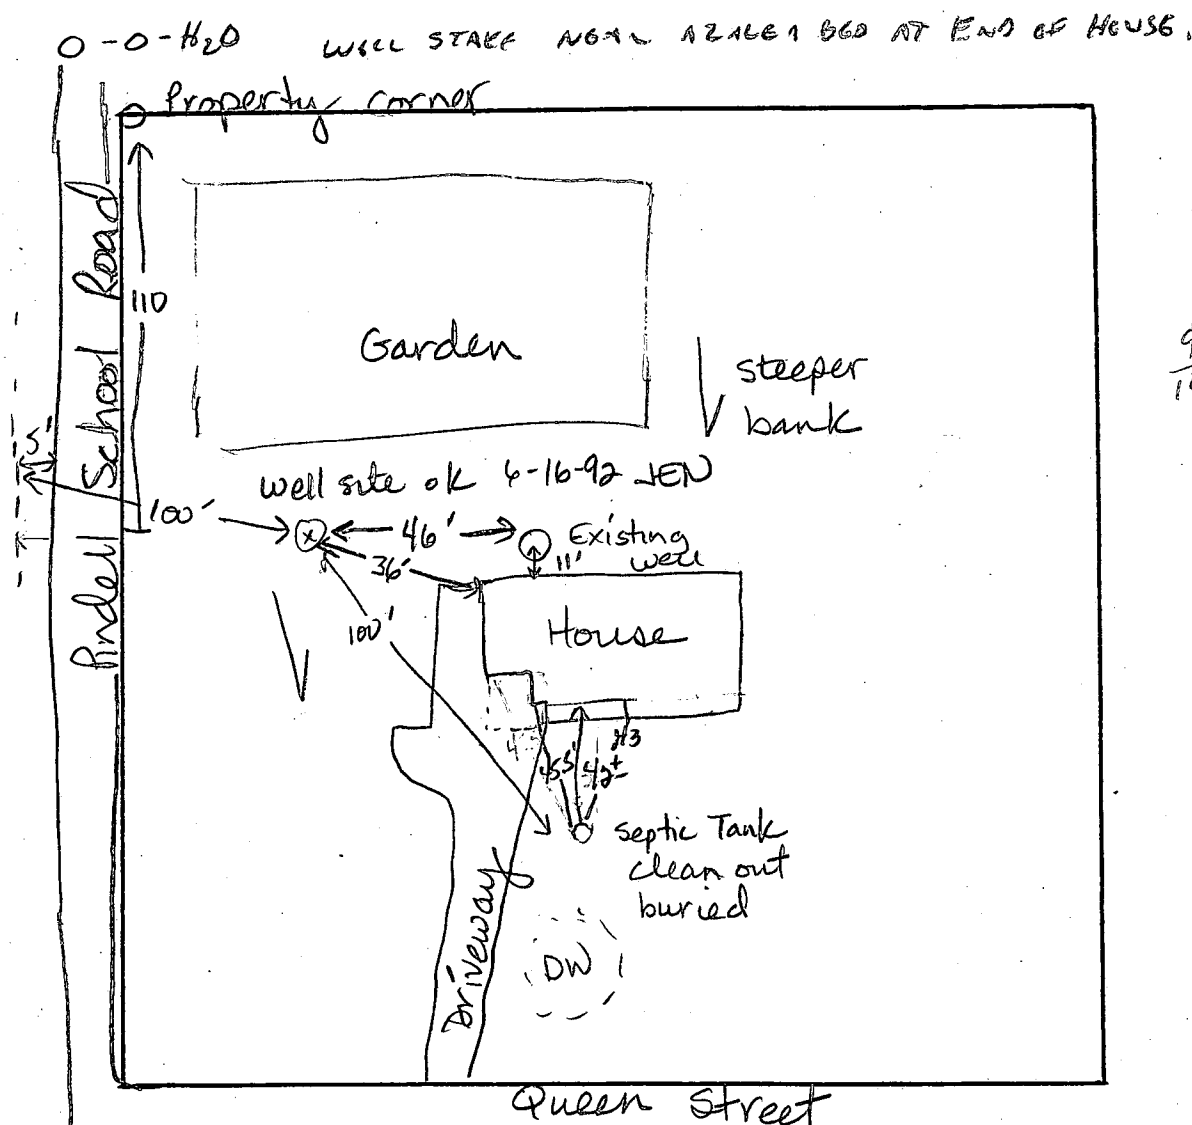

7
45
2.4
980
10

COMMENTS:

6-16-92 Existing well has iron removal filter & acid neutralizer in place. Not enough water for laundry. All facilities cut back to minimum use. Would like to keep existing well for irrigation use. JEN Haden