

PERMIT

SEWAGE DISPOSAL SYSTEM

DEPARTMENT OF HEALTH AND MENTAL HYGIENE

INDEXED

HOWARD COUNTY HEALTH DEPARTMENT

BUREAU OF ENVIRONMENTAL HEALTH

~~XXXXXX~~

313-2640

P 58592 B

A 48631

DISTRICT 4th

DATE 7-31-97

DATE SYSTEM APPROVED 10/1/97

INSPECTOR DKS

South Carroll Backhoe, Inc.

IS PERMITTED TO INSTALL ☒ ALTER

ADDRESS 4410 Salem Bottom Road Westminster, MD 21157 PHONE (410) 875-4197

SUBDIVISION Gwyndyl Oak Estates LOT 4 ROAD 2813 Rolling Fork Way

PROPERTY OWNER NV Homes

ADDRESS

SEPTIC TANK CAPACITY 1250 GALLONS

NUMBER OF BEDROOMS 4

180 SQUARE FEET PER BEDROOM

LINEAR FEET OF TRENCH REQUIRED 180

TRENCHES - Trench to be 2 feet wide. Inlet 3 feet below original grade. Bottom maximum depth 7 feet below original grade. Effective area begins at 3 feet below original grade. 4 feet of stone below distribution pipe.

LOCATION - Place distribution box 165 feet up the left lot line (415.22') and 10 feet off that same lot line when facing the lot from Rolling Fork Way. Run trenches on contour toward the right lot line.

NOTES - No trench to exceed 100 feet in length. Provide 6" - 8" diameter cleanout and cap to grade or above on the septic tank. KM OK 12/18/96

PLANS APPROVED BY Amy McMillen? Donna K. Soe

DATE 12/08/94

COVER NO WORK UNTIL INSPECTED AND APPROVED

NEITHER THE HOWARD COUNTY COUNCIL NOR THE HEALTH DEPARTMENT IS RESPONSIBLE FOR THE SUCCESSFUL OPERATION OF ANY SYSTEM

NOTE: CLEANOUT REQUIRED EVERY 70 FEET OF SEWER LINE AND/OR AT 90° SWEEPS IN LINES FROM HOUSE TO DRAIN FIELDS, 90° ELBOWS NOT ACCEPTABLE.

NOTE: ALL PARTS OF SEPTIC SYSTEMS (I.E. TANK, DISTRIBUTION BOX TRENCHES) TO BE 100 FEET FROM WELL (UNLESS OTHERWISE SPECIFICALLY AUTHORIZED)

NOTE: IF DEEP TRENCH(ES) ARE USED CALL FOR INSPECTION BEFORE AND AFTER PLACING GRAVEL IN TRENCH(ES)

NOTE: NO DRY WELL SHALL EXCEED 15 FOOT IN DIAMETER NO ABSORPTION TRENCH TO EXCEED 100 FEET IN LENGTH


NOTE: ALL PIPE FROM HOUSE TO SEPTIC TANK MUST BE CAST IRON OR SCHEDULE 35/40 PVC OR ABS

PERMIT VOID AFTER TWO YEARS

NOTE: INSTALL STAND PIPE ON SEPTIC TANK AND DRY WELL STAND PIPES MUST BE 6 INCHES IN DIAMETER CAST IRON, CONCRETE OR TERRA COTTA OR PVA OR ABS ACCEPTED. IF TOP OF SEPTIC TANK IS DEEPER THAN 3 FEET, MANHOLE TO GRADE REQUIRED.

NOTE: DISTRIBUTION BOXES MUST HAVE BAFFLES

*INSTALLER IS RESPONSIBLE FOR OBTAINING FINAL APPROVAL ON THIS PERMIT

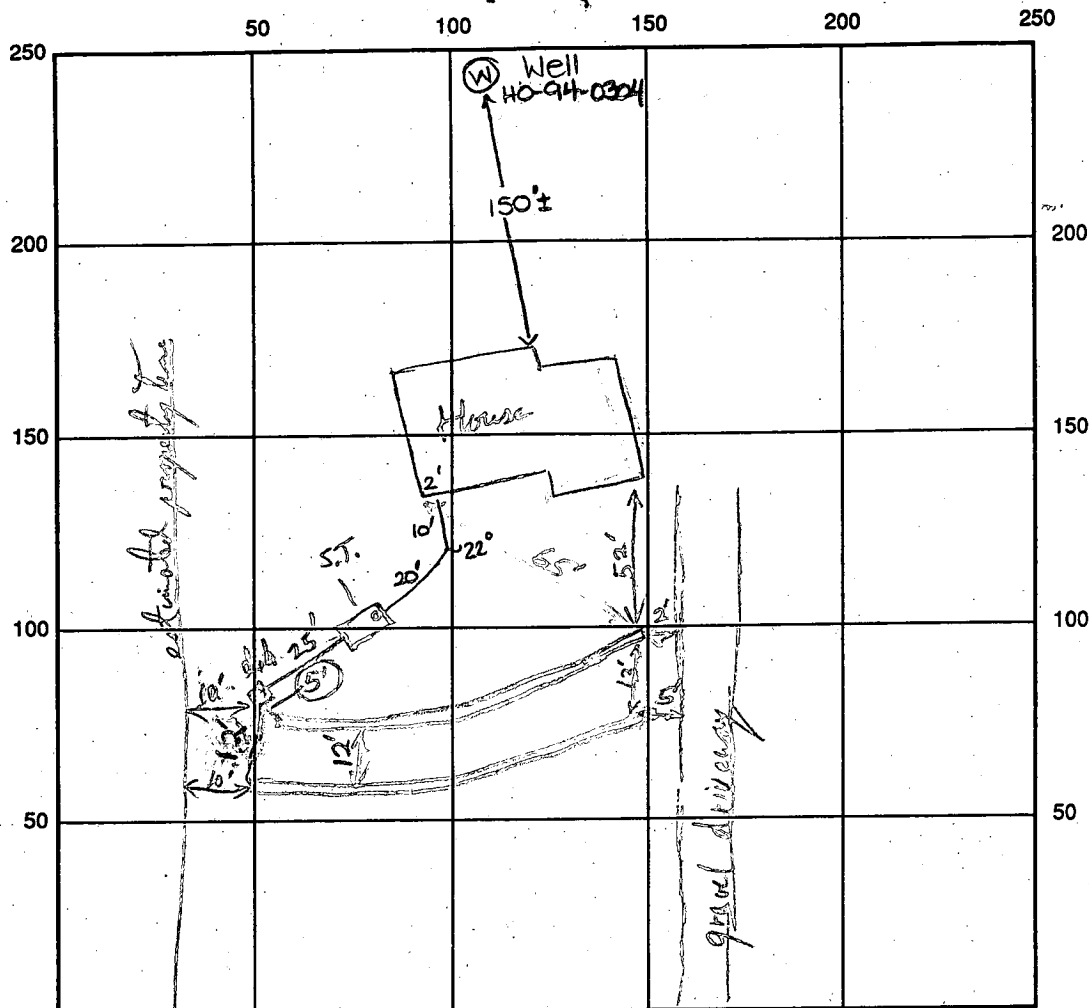

INDICATE NORTH - NAME ADJOINING ROADWAY AS BASE LINE

Rolling Fork Way

SEPTIC TANK LEVEL 1500 gal

CLEANOUTS Not seen - power into over access to Wilson St.

DISTRIBUTION BOX LEVEL OK Earthbox

DRAIN FIELD/TITLE DEPTH 2 FT.

TRENCH WIDTH 2 FT.

INLET DEPTH 3 FT.

EFFECTIVE GRAVEL DEPTH 4 FT.

TOTAL LENGTH 90/90 FT. = 180 LF

NUMBER OF TRENCHES 2

ONE SIDEWALL/BOTTOM AREA 540 SQ. FT.

DRYWALL INSIDE DIAMETER _____ FT.

EFFECTIVE DEPTH BELOW INLET _____ FT.

ABSORBENT AREA _____ SQ. FT.

REMARKS: 9/9/97 OK TO CONTINUE WORK - NO HOUSE CONNECTION,
NO SEPTIC TANK YET. DKS OK to cover the tank after placing cleanout pipe
OK to cover Trenches & dig for & place piping when finish graveling, paving lot Trench.
Call for House I inspection 9/11/97

10/1/97 House connection OK. DKS
WPT - filter cloth OK at 4 1/2 ft - note water in gravel cover 9/11/97

DATE SYSTEM APPROVED 10/1/97 INSPECTOR DAVID B. BOK

APPLICATION

PERCOLATION TESTING

A 48431

P _____

HOWARD COUNTY HEALTH DEPARTMENT

BUREAU OF ENVIRONMENTAL HEALTH

3525-H ELLICOTT MILLS DRIVE/ELLICOTT CITY, MARYLAND 21043
TELEPHONE: 313-2640

DISTRICT _____

DATE 10-22-92

TO: THE COUNTY HEALTH OFFICER
ELLICOTT CITY, MARYLAND

I HEREBY APPLY FOR THE NECESSARY TEST PRIOR TO APPLICATION FOR PERMIT TO CONSTRUCT (OR RECONSTRUCT) A SEWAGE DISPOSAL SYSTEM.

PROPERTY OWNER PETTIT & GRIFFIN INC. NV Homes

ADDRESS 18205-D FLOWER HILL WAY PHONE (301) 975-1020
GAITHERSBURG MARYLAND 20879

AGENT OR PROSPECTIVE BUYER _____

ADDRESS _____ PHONE _____

PROPERTY LOCATION:

SUBDIVISION McKendree estates LOT NO. ~~NEW~~ 4 (9/15/93)

ROAD AND DESCRIPTION McKendree Road
(2813 Rolling Fork Way)

TAX MAP 14 PARCEL # 123

SIZE OF LOT 40,000[#] - 60,000[#] TYPE BLDG. SINGLE FAMILY DWELLING
(SINGLE FAMILY DWELLING OR COMMERCIAL)

BLDG. PERMIT SIGNED

~~AND RETURNED~~ 12/16/96

Serial # B7103366
SFD-4Bm

THE SYSTEM INSTALLED UNDER THIS APPLICATION IS ACCEPTABLE ONLY UNTIL PUBLIC FACILITIES BECOME AVAILABLE. I FULLY UNDERSTAND THE
FEE CONNECTED WITH THE FILING OF THIS PERC TEST APPLICATION IS NON-REFUNDABLE UNDER ANY CIRCUMSTANCES. I ALSO AGREE TO
COMPLY WITH ALL M.O.S.H.A. REQUIREMENTS IN TESTING THIS LOT. Zacharia y. fisch (agent)

(SIGNATURE OF APPLICANT)

APPROVED BY _____ FOR _____ DATE _____

DISAPPROVED BY _____ FOR _____ DATE _____

HOLD PENDING FURTHER TESTS _____

REASONS FOR REJECTION OR HOLDING 11/13/96 Perc OK Hold for Plat B17

PERCOLATION TEST PLAT/PRELIMINARY PLAT - TITLE OR I.D. # _____ DATE _____

SITE DEVELOPMENT PLAN/FINAL PLAT - TITLE OR I.D. # _____ DATE _____

THIS IS NOT A PERMIT

48631

Lot 3

NEW 4(9/15/93)


COUNTY #

SOIL PROFILE (4)

0' TOPSOIL
RED CLAY

3' PINK
BROWN
SAND
LOAM

13'

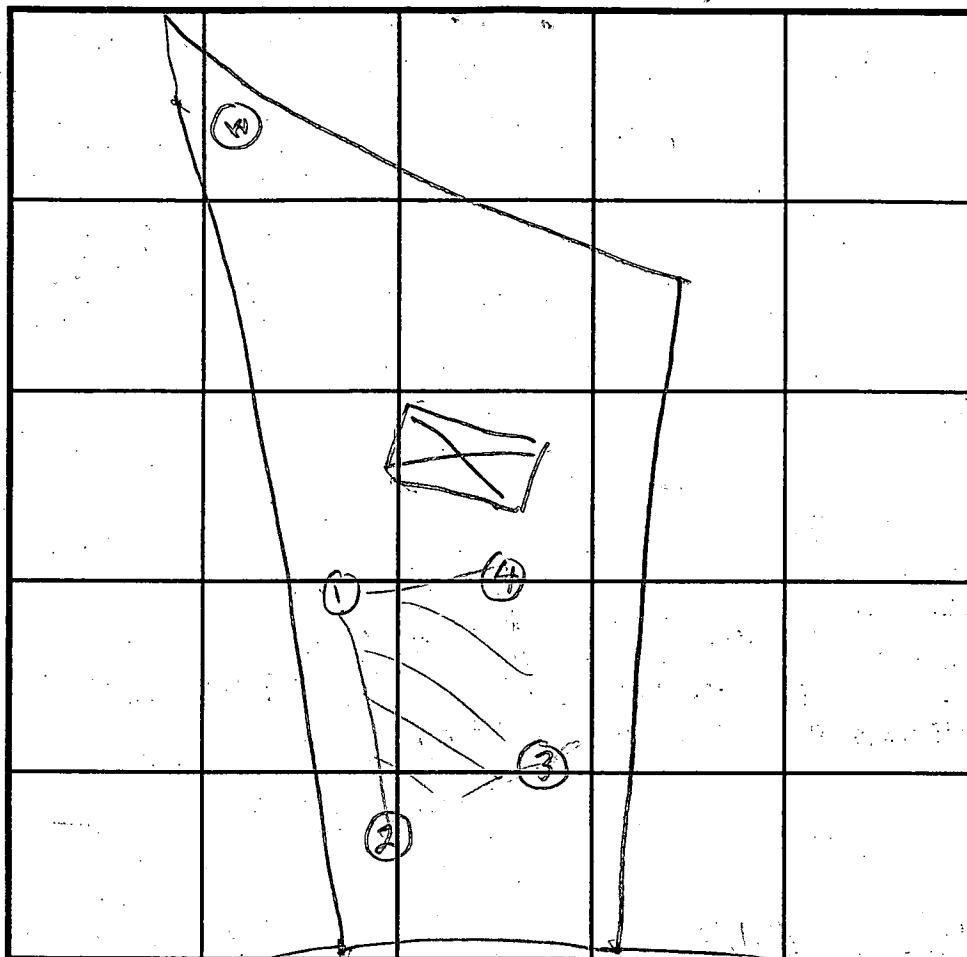

SOIL PROFILE (4)

0' TOPSOIL
CLAY

3' BROWN
SAND
LOAM

13'

INDICATE NORTH - NAME ADJOINING ROADWAY AS BASE LINE.

ROAD A

DATE	TEST NO.	DEPTH	PRE-WET		TEST - 1" DROP		TIME
			START	STOP	START	STOP	
11/13/92	1S	4.5	1051	1053	1053	1055	2
	1D	8	1052	1054	1054	1057	3
	1V	13	OK				
	2S	4	1100	1103	1103	1109	6
	2V	13.5	OK				
	3S	4.5	1104	1109	1109	1114	5
	3V	12.5	OK				
	4V	13	OK				

REMARKS

TYPE OF SOIL

TESTED BY

B. Hodges

ALSO PRESENT

RUGBY OKETTER MANOR

TRENCH DESIGN DATA: AVERAGE PERCOLATION TIME

4

TRENCH WIDTH

2

INLET DEPTH

3

MAXIMUM BOTTOM DEPTH

7

SQ. FT./BEDROOM

180

B 1 6785	SEQUENCE NO. (DP USE ONLY)	STATE OF MARYLAND APPLICATION FOR PERMIT TO DRILL WELL please print or type	STATE PERMIT NUMBER 40-94-0304
(THIS NUMBER IS TO BE PUNCHED IN COLS. 3-6 ON ALL CARDS)			
OWNER INFORMATION Date Received (APA) 010595		B 3 LOCATION OF WELL 1 2 HOWARD	
15 Last Name DETTIT		8 COUNTY HOWARD	
36 Street or RFD 18205 D FLOWER HILL Way		23 SUBDIVISION GLENWOOD	
57 Town GAITHERSBURG		44 SECTION 44	
70 State MD		46 LOT 4	
76 Zip 20879		52 NEAREST TOWN GLENWOOD	
DRILLER INFORMATION Driller's Name Dave Kelly		MILES FROM TOWN (enter 0 if in town) 2	
Firm Name Jones Well Drilling Inc		77 License No. 80 692-6981304	
Address 3700 Rush Rd Arrettsville		Signature Dave Kelly	
Date 11-3-94		B 4 DIRECTION OF WELL FROM TOWN (CIRCLE BOX) 	
B 2 WELL INFORMATION APPROX. PUMPING RATE (GAL. PER MIN.) 4		NEAR WHAT ROAD Rolling Fork Way	
AVERAGE DAILY QUANTITY NEEDED (GAL. PER DAY) 400		ON WHICH SIDE OF ROAD (CIRCLE APPROPRIATE BOX) W	
USE FOR WATER (CIRCLE APPROPRIATE BOX) ☒ D HOME (SINGLE OR DOUBLE HOUSEHOLD UNIT ONLY) ☐ F FARMING (LIVESTOCK WATERING & AGRICULTURAL IRRIGATION) ☐ I INDUSTRIAL, COMMERCIAL, STATE AND FEDERAL GOV. OTHER (REQUIRES APPROPRIATION PERMIT) ☐ P PUBLIC OR PRIVATE WATER COMPANY (REQUIRES APPROPRIATION PERMIT AND STATE HEALTH DEPARTMENT APPROVAL) ☐ T TEST, OBSERVATION, MONITORING (MAY REQUIRE APPROPRIATION PERMIT)		DISTANCE FROM ROAD APPROX 350	
APPROXIMATE DEPTH OF WELL 200 FEET		ENTER FT. OR MI. FT	
APPROXIMATE DIAMETER OF WELL 6 INCH		TAX MAP: _____ BLK: _____ PARCEL: _____	
METHOD OF DRILLING (circle one) BORED (or Augered) ☒ JETTED ☐ Jettied & DRIVEN AIR-ROTARY ☐ AIR-PERCussion ☐ ROTARY (Hydraulic Rotary) CABLE ☐ REVerse-ROTary ☐ Drive-POINT		NOT TO BE FILLED IN BY DRILLER HEALTH DEPARTMENT APPROVAL COUNTY NAME <u>Howard</u> COUNTY NO. <u>A 48631</u> STATE SIGNATURE _____ DATE ISSUED <u>01/18/95</u> INSERT S ☐ CO. SIGNATURE <u>[Signature]</u> EXP. DATE <u>01/18/96</u> NORTH GRID <u>535000</u> EAST GRID <u>0796000</u>	
REPLACEMENT OR DEEPEMED WELLS (CIRCLE APPROPRIATE BOX) ☒ N THIS WELL WILL NOT REPLACE AN EXISTING WELL ☐ Y THIS WELL WILL REPLACE A WELL THAT WILL BE ABANDONED AND SEALED ☐ S THIS WELL WILL REPLACE A WELL THAT WILL BE USED AS A STANDBY-CONTACT LOCAL APPROVING AUTHORITY FOR POLICY ON STANDBY WELLS ☐ D THIS WELL WILL DEEPEN AN EXISTING WELL PERMIT NUMBER OF WELL TO BE REPLACED OR DEEPEMED (IF AVAILABLE) 025		SHOW MAJOR FEATURES OF BOX & LOCATE WELL WITH AN X SOURCES OF DRILLING WATER 1. <u>3/6/95 growth</u> 2. <u>No insp</u> 3. <u>X</u> WRITE THE BOX NUMBER FROM THE MAP HERE 7906 5305	
Not to be filled in by driller (OEP USE ONLY) APPROX. PERMIT NUMBER G A P		DRAW A SKETCH BELOW SHOWING LOCATION OF WELL IN RELATION TO NEARBY TOWNS AND ROADS AND GIVE DISTANCE FROM WELL TO NEAREST ROAD JUNCTION 	
FORCE <u>DS</u> WRITE INITIALS IN BOX PERMIT No. <u>40-94-0304</u>		SPECIAL CONDITIONS NOTE = APPROVING AUTHORITIES SHOULD USE SEPARATE SHEET IF NEEDED =	

SEQUENCE NO.
(DENY USE ONLY)STATE OF MARYLAND
WELL COMPLETION REPORT
FILL IN THIS FORM COMPLETELY
PLEASE PRINT OR TYPETHIS REPORT MUST BE SUBMITTED WITHIN
45 DAYS AFTER WELL IS COMPLETED.COUNTY
NUMBER

A48631

(THIS REPORT TO BE PUNCHED
IN COMPLETION OF ALL CARDS)STATE USE ONLY
DATE RECEIVED

DATE WELL COMPLETED

8 13

030695

Depth of Well
22 3 0 5 26
(TO NEAREST FOOT)PERMIT NO.
FROM "PERMIT TO DRILL WELL"
40-94-0304OWNER Petit & Griffin, Inc.
STREET OR RFD Rolling Fork Way TOWN Glenwood
SUBDIVISION Swindyl Oak Estates SECTION 4 LOT 4

WELL LOG

Not required for driven wells

STATE THE KIND OF FORMATIONS
PENETRATED, THEIR COLOR, DEPTH,
THICKNESS AND IF WATER BEARING

DESCRIPTION (Use additional sheets if needed)	FEET		Check if water bearing
	FROM	TO	
soft/med brown dirt	0	75	
hard tan rock	75	83	
hard green rock	83	90	
med hard green rock	90	91	
med hard/hard green	91	98	
hard green rock	98	103	
med/med hard green	103	105	X
hard green rock	105	109	
med/med hard green	109	113	
hard green rock	113	117	
med/hard green rock	117	118	
hard green rock	118	135	
med green rock	135	140	
hard green rock	140	218	
med tan rock	218	219	
hard gray rock	219	220	
med gray rock	220	221	
hard gray rock	221	305	X

IN HARD ROCK AREAS, IDENTIFY SPECIFICALLY
WHERE SATURATED FRACTURES WERE OBSERVED.

WELL HYDROFRACTURED

yes ☒ no ☒

CIRCLE APPROPRIATE LETTER

A A WELL WAS ABANDONED AND SEALED
WHEN THIS WELL WAS COMPLETED

E ELECTRIC LOG OBTAINED

P TEST WELL CONVERTED TO PRODUCTION
WELLI HEREBY CERTIFY THAT THIS WELL HAS BEEN CONSTRUCTED IN
ACCORDANCE WITH COMAR 26.04.04 "WELL CONSTRUCTION"
AND IN CONFORMANCE WITH ALL CONDITIONS STATED IN THE
ABOVE CAPTIONED PERMIT, AND THAT THE INFORMATION PRE-
SENTED HEREIN IS ACCURATE AND COMPLETE TO THE BEST OF
MY KNOWLEDGE.

DRILLERS IDENT. NO.

David Kelly

DRILLERS SIGNATURE

(MUST MATCH SIGNATURE ON APPLICATION)

Arnold Garrison

SITE SUPERVISOR (sign. of driller or journeyman
responsible for sitework if different from permittee)

GROUTING RECORD

WELL HAS BEEN GROUTED
(Circle Appropriate Box)

TYPE OF GROUTING MATERIAL

CEMENT ☒ BENTONITE CLAY ☒NO. OF BAGS 21 NO. OF POUNDS 2100GALLONS OF WATER 126

DEPTH OF GROUT SEAL (to nearest foot)

from 0 ft. to 8 4 ft.
48 TOP 52 54 BOTTOM 58
(enter 0 if from surface)

CASING RECORD

casing
types
insert
appropriate
code
belowST CO
STEEL CONCRETE
PL OT
PLASTIC OTHERMAIN
CASING
TYPENominal diameter
top (main) casing
(nearest inch)Total depth
of main casing
(nearest foot)P L 6 8 5 70
60 61 63 64 66 67 68 69 70

OTHER CASING (if used)

diameter depth (feet)
inch from to

EACH CASING

screen type
or open hole
(insert
appropriate
code
below)

SCREEN RECORD

ST BR HO
STEEL BRASS OPEN
PL BRONZE HOLE
PLASTIC OTHER

C2

DEPTH (nearest ft.)

1 2 3 100

SLOT SIZE 1/2 2 3DIAMETER OF SCREEN 5 (NEAREST INCH)

from to

GRAVEL PACK ☐
IF WELL DRILLED WAS
FLOWING WELL INSERT
F IN BOX 68MDE USE ONLY
(NOT TO BE FILLED IN BY DRILLER)T (E.R.O.S.) W.Q.
70 72 74 75 76TELESCOPE LOG OTHER DATA
CASING INDICATOR

C3

PUMPING TEST

HOURS PUMPED (nearest hour) 3PUMPING RATE (gal. per min. to nearest gal.) 12METHOD USED TO MEASURE PUMPING RATE timer

WATER LEVEL (distance from land surface)

BEFORE PUMPING 2 6WHEN PUMPING 1 4 2

TYPE OF PUMP USED (for test)

A air P piston T turbine
C centrifugal R rotary O other (describe below)
J jet S submersible

PUMP INSTALLED

DRILLER WILL INSTALL PUMP YES ☒ NO ☒IF DRILLER INSTALLS PUMP, THIS SECTION
MUST BE COMPLETED FOR ALL WELLS
EXCEPT HOME USE
TYPE OF PUMP INSTALLED ☐
PLACE (A,C,J,P,R,S,T,O)
IN BOX - SEE ABOVE: 29CAPACITY:
GALLONS PER MINUTE 31 35PUMP HORSE POWER 37 41PUMP COLUMN LENGTH (nearest ft.) 43 47

CASING HEIGHT (circle appropriate box and enter casing height)

above ☒ below ☐
LAND SURFACE 1 (nearest foot)

LOCATION OF WELL ON LOT

SHOW PERMANENT STRUCTURE SUCH AS
BUILDING, SEPTIC TANKS, AND/OR
LANDMARKS AND INDICATE NOT LESS
THAN TWO DISTANCES
(MEASUREMENTS TO WELL)

25' LPL

67' LRC

COUNTY

[illegible]

HOWARD COUNTY HEALTH DEPARTMENT
Bureau of Environmental Health
3525-W Ellicott Mills Drive
Ellicott City, MD 21043

Fax 313-2648 313-2640

APPLICATION FOR PITLESS ADAPTER, WELL PUMP AND PRESSURE TANK INSTALLATION

New Installation ☒
Replacement ☐

Receipt #
Date

9/10/97

Name of Installer

ROBERT L. FEEZER CO., INC.

Telephone

410-781-4655

License Number

2122

Certified Well Pump Installer ☒

Well Driller ☐

Registered Plumber ☒

Name of Property Owner

NV - HOMES

Telephone

410-785-1405

Subdivision

CWYNDALE ESTATES, Lot # 4

Well Tag #

40-94-0304

Site Address

2813 KALINE FORK WAY

Pump

1. Type

a. Deep well jet

b. Shallow well jet

c. Submersible ☒

2. Make

SPRINT ELECTRIC

3. Model #

1063-301

4. Capacity

10 GPM

5. Pump exceeds well capacity Yes ☐ No ☒

6. If Yes, is low pressure cutoff switch installed? Yes ☐ No ☐

7. What methods are used to protect the pump and electrical wiring from vibrations? Torque arrestors ☐ Cable guards ☐ Other ☒ NONE - WELL IS SLEEVED

Captive Air Tank
WELL-X-TROL

1. Capacity

31 GALS.

2. Pressure relief

valve? YES

9/11/97 - pitless adapter OK at 4 1/2
6' & Case RFP 9/11/97

Piping

1. Type

POLY

2. Size

1"

3. NSF and/or BOCA

Code approved YES

4. Depth of supply

line 42"

Well data

1. Depth 305 ft.

2. Yield 11.5 GPM

3. Static water

level 1 ft.

4. Will water supply

be disinfected by

installer? YES

WELL IS
SLEEVED
FROM 75'-159'
WITH 5"
STEEL
SLEEVE.

I understand that it is my responsibility to notify the Howard County Health Department when the installation is ready for inspection (otherwise this permit is null and void).

All information given above is true to the best of my knowledge.

Signature of Applicant:

Date:

9/10/97


Note: A sticker indicating approval/status of the installation will be placed on the well casing at the time of the inspection.


Preliminary
Plan
Sp 93-15

(ENVIRONMENTAL)
(PRESERVATION)
76.68 Δc ±

EX DRIVEWAY TO BE ~~ABANDONED~~

RONALD CLARK
AND WIFE
1020/420
ZONED RC-DEO

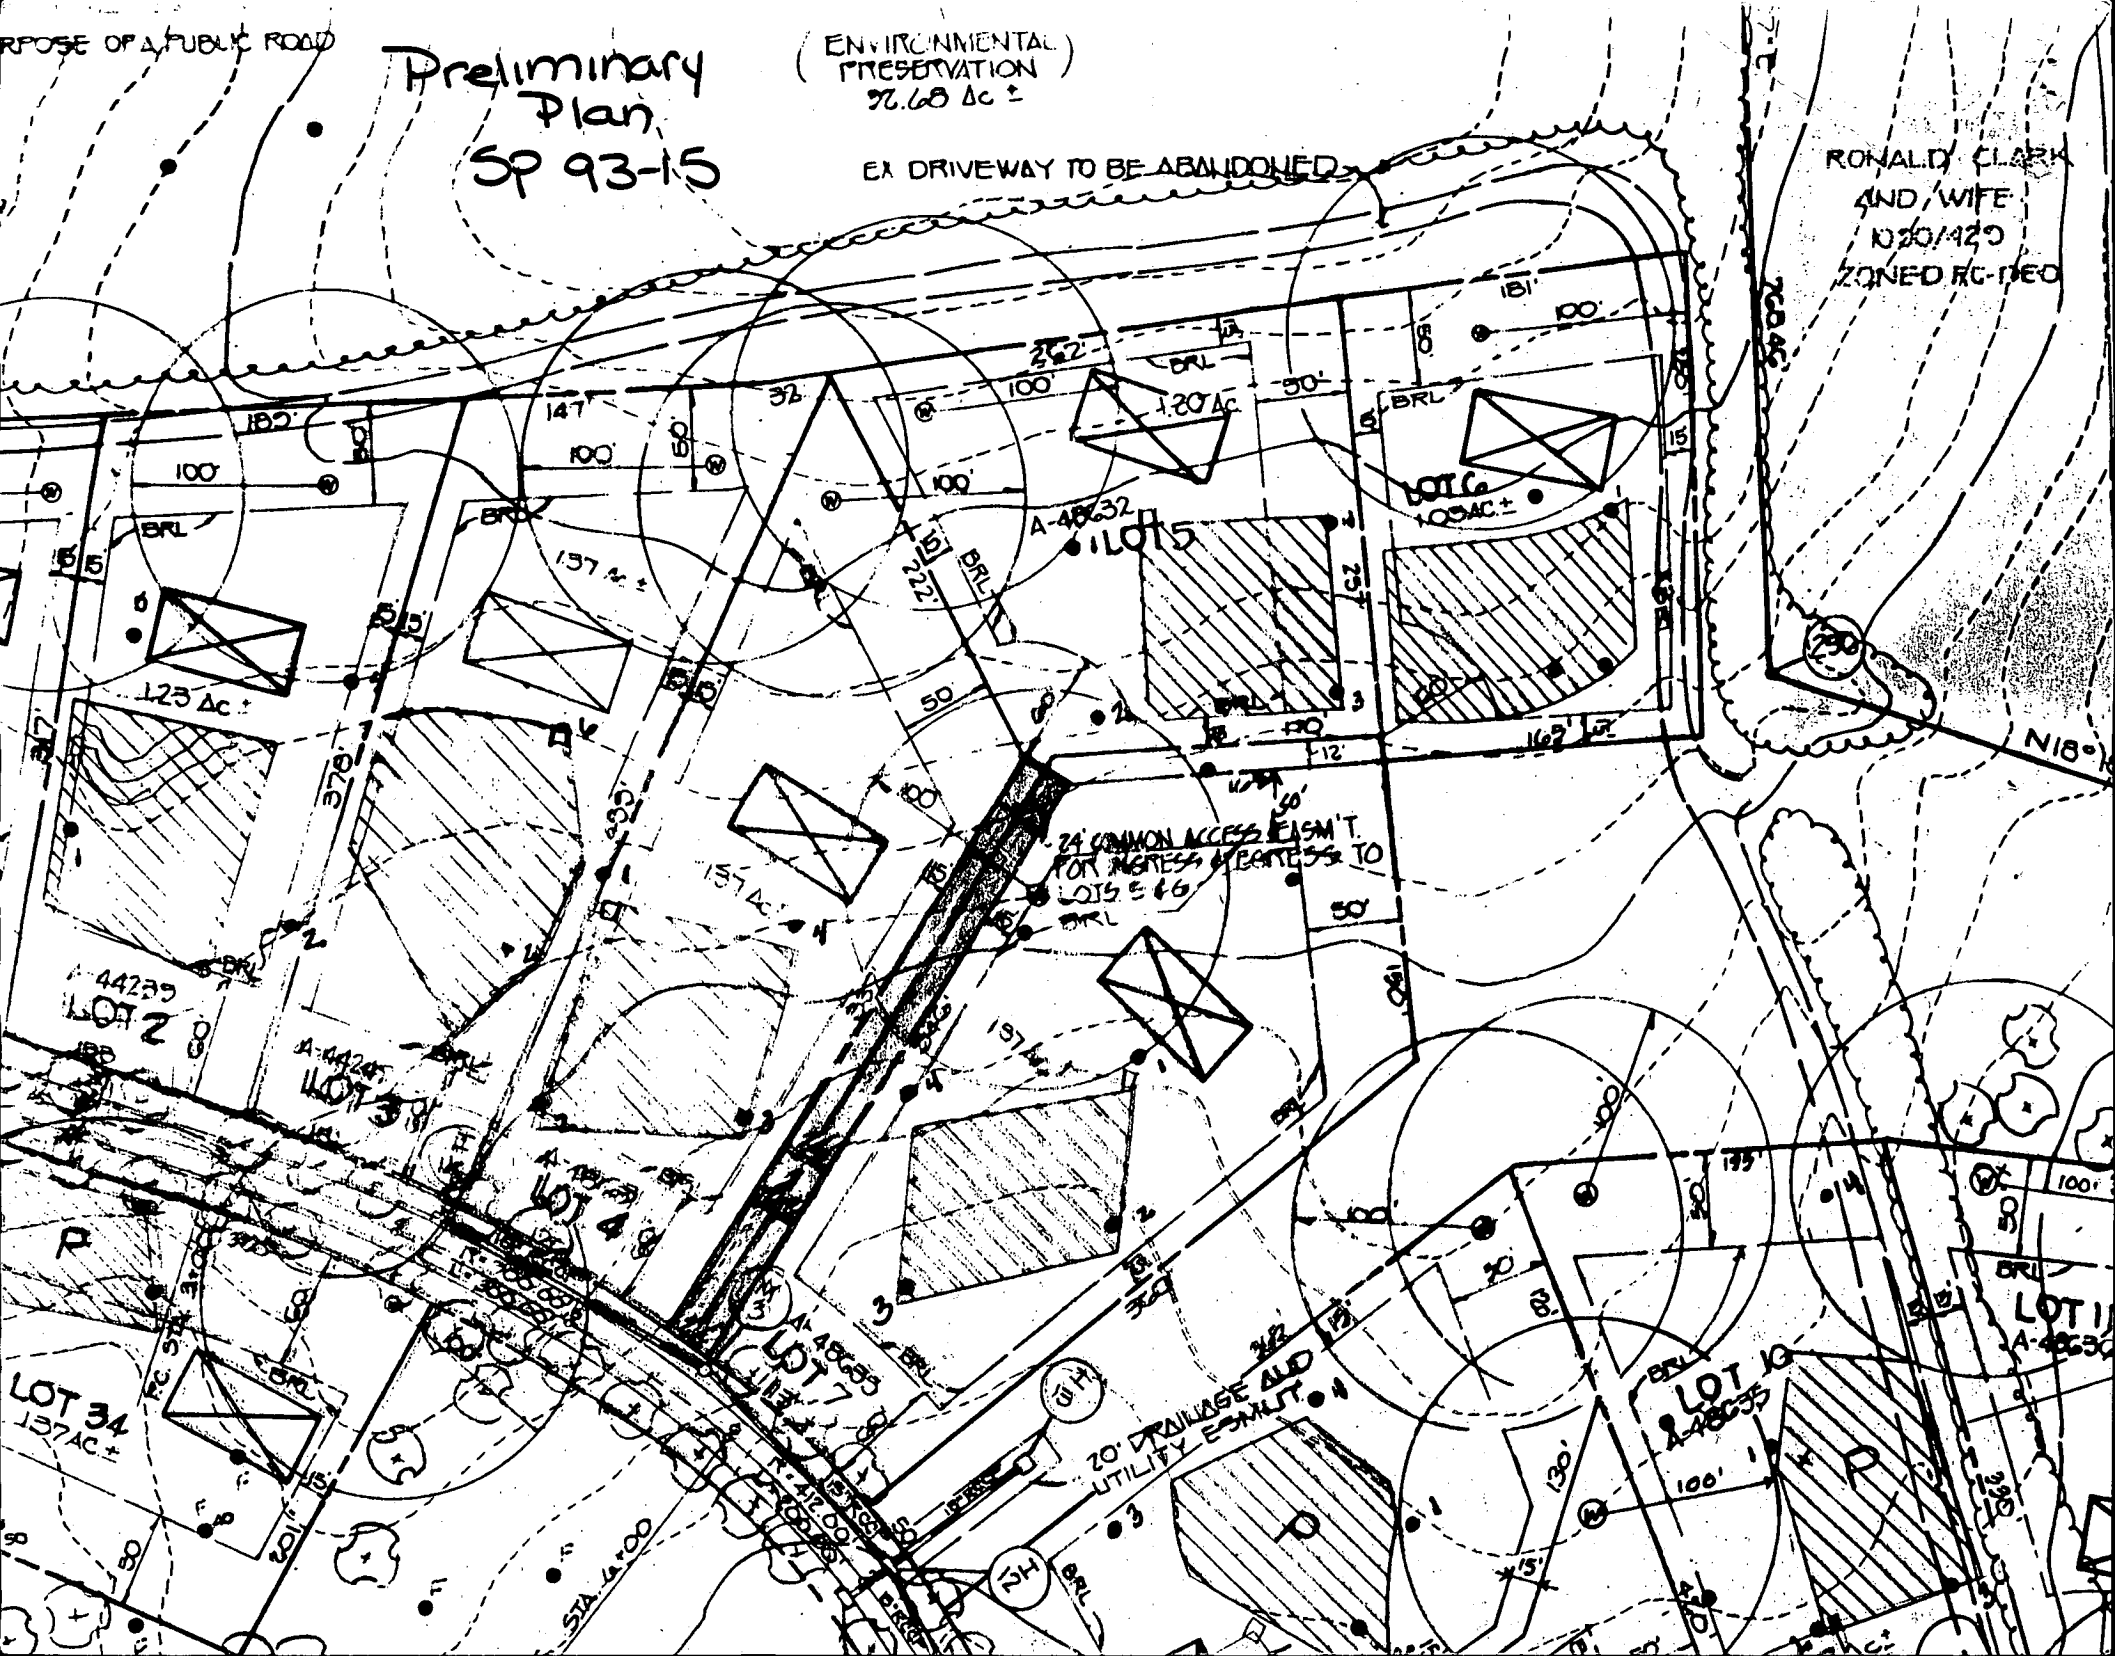


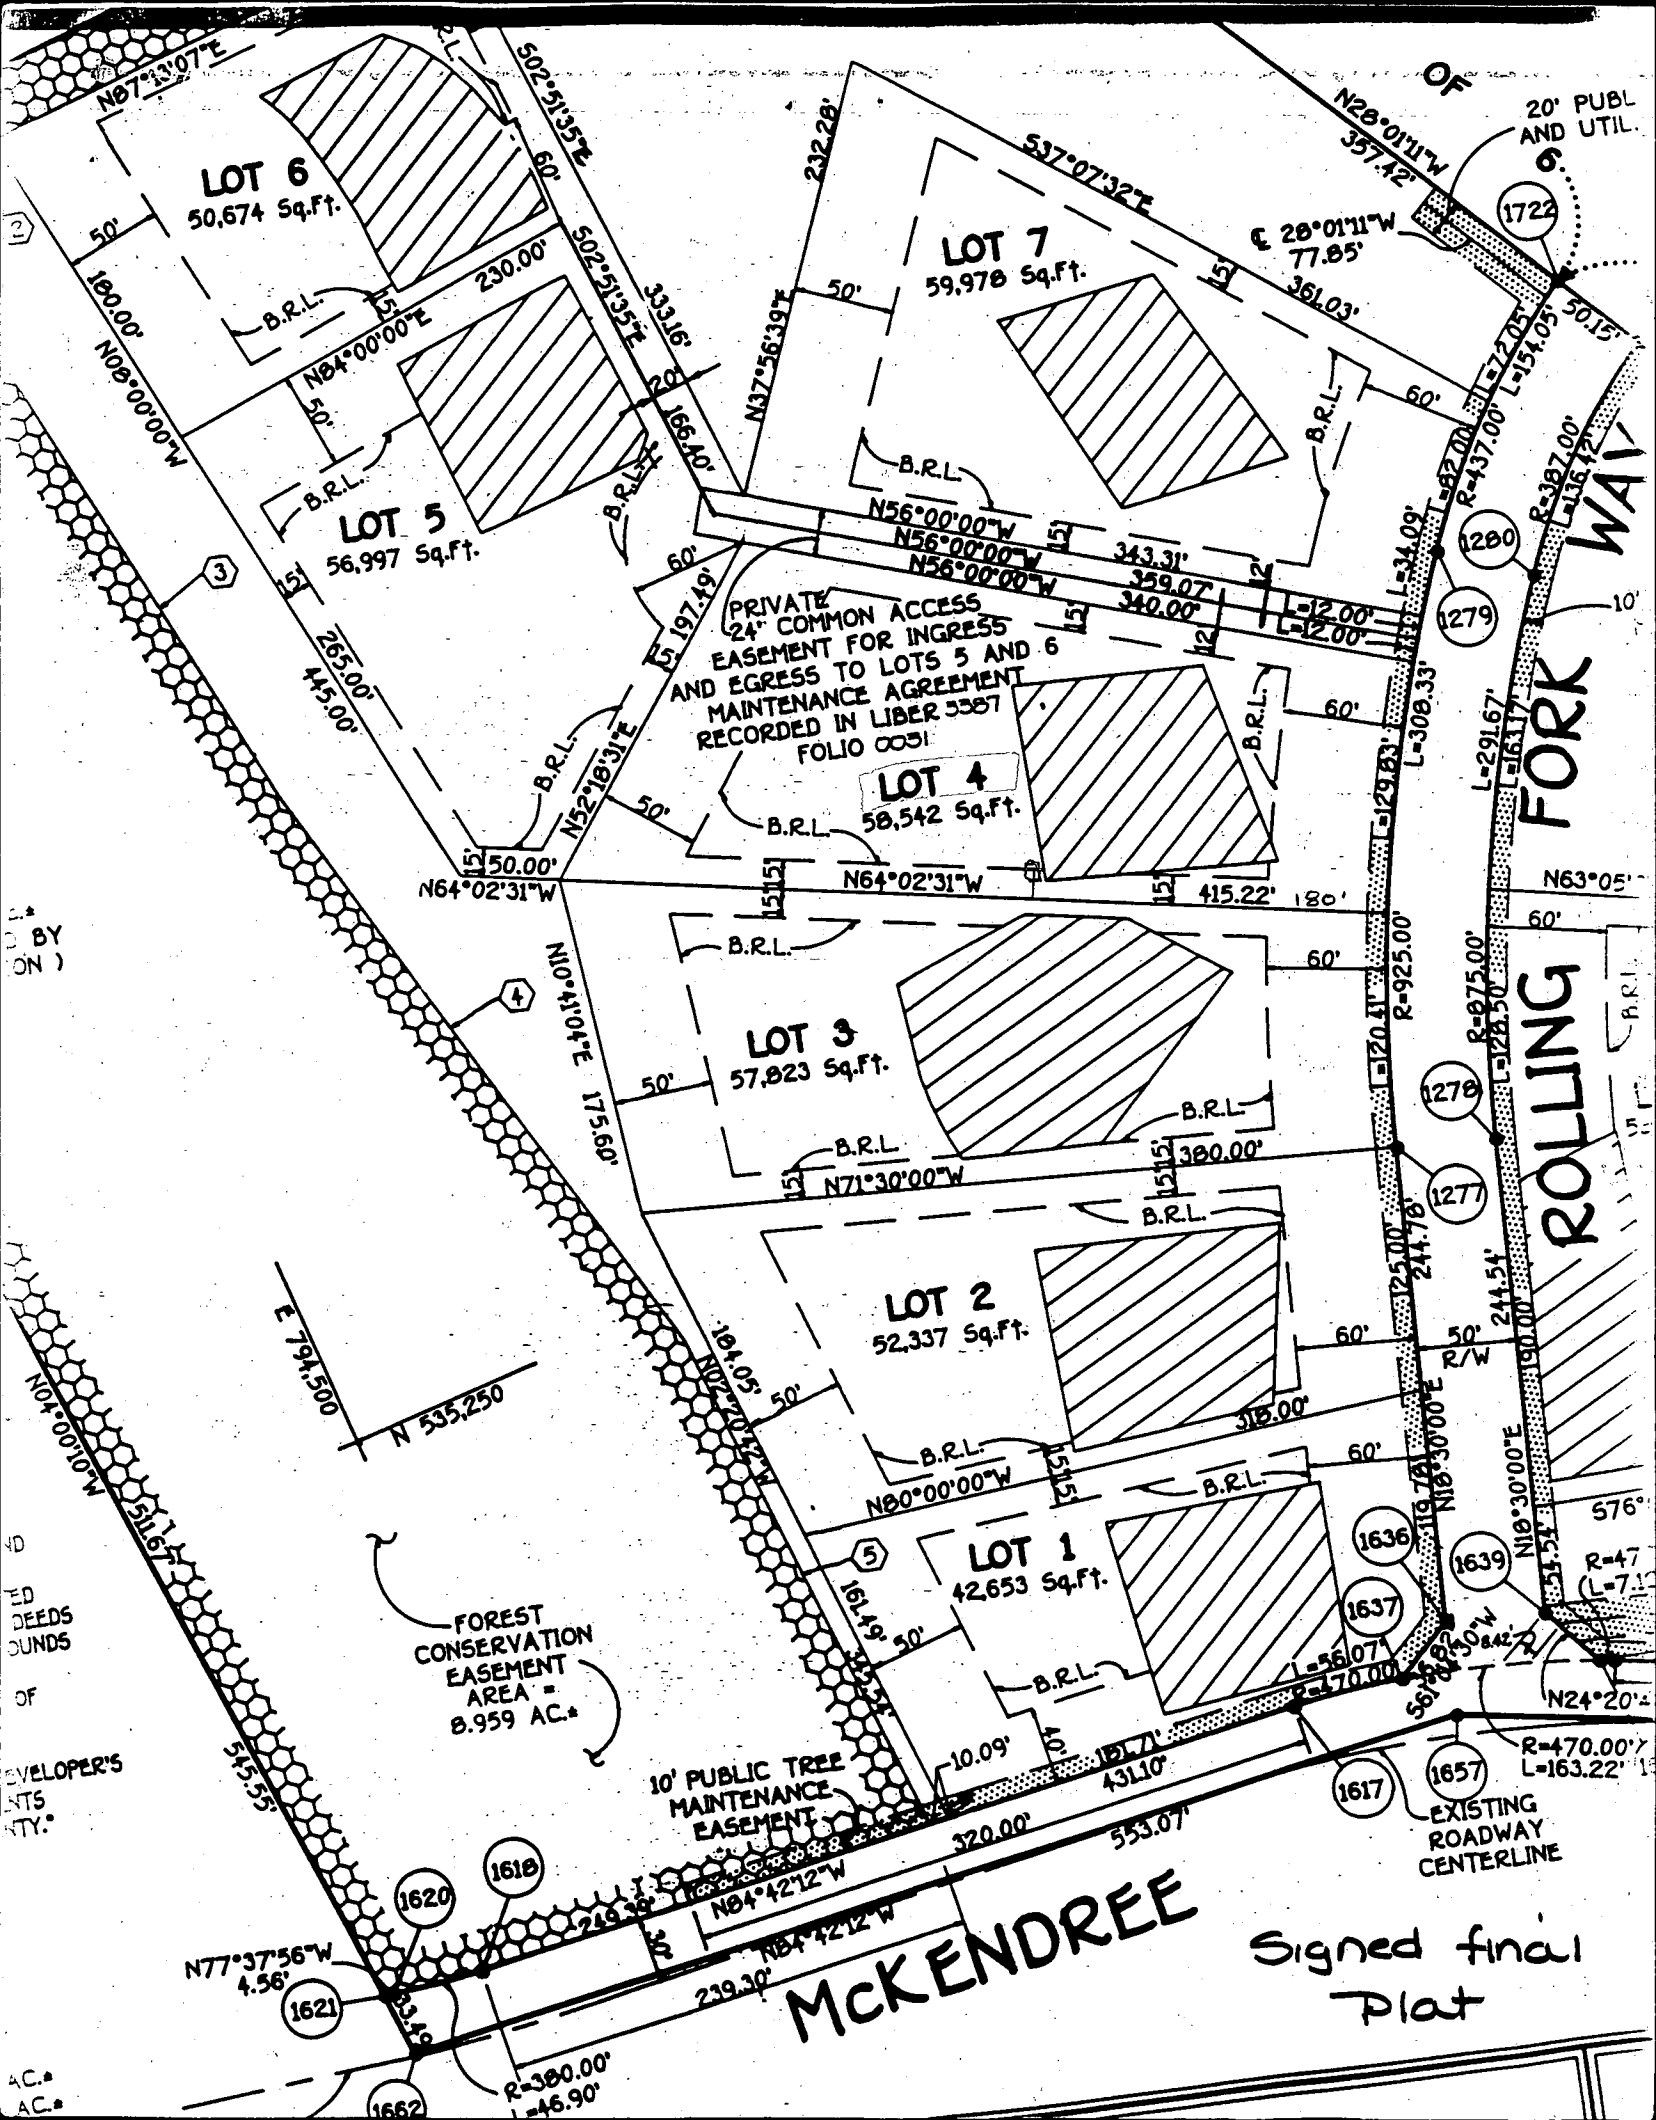

Post-It™ brand fax transmittal memo 7671 # of pages 1

To: JAT Orlah	From: Mike Tran
Co: BPS	Co: GLW
Dept:	Phone #
Fax # 410 515-2213	Fax #

95052

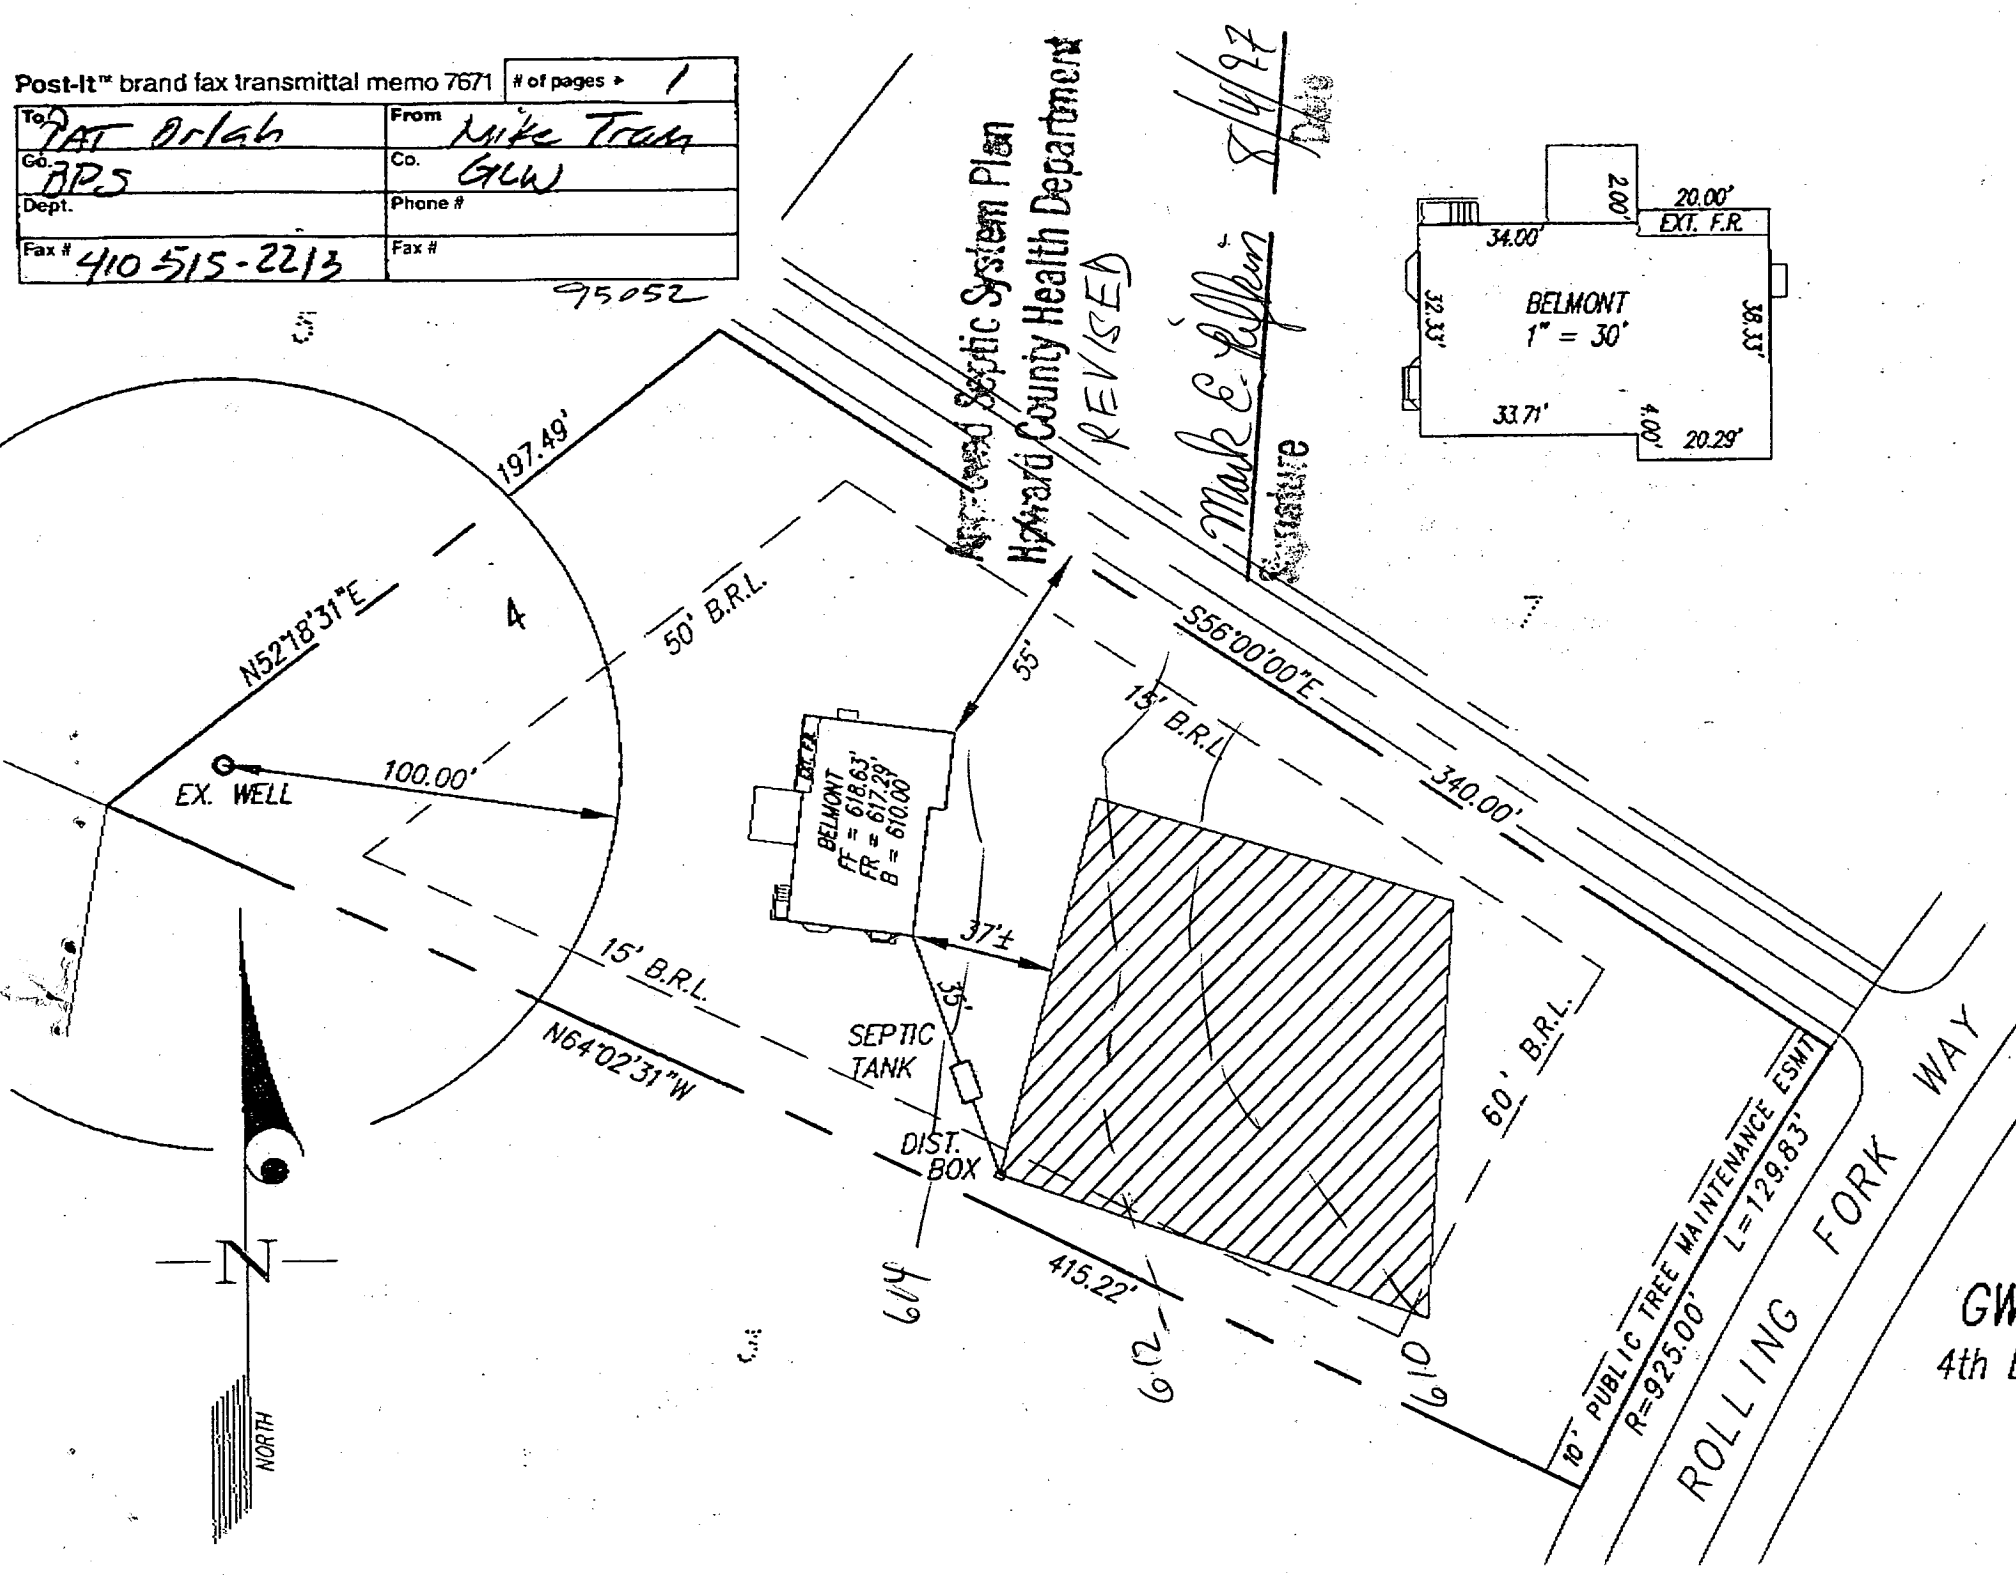

Notes:

1. Lot shown contains 58,542 s.f. of land and recorded at plot # 11549 among the Land Records of Howard County, Maryland.
2. Prepared by Gutschick, Little and Weber, P.A.
3. Grading around house may vary due to field conditions.
4. No construction stockpiling refuse or excess material shall be buried in septic easement.
5. Well as field located by G.L.W.
6. Install sediment controls as required by Site Inspector. See Sediment Control Plan # GP-95-26.
7. Disturbed area shown is 23,720 s.f.
8. Pile excavated material on high side of trench when installing septic field prior to disposal of excess material.
9. Length of trench for septic system to be determined and specified by Howard County Department of Health.

SEPTIC SYSTEM DATA:

BASEMENT FLOOR AREA = 610.00'
 INV. OUT OF HOUSE = 611.55' (HUNG SEWER)
 INV. IN AT SEPTIC TANK = 610.85'
 INV. OUT AT SEPTIC TANK = 610.6'
 EX. ELEV. AT SEPTIC TANK = 613.6'
 PROP. ELEV. AT SEPTIC TANK = 613.6'
 INV. IN AT DIST. BOX = 610.0'
 EX. ELEV. AT DIST. BOX = 613.1'

LOT 4
 GWYNDYL OAK ESTATES
 4th ELEC. DIST. HOWARD CO., MD
 Revised July 16, 1997
 (Resite w/ Belmont)
 1" = 50'


9/10/97
 Shown location of
 Propane tank will have
 no impact to the existing
 well or septic. OK to proceed.

A McMillen

To John St. Jean BGE

Permit # B00103366

To
 Bob Bush

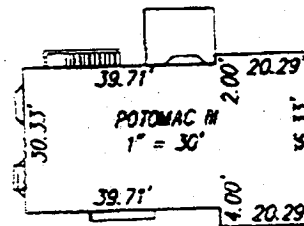

From
 Jim Kerwin
 NU Homes
 410-212-5308

land and
 the Land
 inc.
 Water, P.A.
 due to field

septic

used by
 trial Pion

- Disturbed area shown is 21720 s.f.
- Pile excavated material on high side of trench when installing septic field prior to disposal of excess material.
- Length of trench for septic system to be determined and specified by Howard County Department of Health.

SEPTIC SYSTEM DATA:
 BASEMENT FLOOR AREA = 610.00'
 INV. OUT OF HOUSE = 6112.5' (HUNG SEWER)
 INV. IN AT SEPTIC TANK = 610.85'
 INV. OUT AT SEPTIC TANK = 610.6'
 EX. ELEV. AT SEPTIC TANK = 613.6'
 PROP. ELEV. AT SEPTIC TANK = 613.6'
 INV. IN AT DIST. BOX = 610.8'
 EX. ELEV. AT DIST. BOX = 613.1' ±

McKendree Estates
 LOT 4

GWYNDYL OAK ESTATES
 4th ELEC. DIST. HOWARD CO., MD
 Dec. 6, 1996 1"=50'

2813 Rolling Fork way
 Glenwood md. HO County

