

PERMIT

SEWAGE DISPOSAL SYSTEM

DEPARTMENT OF HEALTH AND MENTAL HYGIENE

HOWARD COUNTY HEALTH DEPARTMENT

BUREAU OF ENVIRONMENTAL HEALTH

~~XXXXXX~~ 410-313-2640

P 513182

A 48817

DISTRICT

DATE 12-17-99

DATE SYSTEM APPROVED 1/7/00

INSPECTOR MR/DKS

INDEXED

Fogle's Septic Clean, Inc.

IS PERMITTED TO INSTALL ☒ ALTER

ADDRESS 580 Obrecht Road, Sykesville, Maryland 21784

PHONE 410-795-5670

SUBDIVISION Quarterfield LOT 39 ROAD 11601 Quarterfield Way DRIVE

DANIEL + MICHELLE

PROPERTY OWNER CONLON Dale Thompson

ADDRESS

SEPTIC TANK CAPACITY 1250 GALLONS

NUMBER OF BEDROOMS 4

180 SQUARE FEET PER BEDROOM

LINEAR FEET OF TRENCH REQUIRED 180

TRENCHES - Trench to be 2 feet wide. Inlet 3 1/2 feet below original grade. Bottom maximum depth 7 1/2 feet below original grade. Effective area begins at 3 1/2 feet below original grade. 4 feet of stone below distribution pipe.

LOCATION - Place the distribution box 115 feet down the right lot line and 85 feet off this same lot line. Run trenches on contour in both directions.

NOTES - No trench to exceed 100 feet in length. Provide 6" - 8" diameter cleanout and cap to grade or above on septic tank. OK/MR

PLANS APPROVED BY Mark Rifkin /C. Williams

DATE 6-28-1999

COVER NO WORK UNTIL INSPECTED AND APPROVED

NEITHER THE HOWARD COUNTY COUNCIL NOR THE HEALTH DEPARTMENT IS RESPONSIBLE FOR THE SUCCESSFUL OPERATION OF ANY SYSTEM

NOTE: CLEANOUT REQUIRED EVERY 70 FEET OF SEWER LINE AND/OR AT 90° SWEEPS IN LINES FROM HOUSE TO DRAIN FIELDS. 90° ELBOWS NOT ACCEPTABLE.

NOTE: ALL PARTS OF SEPTIC SYSTEMS (I.E. TANK, DISTRIBUTION BOX TRENCHES) TO BE 100 FEET FROM WELL (UNLESS OTHERWISE SPECIFICALLY AUTHORIZED)

NOTE: IF DEEP TRENCH(ES) ARE USED CALL FOR INSPECTION BEFORE AND AFTER PLACING GRAVEL IN TRENCH(ES)

NOTE: NO DRY WELL SHALL EXCEED 15 FOOT IN DIAMETER NO ABSORPTION TRENCH TO EXCEED 100 FEET IN LENGTH

NOTE: ALL PIPE FROM HOUSE TO SEPTIC TANK MUST BE CAST IRON OR SCHEDULE 35/40 PVC OR ABS


PERMIT VOID AFTER TWO YEARS

NOTE: INSTALL STAND PIPE ON SEPTIC TANK AND DRY WELL STAND PIPES MUST BE 6 INCHES IN DIAMETER CAST IRON, CONCRETE OR TERRA COTTA OR PVA OR ABS ACCEPTED. IF TOP OF SEPTIC TANK IS DEEPER THAN 3 FEET, MANHOLE TO GRADE REQUIRED.

NOTE: DISTRIBUTION BOXES MUST HAVE BAFFLES

*INSTALLER IS RESPONSIBLE FOR OBTAINING FINAL APPROVAL ON THIS PERMIT

*CALL 461-9933 FOR INSPECTION OF SEPTIC SYSTEM.

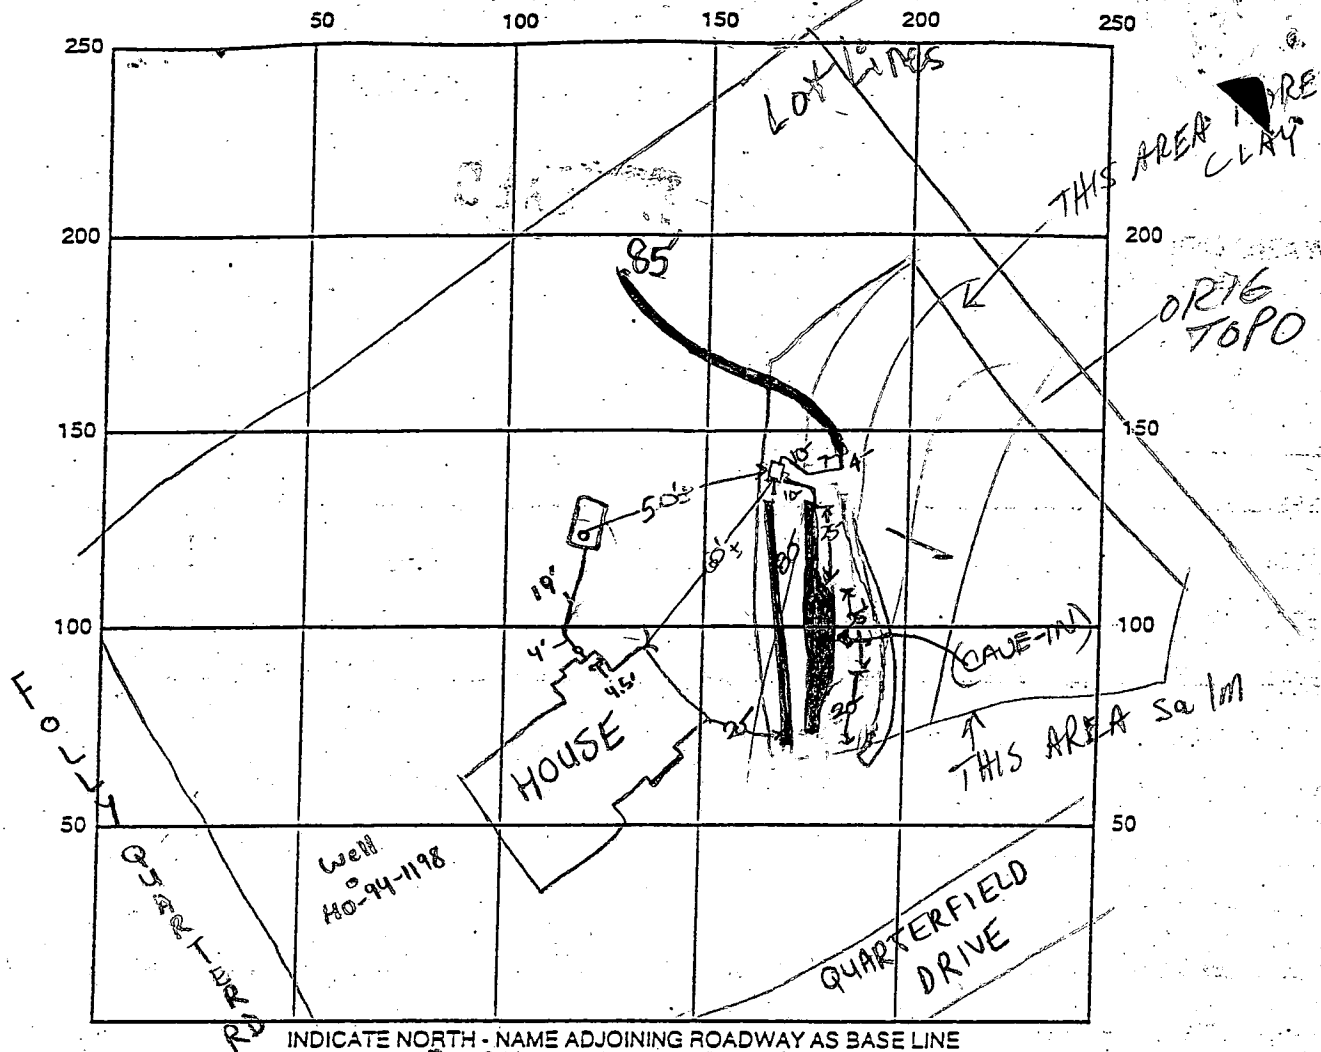

SEPTIC TANK LEVEL ✓ 1250 gallon midseam

CLEANOUTS 4" at house

DISTRIBUTION BOX LEVEL OK

DRAIN FIELD/TITLE DEPTH 7 1/2 FT.

TRENCH WIDTH 2 FT.

INLET DEPTH 3.5 FT.

EFFECTIVE GRAVEL DEPTH 4 FT.

TOTAL LENGTH 085 070 080 FT.

→ 235

NUMBER OF TRENCHES 3

ONE SIDEWALL BOTTOM AREA 940 SQ. FT.

DRYWALL INSIDE DIAMETER N/A FT.

EFFECTIVE DEPTH BELOW INLET N/A FT.

ABSORBENT AREA N/A SQ. FT.

REMARKS: 12/23/99 - HOUSE CONNECTION MADE, OUT TO COVER FROM HOUSE TO TANK (SRK)

12/30/99 STOP WORK - REAR TRENCH OUT OF SEWAGE BSMT, IN CLAY,

FRONT TRENCH THRU FILL (UP TO 4-5' FILL); BSMT TO BE STAKED (MR)

1/5/00 ATTEMPTS TO RE-ROUTE REAR TRENCH TO MORE ACCEPTABLE SOILS NOT

SUCCESSFUL; REAR TRENCH TO BE LEFT INTACT, FRONT TRENCH DISCONNECTED; DUE

TO H-CLAY SOILS, (2) ADD'L 80' TRENCHES TO BE INSTALLED @ HIGH P/O OR SDA (MR)

DATE SYSTEM APPROVED 1/7/00

INSPECTOR [Signature]

1/7/00 OK to cover 2 trenches - cave-in of 2nd trench occurred as indicated. (SRK)

APPLICATION

PERCOLATION TESTING

A 48817

P _____

HOWARD COUNTY HEALTH DEPARTMENT

BUREAU OF ENVIRONMENTAL HEALTH

3525-H ELLICOTT MILLS DRIVE/ELLICOTT CITY, MARYLAND 21043
TELEPHONE: 313-2840

DISTRICT _____

DATE _____

TO: THE COUNTY HEALTH OFFICER
ELLICOTT CITY, MARYLAND

I HEREBY APPLY FOR THE NECESSARY TEST PRIOR TO APPLICATION FOR PERMIT TO CONSTRUCT (OR RECONSTRUCT) A SEWAGE DISPOSAL SYSTEM.

PROPERTY OWNER Joseph M. Zoller, III DALE Thompson
11696 Carroll Mill Road
ADDRESS Ellicott City, Maryland 21043 PHONE _____

AGENT OR PROSPECTIVE BUYER SDC Group, Inc.
ADDRESS P.O. Box 417, Ellicott City, MD 21041 PHONE (410) 465-4244

PROPERTY LOCATION:

SUBDIVISION Zoller Property LOT NO. 1

ROAD AND DESCRIPTION Northeast quadrant Folly Quarter Road and Carroll Mill Road
intersection. (11601 Quarterfield Way)

TAX MAP 23 PARCEL # 8,82 & 101

SIZE OF LOT 1 Ac +/- TYPE BLDG. Single Family - 4 Bed
(SINGLE FAMILY DWELLING OR COMMERCIAL)

THE SYSTEM INSTALLED UNDER THIS APPLICATION IS ACCEPTABLE ONLY UNTIL PUBLIC FACILITIES BECOME AVAILABLE. I FULLY UNDERSTAND THE
FEE CONNECTED WITH THE FILING OF THIS PERC TEST APPLICATION IS NON-REFUNDABLE UNDER ANY CIRCUMSTANCES. I ALSO AGREE TO
COMPLY WITH ALL M.O.S.H.A. REQUIREMENTS IN TESTING THIS LOT. By: [Signature] SDC Group Inc.
(SIGNATURE OF APPLICANT)

APPROVED BY _____ FOR _____ DATE _____

DISAPPROVED BY _____ FOR _____ DATE _____

HOLD PENDING FURTHER TESTS _____

REASONS FOR REJECTION OR HOLDING _____

PERCOLATION TEST PLAT/PRELIMINARY PLAT - TITLE OR I.D. # _____ DATE _____

SITE DEVELOPMENT PLAN/FINAL PLAT - TITLE OR I.D. # _____ DATE _____

THIS IS NOT A PERMIT


COUNTY #

SOIL PROFILE

202 203

red org
cl lmtan
org
si salm
15% frags

FOLLY QTR RD

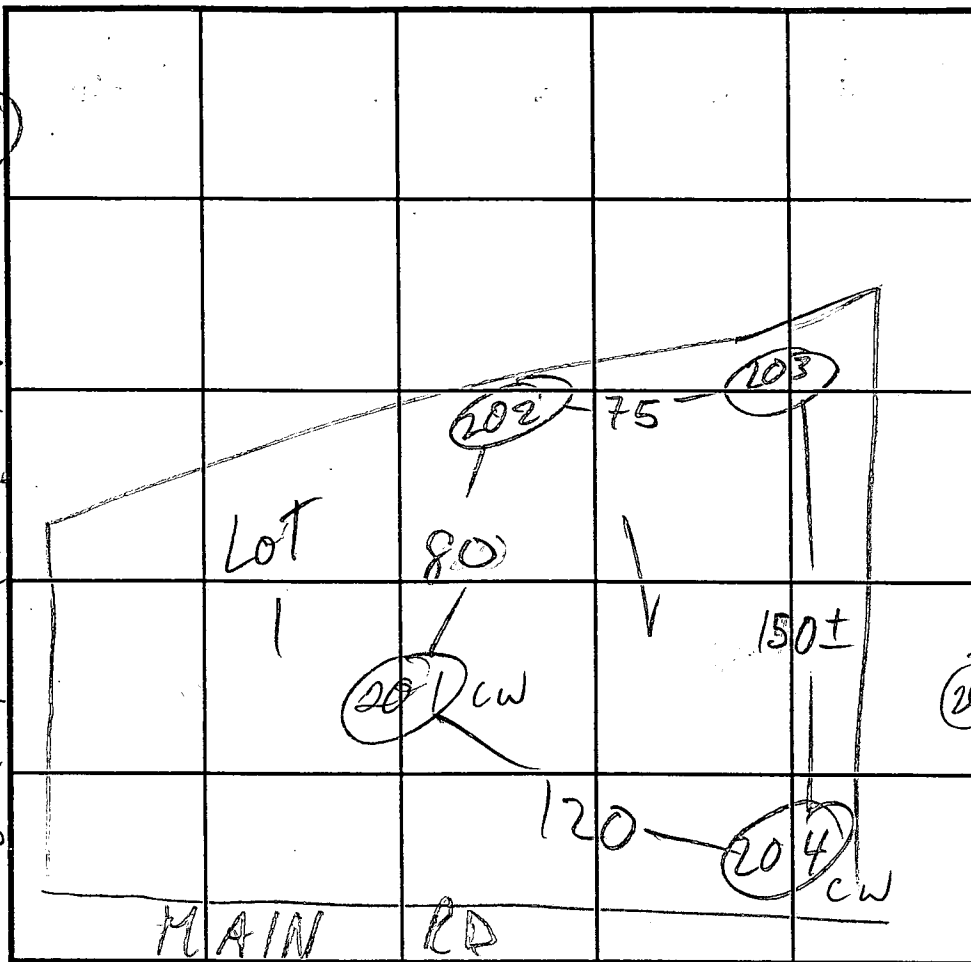

INDICATE NORTH - NAME ADJOINING ROADWAY AS BASE LINE.

SOIL PROFILE

206

205

DATE	TEST NO.	DEPTH	PRE-WET		TEST - 1" DROP		TIME
			START	STOP	START	STOP	
7/20/94	202 S	4 1/2	10:14	10:16	10:16	10:20	4
	202 V	12					
	203 S	4 1/2	10:16:30	10:17:00	10:17:00	10:19	2
	203 V	12					
7/19/94	201						
	201						
	204						
	204						
7/20/94	205 S	4 1/2	10:19	10:21	10:21	10:24	3
	205 V	11'9"					

REMARKS

TYPE OF SOIL

TESTED BY

M. R. P. Kin

ALSO PRESENT Hatfield crew

TRENCH DESIGN DATA: AVERAGE PERCOLATION TIME

TRENCH WIDTH

INLET DEPTH

MAXIMUM BOTTOM DEPTH

SQ. FT/BEDROOM

7/19/94

APPLICATION

PERCOLATION TESTING

A 48817

P _____

HOWARD COUNTY HEALTH DEPARTMENT

BUREAU OF ENVIRONMENTAL HEALTH

3525-H ELLICOTT MILLS DRIVE/ELLICOTT CITY, MARYLAND 21043
TELEPHONE: 313-2640

DISTRICT _____

DATE _____

TO: THE COUNTY HEALTH OFFICER
ELLICOTT CITY, MARYLAND

I HEREBY APPLY FOR THE NECESSARY TEST PRIOR TO APPLICATION FOR PERMIT TO CONSTRUCT (OR RECONSTRUCT) A SEWAGE DISPOSAL SYSTEM.

PROPERTY OWNER _____

ADDRESS _____ PHONE _____

AGENT OR PROSPECTIVE BUYER _____

ADDRESS _____ PHONE _____

PROPERTY LOCATION:

SUBDIVISION ZOLLER PROPERTY LOT NO. 1 on final

ROAD AND DESCRIPTION FOLLY QUARTER RD.

TAX MAP _____ PARCEL # _____

SIZE OF LOT _____ TYPE BLDG. _____
(SINGLE FAMILY DWELLING OR COMMERCIAL)

THE SYSTEM INSTALLED UNDER THIS APPLICATION IS ACCEPTABLE ONLY UNTIL PUBLIC FACILITIES BECOME AVAILABLE. I FULLY UNDERSTAND THE
FEE CONNECTED WITH THE FILING OF THIS PERC TEST APPLICATION IS NON-REFUNDABLE UNDER ANY CIRCUMSTANCES. I ALSO AGREE TO
COMPLY WITH ALL M.O.S.H.A. REQUIREMENTS IN TESTING THIS LOT.

(SIGNATURE OF APPLICANT)

APPROVED BY _____ FOR _____ DATE _____

DISAPPROVED BY _____ FOR _____ DATE _____

HOLD PENDING FURTHER TESTS _____

REASONS FOR REJECTION OR HOLDING _____

PERCOLATION TEST PLAT/PRELIMINARY PLAT - TITLE OR I.D. # _____ DATE _____

SITE DEVELOPMENT PLAN/FINAL PLAT - TITLE OR I.D. # _____ DATE _____

THIS IS NOT A PERMIT

(ZOLLER)

COUNTY #

SOIL PROFILE

0'

209
UNANGS
SILT
LOAM 3'
MICA
SILT
LOAM
(POWDER)
12'

204
TAN
SILT
LOAM


ON ANGGS
SILT
LOAM

POCKET
ROCK
AT 5'

201
VIS OR 3
MICA
LOAM

SOIL PROFILE

0'

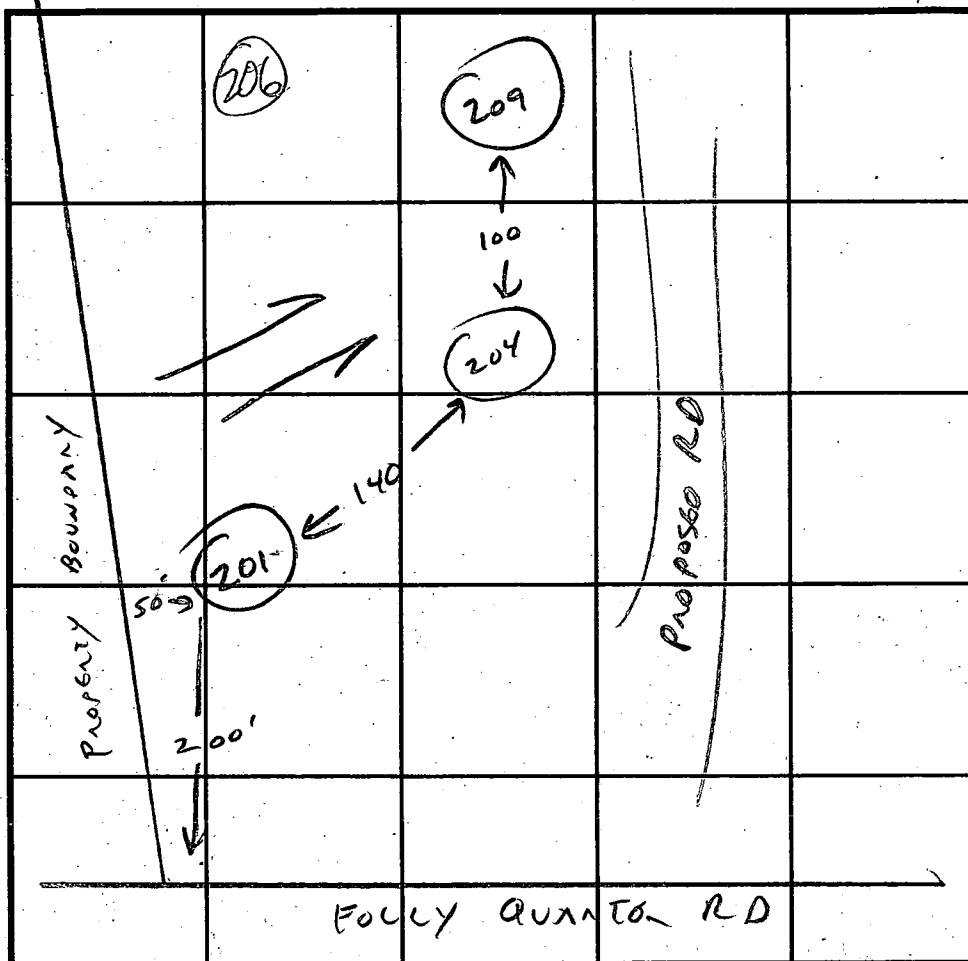

INDICATE NORTH - NAME ADJOINING ROADWAY AS BASE LINE.

DATE	TEST NO.	DEPTH	PRE-WET		TEST - 1" DROP		TIME
			START	STOP	START	STOP	
7/19/94	209	4'	4:59	5:05	5:05	5:15	10 MIN
		12'	VIS OR	4-12	POWDER	LOAM	
	204	4'	5:01	5:07	5:07	5:12	5 MIN
		12'					
	201	VIS OR 2-12'					
			MICA	LOAM			
7/20/94	206	4' 2"	10:24	10:27	10:27	10:30	3
	206	12' 2"					

REMARKS

TYPE OF SOIL

TESTED BY

C. Willha

ALSO PRESENT

C. SPERRY, D. KERR

TRENCH DESIGN DATA: AVERAGE PERCOLATION TIME

6

TRENCH WIDTH

2

INLET DEPTH


3 1/2

MAXIMUM BOTTOM DEPTH

7 1/2

SQ. FT./BEDROOM

180

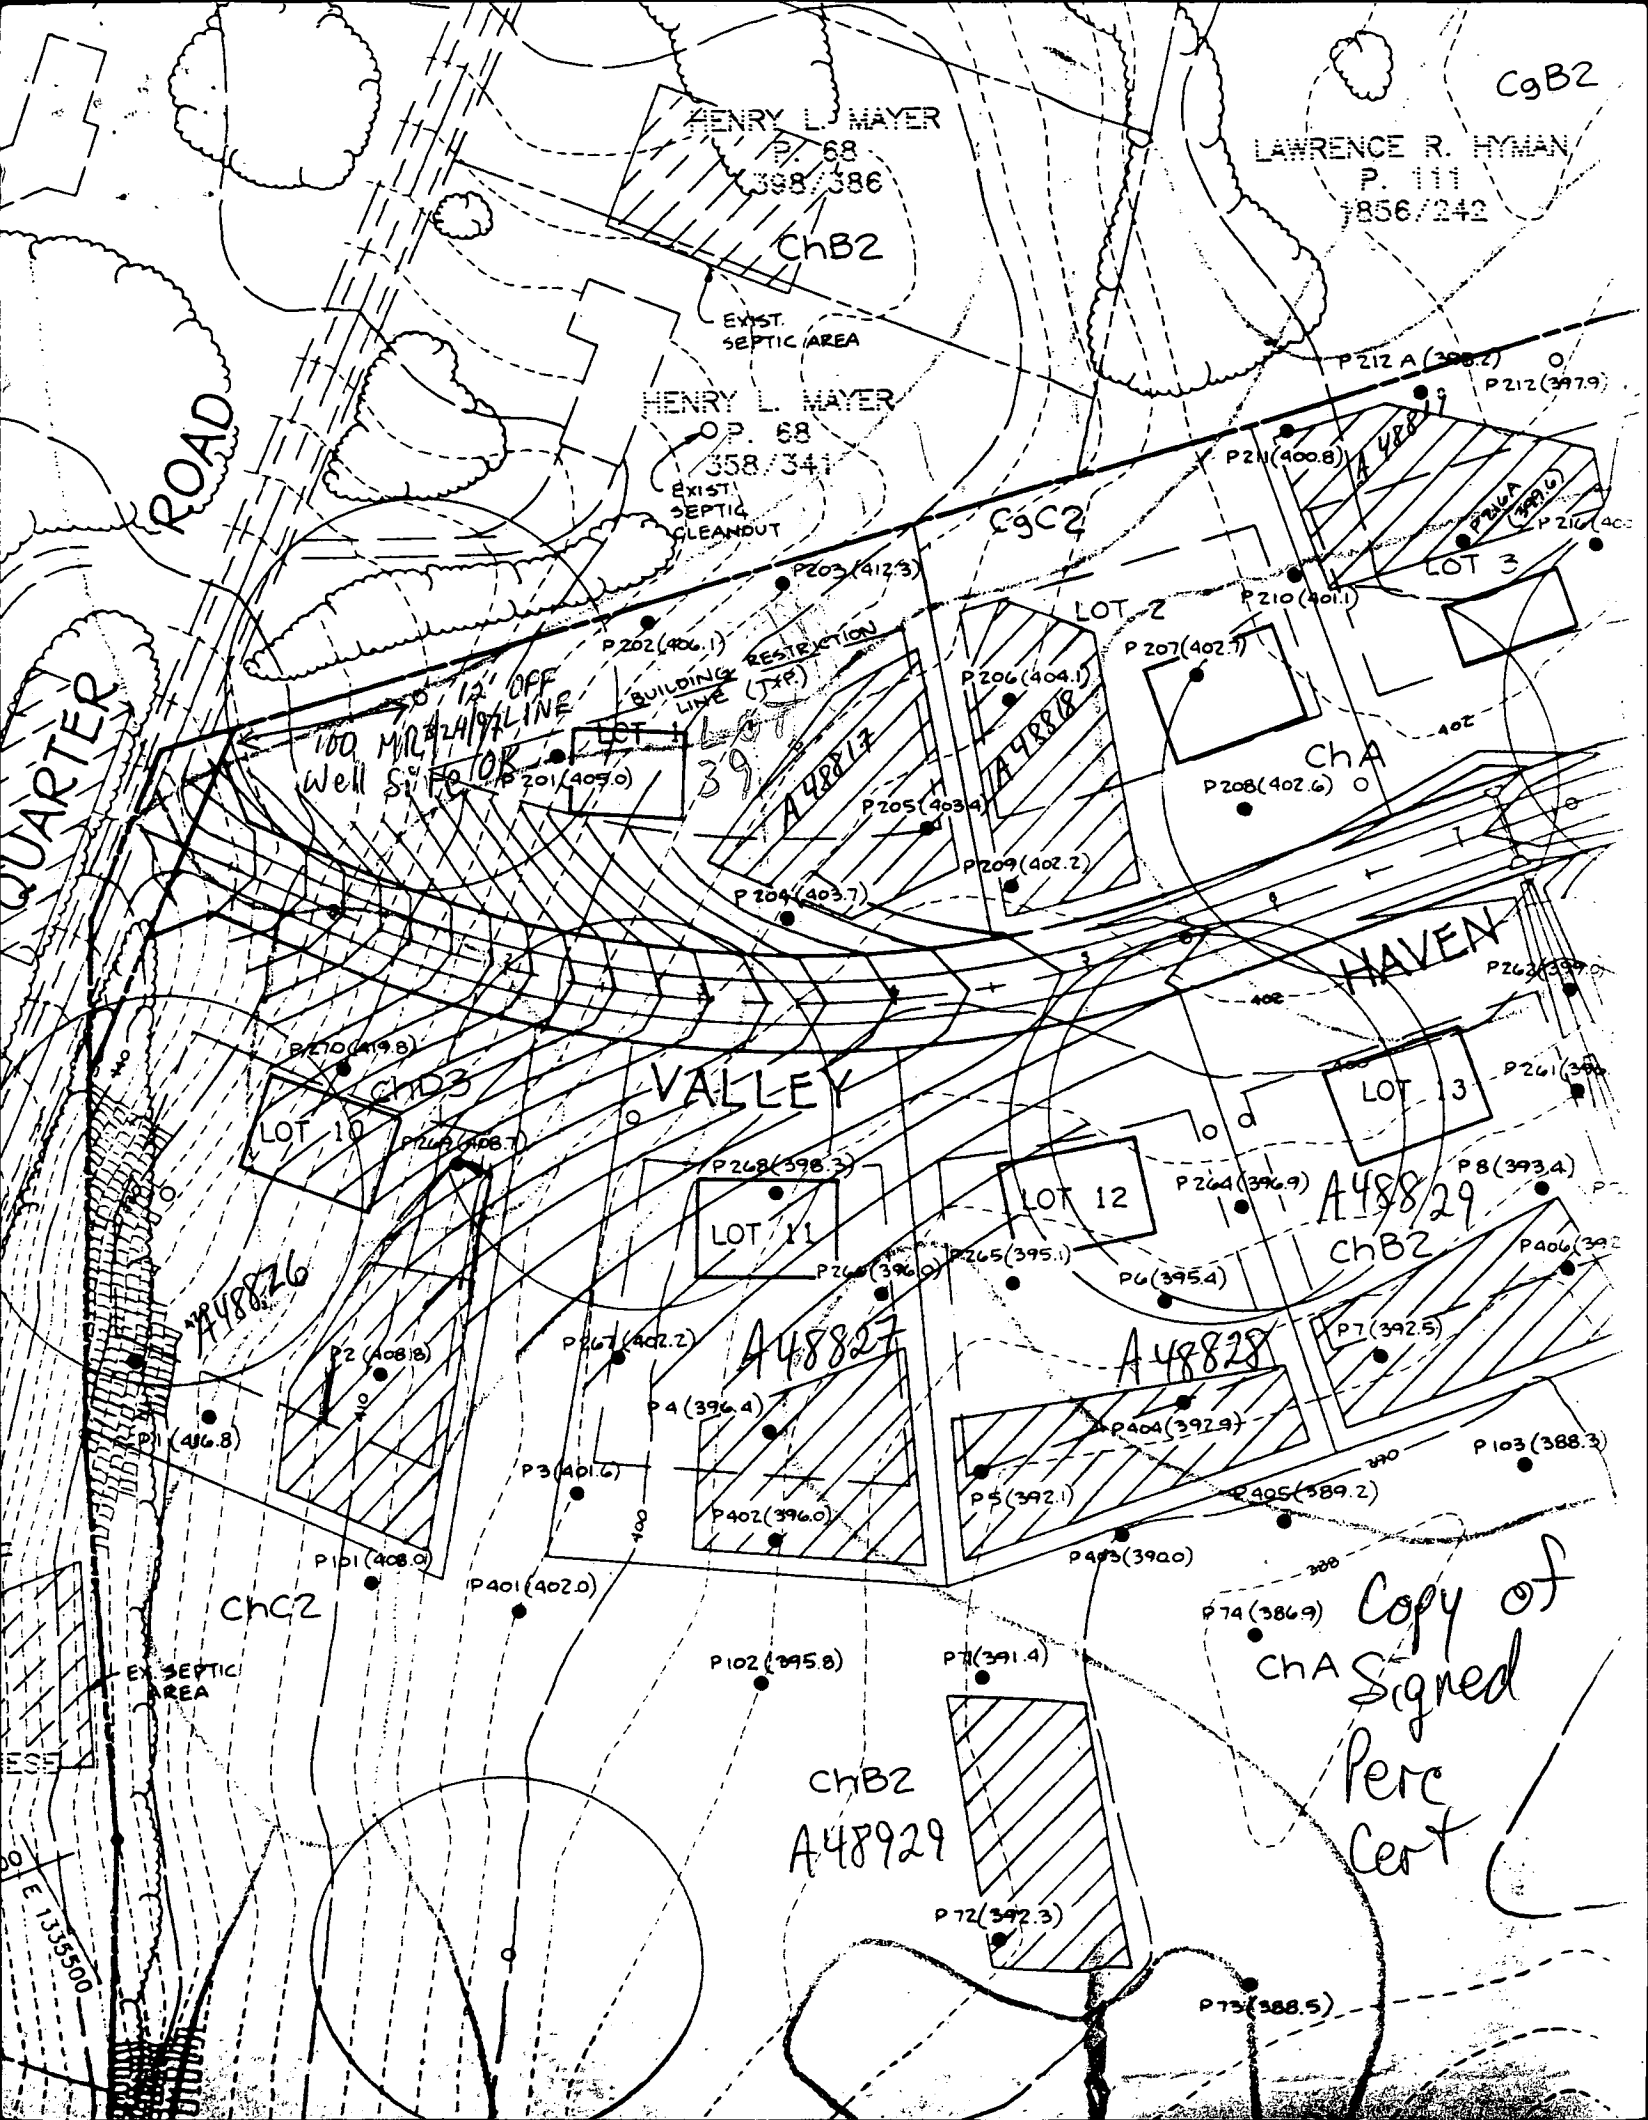

CgB2

LAWRENCE R. HYMAN
P. 111
1856/242

HENRY L. MAYER
P. 68
358/386
ChB2

EXIST.
SEPTIC AREA

HENRY L. MAYER
P. 68
358/341
EXIST.
SEPTIC
CLEANOUT

P212 A (398.2) O
P212 (397.9)

P211 (400.8)

P210A (399.0)
P210 (400.1)

LOT 3

LOT 2

P207 (402.7)

ChA
P208 (402.6) O

P206 (404.1)

P205 (403.4)

P209 (402.2)

P204 (403.7)

P202 (406.1)

P203 (412.3)

RESTRICTION
BUILDING LINE (TYP.)

12' OFF
100' MIN. 4\"/>

P201 (405.0)

VALLEY

HAVEN

P262 (397.0)

P261 (396.0)

P8 (393.4)

A48829

chB2

P264 (396.9)

P6 (395.4)

P265 (395.1)

P266 (396.0)

A48827

P4 (396.4)

P3 (401.6)

P402 (396.0)

P401 (402.0)

P101 (408.0)

ChC2

EXIST. SEPTIC AREA

P102 (395.8)

P7 (391.4)

ChB2
A48929

P72 (392.3)

P74 (386.9)

Copy of
ChA Signed
Per
Cert

P75 (388.5)



QUARTER

ROAD

ESE

00
E 1335500

C1		6091		SEQUENCE NO. (MDE USE ONLY)		STATE OF MARYLAND WELL COMPLETION REPORT FILL IN THIS FORM COMPLETELY PLEASE PRINT OR TYPE				THIS REPORT MUST BE SUBMITTED WITHIN 45 DAYS AFTER WELL IS COMPLETED.			
1 2 3 4 5 6 (THIS NUMBER IS TO BE PUNCHED IN COLS. 3-6 ON ALL CARDS)										COUNTY NUMBER <u>A48817</u>			
ST/CO/USE ONLY DATE RECEIVED <u>8/19/98</u>		DATE WELL COMPLETED MM <u>2</u> DD <u>2</u> YY <u>98</u>		Depth of Well 22 <u>285</u> 26 (TO NEAREST FOOT)		PERMIT NO. FROM "PERMIT TO DRILL WELL" <u>H0-94-1198</u>				28 29 30 31 32 33 34 35 36 37			
OWNER <u>Thompson</u>		last name		first name <u>Dale</u>		STREET OR RFD <u>Quarterfield Dr</u>				TOWN <u>W Friendship</u>			
SUBDIVISION <u>QUARTERFIELD</u>				SECTION <u>139</u>		LOT <u>139</u>							
WELL LOG Not required for driven wells		STATE THE KIND OF FORMATIONS PENETRATED, THEIR COLOR, DEPTH, THICKNESS AND IF WATER BEARING		DESCRIPTION (Use additional sheets if needed)		FEET FROM TO		check if water bearing					
Sand		0		102									
Gray Micabrock		102		285									
GROUTING RECORD		WELL HAS BEEN GROUTED (Circle Appropriate Box)		yes <u>Y</u> no <u>N</u>		TYPE OF GROUTING MATERIAL (Circle one)		CEMENT <u>CM</u> BENTONITE CLAY <u>BC</u>					
NO. OF BAGS <u>30</u>		NO. OF POUNDS <u>2820</u>		GALLONS OF WATER <u>180</u>		DEPTH OF GROUT SEAL (to nearest foot)		from <u>0</u> ft. to <u>100</u> ft.					
Casing types insert appropriate code below		Casing RECORD		STEEL <u>ST</u> CONCRETE <u>CO</u>		PLASTIC <u>PL</u> OTHER <u>OT</u>		MAIN CASING TYPE <u>ST</u>		Nominal diameter top (main) casing (nearest inch) <u>6</u>		Total depth of main casing (nearest foot) <u>106</u>	
OTHER CASING (if used)		diameter inch		depth (feet) from to									
SCREEN RECORD		screen type or open hole		STEEL <u>ST</u> BRASS <u>BR</u> OPEN HOLE <u>HO</u>		BRONZE <u>PL</u> OTHER <u>OT</u>		PLASTIC <u>PL</u> OTHER <u>OT</u>					
C2		DEPTH (nearest ft.)		1 2 3 100									
WELL HYDROFRACTURED		yes <u>Y</u> no <u>N</u>											
CIRCLE APPROPRIATE LETTER		A A WELL WAS ABANDONED AND SEALED WHEN THIS WELL WAS COMPLETED		E ELECTRIC LOG OBTAINED		P TEST WELL CONVERTED TO PRODUCTION WELL							
I HEREBY CERTIFY THAT THIS WELL HAS BEEN CONSTRUCTED IN ACCORDANCE WITH COMAR 26.04.04 "WELL CONSTRUCTION" AND IN CONFORMANCE WITH ALL CONDITIONS STATED IN THE ABOVE CAPTIONED PERMIT, AND THAT THE INFORMATION PRESENTED HEREIN IS ACCURATE AND COMPLETE TO THE BEST OF MY KNOWLEDGE.													
DRILLERS LIC. NO. 1 <u>MS DO 24</u>		DRILLERS SIGNATURE (MUST MATCH SIGNATURE ON APPLICATION)		<u>Joseph L Mayno</u>									
LIC. NO. 1 <u>MS DO 27</u>		SITE SUPERVISOR (sign. of driller or journeyman responsible for sitework if different from permittee)		<u>Joseph L Mayno</u>									
GRAVEL PACK IF WELL DRILLED WAS FLOWING WELL INSERT F IN BOX 68													
MDE USE ONLY (NOT TO BE FILLED IN BY DRILLER)		T (E.R.O.S.)		W Q									
TELESCOPE CASING		LOG INDICATOR		OTHER DATA									
PUMPING TEST		HOURS PUMPED (nearest hour)		<u>3</u>		PUMPING RATE (gal. per min.)		<u>7.5</u>		METHOD USED TO MEASURE PUMPING RATE <u>Bucket</u>			
WATER LEVEL (distance from land surface)		BEFORE PUMPING		<u>66</u> ft.		WHEN PUMPING		<u>166</u> ft.		TYPE OF PUMP USED (for test)			
A air		P piston		T turbine		C centrifugal		R rotary		O other (describe below)			
J jet		S submersible											
PUMP INSTALLED		DRILLER WILL INSTALL PUMP (CIRCLE) (YES or NO)		YES <u>NO</u>		IF DRILLER INSTALLS PUMP, THIS SECTION MUST BE COMPLETED FOR ALL WELLS.		TYPE OF PUMP INSTALLED PLACE (A,C,J,P,R,S,T,O) IN BOX 29		CAPACITY: GALLONS PER MINUTE (to nearest gallon)		31 35	
PUMP HORSE POWER		37 41				PUMP COLUMN LENGTH (nearest ft.)		43 47		CASING HEIGHT (circle appropriate box and enter casing height)			
+ above						LAND SURFACE				(nearest foot)			
- below													
LOCATION OF WELL ON LOT		SHOW PERMANENT STRUCTURE SUCH AS BUILDING, SEPTIC TANKS, AND /OR LANDMARKS AND INDICATE NOT LESS THAN TWO DISTANCES (MEASUREMENTS TO WELL)											
100 well													
Quarterfield Dr.													

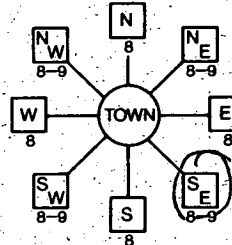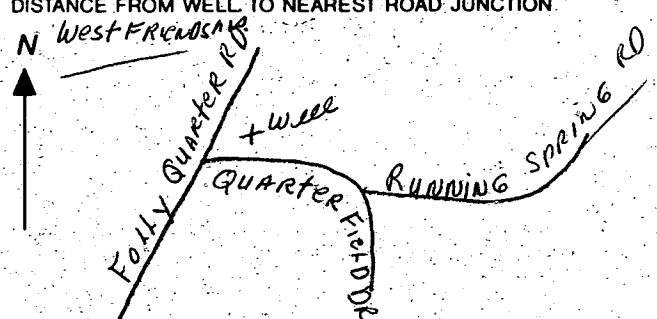B 1 1913 (THIS NUMBER IS TO BE PUNCHED IN COLS. 3-6 ON ALL CARDS)	SEQUENCE NO. (MDE USE ONLY)	STATE OF MARYLAND PERMIT TO DRILL WELL please print or type	STATE PERMIT NUMBER 10-94-1198 fill in this form completely
Date Received (APA) 020196		B 3 LOCATION OF WELL HOWARD 8 COUNTY QUARTERFIELD 23 SUBDIVISION SECTION 44 LOT 39 WEST FRIENDSHIP 52 NEAREST TOWN MILES FROM TOWN (enter 0 if in town) 4 M I 73 76 77 78	
OWNER INFORMATION HOMPSON DALE 15 Last Name Owner First Name 10005010COLUMBIA RD 36 Street or RFD COLUMBIA MD 21046 57 Town 70 State 72 Zip 76		DRILLER INFORMATION CIRCLE: MSD/MGD/MWD Joseph L. Mayne Driller's Name Joseph L. Mayne Well Drilling Firm Name 5512 Ridge Rd. Mt. Airy MD 21771 Address Joseph L. Mayne 2/1/96 Signature Date	
B 2 WELL INFORMATION APPROX. PUMPING RATE (GAL. PER MIN.) 5 0 0 8 12 AVERAGE DAILY QUANTITY NEEDED (GAL. PER DAY) 500 0 0 0 14 20		B 4 DIRECTION OF WELL FROM TOWN (CIRCLE BOX)  NEAR WHAT ROAD QUARTERFIELD DR. 11 30 ON WHICH SIDE OF ROAD (CIRCLE APPROPRIATE BOX) 90 0 0 34 37 DISTANCE FROM ROAD ENTER FT OR MI 4 A 38 39 TAX MAP 23 BLK: 8 PARCEL 82	
USE FOR WATER (CIRCLE APPROPRIATE BOX) ☒ HOME (SINGLE OR DOUBLE HOUSEHOLD UNIT ONLY) ☐ FARMING (LIVESTOCK WATERING & AGRICULTURAL IRRIGATION) ☐ INDUSTRIAL, COMMERCIAL, STATE AND FEDERAL GOV. OTHER (REQUIRES APPROPRIATION PERMIT) ☐ PUBLIC OR PRIVATE WATER COMPANY (REQUIRES APPROPRIATION PERMIT AND STATE HEALTH DEPARTMENT APPROVAL) ☐ TEST, OBSERVATION, MONITORING (MAY REQUIRE APPROPRIATION PERMIT)		NOT TO BE FILLED IN BY DRILLER HEALTH DEPARTMENT APPROVAL Howard A48817 COUNTY NAME COUNTY NO. STATE SIGNATURE Mark E. Aplin 6/12/98 DATE ISSUED 061297 0823000 0823000 43 48 CO SIGNATURE EXP. DATE NORTH GRID 523000 EAST GRID 0823000 50 55 57 63	
APPROXIMATE DEPTH OF WELL 220 0 0 FEET 24 28 APPROXIMATE DIAMETER OF WELL 6 INCH NEAREST		SHOW MAJOR FEATURES OF BOX & LOCATE WELL WITH AN X SOURCES OF DRILLING WATER 1. WELL 2. 3. WRITE THE BOX NUMBER FROM THE MAP HERE 823 3 E N DRAW A SKETCH BELOW SHOWING LOCATION OF WELL IN RELATION TO NEARBY TOWNS AND ROADS AND GIVE DISTANCE FROM WELL TO NEAREST ROAD JUNCTION. 	
METHOD OF DRILLING (circle one) ☒ BORED (or Augered) ☐ JETTED ☐ Jetted & DRIVEN ☐ AIR-ROTARY ☐ AIR-PERCussion ☐ ROTARY (Hydraulic Rotary) ☐ CABLE ☐ REVERSE-ROTARY ☐ DRIVE-POINT other _____		REPLACEMENT OR DEEPEMED WELLS (CIRCLE APPROPRIATE BOX) ☒ THIS WELL WILL NOT REPLACE AN EXISTING WELL ☐ THIS WELL WILL REPLACE A WELL THAT WILL BE ABANDONED AND SEALED ☐ THIS WELL WILL REPLACE A WELL THAT WILL BE USED AS A STANDBY. CONTACT LOCAL APPROVING AUTHORITY FOR POLICY ON STANDBY WELLS ☐ THIS WELL WILL DEEPEN AN EXISTING WELL PERMIT NUMBER OF WELL TO BE REPLACED OR DEEPEMED (IF AVAILABLE) 41 0 0 0 0 0 0 0 0 54 52	
Not to be filled in by driller (MDE OR COUNTY USE ONLY) APPROP. PERMIT NUMBER GAP 0 0 0 0 0 0 0 0 0 54 63 FORCE M12 WRITE INITIALS IN BOX PERMIT No. 10-94-1198 67 68 70 71 72 73 74 75 76 77 78 79			
SPECIAL CONDITIONS NOTE - APPROVING AUTHORITIES SHOULD USE SEPARATE SHEET IF NEEDED			