


48827 A

RON. CONCRETE

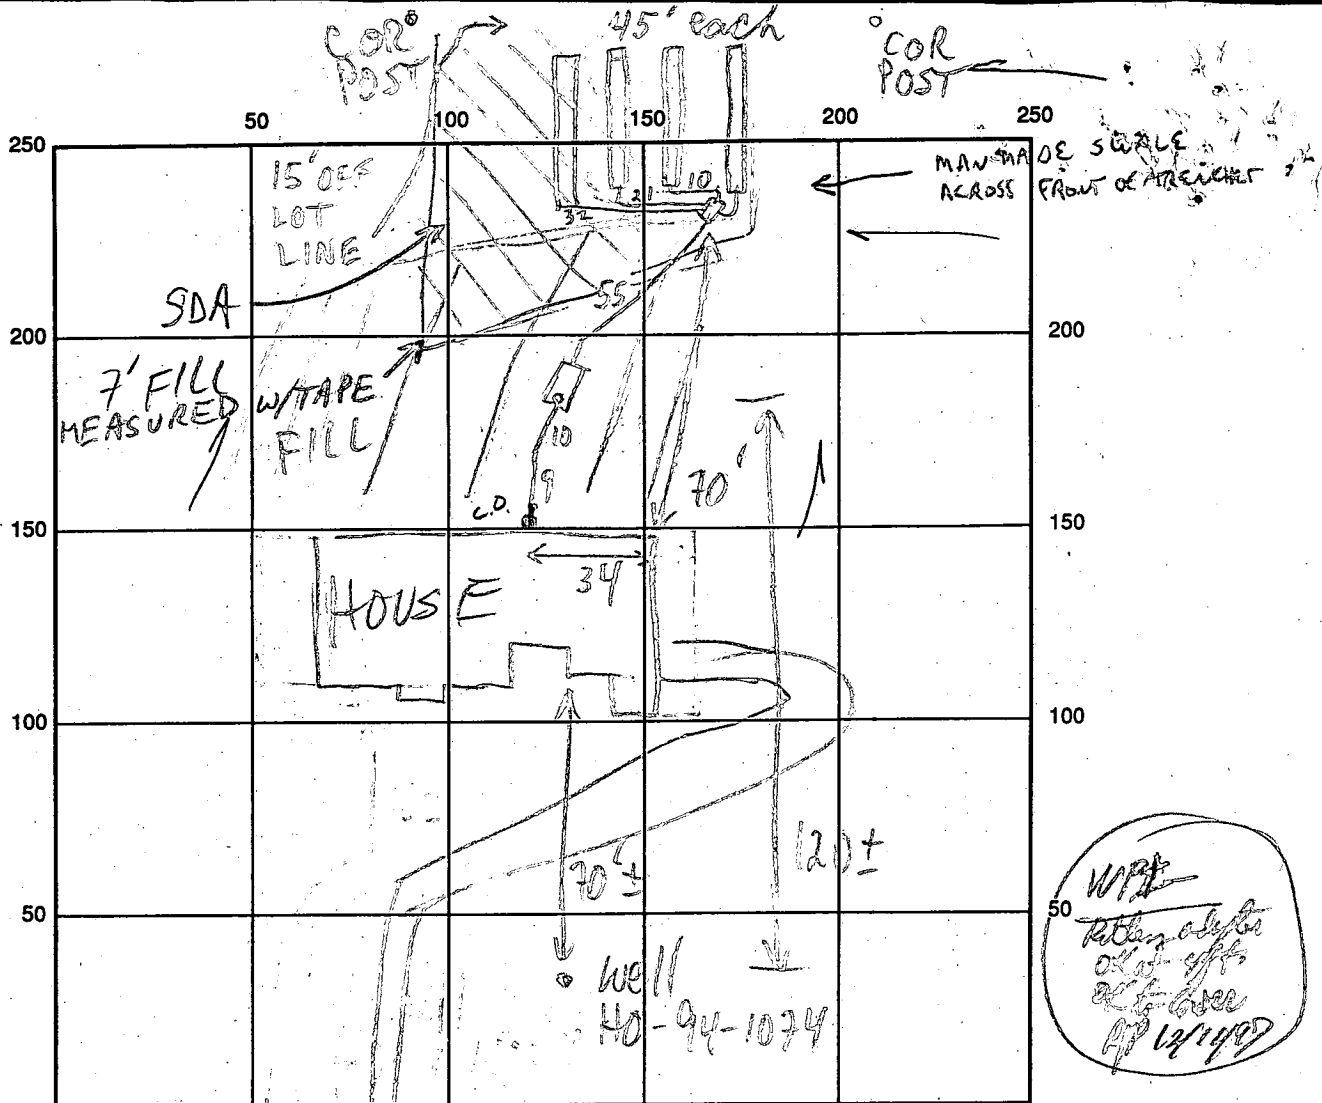

QUARTERFIELD DR INDICATE NORTH - NAME ADJOINING ROADWAY AS BASE LINE

SEPTIC TANK LEVEL 1250 GAL - OK

CLEANOUTS S.T. & INLINE - OK

DISTRIBUTION BOX LEVEL BAFFLE IN

DRAIN FIELD/TITLE DEPTH 7 1/2 FT. TRENCH WIDTH 2 FT. INLET DEPTH 3 1/2 FT.

EFFECTIVE GRAVEL DEPTH 4 FT. TOTAL LENGTH 4 @ 45 FT.

NUMBER OF TRENCHES 4 ONE SIDEWALL/BOTTOM AREA 4 @ 180 SQ. FT.

DRYWALL INSIDE DIAMETER — FT. EFFECTIVE DEPTH BELOW INLET — FT.

ABSORBENT AREA — SQ. FT.

REMARKS: 10/17/97 #1 D.B. 20' TOO FAR BACK. INSTALLER WANTED TO KEEP IT OUT OF FILL, WHICH HAS COVERED FRONT 20% OF SEPTIC AREA; CONTINUE (MR) 10/17/97 #2 OK TO COVER TANK & TRENCHES; HOLD FOR HOUSE CONN. (MR) 10/23/97 SITE INFO: 3' FILL COVERING FRONT OF SDA, AREA STILL USABLE, DRAINAGE MAY BE A PROBLEM. 20' OF SDA CLOSE TO HOUSE IS 15-20% SLOPE. HOUSE CONNECTION MADE, COVER ALL WORK

DATE SYSTEM APPROVED 10/24/97

INSPECTOR Blair

10/28/97 MTG W/DALE T., FOGLE'S. RE: GRADING - IT WAS AGREED THAT CONDITION NOT APPROPRIATE, BUT ACCEPTED; 2 REPAIRS REMAIN MR/CW

APPLICATION

PERCOLATION TESTING

27
A 488/10
P _____

HOWARD COUNTY HEALTH DEPARTMENT
BUREAU OF ENVIRONMENTAL HEALTH
3525-H ELLICOTT MILLS DRIVE/ELLICOTT CITY, MARYLAND 21043
TELEPHONE: 313-2840

DISTRICT _____

DATE 1/7/93

TO: THE COUNTY HEALTH OFFICER
ELLICOTT CITY, MARYLAND

I HEREBY APPLY FOR THE NECESSARY TEST PRIOR TO APPLICATION FOR PERMIT TO CONSTRUCT (OR RECONSTRUCT) A SEWAGE DISPOSAL SYSTEM.

PROPERTY OWNER Joseph M. Zoller, III DALE Thompson Builders
11696 Carroll Mill Road
ADDRESS Ellicott City, Maryland 21043 PHONE _____

AGENT OR PROSPECTIVE BUYER SDC Group, Inc.
ADDRESS P.O. Box 417, Ellicott City, MD 21041 PHONE (410) 465-4244

PROPERTY LOCATION:

SUBDIVISION Zoller Property LOT NO. X-24 11

ROAD AND DESCRIPTION Northeast quadrant Folly Quarter Road and Carroll Mill Road
intersection. (11608 Quarterfield Drive)

TAX MAP 23 PARCEL # 8,82 & 101

SIZE OF LOT 1 Ac +/- TYPE BLDG. Single Family - 4 Bed
(SINGLE FAMILY DWELLING OR COMMERCIAL)

THE SYSTEM INSTALLED UNDER THIS APPLICATION IS ACCEPTABLE ONLY UNTIL PUBLIC FACILITIES BECOME AVAILABLE. I FULLY UNDERSTAND THE
FEE CONNECTED WITH THE FILING OF THIS PERC TEST APPLICATION IS NON-REFUNDABLE UNDER ANY CIRCUMSTANCES. I ALSO AGREE TO
COMPLY WITH ALL M.O.S.H.A. REQUIREMENTS IN TESTING THIS LOT. SDC Group Inc.
Buy: [Signature] VS
(SIGNATURE OF APPLICANT)

APPROVED BY _____ FOR _____ DATE _____

DISAPPROVED BY _____ FOR _____ DATE _____

HOLD PENDING FURTHER TESTS _____

REASONS FOR REJECTION OR HOLDING HOLD FOR PLAT - PERC OK MR 7/22/93

PERCOLATION TEST PLAT/PRELIMINARY PLAT - TITLE OR I.D. # _____ DATE _____

SITE DEVELOPMENT PLAN/FINAL PLAT - TITLE OR I.D. # _____ DATE _____

THIS IS NOT A PERMIT

A48852

COUNTY #

Lot 36

SOIL PROFILE

(4) (5)

brn
sa cl
lm

2 1/2

org br
sa mica

lm

10-15% frags



12

(3)

bra sa
cl lm

2 1/2

org bra
sa mica
lm

10% frags



12 1/4"

(102)


brn yel
org
sa clay

10-15% frags

15

brn org
sa mica
lm
10% frags


12

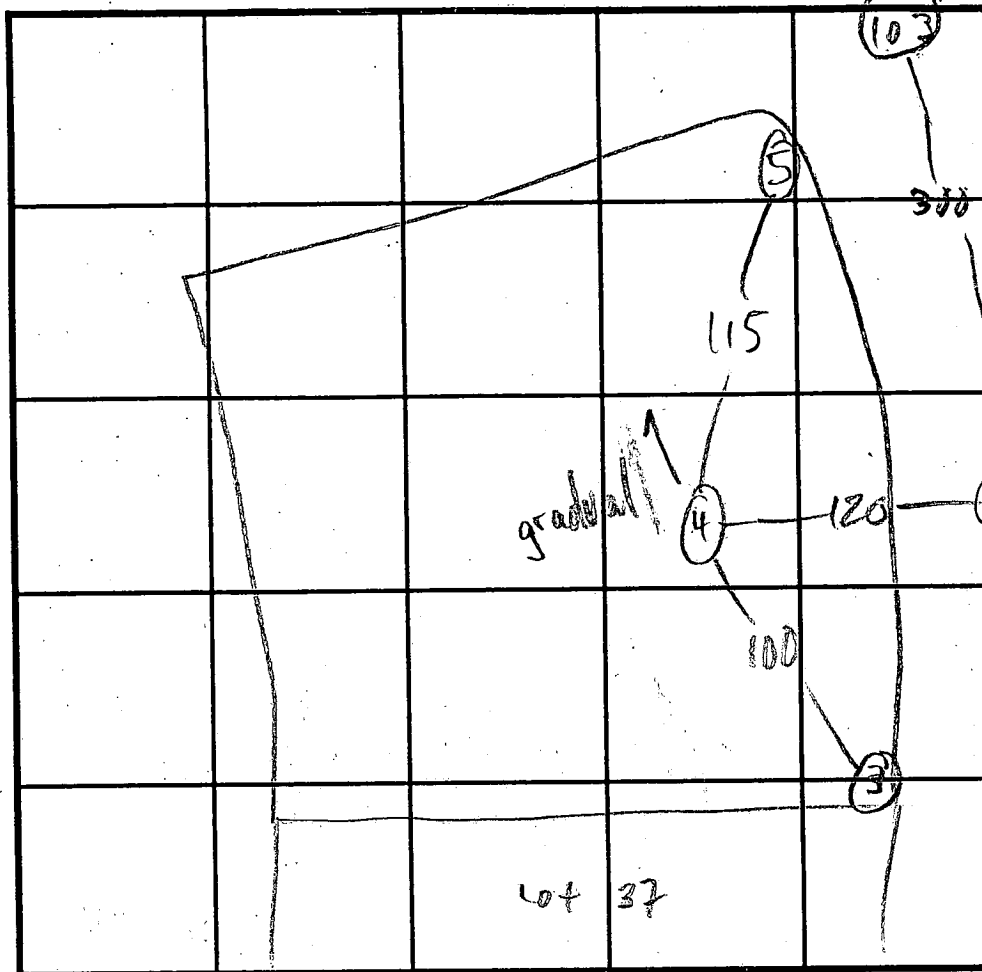

INDICATE NORTH - NAME ADJOINING ROADWAY AS BASE LINE.

SOIL PROFILE

0'

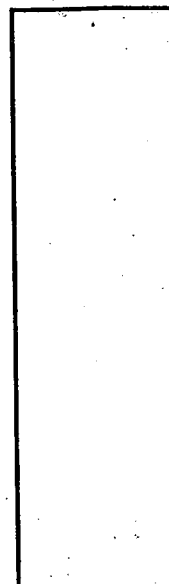

DATE	TEST NO.	DEPTH	PRE-WET		TEST - 1" DROP		TIME
			START	STOP	START	STOP	
2/2/93	3 S	3 1/2	12:24:00	12:24:30	12:24:30	12:25	30 sec
	3 S	3 1/2	12:25:30	12:26:00	12:26:00	12:26:45	45 sec
	3 S	3 1/2	12:27:20	12:28	12:28	12:29:00	1 min
	3 M	8	12:28:45			12:29:45	FAST
	3 M	8	12:32:00	12:36	12:36	12:42	6 EST
	3 V	12 1/4"	see profile				
	4 S	3 1/2	12:45:30	12:52	12:52	12:56	4
	4 M	8	12:47:00	12:49	12:49	12:53	4
	4 V	12	see profile				
	5	3 1/2	1:06	1:12	1:12	1:18	6
	5	8 1/2	1:07	1:08	1:08	1:10	2
	5	12 1/2	see profile				
2/9/93	102 S	6	3:28:15	3:32	3:32	3:39	7
	102 M	8 1/2	3:29:15			3:30:00	FAST
	102 M	8 1/2	3:30:15	3:31:45	3:31:45	3:35:30	3 3/4 min
	102 V	12					

REMARKS

TYPE OF SOIL

TESTED BY

M. Riskin

ALSO PRESENT

TRENCH DESIGN DATA: AVERAGE PERCOLATION TIME

4

TRENCH WIDTH

2

INLET DEPTH

3

MAXIMUM BOTTOM DEPTH

7

SQ. FT./BEDROOM

180

APPLICATION

PERCOLATION TESTING

A 48827

P _____

HOWARD COUNTY HEALTH DEPARTMENT

BUREAU OF ENVIRONMENTAL HEALTH

3525-H ELLICOTT MILLS DRIVE/ELLICOTT CITY, MARYLAND 21043
TELEPHONE: 313-2840

DISTRICT _____

DATE _____

TO: THE COUNTY HEALTH OFFICER
ELLICOTT CITY, MARYLAND

I HEREBY APPLY FOR THE NECESSARY TEST PRIOR TO APPLICATION FOR PERMIT TO CONSTRUCT (OR RECONSTRUCT) A SEWAGE DISPOSAL SYSTEM.

PROPERTY OWNER Joseph M. Zoller, III

11696 Carroll Mill Road

ADDRESS Ellicott City, Maryland 21043 PHONE _____

AGENT OR PROSPECTIVE BUYER SDC Group, Inc.

ADDRESS P.O. Box 417, Ellicott City, MD 21041 PHONE (410) 465-4244

PROPERTY LOCATION:

SUBDIVISION Zoller Property LOT NO. 2411

ROAD AND DESCRIPTION Northeast quadrant Folly Quarter Road and Carroll Mill Road
intersection.

TAX MAP 23 PARCEL # 8,82 & 101

SIZE OF LOT 1 Ac +/- TYPE BLDG. Single Family
(SINGLE FAMILY DWELLING OR COMMERCIAL)

THE SYSTEM INSTALLED UNDER THIS APPLICATION IS ACCEPTABLE ONLY UNTIL PUBLIC FACILITIES BECOME AVAILABLE. I FULLY UNDERSTAND THE
FEE CONNECTED WITH THE FILING OF THIS PERC TEST APPLICATION IS NON-REFUNDABLE UNDER ANY CIRCUMSTANCES. I ALSO AGREE TO

COMPLY WITH ALL M.O.S.H.A. REQUIREMENTS IN TESTING THIS LOT. By: [Signature] J.E.
(SIGNATURE OF APPLICANT)

APPROVED BY _____ FOR _____ DATE _____

DISAPPROVED BY _____ FOR _____ DATE _____

HOLD PENDING FURTHER TESTS _____

REASONS FOR REJECTION OR HOLDING _____

PERCOLATION TEST PLAT/PRELIMINARY PLAT - TITLE OR I.D. # _____ DATE _____

SITE DEVELOPMENT PLAN/FINAL PLAT - TITLE OR I.D. # _____ DATE _____

THIS IS NOT A PERMIT

266

DENSE
silva

occasional
rock,
6-8'

13'

402

mica / m

4'

mica
si /m

large
rock
pocket

8-12'
soil
around

 $12\frac{1}{2}$

268

mica
si lm

top
to
bot

indefinite
mottles


13

16

267

mica
si / m
top
to
bot

13.

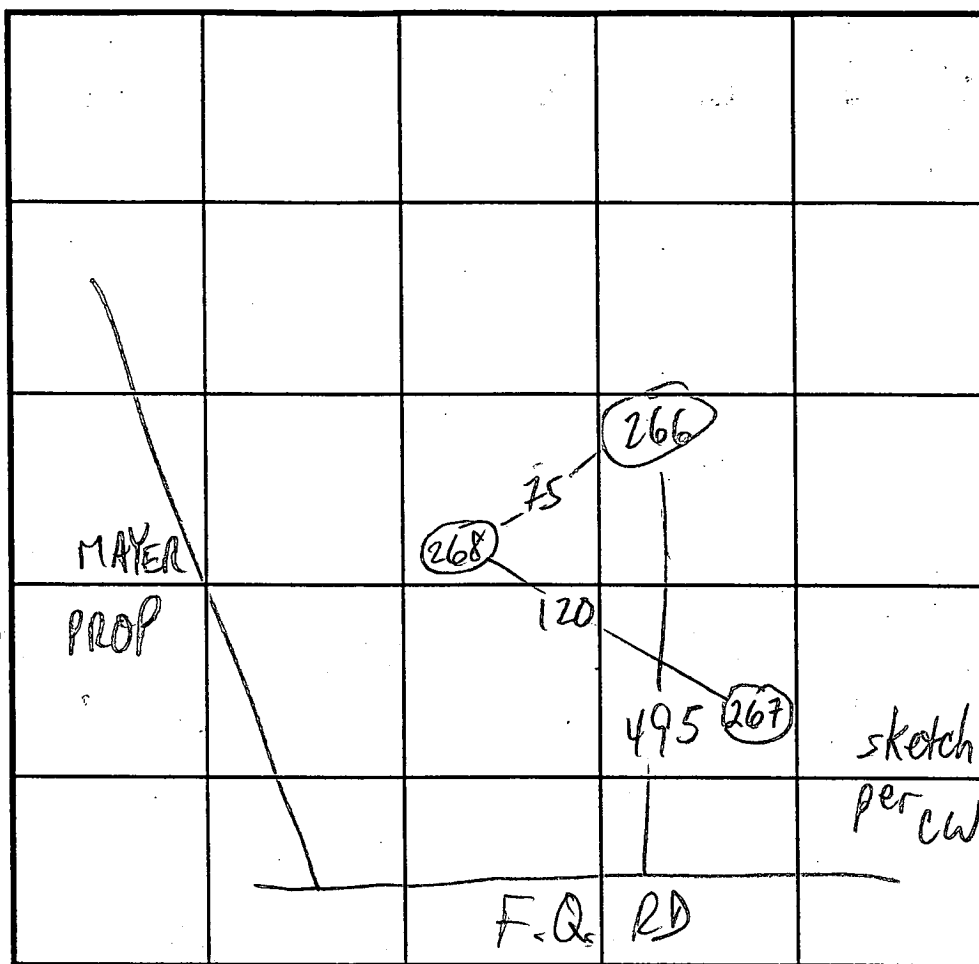

INDICATE NORTH - NAME ADJOINING ROADWAY AS BASE LINE.

DATE	TEST NO.	DEPTH	PRE-WET		TEST - 1" DROP		TIME
			START	STOP	START	STOP	
7/19/94	266	4	2:57	3:00	3:00	3:04	4
		13	VIS OK	TO 13'			
	402	4	3:02	3:04:30	3:04:30	3:08	3 1/2
		12 1/2	VIS OK	TO 8',	VARIABLE	ROCK 8-12'	
	268	4 1/2	2:51	2:52	2:52	2:55	3
		12 1/2					
	267	5	2:47	2:49	2:49	2:51	2
		13	VIS OK				

REMARKS

TYPE OF SOIL

TESTED BY

CW, copied by MK

ALSO PRESENT

TRENCH DESIGN DATA: AVERAGE PERCOLATION TIME

TRENCH WIDTH 2

INLET DEPTH


MAXIMUM BOTTOM DEPTH

SQ FT/BEDROOM 180

Septic Grades & Elevations		
	Inv.	Grade
INVERT @ HOUSE	395.0	398.00
INVERT @ ENTRANCE TO TANK	394.75	
INVERT @ EXIT FROM TANK	394.5	
INVERT @ DISTRIBUTION BOX	393.0	396.00
*Length of trench to be determined at septic permit		

REVISED
SITE PLAN OK
MR 7/24/97

(ORIGINAL SITE
PLAN APPROVED
3/26/97)

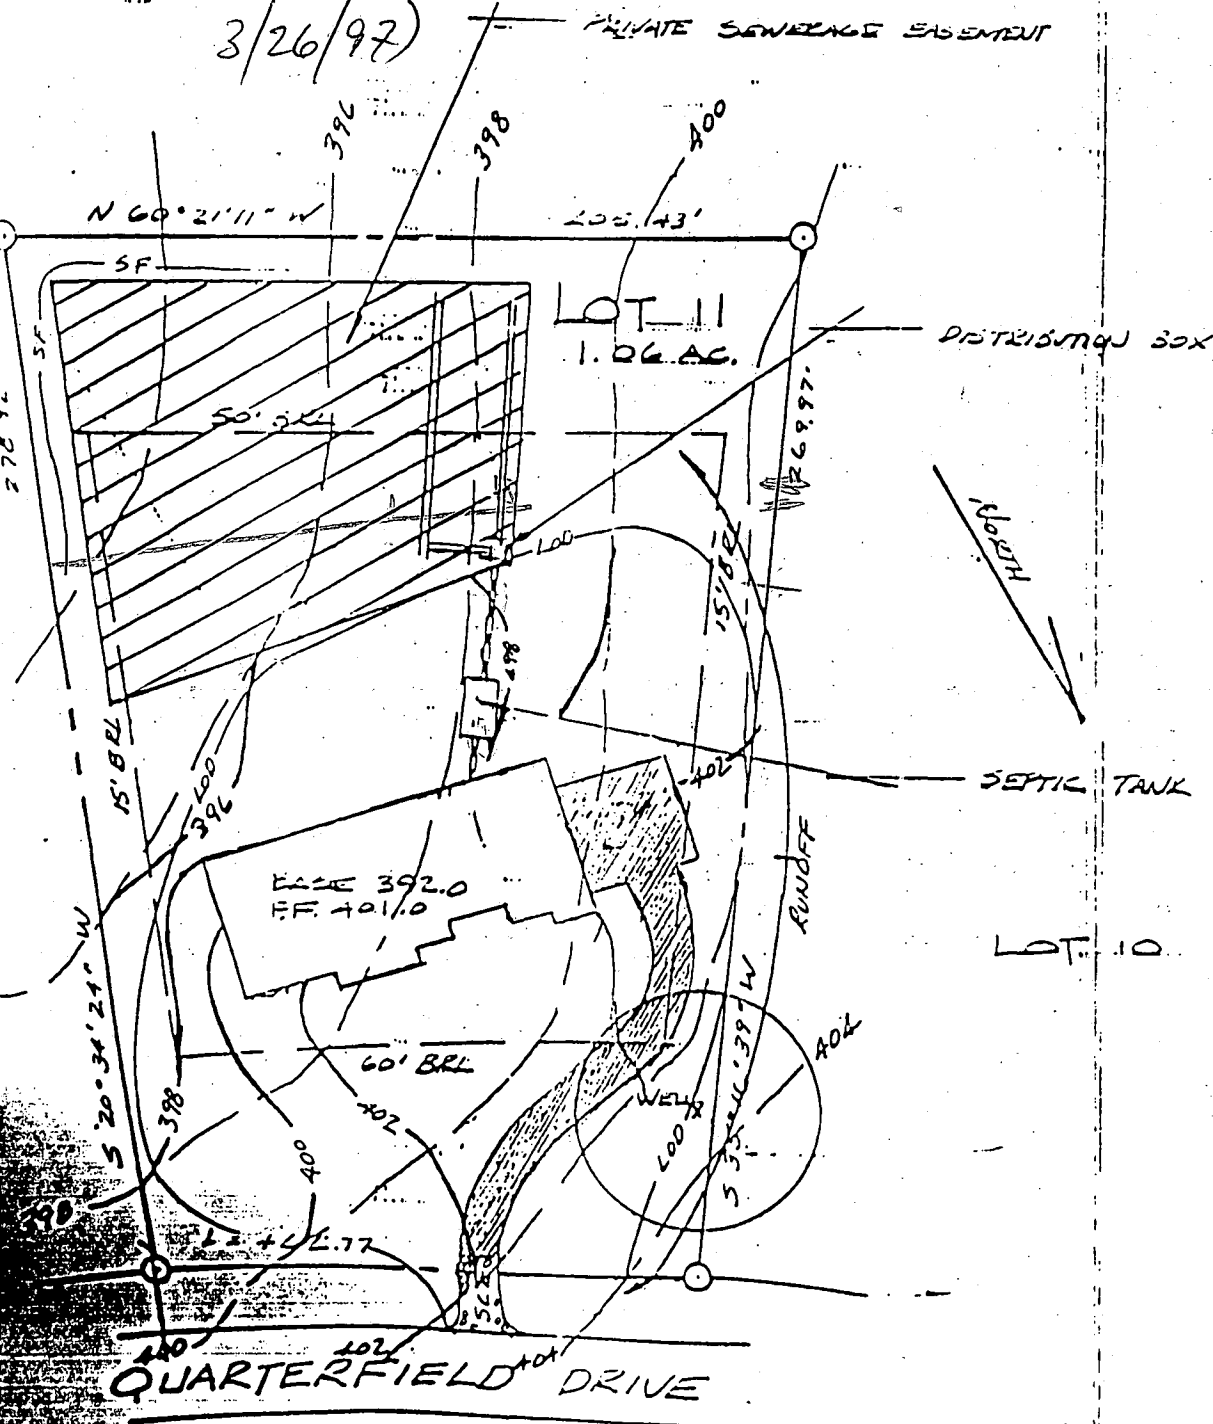

1130

R
Date: 7
Comme
Rise

11

C16092

SEQUENCE NO.
(MDE USE ONLY)

STATE OF MARYLAND
WELL COMPLETION REPORT
FILL IN THIS FORM COMPLETELY
PLEASE PRINT OR TYPE

THIS REPORT MUST BE SUBMITTED WITHIN
45 DAYS AFTER WELL IS COMPLETED.

COUNTY
NUMBERA-48827

PERMIT NO.
FROM "PERMIT TO DRILL WELL"
HO-94-1074

ST/CO USE ONLY
DATE Received
MM3/25/97
DD13
YY97

DATE WELL COMPLETED
MM3
DD18
YY97

Depth of Well
2210526
(TO NEAREST FOOT)

OWNERSDC GROUP

STREET OR RFDlast nameQUARTERFIELD RDfirst nameTOWNWEST FRIENDSHIP

SUBDIVISIONQUARTERFIELD LOT 11SECTIONLOT11

WELL LOG

Not required for driven wells

STATE THE KIND OF FORMATIONS PENETRATED, THEIR
COLOR, DEPTH, THICKNESS AND IF WATER BEARING

DESCRIPTION (Use
additional sheets if needed)

FEET
FROMTO

check
if water
bearing

Sand070

Gray mica Rock70105

GROUTING RECORD

WELL HAS BEEN GROUTED
(Circle Appropriate Box)

TYPE OF GROUTING MATERIAL (Circle one)

CEMENTCMBENTONITE CLAYBC

NO. OF BAGS23NO. OF POUNDS2162

GALLONS OF WATER138

DEPTH OF GROUT SEAL (to nearest foot)

from0ft. to69ft.
48TOP5254BOTTOM58ft.
(enter 0 if from surface)

CASING RECORD

casing
types
insert
appropriate
code
below

STSTEELCOCONCRETE

PLPLASTICOTOOTHER

MAIN
CASING
TYPE

ST677

606163646670

Nominal diameter
top (main) casing
(nearest inch)!

Total depth
of main casing
(nearest foot)

OTHER CASING (if used)

diameter
inch

depth (feet)
fromto

SCREEN RECORD

screen type
or open hole

insert
appropriate
code
below

STSTEELBRBRASSHOOPEN HOLE

PLPLASTICOTOOTHER

NUMBER OF UNSUCCESSFUL WELLS:0

WELL HYDROFRACTUREDyesYnoN

CIRCLE APPROPRIATE LETTER

A A WELL WAS ABANDONED AND SEALED
WHEN THIS WELL WAS COMPLETED

E ELECTRIC LOG OBTAINED

P TEST WELL CONVERTED TO PRODUCTION
WELL

I HEREBY CERTIFY THAT THIS WELL HAS BEEN CONSTRUCTED IN
ACCORDANCE WITH COMAR 26.04.04 "WELL CONSTRUCTION" AND
IN CONFORMANCE WITH ALL CONDITIONS STATED IN THE ABOVE
CAPTIONED PERMIT, AND THAT THE INFORMATION PRESENTED
HEREIN IS ACCURATE AND COMPLETE TO THE BEST OF MY
KNOWLEDGE.

DRILLERS LIC. NO.1MSD0241

DRILLERS SIGNATURE

(MUST MATCH SIGNATURE ON APPLICATION)

LIC. NO.1MD

DEPTH (nearest ft.)

12

14072105

8911151721

232426303236

383941454751

SLOT SIZE 123

DIAMETER
OF SCREEN

(NEAREST
INCH)

5660

fromto

GRAVEL PACK
IF WELL DRILLED
WAS FLOWING WELL
INSERT F IN BOX 68

MDE USE ONLY
(NOT TO BE FILLED IN BY DRILLER)

T(E.R.O.S.)WQ

7072747576

TELESCOPE
CASING

LOG
INDICATOR

OTHER DATA

C3

PUMPING TEST

HOURS PUMPED (nearest hour)389

PUMPING RATE (gal. per min.)201115

METHOD USED TO
MEASURE PUMPING RATEBucket

WATER LEVEL (distance from land surface)

BEFORE PUMPING421720ft.

WHEN PUMPING422225ft.

TYPE OF PUMP USED (for test)

AairPpistonTturbine

272727

CcentrifugalRrotaryOother (describe below)

272727

JjetSsubmersible

2727

PUMP INSTALLED

DRILLER WILL INSTALL PUMP YESNO

(CIRCLE) (YES or NO)

IF DRILLER INSTALLS PUMP, THIS SECTION
MUST BE COMPLETED FOR ALL WELLS.

TYPE OF PUMP INSTALLED
PLACE (A,C,J,P,R,S,T,O)
IN BOX 29

CAPACITY:
GALLONS PER MINUTE
(to nearest gallon)3135

PUMP HORSE POWER3741

PUMP COLUMN LENGTH
(nearest ft.)4347

CASING HEIGHT (circle appropriate box
and enter casing height)

+above49

-below5(nearest foot)
495051

LAND SURFACE

LOCATION OF WELL ON LOT

SHOW PERMANENT STRUCTURE SUCH AS
BUILDING, SEPTIC TANKS, AND /OR
LANDMARKS AND INDICATE NOT LESS
THAN TWO DISTANCES
(MEASUREMENTS TO WELL)

Quartermfield Dr.

40' well

SITE SUPERVISOR (sign. of driller or journeyman
responsible for sitework if different from permittee)

COUNTY

B 1 1907 <small>(THIS NUMBER IS TO BE PUNCHED IN COLS. 3-6 ON ALL CARDS)</small>	SEQUENCE NO. (MDE USE ONLY)	STATE OF MARYLAND PERMIT TO DRILL WELL please print or type	STATE PERMIT NUMBER HO-94-1074 <small>fill in this form completely</small>
Date Received (APA) <div style="border: 1px solid black; width: 100px; height: 20px; margin-bottom: 5px;"></div> OWNER INFORMATION <div style="border: 1px solid black; padding: 2px;"> <div style="display: flex; justify-content: space-between;"> 8 13 </div> <div style="display: flex; justify-content: space-between;"> 15 Last Name Owner First Name 34 </div> <div style="display: flex; justify-content: space-between;"> 36 Street or RFD 55 </div> <div style="display: flex; justify-content: space-between;"> 57 Town 70 State 72 Zip 76 </div> </div>		B 3 LOCATION OF WELL <div style="border: 1px solid black; padding: 2px;"> <div style="display: flex; justify-content: space-between;"> 8 21 </div> <div style="display: flex; justify-content: space-between;"> 23 SUBDIVISION 42 </div> <div style="display: flex; justify-content: space-between;"> SECTION LOT </div> <div style="display: flex; justify-content: space-between;"> 44 46 48 50 </div> </div> <div style="border: 1px solid black; padding: 2px; margin-top: 5px;"> <div style="display: flex; justify-content: space-between;"> 52 NEAREST TOWN 71 </div> </div> <div style="display: flex; justify-content: space-between; margin-top: 5px;"> MILES FROM TOWN (enter 0 if in town) 73 76 77 78 </div>	
DRILLER INFORMATION CIRCLE: MSD/MGD/MWD <div style="border: 1px solid black; padding: 2px; margin-bottom: 5px;"> <div style="display: flex; justify-content: space-between;"> 77 License No. 80 24 </div> </div> <div style="border: 1px solid black; padding: 2px;"> <div style="display: flex; justify-content: space-between;"> Driller's Name 77 License No. 80 </div> <div style="display: flex; justify-content: space-between;"> Driller's Name 77 License No. 80 </div> <div style="display: flex; justify-content: space-between;"> 5512 Ridge Rd. Mt. Airy, Md. 21771 </div> <div style="display: flex; justify-content: space-between;"> Address 10/6/95 </div> <div style="display: flex; justify-content: space-between;"> Signature Date </div> </div>		B 4 DIRECTION OF WELL FROM TOWN (CIRCLE BOX) <div style="text-align: center;"> </div>	
B 2 WELL INFORMATION APPROX. PUMPING RATE (GAL. PER MIN.) <div style="border: 1px solid black; width: 100px; height: 20px; margin-bottom: 5px;"></div> AVERAGE DAILY QUANTITY NEEDED (GAL. PER DAY) <div style="border: 1px solid black; width: 100px; height: 20px; margin-bottom: 5px;"></div>		NEAR WHAT ROAD <div style="border: 1px solid black; padding: 2px; margin-bottom: 5px;"> <div style="display: flex; justify-content: space-between;"> 11 30 </div> </div> ON WHICH SIDE OF ROAD (CIRCLE APPROPRIATE BOX) <div style="display: flex; justify-content: space-around; align-items: center;"> <div style="text-align: center;"> <div style="border: 1px solid black; width: 20px; height: 20px; margin: 0 auto;"></div> <div style="font-size: 8px;">NORTH</div> <div style="font-size: 8px;">WEST</div> <div style="font-size: 8px;">EAST</div> <div style="font-size: 8px;">SOUTH</div> </div> <div style="text-align: center;"> <div style="border: 1px solid black; width: 20px; height: 20px; margin: 0 auto;"></div> <div style="font-size: 8px;">NORTH</div> <div style="font-size: 8px;">WEST</div> <div style="font-size: 8px;">EAST</div> <div style="font-size: 8px;">SOUTH</div> </div> </div> DISTANCE FROM ROAD <div style="display: flex; justify-content: space-between; margin-top: 5px;"> 34 37 </div> <div style="display: flex; justify-content: space-between; margin-top: 5px;"> ENTER FT OR MI FT </div> <div style="display: flex; justify-content: space-between; margin-top: 5px;"> 38 39 </div>	
USE FOR WATER (CIRCLE APPROPRIATE BOX) <div style="display: flex; flex-direction: column; gap: 5px;"> <div><input checked="" type="checkbox"/> HOME (SINGLE OR DOUBLE HOUSEHOLD UNIT ONLY)</div> <div><input type="checkbox"/> FARMING (LIVESTOCK WATERING & AGRICULTURAL IRRIGATION)</div> <div><input type="checkbox"/> INDUSTRIAL, COMMERCIAL, STATE AND FEDERAL GOV. OTHER (REQUIRES APPROPRIATION PERMIT)</div> <div><input type="checkbox"/> PUBLIC OR PRIVATE WATER COMPANY (REQUIRES APPROPRIATION PERMIT AND STATE HEALTH DEPARTMENT APPROVAL)</div> <div><input type="checkbox"/> TEST, OBSERVATION, MONITORING (MAY REQUIRE APPROPRIATION PERMIT)</div> </div>		NOT TO BE FILLED IN BY DRILLER HEALTH DEPARTMENT APPROVAL <div style="display: flex; justify-content: space-between; margin-top: 5px;"> HOWARD A48827 </div> <div style="display: flex; justify-content: space-between; margin-top: 5px;"> COUNTY NAME COUNTY NO. </div> <div style="display: flex; justify-content: space-between; margin-top: 5px;"> STATE SIGNATURE INSERT S </div> <div style="display: flex; justify-content: space-between; margin-top: 5px;"> DATE ISSUED 3/11/98 </div> <div style="display: flex; justify-content: space-between; margin-top: 5px;"> CO SIGNATURE EXP. DATE </div> <div style="display: flex; justify-content: space-between; margin-top: 5px;"> NORTH GRID EAST GRID </div> <div style="display: flex; justify-content: space-between; margin-top: 5px;"> 50 55 57 63 </div>	
APPROXIMATE DEPTH OF WELL <div style="border: 1px solid black; width: 100px; height: 20px; margin-bottom: 5px;"></div> FEET APPROXIMATE DIAMETER OF WELL <div style="border: 1px solid black; width: 100px; height: 20px; margin-bottom: 5px;"></div> INCH		SHOW MAJOR FEATURES OF BOX & LOCATE WELL WITH AN X SOURCES OF DRILLING WATER 1. WELL 2. 3. WRITE THE BOX NUMBER FROM THE MAP HERE. <div style="display: flex; justify-content: space-around; margin-top: 5px;"> <div style="border: 1px solid black; padding: 2px;"> E 82012 N 52002 </div> <div style="text-align: right;"> 000 000 </div> </div>	
METHOD OF DRILLING (circle one) BORED (or Augered) <input type="checkbox"/> JETTED <input type="checkbox"/> Jetted & DRIVEN <input type="checkbox"/> AIR-ROTARY <input type="checkbox"/> AIR-PERCussion <input type="checkbox"/> ROTARY (Hydraulic Rotary) <input type="checkbox"/> CABLE <input type="checkbox"/> REVERSE-ROTARY <input type="checkbox"/> DRIVE-POINT <input type="checkbox"/> other _____		DRAW A SKETCH BELOW SHOWING LOCATION OF WELL IN RELATION TO NEARBY TOWNS AND ROADS AND GIVE DISTANCE FROM WELL TO NEAREST ROAD JUNCTION <div style="text-align: center; margin-top: 10px;"> </div>	
REPLACEMENT OR DEEPEENED WELLS (CIRCLE APPROPRIATE BOX) <div style="display: flex; flex-direction: column; gap: 5px;"> <div><input checked="" type="checkbox"/> THIS WELL WILL NOT REPLACE AN EXISTING WELL</div> <div><input type="checkbox"/> THIS WELL WILL REPLACE A WELL THAT WILL BE ABANDONED AND SEALED</div> <div><input type="checkbox"/> THIS WELL WILL REPLACE A WELL THAT WILL BE USED AS A STANDBY-CONTACT LOCAL APPROVING AUTHORITY FOR POLICY ON STANDBY WELLS</div> <div><input type="checkbox"/> THIS WELL WILL DEEPEEN AN EXISTING WELL</div> </div> PERMIT NUMBER OF WELL TO BE REPLACED OR DEEPEENED (IF AVAILABLE) <div style="border: 1px solid black; width: 100px; height: 20px; margin-bottom: 5px;"></div>		Not to be filled in by driller (MDE OR COUNTY USE ONLY) APPROX. PERMIT NUMBER <div style="border: 1px solid black; width: 100px; height: 20px; margin-bottom: 5px;"></div> FORCE <div style="border: 1px solid black; width: 100px; height: 20px; margin-bottom: 5px;"></div> WRITE INITIALS IN BOX PERMIT No. HO-94-1074	
SPECIAL CONDITIONS NOTE - APPROVING AUTHORITIES SHOULD USE SEPARATE SHEET IF NEEDED * WELL TO BE CLEARLY FLAGGED FOR GRADING PROTECTION, AND EXTEND WELL CASING 3' ABOVE EXISTING SITE ELEVATION FOR GRADING.			

GRID NORTH

ROAD

QUARTER

FOLLY

398/386
ChB2

EXIST. SEPTIC AREA

HENRY L. WAYER
OP. 68
358/341
EXIST. SEPTIC CLEANSOUT

C9C2

LOT 2

RESTRICTION
BUILDING LINE (TYP.)

P206(404.1)

P205(403.4)

P209(402.2)

P204(403.7)

P210(403.8)

LOT 10

P2(408.8)

P101(408.8)

PA01(407.0)

P268(398.3)

P267(402.2)

P4(396.4)

P3(401.6)

QUARTER

LOT 12

P265(395.1)

P6(395.1)

PA04(392.9)

P5(392.1)

PA03(390.0)

LOT 11

P102(395.8)

P7(391.4)

P12(392.3)

P74

P13

FRED P. GRANESE
P. 54

301/17

583000

E 133500

MARY ANNE LINGENFELIER

P. 69

ET25/233

ChC2

10/31/95 MR

Lot 11 Well
Site OK

Grading
90% Complete

37'± to lot
corner
12'± to lot line

Red-Flagged
stake obs'd ChB2
no ID

No approval yet
MR 10/18/95

10/23/95 w/c. Sperry
Stake Gone;
Since ~6' more fill coming,
well not to be
drilled before filling complete
MR

MD STATE GRID MERIDIAN

QUARTERFIELD DRIVE
(50' RIGHT-OF-WAY)

TREE MAINTENANCE
EASEMENT AS SHOWN
ON PLAT NO. 11938

PRESERVATION PARCEL '1A'
PLAT NO. 11938

LOT 11
PLAT NO. 11938
46,000 Sq Ft


LOT 12
PLAT NO. 11938

PRESERVATION PARCEL '1A'
PLAT NO. 11938

EX. PRIVATE SEWAGE EASEMENT
AS SHOWN ON PLAT NO. 11938

3/24/99
shown deck
location will
have no impact
to the existing
well or septic

AN

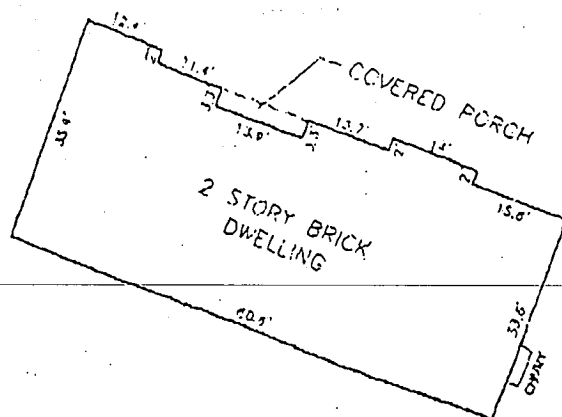

INSET