

PERMIT

SEWAGE DISPOSAL SYSTEM

DEPARTMENT OF HEALTH AND MENTAL HYGIENE

P 510234

A 48844

DISTRICT 3rd

DATE 6-30-98

DATE SYSTEM APPROVED 8-14-98

INSPECTOR ALL

HOWARD COUNTY HEALTH DEPARTMENT

BUREAU OF ENVIRONMENTAL HEALTH

~~XXXXXX~~ 410-313-2640

INDEXED

WPI -
willowby
8/21/98

Fogle's Septic Clean, Inc. IS PERMITTED TO INSTALL X ALTER

ADDRESS 558 Obrecht Road, Sykesville, Maryland 21784 PHONE 410-795-5674

SUBDIVISION Quarterfield LOT 28 ROAD 3749 Running Springs Road

PROPERTY OWNER Dale Thompson Builders

ADDRESS

SEPTIC TANK CAPACITY 1250 GALLONS

NUMBER OF BEDROOMS 4

180 SQUARE FEET PER BEDROOM

LINEAR FEET OF TRENCH REQUIRED 180

TRENCHES - Trench to be 2 feet wide. Inlet 3 feet below original grade. Bottom maximum depth 7 feet below original grade. Effective area begins at 3 feet below original grade. 4 feet of stone below distribution pipe.

LOCATION - Starting from the left rear lot corner, place the distribution box 85 feet up the left (329.73') lot line and 100 feet off this same lot line. Run trenches on contour in both directions.

NOTES - No trench to exceed 100 feet in length. Provide 6" - 8" diameter cleanout and cap to grade or above on septic tank.

OK KM 6-17-98

PLANS APPROVED BY Mark Rifkin DATE 6/16/98

COVER NO WORK UNTIL INSPECTED AND APPROVED

NEITHER THE HOWARD COUNTY COUNCIL NOR THE HEALTH DEPARTMENT IS RESPONSIBLE FOR THE SUCCESSFUL OPERATION OF ANY SYSTEM

NOTE: CLEANOUT REQUIRED EVERY 70 FEET OF SEWER LINE AND/OR AT 90° SWEEPS IN LINES FROM HOUSE TO DRAIN FIELDS. 90° ELBOWS NOT ACCEPTABLE.

NOTE: ALL PARTS OF SEPTIC SYSTEMS (I.E. TANK, DISTRIBUTION BOX TRENCHES) TO BE 100 FEET FROM WELL (UNLESS OTHERWISE SPECIFICALLY AUTHORIZED)

NOTE: IF DEEP TRENCH(ES) ARE USED CALL FOR INSPECTION BEFORE AND AFTER PLACING GRAVEL IN TRENCH(ES)

NOTE: NO DRY WELL SHALL EXCEED 15 FOOT IN DIAMETER NO ABSORPTION TRENCH TO EXCEED 100 FEET IN LENGTH

NOTE: ALL PIPE FROM HOUSE TO SEPTIC TANK MUST BE CAST IRON OR SCHEDULE 35/40 PVC OR ABS

PERMIT VOID AFTER TWO YEARS


NOTE: INSTALL STAND PIPE ON SEPTIC TANK AND DRY WELL STAND PIPES MUST BE 6 INCHES IN DIAMETER CAST IRON. CONCRETE OR TERRA COTTA OR PVA OR ABS ACCEPTED. IF TOP OF SEPTIC TANK IS DEEPER THAN 3 FEET. MANHOLE TO GRADE REQUIRED.

NOTE: DISTRIBUTION BOXES MUST HAVE BAFFLES

*INSTALLER IS RESPONSIBLE FOR OBTAINING FINAL APPROVAL ON THIS PERMIT

VOID PERMIT
AND RETURNED 4/19/01
B00129714
deck

44887

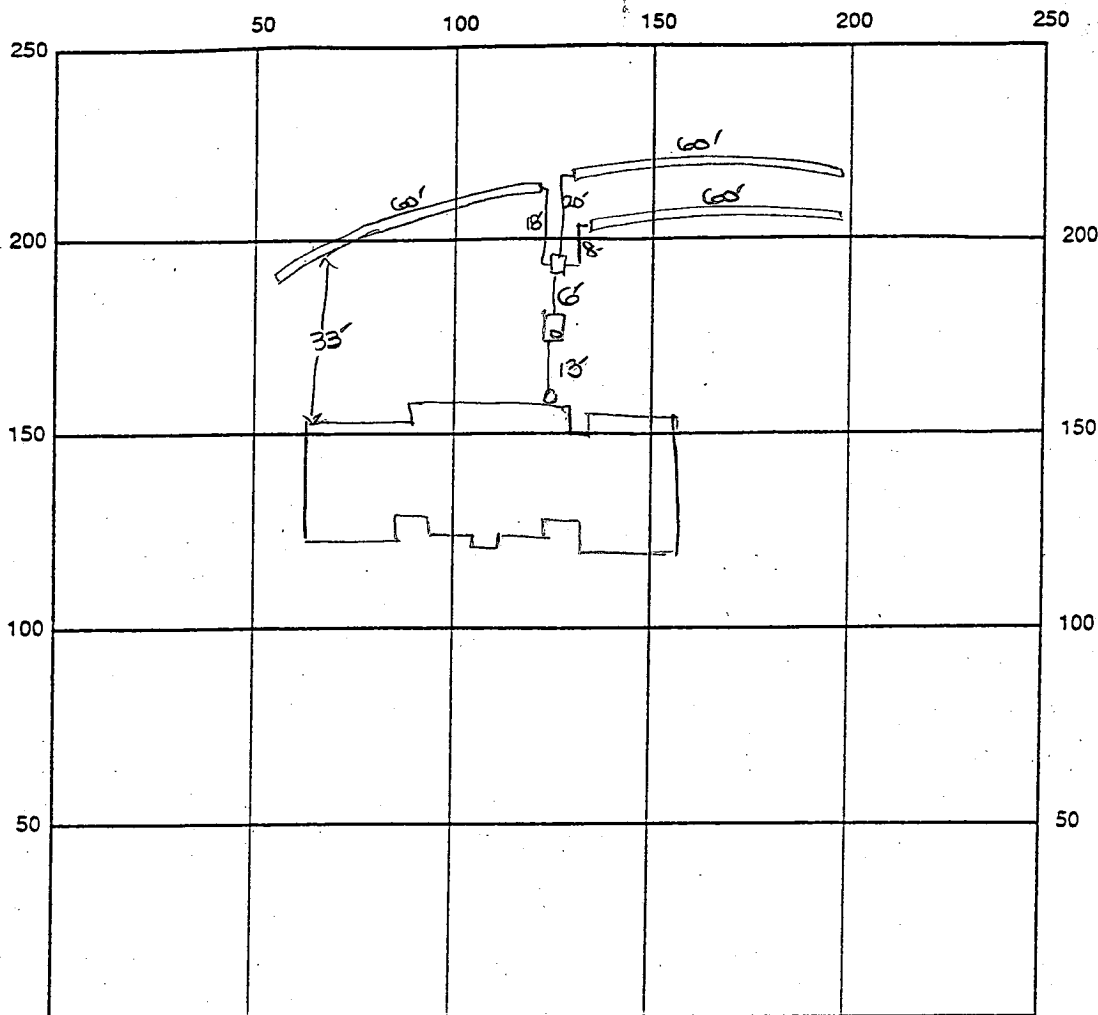

INDICATE NORTH - NAME ADJOINING ROADWAY AS BASE LINE

SEPTIC TANK LEVEL OK CLEANOUTS one on s.t.

DISTRIBUTION BOX LEVEL OK - baffle in

DRAIN FIELD/TITLE DEPTH 7 FT. TRENCH WIDTH 2 FT. INLET DEPTH 3 FT.

EFFECTIVE GRAVEL DEPTH 4 FT. TOTAL LENGTH 3 x 60 FT.

NUMBER OF TRENCHES 3 ONE SIDEWALL BOTTOM AREA 720 SQ. FT.

DRYWALL INSIDE DIAMETER 1 FT. EFFECTIVE DEPTH BELOW INLET 4.0 FT.

ABSORBENT AREA 1 SQ. FT.

REMARKS: 8/14/98 OK to cover all work final AU

8-24-98 WPI OK to cover AU

DATE SYSTEM APPROVED 8-14-98 INSPECTOR Amy McMulle

APPLICATION

PERCOLATION TESTING

A 485

P _____

HOWARD COUNTY HEALTH DEPARTMENT
BUREAU OF ENVIRONMENTAL HEALTH
3525-H ELLICOTT MILLS DRIVE/ELLICOTT CITY, MARYLAND 21043
TELEPHONE: 313-2840

DISTRICT _____

DATE 1/7/93

TO: THE COUNTY HEALTH OFFICER
ELLICOTT CITY, MARYLAND

I HEREBY APPLY FOR THE NECESSARY TEST PRIOR TO APPLICATION FOR PERMIT TO CONSTRUCT (OR RECONSTRUCT) A SEWAGE DISPOSAL SYSTEM.

PROPERTY OWNER Joseph M. Zoller, III
11696 Carroll Mill Road
ADDRESS Ellicott City, Maryland 21043

PHONE _____

AGENT OR PROSPECTIVE BUYER SDC Group, Inc.

ADDRESS P.O. Box 417, Ellicott City, MD 21041 PHONE (410) 465-4244

PROPERTY LOCATION:

SUBDIVISION Zoller Property

LOT NO. 10 ~~28~~

ROAD AND DESCRIPTION Northeast quadrant Folly Quarter Road and Carroll Mill Road
intersection.

BLDG. PERMIT SIGNED

AND RETURNED 6-16-98Serial # 37111956

TAX MAP 23 PARCEL # 8,82 & 101

SIZE OF LOT 1 Ac +/-

TYPE BLDG. Single Family- 4 Brms
(SINGLE FAMILY DWELLING OR COMMERCIAL)

THE SYSTEM INSTALLED UNDER THIS APPLICATION IS ACCEPTABLE ONLY UNTIL PUBLIC FACILITIES BECOME AVAILABLE. I FULLY UNDERSTAND THE

FEE CONNECTED WITH THE FILING OF THIS PERC TEST APPLICATION IS NON-REFUNDABLE UNDER ANY CIRCUMSTANCES. I ALSO AGREE TO

COMPLY WITH ALL M.O.S.H.A. REQUIREMENTS IN TESTING THIS LOT.

By: SDC Group Inc.
John Pich v.p.
(SIGNATURE OF APPLICANT)

APPROVED BY _____

FOR _____

DATE _____

DISAPPROVED BY _____

FOR _____

DATE _____

HOLD PENDING FURTHER TESTS _____

REASONS FOR REJECTION OR HOLDING PERC OK - HOLD FOR PLAT MR 7/26/9-

PERCOLATION TEST PLAT/PRELIMINARY PLAT - TITLE OR I.D. # _____

DATE _____

SITE DEVELOPMENT PLAN/FINAL PLAT - TITLE OR I.D. # _____

DATE _____

THIS IS NOT A PERMIT

COUNTY #

SOIL PROFILE


276
tan/brn
scl lm
10% frags
0-9 gray
tan sa
lm
5-15%
frags

426

tan sa
cl lm
10% frags

tan sa
lm
10-20%
frags

tan sa
lm
10%
frags

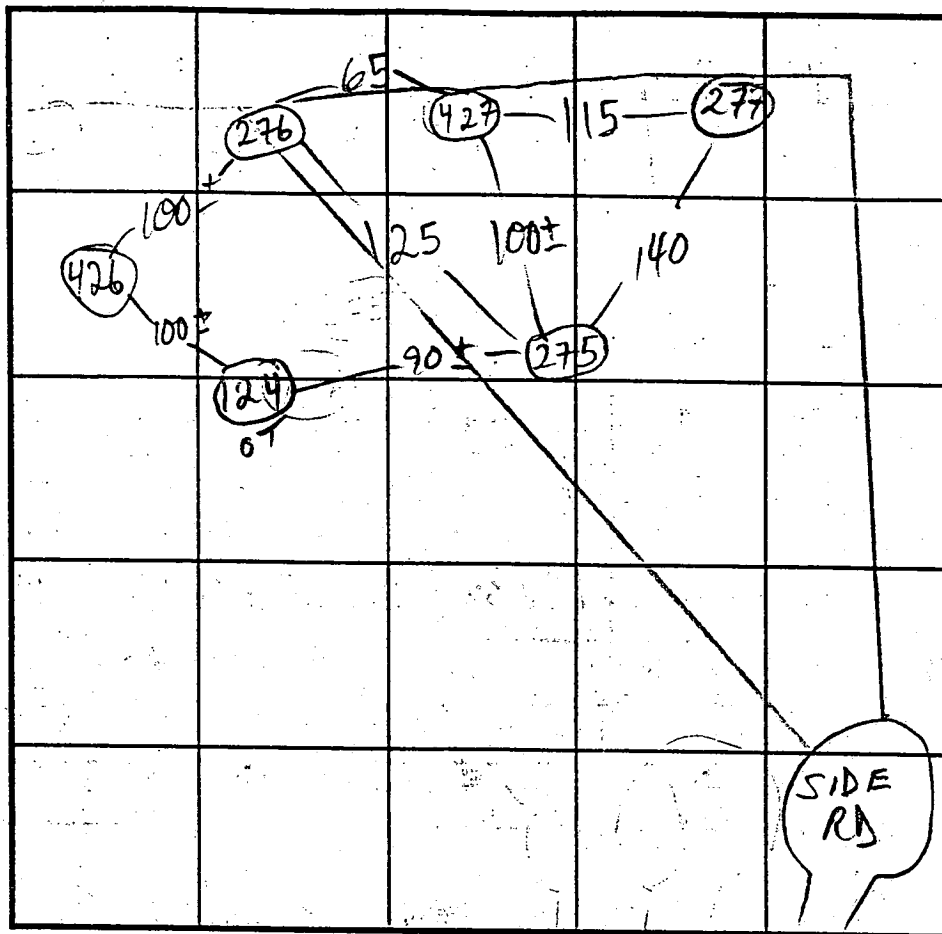

SCIL PROFILE

INDICATE NORTH - NAME ADJOINING ROADWAY AS BASE LINE.

DATE	TEST NO.	DEPTH	PRE-WET		TEST - 1" DROP		TIME
			START	STOP	START	STOP	
8/3/94	276 S	4 1/2	1:46:25	1:47:05	1:47:05	1:48:20	1 1/4 min
	276 V	11 1/2					
	277 S	5	2:12:50	2:14:25	2:14:25	2:17	2 +
	277 V	13					
	275 S	5	2:03:20	2:04:05	2:04:05	2:05:15	1 +
	275 V	11 1/2					
	427 S	5	1:51:45	1:52:30	1:52:30	1:53:30	1
	427 V	13	clay	to 3' s into profile			
	426 S	4 1/2	1:15	1:21	1:21	1:37	16
	426 V	11 1/2					

REMARKS

TYPE OF SOIL

TESTED BY

M. Rifkin

ALSO PRESENT

Hartfield crew

TRENCH DESIGN DATA: AVERAGE PERCOLATION TIME

2

TRENCH WIDTH

2

INLET DEPTH

3


MAXIMUM BOTTOM DEPTH

7

SQ. FT/BEDROOM

180

SPACE LOT 11

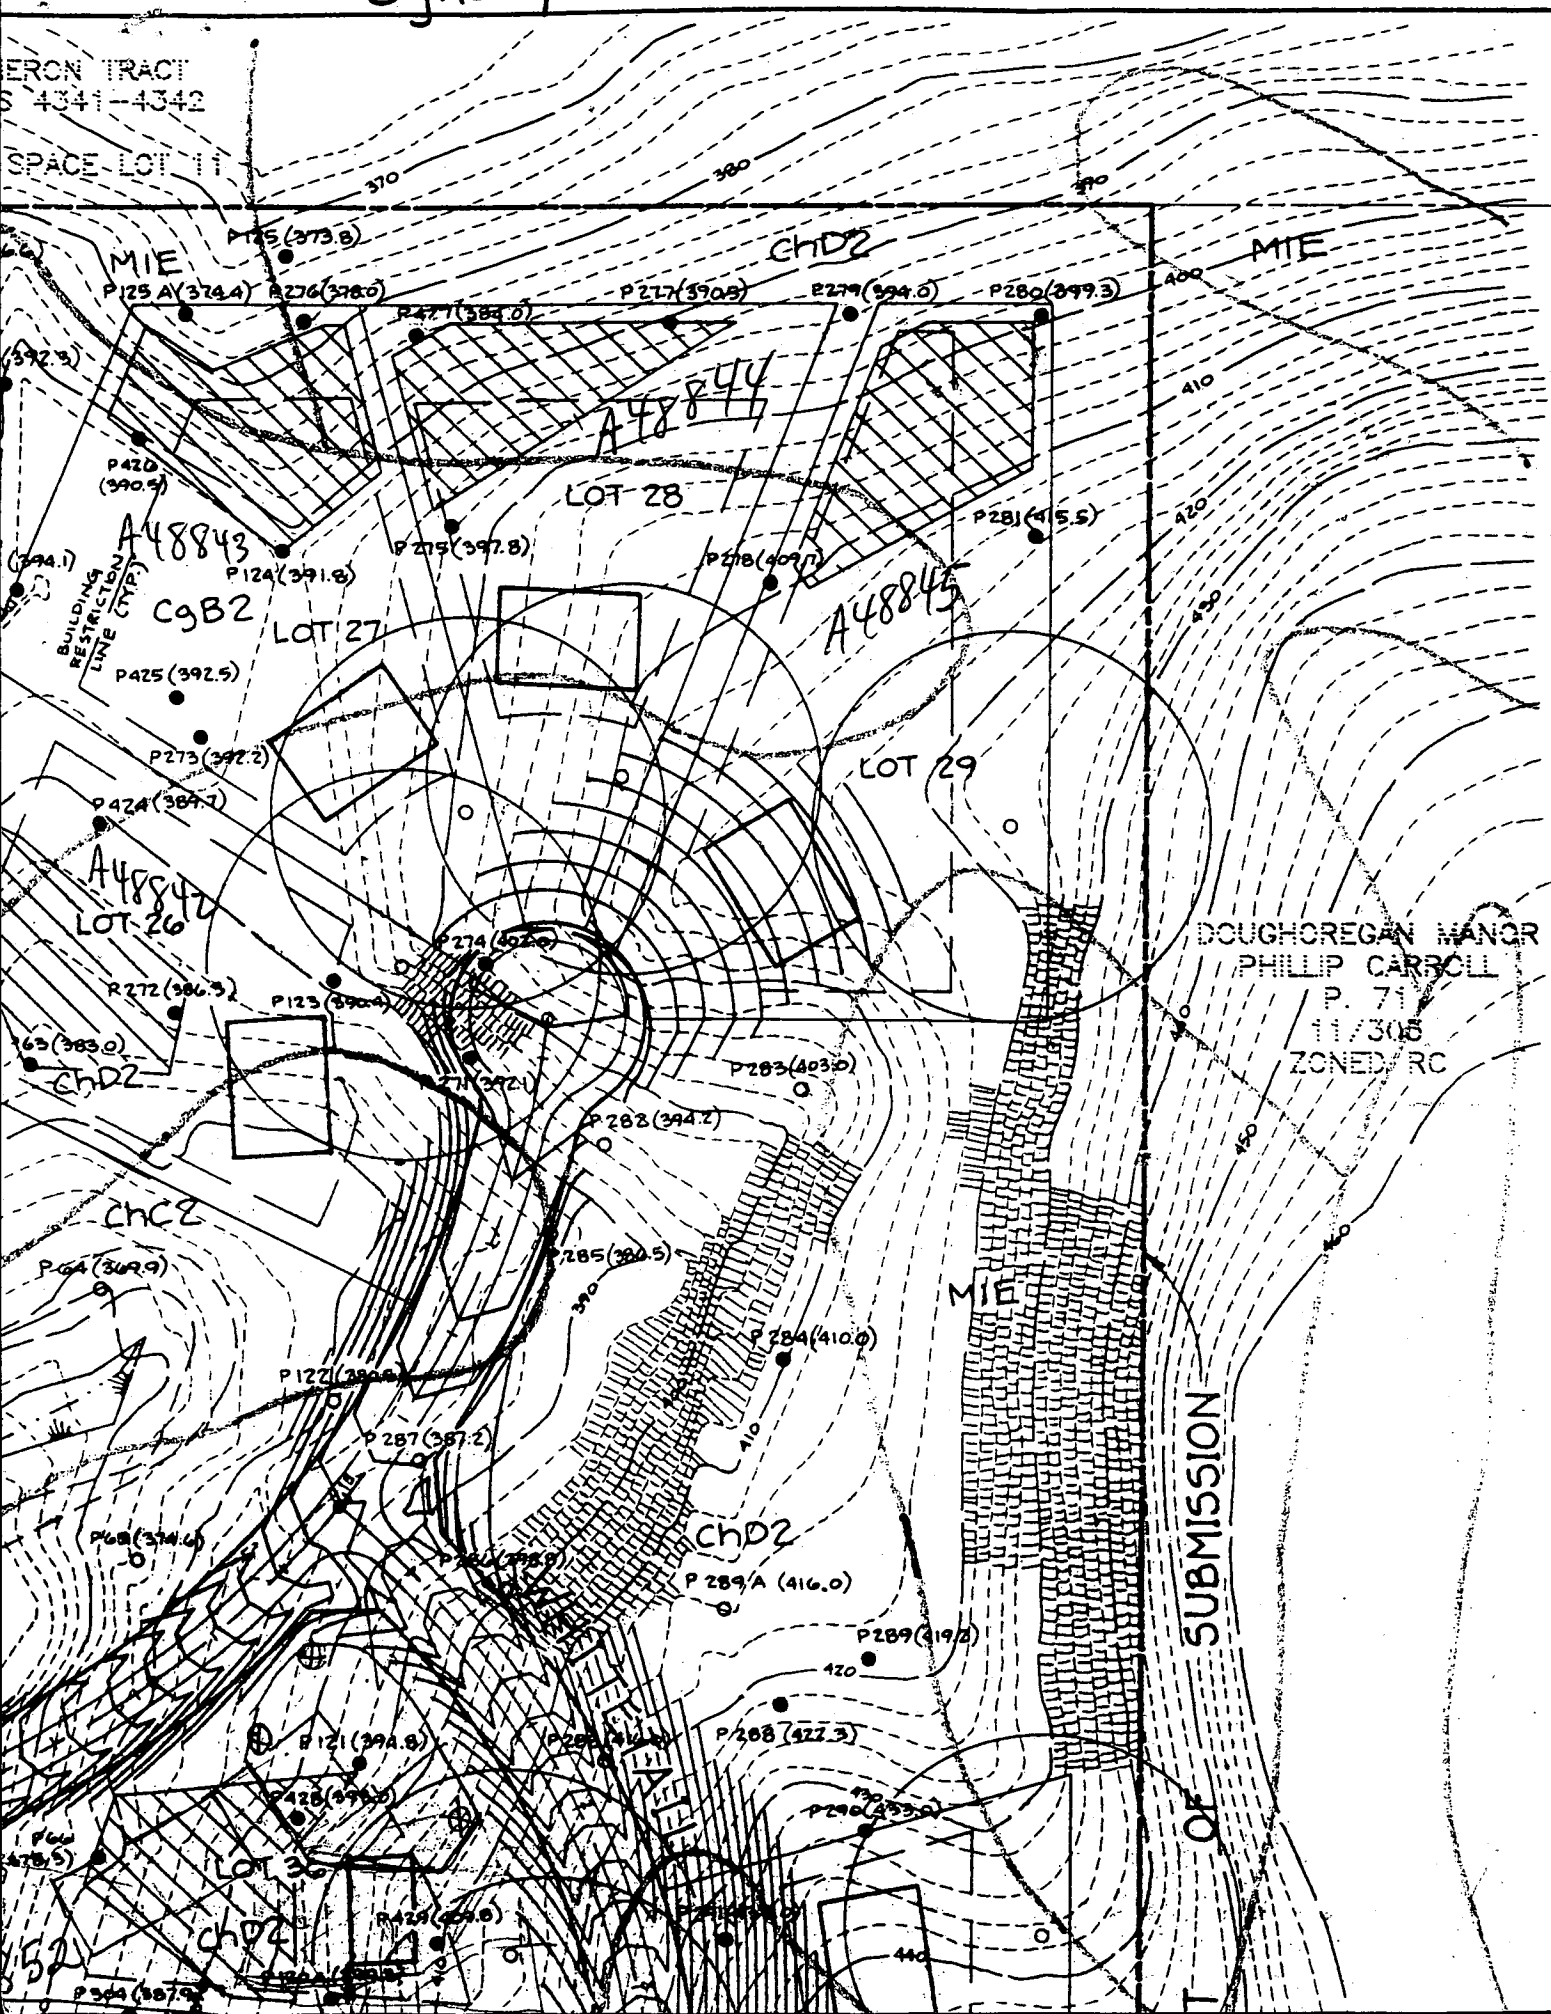

C 1	05060	SEQUENCE NO. (MDE USE ONLY)	STATE OF MARYLAND WELL COMPLETION REPORT FILL IN THIS FORM COMPLETELY PLEASE PRINT OR TYPE		THIS REPORT MUST BE SUBMITTED WITHIN 45 DAYS AFTER WELL IS COMPLETED.	
1 2 3 4 5 6 (THIS NUMBER IS TO BE PUNCHED IN COLS. 3-6 ON ALL CARDS)				COUNTY NUMBER A 48844		
ST/CO USE ONLY DATE RECEIVED 85-2-98		DATE WELL COMPLETED MM 4 DD 23 YY 98		Depth of Well 22 200 26 (TO NEAREST FOOT)		
				PERMIT NO. FROM "PERMIT TO DRILL WELL" H0-94-1477		

OWNER Dale Thompson Bldrs		
STREET OR RFD Running Springs Rd	TOWN W. Friendship	
SUBDIVISION QUARTER FIELD	SECTION	LOT 28

WELL LOG Not required for driven wells		
STATE THE KIND OF FORMATIONS PENETRATED, THEIR COLOR, DEPTH, THICKNESS AND IF WATER BEARING		
DESCRIPTION (Use additional sheets if needed)	FEET FROM TO	check if water bearing
Sand	0 28	
Gray Granite	28 200	☒

GROUTING RECORD	
WELL HAS BEEN GROUTED (Circle Appropriate Box) Y N	
TYPE OF GROUTING MATERIAL (Circle one) CEMENT CM BENTONITE CLAY BC	
NO. OF BAGS 9	NO. OF POUNDS 846
GALLONS OF WATER 54	
DEPTH OF GROUT SEAL (to nearest foot) from 0 ft. to 29 ft. (enter 0 if from surface)	

CASING RECORD	
casing types insert appropriate code below	ST CO STEEL CONCRETE
	PL OT PLASTIC OTHER
MAIN CASING TYPE ST	Nominal diameter top (main) casing (nearest inch) 6
	Total depth of main casing (nearest foot) 32

OTHER CASING (if used)	
diameter inch	depth (feet) from to

SCREEN RECORD	
screen type or open hole (insert appropriate code below)	ST BR HO STEEL BRASS OPEN HOLE
	PL OT PLASTIC OTHER

NUMBER OF UNSUCCESSFUL WELLS: 0
WELL HYDROFRACTURED Y N

CIRCLE APPROPRIATE LETTER	
A	A WELL WAS ABANDONED AND SEALED WHEN THIS WELL WAS COMPLETED
E	ELECTRIC LOG OBTAINED
P	TEST WELL CONVERTED TO PRODUCTION WELL

I HEREBY CERTIFY THAT THIS WELL HAS BEEN CONSTRUCTED IN ACCORDANCE WITH COMAR 26.04.04 "WELL CONSTRUCTION" AND IN CONFORMANCE WITH ALL CONDITIONS STATED IN THE ABOVE CAPTIONED PERMIT, AND THAT THE INFORMATION PRESENTED HEREIN IS ACCURATE AND COMPLETE TO THE BEST OF MY KNOWLEDGE.

DRILLERS LIC. NO. MSD024
DRILLERS SIGNATURE Barry Mayne
(MUST MATCH SIGNATURE ON APPLICATION)

LIC. NO. MSD021
SITE SUPERVISOR (signature of driller or journeyman responsible for sitework if different from permittee)


C 2 DEPTH (nearest ft.)	
1 H0 30 200	
2	
3	
GRAVEL PACK IF WELL DRILLED WAS FLOWING WELL INSERT F IN BOX 68
68

MDE USE ONLY (NOT TO BE FILLED IN BY DRILLER)	
T (E.R.O.S.)	W Q
70	72
TELESCOPE CASING	LOG INDICATOR
74	75 76
OTHER DATA	

C 3	
PUMPING TEST	
HOURS PUMPED (nearest hour)	3
PUMPING RATE (gal. per min.)	20
METHOD USED TO MEASURE PUMPING RATE	Bucket
WATER LEVEL (distance from land surface)	
BEFORE PUMPING	45 ft.
WHEN PUMPING	55 ft.
TYPE OF PUMP USED (for test)	
A air	P piston
C centrifugal	R rotary
J jet	S submersible

PUMP INSTALLED	
DRILLER WILL INSTALL PUMP (CIRCLE) (YES or NO)	YES NO
IF DRILLER INSTALLS PUMP, THIS SECTION MUST BE COMPLETED FOR ALL WELLS.	
TYPE OF PUMP INSTALLED	
PLACE (A,C,J,P,R,S,T,O) IN BOX 29.	29
CAPACITY: GALLONS PER MINUTE (to nearest gallon)	31 35
PUMP HORSE POWER	37 41
PUMP COLUMN LENGTH (nearest ft.)	43 47
CASING HEIGHT (circle appropriate box and enter casing height)	+ above
LAND SURFACE	2 (nearest foot)
- below	49 50 51

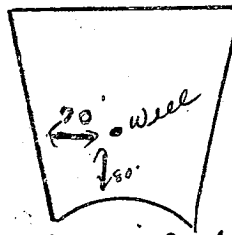LOCATION OF WELL ON LOT	
SHOW PERMANENT STRUCTURE SUCH AS BUILDING, SEPTIC TANKS, AND /OR LANDMARKS AND INDICATE NOT LESS THAN TWO DISTANCES (MEASUREMENTS TO WELL)	
	

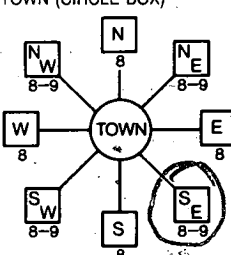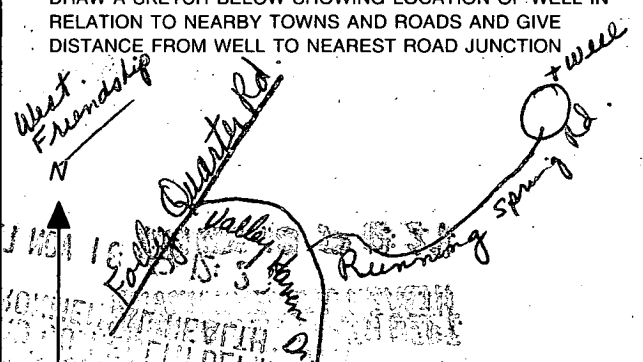B 1 8006	SEQUENCE NO. (MDE USE ONLY)	STATE OF MARYLAND PERMIT TO DRILL WELL please print or type	STATE PERMIT NUMBER H0-94-1477 fill in this form completely
Date Received (APA) 11/10/97		B 3 LOCATION OF WELL 8 COUNTY <u>Howard</u> 21 23 SUBDIVISION <u>Quarterfield</u> 42 SECTION <u>44</u> 46 LOT <u>28</u> 48 50 <u>West Friendship</u> 52 NEAREST TOWN 71 MILES FROM TOWN (enter 0 if in town) <u>4</u> M 73 76 77 78	
OWNER INFORMATION 15 Last Name <u>Thompson</u> Owner First Name <u>Dale</u> 34 36 Street or RFD <u>10005 Old Columbia Rd.</u> 55 <u>Columbia</u> 57 Town 70 State 72 Zip 76 <u>21046</u>		B 4 1 2 DIRECTION OF WELL FROM TOWN (CIRCLE BOX) 	
DRILLER INFORMATION Driller's Name <u>Joseph L. Mayne</u> 76 License No. 81 <u>MSD024</u> Firm Name <u>Joseph L. Mayne Well Drilling</u> Address <u>5512 Ridge Rd. Mt. Airy Md. 21771</u> Signature <u>Joseph L. Mayne</u> Date <u>11/17/97</u>		11 NEAR WHAT ROAD <u>Running Spring Rd.</u> 30 ON WHICH SIDE OF ROAD (CIRCLE APPROPRIATE BOX)  34 80 37 DISTANCE FROM ROAD 38 39 ENTER FT OR MI <u>FT</u> TAX MAP: <u>23</u> BLK: <u>115</u> PARCEL <u>1101</u>	
B 2 WELL INFORMATION 1 2 APPROX. PUMPING RATE (GAL. PER MIN.) <u>5</u> 8 12 AVERAGE DAILY QUANTITY NEEDED (GAL. PER DAY) <u>500</u> 14 20		NOT TO BE FILLED IN BY DRILLER HEALTH DEPARTMENT APPROVAL <u>Howard</u> COUNTY NAME <u>A48844</u> COUNTY NO. STATE SIGNATURE <u>Mark E. Ripkin</u> INSERT S → DATE ISSUED <u>03 12 98</u> 43 MM DD YY 48 CO SIGNATURE <u>3/12/98</u> EXP. DATE NORTH GRID <u>522</u> 50 55 EAST GRID <u>0826</u> 57 63	
USE FOR WATER (CIRCLE APPROPRIATE BOX) ☒ HOME (SINGLE OR DOUBLE HOUSEHOLD UNIT ONLY) ☐ FARMING (LIVESTOCK WATERING & AGRICULTURAL IRRIGATION) 22 ☐ INDUSTRIAL, COMMERCIAL, STATE AND FEDERAL GOV. OTHER (REQUIRES APPROPRIATION PERMIT) ☐ PUBLIC OR PRIVATE WATER COMPANY (REQUIRES APPROPRIATION PERMIT AND STATE APPROVAL) ☐ TEST, OBSERVATION, MONITORING (MAY REQUIRE APPROPRIATION PERMIT)		SHOW MAJOR FEATURES OF BOX & LOCATE WELL WITH AN X SOURCES OF DRILLING WATER 1. <u>Well</u> 2. 3. WRITE THE BOX NUMBER FROM THE MAP HERE E <u>826</u> N <u>522</u>	
APPROXIMATE DEPTH OF WELL <u>240</u> FEET 24 28 APPROXIMATE DIAMETER OF WELL <u>6</u> INCH NEAREST INCH		4/23/98 9:30 GROUT 000 000	
METHOD OF DRILLING (circle one) 30 <u>BORED</u> (or Augered) <u>AIR-ROTARY</u> 37 <u>CABLE</u> JETTED <u>AIR-PERCussion</u> <u>ROTARY</u> (Hydraulic Rotary) <u>REVerse-ROTary</u> <u>DRive-POINT</u> other _____		DRAW A SKETCH BELOW SHOWING LOCATION OF WELL IN RELATION TO NEARBY TOWNS AND ROADS AND GIVE DISTANCE FROM WELL TO NEAREST ROAD JUNCTION 	
REPLACEMENT OR DEEPEINED WELLS (CIRCLE APPROPRIATE BOX) ☒ THIS WELL WILL NOT REPLACE AN EXISTING WELL ☐ THIS WELL WILL REPLACE A WELL THAT WILL BE ABANDONED AND SEALED 39 ☐ THIS WELL WILL REPLACE A WELL THAT WILL BE USED AS A STANDBY-CONTACT LOCAL APPROVING AUTHORITY FOR POLICY ON STANDBY WELLS ☐ THIS WELL WILL DEEPEIN AN EXISTING WELL PERMIT NUMBER OF WELL TO BE REPLACED OR DEEPEINED (IF AVAILABLE) 41 _____ 52		Not to be filled in by driller (MDE OR COUNTY USE ONLY) APPROX. PERMIT NUMBER <u>54</u> G A P 63 FORCE <u>MR</u> WRITE INITIALS IN BOX <u>H0-94-1477</u> PERMIT No. 70 71 72 73 74 75 76 77 78 79	

HOWARD COUNTY HEALTH DEPARTMENT
Bureau of Environmental Health
2220-N Ellsboro Mills Drive
Ellsboro City, MD 21043
401-0032

APPLICATION FOR PITLESS ADAPTER, WELL PUMP AND PRESSURE TANK INSTALLATION

New Installation ☒
Replacement ☐

Receipt #
Date 8/24/98

Name of Installer Willoughby Plumbing Svc. Inc.

Telephone 410-781-7051

License Number #6998

Certified Well Pump Installer ☐

Well Driller ☐

Registered Plumber ☒

Name of Property Owner DALE THOMPSON BUILDERS

Telephone 410-781-7051

Subdivision QUARTERFIELD

Lot # 28

Well Tag # HO-92-1977

Site Address 3709 RUNNING SPRING

Pump

1. Type

- a. Deep well jet
b. Shallow well jet ☒
c. Submersible ☒

2. Make IRIDIUM

3. Model #

4. Capacity 7 GPM

5. Pump exceeds well capacity Yes ☐ No ☒

6. If Yes, is low pressure cutoff switch installed? Yes ☐ No ☐

7. What methods are used to protect the pump and electrical wiring from vibration? Torque arresters ☒ Cable guards ☒ Other TAPE

Meter

1. Horsepower 1/2 HP
2. RPM
3. Voltage
a. 110
b. 220

Pitless Adapter

1. Make HARVARD
2. Model #
3. Depth 4 FT

8. Capacity 40 GAL

9. Pressure relief valve? YES

Piping

1. Type CRESTLINE
2. Size 1"
3. NSF and/or BOCB Code approved YES
4. Depth of supply line 4 FT

Well data

1. Depth 200 ft.
2. Yield 20 GPM
3. Static water level 45 ft.
4. Will water supply be disinfected by installer? NO

I understand that it is my responsibility to notify the Howard County Health Department when the installation is ready for inspection (otherwise this permit is null and void).

All information given above is true to the best of my knowledge.

Signature of Applicant: Chris J. Willoughby

Date: 8/24/98

Note: A sticker indicating approval/status of the installation will be placed on the well cap at the time of the inspection.

