

8/24/92 ASDP

PERMIT

SEWAGE DISPOSAL SYSTEM

DEPARTMENT OF HEALTH AND MENTAL HYGIENE

P 48461
A25741
A REPAIR

HOWARD COUNTY HEALTH DEPARTMENT
BUREAU OF ENVIRONMENTAL HEALTH

461-9933

INDEXED

03-296652

DISTRICT 3rd

DATE 8/26/92

DATE SYSTEM APPROVED 8/24/92

INSPECTOR R.H.

Jenkins Brothers

IS PERMITTED TO INSTALL ☐ ALTER ☒

ADDRESS 7670 Smiths Private Road, Sykesville, MD 21784 PHONE 795-5670

SUBDIVISION LOT 4 ROAD 1475 Route 32

PROPERTY OWNER Dr. Victor A. Fazekas
1475 Route 32

ADDRESS

SEPTIC TANK CAPACITY GALLONS

NUMBER OF BEDROOMS 4

125 SQUARE FEET PER BEDROOM

LINEAR FEET OF TRENCH REQUIRED 72

Became Lot 4 of the
Christian Family
Outreach Center

REPAIR - PURPOSE - Septic System Has Failed.

Call for inspection when ground is opened so sanitarian can recommend repair. 8/24/92

TRENCH - 2 FT WIDE 72 FT LONG 11 FT DEEP
INLET 4 FT 17 FT OF STONE PLACE
TRENCH OFF OLD DRY WELL
8/24/92 R.H.

PLANS APPROVED BY DATE

COVER NO WORK UNTIL INSPECTED AND APPROVED

NEITHER THE HOWARD COUNTY COUNCIL NOR THE HEALTH DEPARTMENT IS RESPONSIBLE FOR THE SUCCESSFUL OPERATION OF ANY SYSTEM

NOTE: CLEANOUT REQUIRED EVERY 70 FEET OF SEWER LINE AND/OR AT 90° SWEEPS IN LINES FROM HOUSE TO DRAIN FIELDS, 90° ELBOWS NOT ACCEPTABLE.

NOTE: ALL PARTS OF SEPTIC SYSTEMS (I.E. TANK, DISTRIBUTION BOX TRENCHES) TO BE 100 FEET FROM WELL (UNLESS OTHERWISE SPECIFICALLY AUTHORIZED)

NOTE: IF DEEP TRENCH(ES) ARE USED CALL FOR INSPECTION BEFORE AND AFTER PLACING GRAVEL IN TRENCH(ES)

NOTE: NO DRY WELL SHALL EXCEED 15 FOOT IN DIAMETER NO ABSORPTION TRENCH TO EXCEED 100 FEET IN LENGTH

NOTE: ALL PIPE FROM HOUSE TO SEPTIC TANK MUST BE CAST IRON OR SCHEDULE 35/40 PVC OR ABS

PERMIT VOID AFTER TWO YEARS


NOTE: INSTALL STAND PIPE ON SEPTIC TANK AND DRY WELL STAND PIPES MUST BE 6 INCHES IN DIAMETER CAST IRON. CONCRETE OR TERRA COTTA OR PVA OR ABS ACCEPTED. IF TOP OF SEPTIC TANK IS DEEPER THAN 3 FEET. MANHOLE TO GRADE REQUIRED.

NOTE: DISTRIBUTION BOXES MUST HAVE BAFFLES

*INSTALLER IS RESPONSIBLE FOR OBTAINING FINAL APPROVAL ON THIS PERMIT

48461

①
0 CLAY
2 TOPSOIL
BROWN
GRIMY
SAND
LOAM

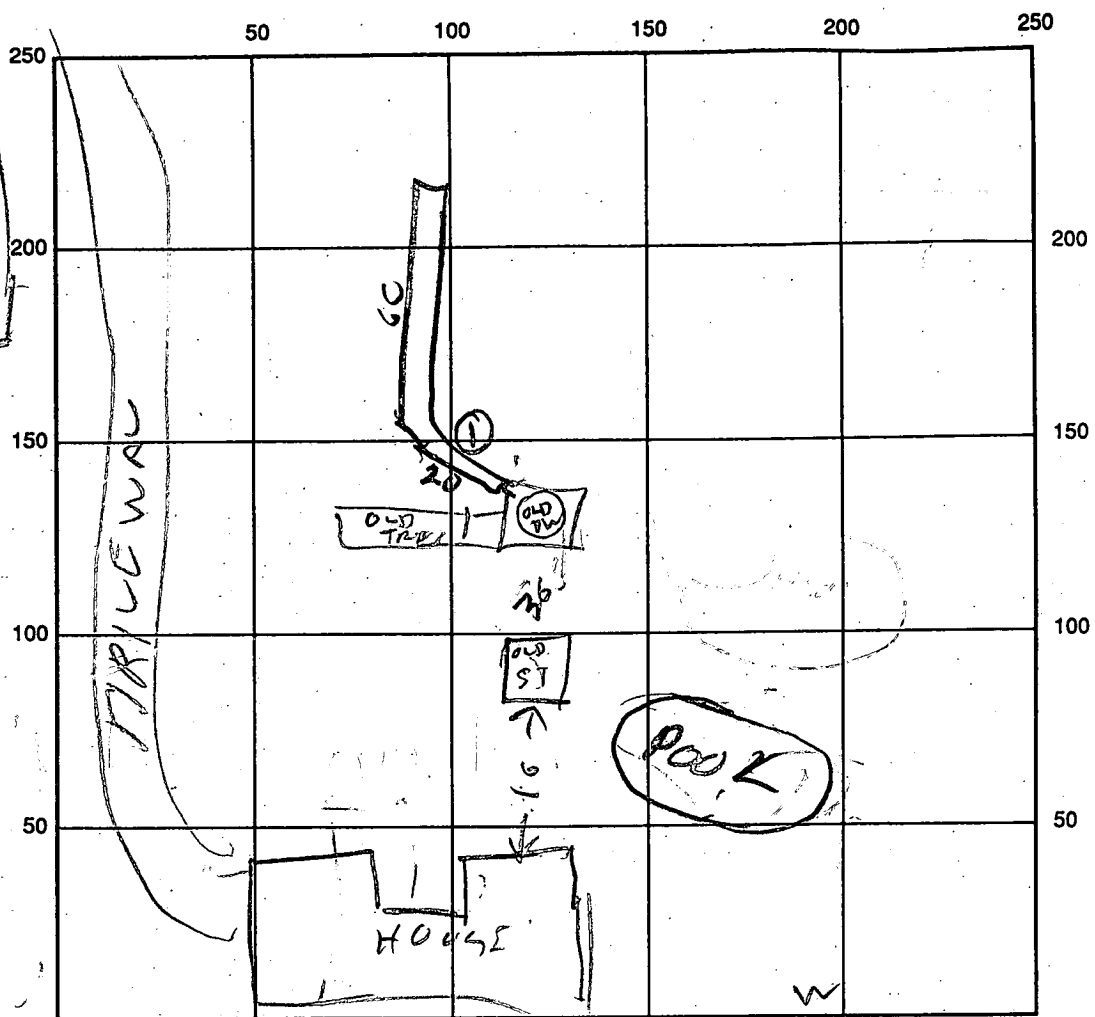

INDICATE NORTH - NAME ADJOINING ROADWAY AS BASE LINE

SEPTIC TANK LEVEL _____ CLEANOUTS _____

DISTRIBUTION BOX LEVEL _____

DRAIN FIELD/TITLE DEPTH 11 FT. TRENCH WIDTH 2 FT. INLET DEPTH 4 FT.

EFFECTIVE GRAVEL DEPTH 7 FT. TOTAL LENGTH 80 FT.

NUMBER OF TRENCHES 1 ONE SIDEWALL/BOTTOM AREA 560 SQ. FT.

DRYWALL INSIDE DIAMETER _____ FT. EFFECTIVE DEPTH BELOW INLET _____ FT.

ABSORBENT AREA _____ SQ. FT.

REMARKS: 8/24/92 - SOIL VERY GOOD. OLD SYSTEM INSTALLED 1979
8/24/92 - TRENCH FINISHED. HOME OWNER MRS FAZGROV
TOOK PICTURES. O

DATE SYSTEM APPROVED 8/24/92 INSPECTOR Raymond Hodges

6/26/79
am phase
2/79 after lunch
approved 6/29/79
5/17/79 J. Stayer
9:30 A.M. P 29119
A 25741

PERMIT

SEWAGE DISPOSAL SYSTEM

MARYLAND STATE DEPARTMENT OF HEALTH*

HOWARD COUNTY

ELLICOTT CITY

DISTRICT 3rd

DATE 10/31/78

INDEXED

BRITTINGHAM

Jim Brittingham, Liberty Backhoe

Jim Brittingham

IS PERMITTED TO INSTALL ☒ ALTER

ADDRESS 7311 Brangles Road Manothville Md 21043
3004 N. Rogers Avenue, Ellicott City, Md. 21043 PHONE 461-1870

SUBDIVISION ROAD 1475 Route 32 LOT BUILDER: Leslie Luter 929-1149

PROPERTY OWNER Dr. Victor A. Fazekas

ADDRESS 5214 Lightning View Road, Columbia, Md. 21045 Phone: 730-3993

SPECIFICATIONS 4 bedrooms

SEPTIC TANK CAPACITY 1250 GALLONS

DRAIN FIELD DEPTH FEET, BOTTOM AREA SQ. FT.

DEEP TRENCH DEPTH FEET, BOTTOM AREA SQ. FT.

SEEPAGE PITS ☒ ABSORBENT SIDE-WALL AREA 480 SQ. FT. total sidewall area in dry well.

INLET PIPE 4 1/2 FT. BELOW ORIGINAL GRADE. MAXIMUM DEPTH 13 FT. BELOW ORIGINAL GRADE

EFFECTIVE DEPTH AT FT. BELOW ORIGINAL GRADE.

LOCATE DISPOSAL AREA FT. FROM LOT LINE AND FT. FROM LOT LINE AS SEEN WHEN FACING LOT FROM

Place the dry well 420 ft. from the lot line which is 1372.08 ft. long and runs

N85degrees38 30 E and 200 ft. from the stone shown on the site plan. This stone

is the one which is the 100 ft. assumed elevation. Cleanout provided if sharp

bend in line between house and septic tank.

PLANS APPROVED BY Raymond Hodges

DATE 5/20/77

COVER NO WORK UNTIL INSPECTED AND APPROVED.

NEITHER THE HOWARD COUNTY COUNCIL NOR THE HEALTH DEPARTMENT IS RESPONSIBLE FOR THE SUCCESSFUL OPERATION OF ANY SYSTEM.

NOTE: IF TRENCH IS USED CALL FOR INSPECTION BEFORE PLACING GRAVEL IN TRENCH.

NOTE: NO DRY WELL SHALL EXCEED 15 FOOT IN DIAMETER.

NOTE: ALL PIPE FROM HOUSE TO DISPOSAL AREA MUST BE CAST IRON.

PERMIT VOID AFTER THREE YEARS.

NOTE: INSTALL STAND PIPE ON SEPTIC TANK AND DRY WELL. STAND PIPES MUST BE 6 INCHES IN DIAMETER. CAST IRON, CONCRETE OR TERRA COTTA ACCEPTED.

*INSTALLER IS RESPONSIBLE FOR OBTAINING FINAL APPROVAL ON THIS PERMIT.

CR10

52

7 1/2

364

26

390

480

364

116

18

7116

1


46

52

364

12

7 1/2

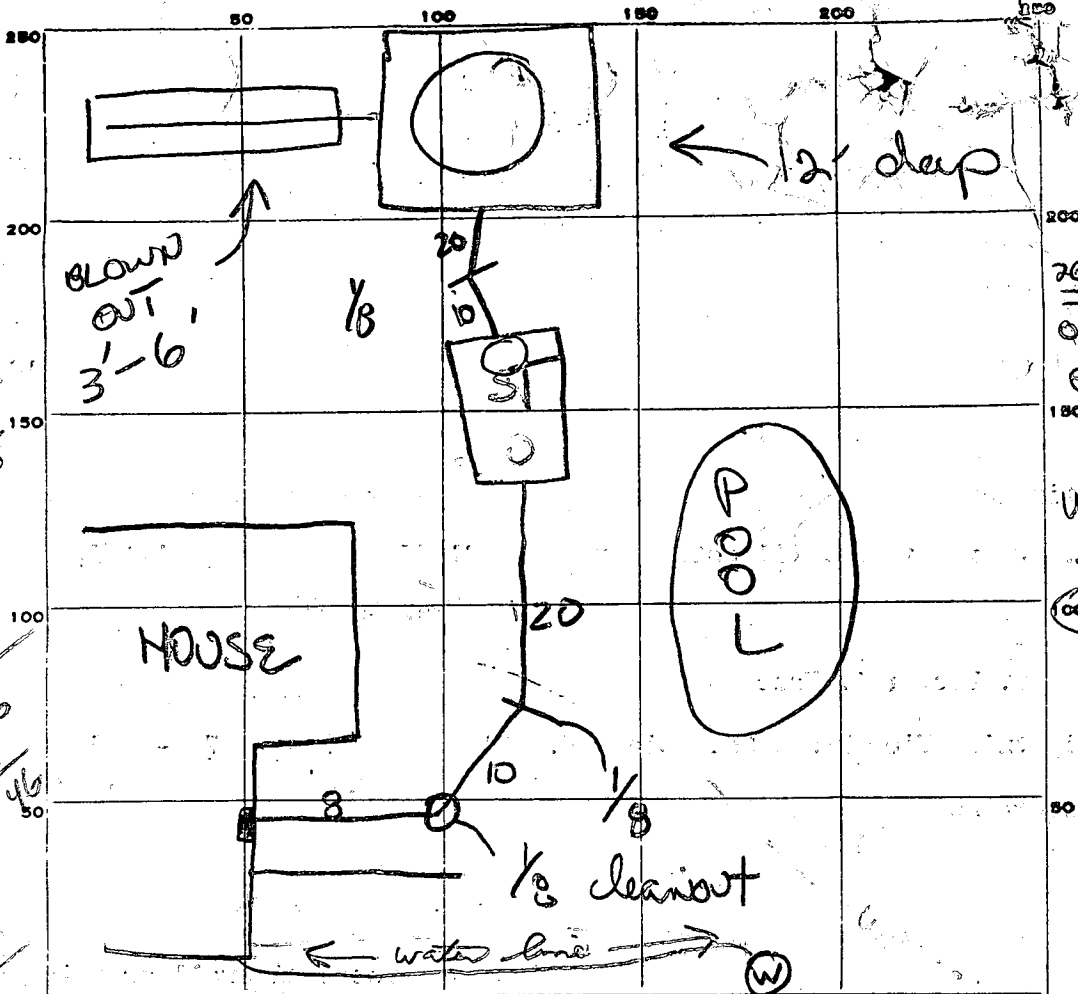

INDICATE NORTH - NAME ADJOINING ROADWAY AS BASE LINE.

RT 32

PERMIT CARD contender

6/22

SEPTIC TANK, LEVEL 1500 feet

ST	DW
MANHOLE	✓ CAST IRON

DISTRIBUTION BOX, LEVEL NA

TILE FIELD, DEPTH 13 FT. TRENCH WIDTH 2 FT.

GRAVEL DEPTH 7 FT. TOTAL LENGTH 20 FT.

NUMBER OF TRENCHES 1 TOTAL 1/2 SW BOTTOM AREA 140

SEEPAGE PITS, perimeter 52 FT. DEPTH BELOW INLET 7 FT. 364

ABSORBENT AREA ± 504 SQ. FT.

REMARKS 17 MAY 77 - See attached sheet. (GLK) 25 MAY 77 - letter sent to builder (GLK)
22 June 77 - Well water line under house sewer as indicated above. Short on area - Add 15' trench & call before adding gravel. Also manhole will be needed on ST. (GLK)
25 June 77 - Drywell inlet at 5'. Need to add trench 20' long - 13' deep. Call before adding gravel (GLK) 26 June 77 - OK for stone (GLK)

6/29/77 Water line connected OK to cover all work for J. Stanger
 DATE SYSTEM APPROVED 6/29/77 INSPECTOR

A 25741

P

STATE OF MARYLAND - DEPARTMENT OF HEALTH AND MENTAL HYGIENE
HOWARD COUNTY HEALTH DEPARTMENT 3BR 1000 GAL TANK DISTRICT 3rd
ENVIRONMENTAL HEALTH SERVICES 4BR 1250 GAL TANK DATE 4/27/77

DATE 4/27/77

~~TO THE COUNTY HEALTH OFFICER~~
ELLICOTT CITY, MARYLAND

clean out provided if sharp bend in line between house & septic tank.

I, HEREBY, APPLY FOR THE NECESSARY TEST IN ORDER TO CONSTRUCT (OR RECONSTRUCT) A SEWAGE DISPOSAL SYSTEM. ~~PLACE THE DW 429 IF FROM THE LOT LINE~~
WHICH IS 1372.08 FT LONG FROM S N 85° 38' 30" E

PROPERTY OWNER Dr. Victor A. Fazekas
8200 FT FROM THE STONE SHOWN ON
 ADDRESS 5214 Lighting View Road, Columbia, Md. 21045 PHONE 730-3993

ADDRESS 5214 Lighting View Road, Columbia, Md. 21045 PHONE 730-1551
 THE SITE PLAN. THIS STONE IS THE ONE
 PROPERTY LOCATION: WITH THE 100 FT ASSUMED

SUBDIVISION Parcel #14 Tax Map 9 LOT NO.

ROAD AND DESCRIPTION State Route 32 north of 70 toward Sykesville just before
Indian Hill Drive

SIZE OF LOT 25.25 acres TYPE BLDG. 3 or 4 bedrooms

IF NOT SINGLE RESIDENCE DESCRIBE _____

THE SYSTEM INSTALLED UNDER THIS APPLICATION IS ACCOMPANIED BY A PERMIT TO USE ONLY UNTIL PUBLIC FACILITIES BECOME AVAILABLE. BLDG. PERMIT NO. 8/31/78 AND RETURNED

SIGNATURE OF APPLICANT /s/ Victor A. Fazekas Serial No. 35326


APPROVED BY Raymond M. Hayes FOR DR 7 WELL DATE 5/10/77
(KIND OF SYSTEM)

REJECTED BY _____ FOR _____ DATE _____
(KIND OF SYSTEM)

HOLD PENDING FURTHER TESTS _____ DATE _____

REASONS FOR REJECTION OR HOLDING BUILDER: Leslie Lutor
929-1149

THIS IS NOT A PERMIT

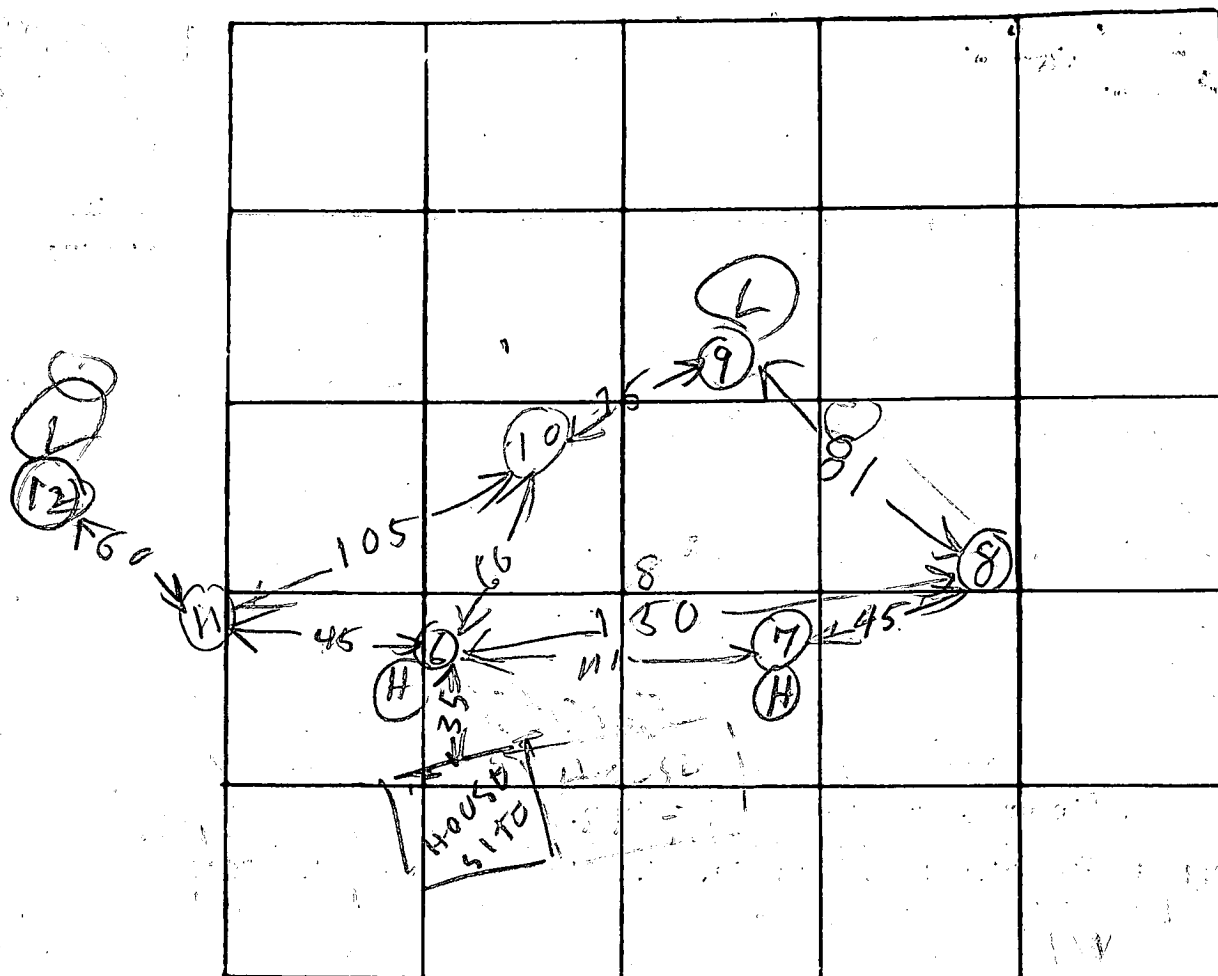

INDICATE NORTH. - NAME ADJOINING ROADWAY AS BASE LINE

DATE	TEST NO.	DEPTH	PRE-WET		TEST 1" DROP		TIME
			START	STOP	START	STOP	
5/19/77	8D	13	207	217	217	227	10
5/19/77	8S	5 1/2	207	210	210	215	5
	9S	4 1/2	215	217	217	220	3
	9D	13	215	217	217	220	3
	10S	5	224	226	226	229	3
	10D	13	224	232	232	244	12
	11V	11 1/2	ALG SAND				32
5/19/77	12V	12	70N	7FT	CLAY		
			BOT	5 FT	SANDY		
			1 X 1	1			
	Use Hole 6 or 7 for DW high hole						

REMARKS

TYPE OF SOIL

TESTED BY

ALSO PRESENT

PR FAZEKAS
J. BRITTINGHAM

Recorded

APPLICATION

A 22653

SEWAGE DISPOSAL TESTING

P. 1000

STATE OF MARYLAND - DEPARTMENT OF HEALTH AND MENTAL HYGIENE

HOWARD COUNTY HEALTH DEPARTMENT
ENVIRONMENTAL HEALTH SERVICES

BR ST
3 - 1000 gal
4 - 1250 gal

DISTRICT 3rd

P. O. BOX 476, ELLICOTT CITY, MARYLAND 21043
TELEPHONE: 465-5000, EXT. 356

DATE 12/28/75

The sewage disposal field will consist of trenches 2' wide and 9' deep with 6' of stone. The vertical usable sidewall area will be considered as between 5' and 9' below O.G. There will be 135th feet of absorbent sidewall area per bedroom in the trenches.

[BR - 1 trench 105' long; 4BR - 2 trenches 70' long] The trench(s) will follow the contour of the land. The first trench will begin at a point 105' from the corner of the 127' prop. line & the 134' prop. line, and 60' from the 134' prop. line & the 199' prop. line corner. If 2 trenches are used, they will be spaced 15' apart center-to-center. The trenches should be connected in series.

TO: THE COUNTY HEALTH OFFICER
ELLICOTT CITY, MARYLAND

I, HEREBY, APPLY FOR THE NECESSARY TEST IN ORDER TO CONSTRUCT (OR RECONSTRUCT) A SEWAGE DISPOSAL SYSTEM.

PROPERTY OWNER Dr. Victor A. Fazekas

ADDRESS 5214 Lighting View Road
Columbia Maryland 21045

PHONE 730-3993

PROPERTY LOCATION:

SUBDIVISION Parcel #14 Tax Map 9

LOT NO.

ROAD AND DESCRIPTION State Route 32

North of 70 toward Sykesville

just before Indian Hill Dr. BEHIND A YELLOW HOUSE

SIZE OF LOT 25.25 Acres

TYPE BLDG. Residence

IF NOT SINGLE RESIDENCE DESCRIBE Construct another house on this property - no subdividing.

THE SYSTEM INSTALLED UNDER THIS APPLICATION IS ACCEPTABLE ONLY UNTIL PUBLIC FACILITIES BECOME AVAILABLE.

SIGNATURE OF APPLICANT Victor Fazekas

APPROVED BY R. Moorefield

FOR Trenches

DATE 3/11/76

(KIND OF SYSTEM)

REJECTED BY

FOR

DATE

(KIND OF SYSTEM)


HOLD PENDING FURTHER TESTS R. Moorefield

DATE 1/16/76

REASONS FOR REJECTION OR HOLDING Hold for wet season, test for shallow system

THIS IS NOT A PERMIT

0
clay/loam
4-5
less clay
12

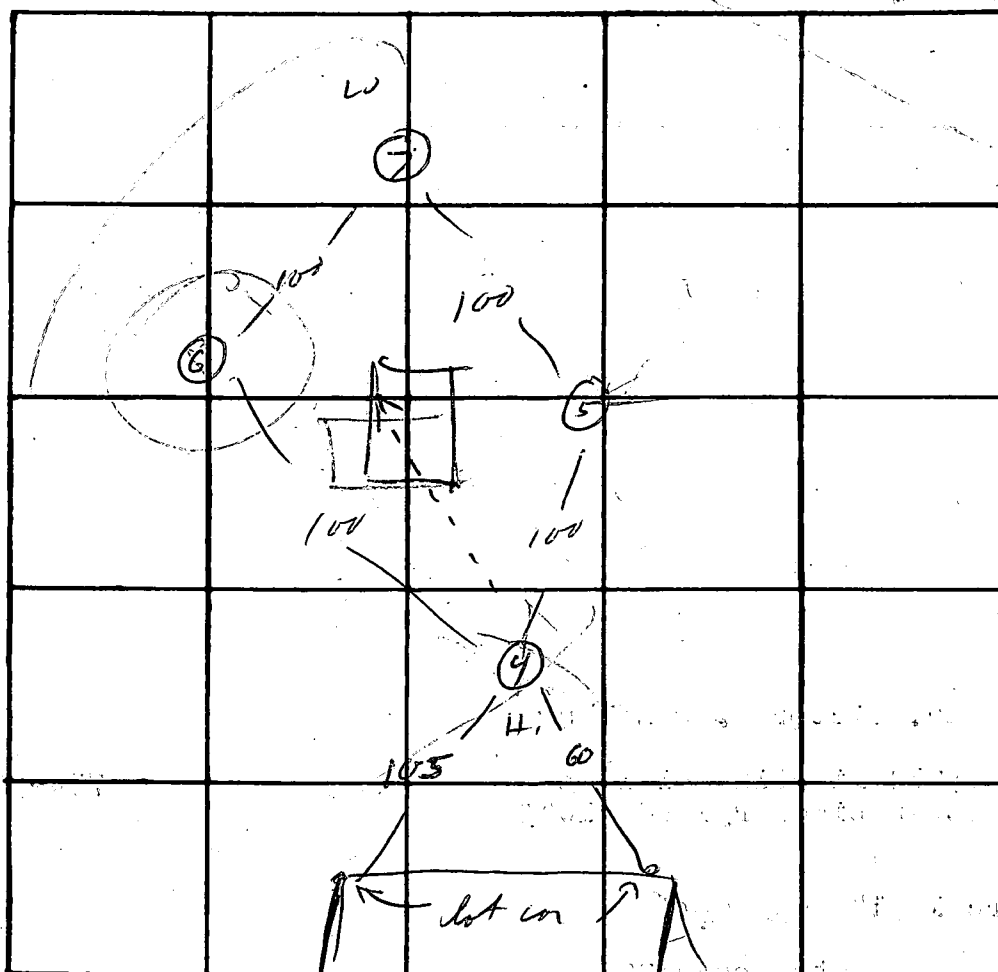

INDICATE NORTH. - NAME ADJOINING ROADWAY AS BASE LINE.

← 024 32 →

DATE	TEST NO.	DEPTH	PRE-WET		TEST - 1" DROP		TIME
			START	STOP	START	STOP	
3/11	4	5	10 ¹⁰	10 ¹²	10 ¹²	10 ¹⁴	2
	4A	12	10 ¹⁰	10 ¹³	10 ¹³	10 ²⁰	7
	5	12	10 ¹⁴	10 ²¹	10 ²¹	10 ²⁷	6
	5A	4	10 ¹⁵	10 ²⁰	10 ²⁰	10 ²⁶	6
	7	5	10 ²⁵	10 ³⁰	10 ³⁰	10 ³⁵	5
	7A	13	10 ²⁵	10 ³³	10 ³³	10 ⁴³	10

REMARKS

Δ in elev. hi. to 20' ~ 3'; for better location

TYPE OF SOIL

R-M

Frysk

see attached plat

APPLICATION

A 22653

SEWAGE DISPOSAL TESTING

P _____

STATE OF MARYLAND - DEPARTMENT OF HEALTH AND MENTAL HYGIENE

HOWARD COUNTY HEALTH DEPARTMENT
ENVIRONMENTAL HEALTH SERVICES

DISTRICT 3rd

P. O. BOX 476, ELLICOTT CITY, MARYLAND 21043
TELEPHONE: 465-5000, EXT. 356

DATE 12/28/75

TO: THE COUNTY HEALTH OFFICER
ELLICOTT CITY, MARYLAND

I, HEREBY, APPLY FOR THE NECESSARY TEST IN ORDER TO CONSTRUCT (OR RECONSTRUCT) A SEWAGE DISPOSAL SYSTEM.

PROPERTY OWNER Dr. Victor A. Fazekas

ADDRESS 5214 Lighting View Road
Columbia Maryland 21045

PHONE 730-3993

PROPERTY LOCATION:

SUBDIVISION Parcel #14 Tax Map 9

LOT NO. _____

ROAD AND DESCRIPTION State Route 32

SIZE OF LOT 25.25 Acres

TYPE BLDG. Residence

NUMBER OF BEDROOMS _____

IF NOT SINGLE RESIDENCE DESCRIBE _____

THE SYSTEM INSTALLED UNDER THIS APPLICATION IS ACCEPTABLE ONLY UNTIL PUBLIC FACILITIES BECOME AVAILABLE.

SIGNATURE OF APPLICANT *Victor A. Fazekas*

APPROVED BY _____

FOR _____

(KIND OF SYSTEM)

DATE _____

REJECTED BY _____

FOR _____

(KIND OF SYSTEM)

DATE _____


HOLD PENDING FURTHER TESTS _____

DATE _____

REASONS FOR REJECTION OR HOLDING _____

THIS IS NOT A PERMIT

①
0
4
redish clay/loam
yellow micaceous
very fine loam
12 1/2

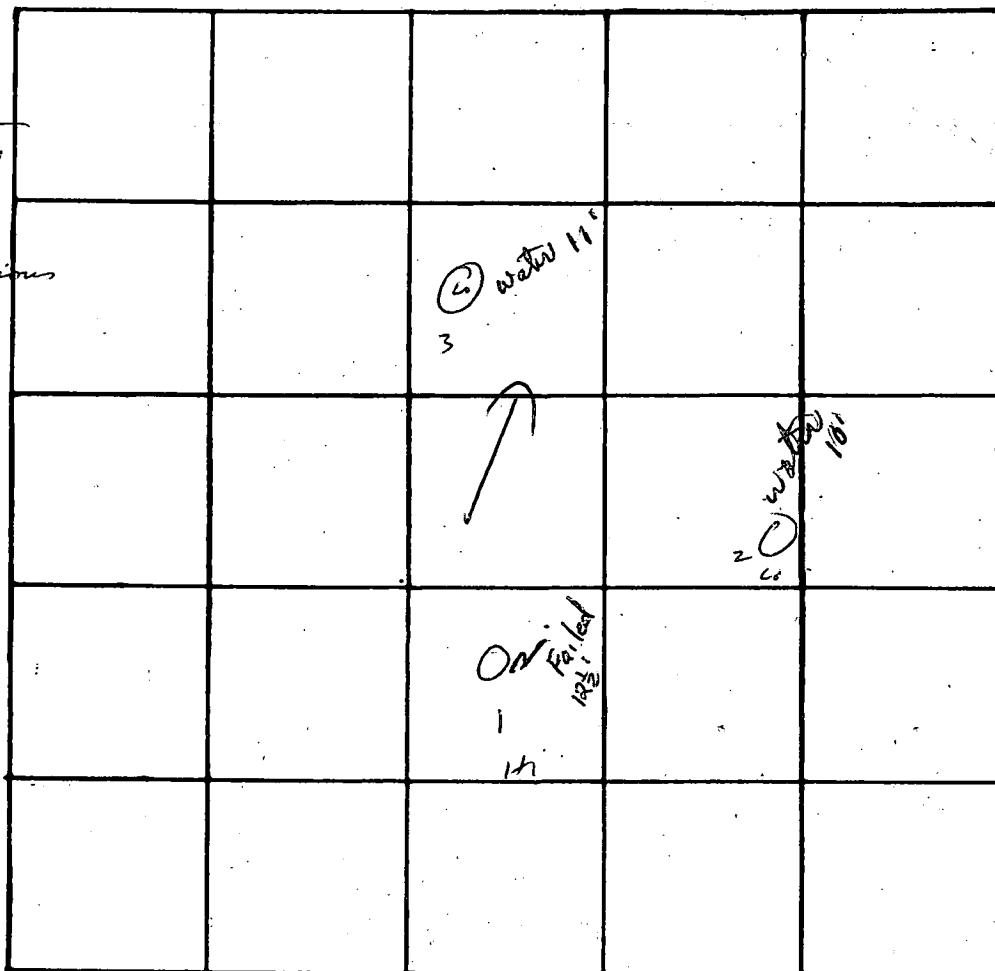

INDICATE NORTH. - NAME ADJOINING ROADWAY AS BASE LINE.

← 32 →

DATE	TEST NO.	DEPTH	PRE-WET		TEST - 1" DROP		TIME
			START	STOP	START	STOP	
7/1/76	1	4	12 ²⁷	12 ³²	12 ³²	12 ³⁸	6
	1A	12 1/2	12 ²⁷	1 ⁰⁷	40 min for 1"		>30
	2	11 1/2	water		@ 10'		
	3	13	water @		11'		
	3A	4	12 ⁴⁸	12 ⁵¹	12 ⁵¹	12 ⁵⁹	8

REMARKS


Test for shallow system in the wet season

TYPE OF SOIL

12 mow/rit

Fryok

N

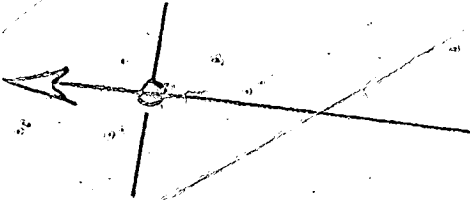

578.78'

358.69'

24.10 Acres

1372.08' stone

1625.89'

434.00'

199.09'

127.26'

134.3'

412.09'

132.9'

200'

Service Rd.

281.50'

202.00'

119.150'

100'

100'

Rt. 32

To Sykesville

To 70N


C 1	8655	SEQUENCE NO. (WRA USE ONLY)	STATE OF MARYLAND WATER RESOURCES ADMINISTRATION TAWES STATE OFFICE BLDG., ANNAPOLIS, MD. 21401 WELL COMPLETION REPORT		THIS REPORT MUST BE SUBMITTED WITHIN 30 DAYS AFTER WELL COMPLETION FILL IN THIS FORM COMPLETELY COUNTY NUMBER _____
DATE RECEIVED (WRA USE ONLY) 8-25-78 DATE WELL COMPLETED		DEPTH OF WELL 125 (TO NEAREST FOOT)		PERMIT NO. FROM "PERMIT TO DRILL WELL" HO-73-2947 28 29 30 31 32 33 34 35 36 37	
OWNER: FAZEKAS, VICTOR LAST NAME		FIRST NAME COLUMBIA, MA 21045		DRILLERS IDENTIFICATION NO. 120	
STREET OR RFD: 5214 LIGHTNING VIEW		POST OFFICE			

WELL LOG			
STATE THE KIND OF FORMATIONS PENETRATED, THEIR COLOR, DEPTH, THICKNESS AND IF WATER BEARING			
DESCRIPTION (USE ADDITIONAL SHEETS IF NECESSARY)	FEET	FROM	TO
OVERBURDEN	0		8
BROWN SHALE	8		62
GRAY ROCK	62		125 X

GROUTING RECORD			
WELL HAS BEEN GROUTED (CIRCLE APPROPRIATE BOX) YES ☒ NO ☐			
TYPE OF GROUTING MATERIAL (CIRCLE BOX) CEMENT ☒ BENTONITE CLAY ☐			
NO. OF BAGS 10 NO. OF POUNDS 1000			
GALLONS OF WATER 60			
DEPTH OF GROUT SEAL (TO NEAREST FOOT) FROM 0 FT. TO 64 FT.			
CASING RECORD			
INSERT APPROPRIATE CODE BELOW STEEL ☒ CONCRETE ☐ PLASTIC ☐ OTHER ☐			
MAIN CASING TYPE ☒ NOMINAL DIAMETER TOP (MAIN) CASING (NEAREST INCH) 6 TOTAL DEPTH OF MAIN CASING (NEAREST FOOT) 64			
OTHER CASING (IF USED) DIAMETER (INCH) FROM DEPTH (FEET)			
SCREEN TYPE OR OPEN HOLE INSERT APPROPRIATE CODE BELOW STEEL ☒ BRASS OR BRONZE ☐ OPEN HOLE ☐ PLASTIC ☐ OTHER ☐			
C 2 (SEQ. NO.) 6 DEPTH (NEAREST WHOLE FOOT) FROM 64 TO 125			
EACH SCREEN 1 HO 23 24 26 30 32 36 2 38 39 41 45 47 51 SLOT SIZE 1, 2, 3,			
DIAMETER OF SCREEN 56 (NEAREST INCH) FROM TO			
GRAVEL PACK			
IF WELL DRILLED WAS A FLOWING WELL CIRCLE BOX 68 F			
WRA USE ONLY (NOT TO BE FILLED IN BY DRILLER) (E.R.O.S.) T 70 LOG 72 INDICATOR W 74 75 76 OTHER DATA AVAILABLE			

PUMPING TEST	
HOURS PUMPED (TO NEAREST HOUR) 8	
PUMPING RATE (GALLONS PER MINUTE TO NEAREST GALLON) 15	
METHOD USED TO MEASURE PUMPING RATE AIR	
WATER LEVEL: (DISTANCE FROM LAND SURFACE) BEFORE PUMPING 31 (NEAREST FOOT) WHEN PUMPING 100 (NEAREST FOOT)	
TYPE OF PUMP USED (CIRCLE APPROPRIATE BOX) AIR ☒ PISTON ☐ TURBINE ☐ CENTRIFUGAL ☐ ROTARY ☐ OTHER (DESCRIBE BELOW) ☐ JET ☐ SUBMERSIBLE ☐	
PUMP INSTALLED	
TYPE OF PUMP (WRITE APPROPRIATE LETTER IN BOX - SEE ABOVE: A, C, J, P, R, S, T, O)	
DRILLER WILL INSTALL PUMP (CIRCLE APPROPRIATE BOX) YES ☒ NO ☐	
CAPACITY: GALLONS PER MINUTE (TO NEAREST GALLON) 31 35 PUMP HORSE POWER 37 41 PUMP COLUMN LENGTH (NEAREST FOOT) 43 47	
CASING HEIGHT	
(CIRCLE APPROPRIATE BOX AND ENTER CASING HEIGHT) ABOVE ☒ BELOW ☐ LAND SURFACE 1 (NEAREST FOOT)	
LOCATION OF WELL ON LOT	
SHOW PERMANENT STRUCTURE SUCH AS BUILDINGS, SEPTIC TANKS, AND/OR OTHER LAND MARKS AND INDICATE NOT LESS THAN TWO DISTANCES (MEASUREMENTS TO WELL). PITLESS ADAPTER	

CIRCLE APPROPRIATE BOXES	
A A WELL WAS ABANDONED AND SEALED WHEN THIS WELL WAS COMPLETED E ELECTRIC LOG OBTAINED P TEST WELL CONVERTED TO PRODUCTION WELL	
I HEREBY CERTIFY THAT I HAVE COMPLIED WITH ALL CONDITIONS STATED ON THE ABOVE-CAPTIONED "PERMIT TO DRILL WELL", AND THAT INFORMATION CONTAINED IN THIS REPORT IS TRUE, ACCURATE, AND COMPLETE TO THE BEST OF MY KNOWLEDGE, INFORMATION AND BELIEF.	
DRILLERS NAME (PLEASE PRINT) EDGAR HARRIS CORP.	
SIGNATURE	

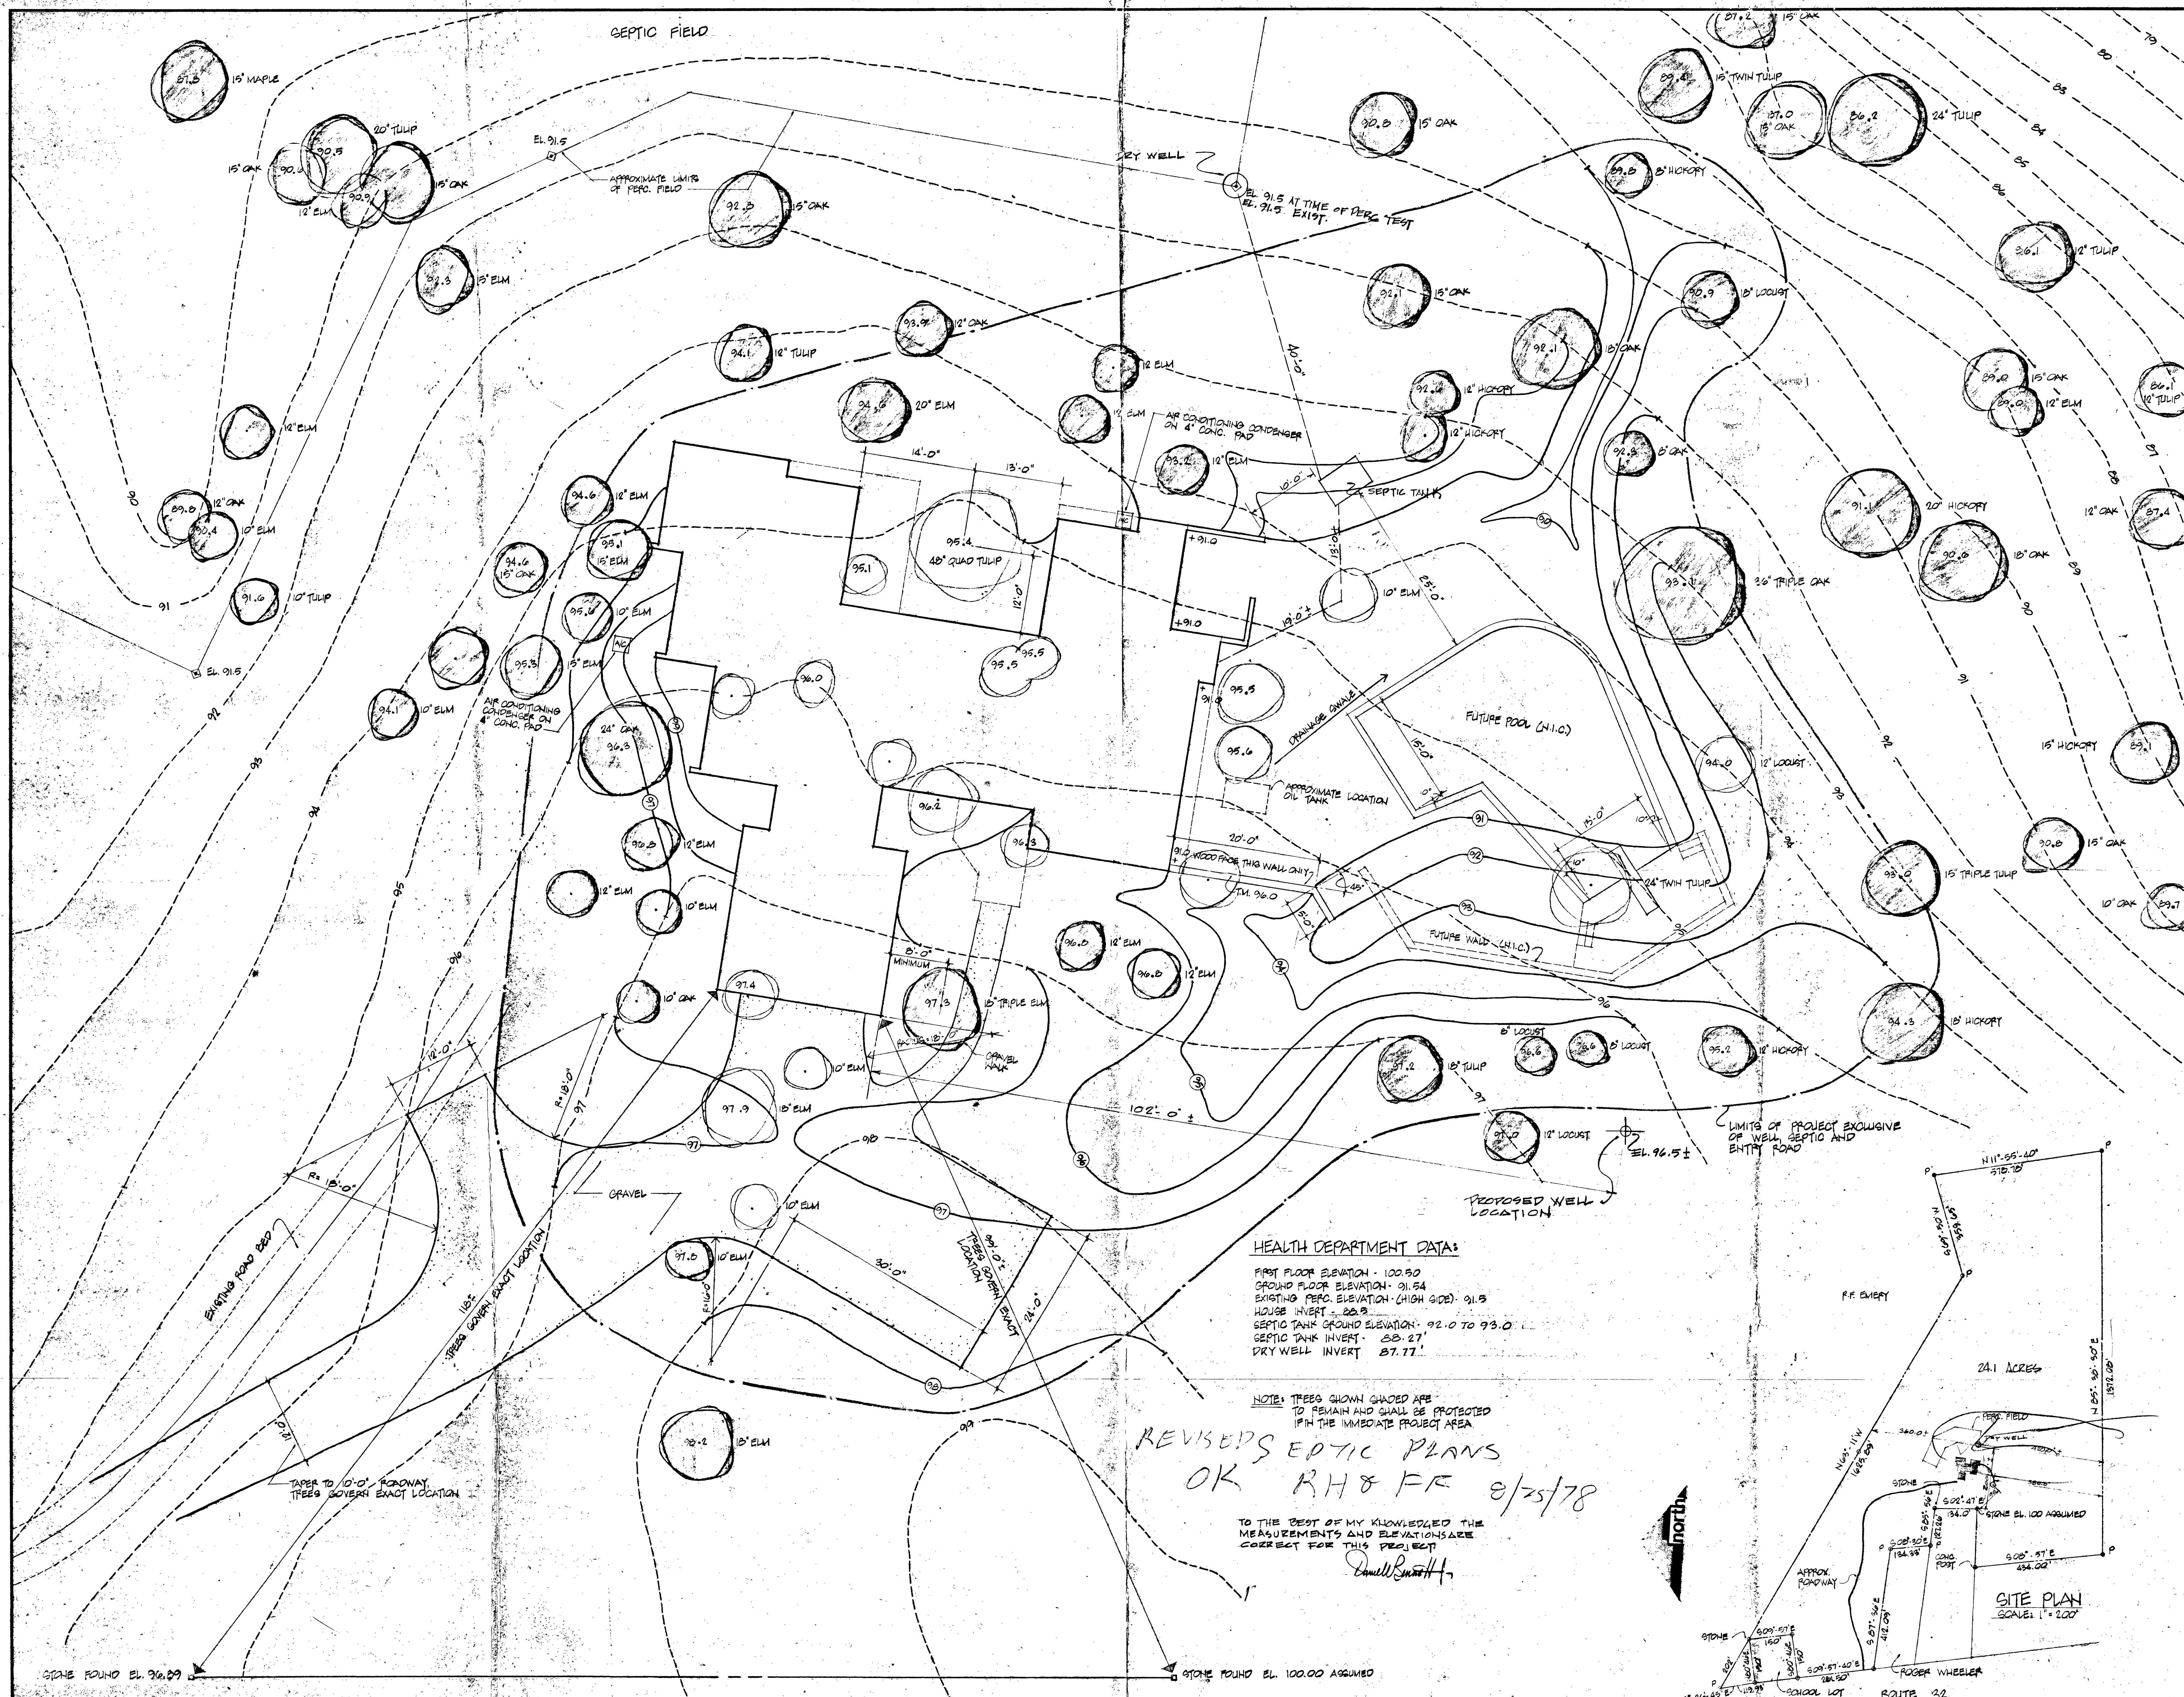

HEALTH DEPARTMENT DATA:



FIRST FLOOR ELEVATION - 100.50
GROUND FLOOR ELEVATION - 91.54
EXISTING PERC. ELEVATION (HIGH SIDE) - 91.5
HOUSE INVERT - 88.9
SEPTIC TANK GROUND ELEVATION - 92.0 TO 93.0
SEPTIC TANK INVERT - 88.27
DRY WELL INVERT - 87.77

NOTE: TREES SHOWN SHADED ARE TO REMAIN AND SHALL BE PROTECTED IN THE IMMEDIATE PROJECT AREA

REVISED SEPTIC PLANS
OK RH & FR 8/25/78

TO THE BEST OF MY KNOWLEDGE THE MEASUREMENTS AND ELEVATIONS ARE CORRECT FOR THIS PROJECT

Daniel R. Smith

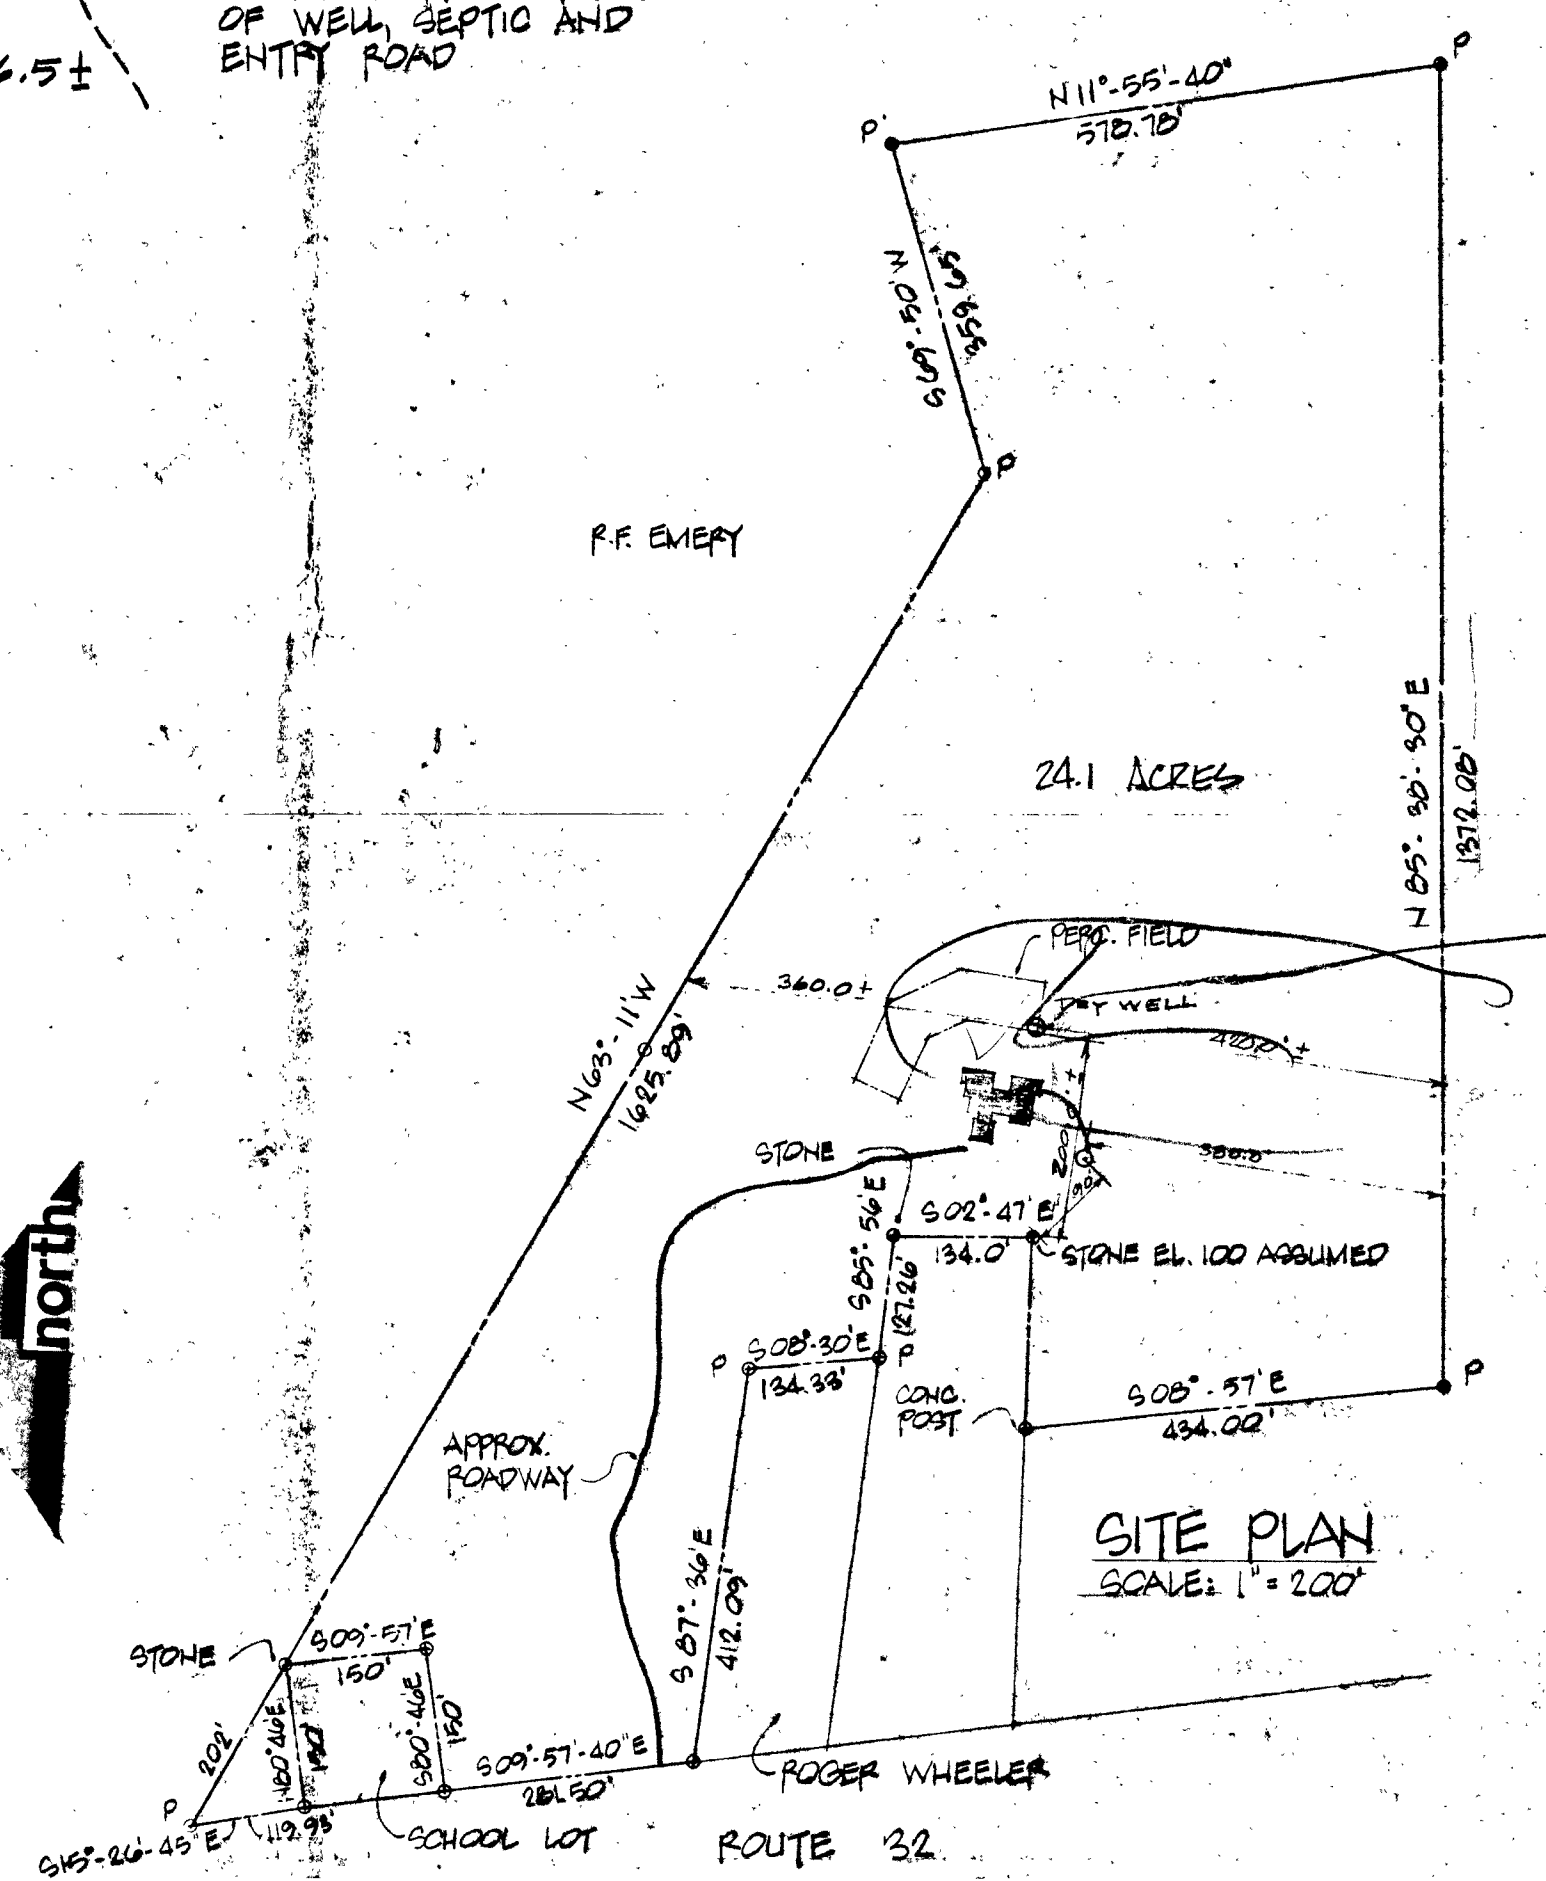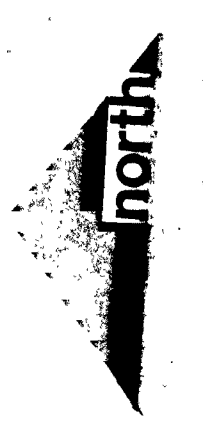

DRAWN BY: C.K.	CHECKED BY:	REVISIONS: MARCH 8, 1978 REVISED BY: J.E. WELLS & J. H. WELLS	JOB NO:
SITE & GRADING PLAN			
REGISTERED PROFESSIONAL ARCHITECT BENNETT/JOLSON AND ASSOCIATES ARCHITECTS & PLANNERS - SUITE 719 AMERICAN CITY BUILDING COLUMBIA, MARYLAND 21044 - 301-730-1766			
ROUTE 72 HOWARD COUNTY, MARYLAND			
1			