

PERMIT

SEWAGE DISPOSAL SYSTEM

DEPARTMENT OF HEALTH AND MENTAL HYGIENE

P 48965
A 24986
A REPAIR

DISTRICT _____

DATE 7/23/93

DATE SYSTEM APPROVED 1/25/93

INSPECTOR RP

HOWARD COUNTY HEALTH DEPARTMENT

BUREAU OF ENVIRONMENTAL HEALTH

~~461-9933~~ 313-2640

Jack Fyock

IS PERMITTED TO INSTALL _____ ALTER X

ADDRESS _____ PHONE 988-9270

SUBDIVISION Slack Property LOT 5A ROAD 1919 Route 32

PROPERTY OWNER William T. Krebs

1919 Route 32

ADDRESS _____

SEPTIC TANK CAPACITY existing 1600 gal GALLONS

NUMBER OF BEDROOMS 3

125 SQUARE FEET PER BEDROOM

LINEAR FEET OF TRENCH REQUIRED 65

REPAIR - PURPOSE - SEPTIC SYSTEM HAS FAILED.

Call for inspection when ground is opened so sanitarian can recommend repair. 1/25/93

Install one 65' long, 2 ft wide Trench tied into existing drywell.

Make trench inlet @ 4 1/2 ft below existing grade, 11 ft deep max., 6 1/2 ft gravel fill.

Install trench on contour.

PLANS APPROVED BY _____ DATE _____

COVER NO WORK UNTIL INSPECTED AND APPROVED

NEITHER THE HOWARD COUNTY COUNCIL NOR THE HEALTH DEPARTMENT IS RESPONSIBLE FOR THE SUCCESSFUL OPERATION OF ANY SYSTEM

NOTE: CLEANOUT REQUIRED EVERY 70 FEET OF SEWER LINE AND/OR AT 90° SWEEPS IN LINES FROM HOUSE TO DRAIN FIELDS, 90° ELBOWS NOT ACCEPTABLE.

NOTE: ALL PARTS OF SEPTIC SYSTEMS (I.E. TANK, DISTRIBUTION BOX TRENCHES) TO BE 100 FEET FROM WELL (UNLESS OTHERWISE SPECIFICALLY AUTHORIZED)

NOTE: IF DEEP TRENCH(ES) ARE USED CALL FOR INSPECTION BEFORE AND AFTER PLACING GRAVEL IN TRENCH(ES)

NOTE: NO DRY WELL SHALL EXCEED 15 FOOT IN DIAMETER NO ABSORPTION TRENCH TO EXCEED 100 FEET IN LENGTH

NOTE: ALL PIPE FROM HOUSE TO SEPTIC TANK MUST BE CAST IRON OR SCHEDULE 35/40 PVC OR ABS

PERMIT VOID AFTER TWO YEARS

NOTE: INSTALL STAND PIPE ON SEPTIC TANK AND DRY WELL STAND PIPES MUST BE 6 INCHES IN DIAMETER CAST IRON. CONCRETE OR TERRA COTTA OR PVA OR ABS ACCEPTED. IF TOP OF SEPTIC TANK IS DEEPER THAN 3 FEET. MANHOLE TO GRADE REQUIRED.

NOTE: DISTRIBUTION BOXES MUST HAVE BAFFLES

***INSTALLER IS RESPONSIBLE FOR OBTAINING FINAL APPROVAL ON THIS PERMIT**

A 48965

APPROVED 12/10/79

R.D.

P 30359

A 24986

PERMIT

SEWAGE DISPOSAL SYSTEM

MARYLAND STATE DEPARTMENT OF HEALTH*

HOWARD COUNTY

ELLICOTT CITY

DISTRICT 3rd

(INDEXED)

DATE 11/14/79

J. Joseph Gartland

IS PERMITTED TO INSTALL ☒ ALTER

ADDRESS

PHONE

SUBDIVISION (Slack Property)

ROAD 1919 Route 32

LOT 5A

PROPERTY OWNER William T. Krebs

ADDRESS 802 Roundtop Court, Apt. 1B, Lutherville, Md. 21093

SPECIFICATIONS 3 bedrooms

SEPTIC TANK CAPACITY 1000 GALLONS

DRAIN FIELD DEPTH FEET, BOTTOM AREA SQ. FT.

DEEP TRENCH DEPTH FEET, BOTTOM AREA SQ. FT.

SEEPAGE PITS ☒ ABSORBENT SIDE-WALL AREA 130 SQ. FT. per bedroom in system.

INLET PIPE 4 FT. BELOW ORIGINAL GRADE. MAXIMUM DEPTH 12 FT. BELOW ORIGINAL GRADE

EFFECTIVE DEPTH AT FT. BELOW ORIGINAL GRADE.

LOCATE DISPOSAL AREA 20 FT. FROM left LOT LINE AND 435 FT. FROM front LOT LINE AS SEEN WHEN

FACING LOT FROM Route 32. (Perc hole 142).

If trench is used, with dry well, need a 5 ft. earth buffer between dry well and trench.

Inspections before and after gravel is installed. Trench to follow contour of land.

A.M. { 12/5/79. Recommended 13' x 13' DW; 8' effective; inlet 3 1/2' - 4' }
 at sites with Mr. Gartland, C.B.D.

PLANS APPROVED BY C.B. Streaker

DATE 5/2/77

COVER NO WORK UNTIL INSPECTED AND APPROVED.

NEITHER THE HOWARD COUNTY COUNCIL NOR THE HEALTH DEPARTMENT IS RESPONSIBLE FOR THE SUCCESSFUL OPERATION OF ANY SYSTEM.

NOTE: IF TRENCH IS USED CALL FOR INSPECTION BEFORE PLACING GRAVEL IN TRENCH.

NOTE: NO DRY WELL SHALL EXCEED 15 FOOT IN DIAMETER.

NOTE: ALL PIPE FROM HOUSE TO DISPOSAL AREA MUST BE CAST IRON.


PERMIT VOID AFTER THREE YEARS.

NOTE: INSTALL STAND PIPE ON SEPTIC TANK AND DRY WELL. STAND PIPES MUST BE 6 INCHES IN DIAMETER. CAST IRON, CONCRETE OR TERRA COTTA ACCEPTED.

*INSTALLER IS RESPONSIBLE FOR OBTAINING FINAL APPROVAL ON THIS PERMIT.

A 24986

390 NEEDED

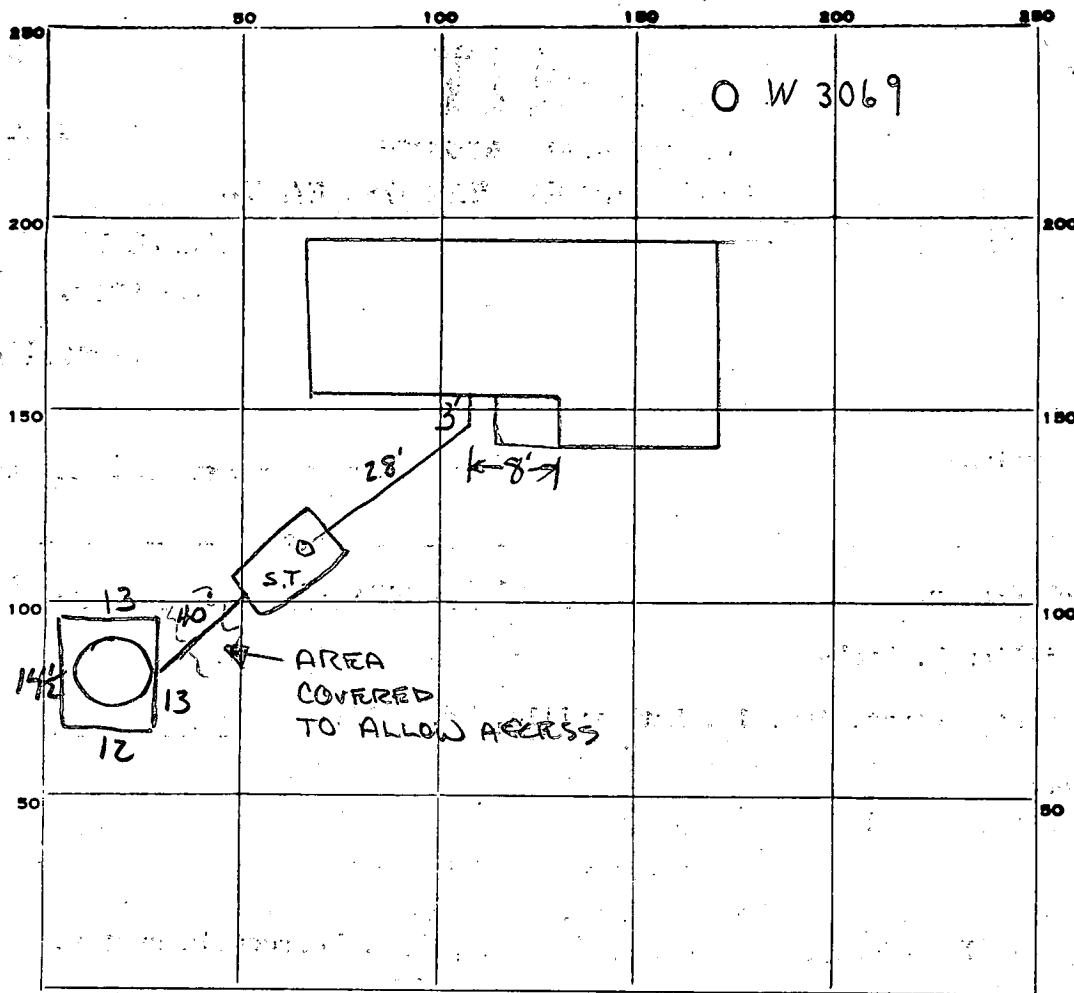

INDICATE NORTH. - NAME ADJOINING ROADWAY AS BASE LINE.

RT. 32

PERMIT CARD ☒

SEPTIC TANK, LEVEL ☒

CLEANOUTS

S.T. | D.W.

CAST IRON ☒

CAST IRON ☒

DISTRIBUTION BOX, LEVEL ☐

TILE FIELD, DEPTH 8 FT. TRENCH WIDTH 8 FT.

GRAVEL DEPTH 8 IN. TOTAL LENGTH 52.5 FT.

NUMBER OF TRENCHES 1 TOTAL BOTTOM AREA 52.5

SEEPAGE PITS, INSIDE DIAMETER 52.5 FT. DEPTH BELOW INLET 8 FT.

ABSORBENT AREA 422 SQ. FT.

REMARKS 12/4/79 NO WORK DONE. 12/5/79 NO WORK DONE - SEE FRONT.
12/7/79 - 12 CLEANOUT NEEDED AT 45° WITH CLEANOUT IN BASEMENT 3' AWAY. C.B.S. + J.S. C.B.S.
OK TO COVER SYSTEM EXCEPT HOUSE CONN. R.D. HOUSE CONN. OK, NO
CLEANOUT NEEDED CBS & D.W.M. 12/10/79

DATE SYSTEM APPROVED 12/10/79

INSPECTOR R. DeMarco

J. Joseph Gartland

APPLICATION

A24986

SEWAGE DISPOSAL TESTING

STATE OF MARYLAND - DEPARTMENT OF HEALTH AND MENTAL HYGIENE
HOWARD COUNTY HEALTH DEPARTMENT
ENVIRONMENTAL HEALTH SERVICES

P. O. BOX 476, ELLICOTT CITY, MARYLAND 21043
TELEPHONE: 465-5000, EXT. 356

P. _____
1000 gallons
DISTRICT 3rd
1250 gallon
DATE 12/15/76

*Septic Tank { 1-3 Bedrooms
4 Bedrooms*
Boy will to have 130 sq. ft.
effective absorbant sidewalk area per
bedroom below inlet. Inlet to be 4'
and maximum depth 12'. Location
per plat 20' off right property line and
435' from front property line when facing
lot from R132 (Peru data 142)
** If trench used with drywell*

TO: THE COUNTY HEALTH OFFICER
ELLICOTT CITY, MARYLAND

I, HEREBY, APPLY FOR THE NECESSARY TEST IN ORDER TO CONSTRUCT (OR RECONSTRUCT) A SEWAGE
DISPOSAL SYSTEM.

PROPERTY OWNER *William J. Krebs*
Need 0.5' earth layer
Before & after
any questions call: Mr.
823-3535 Spellman
gravel in for
inspection of
trench

ADDRESS *Route 32 802 Roundtop Court* PHONE _____
Apt. 1B, Lutherville, Md. 21093

PROPERTY LOCATION

SUBDIVISION *SLACK PROPERTY* LOT NO. *5A*

1919
ROAD AND DESCRIPTION *Route 32*

SIZE OF LOT *2.65 acres ±* TYPE BLDG. *3 or 4*
NUMBER OF BEDROOMS

IF NOT SINGLE RESIDENCE DESCRIBE _____

THE SYSTEM INSTALLED UNDER THIS APPLICATION IS ACCEPTABLE ONLY UNTIL PUBLIC
FACILITIES BECOME AVAILABLE.

SIGNATURE OF APPLICANT */s/ Mr. George Slack*

APPROVED BY *C. B. Shuck* FOR *Boy will or*
dry well & trench DATE *5/2/77*
(KIND OF SYSTEM)

REJECTED BY _____ FOR _____ DATE _____
(KIND OF SYSTEM)

HOLD PENDING FURTHER TESTS _____ DATE _____

REASONS FOR REJECTION OR HOLDING _____

B.P. Appl. # 39790 - has bldg. permit

THIS IS NOT A PERMIT

INDICATE NORTH. - NAME ADJOINING ROADWAY AS BASE LINE

DATE	TEST NO.	DEPTH	PRE-WET		TESTER		TIME
			START	STOP	START	STOP	

REMARKS _____

TYPE OF SOIL _____

TESTED BY _____ ALSO PRESENT: _____

APPLICATION

SEWAGE DISPOSAL TESTING

STATE OF MARYLAND - DEPARTMENT OF HEALTH AND MENTAL HYGIENE

HOWARD COUNTY HEALTH DEPARTMENT
ENVIRONMENTAL HEALTH SERVICES

P. O. BOX 476, ELLICOTT CITY, MARYLAND 21043
TELEPHONE: 465-5000, EXT. 356

DISTRICT 3rd

DATE 12/15/76

A _____

P _____

TO: THE COUNTY HEALTH OFFICER
ELLICOTT CITY, MARYLAND

I, HEREBY, APPLY FOR THE NECESSARY TEST IN ORDER TO CONSTRUCT (OR RECONSTRUCT) A SEWAGE DISPOSAL SYSTEM.

PROPERTY OWNER Mr. George W. Slack - Estate of Ethel Slack

ADDRESS Route 32

PHONE any questions call: Mr. 823-3535 Spellman

PROPERTY LOCATION:

SUBDIVISION SLACK PROPERTY

LOT NO. 5A

ROAD AND DESCRIPTION Route 32

SIZE OF LOT 2.65 acres ±

TYPE BLDG. 3 or 4

NUMBER OF BEDROOMS

IF NOT SINGLE RESIDENCE DESCRIBE _____

THE SYSTEM INSTALLED UNDER THIS APPLICATION IS ACCEPTABLE ONLY UNTIL PUBLIC FACILITIES BECOME AVAILABLE.

SIGNATURE OF APPLICANT /s/ Mr. George Slack

APPROVED BY _____ FOR _____ DATE _____

(KIND OF SYSTEM)

REJECTED BY _____ FOR _____ DATE _____


(KIND OF SYSTEM)

HOLD PENDING FURTHER TESTS _____ DATE _____

REASONS FOR REJECTION OR HOLDING _____

THIS IS NOT A PERMIT

Rt 99
 9/13
 Gift House
 Barn

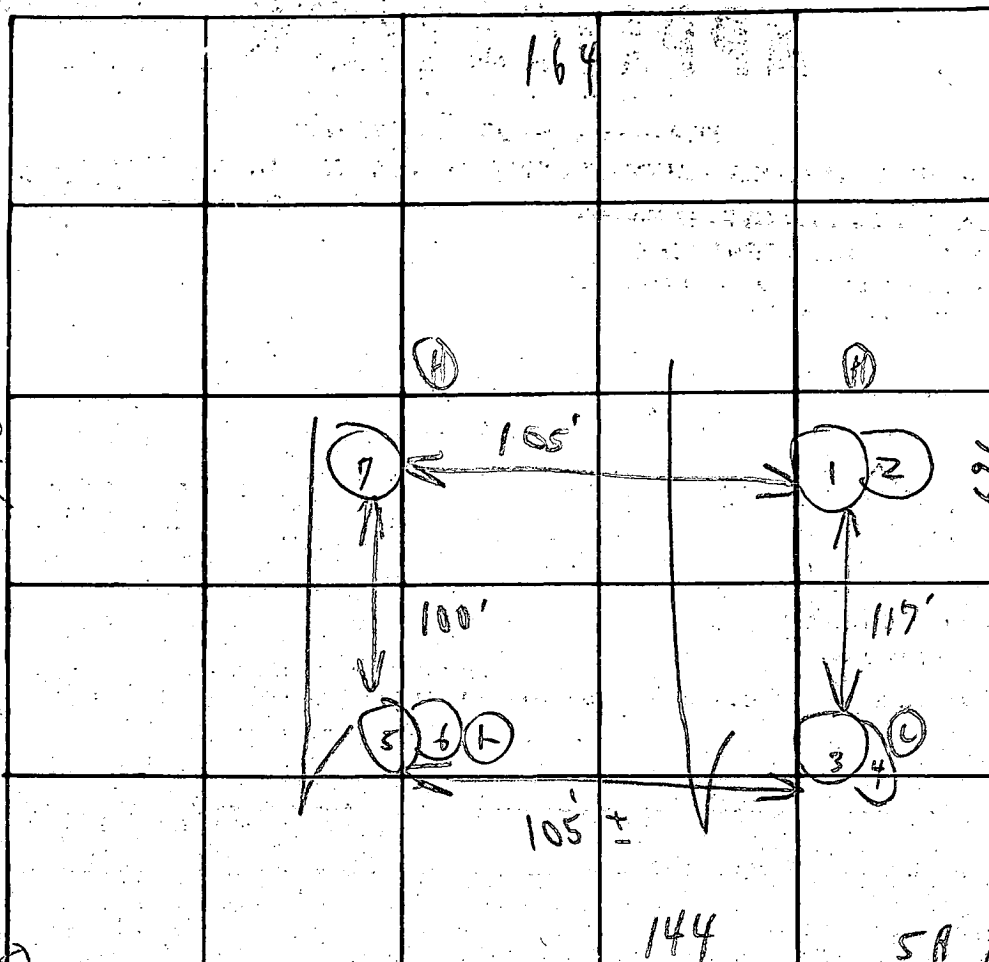

INDICATE NORTH. - NAME ADJOINING ROADWAY AS BASE LINE

Deposited 30¢
Sollitt DATE

R 32

West Friendship

DATE	TEST NO.	DEPTH	PRE-WET		TEST - 1" DROP		TIME
			START	STOP	START	STOP	
2/24/77	1	4'	10:03	10:05	10:05	10:08	3m
	2 (H)	13 1/2'	10:04	10:06	10:06	10:10	4m
	3	6 1/2'	10:07	10:08	10:08	10:10	2m
10/24	4 (H)	13 1/2'	10:07	10:08	10:08	10:10	2m
24	5	5 1/2'	10:08	10:09	10:09	10:11	2m
	6 (H)	13 1/2'	10:08	10:11	10:11	10:16	5m
	7 (H)	12 1/2'	Ves	air	seal	seal	To o
							18

Ember 4'

Jan 19
Korn
S. C.

out
out

REMARKS

Hold for certified holes high grass

TYPE OF SOIL

TESTED BY

C.B.S.

ALSO PRESENT

Fryck

DRILLER: OBTAIN HEALTH DEPT. APPROVAL AND RETURN ALL PARTS OF THIS FORM INTACT TO THE WATER RESOURCES ADMINISTRATION.

EMERGENCY NO. (If any) -

B 1 4638		SEQUENCE NO. (WRA USE ONLY)	STATE OF MARYLAND WATER RESOURCES ADMINISTRATION TAWES STATE OFFICE BLDG., ANNAPOLIS, MARYLAND 21401 APPLICATION FOR PERMIT TO DRILL WELL		WRA PERMIT NUMBER		
1 2 3 (SEQ. NO.) 6 (THIS NUMBER IS TO BE PUNCHED IN COLS. 3-6 ON ALL CARDS)						FILL IN THIS FORM COMPLETELY	

DATE RECEIVED (WRA USE ONLY) 11/29/78 9:30 A.M.		OWNER COL 15 LAST NAME <i>Krebs</i> COL 34 FIRST NAME <i>William</i>	
STREET OR RFD COL 36 <i>3309 Turcotte Lane Apt. 2A</i>		POST OFFICE COL 57 <i>Baltimore Md - 21207</i>	

B 1 CONTINUED		DRILLER INFORMATION	
1 2 3 (SEQ. NO.) 6		DATE <i>Nov 13, 1978</i>	
DATE		LICENSE NUMBER <i>238</i>	
FIRST NAME <i>Joseph L. Mayne</i>		LAST NAME <i>Mayne</i>	
SIGNATURE <i>Joseph L. Mayne</i>			

B 2		WELL INFORMATION	
1 2 3 (SEQ. NO.) 6		MAXIMUM PUMPING RATE (GALLONS PER MINUTE) <i>5</i>	
AVERAGE DAILY QUANTITY NEEDED (GALLONS PER DAY) <i>250</i>			
USE FOR WATER (CIRCLE APPROPRIATE BOX)			
☒ HOME (SINGLE OR DOUBLE HOUSEHOLD UNIT ONLY)			
☐ FARMING, AGRICULTURE, IRRIGATION			
☐ INDUSTRIAL, COMMERCIAL, STATE AND FEDERAL GOVERNMENT			
☐ MUNICIPAL WATER SUPPLY			
☐ PRIVATE WATER COMPANY		MUST HAVE STATE HEALTH DEPT. APPROVAL	
☐ TEST			

APPROXIMATE DEPTH OF WELL <i>200</i>		FEET	
APPROXIMATE DIAMETER OF WELL <i>6</i>		(NEAREST INCH)	

METHOD OF DRILLING USED (CIRCLE APPROPRIATE METHOD)			
☒ BORED (OR AUGERED)		☐ JETTED	
☐ AIR-ROTARY		☐ AIR-PERCUSSION	
☐ CABLE		☐ REVERSE-ROTARY	
☐ DRIVE-POINT			
OTHER (DESCRIBE)			

REPLACEMENT OR DEEPEINED WELLS (CIRCLE APPROPRIATE BOX)			
☐ THIS WELL WILL NOT REPLACE AN EXISTING WELL			
☐ THIS WELL WILL REPLACE A WELL THAT WILL BE ABANDONED AND SEALED			
☐ THIS WELL WILL REPLACE A WELL THAT WILL BE USED AS A STANDBY			
☐ THIS WELL WILL DEEPEIN AN EXISTING WELL			
PERMIT NUMBER OF WELL TO BE REPLACED OR DEEPEINED (IF AVAILABLE)			

NOT TO BE FILLED IN BY DRILLER (WRA USE ONLY)			
APPROPRIATION PERMIT NUMBER		ENGINEER REVIEW DISTRICT NO.	
FORCE		CONDITIONS	
WRITE INITIALS IN BOX			

B 4 CONTINUED		HEALTH DEPARTMENT APPROVAL	
1 2 3 (SEQ. NO.) 6		DATE <i>11/15/78</i>	
STATE HEALTH (CIRCLE BOX)		COUNTY NAME <i>Howard</i>	
MO. DAY YR.		COUNTY NO. <i>W29232</i>	
DATE		APPROVED BY <i>Donald W. Monaghan</i>	
		Sanitarian	


B 3		LOCATION OF WELL	
1 2 3 (SEQ. NO.) 6		COUNTY <i>Howard</i>	
SUBDIVISION <i>George Stock Property</i>		LOT <i>5</i>	
SECTION <i>44</i>		NEAREST TOWN <i>West Friendship</i>	
MILES FROM TOWN (ENTER 0 IF IN TOWN) <i>1</i>			

B 4		DIRECTION FROM TOWN (CIRCLE APPROPRIATE BOX)	
1 2 3 (SEQ. NO.) 6		☒ NORTH	
☐ SOUTH		☐ EAST	
☐ WEST		☐ NORTHWEST	
☐ SOUTHWEST			
NEAR WHAT ROAD <i>MD. 32</i>			
ON WHICH SIDE OF ROAD (CIRCLE APPROPRIATE BOX) <i>E</i>			
DISTANCE FROM ROAD (ENTER DISTANCE AND CIRCLE APPROPRIATE BOX) <i>400</i>			

DRAW A SKETCH BELOW SHOWING LOCATION OF WELL IN RELATION TO NEARBY TOWN ROADS AND STREAMS WITH NORTH IN THE DIRECTION OF THE ARROW, AND GIVE DISTANCE FROM WELL TO NEAREST ROAD JUNCTION OR STREAM CROSSING SHOWN ON SKETCH. ALSO SHOW, BY MEANS OF AN "X", THE WELL LOCATION IN THE BOX BELOW AND THE BOX NUMBER FROM THE WELL LOCATION MAP.

N 11/29/78 89' corr 200' grade 32' open jetted to 45 ft + 21 bags cement 015 alum MD. 70 MD. 32 will drill	
--	--

BOX NUMBER <i>810</i> <i>540</i>		NORTH COORDINATE <i>50</i>	
		EAST COORDINATE <i>57</i>	
		ELEVATION AT WELL HEAD (FEET) <i>55</i>	

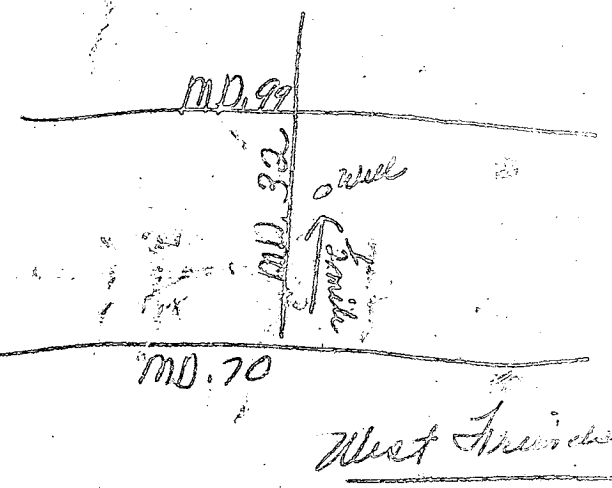B 1 4638 1 2 3 (SEQ. NO.) 6 (THIS NUMBER IS TO BE PUNCHED IN COLS. 3-6 ON ALL CARDS)		STATE OF MARYLAND WATER RESOURCES ADMINISTRATION TAWES STATE OFFICE BLDG., ANNAPOLIS, MARYLAND 21401 APPLICATION FOR PERMIT TO DRILL WELL				WRA PERMIT NUMBER HO-73-3069 FILL IN THIS FORM COMPLETELY	
DATE RECEIVED (WRA USE ONLY)		OWNER <u>Krebs</u> <u>William</u> COL 15 LAST NAME FIRST NAME COL 34 STREET OR RFD <u>3309 Incoth Lane Apt. 2A</u> COL 36 COL 55 POST OFFICE <u>Baltimore Md - 21207</u> COL 57 COL 76					
B 1 CONTINUED 1 2 3 (SEQ. NO.) 6 DATE <u>Nov 13, 1978</u> LICENSE NUMBER <u>238</u> 77 80 <u>Joseph L. Mayne</u> FIRST NAME DRILLER LAST NAME SIGNATURE <u>Joseph L. Mayne</u>		B 3 LOCATION OF WELL 1 2 3 (SEQ. NO.) 6 COUNTY <u>Howard</u> (DO NOT ABBREVIATE COUNTY NAME) 21 SUBDIVISION <u>George Stalk Property</u> 23 42 SECTION <u>A</u> LOT <u>5</u> 44 46 48 50 NEAREST TOWN <u>West Friendship</u> 62 71 MILES FROM TOWN (ENTER 0 IF IN TOWN) <u>1</u> 73 76 77 78				B 4 DIRECTION FROM TOWN (CIRCLE APPROPRIATE BOX) 1 2 3 (SEQ. NO.) 6 ☒ N NORTH ☐ E EAST ☐ NE NORTHEAST ☐ SE SOUTHEAST ☐ S SOUTH ☐ W WEST ☐ NW NORTHWEST ☐ SW SOUTHWEST NEAR WHAT ROAD <u>MD. 32</u> ON WHICH SIDE OF ROAD (CIRCLE APPROPRIATE BOX) ☐ N ☐ S ☒ E ☐ W DISTANCE FROM ROAD (ENTER DISTANCE AND CIRCLE APPROPRIATE BOX) <u>400</u> 34 37 38 39	
B 2 WELL INFORMATION 1 2 3 (SEQ. NO.) 6 MAXIMUM PUMPING RATE (GALLONS PER MINUTE) <u>5</u> 8 12 AVERAGE DAILY QUANTITY NEEDED (GALLONS PER DAY) <u>750</u> 14 20 USE FOR WATER (CIRCLE APPROPRIATE BOX) ☒ D HOME (SINGLE OR DOUBLE HOUSEHOLD UNIT ONLY) ☐ F FARMING, AGRICULTURE, IRRIGATION ☐ I INDUSTRIAL, COMMERCIAL, STATE AND FEDERAL GOVERNMENT. ☐ M MUNICIPAL WATER SUPPLY } MUST HAVE STATE HEALTH DEPT. APPROVAL ☐ P PRIVATE WATER COMPANY ☐ T TEST		DRAW A SKETCH BELOW SHOWING LOCATION OF WELL IN RELATION TO NEARBY TOWNS, ROADS AND STREAMS WITH NORTH IN THE DIRECTION OF THE ARROW, AND GIVE DISTANCE FROM WELL TO NEAREST ROAD JUNCTION OR STREAM CROSSING SHOWN ON THE SKETCH. ALSO SHOW, BY MEANS OF AN "X", THE WELL LOCATION IN THE BOX BELOW AND THE BOX NUMBER FROM THE WELL LOCATION MAP. 				BOX NUMBER E <u>810</u> N <u>540</u> NORTH COORDINATE <u>400000</u> 50 51 52 53 54 55 EAST COORDINATE <u>0210000</u> 57 58 59 60 61 62 63 ELEVATION AT WELL HEAD (FEET) <u>65</u> 66 67 68	
APPROXIMATE DEPTH OF WELL <u>200</u> 24 28 FEET APPROXIMATE DIAMETER OF WELL <u>6</u> (NEAREST INCH) METHOD OF DRILLING USED (CIRCLE APPROPRIATE METHOD) <u>BORED</u> (OR AUGURED) <u>JETTED</u> <u>DRIVEN</u> 30-37 <u>AIR-ROTARY</u> <u>AIR-PERCUSSION</u> <u>ROTARY</u> (HYDRAULIC ROTARY) <u>CABLE</u> <u>REVERSE-ROTARY</u> <u>DRIVE-POINT</u> OTHER (DESCRIBE) _____ REPLACEMENT OR DEEPEINED WELLS (CIRCLE APPROPRIATE BOX) ☒ N THIS WELL WILL NOT REPLACE AN EXISTING WELL ☐ Y THIS WELL WILL REPLACE A WELL THAT WILL BE ABANDONED AND SEALED ☐ S THIS WELL WILL REPLACE A WELL THAT WILL BE USED AS A STANDBY ☐ D THIS WELL WILL DEEPEIN AN EXISTING WELL PERMIT NUMBER OF WELL TO BE REPLACED OR DEEPEINED (IF AVAILABLE) _____ 41 52							
B 4 CONTINUED 1 2 3 (SEQ. NO.) 6 41 <u>S</u> STATE HEALTH (CIRCLE BOX) <u>Howard</u> COUNTY NAME <u>1129232</u> COUNTY NO. MO. DAY YR. <u>11</u> <u>15</u> <u>78</u> DATE <u>11</u> <u>15</u> <u>78</u> 43 48 <u>Donald W. Monaghan, Sanitarian</u> APPROVED BY		NOT TO BE FILLED IN BY DRILLER (WRA USE ONLY) APPROPRIATION PERMIT NUMBER <u>54</u> ENGINEER REVIEW DISTRICT NO. <u>63</u> FORCE <u>67</u> WRITE INITIALS IN BOX CONDITIONS <u>68</u> A E N S G W Q C L U 70 71 72 73 74 75 76 77 78 79				B 5 SPECIAL CONDITIONS 8-63 (WRA USE ONLY) 1 2 3 (SEQ. NO.) 6	


A24986

HEALTH

RT. 32

NO SCALE
APPROX. PROPORTIONS

LOT 5A
2.65 ± ACRES.

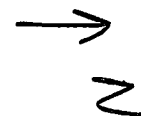

MAP FOR
APPLICATION OF
BUILDING PERMIT

WILLIAM KREBS
802 ROUNDTOP CT.
LUTHERVILLE, MD, 21093

William T. Krebs

