

3/9/93 AFTER
(5:00 P.M.)
3/11/93
Late P.M.

PERMIT

SEWAGE DISPOSAL SYSTEM

DEPARTMENT OF HEALTH AND MENTAL HYGIENE

HOWARD COUNTY HEALTH DEPARTMENT

BUREAU OF ENVIRONMENTAL HEALTH

~~XXXXXX~~ 313-2640

INDEXED

File

3/9/93 P.C.O. *Late*

P 48986

A REPAIR

DISTRICT 4th

DATE 3/9/93

DATE SYSTEM APPROVED 3/11/93

INSPECTOR C.B.C.

Herman Sirk IS PERMITTED TO INSTALL ALTER X

ADDRESS 2555 Jennings Chapel Road, Woodbine, Maryland PHONE 489-4724

SUBDIVISION Timberleigh Ridge LOT 7 ROAD 17529 Timberleigh Way

PROPERTY OWNER Elizabeth Taylor
17529 Timberleigh Way

ADDRESS

SEPTIC TANK CAPACITY GALLONS

NUMBER OF BEDROOMS

SQUARE FEET PER BEDROOM

LINEAR FEET OF TRENCH REQUIRED

REPAIR - PURPOSE - IN SUPPORT OF FUTURE BUILDING PERMIT FOR INGROUND SWIMMING POOL.

DISCONNECT THE DISPOSAL TRENCH NEAREST TO THE HOUSE AND REPLACE WITH AN EQUIVALENT LENGTH OF TRENCH WITHIN THE SEWAGE DISPOSAL EASEMENT

INSTALL - Trench to be 65 feet long. 2 feet wide. Inlet 2 1/2 feet, Bottom 7 1/2 feet with 5 feet of gravel 66'

late 3/9/93 Trench inspected only
C.B.C. for

BLDG. PERMIT SIGNED
AND RETURNED 3/8/93
Seal # 47436-2 pool

PLANS APPROVED BY C. Williams DATE 2/25/93

COVER NO WORK UNTIL INSPECTED AND APPROVED

NEITHER THE HOWARD COUNTY COUNCIL NOR THE HEALTH DEPARTMENT IS RESPONSIBLE FOR THE SUCCESSFUL OPERATION OF ANY SYSTEM

NOTE: CLEANOUT REQUIRED EVERY 70 FEET OF SEWER LINE AND/OR AT 90° SWEEPS IN LINES FROM HOUSE TO DRAIN FIELDS, 90° ELBOWS NOT ACCEPTABLE.

NOTE: ALL PARTS OF SEPTIC SYSTEMS (I.E. TANK, DISTRIBUTION BOX TRENCHES) TO BE 100 FEET FROM WELL (UNLESS OTHERWISE SPECIFICALLY AUTHORIZED)

NOTE: IF DEEP TRENCH(ES) ARE USED CALL FOR INSPECTION BEFORE AND AFTER PLACING GRAVEL IN TRENCH(ES)

NOTE: NO DRY WELL SHALL EXCEED 15 FOOT IN DIAMETER NO ABSORPTION TRENCH TO EXCEED 100 FEET IN LENGTH

NOTE: ALL PIPE FROM HOUSE TO SEPTIC TANK MUST BE CAST IRON OR SCHEDULE 35/40 PVC OR ABS


PERMIT VOID AFTER TWO YEARS

NOTE: INSTALL STAND PIPE ON SEPTIC TANK AND DRY WELL STAND PIPES MUST BE 6 INCHES IN DIAMETER CAST IRON. CONCRETE OR TERRA COTTA OR PVA OR ABS ACCEPTED. IF TOP OF SEPTIC TANK IS DEEPER THAN 3 FEET. MANHOLE TO GRADE REQUIRED.

NOTE: DISTRIBUTION BOXES MUST HAVE BAFFLES

*INSTALLER IS RESPONSIBLE FOR OBTAINING FINAL APPROVAL ON THIS PERMIT

P 48986

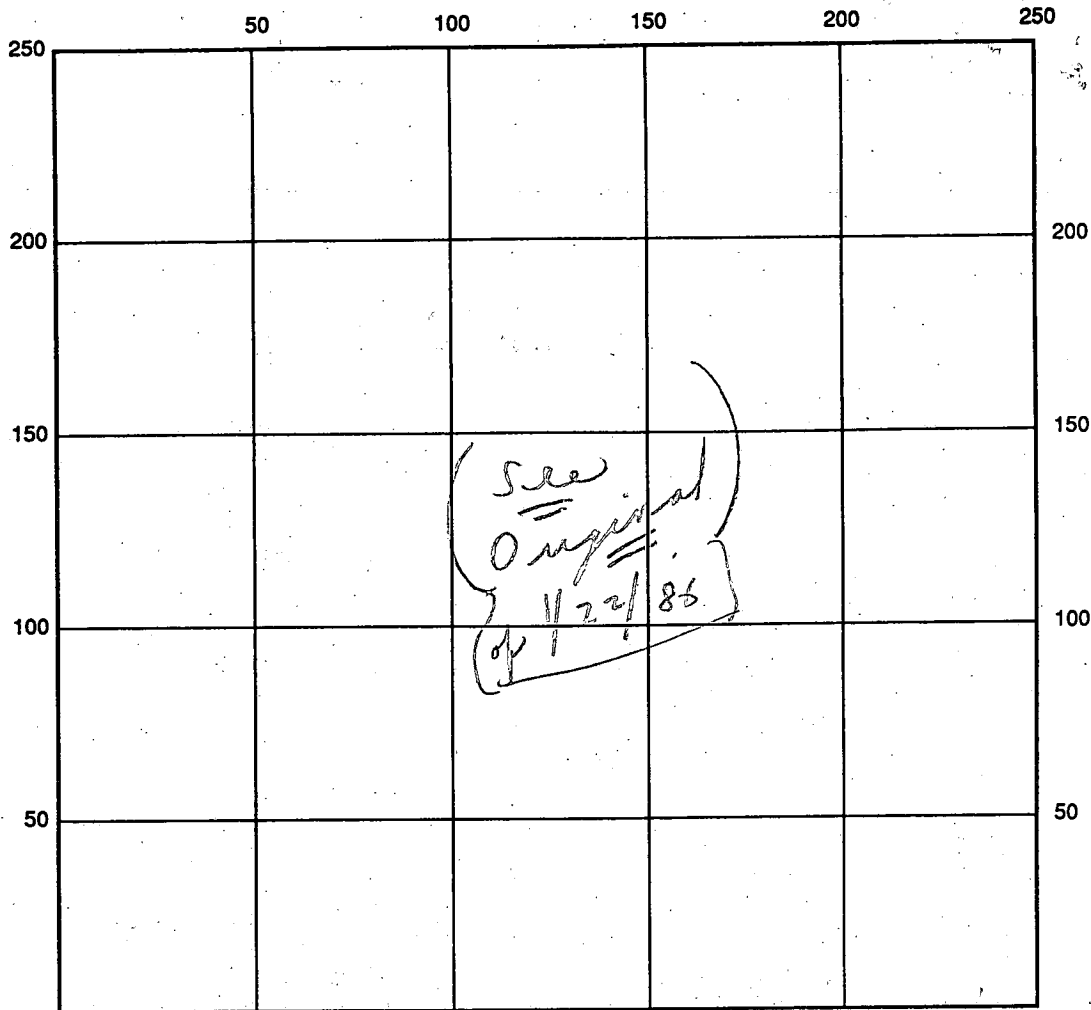

INDICATE NORTH - NAME ADJOINING ROADWAY AS BASE LINE

SEPTIC TANK LEVEL Existing CLEANOUTS Existing
 DISTRIBUTION BOX LEVEL Existing
 DRAIN FIELD/TITLE DEPTH 7 1/2 ^{+ average} FT. TRENCH WIDTH 2 FT. INLET DEPTH 2 1/2 FT.
 EFFECTIVE GRAVEL DEPTH 5 ⁺ FT. TOTAL LENGTH 66 FT.
 NUMBER OF TRENCHES 1 ONE SIDEWALL/BOTTOM AREA 330 ⁺ SQ. FT. (New)
 DRYWALL INSIDE DIAMETER — FT. EFFECTIVE DEPTH BELOW INLET — FT.
 ABSORBENT AREA 330 ⁺ SQ. FT. (Plus old system) = 630 ⁺ = Total

REMARKS: 3/9/93 Late after 5:00 P.M. - Partial to trench - ok for stone
HOLD FOR A CALL: 3/10/93 T/C to Mr. Dink's office - Mr. Dick not in.
3/11/93 Final - ok to cover all work; #2 Trench sealed
off at distribution box; C.B.S.

DATE SYSTEM APPROVED 3/11/93 INSPECTOR Charles Bryan Street

1-22-86
After lunch
11/24/85
OR 24/85
P
A

PERMIT

SEWAGE DISPOSAL SYSTEM

MARYLAND STATE DEPARTMENT OF HEALTH

P 36434

A 34707

HOWARD COUNTY

BUREAU OF ENVIRONMENTAL HEALTH

~~461-9933~~
461-9933

ELLICOTT CITY

DISTRICT 4th

DATE 1/9/86

INDEXED

Herman Sirk

IS PERMITTED TO INSTALL X ALTER

ADDRESS 2555 Jennings Chapel Road, Woodbine, MD 21797 PHONE 489-4724

SUBDIVISION Timberleigh Ridge ROAD 17529 Timberleigh Way LOT Final 7

PROPERTY OWNER Elizabeth Taylor

ADDRESS

IF GARBAGE GRINDER IS USED INCREASE SEPTIC TANK CAPACITY BY 50% AND ABSORPTION AREA BY 22%.

GARBAGE GRINDER? YES NO X

SEPTIC TANK CAPACITY 1000 GALLONS NUMBER OF BEDROOMS 3

TRENCHES - 130 sq. ft. per bedroom. Trench to be 2 feet wide. Inlet 2 feet below original grade. Bottom maximum depth 7 feet below original grade. Effective area begins at 2 feet below original grade. 5 feet of stone below distribution pipe.

LOCATION: Start trench 130 feet from the front lot line and 25 feet from the right lot line as seen when facing lot from Route 94. Run trench on level ground towards left lot line as seen when facing lot from Route 94.

NOTE: No trench to exceed 100 feet in length. If more than one trench used, a distribution box is required. Call for inspection of trench before and after gravel is installed. Provide 6" - 8" diameter cleanout and cap to grade or above on septic tank.

PLANS APPROVED BY Sid Abel DATE 1/8/85

COVER NO WORK UNTIL INSPECTED AND APPROVED.

NEITHER THE HOWARD COUNTY COUNCIL NOR THE HEALTH DEPARTMENT IS RESPONSIBLE FOR THE SUCCESSFUL OPERATION OF ANY SYSTEM.

NOTE: IF TRENCH IS USED CALL FOR INSPECTION BEFORE AND AFTER PLACING GRAVEL IN TRENCH.

NOTE: NO DRY WELL SHALL EXCEED 15 FOOT IN DIAMETER. NO ABSORPTION TRENCH TO EXCEED 100 FEET IN LENGTH.

NOTE: ALL PIPE FROM HOUSE TO SEPTIC TANK MUST BE CAST IRON OR SCHEDULE 40 PVC OR ABS.

PERMIT VOID AFTER THREE YEARS.


NOTE: INSTALL STAND PIPE ON SEPTIC TANK AND DRY WELL. STAND PIPES MUST BE 6 INCHES IN DIAMETER. CAST IRON, CONCRETE OR TERRA COTTA, OR PVC OR ABS ACCEPTED. IF TOP OF SEPTIC TANK IS DEEPER THAN 3 FEET MANHOLE TO GRADE REQUIRED.

*INSTALLER IS RESPONSIBLE FOR OBTAINING FINAL APROVAL ON THIS PERMIT

*CALL ~~992-2330~~ FOR INSPECTION OF SEPTIC SYSTEMS.

EH - 2-1082

A 34707

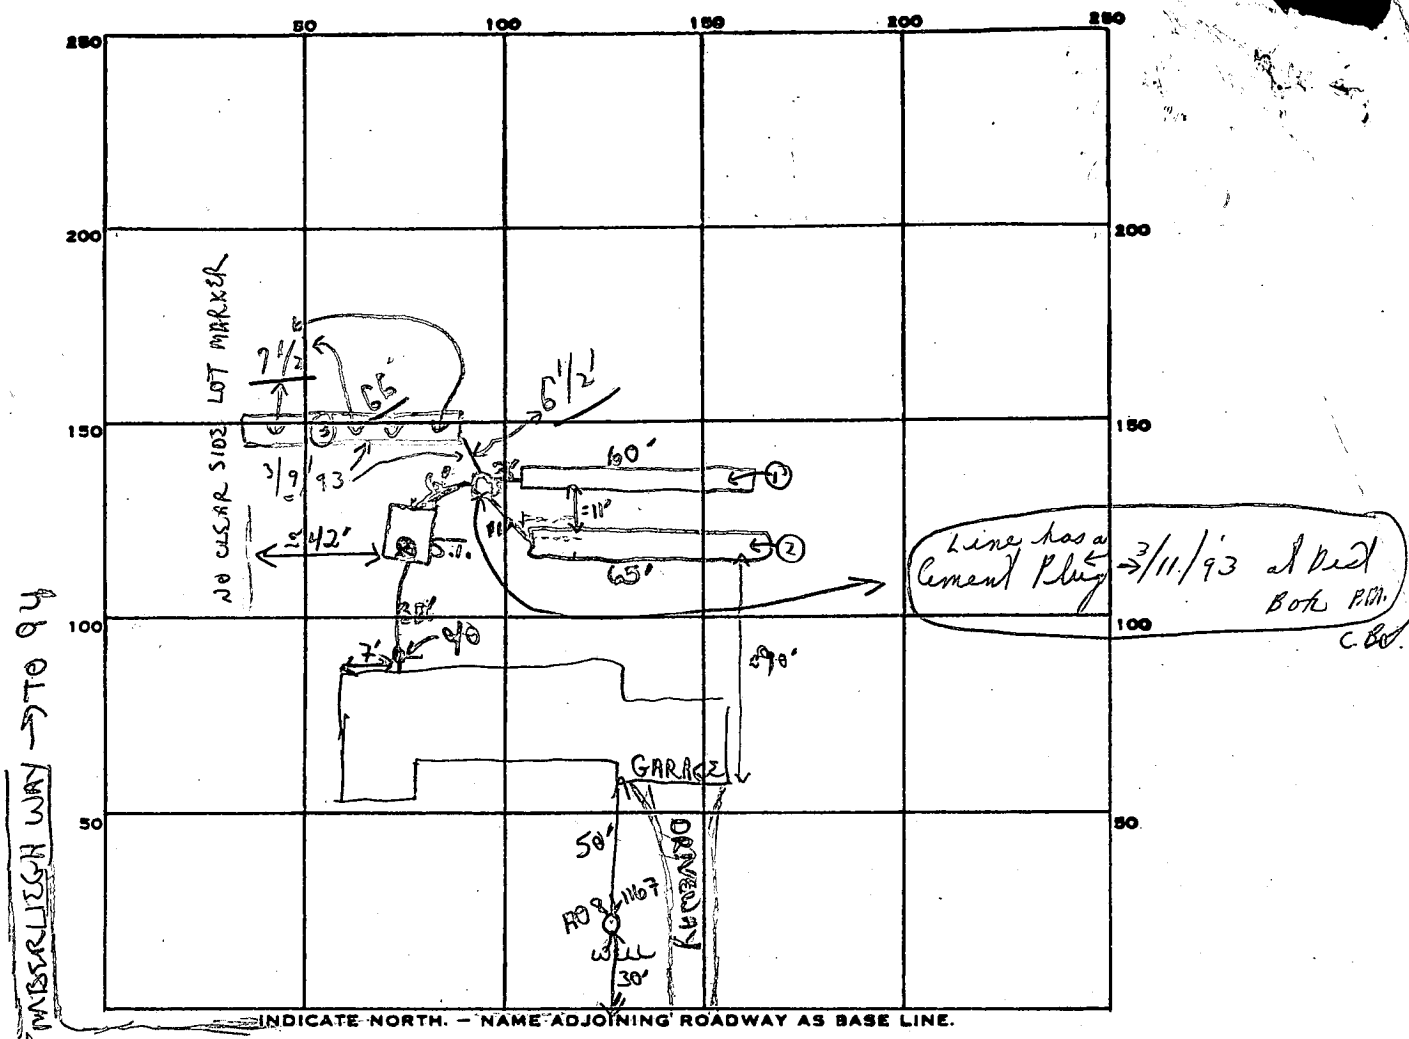

PERMIT CARD

SEPTIC TANK, LEVEL 1000 gal ✓ CLEANOUTS 1 Downline out of house; 1 Str.

DISTRIBUTION BOX, LEVEL ✓

TILE FIELD, DEPTH 7; 7; 7 1/2 FT. TRENCH WIDTH 2 FT.

GRAVEL DEPTH 5; 5 FT. IN. TOTAL LENGTH 60' 65' 66' = 330 FT.

NUMBER OF TRENCHES 1+1=2 TOTAL BOTTOM AREA 300 + 325 = 625 SQ. FT.

SEEPAGE PITS, INSIDE DIAMETER — FT. DEPTH BELOW INLET — FT.

ABSORBENT AREA 625 SQ. FT. + (3/9/93) = 955 (Minus = #2 Trench) = 630 Total 3/11/93

REMARKS 1/21/86 OK to add stone pipe paper to trench #1. OK to start trench #2, (also to be 65' long).

1/22/86 OK to cover trench #1, OK to add stone, pipe paper to #2

OK to cover all work

3/9/93 ok to stone #3 trench; no pipes yet 3/11 Final

3/9/93 + 3/11/93 C.B. Shuck C.B. C.B.

DATE SYSTEM APPROVED 1/22/86 INSPECTOR B. Nipon

PRELIMINARY

APPLICATION

A34707

4/30/84

9:30 A.M.

Cancelled Permit

5/3/84

9:30 A.M.

SEWAGE DISPOSAL TESTING

A 33827

STATE OF MARYLAND - DEPARTMENT OF HEALTH AND MENTAL HYGIENE

P

HOWARD COUNTY HEALTH DEPARTMENT
ENVIRONMENTAL HEALTH SERVICES

P. O. BOX 476 ELLICOTT CITY, MARYLAND 21043
TELEPHONE: 992-2330

DISTRICT 4th

DATE 4/25/84

TH656 AND CORRECT PERC TEST
RECORDS FOR LOT 7
C.W.

TO: THE COUNTY HEALTH OFFICER
ELLICOTT CITY, MARYLAND

I HEREBY APPLY FOR THE NECESSARY TEST IN ORDER TO CONSTRUCT (OR RECONSTRUCT) A SEWAGE DISPOSAL SYSTEM.

PROPERTY OWNER William B. & Phyllis B. Martin

ADDRESS Timberleigh Farm, 3268 Route 94, Woodbine, Md.

21797
PHONE

489-4983

PROPERTY LOCATION:

SUBDIVISION

LOT NO.

27

ROAD AND DESCRIPTION adjacent to 3268 Route 94

SIZE OF LOT (?)

TYPE BLDG. 3 or 4 bedrooms

(NUMBER OF BEDROOMS)

THE SYSTEM INSTALLED UNDER THIS APPLICATION IS ACCEPTABLE ONLY UNTIL PUBLIC FACILITIES BECOME AVAILABLE. I FULLY UNDERSTAND THE FEE CONNECTED WITH THE FILING OF THIS PERC TEST APPLICATION IS NON-REFUNDABLE UNDER ANY CIRCUMSTANCES. I ALSO AGREE TO COMPLY WITH ALL M.O.S.H.A. REQUIREMENTS IN TESTING THIS LOT.

William B. Martin

(SIGNATURE OF APPLICANT)

APPROVED BY FOR DATE

REJECTED BY FOR DATE

HOLD PENDING FURTHER TESTS DATE

REASONS FOR REJECTION OR HOLDING

5/3/84 - DIG MORE (500 FEET & ROCK)

5/4/84 PERC OK BUT LOT LINES

MUST BE CHANGED TO INCLUDE PERC AREA

THIS IS NOT A PERMIT

Lot 1

see plan

HOLE BLOW

200

③ = HIGHER


①② HIGH

⑥ = LOWER

④⑤⑦ MEDIUM

SOIL PROFILE
0
CLAY
2
SANDY
8 SMALL
SHALE
8 WEATHERED
ROCK

Future Road B

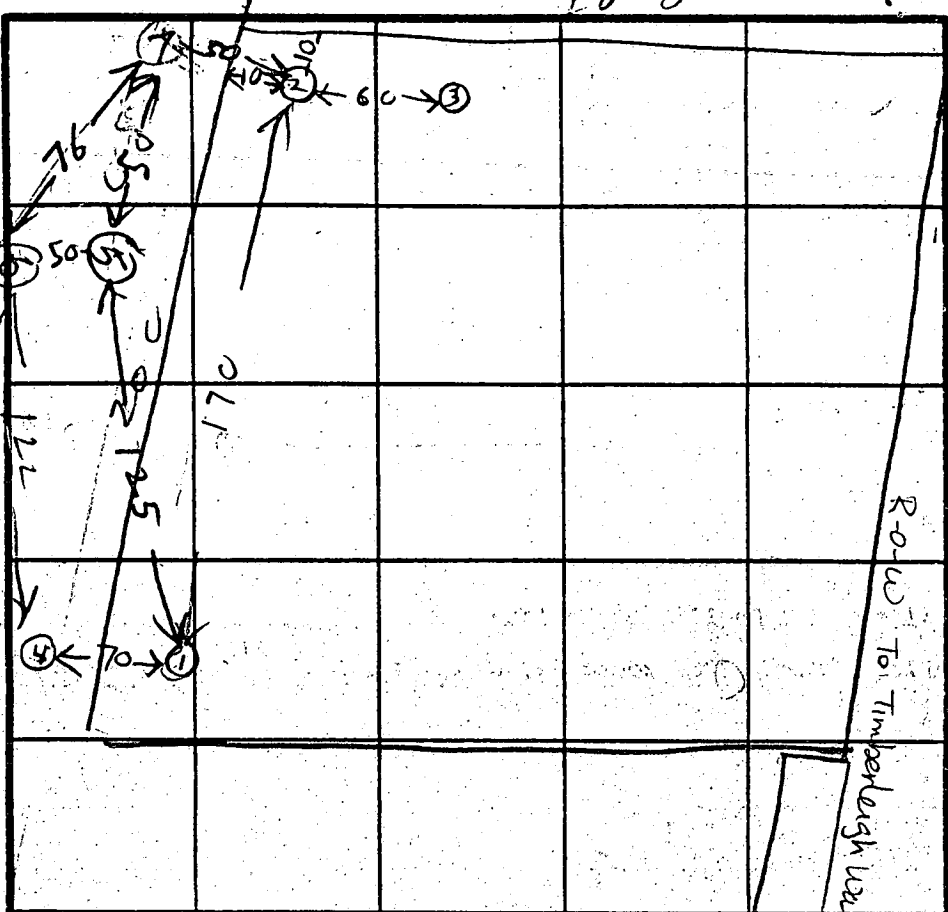

④
CLAY
2
TAN
SAND
8 SMALL
SHALE

⑤
CLAY
2
TAN
SAND
8
SMALL
SHALE

②
CLAY
3
SAND
SMALL
SHALE
6
MEDIUM
SHALE
8
SOFT
SLAND

③
CLAY
3
BIG
SHALE
8
SAND
7
ROCK

⑥
CLAY
2
TAN
SAND
8 SMALL
SHALE

⑦
TAN CLAY
2
TAN
SAND
8
SMALL
SHALE

DATE	TEST NO.	DEPTH	PRE-WET		TEST - 1" DROP		TIME
			START	STOP	START	STOP	
5/3/84	1D	8	1202	1204	1204	1209	5
	1S	4	1210	1219	1219	1228	9
	1V	12	LOOKS OK				
	2D	8	1220	1226	1226	1232	46 sec
	2D (reborn)	8'	1226	1236	1236	1242	65 sec
	2V	11 1/2	UNSATISFACTORY TOO FAST				
5/3/84	31/	7	UNSATISFACTORY ROCK BOTTOM				
5/4/84	4D	7 1/2	224	235	235	245	10
	4S	4	227	241	241	257	16
	5D	8 1/2	236	247	247	302	17
	5S	4	236	243	243	255	13
	6D	8	300	319	319	330	21
	6S	4	309	313	313	319	6
	6V	1 1/2	LOOKS OK				
	7V	10	LOOKS OK ✓				

REMARKS
Put DW at ① & Run Ditch Toward ⑤

TYPE OF SOIL

TESTED BY B. HODGES See Page 2

ALSO PRESENT H. S. IRKOSON 10

EH-12-1079

WYE RIVER ENTERPRISES
10/58/68

EX 20' EASEMENT FOR INGRESS & EGRESS
LOTS 1-D & WILLIAM B MARTIN PROPERTY
ACCESS EASEMENT TO LOT NOS 1-D WILL
TERMINATE WHEN OTHER MEANS OF
PUBLIC ACCESS BECOMES AVAILABLE

1"=30'




PROPOSED SEW
DISPOSAL AREA

Elevation of




TRENCH DETAIL
TO BE ADJUSTED AT
TIME OF SEPTIC PUMP

10/2/8
CW

B.P.#
67277

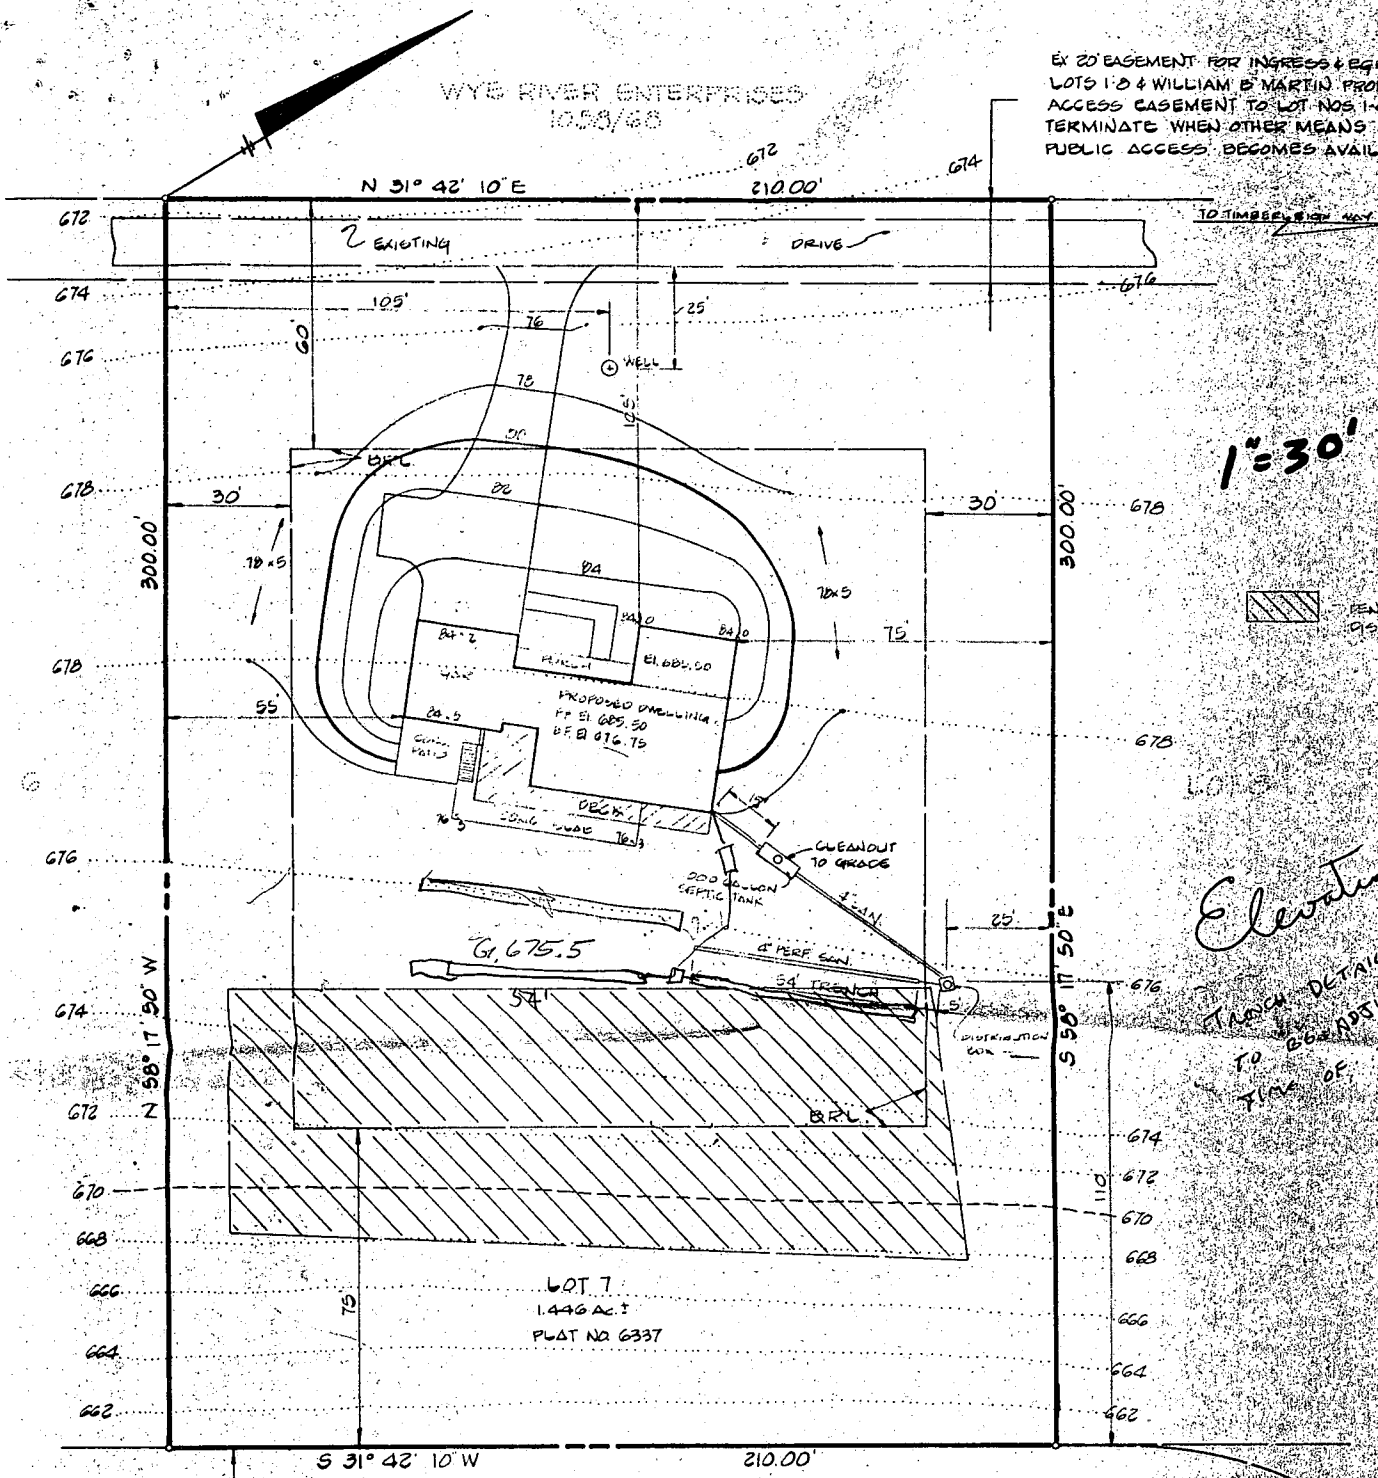


WILLIAM B MARTIN
5/9/69

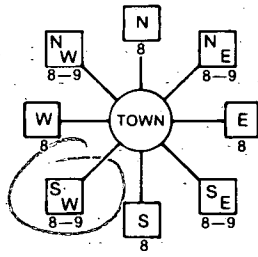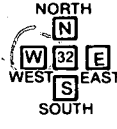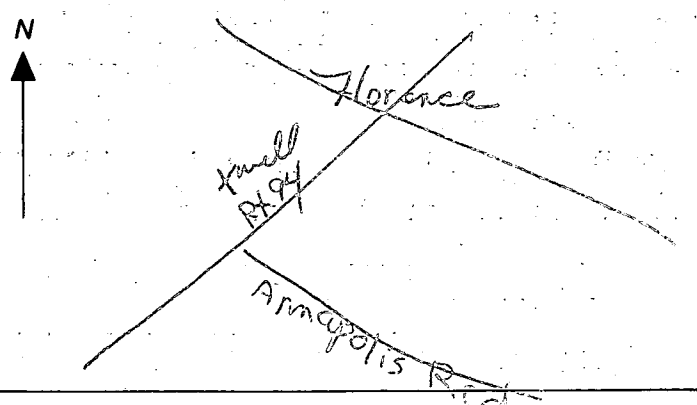B 1 7175	SEQUENCE NO. (OEP USE ONLY)	STATE OF MARYLAND PERMIT TO DRILL WELL please print or type	OEP PERMIT NUMBER 40-81-1167 <small>70 fill in this form completely 79</small>
1 2 3 4 5 6 (THIS NUMBER IS TO BE PUNCHED IN COLS. 3-6 ON ALL CARDS)		B 3 3	
Date Received 9/25/85 - 3 PM OWNER INFORMATION Wm. Martin <div style="border: 1px solid black; padding: 2px;"> <div style="display: flex; justify-content: space-between;"> <div> 15 Last Name TAYLOR </div> <div> Owner Garry </div> <div> First Name Garry </div> </div> <div style="display: flex; justify-content: space-between; margin-top: 5px;"> <div> 36 3268 </div> <div> Street or RFD Rt 94 </div> <div> 55 Woodbine </div> </div> <div style="display: flex; justify-content: space-between; margin-top: 5px;"> <div> Town Md </div> <div> 70 State 1797 </div> <div> Zip 76 </div> </div> </div>		LOCATION OF WELL <div style="border: 1px solid black; padding: 2px;"> <div style="display: flex; justify-content: space-between;"> <div> 8 COUNTY Howard </div> <div> 21 Timberleigh </div> </div> <div style="display: flex; justify-content: space-between; margin-top: 5px;"> <div> 23 SUBDIVISION Florence </div> <div> 42 Florence </div> </div> </div> <div style="display: flex; justify-content: space-around; margin-top: 5px;"> <div> SECTION 44 46 </div> <div> LOT 7 50 </div> </div> <div style="display: flex; justify-content: space-between; margin-top: 5px;"> <div> 52 NEAREST TOWN Florence </div> <div> 71 Florence </div> </div>	
DRILLER INFORMATION <div style="border: 1px solid black; padding: 2px;"> <div style="display: flex; justify-content: space-between;"> <div> Driller's Name George Easterday </div> <div> 77 License No. 80 410 </div> </div> <div style="display: flex; justify-content: space-between; margin-top: 5px;"> <div> Firm Name J. Franklin Easterday Inc </div> <div> Address 9265 Brown Church Rd Mt. Airy Md </div> </div> <div style="display: flex; justify-content: space-between; margin-top: 5px;"> <div> Signature George Easterday </div> <div> Date 9-3-85 </div> </div> </div>		MILES FROM TOWN (enter 0 if in town) 1 MI B 4 4	
WELL INFORMATION <div style="border: 1px solid black; padding: 2px;"> <div style="display: flex; justify-content: space-between;"> <div> 1 2 APPROX. PUMPING RATE (GAL. PER MIN.) 5 8 12 </div> <div> 14 AVERAGE DAILY QUANTITY NEEDED (GAL. PER DAY) 520 14 20 </div> </div> </div>		DIRECTION OF WELL FROM TOWN (CIRCLE BOX) 	
USE FOR WATER (CIRCLE APPROPRIATE BOX) <div style="display: flex; flex-wrap: wrap;"> <div style="width: 50%;"> <input checked="" type="checkbox"/> D HOME (SINGLE OR DOUBLE HOUSEHOLD UNIT ONLY) </div> <div style="width: 50%;"> <input type="checkbox"/> F FARMING (LIVESTOCK WATERING & AGRICULTURAL IRRIGATION) </div> <div style="width: 50%;"> <input type="checkbox"/> I INDUSTRIAL, COMMERCIAL, STATE AND FEDERAL GOV. OTHER (REQUIRES APPROPRIATION PERMIT) </div> <div style="width: 50%;"> <input type="checkbox"/> P PUBLIC OR PRIVATE WATER COMPANY (REQUIRES APPROPRIATION PERMIT AND STATE HEALTH DEPARTMENT APPROVAL) </div> <div style="width: 50%;"> <input type="checkbox"/> T TEST, OBSERVATION, MONITORING (MAY REQUIRE APPROPRIATION PERMIT) </div> </div>		ON WHICH SIDE OF ROAD (CIRCLE APPROPRIATE BOX) 	
APPROXIMATE DEPTH OF WELL 150 24 28 FEET APPROXIMATE DIAMETER OF WELL 6 INCH		NOT TO BE FILLED IN BY DRILLER HEALTH DEPARTMENT APPROVAL <div style="border: 1px solid black; padding: 2px;"> <div style="display: flex; justify-content: space-between;"> <div> COUNTY NAME Howard </div> <div> COUNTY NO. A 34707 </div> </div> <div style="display: flex; justify-content: space-between; margin-top: 5px;"> <div> OEP SIGNATURE Howard </div> <div> STATE HEALTH INSERT S A 34707 </div> </div> <div style="display: flex; justify-content: space-between; margin-top: 5px;"> <div> DATE ISSUED 09/09/85 </div> <div> CO SIGNATURE Cian Wilkins </div> </div> <div style="display: flex; justify-content: space-between; margin-top: 5px;"> <div> NORTH GRID 552000 </div> <div> EAST GRID 0763000 </div> </div> </div>	
METHOD OF DRILLING (circle one) <div style="display: flex; justify-content: space-around;"> <div> <input checked="" type="checkbox"/> BORED (or Augered) <input type="checkbox"/> AIR-ROTARY <input type="checkbox"/> CABLE </div> <div> <input type="checkbox"/> JETTED <input type="checkbox"/> AIR-PERCUSION <input type="checkbox"/> REVERSE-ROTARY </div> <div> <input type="checkbox"/> Jetted & DRIVEN <input type="checkbox"/> ROTARY (Hydraulic Rotary) <input type="checkbox"/> DRIVE-POINT </div> </div>		SHOW MAJOR FEATURES OF BOX & LOCATE WELL WITH AN X SOURCES OF DRILLING WATER 1. Location OK 2. 21' casing 3. 18' open 5-bag cement WRITE THE BOX NUMBER FROM THE MAP HERE Paper & Tag given to Easterday crew <div style="display: flex; justify-content: space-around; margin-top: 5px;"> <div> E 760 3 N 550 2 </div> <div> 000 000 9/25/85 JS </div> </div>	
REPLACEMENT OR DEEPEMED WELLS (CIRCLE APPROPRIATE BOX) <div style="display: flex; flex-wrap: wrap;"> <div style="width: 50%;"> <input checked="" type="checkbox"/> N THIS WELL WILL NOT REPLACE AN EXISTING WELL </div> <div style="width: 50%;"> <input type="checkbox"/> Y THIS WELL WILL REPLACE A WELL THAT WILL BE ABANDONED AND SEALED </div> <div style="width: 50%;"> <input type="checkbox"/> S THIS WELL WILL REPLACE A WELL THAT WILL BE USED AS A STANDBY </div> <div style="width: 50%;"> <input type="checkbox"/> D THIS WELL WILL DEEPEMED AN EXISTING WELL </div> </div> PERMIT NUMBER OF WELL TO BE REPLACED OR DEEPEMED (IF AVAILABLE) 41 70 71 72 73 74 75 76 77 78 79		DRAW A SKETCH BELOW SHOWING LOCATION OF WELL IN RELATION TO NEARBY TOWNS AND ROADS AND GIVE DISTANCE FROM WELL TO NEAREST ROAD JUNCTION 	
Not to be filled in by driller (OEP USE ONLY)			
APPROP. PERMIT NUMBER 54 GAP 63 FORCE CW WRITE INITIALS IN BOX PERMIT NO. 40-81-1167 67 68 IN BOX 70 71 72 73 74 75 76 77 78 79			
SPECIAL CONDITIONS			

C1 06491		SEQUENCE NO. (OEP USE ONLY)		STATE OF MARYLAND WELL COMPLETION REPORT FILL IN THIS FORM COMPLETELY PLEASE PRINT OR TYPE				THIS REPORT MUST BE SUBMITTED WITHIN 45 DAYS AFTER WELL IS COMPLETED.			
1 2 3 (THIS NUMBER IS TO BE PUNCHED IN COLS. 3-6 ON ALL CARDS)								COUNTY NUMBER			
DATE Received		DATE WELL COMPLETED		Depth of Well				PERMIT NO.			
8 13		15 20		22 26				FROM "PERMIT TO DRILL WELL"			
		092585		(TO NEAREST FOOT)				40-81-1167			
OWNER		JAYNOE		BARRY							
STREET OR RFD		17521		JUNTER LUGH WAY				TOWN			
SUBDIVISION		JUNTER LUGH		SECTION				LOT 7			
WELL LOG		Not required for driven wells		GROUTING RECORD				C 3			
STATE THE KIND OF FORMATIONS PENETRATED, THEIR COLOR, DEPTH, THICKNESS AND IF WATER BEARING				WELL HAS BEEN GROUTED (Circle Appropriate Box)				yes no			
DESCRIPTION (Use additional sheets if needed)		FEET		TYPE OF GROUTING MATERIAL				Y N			
		FROM TO		CEMENT CEMENTITE CLAY				44 44			
topsoil		0 1		NO. OF BAGS 5 NO. OF POUNDS 500							
Red shale		1 6		GALLONS OF WATER 30							
brown slate		6 11		DEPTH OF GROUT SEAL (to nearest foot)							
green slate		11 25		from 0 ft. to 18 ft.							
blue slate		25 40		(enter 0 if from surface)							
brown slate		40 45		CASING RECORD							
blue slate		45 60		casing types insert appropriate code below				ST CO			
brown slate		60 70		MAIN CASING Nominal diameter Total depth				STEEL CONCRETE			
blue slate		70 85		TYPE top (main) casing of main casing				PL OT			
brown slate		85 90		TYPE (nearest inch) (nearest foot)				PLASTIC OTHER			
blue slate		90 180		OTHER CASING (if used)							
blue slate w/ Flint		180 200		diameter depth (feet)							
blue slate		200 300		inch from to							
				SCREEN RECORD							
				screen type or open hole				ST BR HO			
				insert appropriate code below				STEEL BRASS OPEN HOLE			
								PL OT			
								PLASTIC OTHER			
				C 2							
				DEPTH (nearest ft.)							
				1 2 3 100							
				SLOT SIZE 1 2 3							
				DIAMETER OF SCREEN (NEAREST INCH)							
				GRAVEL PACK							
				IF WELL DRILLED WAS FLOWING WELL INSERT F IN BOX 68							
				OEP USE ONLY (NOT TO BE FILLED IN BY DRILLER)							
				T (E.R.O.S.) WQ							
				70 72 74 75 76							
				TELESCOPE CASING LOG INDICATOR OTHER DATA							
				PUMPING TEST							
				HOURS PUMPED (nearest hour)							
				PUMPING RATE (gal. per min. to nearest gal.)							
				METHOD USED TO MEASURE PUMPING RATE				Bucket			
				WATER LEVEL (distance from land surface)							
				BEFORE PUMPING							
				WHEN PUMPING							
				TYPE OF PUMP USED (for test)							
				A air P piston T turbine							
				C centrifugal R rotary O other (describe below)							
				J jet S submersible							
				PUMP INSTALLED							
				DRILLER WILL INSTALL PUMP YES NO							
				IF DRILLER INSTALLS PUMP, THIS SECTION MUST BE COMPLETED FOR ALL WELLS EXCEPT HOME USE							
				TYPE OF PUMP INSTALLED PLACE (A,C,J,P,R,S,T,O) IN BOX - SEE ABOVE:							
				CAPACITY: GALLONS PER MINUTE (to nearest gallon)							
				PUMP HORSE POWER							
				PUMP COLUMN LENGTH (nearest ft.)							
				CASING HEIGHT (circle appropriate box and enter casing height)							
				above below LAND SURFACE (nearest foot)							
				LOCATION OF WELL ON LOT							
				SHOW PERMANENT STRUCTURE SUCH AS BUILDING, SEPTIC TANKS, AND/OR LANDMARKS AND INDICATE NOT LESS THAN TWO DISTANCES (MEASUREMENTS TO WELL)							
				CIRCLE APPROPRIATE LETTER							
				A A WELL WAS ABANDONED AND SEALED WHEN THIS WELL WAS COMPLETED							
				E ELECTRIC LOG OBTAINED							
				P TEST WELL CONVERTED TO PRODUCTION WELL							
				I HEREBY CERTIFY THAT THIS WELL HAS BEEN CONSTRUCTED IN ACCORDANCE WITH COMAR 10.17.13 "WELL CONSTRUCTION" AND IN CONFORMANCE WITH ALL CONDITIONS STATED IN THE ABOVE CAPTIONED PERMIT, AND THAT THE INFORMATION PRESENTED HEREIN IS ACCURATE AND COMPLETE TO THE BEST OF MY KNOWLEDGE.							
				DRILLERS IDENT. NO. 40							
				DRILLERS SIGNATURE (MUST MATCH SIGNATURE ON APPLICATION)							
				SITE SUPERVISOR (sign. of driller or journeyman responsible for sitework if different from permittee)							

SET BACKS	
REAR PL	10'
SIDE PL	10'
HOUSE	10'
SEPTIC	20'
WELL	10'

PRIVATE WELL & SEPTIC

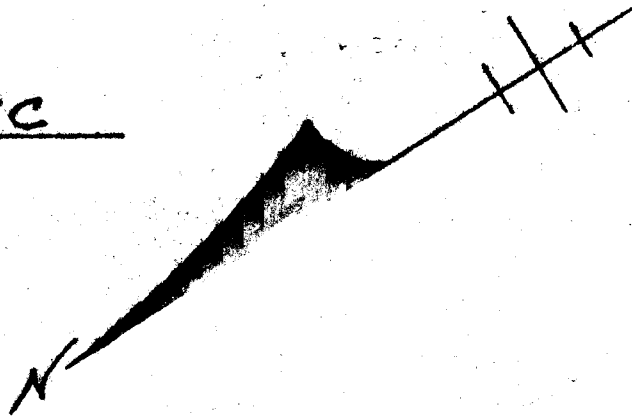

1/30
Scale

PROPOSAL TO
ABANDON TRENCH (4 REPLACES)
TO ACCOMMODATE
THIS POOL LOCATION
COULD BE ACCEPTED.
1/13/93 CWL
HOW CO. HEALTH

SEPTIC REPAIR PERMIT
ISSUED 5/4/93
BP ACCOMMOD FOR THIS DATE
APPROVAL
BP 47426
CWL

