

2/27/96
ASAP

PERMIT

SEWAGE DISPOSAL SYSTEM

DEPARTMENT OF HEALTH AND MENTAL HYGIENE

P 56446

A 49018

DISTRICT 3rd

DATE 2/13/96

HOWARD COUNTY HEALTH DEPARTMENT

BUREAU OF ENVIRONMENTAL HEALTH

~~461-9933~~ 313-2640

INDEXED

DATE SYSTEM APPROVED 2/27/96

INSPECTOR Am

WTC III Plumbing & Heating, Inc.

IS PERMITTED TO INSTALL X ALTER

ADDRESS 1820 Gillis Falls Road Woodbine, MD 21797 PHONE 489-4457

SUBDIVISION West Friendship Estates LOT 9 ROAD 3151 River Valley Chase

PROPERTY OWNER Forrest & Elizabeth Medley

ADDRESS

SEPTIC TANK CAPACITY 1250 GALLONS

NUMBER OF BEDROOMS 4

210 SQUARE FEET PER BEDROOM

LINEAR FEET OF TRENCH REQUIRED 280

210
4
840
280
3
840
24

TRENCHES - Trench to be 3 feet wide. Inlet 4 feet below original grade. Bottom maximum depth 6 feet below original grade. Effective area begins at 6 feet below original grade. 2 feet of stone below distribution pipe.

LOCATION - Place the distribution box 180' down the left (303) lot line, and 85' off that same lot line as seen from River Valley Chase. Run trenches along contour in both directions.

NOTES - No trench to exceed 100 feet in length. Provide 6" - 8" diameter cleanout and cap to grade or above on septic tank.

OK 12/11/95 KB

PLANS APPROVED BY Glen Savage

DATE 11/30/95

COVER NO WORK UNTIL INSPECTED AND APPROVED

NEITHER THE HOWARD COUNTY COUNCIL NOR THE HEALTH DEPARTMENT IS RESPONSIBLE FOR THE SUCCESSFUL OPERATION OF ANY SYSTEM

NOTE: CLEANOUT REQUIRED EVERY 70 FEET OF SEWER LINE AND/OR AT 90° SWEEPS IN LINES FROM HOUSE TO DRAIN FIELDS, 90° ELBOWS NOT ACCEPTABLE.

NOTE: ALL PARTS OF SEPTIC SYSTEMS (I.E. TANK, DISTRIBUTION BOX TRENCHES) TO BE 100 FEET FROM WELL (UNLESS OTHERWISE SPECIFICALLY AUTHORIZED)

NOTE: IF DEEP TRENCH(ES) ARE USED CALL FOR INSPECTION BEFORE AND AFTER PLACING GRAVEL IN TRENCH(ES)

NOTE: NO DRY WELL SHALL EXCEED 15 FOOT IN DIAMETER NO ABSORPTION TRENCH TO EXCEED 100 FEET IN LENGTH

NOTE: ALL PIPE FROM HOUSE TO SEPTIC TANK MUST BE CAST IRON OR SCHEDULE 35/40 PVC OR ABS

PERMIT VOID AFTER TWO YEARS

NOTE: INSTALL STAND PIPE ON SEPTIC TANK AND DRY WELL STAND PIPES MUST BE 6 INCHES IN DIAMETER CAST IRON, CONCRETE OR TERRA COTTA OR PVA OR ABS ACCEPTED. IF TOP OF SEPTIC TANK IS DEEPER THAN 3 FEET. MANHOLE TO GRADE REQUIRED.

NOTE: DISTRIBUTION BOXES MUST HAVE BAFFLES

LOG. PERMIT SIGNED


AND RETURNED 5-28-98

Serial # 20112035

Interior Alteration
Basement

*INSTALLER IS RESPONSIBLE FOR OBTAINING FINAL APPROVAL ON THIS PERMIT

A
49018

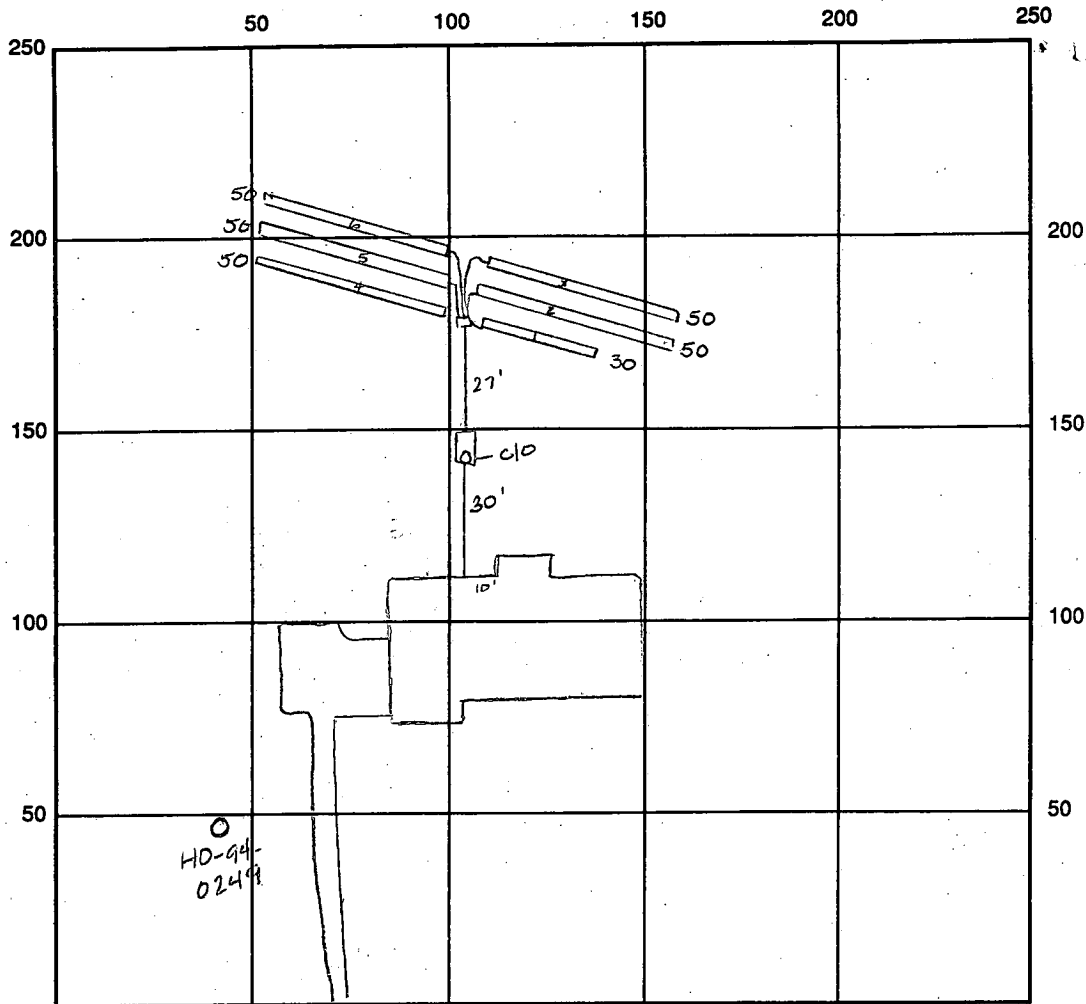

INDICATE NORTH - NAME ADJOINING ROADWAY AS BASE LINE

SEPTIC TANK LEVEL 1250 gal

CLEANOUTS clb OK

DISTRIBUTION BOX LEVEL OR baffle is in

DRAIN FIELD/TITLE DEPTH 6.0 FT.

TRENCH WIDTH 3.0 FT.

INLET DEPTH 4.0 FT.

EFFECTIVE GRAVEL DEPTH 2.0 FT.

TOTAL LENGTH ① 30 ④ 50 ② 50 ③ 50 ⑤ FT. 50 ⑥ 50 = 280 total linear ft

NUMBER OF TRENCHES 6

ONE SIDEWALL/BOTTOM AREA 840 SQ. FT.

$\frac{280}{3} = 840$

DRYWALL INSIDE DIAMETER — FT.

EFFECTIVE DEPTH BELOW INLET — FT.

ABSORBENT AREA — SQ. FT.

REMARKS: 2/27/95 OK to cover all work final. dln

DATE SYSTEM APPROVED 1/27/96

INSPECTOR Larry McMiller

APPLICATION

PERCOLATION TESTING

HOWARD COUNTY HEALTH DEPARTMENT
BUREAU OF ENVIRONMENTAL HEALTH
3525-H ELLICOTT MILLS DRIVE/ELLICOTT CITY, MARYLAND 21043
TELEPHONE: 313-2640

FEE A 49018
P _____
DISTRICT _____
DATE 3/5/93

TO: THE COUNTY HEALTH OFFICER
ELLICOTT CITY, MARYLAND

I HEREBY APPLY FOR THE NECESSARY TEST PRIOR TO APPLICATION FOR PERMIT TO CONSTRUCT (OR RECONSTRUCT) A SEWAGE DISPOSAL SYSTEM.

PROPERTY OWNER _____

ADDRESS _____ PHONE _____

AGENT OR PROSPECTIVE BUYER _____

ADDRESS _____ PHONE _____

PROPERTY LOCATION:

SUBDIVISION W FNS4P I LOT NO. 10

ROAD AND DESCRIPTION NORD FARM

TAX MAP _____ PARCEL # _____

SIZE OF LOT _____ TYPE BLDG. _____
(SINGLE FAMILY DWELLING OR COMMERCIAL)

BLDG. PERMIT SIGNED
AND RETURNED 11-30-95
Serial # 62788
SFD-32254Bms

THE SYSTEM INSTALLED UNDER THIS APPLICATION IS ACCEPTABLE ONLY UNTIL PUBLIC FACILITIES BECOME AVAILABLE. I FULLY UNDERSTAND THE
FEE CONNECTED WITH THE FILING OF THIS PERC TEST APPLICATION IS NON-REFUNDABLE UNDER ANY CIRCUMSTANCES. I ALSO AGREE TO
COMPLY WITH ALL M.O.S.H.A. REQUIREMENTS IN TESTING THIS LOT.

(SIGNATURE OF APPLICANT) _____

APPROVED BY _____ FOR _____ DATE _____

DISAPPROVED BY _____ FOR _____ DATE _____

HOLD PENDING FURTHER TESTS _____

REASONS FOR REJECTION OR HOLDING _____

PERCOLATION TEST PLAT/PRELIMINARY PLAT - TITLE OR I.D. # _____ DATE _____

SITE DEVELOPMENT PLAN/FINAL PLAT - TITLE OR I.D. # _____ DATE _____

THIS IS NOT A PERMIT

49018

LOT #10

COUNTY #

SOIL PROFILE

Hole #①

0'



to 5' clay
5' to
↓
LOAM
11' DRY

HOLE #②

0'-5'
clay
5'
↓
LOAM
↓
DRY
11 1/2'

SOIL PROFILE

0'

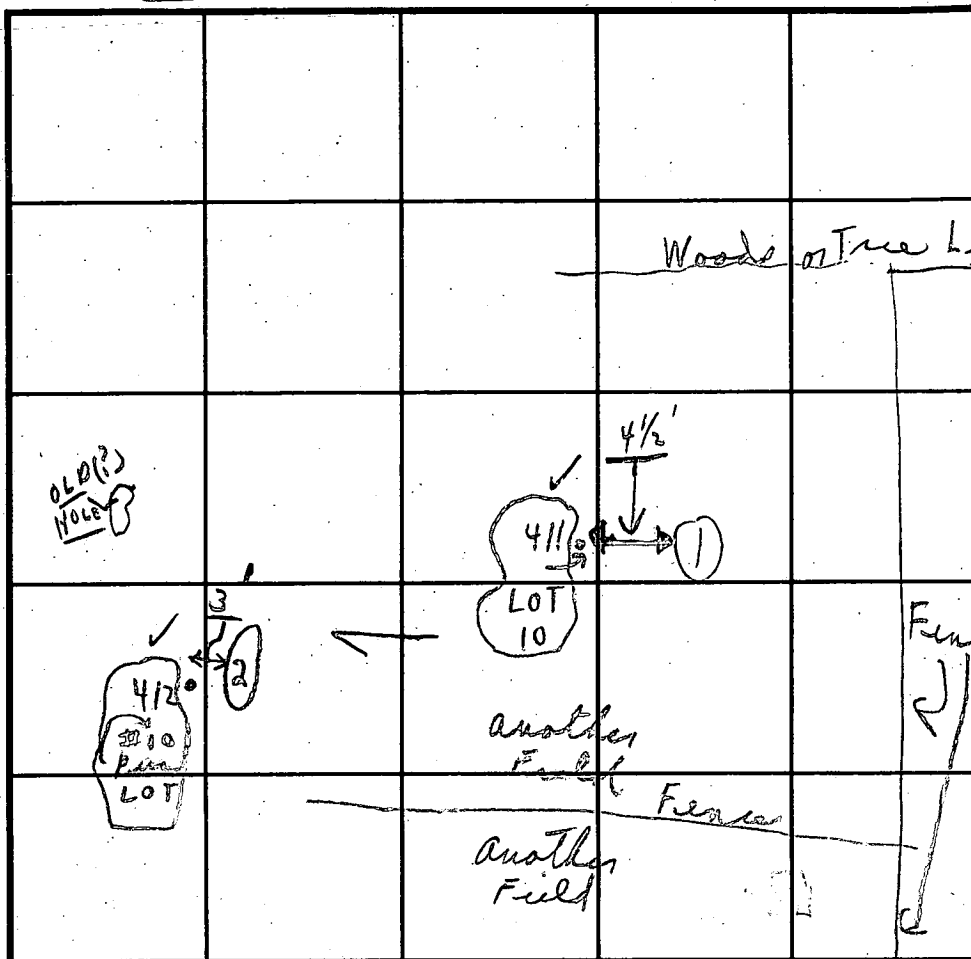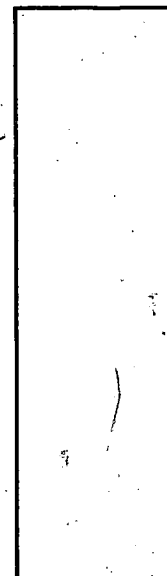

INDICATE NORTH - NAME ADJOINING ROADWAY AS BASE LINE.

(N 89° 31' 0" E) (S 17° 00' 0" W)

DATE	TEST NO.	DEPTH	PRE-WET		TEST - 1" DROP		TIME
			START	STOP	START	STOP	
1/26/93	#①	5'	1:21	1:22	1:22	1:24	2m
(H)	#411	11'			(all loam is seen)		
	#②	5'	1:26	1:44	1:44	2:06	22m
(L)	#412	11 1/2'			(Loam below clay)		
2 Holes only							

REMARKS

Tests in open field

TYPE OF SOIL

TESTED BY

C.B.S.

ALSO PRESENT

O.K. Jr. & assistant

TRENCH DESIGN DATA: AVERAGE PERCOLATION TIME

10

TRENCH WIDTH

3

INLET DEPTH

4'


MAXIMUM BOTTOM DEPTH

6'

SQ. FT./BEDROOM

210

LOTS 9, 10 & 11 - BASEMENTS DO NOT SEWER BY GRAVITY

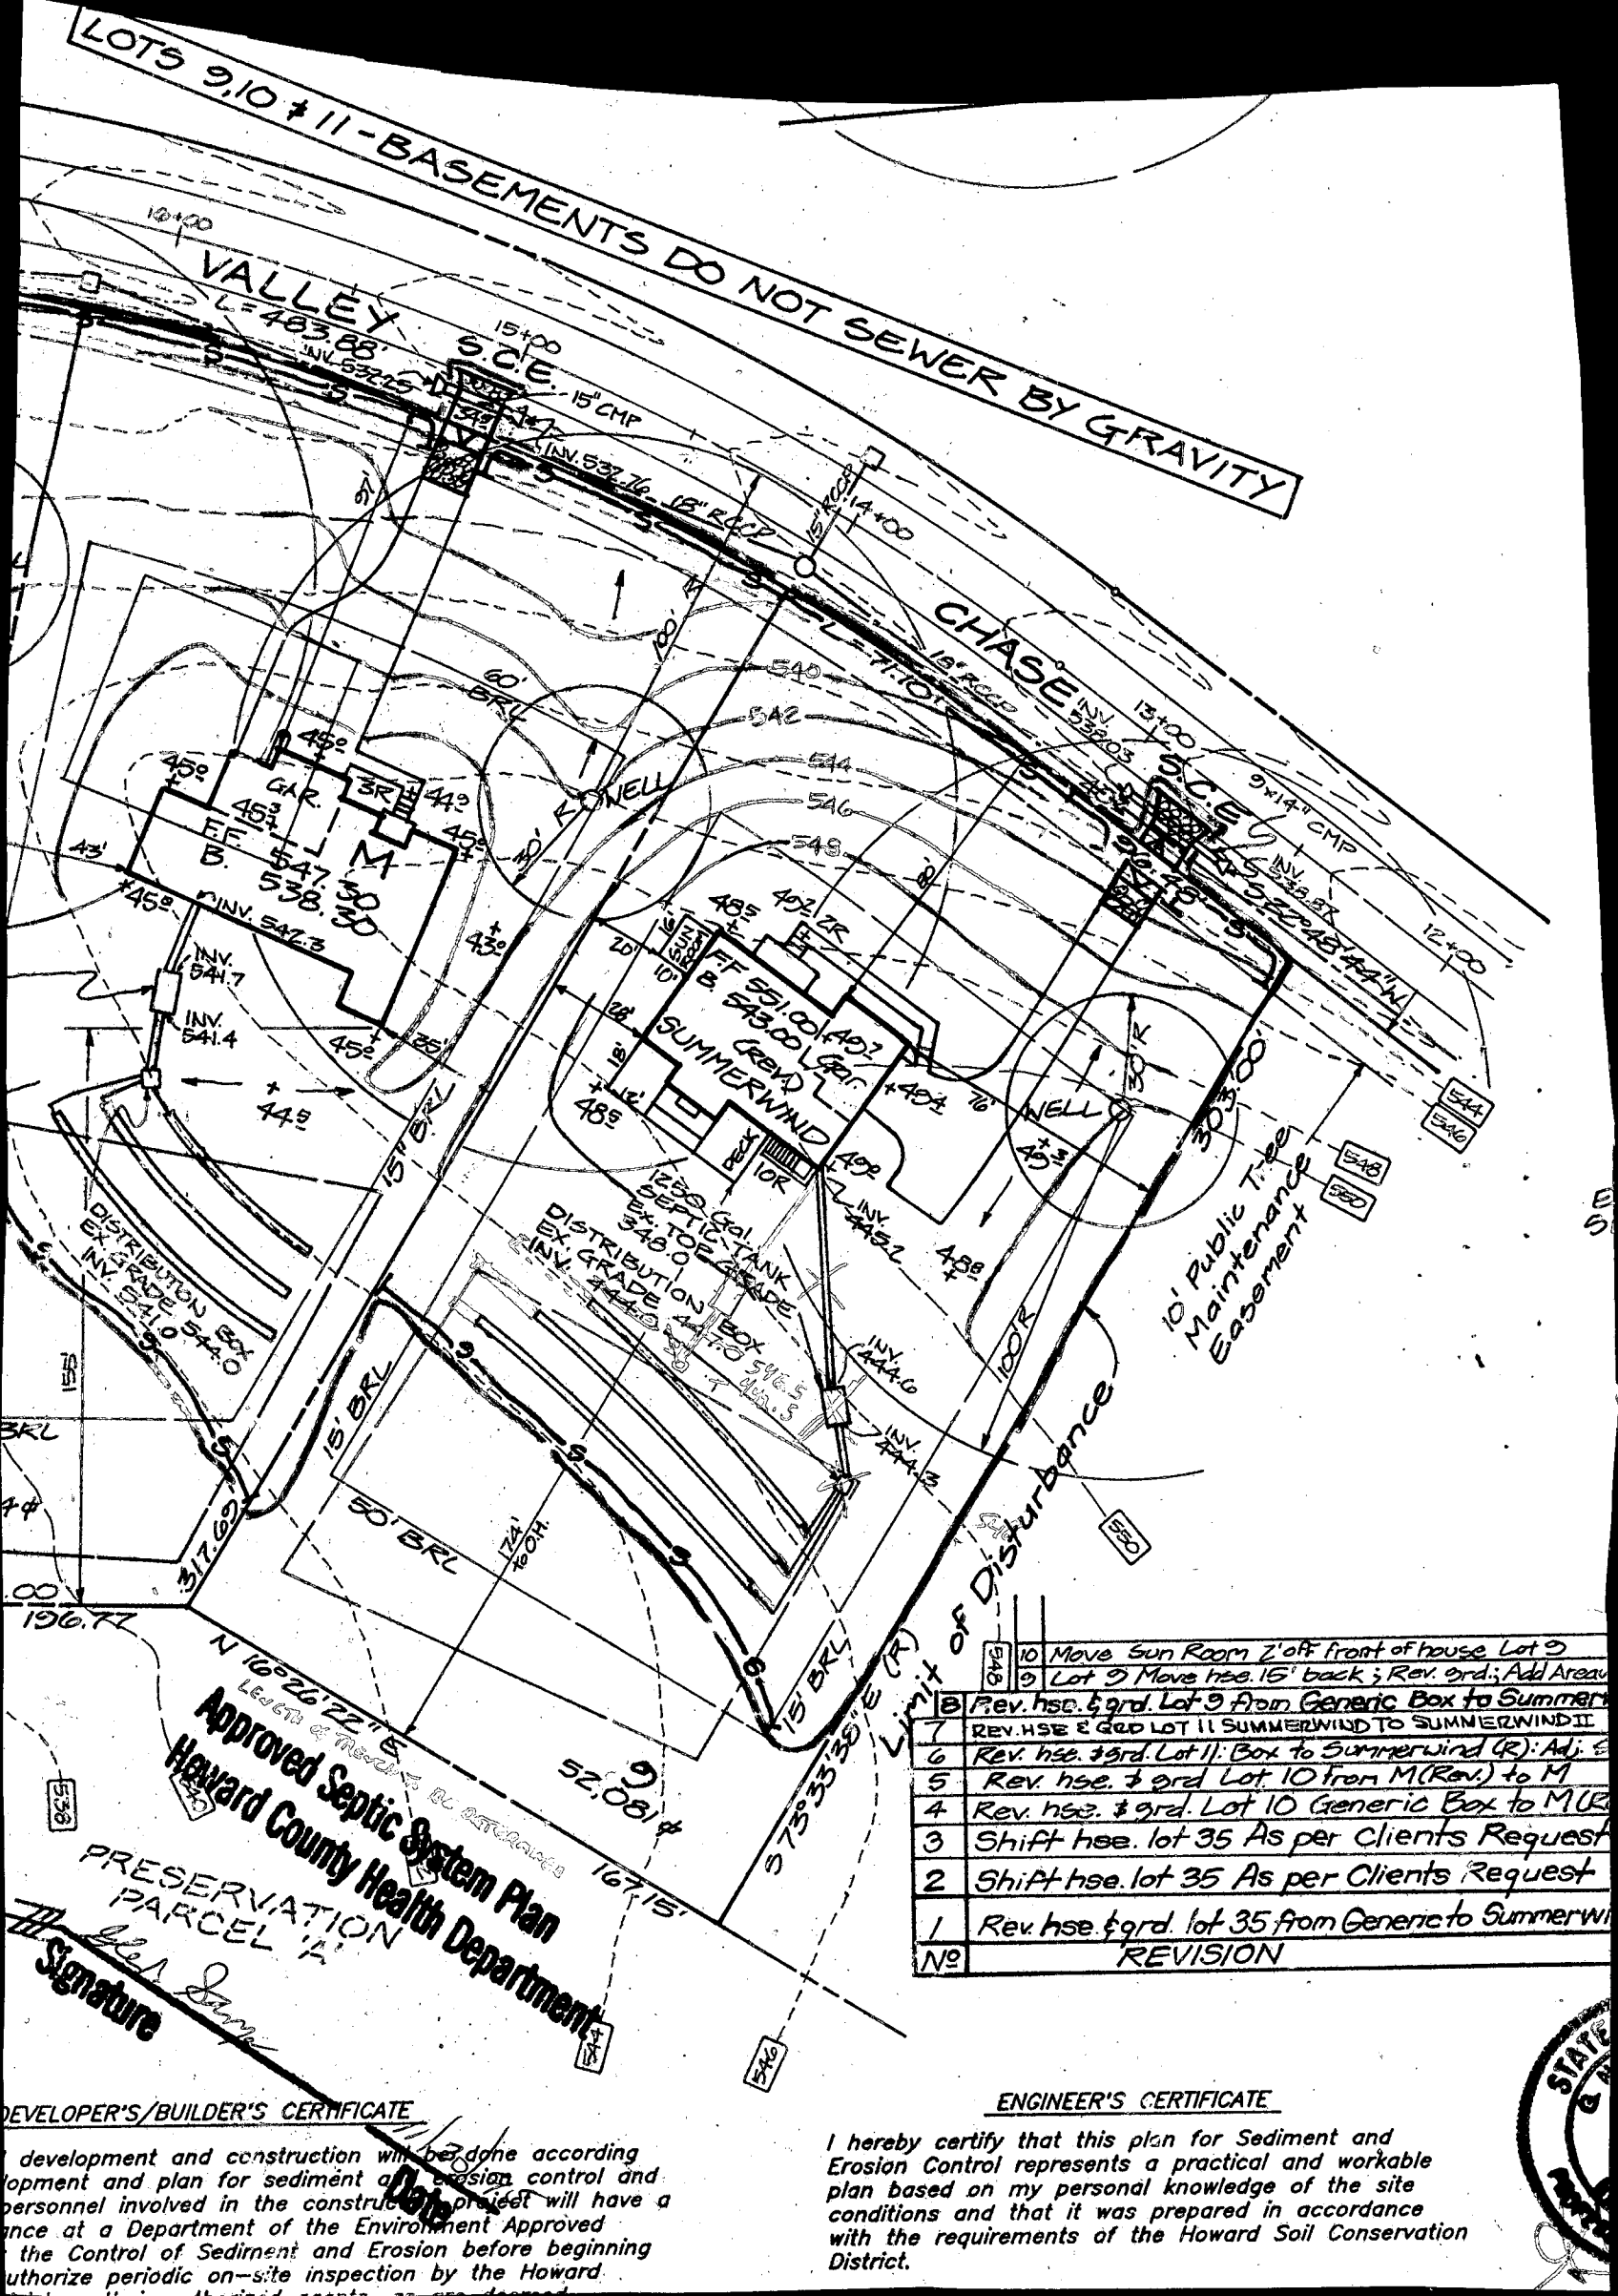

Approved Septic System Plan
 Howard County Health Department
 PRESERVATION
 PARCEL 'A'
 Signature

10	Move Sun Room 2' off front of house Lot 9
9	Lot 9 Move hse. 15' back; Rev. ord.; Add Area
8	Rev. hse. & grd. Lot 9 from Generic Box to Summerwind
7	Rev. hse. & grd. Lot 11 Summerwind to Summerwind II
6	Rev. hse. & grd. Lot 11: Box to Summerwind (R): Adj. E
5	Rev. hse. & grd. Lot 10 from M (Rev.) to M
4	Rev. hse. & grd. Lot 10 Generic Box to MUR
3	Shift hse. lot 35 As per Clients Request
2	Shift hse. lot 35 As per Clients Request
1	Rev. hse. & grd. lot 35 from Generic to Summerwind
NO	REVISION

DEVELOPER'S/BUILDER'S CERTIFICATE

I hereby certify that this plan for development and construction will be done according to the plan for sediment and erosion control and that the personnel involved in the construction of this project will have a permit from the Department of the Environment Approved for the Control of Sediment and Erosion before beginning construction. I authorize periodic on-site inspection by the Howard County Health Department.

ENGINEER'S CERTIFICATE

I hereby certify that this plan for Sediment and Erosion Control represents a practical and workable plan based on my personal knowledge of the site conditions and that it was prepared in accordance with the requirements of the Howard Soil Conservation District.



C15926

SEQUENCE NO.
(DENV USE ONLY)

STATE OF MARYLAND
WELL COMPLETION REPORT
FILL IN THIS FORM COMPLETELY
PLEASE PRINT OR TYPE

THIS REPORT MUST BE SUBMITTED WITHIN
45 DAYS AFTER WELL IS COMPLETED.

COUNTY
NUMBER

A# 49018

ST/CO USE ONLY
DATE Received

DATE WELL COMPLETED

Depth of Well

PERMIT NO.
FROM "PERMIT TO DRILL WELL"

12/12/94

120694

305

40-94-0249

8

13

15

20

22

26

28

29

30

31

32

33

34

35

36

37

OWNER

DORSEY BUILDERS INC.

last name

RIVER VALLEY CHASE

first name

TOWN

W. FRIENDSHIP

SUBDIVISION

W. FRIENDSHIP EST.

SECTION

1

LOT

9

WELL LOG

Not required for driven wells

STATE THE KIND OF FORMATIONS
PENETRATED, THEIR COLOR, DEPTH,
THICKNESS AND IF WATER BEARING

DESCRIPTION (Use
additional sheets if needed)

FEET

FROM

TO

Check
if water
bearing

SAND

0

47

GRAY MICA
ROCK

47

305

GROUTING RECORD

WELL HAS BEEN GROUTED

(Circle Appropriate Box)

TYPE OF GROUTING MATERIAL

CEMENT

BENTONITE CLAY

NO. OF BAGS

15

NO. OF POUNDS

1410

GALLONS OF WATER

90

DEPTH OF GROUT SEAL (to nearest foot)

from

0

ft.

to

42

ft.

CASING RECORD

casing
types
insert
appropriate
code
below

ST

CO

STEEL

CONCRETE

PL

OT

PLASTIC

OTHER

MAIN
CASING
TYPE

Nominal diameter
top (main) casing
(nearest inch)

Total depth
of main casing
(nearest foot)

S

6

50

OTHER CASING (if used)

diameter
inch

depth (feet)
from

to

screen type
or open hole

insert
appropriate
code
below

ST

BR

HO

STEEL

BRASS

OPEN
HOLE

BRONZE

PL

OT

PLASTIC

OTHER

IN HARD ROCK AREAS, IDENTIFY SPECIFICALLY
WHERE SATURATED FRACTURES WERE OBSERVED.

WELL HYDROFRACTURED

yes

no

CIRCLE APPROPRIATE LETTER

A

A WELL WAS ABANDONED AND SEALED
WHEN THIS WELL WAS COMPLETED

E

ELECTRIC LOG OBTAINED

P

TEST WELL CONVERTED TO PRODUCTION
WELL

I HEREBY CERTIFY THAT THIS WELL HAS BEEN CONSTRUCTED IN
ACCORDANCE WITH COMAR 26.04.04 "WELL CONSTRUCTION"
AND IN CONFORMANCE WITH ALL CONDITIONS STATED IN THE
ABOVE CAPTIONED PERMIT, AND THAT THE INFORMATION PRE-
SENTED HEREIN IS ACCURATE AND COMPLETE TO THE BEST OF
MY KNOWLEDGE.

DRILLERS IDENT. NO.

24

DRILLERS SIGNATURE

Joseph L. Mayne

SITE SUPERVISOR (sign. of driller or journeyman
responsible for sitework if different from permittee)

GRAVEL PACK
IF WELL DRILLED WAS
FLOWING WELL INSERT
F IN BOX 68

MDE USE ONLY
(NOT TO BE FILLED IN BY DRILLER)

T

(E.R.O.S.)

W Q

70

72

74

75

76

TELESCOPE
CASING

LOG
INDICATOR

OTHER DATA

LOCATION OF WELL ON LOT

SHOW PERMANENT STRUCTURE SUCH AS
BUILDING, SEPTIC TANKS, AND/OR
LANDMARKS AND INDICATE NOT LESS
THAN TWO DISTANCES
(MEASUREMENTS TO WELL)

18'

70'

River Valley
Chase

DEPT. (nearest ft.)

1

2

3

3/21/97
REGION _____

A49018

AREA _____

RATING _____

ACKNOWLEDGMENT AND CONTROLS	DATE

Howard County Department of Health
BUREAU OF ENVIRONMENTAL HEALTH

RECORD OF INVESTIGATION

DISPOSITION	DATE

LOCATION 3151 River Valley Chase (Lot 9) ZIP _____
OWNER ☒ Beth Medley ADDRESS same as above PHONE 489 5657
OCCUPANT ☐ _____ ADDRESS _____ PHONE _____

COMPLAINANT _____ ADDRESS _____ PHONE _____

REASON FOR INVESTIGATION Smells sewage in back yard WHEN
STANDING ON PARKING PADCODES _____
RECEIVED BY A McMillen DATE 3/18/97 ASSIGNED TO _____ DATE _____DATE OF INVESTIGATION 3/20/97 TIME 3:15 PM WEATHER CloudyREPORT No odor noted at this time. Probably odor from sewer vent pipes on ceiling from my house.
Septic system appears to be in good condition - No odor noticed in Septic tank Chamber. 3/20/97

3/27/97 MET OWNERS @ PROP; DISCUSSED W/MR. MEDLEY
BASIC SEPTIC SYSTEM OPERATION, ORIGINS OF SEPTIC
FAILURES, ETC.; ALSO WALKED OVER SEWAGE ESMT
(NO DISCHARGE NOTED) AND EXAMINED ADJ. PROPERTIES
(NO DISCH. NOTED); ROOF DRAIN DISCHARGE LINE INSTALLED
AT TOP OF SEWAGE AREA; END OF THIS DRAINLINE
APPEARS TO HAVE SLIGHT UPSLOPE, SUCH THAT ALGAE
& H₂O OBS'D SITTING IN END OF LINE; ADVISED OWNER
THIS IS MOST LIKELY ODOR SOURCE; ALSO INVESTIGATED
TWO VENTS 2' OFF GRADE @ DRIVEWAY ~~OR~~ PARKING PAD;
BOTH CONN TO HOT H₂O HEATER; NO H.D. ISSUE - FILE CLOSED
(MR)

DATE SUBMITTED 3/20/97SANITARIAN hally

REGION

AREA

RATING

ACKNOWLEDGMENT AND CONTROLS	DATE

Howard County Department of Health
BUREAU OF ENVIRONMENTAL HEALTH

RECORD OF INVESTIGATION

DISPOSITION	DATE

LOCATION 3151 River Valley Chase (Lot 9) ZIP
OWNER ☒ Beth Medley ADDRESS same as above PHONE 489 5657
OCCUPANT ☐ ADDRESS PHONE

COMPLAINANT ADDRESS PHONE

REASON FOR INVESTIGATION Smells sewage in back yard WHEN
STANDING ON PARKING PAD

RECEIVED BY A McMillen DATE 3/18/97 ASSIGNED TO DATE

DATE OF INVESTIGATION 3/20/97 TIME 3:15 PM WEATHER Cloudy

REPORT No odor noted at this time. Probably odor from sewer vent pipes on ceiling from any house.
Septic system appears to be in good condition - No odor noticed in Septic Tank Chamber. 3/20/97

3/27/97 MET OWNERS @ PROP; DISCUSSED W/MR. MEDLEY
BASIC SEPTIC SYSTEM OPERATION, ORIGINS OF SEPTIC
FAILURES, ETC.; ALSO WALKED OVER SEWAGE ESMT.
(NO DISCHARGE NOTED) AND EXAMINED ADJ. PROPERTIES
(NO DISCH. NOTED); ROOF DRAIN DISCHARGE LINE INSTALLED
AT TOP OF SEWAGE AREA. END OF THIS DRAIN LINE
APPEARS TO HAVE SLIGHT UPSLOPE, SUCH THAT ALGAE
& H₂O OBS'D SITTING IN END OF LINE; ADVISED OWNER
THIS IS MOST LIKELY ODOR SOURCE; ALSO INVESTIGATED
TWO VENTS 2' OFF GRADE @ DRIVEWAY ~~AND~~ PARKING PAD;
BOTH CONN TO HOT H₂O HEATER; NO H₂O. ISSUE - FILE CLOSED

DATE SUBMITTED

SANITARIAN