

6-5-96
EARLY PM
6-6-96
11/25/96
WPI

6/5/96 PAID BY CHECK #
3118-\$180.00
88

PERMIT

SEWAGE DISPOSAL SYSTEM

DEPARTMENT OF HEALTH AND MENTAL HYGIENE

P 56968

A 49020

DISTRICT 3rd

DATE 6-5-96

HOWARD COUNTY HEALTH DEPARTMENT

BUREAU OF ENVIRONMENTAL HEALTH

461-9933 313-2640

DATE SYSTEM APPROVED 11/25/96

INSPECTOR ALM

INDEXED

Olen Ketterman-K & K Excavating IS PERMITTED TO INSTALL ☒ ALTER ☐

ADDRESS 14960 Route 144, Woodbine, MD 21797 PHONE 442-1336

SUBDIVISION West Friendship Estates LOT 20 ROAD 3184 River Valley Chase

PROPERTY OWNER ~~Sovereign Homes~~ CRAWLEY

ADDRESS

SEPTIC TANK CAPACITY 1250 GALLONS *TOP SEAM TANK*
*Preschedule at all times during trench excavation.

NUMBER OF BEDROOMS 4

210 SQUARE FEET PER BEDROOM

LINEAR FEET OF TRENCH REQUIRED 280

TRENCHES - Trench to be 3 feet wide. Inlet 3 feet below original grade. Bottom maximum depth 5 feet below original grade. Effective area begins at 5 feet below original grade. 2 feet of stone below distribution pipe.

LOCATION - Start trenches at a point 195' from front (64') lot line and 50' off the right (353') lot lines. Run trenches along contour towards left lot line.

NOTES - No trench to exceed 100 feet in length. Provide 6" - 8" diameter cleanout and cap to grade or above on septic tank. OK - 6-3-96

6/5 OK TO INCREASE STARTPOINT TO 205' (195' WAS DISTANCE TO TEST A)
4-70' TRENCHES DISCLOSED, OK TO MOVE TOWARDS RIGHT SIDE LOT LINE IF SOIL OK

PLANS APPROVED BY Glen Savage DATE

COVER NO WORK UNTIL INSPECTED AND APPROVED

NEITHER THE HOWARD COUNTY COUNCIL NOR THE HEALTH DEPARTMENT IS RESPONSIBLE FOR THE SUCCESSFUL OPERATION OF ANY SYSTEM

NOTE: CLEANOUT REQUIRED EVERY 70 FEET OF SEWER LINE AND/OR AT 90° SWEEPS IN LINES FROM HOUSE TO DRAIN FIELDS, 90° ELBOWS NOT ACCEPTABLE.

NOTE: ALL PARTS OF SEPTIC SYSTEMS (I.E. TANK, DISTRIBUTION BOX TRENCHES) TO BE 100 FEET FROM WELL (UNLESS OTHERWISE SPECIFICALLY AUTHORIZED)

NOTE: IF DEEP TRENCH(ES) ARE USED CALL FOR INSPECTION BEFORE AND AFTER PLACING GRAVEL IN TRENCH(ES)

NOTE: NO DRY WELL SHALL EXCEED 15 FOOT IN DIAMETER NO ABSORPTION TRENCH TO EXCEED 100 FEET IN LENGTH

NOTE: ALL PIPE FROM HOUSE TO SEPTIC TANK MUST BE CAST IRON OR SCHEDULE 35/40 PVC OR ABS

PERMIT VOID AFTER TWO YEARS


NOTE: INSTALL STAND PIPE ON SEPTIC TANK AND DRY WELL STAND PIPES MUST BE 6 INCHES IN DIAMETER CAST IRON. CONCRETE OR TERRA COTTA OR PVA OR ABS ACCEPTED. IF TOP OF SEPTIC TANK IS DEEPER THAN 3 FEET. MANHOLE TO GRADE REQUIRED.

NOTE: DISTRIBUTION BOXES MUST HAVE BAFFLES

*INSTALLER IS RESPONSIBLE FOR OBTAINING FINAL APPROVAL ON THIS PERMIT

A 49020

HOUSE, TANK LOCATION FIELD CHECKED 6-18-96

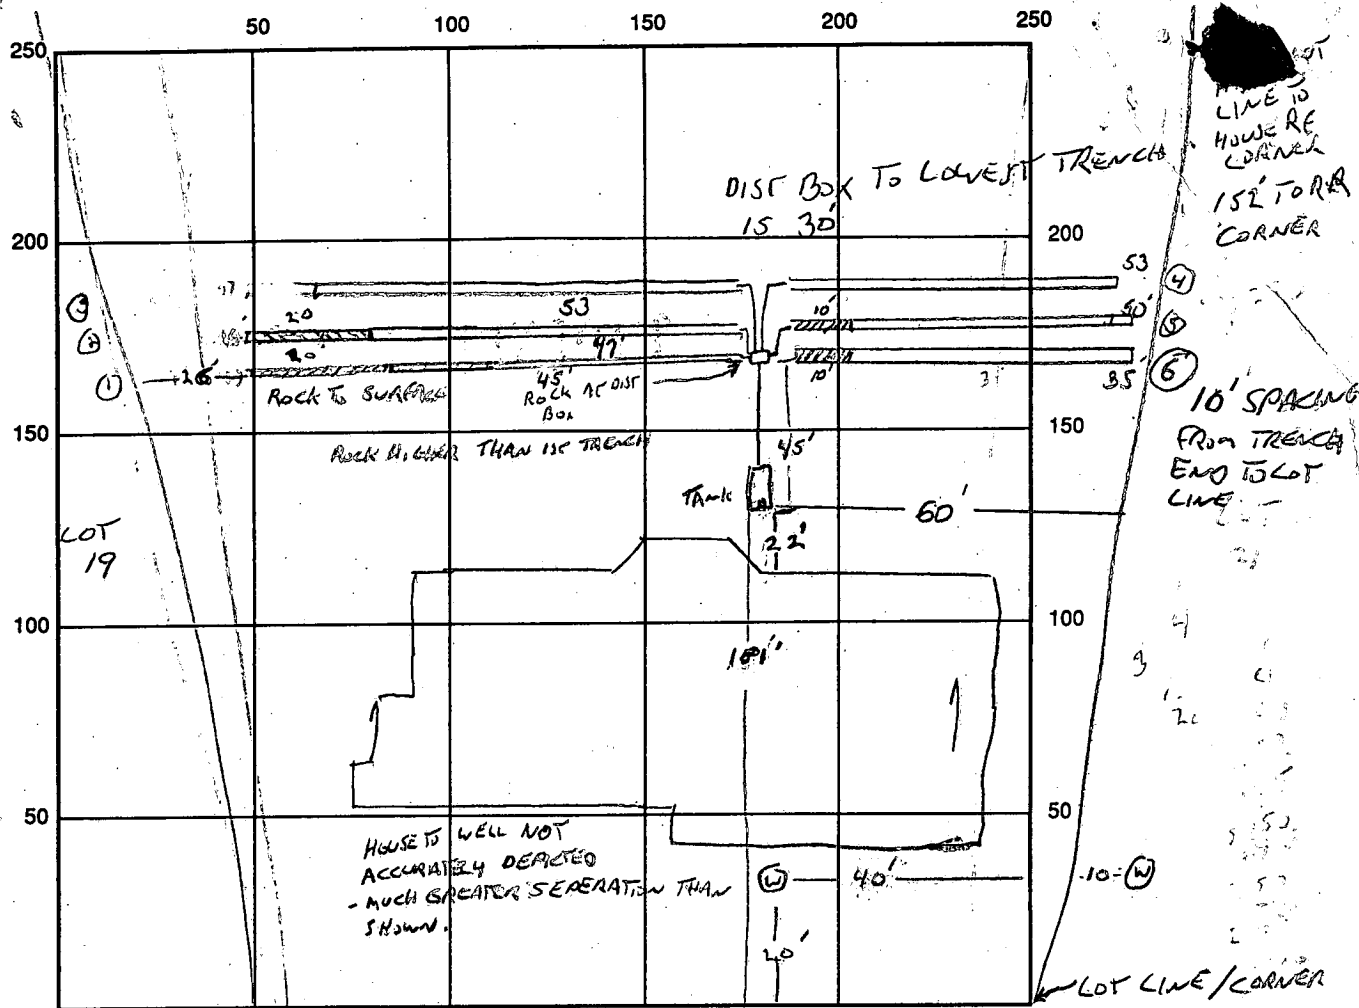

SEPTIC TANK LEVEL OK - 1500 GALLON

CLEANOUTS ON TANK

DISTRIBUTION BOX LEVEL OK

DRAIN FIELD/TITLE DEPTH 5 FT.

TRENCH WIDTH 3 FT.

INLET DEPTH 3 FT.

EFFECTIVE GRAVEL DEPTH 2 FT.

TOTAL LENGTH $\frac{1 \times 2 \times 3 \times 4 \times 5 \times 6}{1 \times 2 \times 3 \times 4 \times 5 \times 6} = 283$

NUMBER OF TRENCHES 6

ONE SIDEWALL/BOTTOM AREA 849 SQ. FT.

DRYWALL INSIDE DIAMETER — FT.

EFFECTIVE DEPTH BELOW INLET — FT.

ABSORBENT AREA — SQ. FT.

REMARKS: 6/6/96 HIGH SIDE OF TANK HAVE 15 SOLID ROCK SEAMS, 20' AT ENDS OF 1ST 2 TRENCHES
NOT USEABLE DUE TO ROCK. 6' BETWEEN TRENCHES, SOIL IN 1ST 3 TRENCHES WILL PERC
AT 180 FT / BARM. OK TO START COVER TRENCHES 1-4 6-7 TRENCHES COMPLETE
OK TO COVER SYSTEM. HOUSE CONNECTION FOR FINAL. 11/26/96
HOUSE CONNECTION MADE W/PI OK TO COVER AC

DATE SYSTEM APPROVED 11/25/96

INSPECTOR A M' Miller

APPLICATION

PERCOLATION TESTING

A 49020

P _____

HOWARD COUNTY HEALTH DEPARTMENT

BUREAU OF ENVIRONMENTAL HEALTH

3525-H ELLICOTT MILLS DRIVE/ELLICOTT CITY, MARYLAND 21043
TELEPHONE: 313-2640

RETEST SEPTIC
CASEMENT
TO VERIFY
ABSENCE OF ROCK

DISTRICT _____

DATE 5/24/96

TO: THE COUNTY HEALTH OFFICER
ELLICOTT CITY, MARYLAND

I HEREBY APPLY FOR THE NECESSARY TEST PRIOR TO APPLICATION FOR PERMIT TO CONSTRUCT (OR RECONSTRUCT) A SEWAGE DISPOSAL SYSTEM.

PROPERTY OWNER SOVEREIGN HOMES

ADDRESS 2915 BEAVER LAKE CT EST. PHONE _____

AGENT OR PROSPECTIVE BUYER _____

ADDRESS _____ PHONE _____

PROPERTY LOCATION:

SUBDIVISION WEST FRIENDSHIP EST. LOT NO. 20

ROAD AND DESCRIPTION _____

TAX MAP _____ PARCEL # _____

SIZE OF LOT _____ TYPE BLDG. _____
(SINGLE FAMILY DWELLING OR COMMERCIAL)

THE SYSTEM INSTALLED UNDER THIS APPLICATION IS ACCEPTABLE ONLY UNTIL PUBLIC FACILITIES BECOME AVAILABLE. I FULLY UNDERSTAND THE FEE CONNECTED WITH THE FILING OF THIS PERC TEST APPLICATION IS NON-REFUNDABLE UNDER ANY CIRCUMSTANCES. I ALSO AGREE TO COMPLY WITH ALL M.O.S.H.A. REQUIREMENTS IN TESTING THIS LOT.

(SIGNATURE OF APPLICANT) _____

APPROVED BY _____ FOR _____ DATE _____

DISAPPROVED BY _____ FOR _____ DATE _____

HOLD PENDING FURTHER TESTS _____

REASONS FOR REJECTION OR HOLDING _____

PERCOLATION TEST PLAT/PRELIMINARY PLAT - TITLE OR I.D. # _____ DATE _____


SITE DEVELOPMENT PLAN/FINAL PLAT - TITLE OR I.D. # _____ DATE _____

THIS IS NOT A PERMIT



49020 RETEST

COUNTY #

SOIL PROFILE B

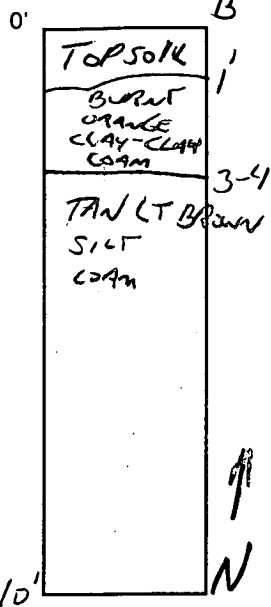

SOIL PROFILE A

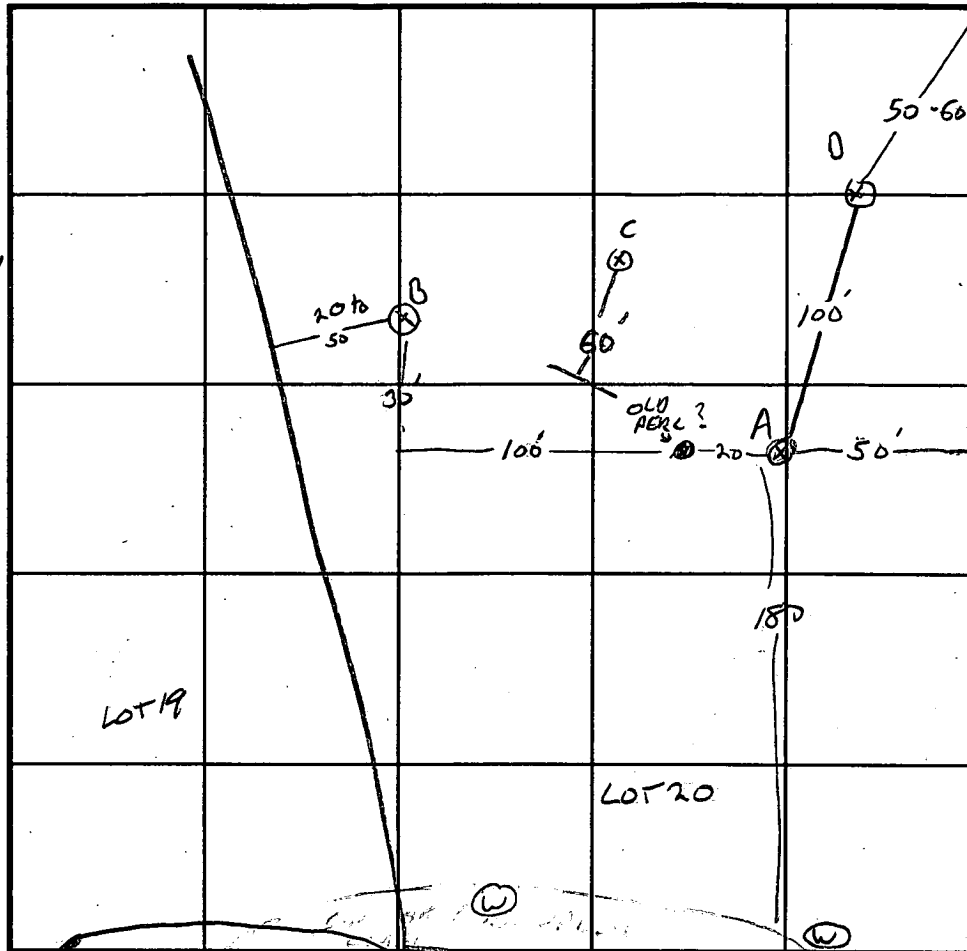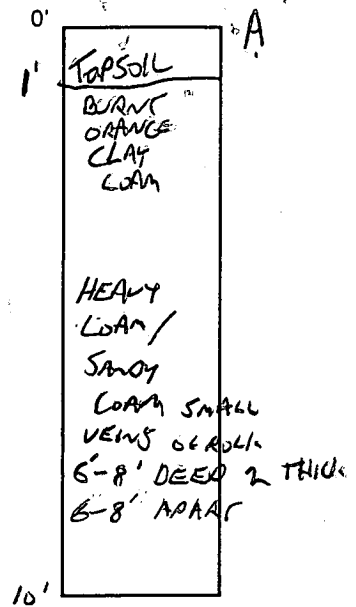

INDICATE NORTH - NAME ADJOINING ROADWAY AS BASE LINE

RIVER VALLEY CLAY

DATE	TEST NO.	DEPTH	PRE-WET		TEST - 1" DROP		TIME
			START	STOP	START	STOP	
5-24-96	A	CAUTION / 10'					
	B	OK TO 6' VISUAL OK					
	C	POCKET OF ROCK AT 6' IN ONE SIDE OF PERC HOLE					
	D	VISUAL OK TO 10' HEAVY ORANGE LOAM					
— RECOMMEND MOVING HIGHEST TRENCH DOWN SLOPE SLIGHTLY							
— SANITARIAN PRESENT DURING TRENCH EXCAVATION?							
— TOP SEAM TANK							
— OK TO ISSUE BUILDING PERMIT							

REMARKS RE-TEST TO VERIFY ABSENCE OF ROCK.

TYPE OF SOIL Rock APPEARS TO OCCUR IN RANDOM LOCATIONS IN HIGHER PORTIONS OF EASEMENT

TESTED BY G. SALVAGE ALSO PRESENT KET TEAM KN

TRENCH DESIGN DATA: AVERAGE PERCOLATION TIME 10 MIN TRENCH WIDTH 3

INLET DEPTH 3 MAXIMUM BOTTOM DEPTH 5 SQ. FT./BEDROOM 210

APPLICATION

PERCOLATION TESTING

HOWARD COUNTY HEALTH DEPARTMENT
BUREAU OF ENVIRONMENTAL HEALTH
3525-H ELLICOTT MILLS DRIVE/ELLICOTT CITY, MARYLAND 21043
TELEPHONE: 313-2640

A 49020

P _____

DISTRICT _____

DATE 3/5/93

TO: THE COUNTY HEALTH OFFICER
ELLICOTT CITY, MARYLAND

I HEREBY APPLY FOR THE NECESSARY TEST PRIOR TO APPLICATION FOR PERMIT TO CONSTRUCT (OR RECONSTRUCT) A SEWAGE DISPOSAL SYSTEM.

PROPERTY OWNER _____

ADDRESS _____ PHONE _____

AGENT OR PROSPECTIVE BUYER _____

ADDRESS _____ PHONE _____

PROPERTY LOCATION:

SUBDIVISION W ELSHP I LOT NO. 21

ROAD AND DESCRIPTION Hood Farm

TAX MAP _____ PARCEL # _____

SIZE OF LOT _____ TYPE BLDG. _____
(SINGLE FAMILY DWELLING OR COMMERCIAL)

THE SYSTEM INSTALLED UNDER THIS APPLICATION IS ACCEPTABLE ONLY UNTIL PUBLIC FACILITIES BECOME AVAILABLE. I FULLY UNDERSTAND THE
FEE CONNECTED WITH THE FILING OF THIS PERC TEST APPLICATION IS NON-REFUNDABLE UNDER ANY CIRCUMSTANCES. I ALSO AGREE TO
COMPLY WITH ALL M.O.S.H.A. REQUIREMENTS IN TESTING THIS LOT.

(SIGNATURE OF APPLICANT)

APPROVED BY _____ FOR _____ DATE _____

DISAPPROVED BY _____ FOR _____ DATE _____

HOLD PENDING FURTHER TESTS _____

REASONS FOR REJECTION OR HOLDING _____

PERCOLATION TEST PLAT/PRELIMINARY PLAT - TITLE OR I.D. # _____ DATE _____

SITE DEVELOPMENT PLAN/FINAL PLAT - TITLE OR I.D. # _____ DATE _____

THIS IS NOT A PERMIT

COUNTY #

SOIL PROFILE
HOLE (2)

0:

0'-2'

Chaz

2' to 9'

55%
LOAN

45%

FLARY.
SANDSTONE

9

HOLE ③

0 to 4
clay

4' 7" 10'-9"

Reddick
Sandy
Loren

HOLE ④


0' to 5' ±
Clay

5 1/2 to.

(ALL
LOAN)

DRY

12 1/2'

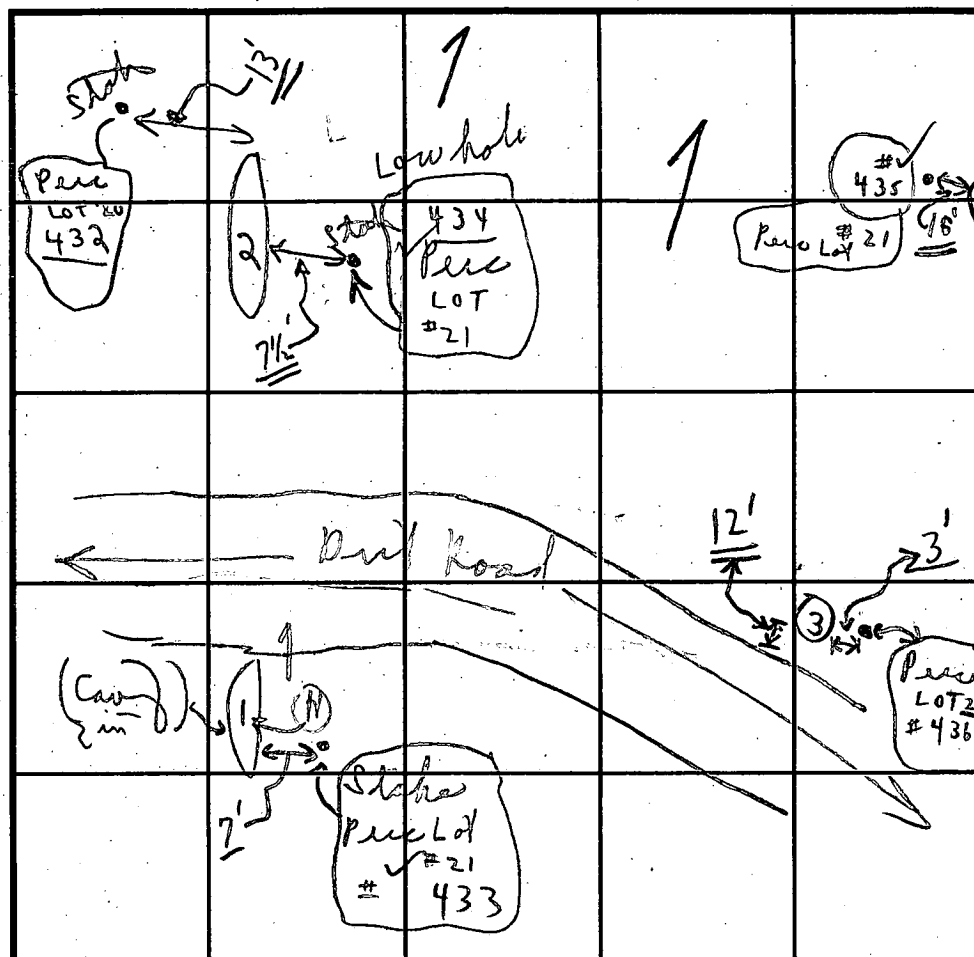

INDICATE NORTH - NAME ADJOINING ROADWAY AS BASE LINE

SOIL PROFILE

0

4437

L.O. 2
Pace

HOLE # ①

0' to 4' clay

4' 70 9'-9"
seen

Covered

9'-9" ←

LOAM #0
SANDSTONE

$(LOT22) \rightarrow$

DATE	TEST NO.	DEPTH	PRE-WET		TEST - 1" DROP		TIME
			START	STOP	START	STOP	
1/27/93	① ✓	4'	12:56	1:00	1:00	1:12	12 min
(Wednesday)	# 433	7'	12:56	12:58	12:58	1:10 ^{out}	12 min
Low	② ✓	2'	12:45	12:52	12:52	1:03	11 min
LOT 20 432 (Nes)	# 434	9'		55%	Loam	45%	Flaky
	③ ✓		5: Visual		4' to 10'	9"	
	# 436	10'-9"	{	Visual	5' to 10'	4' clay	
LOT 21 + 22 On the	④ ✓	5 1/2'	1:49	1:46	1:46	1:49	4 min
line	# 435	12 1/2'	any	all	loam		

REMARKS: Tests in woods & mud (shallow only)

TYPE OF SOIL Loam & above

TESTED BY C. B. C. ALSO PRESENT O. K. C. + assistant


TRENCH DESIGN DATA: AVERAGE PERCOLATION TIME _____ TRENCH WIDTH 1 _____

INLET DEPTH	MAXIMUM BOTTOM DEPTH	SQ. FT./BEDROOM

SQ. FT./BEDROOM


3' wide

C1 7902		SEQUENCE NO. (MDE USE ONLY)		STATE OF MARYLAND WELL COMPLETION REPORT FILL IN THIS FORM COMPLETELY PLEASE PRINT OR TYPE		THIS REPORT MUST BE SUBMITTED WITHIN 45 DAYS AFTER WELL IS COMPLETED. COUNTY <u>Not on Permit</u> NUMBER	
ST/CO USE ONLY DATE Received		DATE WELL COMPLETED		Depth of Well		PERMIT NO. FROM "PERMIT TO DRILL WELL"	
8 13		15 20		22 26		28 37	
		CS2996		185		H0-94-0787	
				(TO NEAREST FOOT)			
OWNER <u>SOVEREIGN HOMES</u> STREET OR RFD <u>RIVER VALLEY CHASE</u> TOWN <u>WEST FRIENDSHIP</u> SUBDIVISION <u>WEST FRIENDSHIP ESTATES</u> SECTION <u>LOT 20</u>							
WELL LOG Not required for driven wells			GROUTING RECORD			C3	
STATE THE KIND OF FORMATIONS PENETRATED, THEIR COLOR, DEPTH, THICKNESS AND IF WATER BEARING			WELL HAS BEEN GROUTED (Circle Appropriate Box)			PUMPING TEST	
DESCRIPTION (Use additional sheets if needed)			TYPE OF GROUTING MATERIAL (Circle one)			HOURS PUMPED (nearest hour)	
FEET			CEMENT <u>CM</u> BENTONITE CLAY <u>BC</u>			PUMPING RATE (gal. per min.)	
FROM TO			NO. OF BAGS <u>14</u> NO. OF POUNDS <u>1400</u>			METHOD USED TO MEASURE PUMPING RATE <u>Bucket</u>	
check if water bearing			GALLONS OF WATER <u>84</u>			WATER LEVEL (distance from land surface)	
Top Soil 0 2			DEPTH OF GROUT SEAL (to nearest foot)			BEFORE PUMPING	
Sandy 2 12			from 48 TOP 52 ft. to 30 54 BOTTOM 58			WHEN PUMPING	
Clay 12 15			CASING RECORD			TYPE OF PUMP USED (for test)	
Sandy 15 35			casing types insert appropriate code below			A air P piston T turbine	
MICKA 35 60			STEEL CONCRETE			C centrifugal R rotary O other (describe below)	
SANDSTONE 60 65			PLASTIC OTHER			J jet S submersible	
MICKA 65 185			MAIN CASING TYPE			PUMP INSTALLED	
			Nominal diameter top (main) casing (nearest inch)			DRILLER WILL INSTALL PUMP (CIRCLE) (YES or NO)	
			Total depth of main casing (nearest foot)			IF DRILLER INSTALLS PUMP, THIS SECTION MUST BE COMPLETED FOR ALL WELLS.	
			OTHER CASING (if used)			TYPE OF PUMP INSTALLED PLACE (A,C,J,P,R,S,T,O) IN BOX 29	
			EACH CASING diameter inch depth (feet) from to			CAPACITY: GALLONS PER MINUTE (to nearest gallon)	
			SCREEN RECORD			PUMP HORSE POWER	
			screen type or open hole insert appropriate code below			PUMP COLUMN LENGTH (nearest ft.)	
			STEEL BRASS BRONZE PLASTIC OTHER			CASING HEIGHT (circle appropriate box and enter casing height)	
			C2			LAND SURFACE (nearest foot)	
NUMBER OF UNSUCCESSFUL WELLS: 0			DEPTH (nearest ft.)			LOCATION OF WELL ON LOT	
WELL HYDROFRACTURED YES Y NO N			1 2 3 100			SHOW PERMANENT STRUCTURE SUCH AS BUILDING, SEPTIC TANKS, AND /OR LANDMARKS AND INDICATE NOT LESS THAN TWO DISTANCES (MEASUREMENTS TO WELL)	
CIRCLE APPROPRIATE LETTER A A WELL WAS ABANDONED AND SEALED WHEN THIS WELL WAS COMPLETED E ELECTRIC LOG OBTAINED P TEST WELL CONVERTED TO PRODUCTION WELL			SLOT SIZE 1 2 3 DIAMETER OF SCREEN (NEAREST INCH)			30' well 20' ROAD	
I HEREBY CERTIFY THAT THIS WELL HAS BEEN CONSTRUCTED IN ACCORDANCE WITH COMAR 26.04.04 "WELL CONSTRUCTION" AND IN CONFORMANCE WITH ALL CONDITIONS STATED IN THE ABOVE CAPTIONED PERMIT, AND THAT THE INFORMATION PRESENTED HEREIN IS ACCURATE AND COMPLETE TO THE BEST OF MY KNOWLEDGE.			GRAVEL PACK IF WELL DRILLED WAS FLOWING WELL INSERT F IN BOX 68				
TYPE: MWD/MSP/MGD 116			MDE USE ONLY (NOT TO BE FILLED IN BY DRILLER)				
DRILLERS LIC. NO. 116			T (E.R.O.S.) W Q				
DRILLERS SIGNATURE			70 72 74 75 76				
(MUST MATCH SIGNATURE ON APPLICATION)			TELESCOPE CASING LOG INDICATOR OTHER DATA				
LIC. NO. 117							
SITE SUPERVISOR (sign. of driller or journeyman responsible for sitework if different from permittee)							

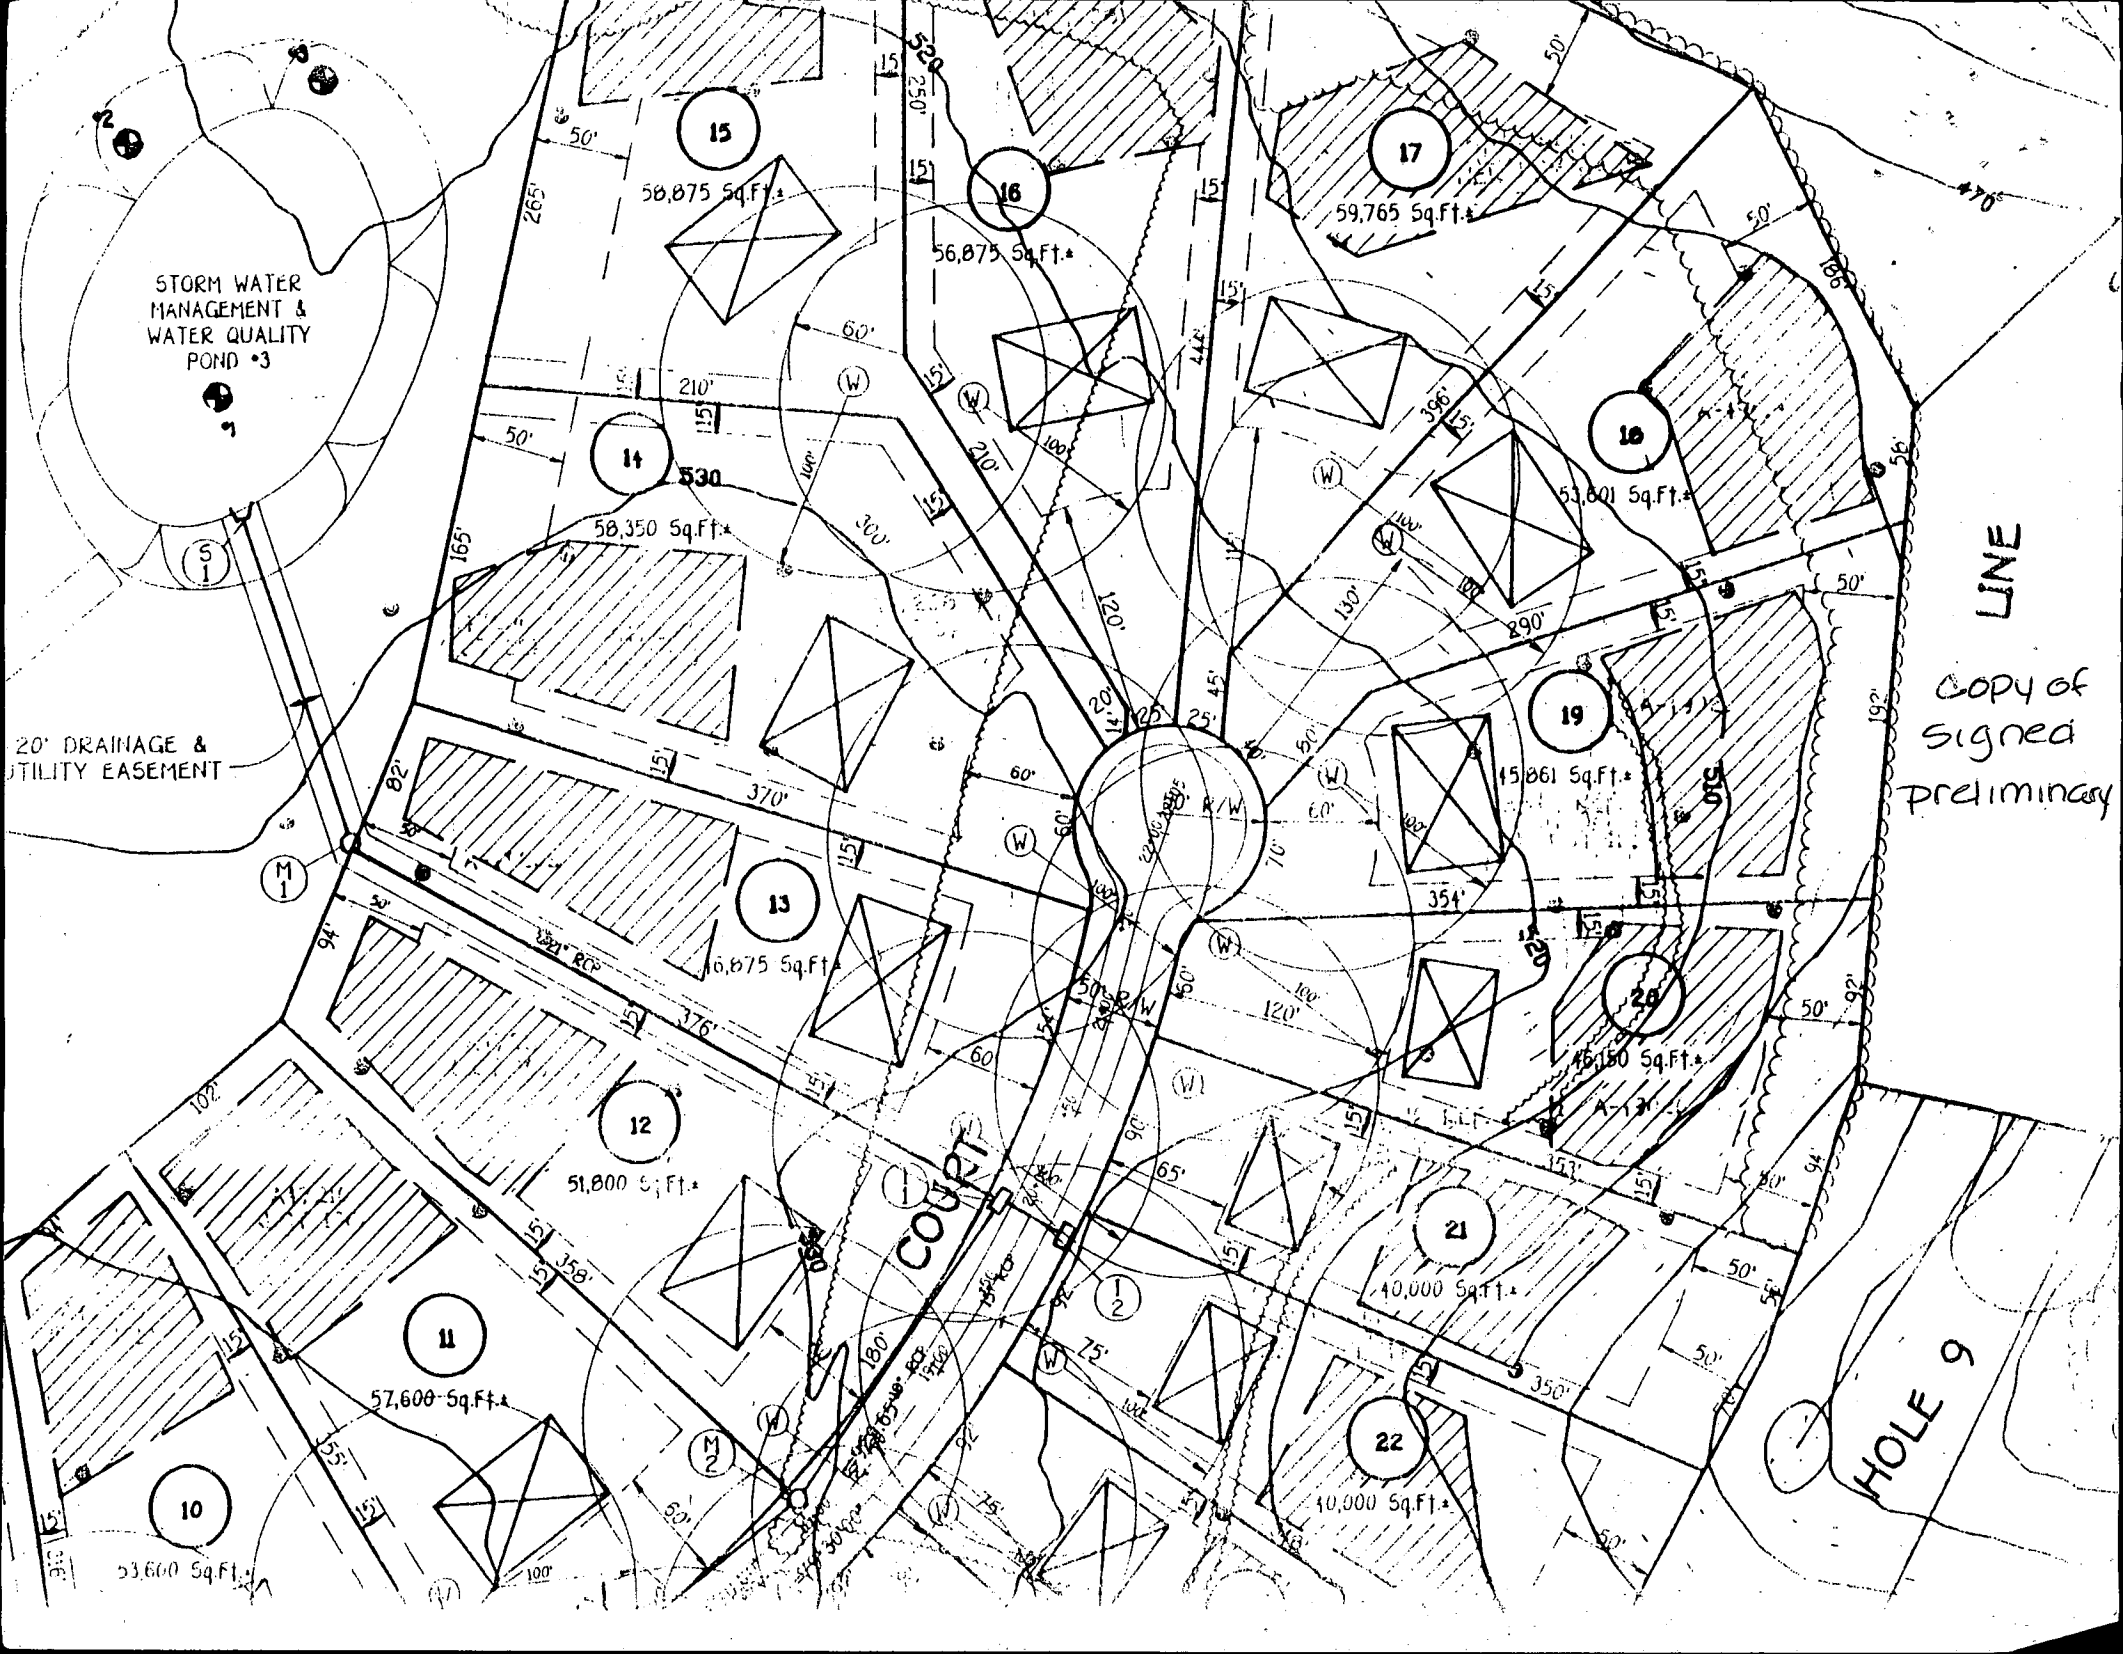


GENERAL NOTES:

- 1) THIS PLAT IS PREPARED FOR THE BENEFIT OF THE CLIENT SIGNING THE HOUSE LOCATION SURVEY APPROVAL FORM INsofar AS IT IS REQUIRED BY A LENDER OR TITLE INSURANCE COMPANY OR ITS AGENTS IN CONNECTION WITH THE CONTEMPLATED TRANSFER, FINANCING OR RE-FINANCING. UNLESS INDICATED AS BEING A BOUNDARY SURVEY, THIS PLAT IS NOT INTENDED FOR USE IN THE ESTABLISHMENT OF PROPERTY LINES AND IS NOT TO BE RELIED UPON FOR THE ESTABLISHMENT OR LOCATIONS OF FENCES, GARAGES, BUILDINGS OR OTHER EXISTING OR FUTURE IMPROVEMENTS. AS A RESULT, THIS PLAT DOES NOT PROVIDE FOR ACCURATE IDENTIFICATION OF PROPERTY LINE, BUT SUCH IDENTIFICATION MAY NOT BE REQUIRED FOR THE TRANSFER OF TITLE OR SECURING FINANCING OR RE-FINANCING.
- 2) SUBJECT PROPERTY IS SHOWN IN ZONE C ON THE NATIONAL FLOOD INSURANCE PROGRAM FLOOD INSURANCE RATE MAP OF HOWARD COUNTY, MARYLAND, COMMUNITY PANEL No. 240044 00 15 B, EFFECTIVE DATE: DEC. 4, 1986.
- 3) THE OFFSETS FROM BUILDING LINE TO PROPERTY LINE AS SHOWN ON THE PLAT HEREON ARE TO AN ACCURACY OF 1' PLUS OR MINUS (+).

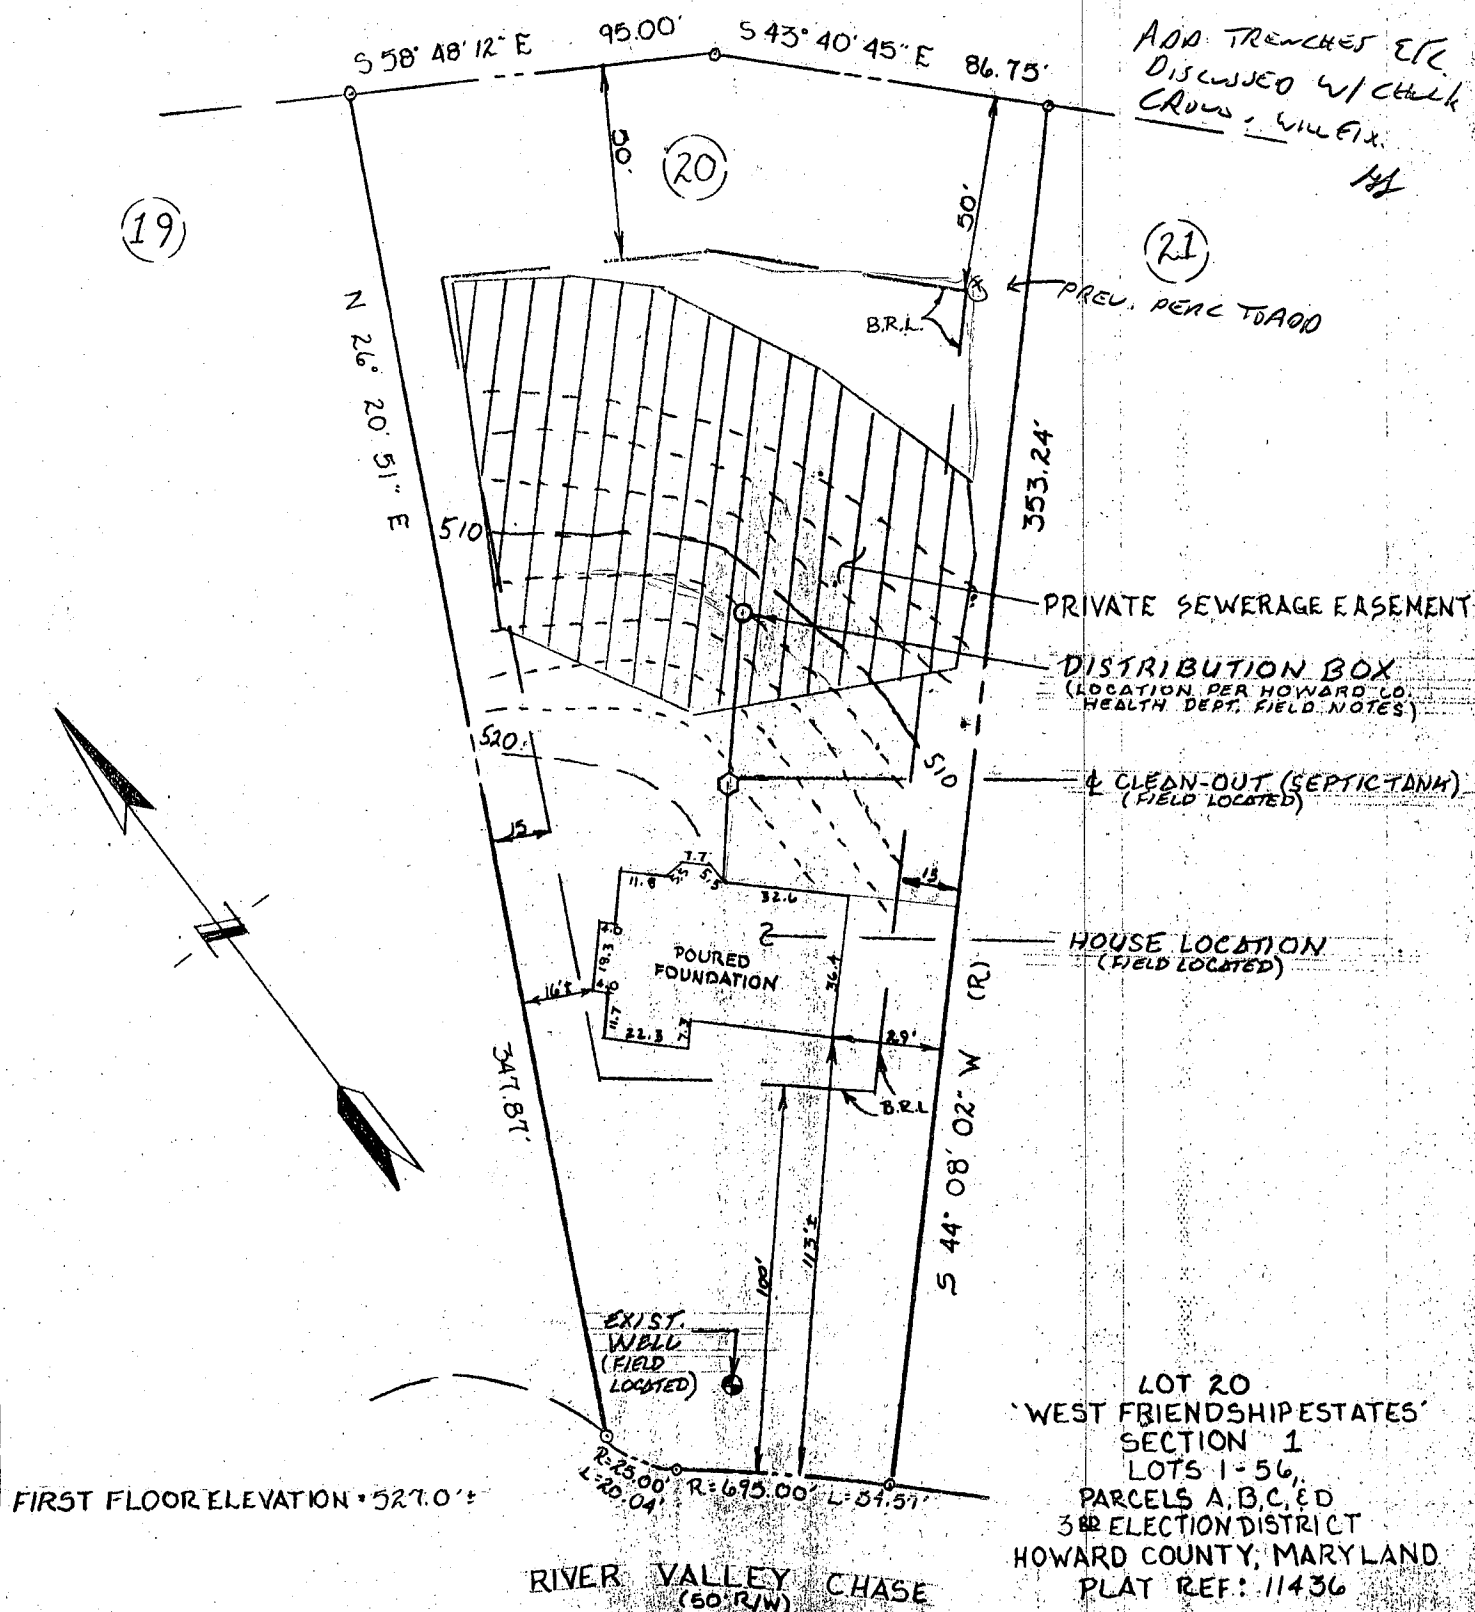

FISHER, COLLINS & CARTER, INC.
CIVIL ENGINEERING CONSULTANTS & LAND SURVEYORS
CENTENNIAL SQUARE OFFICE PARK - 10272 BALTIMORE NATIONAL PIKE
ELLICOTT CITY, MARYLAND 21042
(410) 461-2222

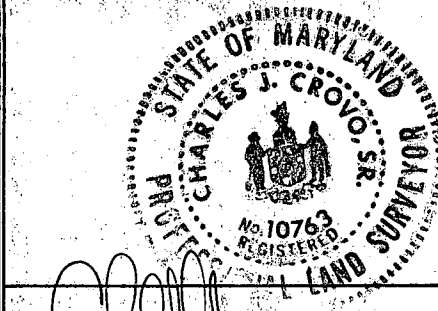

PROFESSIONAL LAND SURVEYOR
REG. # 10763

7/16/96
DATE

HOUSE LOCATION DRAWING

FOUNDATION LOCATION: 7/16/96
FINAL LOCATION:
BOUNDARY SURVEY:

SCALE: 1"=50'
DATE: 7-17-96
DRAWN BY: KEL
CHECKED BY: MLR
PROJECT No.: 61048


6-19-96

SEPTIC INSTALLATION DRAWING
COMPILED FROM INSTALLATION NOTES
AND FIELD MEASUREMENTS
MADE 6-18-96

Rock

RE-PERC

TRENCH INSTALLATION
TRENCH NOT USABLE

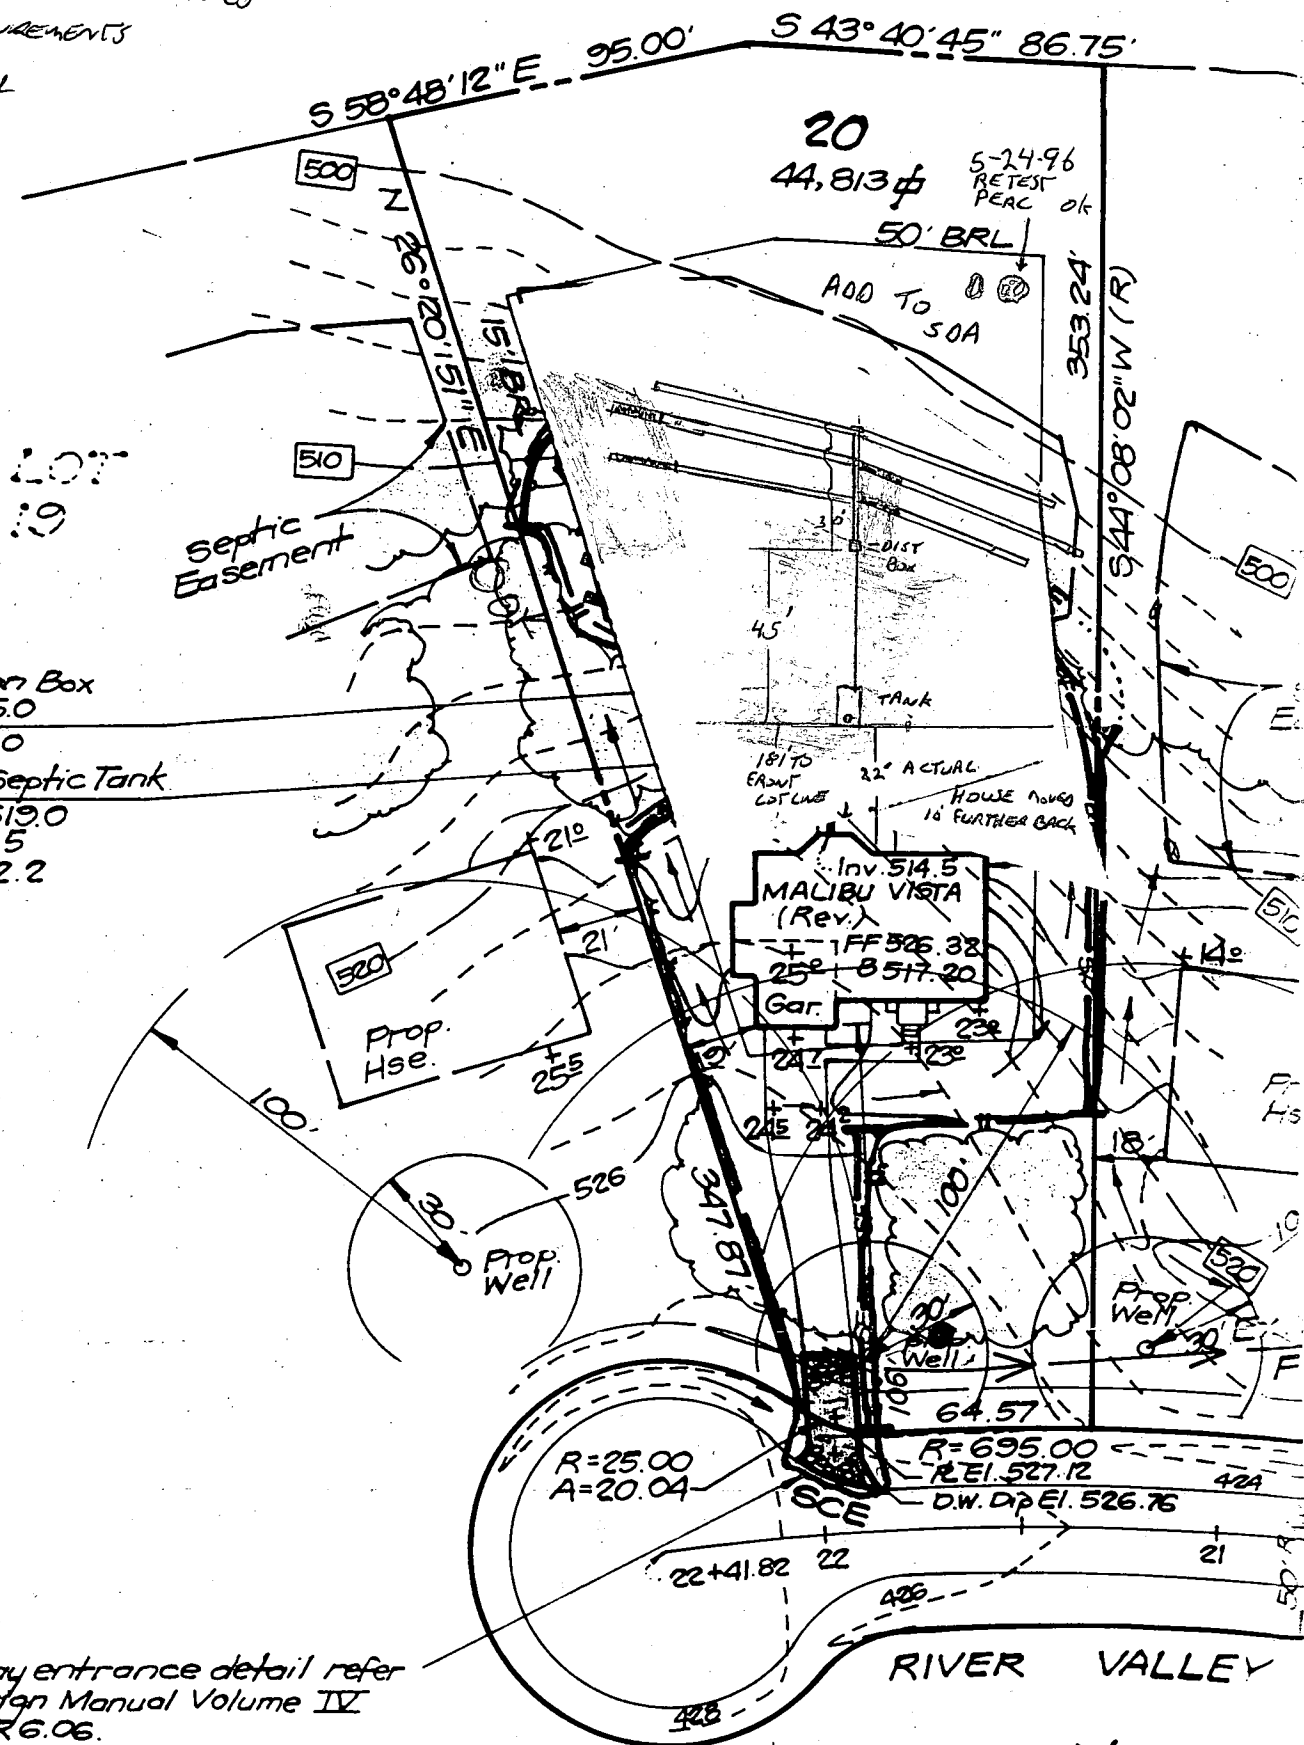

For Driveway entrance detail refer
to Ho. Co. Design Manual Volume IV
Std. Detail R6.06.

NOTE: Grade swale along River Valley
Chase as necessary to provide
positive drainage across driveway
347' LOT LINE

5/30/96

WELL STAKE
APPROX. BAX
ON APPLICANT
SUBMIT TO

[Handwritten signature]
 03.00

5-31-96

143

S 53° 48' 12" E 95.00' S 43° 40' 45" 86.75'

20 TEST PEARLS
44.813¢

50 BRL



353.24
W(R)

Septic
Easement

Distribution Box
Ex. Grd. 515.0
Inv. In 512.0

1250 Gal. Septic Tank
Ex. Grd. 519.0
Inv. In 512.5
Inv. Out 512.2

Inv. 514.5
MALIBU VISTA
(Rev.)

FF 506 38
25e 1 8517 20

24

23

23

Prop.
Well

E.D. As Per
F.M. 25

$R = 25.00$
 $A = 20.04$

R=695.00
REI.527.12

D.W. Dip EI. 526.76

For Driveway entrance detail refer
to Ho. Co. Design Manual Volume IV
Std. Detail R6.06

NOTE: Grade swale along River Valley Chase as necessary to provide positive drainage across driveway.

5/30

WELL FIELD

Checked location
of @ 22:00

347' LONG AND

20' OFF FRONT LOT LINE

48

1) THIS PLAT IS PREPARED FOR THE BENEFIT OF THE CLIENT SIGNING THE HOUSE LOCATION SURVEY APPROVAL FORM INsofar AS IT IS REQUIRED BY A LENDER OR TITLE INSURANCE COMPANY OR ITS AGENTS IN CONNECTION WITH THE CONTEMPLATED TRANSFER, FINANCING OR RE-FINANCING. UNLESS INDICATED AS BEING A BOUNDARY SURVEY, THIS PLAT IS NOT INTENDED FOR USE IN THE ESTABLISHMENT OF PROPERTY LINES AND IS NOT TO BE RELIED UPON FOR THE ESTABLISHMENT OR LOCATIONS OF FENCES, GARAGES, BUILDINGS OR OTHER EXISTING OR FUTURE IMPROVEMENTS. AS A RESULT, THIS PLAT DOES NOT PROVIDE FOR ACCURATE IDENTIFICATION OF PROPERTY LINE, BUT SUCH IDENTIFICATION MAY NOT BE REQUIRED FOR THE TRANSFER OF TITLE OR SECURING FINANCING OR RE-FINANCING.

2) SUBJECT PROPERTY IS SHOWN IN ZONE C ON THE NATIONAL FLOOD INSURANCE PROGRAM FLOOD INSURANCE RATE MAP OF HOWARD COUNTY, MARYLAND, COMMUNITY PANEL No. 240044 00 15 B EFFECTIVE DATE: DEC. 4, 1986.

3) THE OFFSETS FROM BUILDING LINE TO PROPERTY LINE AS SHOWN ON THE PLAT HEREON ARE TO AN ACCURACY OF 1' PLUS OR MINUS (±).

SEPARATION

[illegible]

LOT 20
WEST FRIENDSHIP ESTATES
SECTION 1
LOTS 1-56
PARCELS A, B, C, D
3RD ELECTION DISTRICT
HOWARD COUNTY, MARYLAND
PLAT REF: 11436

PROFESSIONAL LAND SURVEYOR
REG. # 12345

SCALE: 1:250
DATE: 2/3/97
DRAWN BY: CEL
CHECKED BY: MRP
PROJECT: 10/10/96 (10/10/96)

HOWARD COUNTY
PERMIT APPLICATION

PERMIT NUMBER

300119876

Building Address 3184 River Valley Chase
West Friendship, MD 21094
Suite/Apt. #: _____ SDP/NP/Petition #: _____
Census Tract 6030 Subdivision West Friendship
Section _____ Area _____ Lot 20
Tax Map 15 Parcel 12 Grid 21
Zoning R2000 Map Coordinates 9106 Lot size _____

Property Owner's Name _____
Address _____
City _____ State _____ Zip Code _____
Home Phone _____ Work Phone _____
Applicant's Name & Mailing Address, (if other than stated hereon):

Phone _____ Fax _____

Existing Use SFO
Proposed Use SFO w/ Driveway
Estimated Construction Cost \$ 11,000
Description of Work 2 Level Deck
29 X 16 20 X 6

Contractor Company OWNED
Contact Person _____
Address _____
City _____ State _____ Zip Code _____
License No. _____
Phone _____ Fax _____

Occupant or Tenant _____
Contact Name Shawn
Address _____
City _____ State _____ Zip Code _____
Phone _____ Fax _____

Engineer or Architect Company _____
Contact Person _____
Address _____
City _____ State _____ Zip Code _____
Phone _____ Fax _____

BUILDING DESCRIPTION - COMMERCIAL

Building Characteristics	Utilities
Height: _____	Water Supply: _____ Public _____ Private _____
No. of stories: _____	Sewage Disposal: _____ Public _____ Private _____
Gross area, sq. ft. per floor: _____	Electric Yes ☐ No ☐ Gas Yes ☐ No ☐
Use group: _____	Heating System: _____ Electric ☐ Oil ☐ Natural Gas ☐ Propane Gas ☐
Construction type: _____ Reinforced Concrete _____ Structural Steel _____ Masonry _____ Wood Frame _____ State Certified Modular _____	Sprinkler system: N/A ☐ Full _____ Partial _____ Other Suppression _____ # of Heads _____

BUILDING DESCRIPTION - RESIDENTIAL

Building Characteristics	Utilities
SF Dwelling ☒ SF Townhouse ☐ Depth _____ Width _____	Water Supply: _____ Public _____ Private _____
1st floor: _____	Sewage Disposal: _____ Public _____ Private _____
2nd floor: _____	Electric Yes ☐ No ☐ Gas Yes ☐ No ☐
Basement: _____	Heating System: _____ Electric ☐ Oil ☐ Natural Gas ☐ Propane Gas ☐
Finished Basement ☐ Unfinished Basement ☐ Crawl space ☐ Slab on Grade ☐	Sprinkler system: N/A ☐ NFA #13D _____ NFA #13R _____ Other: _____
No. of Bedrooms _____	
Multi-family dwellings: No. of efficiency units: _____ No. of 1 BR units: _____ No. of 2 BR units: _____ No. of 3 BR units: _____	
Other Structure: _____ Dimensions: _____ Footings: _____ Roof: _____	
State Certified Modular Manufactured Home _____	

THE UNDERSIGNED HEREBY CERTIFIES AND AGREES AS FOLLOWS: (1) THAT HE/SHE IS AUTHORIZED TO MAKE THIS APPLICATION; (2) THAT THE INFORMATION IS CORRECT; (3) THAT HE/SHE WILL COMPLY WITH ALL REGULATIONS OF HOWARD COUNTY WHICH ARE APPLICABLE THERETO; (4) THAT HE/SHE WILL PERFORM NO WORK ON THE ABOVE REFERENCED PROPERTY NOT SPECIFICALLY DESCRIBED IN THIS APPLICATION; (5) THAT HE/SHE GRANTS COUNTY OFFICIALS THE RIGHT TO ENTER ONTO THIS PROPERTY FOR THE PURPOSE OF INSPECTING THE WORK PERMITTED AND POSTING NOTICES.

Applicant's Signature _____
Title/Company _____

Print Name _____
Date _____

Checks payable to: DIRECTOR OF FINANCE OF HOWARD COUNTY

PLEASE WRITE NEATLY AND LEGIBLY.

FOR OFFICE USE ONLY

AGENCY _____ DATE _____ SIGNATURE APPROVAL _____
Land Development DPZ _____
State Highways _____
Building Official _____
Dev. Engineering DPZ _____
Health _____
Fire Protection _____
Is Sediment Control approval required prior to issuance?
YES ☐ NO ☐

DPZ SETBACK INFORMATION
Front: _____
Rear: _____
Side: _____
Side St.: _____
All minimum setbacks met? YES ☐ NO ☐
Is Entrance Permit required? YES ☐ NO ☐
Historic District? YES ☐ NO ☐
Lot Coverage for New Town Zone _____
SDP/Red-line approval date _____

PROPERTY ID# 16637
Filing fee \$ _____
Permit fee \$ _____
Excise tax \$ _____
Sub-total paid \$ _____
Add'l permit fee \$ _____
TOTAL FEES \$ _____
Balance due \$ _____
Check # 1058
Validation # _____

CONTINGENCY CONSTRUCTION START: ☐
ONE STOP SHOP: ☐

Accepted by _____

Distribution of Copies: White: Building Official Green: LDD, DPZ Yellow: DED, DPZ Pink: Health Gold: SHA