

PERMIT

SEWAGE DISPOSAL SYSTEM

DEPARTMENT OF HEALTH AND MENTAL HYGIENE

HOWARD COUNTY HEALTH DEPARTMENT

BUREAU OF ENVIRONMENTAL HEALTH

~~XXXXXXX~~ 313-2640

INDEXED

P 49560

A 49164

DISTRICT 4th

DATE 8/26/93

DATE SYSTEM APPROVED 10/21/93

INSPECTOR ARM

Lauer Construction, Inc. South Carroll Backhoe IS PERMITTED TO INSTALL X ALTER

ADDRESS 132 Mayo Road, Edgewater, Maryland 21037 PHONE 269-8044 875-4197

SUBDIVISION Gaithers Sideling LOT 15 ROAD 614 Sideling Court

PROPERTY OWNER Christopher T. McCarthy

ADDRESS

SEPTIC TANK CAPACITY 1000 GALLONS

NUMBER OF BEDROOMS 3

180 SQUARE FEET PER BEDROOM

LINEAR FEET OF TRENCH REQUIRED 180

TRENCHES - Trench to be 3 feet wide. Inlet 2½ feet below original grade. Bottom maximum depth 4 feet below original grade. Effective area begins at 2½ feet below original grade. 1½ feet of stone below distribution pipe.

LOCATION - From the end of the pipestem access, place the distribution box 210 feet down the left (595') lot line and 105 feet off that lot line. Run trenches along contour in both directions.

NOTES - No trench to exceed 100 feet in length. Provide 6" - 8" diameter cleanout and cap to grade or above on septic tank. OK MR 8/25/93

PLANS APPROVED BY C. Williams DATE 8/23/93

COVER NO WORK UNTIL INSPECTED AND APPROVED

NEITHER THE HOWARD COUNTY COUNCIL NOR THE HEALTH DEPARTMENT IS RESPONSIBLE FOR THE SUCCESSFUL OPERATION OF ANY SYSTEM

NOTE: CLEANOUT REQUIRED EVERY 70 FEET OF SEWER LINE AND/OR AT 90° SWEEPS IN LINES FROM HOUSE TO DRAIN FIELDS, 90° ELBOWS NOT ACCEPTABLE.

NOTE: ALL PARTS OF SEPTIC SYSTEMS (I.E. TANK, DISTRIBUTION BOX TRENCHES) TO BE 100 FEET FROM WELL (UNLESS OTHERWISE SPECIFICALLY AUTHORIZED)

NOTE: IF DEEP TRENCH(ES) ARE USED CALL FOR INSPECTION BEFORE AND AFTER PLACING GRAVEL IN TRENCH(ES)

NOTE: NO DRY WELL SHALL EXCEED 15 FOOT IN DIAMETER NO ABSORPTION TRENCH TO EXCEED 100 FEET IN LENGTH

NOTE: ALL PIPE FROM HOUSE TO SEPTIC TANK MUST BE CAST IRON OR SCHEDULE 35/40 PVC OR ABS

PERMIT VOID AFTER TWO YEARS

NOTE: INSTALL STAND PIPE ON SEPTIC TANK AND DRY WELL STAND PIPES MUST BE 6 INCHES IN DIAMETER CAST IRON. CONCRETE OR TERRA COTTA OR PVA OR ABS ACCEPTED. IF TOP OF SEPTIC TANK IS DEEPER THAN 3 FEET. MANHOLE TO GRADE REQUIRED.

NOTE: DISTRIBUTION BOXES MUST HAVE BAFFLES


***INSTALLER IS RESPONSIBLE FOR OBTAINING FINAL APPROVAL ON THIS PERMIT**

BUDG. PERMIT SIGNED

AND RETURNED 4/18/97

Final # B70105019-dub

A 49164

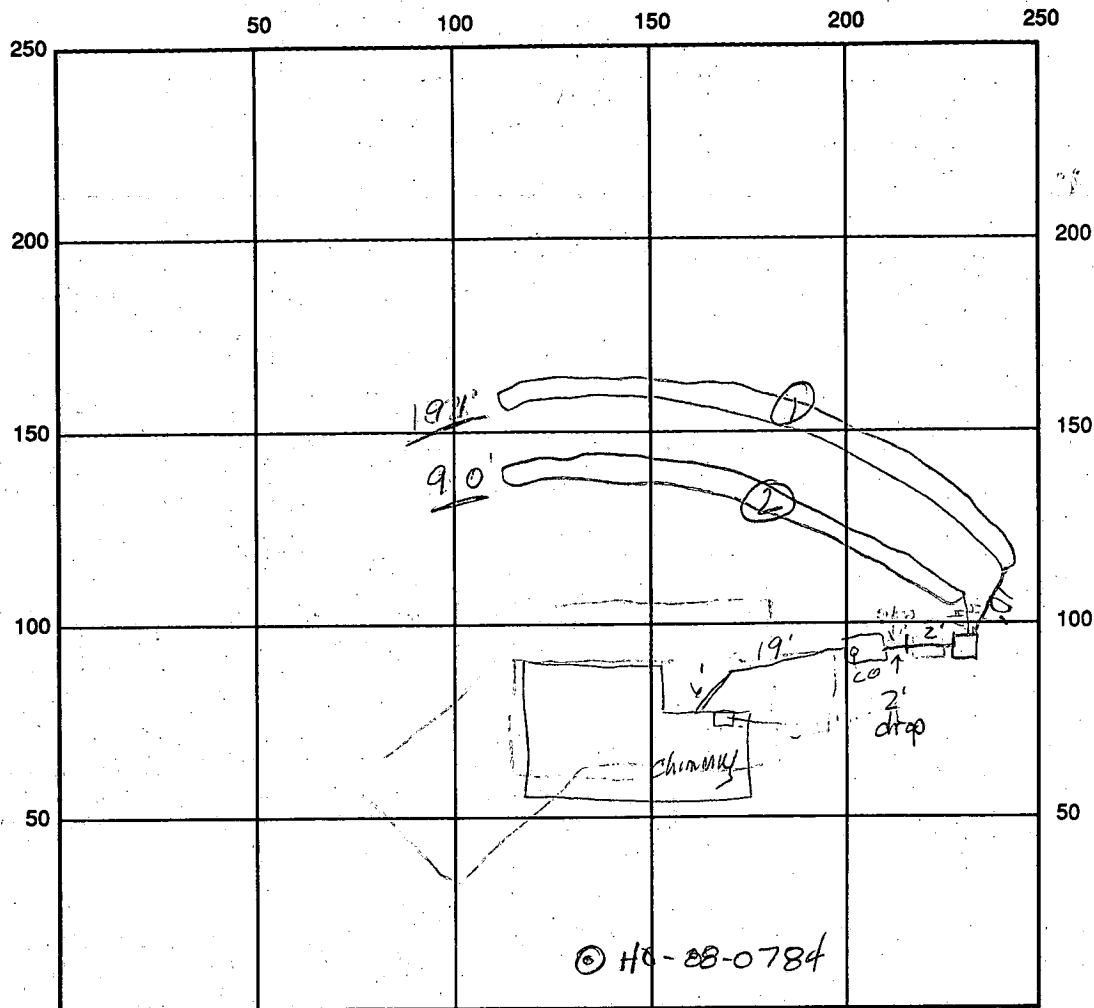

INDICATE NORTH - NAME ADJOINING ROADWAY AS BASE LINE

SEPTIC TANK LEVEL OK CLEANOUTS OK 1

DISTRIBUTION BOX LEVEL OK

DRAIN FIELD/TITLE DEPTH 4 FT. TRENCH WIDTH 0.21 FT. INLET DEPTH 2 1/2 FT.

EFFECTIVE GRAVEL DEPTH 3 FT. TOTAL LENGTH 290 FT. 181 ft²

NUMBER OF TRENCHES 2 ONE-SIDEWALL/BOTTOM AREA 543 SQ. FT.

DRYWALL INSIDE DIAMETER FT. EFFECTIVE DEPTH BELOW INLET FT.

ABSORBENT AREA SQ. FT.

REMARKS: 10/21/93 OK to cover final - put baffle in PB and seal all lines. ARM

10/21 WPI. No line but pitless adaptor OK and trench depth. ARM

DATE SYSTEM APPROVED 10/21/93 INSPECTOR Andy McMillen

APPROVED: FOR PRIVATE WATER AND PRIVATE
SEWERAGE SYSTEMS.
HOWARD COUNTY HEALTH DEPARTMENT.

REC'D
6/15/93 (CW)

Joseph B. Lauer
HOWARD COUNTY HEALTH OFFICER

6-17-93
DATE (CW)

THIS AREA DESIGNATED A PRIVATE SEWAGE EASEMENT OF APPROX 10,000 SQ. FT. AS REQUIRED BY THE MARYLAND STATE DEPARTMENT OF HEALTH AND MENTAL HYGIENE FOR INDIVIDUAL SEWAGE DISPOSAL, IMPROVEMENTS OF ANY NATURE IN THIS AREA ARE RESTRICTED UNTIL PUBLIC SEWERAGE IS AVAILABLE AND SERVICING ANY RESIDENTIAL STRUCTURES CONSTRUCTED ON THESE BUILDING SITES. THESE EASEMENTS SHALL BECOME NULL AND VOID UPON CONNECTION TO A PUBLIC SEWAGE SYSTEM. THE COUNTY HEALTH OFFICER SHALL HAVE THE AUTHORITY TO GRANT VARIANCES FOR ENCROACHMENTS INTO THE PRIVATE SEWER EASEMENT. RECORDATION OF A MODIFIED SEWER EASEMENT SHALL NOT BE NECESSARY.

ALL PERCOLATION TEST HOLES SHOWN HEREON HAVE BEEN FIELD LOCATED AND SHOWN THUS (●)



APPLICATION

PERCOLATION TESTING

A 49164
P _____

HOWARD COUNTY HEALTH DEPARTMENT
BUREAU OF ENVIRONMENTAL HEALTH
3525-H ELLICOTT MILLS DRIVE/ELLICOTT CITY, MARYLAND 21043
TELEPHONE: 313-2640

Proposal TO
REVISE RECORD
SEWAGE DISPOSAL
EASEMENT.

DISTRICT _____
DATE _____

TO: THE COUNTY HEALTH OFFICER
ELLICOTT CITY, MARYLAND

I HEREBY APPLY FOR THE NECESSARY TEST PRIOR TO APPLICATION FOR PERMIT TO CONSTRUCT (OR RECONSTRUCT) A SEWAGE DISPOSAL SYSTEM.

PROPERTY OWNER CHRISTOPHER T. MCCARTHY

ADDRESS 1151 KENFIELD DR. PHONE (410) 536-4000 (W)

AGENT OR PROSPECTIVE BUYER N/A

ADDRESS _____ PHONE _____

PROPERTY LOCATION:

SUBDIVISION GAITHER SIDELING LOT NO. 15

ROAD AND DESCRIPTION (614 Sideling Court)

TAX MAP _____ PARCEL # _____

SIZE OF LOT _____ TYPE BLDG. _____
(SINGLE FAMILY DWELLING OR COMMERCIAL)

BLDG. PERMIT SIGNED
AND RETURNED 6/30/93

Serial # 9995-SFD-3Bim.

THE SYSTEM INSTALLED UNDER THIS APPLICATION IS ACCEPTABLE ONLY UNTIL PUBLIC FACILITIES BECOME AVAILABLE. I FULLY UNDERSTAND THE
FEE CONNECTED WITH THE FILING OF THIS PERC TEST APPLICATION IS NON-REFUNDABLE UNDER ANY CIRCUMSTANCES. I ALSO AGREE TO
COMPLY WITH ALL M.O.S.H.A. REQUIREMENTS IN TESTING THIS LOT.

(SIGNATURE OF APPLICANT)

APPROVED BY _____ FOR _____ DATE _____

DISAPPROVED BY _____ FOR _____ DATE _____

HOLD PENDING FURTHER TESTS _____

REASONS FOR REJECTION OR HOLDING REVISED PERC PLAT ✓

PERCOLATION TEST PLAT/PRELIMINARY PLAT - TITLE OR I.D. # ✓ 516265 DATE 6/17/93

SITE DEVELOPMENT PLAN/FINAL PLAT - TITLE OR I.D. # _____ DATE _____

THIS IS NOT A PERMIT

049164


COUNTY #

SOIL PROFILE

ORANGE
CLAY
LOAM
3'
SAND
LOAM
1 1/2'
FLINT
ROCK
8'

ORANGE
CLAY
LOAM
3'
SAND
LOAM
8' - Rock
BOTTOM

ORANGE
CLAY
LOAM
3'
SAND
LOAM
20%
ISOLATED
ROCK
9' - Rock
BOTTOM

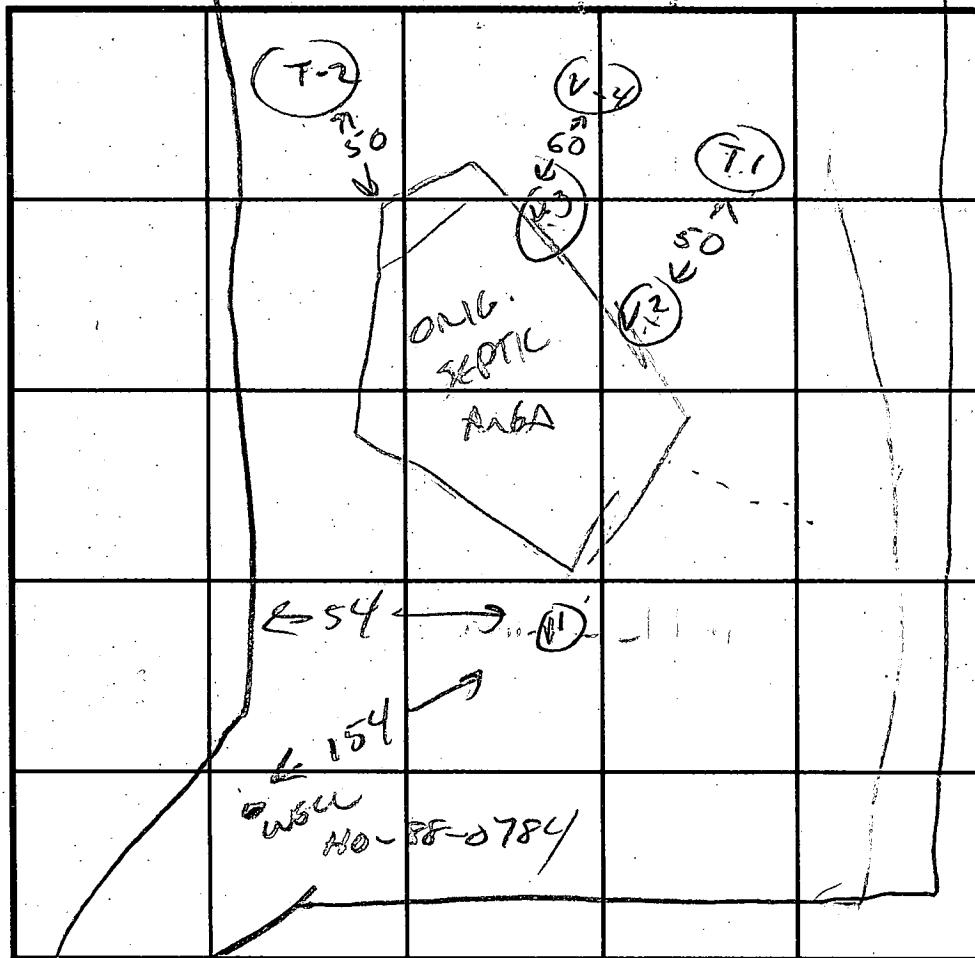

V-4
SOIL PROFILE
0' TOP
SOIL
2' SAND
LOAM
6' 20%
ROCK
8' ROCK
BOTTOM

DATE	TEST NO.	DEPTH	PRE-WET START STOP	TEST - 1" DROP START STOP	TIME
5/10/93	V-1	SAME LOCATION AS OLD TEST HOLE	- FAILS	EXCESS ROCK AT 5'	(FAIL)
	V-2	SAME LOCATION AS OLD TEST HOLE	- OK	3-8'	(OK)
	V-3	SAME LOCATION AS OLD TEST HOLE	- OK FOR	SHALLOW 3-8'	(OK)
	T-1	3/8	VIS OK	SAND LOAM 3-8'	Rock BOTTOM (OK)
	T-2	FAILS	- EXCESS ROCK AT 5'		(FAIL)
6/1/93	V-4	3/8	7/12 VIS OK	7/13 SAND LOAM 3-8'	7/15 Rock BOTTOM (OK)

REMARKS
TYPE OF SOIL SANDY/DECOMPOSED SANDSTONE
TESTED BY CWILLIAMS ALSO PRESENT McCAATHY BUREAU
TRENCH DESIGN DATA: AVERAGE PERCOLATION TIME 3 MIN TRENCH WIDTH 3'
INLET DEPTH 2' MAXIMUM BOTTOM DEPTH 4' SQ. FT./BEDROOM 180

APPLICATION

PERCOLATION TESTING

A 37894

P _____

HOWARD COUNTY HEALTH DEPARTMENT
BUREAU OF ENVIRONMENTAL HEALTH

P.O. BOX 476 ELLICOTT CITY, MARYLAND 21043
TELEPHONE: 461-9933

DISTRICT _____

DATE _____

TO: THE COUNTY HEALTH OFFICER
ELLICOTT CITY, MARYLAND

I, HEREBY, APPLY FOR THE NECESSARY TEST IN ORDER TO CONSTRUCT (OR RECONSTRUCT) A SEWAGE DISPOSAL SYSTEM.

PROPERTY OWNER Christopher T. McCarthy

ADDRESS _____ PHONE 410-536-4727

PROSPECTIVE BUYER _____

ADDRESS _____ PHONE _____

PROPERTY LOCATION:

SUBDIVISION Gaither Sidelings LOT NO. 15 reperc, see 4

ROAD AND DESCRIPTION 614 Sidelings Court

TAX MAP 4 PARCEL # 31

SIZE OF LOT _____ TYPE BLDG. SFD
(SINGLE FAMILY DWELLING OR COMMERCIAL)

THE SYSTEM INSTALLED UNDER THIS APPLICATION IS ACCEPTABLE ONLY UNTIL PUBLIC FACILITIES BECOME AVAILABLE. I FULLY UNDERSTAND THE FEE CONNECTED WITH THE FILING OF THIS PERC TEST APPLICATION IS NON-REFUNDABLE UNDER ANY CIRCUMSTANCES. I ALSO AGREE TO COMPLY WITH ALL M.O.S.H.A. REQUIREMENTS IN TESTING THIS LOT.

(SIGNATURE OF APPLICANT)

APPROVED BY _____ FOR _____ DATE _____

REJECTED BY _____ FOR _____ DATE _____

HOLD PENDING FURTHER TESTS _____ DATE _____

REASONS FOR REJECTION OR HOLDING Reperc holding pending certified plat approval
and well site availability DEN 6-6-89 Repair to be
SHALLOW 6-28-89 DEN

BLDG. PERMIT SIGNED
AND RETURNED 4/30/93
Seal # 4916-550-3848

THIS IS NOT A PERMIT

A37894

(K)

SOIL PROFILE


0-3.0 Brs sa si
cl lm
3.0-11.5 Gray-
br sa si
lm, little
decomp
rx frags
< 30%
11.5 Bottom

(L)

0-2.0 Rd-br
si cl lm
2.0-12.0 Brs sa
si lm,
some
broken
rock
< 35%
some
structure
at 6.0 ft
12.0 Bottom

(V)

0-5.0 Brs si cl
lm
5.0-12.0 Rd-br
sa si lm,
some
decomp
rx frags
< 10%
12.0 Bottom

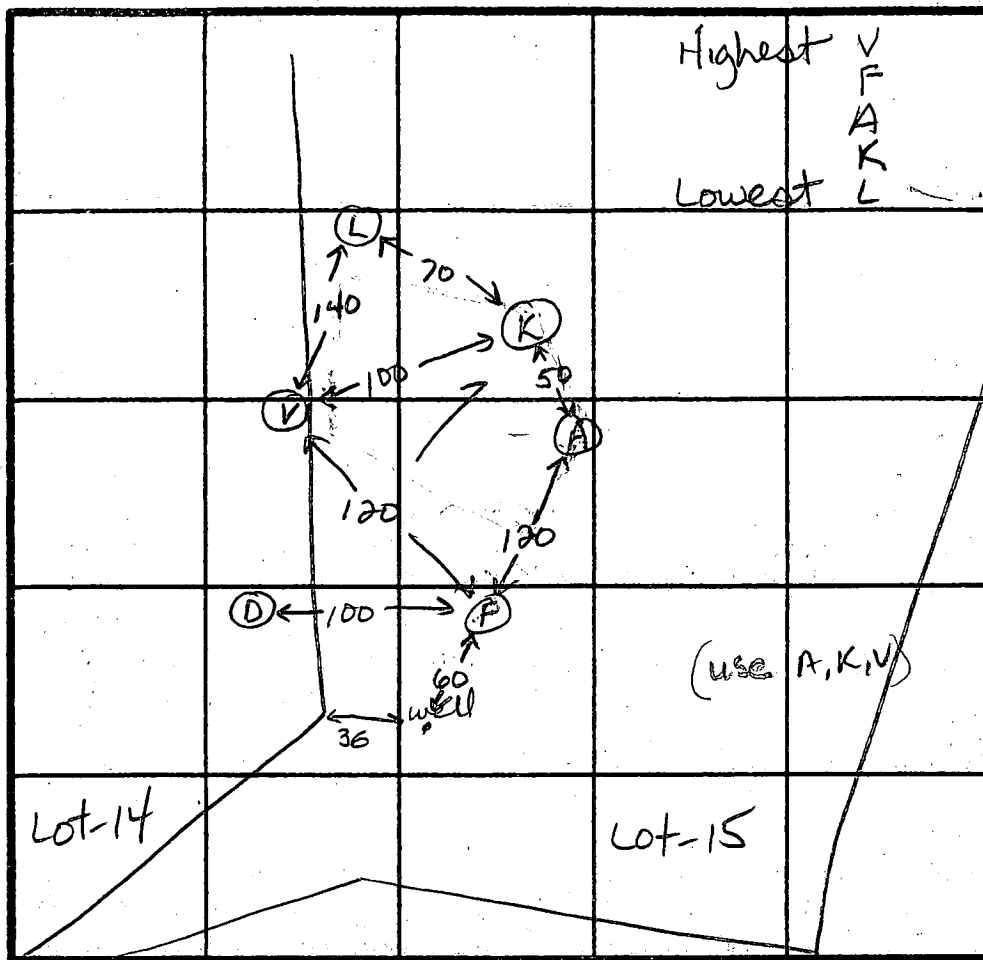

$\bar{x} = 3 \text{ min}$
Inlet = 3.5
Bottom = 7.5
180 sq ft / bdrm
Repair - SHALLOW

INDICATE NORTH - NAME ADJOINING ROADWAY AS BASE LINE.

DATE	TEST NO.	DEPTH	PRE-WET		TEST - 1" DROP		TIME
			START	STOP	START	STOP	
6-6-89	K	4.5 S 8.0 M	3:03 3:01	3:03 3:01	3:03 3:01	3:05 3:03	2min 2min
↓		11.5 D	Bottom (see profile)				ok
↓	L	12.0 V	(some structure at 6.0 ft)				Marginal
NOTES: F is old #4 (11-12-86)							
A is old #3 (11-12-86)							
6-6-89	Lot-14	V	12.0 V	Bottom (see profile)			ok

REMARKS Use new holes V, K, 20 ft uphill from L, old A and 40 ft downhill of old F

TYPE OF SOIL

TESTED BY

Jane E. Nadeau

ALSO PRESENT

Claude Cissel
Phil Mangalitz

APPLICATION

PERCOLATION TESTING

HOWARD COUNTY HEALTH DEPARTMENT
BUREAU OF ENVIRONMENTAL HEALTH
P.O. BOX 476 ELLICOTT CITY, MARYLAND 21043
TELEPHONE: 461-9933

A 37894

P _____

DISTRICT 4

DATE 7/2/86

11/12/86
perc OK'd pending
approved
@

TO: THE COUNTY HEALTH OFFICER
ELLICOTT CITY, MARYLAND

I, HEREBY, APPLY FOR THE NECESSARY TEST IN ORDER TO CONSTRUCT (OR RECONSTRUCT) A SEWAGE DISPOSAL SYSTEM.

PROPERTY OWNER Arthur Dadian

ADDRESS 1846 16th St. NW Wash DC 20009 PHONE 202-332-5364

PROSPECTIVE BUYER Gaither Road Joint Venture

ADDRESS 9 Carissa Ct. Owings Mills, MD 21117 PHONE 301-356-9351

PROPERTY LOCATION: Gaither Sidelings LOT NO. 19

ROAD AND DESCRIPTION Gaither Road + Patapsco River

TAX MAP 4 PARCEL # 31

SIZE OF LOT 3-5 acr TYPE BLDG. SFD
(SINGLE FAMILY DWELLING OR COMMERCIAL)

THE SYSTEM INSTALLED UNDER THIS APPLICATION IS ACCEPTABLE ONLY UNTIL PUBLIC FACILITIES BECOME AVAILABLE. I FULLY UNDERSTAND THE FEE CONNECTED WITH THE FILING OF THIS PERC TEST APPLICATION IS NON-REFUNDABLE UNDER ANY CIRCUMSTANCES. I ALSO AGREE TO COMPLY WITH ALL M.O.S.H.A. REQUIREMENTS IN TESTING THIS LOT.

[Signature]
(SIGNATURE OF APPLICANT)

APPROVED BY B. W. [Signature] FOR deep/shallow DATE 7/2/87

REJECTED BY _____ FOR _____ DATE _____

HOLD PENDING FURTHER TESTS _____ DATE _____

REASONS FOR REJECTION OR HOLDING for field location of holes

THIS IS NOT A PERMIT

9

Similar
to hole
2
W/ 10-15
small
shell
frag
3-4'
↓

12'

② common
hole

red/brown
gaily chunky
clay 3'

Setty Ann


5-9' small frogs
mud skirt
(10%)

1150

brown/orange
silty clay
loam

tan brown
silty mica
lens
4 1/2' - 5-10'
small med
frag. EH

12'D

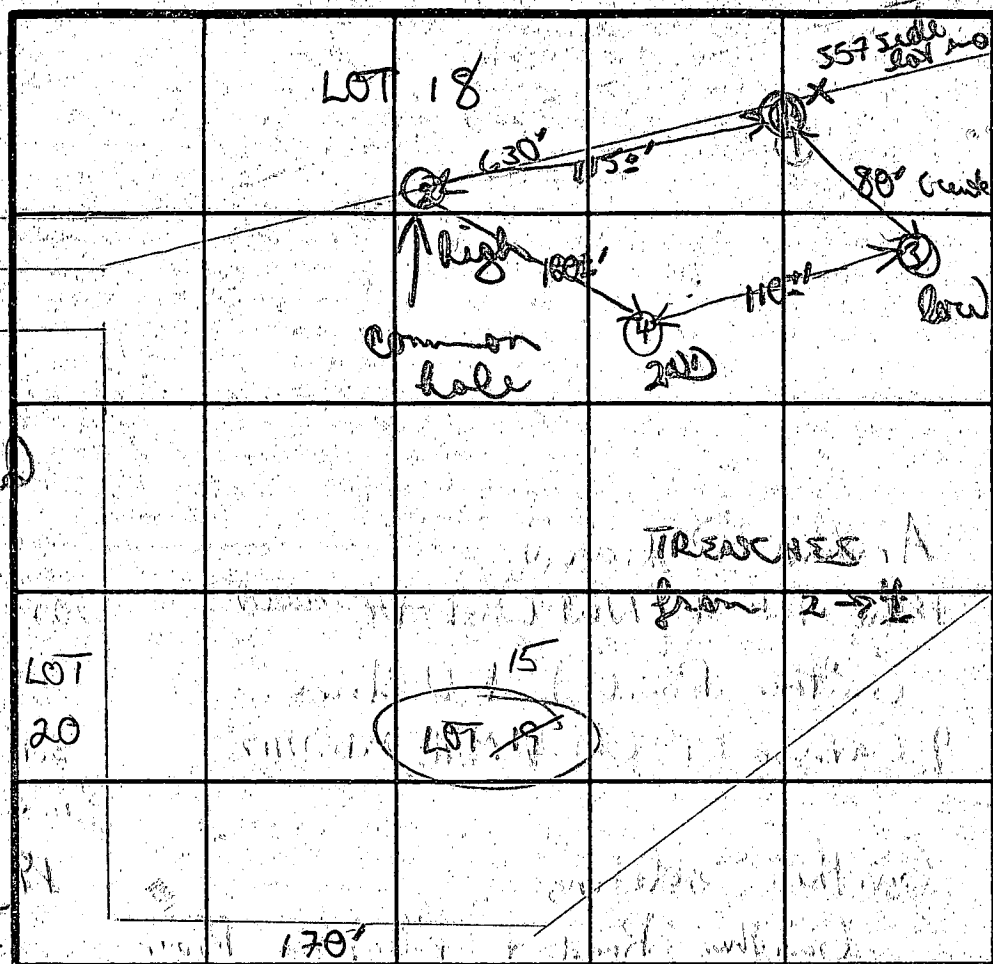

INDICATE NORTH - NAME ADJOINING ROADWAY AS BASE LINE

④

orange brown
silty clay
loam
2 1/2'
silty loam
tan brown
4'-9' sand
frag. mica
shard

✓ done

12th D

DATE	TEST NO.	DEPTH	PRE-WET		TEST - 1" DROP		TIME
			START	STOP	START	STOP	
11/12/86	(2)	4 1/2 S 8' M 11 1/2 D					2 MIN 3 MIN
common	(3)	3 1/2 8' M 12' D	1239	1240	1240	1242	2 MIN 2 MIN
		12' D	bottom (see profile)				
	(3)	3 1/2 S 12' D	1241	1243	1243	1247	4 MIN
		12' D	bottom (see profile)				
	(4)	3 1/2 12' D	1245	1247	1247	1251	4 MIN
		12' D	bottom (see profile)				

REMARKS

TYPE OF SOIL

TESTED BY

perc field adjusted; common hole w/ lot 18

clay/silty loams; silty clay loams w/ 5-10 % shst

B. Wilson

ALSO PRESENT

John Phil Gary

5-26-89 Lot-15


Met w/ Ron Carter re: well sites. All lettered holes were flagged w/ blue and located in relation to well sites & EN.

5° 16' 25" E.

1733.33

RIVER

15

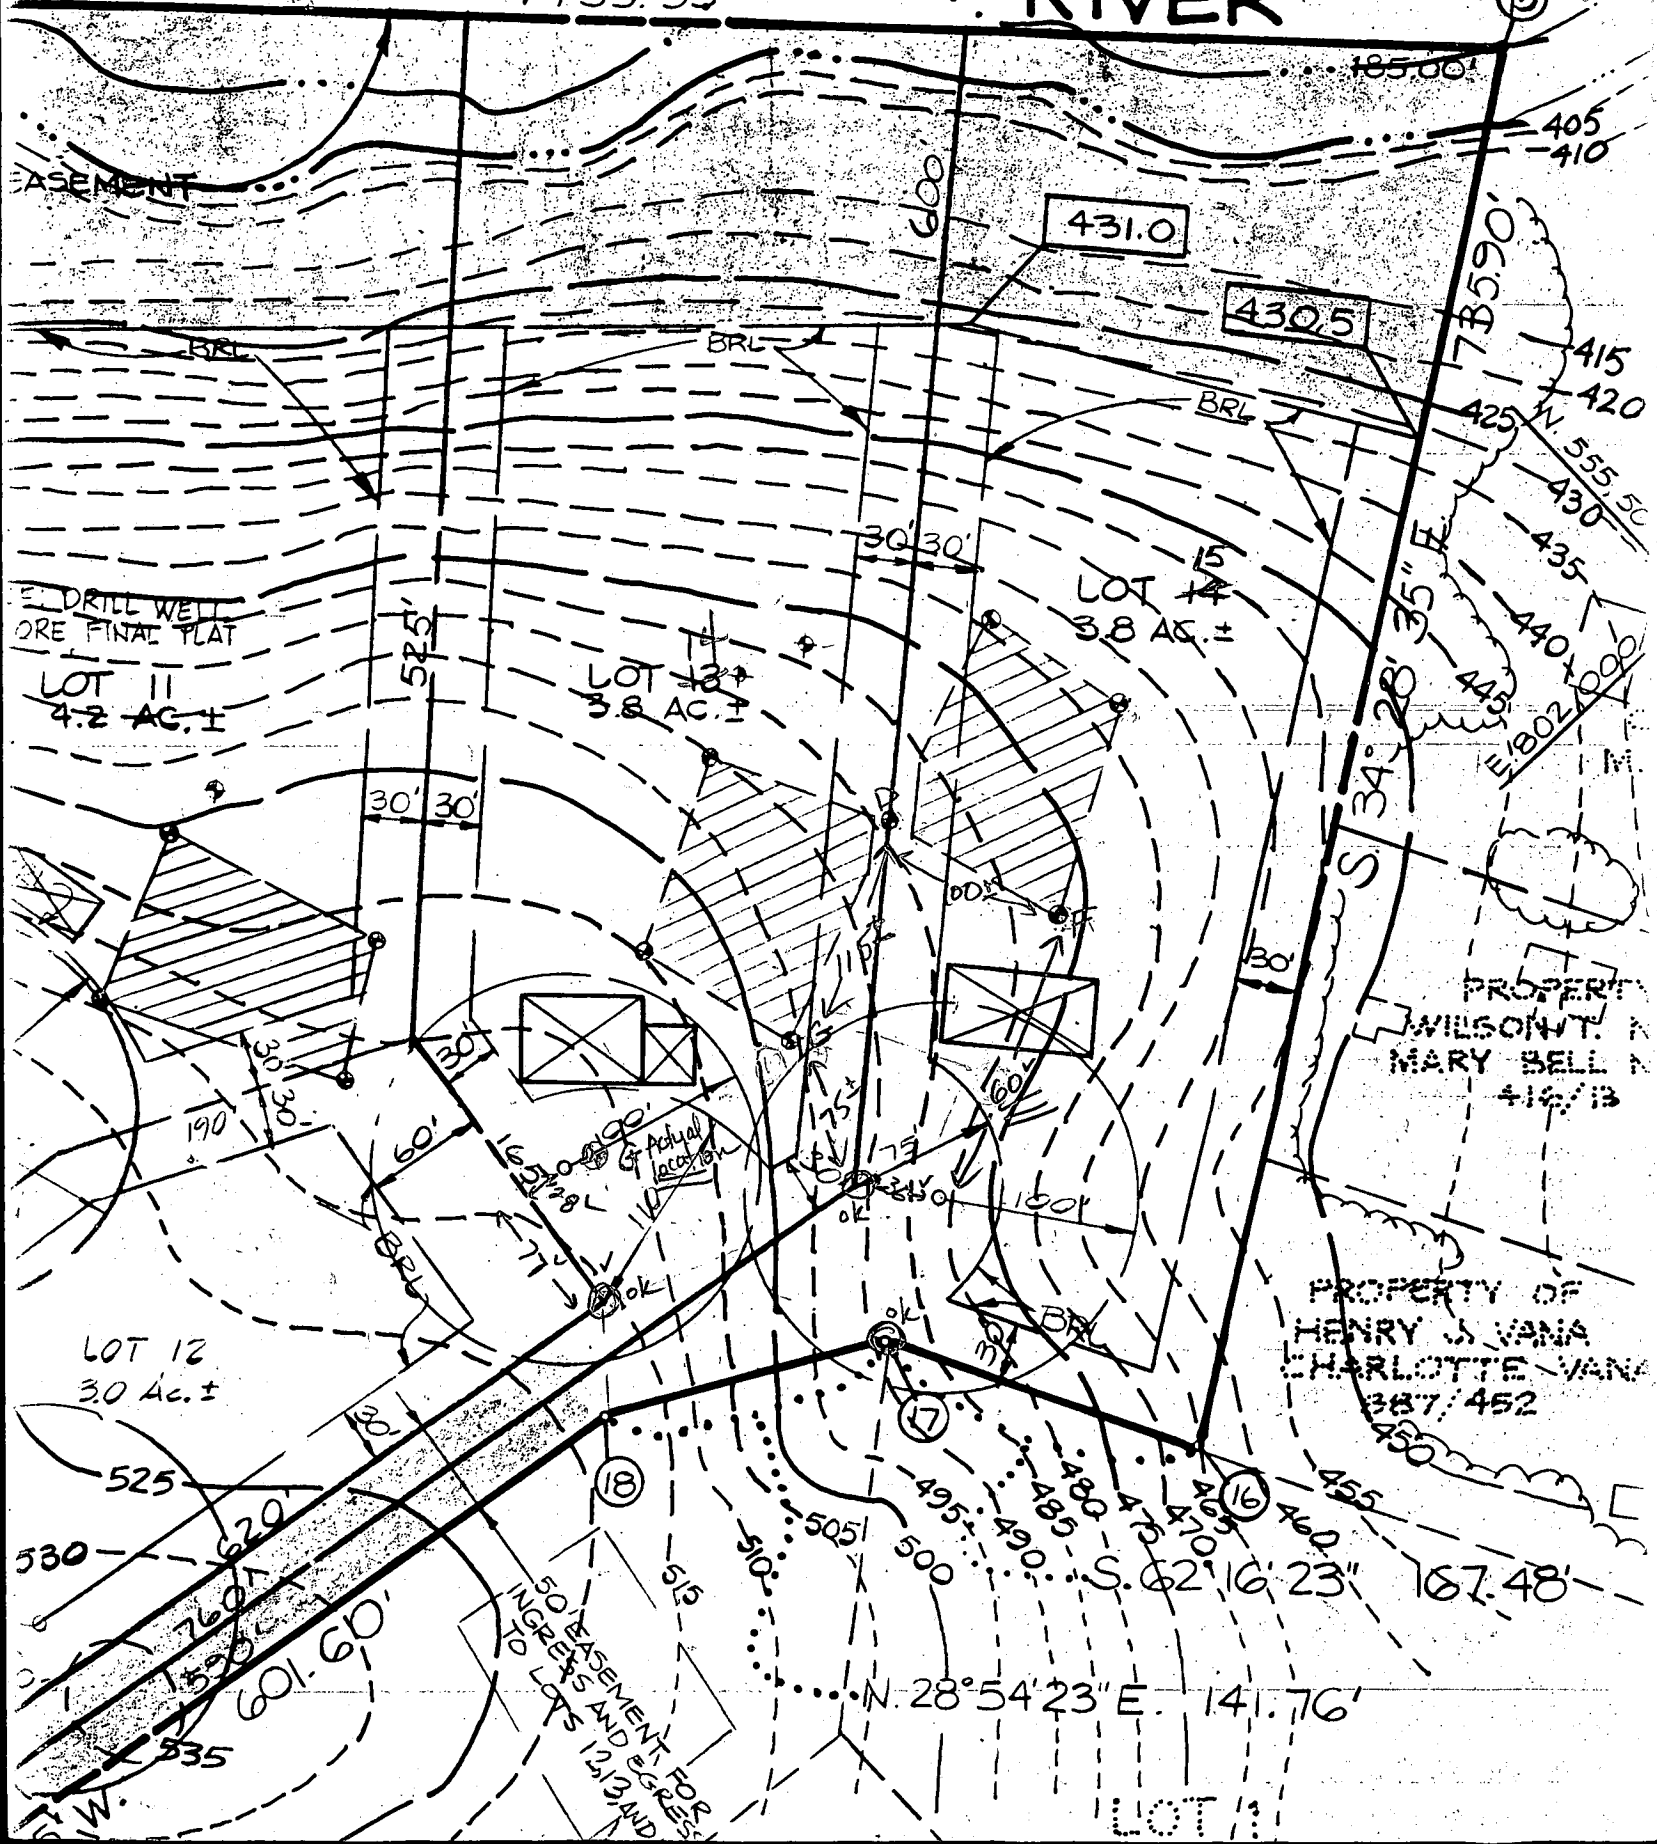

APPROVED: FOR PRIVATE WATER AND PRIVATE
SEWERAGE SYSTEMS.
HOWARD COUNTY HEALTH DEPARTMENT.


HOWARD COUNTY HEALTH OFFICER

DATE

THIS AREA DESIGNATED A PRIVATE SEWAGE EASEMENT OF APPROX. 10,000 SQ. FT. AS REQUIRED BY THE MARYLAND STATE DEPARTMENT OF HEALTH AND MENTAL HYGIENE FOR INDIVIDUAL SEWAGE DISPOSAL, IMPROVEMENTS OF ANY NATURE IN THIS AREA ARE RESTRICTED UNTIL PUBLIC SEWERAGE IS AVAILABLE AND SERVING ANY RESIDENTIAL STRUCTURES CONSTRUCTED ON THESE BUILDING SITES. THESE EASEMENTS SHALL BECOME NULL AND VOID UPON CONNECTION TO A PUBLIC SEWAGE SYSTEM. THE COUNTY HEALTH OFFICER SHALL HAVE THE AUTHORITY TO GRANT VARIANCES FOR ENCROACHMENTS INTO THE PRIVATE SEWER EASEMENT. RECORDATION OF A MODIFIED SEWER EASEMENT SHALL NOT BE NECESSARY.

ALL PERCOLATION TEST HOLES SHOWN HEREON HAVE BEEN FIELD LOCATED AND SHOWN THUS (●)

INV. EL. INTO BOX
471.9
EXIST. EL. AT BOX
474.0
INV. EL. INTO TR.
471.5
EXIST. EL. AT TR.
474.0
TR. LENGTH TO
BE DETER.
SEP. TANK:
INV. EL. IN - 472.3
INV. EL. OUT - 472.0
EX. EL. - 475.0
INV. EL. OUT OF
HOUSE - 472.5
3 BEDROOMS
elevations OK
MR 6/30/93
WELL EL. - 495.0

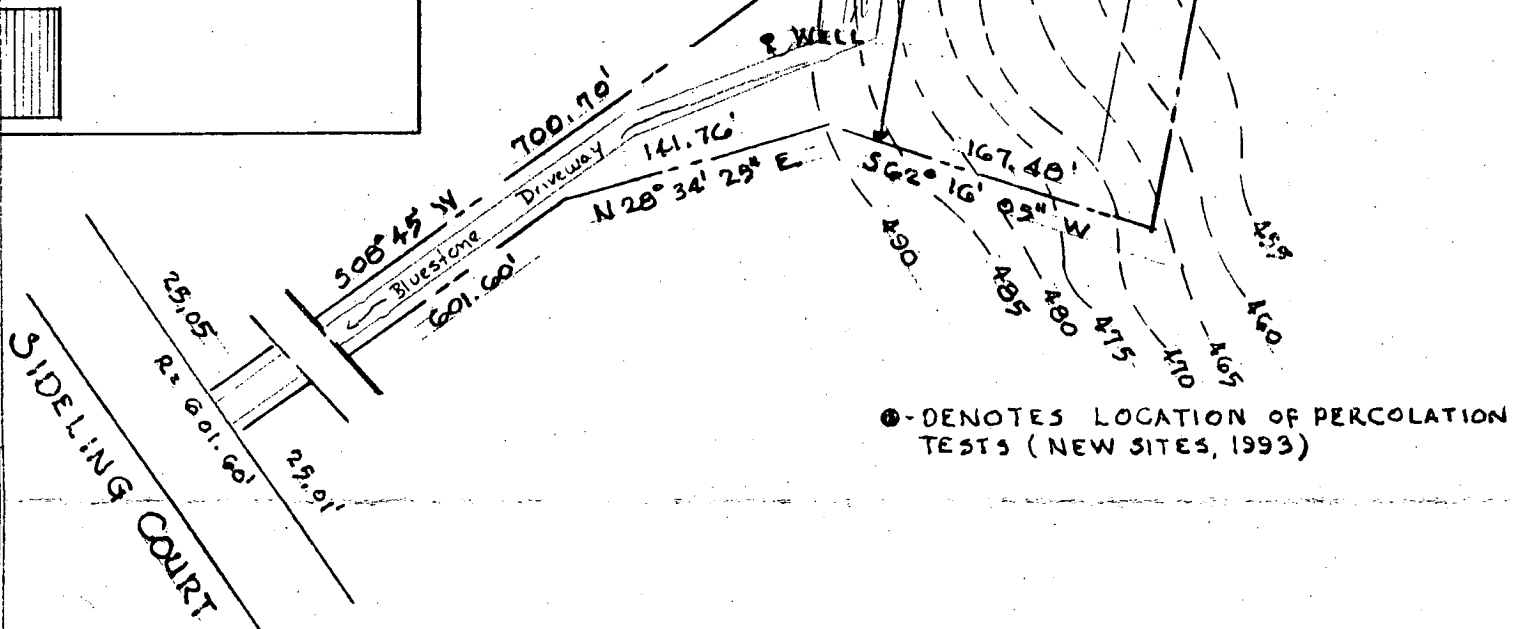

● - DENOTES LOCATION OF PERCOLATION TESTS (NEW SITES, 1993)

PERCOLATION TEST LOCATION PLAN
LOT # 15
GATTHER'S SIDELING
4TH. ELECTION DISTRICT
HOWARD COUNTY MARYLAND
SCALE: 1" = 100' JUNE 4, 1993

I CERTIFY MEASUREMENTS ARE ACCURATE
TO THE BEST OF MY ABILITY:

John B. Lauer
JOHN B. LAUER
6-15-93
DATE

C1 9958 SEQUENCE NO. (DENY USE ONLY)

(THIS NUMBER IS TO BE PUNCHED IN COLS. 3-8 ON ALL CARDS)

STATE OF MARYLAND
WELL COMPLETION REPORT
FILL IN THIS FORM COMPLETELY
PLEASE PRINT OR TYPETHIS REPORT MUST BE SUBMITTED WITHIN
45 DAYS AFTER WELL IS COMPLETED.COUNTY
NUMBER

A37894

STACO USE ONLY
DATE Received

DATE WELL COMPLETED

Depth of Well

PERMIT NO.
FROM "PERMIT TO DRILL WELL"

8 13

171489

22 165 26
(TO NEAREST FOOT)28 29 30 31 32 33 34 35 36 37
140-88-0784OWNER KIMMEL GARY
last name first name
STREET OR RFD Sideling Court TOWN SYKESVILLE
SUBDIVISION CAITHAN SIDELING SECTION LOT 15

WELL LOG

Not required for driven wells

STATE THE KIND OF FORMATIONS
PENETRATED, THEIR COLOR, DEPTH,
THICKNESS AND IF WATER BEARING

DESCRIPTION (Use additional sheets if needed) FEET Check if water bearing

FROM TO

SAND 0 35
GARY M. H. A rock 35 165 ✓

GROUTING RECORD

WELL HAS BEEN GROUTED (Circle Appropriate Box) yes no
TYPE OF GROUTING MATERIAL

CEMENT CM BENTONITE CLAY BC

NO. OF BAGS 11 NO. OF POUNDS 1034

GALLONS OF WATER 66

DEPTH OF GROUT SEAL (to nearest foot)

from 0 ft. to 34 ft.
(enter 0 if from surface)

CASING RECORD

casing types insert appropriate code below

ST CO
STEEL CONCRETE
PL OT
PLASTIC OTHER

MAIN CASING TYPE Nominal diameter top (main) casing (nearest inch) Total depth of main casing (nearest foot)

5 1 40

OTHER CASING (if used)

diameter inch depth (feet) from to

EACH CASING

screen type or open hole

SCREEN RECORD

insert appropriate code below

ST BR HO
STEEL BRASS OPEN
PL BRONZE HOLE
PLASTIC OTHER

C2

DEPTH (nearest ft.)

1 2 3 100

SLOT SIZE 1 2 3

DIAMETER OF SCREEN (NEAREST INCH)

from to

GRAVEL PACK IF WELL DRILLED WAS FLOWING WELL INSERT F IN BOX 68

OEP USE ONLY (NOT TO BE FILLED IN BY DRILLER)

T (E.R.O.S.) W Q
70 72 74 75 76

TELESCOPE CASING LOG INDICATOR OTHER DATA

C3

PUMPING TEST

HOURS PUMPED (nearest hour) 3

PUMPING RATE (gal. per min. to nearest gal.) 15

METHOD USED TO MEASURE PUMPING RATE Burk

WATER LEVEL (distance from land surface)

BEFORE PUMPING 55

WHEN PUMPING 57

TYPE OF PUMP USED (for test)

A air P piston T turbine

C centrifugal R rotary O other (describe below)

J jet S submersible

PUMP INSTALLED

DRILLER WILL INSTALL PUMP (CIRCLE) (YES or NO) YES NO

IF DRILLER INSTALLS PUMP, THIS SECTION MUST BE COMPLETED FOR ALL WELLS EXCEPT HOME USE

TYPE OF PUMP INSTALLED PLACE (A,C,J,P,R,S,T,O)

IN BOX - SEE ABOVE:

CAPACITY: GALLONS PER MINUTE (to nearest gallon)

PUMP HORSE POWER

PUMP COLUMN LENGTH (nearest ft.)

CASING HEIGHT (circle appropriate box and enter casing height)


+ above - below

LAND SURFACE

(nearest foot)

LOCATION OF WELL ON LOT

SHOW PERMANENT STRUCTURE SUCH AS BUILDING, SEPTIC TANKS, AND/OR LANDMARKS AND INDICATE NOT LESS THAN TWO DISTANCES (MEASUREMENTS TO WELL)

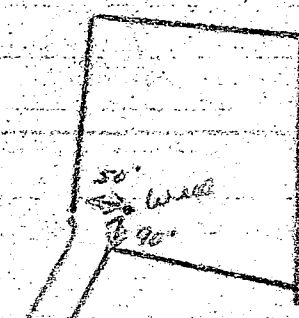CIRCLE APPROPRIATE LETTER
A A WELL WAS ABANDONED AND SEALED WHEN THIS WELL WAS COMPLETED

E ELECTRIC LOG OBTAINED

P TEST WELL CONVERTED TO PRODUCTION WELL


I HEREBY CERTIFY THAT THIS WELL HAS BEEN CONSTRUCTED IN ACCORDANCE WITH COMAR 26.04.04 "WELL CONSTRUCTION" AND IN CONFORMANCE WITH ALL CONDITIONS STATED IN THE ABOVE CAPTIONED PERMIT, AND THAT THE INFORMATION PRESENTED HEREIN IS ACCURATE AND COMPLETE TO THE BEST OF MY KNOWLEDGE.

DRILLERS IDENT. NO. 235

DRILLERS SIGNATURE (MUST MATCH SIGNATURE ON APPLICATION)

SITE SUPERVISOR (sign of driller or journeyman responsible for sitework if different from permittee)

COUNTY

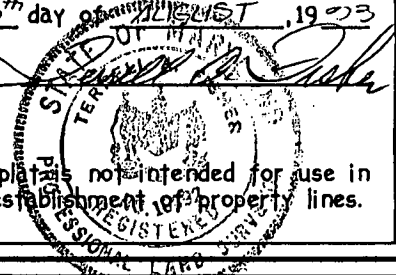

W/O. # 607150