

10/1/98
OPEN TRENCH
ASAP (10-10-98)

PERMIT

SEWAGE DISPOSAL SYSTEM

DEPARTMENT OF HEALTH AND MENTAL HYGIENE

P 571 015-B

A 49482-L

DISTRICT 4th

DATE 9-30-98

DATE SYSTEM APPROVED 10-2-98

INSPECTOR gh

HOWARD COUNTY HEALTH DEPARTMENT

BUREAU OF ENVIRONMENTAL HEALTH

~~XXXXXX~~ 410-313-2640

04-357051

INDEXED

Olen Ketterman IS PERMITTED TO INSTALL X ALTER

ADDRESS 14960 Route 144, Woodbine, Maryland 21797 PHONE 410-442-1336

SUBDIVISION Warfields Grant II LOT 14 ROAD 3104 Spring House Court

PROPERTY OWNER Selfridge Builders

ADDRESS

SEPTIC TANK CAPACITY 1250 GALLONS

NUMBER OF BEDROOMS 4

180 SQUARE FEET PER BEDROOM

LINEAR FEET OF TRENCH REQUIRED 240

SPEC OK: 2' WIDE 5-8' IF NECESSARY
VERY DIFFICULT DIGGING THROUGH CLAY CONTRACTOR
TO CALL FOR OPEN TRENCH INSP. gh

TRENCHES - Trench to be 3 feet wide. Inlet 5 feet below original grade. Bottom maximum depth 7 feet below original grade. Effective area begins at 5 feet below original grade. 2 feet of stone below distribution pipe.

LOCATION - Place distribution box 165 feet up the right (273.07') lot line and 30 feet off that same lot line as seen when facing the lot from Spring House Court. Run trenches on contour toward the back lot line.

NOTES - No trench to exceed 100 feet in length. Provide 6" - 8" diameter cleanout and cap to grade or above on septic tank.

OK KM 7-17-98

PLANS APPROVED BY Amy McMillen DATE 7/10/98

COVER NO WORK UNTIL INSPECTED AND APPROVED

NEITHER THE HOWARD COUNTY COUNCIL NOR THE HEALTH DEPARTMENT IS RESPONSIBLE FOR THE SUCCESSFUL OPERATION OF ANY SYSTEM

NOTE: CLEANOUT REQUIRED EVERY 70 FEET OF SEWER LINE AND/OR AT 90° SWEEPS IN LINES FROM HOUSE TO DRAIN FIELDS. 90° ELBOWS NOT ACCEPTABLE.

NOTE: ALL PARTS OF SEPTIC SYSTEMS (I.E. TANK, DISTRIBUTION BOX TRENCHES) TO BE 100 FEET FROM WELL (UNLESS OTHERWISE SPECIFICALLY AUTHORIZED)

NOTE: IF DEEP TRENCH(ES) ARE USED CALL FOR INSPECTION BEFORE AND AFTER PLACING GRAVEL IN TRENCH(ES)

NOTE: NO DRY WELL SHALL EXCEED 15 FOOT IN DIAMETER NO ABSORPTION TRENCH TO EXCEED 100 FEET IN LENGTH

NOTE: ALL PIPE FROM HOUSE TO SEPTIC TANK MUST BE CAST IRON OR SCHEDULE 35/40 PVC OR ABS

PERMIT VOID AFTER TWO YEARS


NOTE: INSTALL STAND PIPE ON SEPTIC TANK AND DRY WELL STAND PIPES MUST BE 6 INCHES IN DIAMETER CAST IRON. CONCRETE OR TERRA COTTA OR PVA OR ABS ACCEPTED. IF TOP OF SEPTIC TANK IS DEEPER THAN 3 FEET. MANHOLE TO GRADE REQUIRED.

NOTE: DISTRIBUTION BOXES MUST HAVE BAFFLES

*INSTALLER IS RESPONSIBLE FOR OBTAINING FINAL APPROVAL ON THIS PERMIT

49482-L

SPRING HOUSE CT.

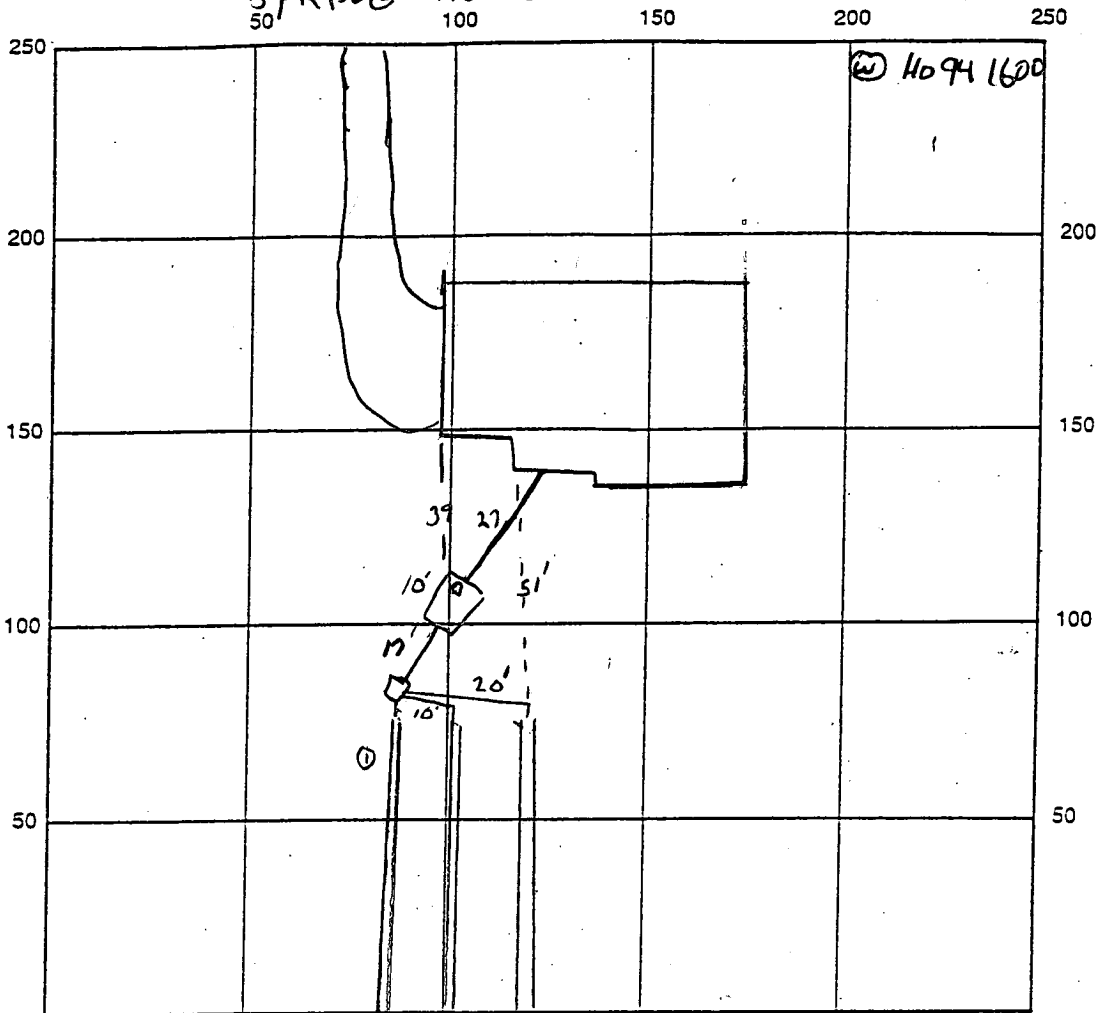

INDICATE NORTH - NAME ADJOINING ROADWAY AS BASE LINE

SEPTIC TANK LEVEL OK - 1250 CLEANOUTS OK - 1 ON ST.

DISTRIBUTION BOX LEVEL OK LARGE CONCRETE BOX

DRAIN FIELD/TITLE DEPTH 8 FT. TRENCH WIDTH 2 FT. INLET DEPTH 5 FT.

EFFECTIVE GRAVEL DEPTH 3 FT. TOTAL LENGTH 81 2/3 FT. = 240

NUMBER OF TRENCHES 3 ONE SIDEWALL/BOTTOM AREA 720 SQ. FT.

DRYWALL INSIDE DIAMETER — FT. EFFECTIVE DEPTH BELOW INLET — FT.

ABSORBENT AREA — SQ. FT.

REMARKS: 10.1.98 OK TO START 1ST TRENCH, CONTINUE OK TO COVER LINES
TO ST 10.1 OK TO START 2ND TRENCH, CONTINUE, CHAL TO APPROX AM. 11
10.2.98 FINAL-COVER ALL WORK

DATE SYSTEM APPROVED 10.2.98 INSPECTOR Alley

HOWARD COUNTY HEALTH DEPARTMENT
Bureau of Environmental Health
3525-N Ellicott Mills Drive
Ellicott City, MD 21043
461-9933

APPLICATION FOR PITLESS ADAPTER, WELL PUMP AND PRESSURE TANK INSTALLATION

New Installation ☒
Replacement ☐

Receipt #
Date 10-14-98

Name of Installer George Baker

Telephone 410-788-3280

License Number 4107883030

Certified Well Driller ☐ Well Driller ☐ Registered Plumber ☒

Name of Property Selfridge Bldg

Telephone 410-992-8282

Subdivision Grant 3rd Lot # 14

Well Tag # 140-84-1600

Site Address SPRING HOUSE CT

Pump

1. Type

- a. Deep well jet ☒
b. Shallow well jet ☐
c. Submersible ☒

Motor

1. Horsepower 3/4
2. RPM 3450
3. Voltage 220
a. 110 ☐
b. 220 ☒

Pitless Adapter

1. Make Martinson
2. Model # 810K
3. Depth 48"

2. Make Meyco

3. Model # 52322-578P

4. Capacity 8 GPM

5. Pump exceeds well capacity Yes ☒ No ☐

6. If Yes, is low pressure cutoff switch installed? Yes ☒ No ☐

7. What methods are used to protect the pump and electrical wiring from vibrations? Torque arrestors ☒ Cable guards ☒ Other ☐

Tank

1. Capacity 1100 gal

2. Pressure relief valve? yes

Piping

1. Type 1/2" black pipe
2. Size 1/2"
3. NSF and/or BOCA Code approved ☐
4. Depth of supply line 42"

Well data

1. Depth 340 ft.
2. Yield 3 GPM
3. Static water level 340 ft.
4. Will water supply be disinfected by installer? yes

10/19/98 NO INSP FOR CONDUIT (MR)

10/16/98 LINE OK, CONDUIT NEEDED per ALM

I understand that it is my responsibility to notify the Howard County Health Department when the installation is ready for inspection (otherwise this permit is null and void).

All information given above is true to the best of my knowledge.

Signature of Applicant: George Baker

Date: 10-14-98

Note: A sticker indicating approval/status of the installation will be placed on the well casing at the time of the inspection.

Total linear feet of trench
required 240 feet


Width of trench(es) 3.0 feet

Depth of trench(es) 7.0 feet

Depth of stone required below
distribution pipe 2.0 feet

Approved Septic System Plan
Howard County Health Department

Amy McMill 7/10/98
Signature Date

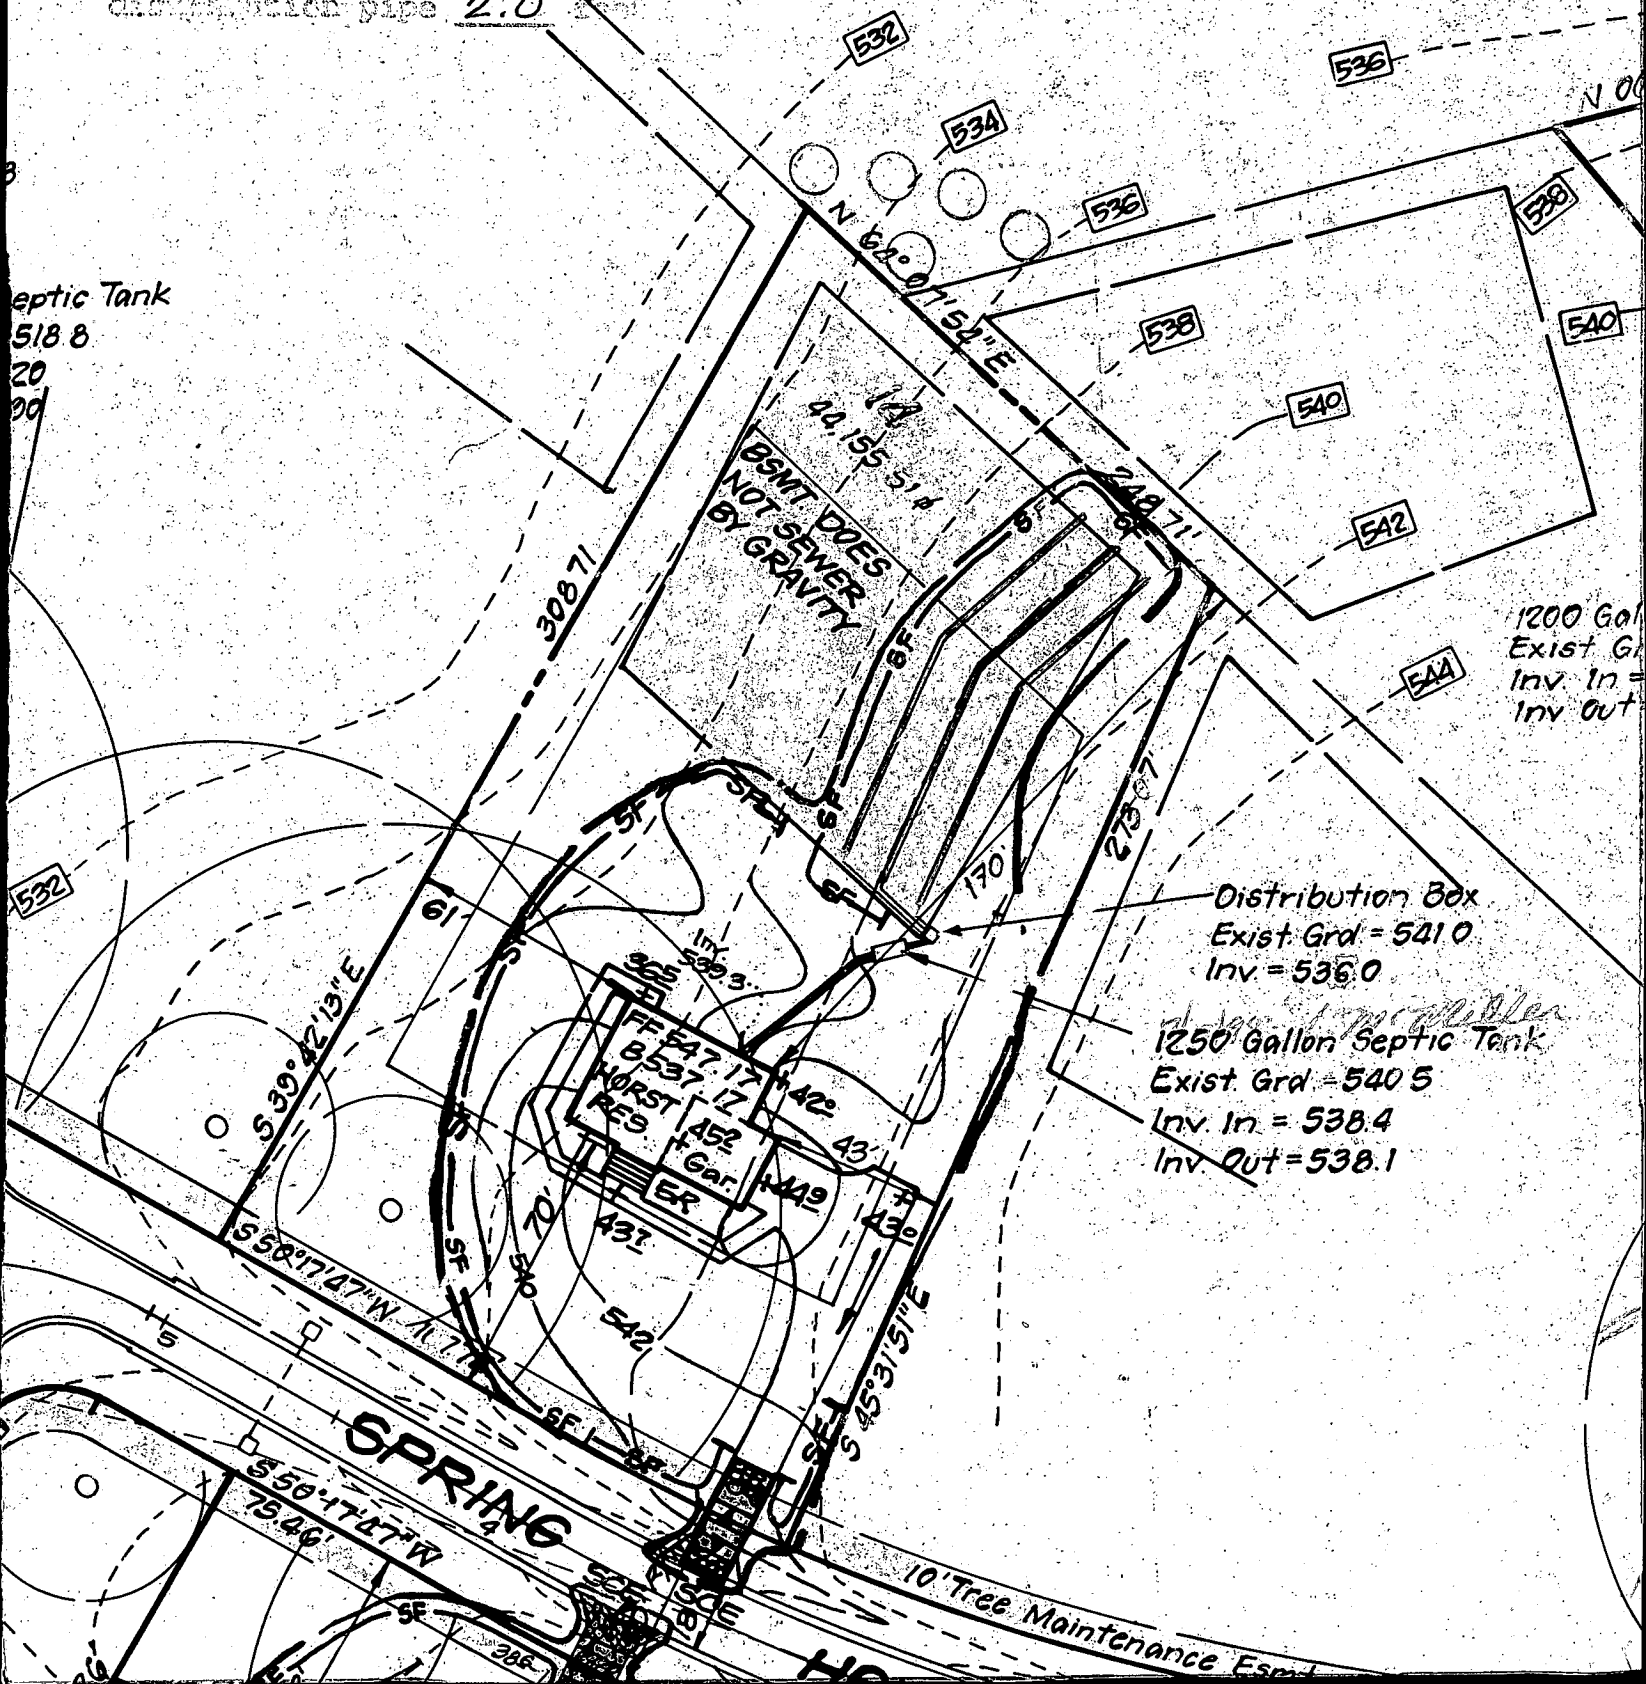

SEP-30-98 WED T:26 JHS BUILDERS

P. 01

TO: OLIN KETTERMAN
9/30/98

WALFIELDS GRANT II
3104 Spring House C

AGRICULTURAL
PRESERVATION PARCEL A

LOT 13

N64°07'54"E

LOT 17
44,155.51 ±

LOT 16

142.53'

LOT 15

Swage Easement, see -
Plat No. 11971

S4E31°51"E

15' B.R.

#3104

42' ±

60' B.R.L

273.07'

M4E13°46'30"N

S60°17'17"W

107.74' R=575.00'
L=58.48'

SPRING HOUSE

50' R/W

COURT

9/30/98
Will check
Hse location is
consistent w/ the
approved BP plan
A. McMill

Side Tree Maintenance
see Note No. 9
971

APPLICATION

PERCOLATION TESTING

A 49482 L

P _____

HOWARD COUNTY HEALTH DEPARTMENT

BUREAU OF ENVIRONMENTAL HEALTH

3525-H ELLICOTT MILLS DRIVE/ELLICOTT CITY, MARYLAND 21043
TELEPHONE: 313-2640

DISTRICT _____

DATE _____

TO: THE COUNTY HEALTH OFFICER
ELLICOTT CITY, MARYLAND

I HEREBY APPLY FOR THE NECESSARY TEST PRIOR TO APPLICATION FOR PERMIT TO CONSTRUCT (OR RECONSTRUCT) A SEWAGE DISPOSAL SYSTEM.

PROPERTY OWNER WARFIELDS GRANT LTD. PARTNERSHIP c/o Ronald B. Carter
Selfridge Builders

ADDRESS P.O. Box 122 ELLICOTT CITY PHONE _____
MD. 21043

AGENT OR PROSPECTIVE BUYER FISHER COLLINS + CARTER ATTN: Zach Fisch

ADDRESS 9171 BALTIMORE NATIONAL PIKE ELLICOTT PHONE 461-2855
CITY MD. 21042

PROPERTY LOCATION:

SUBDIVISION WARFIELDS GRANT SEC. 2 LOT NO. 14

ROAD AND DESCRIPTION Daisy Road (3104 Spring House Court)

TAX MAP 13 PARCEL # 128

SIZE OF LOT 1 AC. ± TYPE BLDG. S.F.D. - 4 Bed
BLDG. PERMIT SIGNED
AND RETURNED 7-10-98
Serial # B1012752

(SINGLE FAMILY DWELLING OR COMMERCIAL)

THE SYSTEM INSTALLED UNDER THIS APPLICATION IS ACCEPTABLE ONLY UNTIL PUBLIC FACILITIES BECOME AVAILABLE. I FULLY UNDERSTAND THE

FEE CONNECTED WITH THE FILING OF THIS PERC TEST APPLICATION IS NON-REFUNDABLE UNDER ANY CIRCUMSTANCES. I ALSO AGREE TO

COMPLY WITH ALL M.O.S.H.A. REQUIREMENTS IN TESTING THIS LOT. Zacharia Y. Fisch (agent)
(SIGNATURE OF APPLICANT)

APPROVED BY _____ FOR _____ DATE _____

DISAPPROVED BY _____ FOR _____ DATE _____

HOLD PENDING FURTHER TESTS _____

REASONS FOR REJECTION OR HOLDING _____

PERCOLATION TEST PLAT/PRELIMINARY PLAT - TITLE OR I.D. # _____ DATE _____

SITE DEVELOPMENT PLAN/FINAL PLAT - TITLE OR I.D. # _____ DATE _____

THIS IS NOT A PERMIT

A49482L

COUNTY #

SOIL PROFILE

0' 38
SiL
tan

3' red CL

6' SL
red
10-20%
rock

11'

37
red C

3'

SMICL
red

6' ~~veinol~~
~~rock~~ 20%

7' SMICL

12'

36
SL
red


4'

red C

5'

SMICL

12'

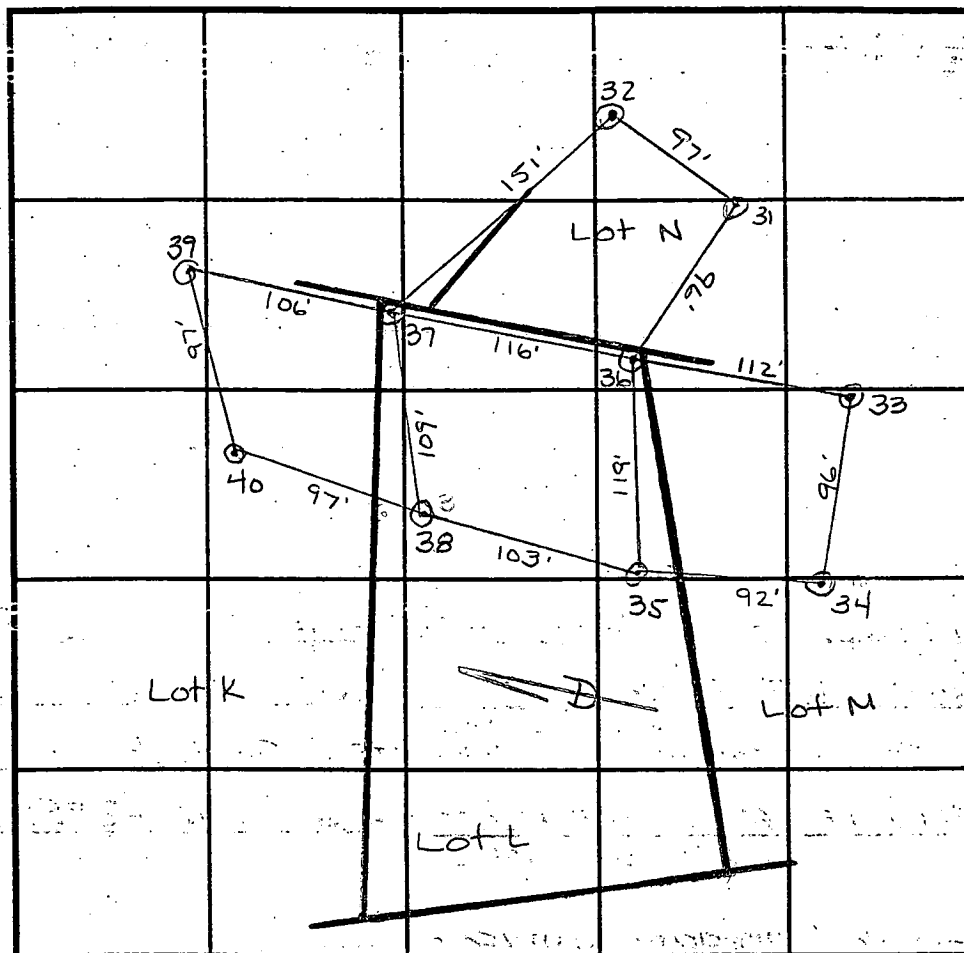

INDICATE NORTH - NAME ADJOINING ROADWAY AS BASE LINE.

SOIL PROFILE

0' 35
Br
SiL

3' red C

8' SL

12'

DATE	TEST NO.	DEPTH	PRE-WET		TEST - 1" DROP		TIME
			START	STOP	START	STOP	
8/20/93	38	VII 6 1/2	10:32 ³⁰	10:34	10:34	10:38	4
	37	VII 5	10:34	10:36	10:36	10:38	2
		9	10:41	10:44	10:44	10:50	6
	37	VII 4 1/2	10:42	10:44	10:44	10:46	2
	36	VII 5	1:54 ³⁰	1:55 ³⁰	1:55 ³⁰	1:57 ³⁰	1 1/2
		8	1:57 ¹⁰	1:58 ³⁰	1:58 ³⁰	2:00 ¹⁵	2
	41		11:40	11:44			
			11:40	11:46	11:46	11:50	4
	35	VII 5	1:45	less than 1" in 30 min			
		8	1:44 ¹⁵	1:46 ³⁰	1:46 ³⁰	1:52	5 1/2

REMARKS Tests 40-39 in A49482K; 31, 32 in A49482N; 33-34 in A49482M

TYPE OF SOIL Chester

TESTED BY Amy McMullen / Cig Willen


ALSO PRESENT Cissle / Andres

TRENCH DESIGN DATA: AVERAGE PERCOLATION TIME 5 TRENCH WIDTH 3

INLET DEPTH 5 MAXIMUM BOTTOM DEPTH 7 SQ. FT./BEDROOM 180

[illegible]

9.48'	S 13°34'46" E	74°52'56"
91.68'	S 17°44'00" E	83°11'26"
20.41'	N 00°13'59" W	48°11'23"
6.67'	N 66°08'18" W	276°22'46"
20.41'	S 47°57'24" W	48°11'23"
1.40'	N 01°35'53" E	01°08'03"
1.19'	N 00°16'18" E	01°31'07"

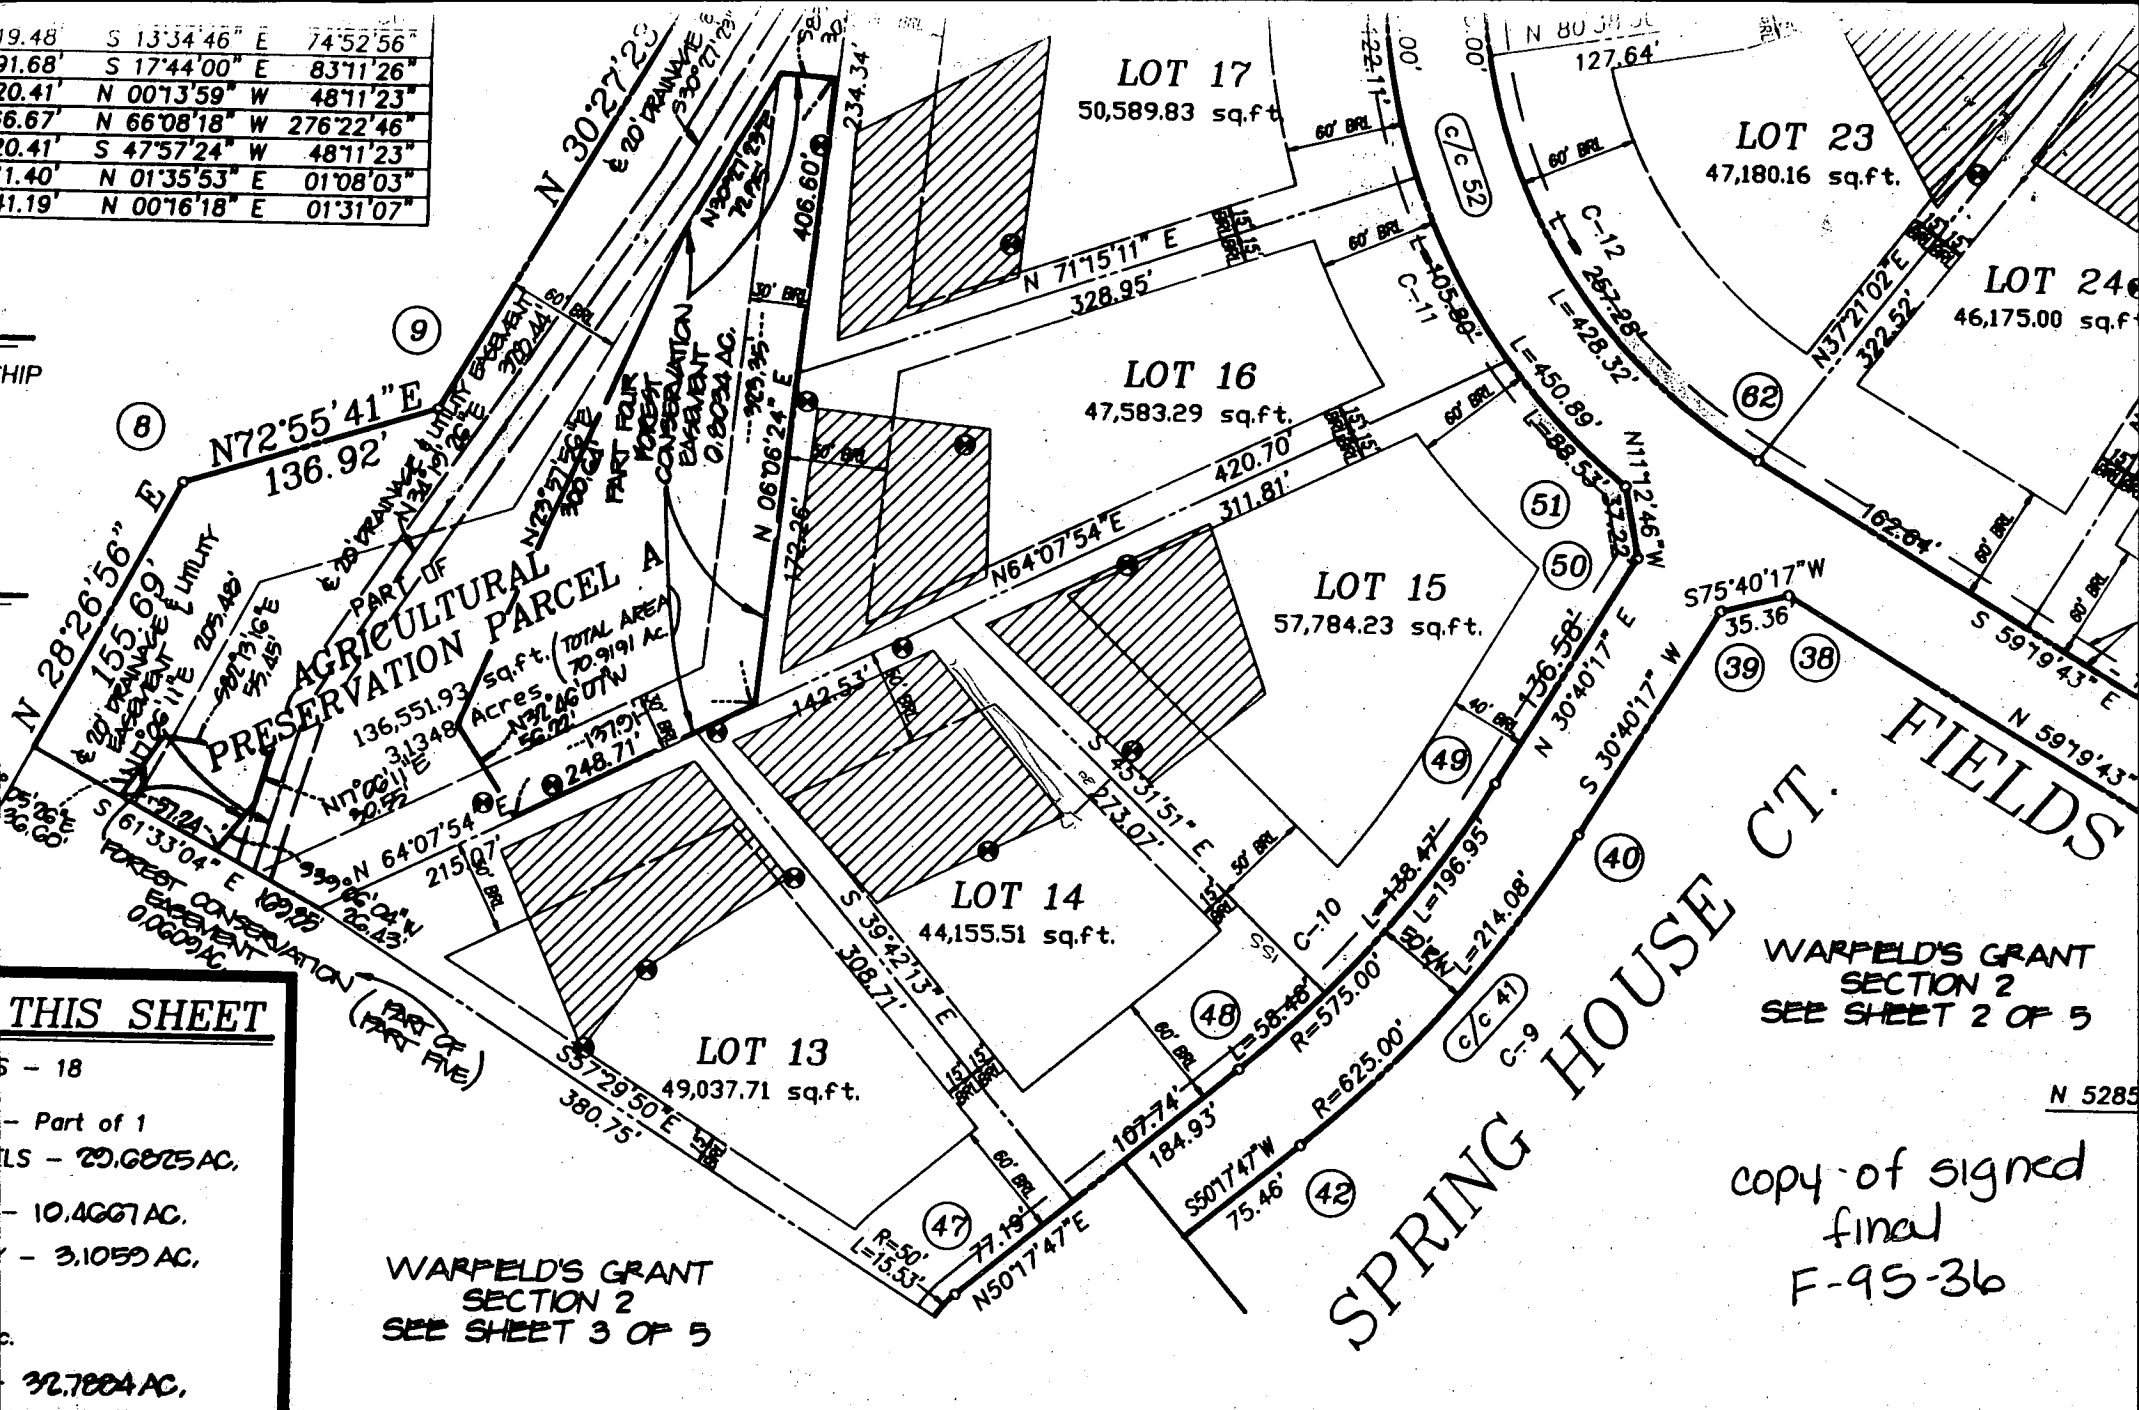

THIS SHEET

5 - 18

Part of 1

LS - 20.6825 AC.

10.4667 AC.

3.1059 AC.

32.7884 AC.

WATER AND SEWERAGE SYSTEMS, DEPARTMENT OF HEALTH

DATE

Surveyor's Certificate

I hereby certify that the final plat shown hereon is correct; that it is a subdivision of part of the lands conveyed by Edwin Warfield, III and Ellen Warfield, his wife to Robert M. Warfield by and dated November 9, 1966 and recorded the Land Records of Howard County, Maryland in Liber No. 461 at folio 710 and that all monuments are in place or will be in place prior to the acceptance of the streets in the subdivision by Howard County.

Owner's Declaration

I, Robert M. Warfield, owner of the property shown and in consideration of the approval of this final plat by the minimum building restriction lines and consent unto Howard County the right to lay, construct and maintain sewers, drains, water pipes under all roads and street right-of-ways and the specific e

C1 1936

SEQUENCE NO.
(DENY USE ONLY)STATE OF MARYLAND
WELL COMPLETION REPORT
FILL IN THIS FORM COMPLETELY
PLEASE PRINT OR TYPETHIS REPORT MUST BE SUBMITTED WITHIN
45 DAYS AFTER WELL IS COMPLETED.COUNTY
NUMBER A-49482-LST/CO USE ONLY
DATE Received

DATE WELL COMPLETED

Depth of Well

PERMIT NO.
FROM "PERMIT TO DRILL WELL"

8 13

062498

22 340 26
(TO NEAREST FOOT)170-94-1600
28 29 30 31 32 33 34 35 36 37

OWNER

STREET OR RFD

SUBDIVISION

SELF RIDGE Builders
last name Spring House Ct. first name

TOWN

DAISY MD

SECTION 2

LOT 14

WELL LOG

Not required for driven wells

STATE THE KIND OF FORMATIONS
PENETRATED, THEIR COLOR, DEPTH,
THICKNESS AND IF WATER BEARINGDESCRIPTION (Use
additional sheets if needed)

FEET

FROM TO

Check
if water
bearing

Top Soil

0 2

Brown Shale

2 20 ✓

Brown Shale

20 25

Blue Shale

25 95

Brown Shale

95 100 ✓

Blue Shale

100 340

GROUTING RECORD

WELL HAS BEEN GROUTED
(Circle Appropriate Box)yes ☒ Y no ☐ N

TYPE OF GROUTING MATERIAL

CEMENT ☒ CMBENTONITE CLAY ☐ BC

NO. OF BAGS 20

NO. OF ROUNDS 2000

GALLONS OF WATER 120

DEPTH OF GROUT SEAL (to nearest foot)

from 0 ft. to 304 ft.
(enter 0 if from surface)

CASING RECORD

casing
types
insert
appropriate
code
belowST CO
STEEL CONCRETE
PL PL OT
PLASTIC OTHERMAIN
CASING
TYPENominal diameter
top (main) casing
(nearest inch)Total depth
of main casing
(nearest foot)

PL

6

84

E
A
C
H
C
A
S
I
N
G

OTHER CASING (if used)

diameter depth (feet)
inch from toscreen type
or open hole

SCREEN RECORD

insert
appropriate
code
belowST BR HO
STEEL BRASS OPEN
PL PL OT
PLASTIC HOLE
OTHERIN HARD ROCK AREAS, IDENTIFY SPECIFICALLY
WHERE SATURATED FRACTURES WERE OBSERVED.

WELL HYDROFRACTURED.

yes ☒ Y no ☐ N

CIRCLE APPROPRIATE LETTER.

A A WELL WAS ABANDONED AND SEALED
WHEN THIS WELL WAS COMPLETED

E ELECTRIC LOG OBTAINED

P TEST WELL CONVERTED TO PRODUCTION
WELLI HEREBY CERTIFY THAT THIS WELL HAS BEEN CONSTRUCTED IN
ACCORDANCE WITH COMAR 26.04.04 "WELL CONSTRUCTION"
AND IN CONFORMANCE WITH ALL CONDITIONS STATED IN THE
ABOVE CAPTIONED PERMIT, AND THAT THE INFORMATION PRE-
SENTED HEREIN IS ACCURATE AND COMPLETE TO THE BEST OF
MY KNOWLEDGE

DRILLERS IDENT. NO.

MSD 116

DRILLERS SIGNATURE

(MUST MATCH SIGNATURE ON APPLICATION)

MSD 116 R. H. Mayne

SITE SUPERVISOR (sign of driller or journeyman
responsible for sitework if different from permittee)

GRAVEL PACK

IF WELL DRILLED WAS
FLOWING WELL INSERT
F IN BOX 68MDE USE ONLY
(NOT TO BE FILLED IN BY DRILLER)

T

(E.R.O.S.)

W Q

70

72

74 75 76

TELESCOPE
CASINGLOG
INDICATOR

OTHER DATA

C 3

PUMPING TEST

HOURS PUMPED (nearest hour)

6

PUMPING RATE (gal. per min.
to nearest gal.)

3

METHOD USED TO
MEASURE PUMPING RATE

Bucket

WATER LEVEL (distance from land surface)

BEFORE PUMPING

62

WHEN PUMPING

160

TYPE OF PUMP USED (for test)

A air

P piston

T turbine

C centrifugal

R rotary

O other
(describe
below)

J jet

S submersible

PUMP INSTALLED

DRILLER WILL INSTALL PUMP YES ☒ NO ☐IF DRILLER INSTALLS PUMP, THIS SECTION
MUST BE COMPLETED FOR ALL WELLS
EXCEPT HOME USE
TYPE OF PUMP/INSTALLED
PLACE (A,C,J,P,R,S,T,O)
IN BOX - SEE ABOVE:CAPACITY:
GALLONS PER MINUTE
(to nearest gallon)

31 35

PUMP HORSE POWER

37 41

PUMP COLUMN LENGTH
(nearest ft.)

43 47

CASING HEIGHT (circle appropriate box
and enter casing height)+ above
- below

LAND SURFACE

2 (nearest
foot)

LOCATION OF WELL ON LOT

SHOW PERMANENT STRUCTURE SUCH AS
BUILDING, SEPTIC TANKS, AND/OR
LANDMARKS AND INDICATE NOT LESS
THAN TWO DISTANCES
(MEASUREMENTS TO WELL)well 30' Road
25' Group Line

COUNTY

B 1	4750	SEQUENCE NO. (MDE USE ONLY)	STATE OF MARYLAND PERMIT TO DRILL WELL please print or type	STATE PERMIT NUMBER HO-94-1600 fill in this form completely
Date Received (APA) 6-18-98 8 MM DD YY 13		OWNER INFORMATION		
15 Last Name SELFRIEDGE		34 First Name Builder's		
36 Street or RFD 14045 GANEY DRIVE		55		
57 Town Glenwood		76 State MD		
		72 Zip 21738		
DRILLER INFORMATION				
Driller's Name Ralph Mayne		MSD 117 76 License No. 81		
Firm Name Ralph Mayne Well Drilling				
Address 9120 Brown Church Rd Mt Airy				
Signature Ralph Mayne				
Date 6-12-98				
B 2 WELL INFORMATION				
1 2		APPROX. PUMPING RATE (GAL. PER MIN.)		
		5		
AVERAGE DAILY QUANTITY NEEDED (GAL. PER DAY)		14 500 20		
USE FOR WATER (CIRCLE APPROPRIATE BOX)				
☒ DOMESTIC POTABLE SUPPLY & RESIDENTIAL IRRIGATION				
☐ FARMING (LIVESTOCK WATERING & AGRICULTURAL IRRIGATION)				
☐ INDUSTRIAL, COMMERCIAL, DEWATERING				
☐ PUBLIC WATER SUPPLY WELL				
☐ TEST, OBSERVATION, MONITORING				
☐ GEO-THERMAL				
APPROXIMATE DEPTH OF WELL 150 FEET 24 28				
APPROXIMATE DIAMETER OF WELL 64 INCH NEAREST INCH				
METHOD OF DRILLING (circle one)				
BORED (or Augered) JETTED Jetted & DRIVEN				
30 ☒ AIR-ROTARY AIR-PERCussion ROTARY (Hydraulic Rotary)				
37 ☐ CABLE ☐ REVERSE-ROTARY ☐ DRIVE-POINT				
other				
REPLACEMENT OR DEEPEMED WELLS (CIRCLE APPROPRIATE BOX)				
☒ THIS WELL WILL NOT REPLACE AN EXISTING WELL				
☐ THIS WELL WILL REPLACE A WELL THAT WILL BE ABANDONED AND SEALED				
39 ☐ THIS WELL WILL REPLACE A WELL THAT WILL BE USED AS A STANDBY-CONTACT LOCAL APPROVING AUTHORITY FOR POLICY ON STANDBY WELLS				
☐ THIS WELL WILL DEEPEN AN EXISTING WELL				
PERMIT NUMBER OF WELL TO BE REPLACED OR DEEPEMED (IF AVAILABLE) 41 _____ 52				
Not to be filled in by driller (MDE OR COUNTY USE ONLY)				
APPROP. PERMIT NUMBER 54 _____ G A P 63				
PERMIT No. HO-94-1600 70 71 72 73 74 75 76 77 78 79				
SPECIAL CONDITIONS NOTE - APPROVING AUTHORITIES SHOULD USE SEPARATE SHEET IF NEEDED				

B 3 LOCATION OF WELL

8 COUNTY **Howard**

23 SUBDIVISION **WARFIELDS GRANT**

SECTION **II** LOT **14**

52 NEAREST TOWN **DAISY**

MILES FROM TOWN (enter 0 if in town) **1** M I

73 76 77 78

B 4

1 2 DIRECTION OF WELL FROM TOWN (CIRCLE BOX)

ON WHICH SIDE OF ROAD (CIRCLE APPROPRIATE BOX)

Spring House Ct

11 30 37

DISTANCE FROM ROAD

ENTER FT OR MI **30** 38 39

TAX MAP _____ BLK: _____ PARCEL _____

NOT TO BE FILLED IN BY DRILLER
HEALTH DEPARTMENT APPROVAL

Howard County **A49482-6**

COUNTY NAME COUNTY NO.

STATE SIGNATURE _____ INSERT S → 41

DATE ISSUED **06/19/98** **Amc-McL...** **6/19/99**

43 MM DD YY 48 CO SIGNATURE EXP. DATE

NORTH GRID **528** 000 EAST GRID **780** 000

50 55 57 63

SHOW MAJOR FEATURES OF BOX & LOCATE WELL WITH AN X

SOURCES OF DRILLING WATER

1. **well**

2.

3.

WRITE THE BOX NUMBER FROM THE MAP HERE

780

528

DRAW A SKETCH BELOW SHOWING LOCATION OF WELL IN RELATION TO NEARBY TOWNS AND ROADS AND GIVE DISTANCE FROM WELL TO NEAREST ROAD JUNCTION

6/2/98

HORST RESIDENCE PRELIMINARY PLOT PLAN 1"=50' WARFIELDS GRANT, LOT # 14

6/19/98
Well site OK
as staked

Sidewalk From Driveway
to walkout (No steps)

1200 Gal. Sep.
Exist. Grd. = 5.
Inv. In = 540.
Inv. Out = 540.1


Distribution Box
Exist. Grd. = 541.0
Inv. = 538.0

1250 Gallon Septic Tank
Exist. Grd. = 540.5
Inv. In = 538.4
Inv. Out = 538.1

Approx F.F. 547.00
Approx B.F. 537.00

NOTE: BASEMENT SEWER
DOES NOT GRAVITY FLOW

- * 9' Foundation Walls
- * WALKOUT BASEMENT
- 10' Tree Maintenance Esmt

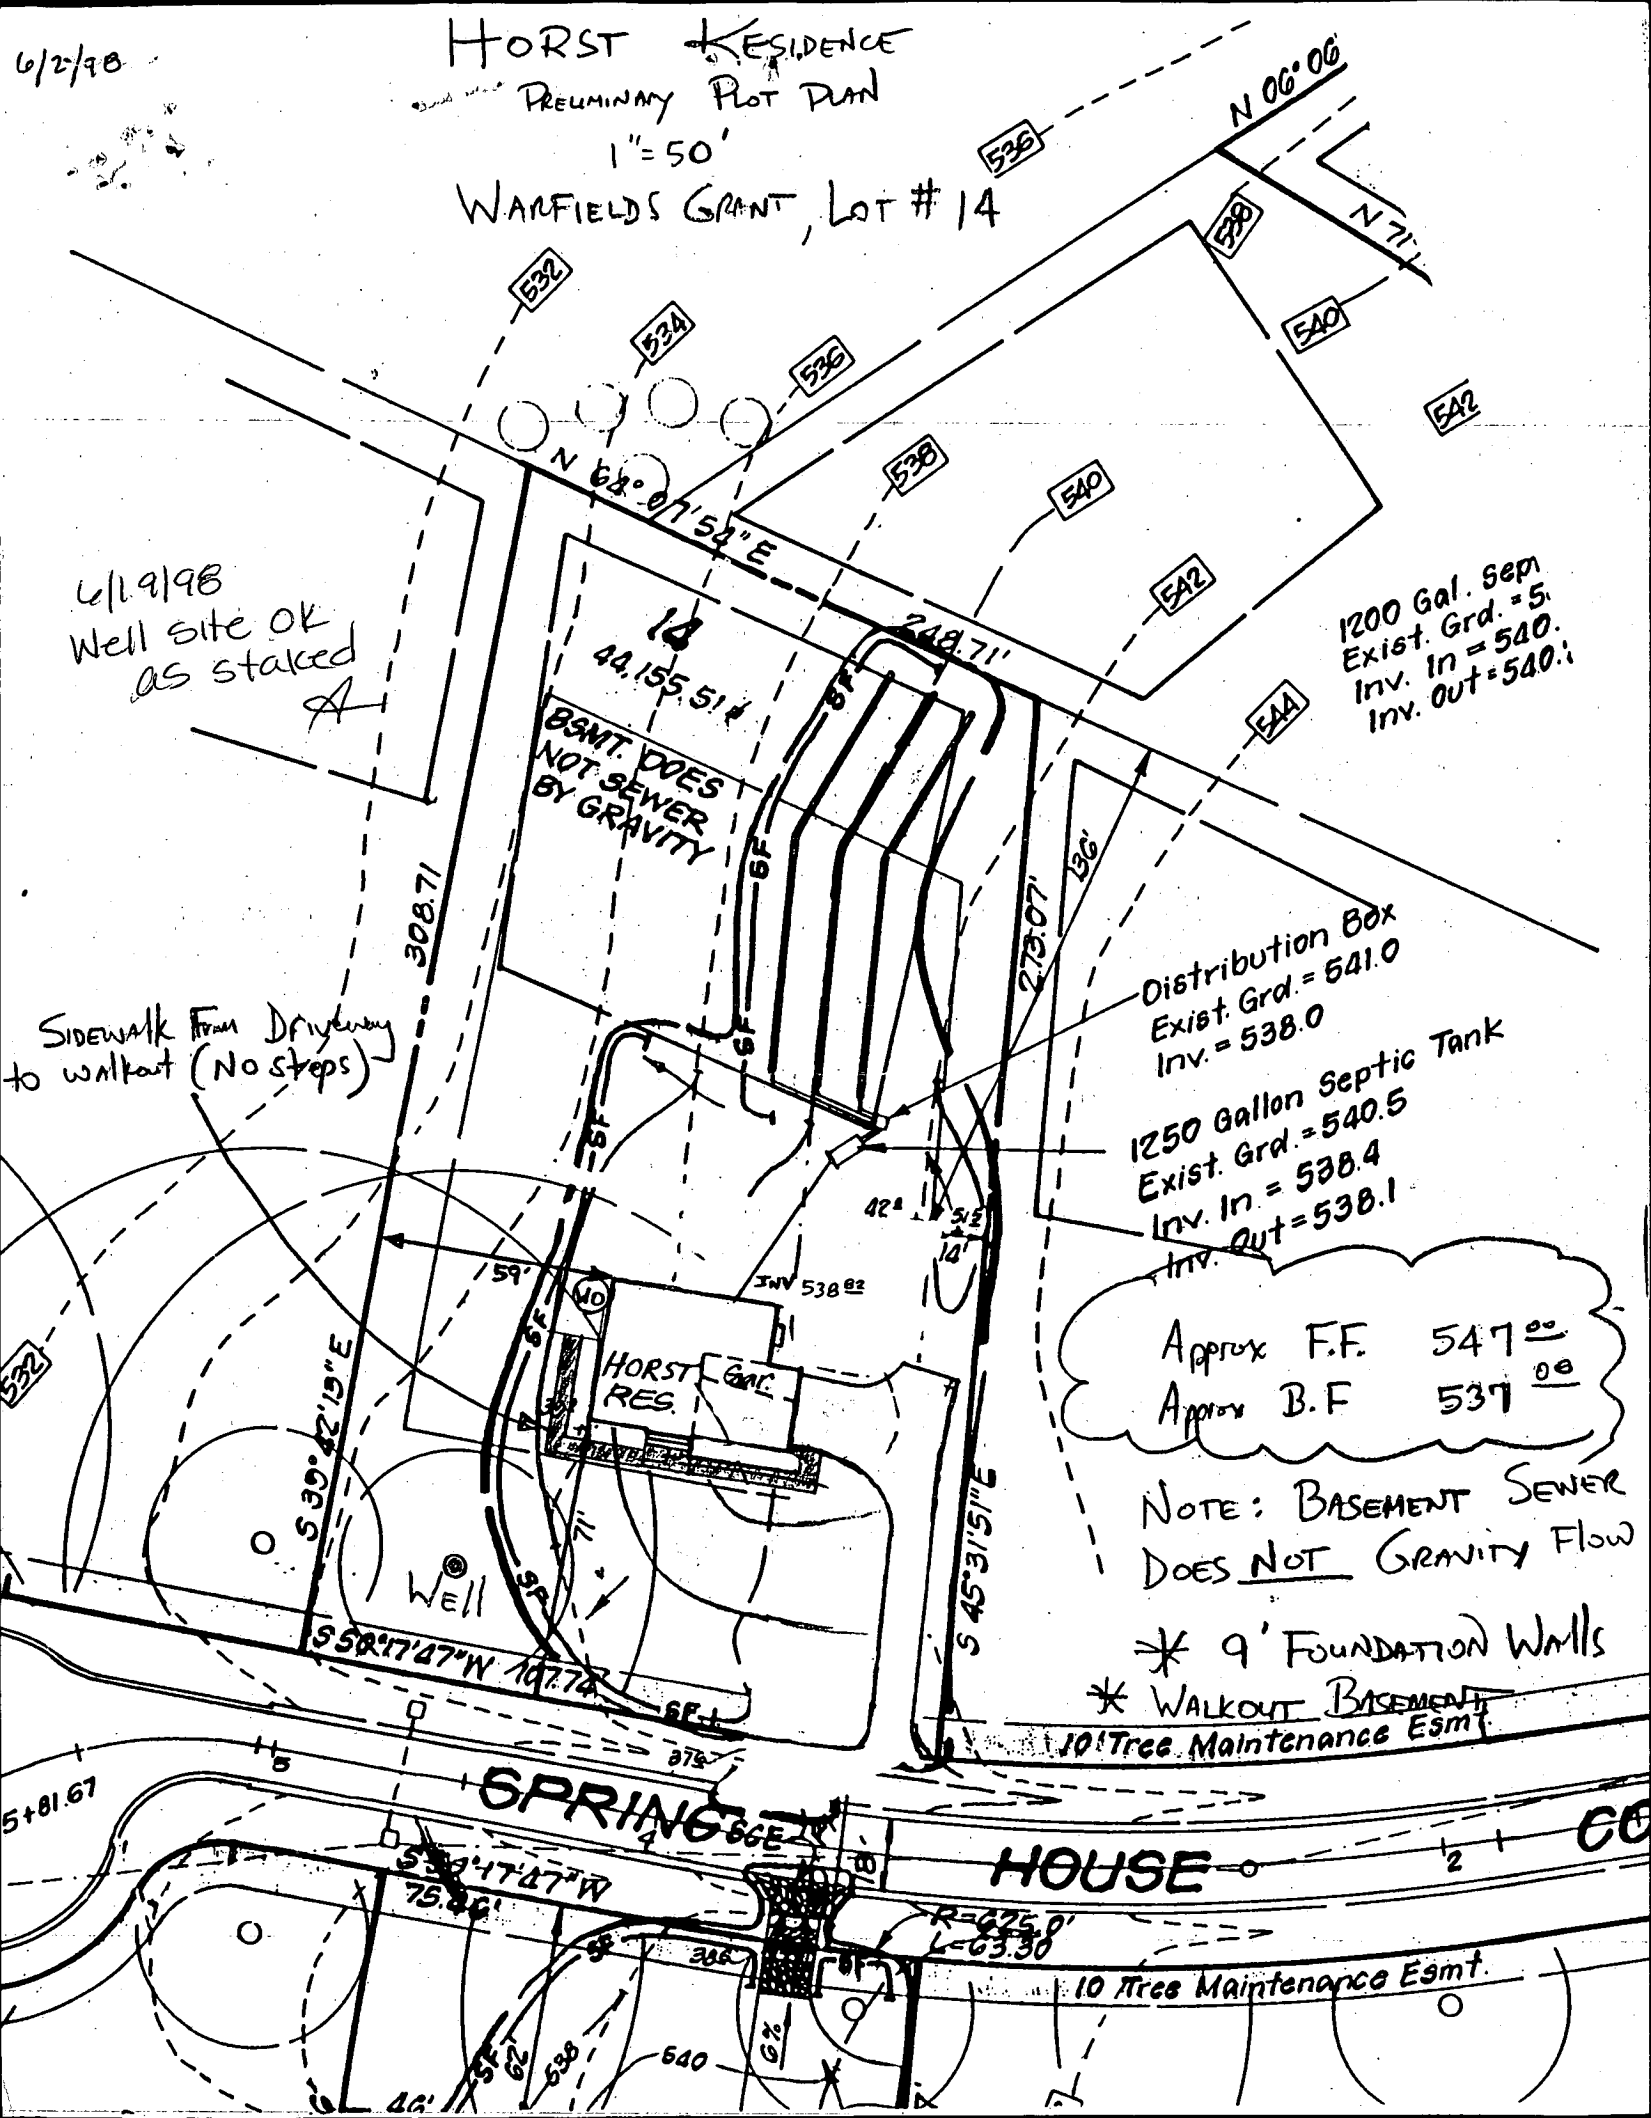



HOWARD COUNTY HEALTH DEPARTMENT

Joyce M. Boyd, M.D., County Health Officer

December 15, 1998

Mr. James Selfridge
Selfridge Builders
14045 Gared Drive
Glenwood, Maryland 21738

RE: Warfields Grant, Lot #14
3104 Spring House Court
Well Permit #HO-94-1600

Dear Mr. Selfridge:

This is to advise you that the septic system for the above referenced property was installed, inspected and approved on October 2, 1998.

The water sample recently submitted for testing was free of coliform and fecal coliform bacteria and is bacteriologically safe for drinking. The water sample was found to be in compliance with COMAR water quality standards.

This certifies that the initial sampling requirements of COMAR 26.04.04 "Well Regulations" have been met for the water supply system installed under well permit #HO- 94-1600. No guarantee can be given for health protection beyond this date of issue. Based upon satisfactory investigation and evaluation by the Howard County Health Department, the Maryland Department of the Environment accepts this well system as required by COMAR 26.04.04.09.

This certificate may become final upon completion of the final bacteriological test which is to be taken by the Health department within six (6) months of receipt of this letter. Please contact Ms. Vicki Fellas at (410) 313-2644 to schedule a final water sample appointment.

INTERIM CERTIFICATE OF POTABILITY

Date(s) of water sample(s): December 14, 1998

Date of well completion: June 24, 1998

Approving Authority

Kimberly Maiste

Sanitarian

Water and Sewerage Program

cc: Building Inspector's office
file