

3/17/60 - ch out

Indeped

PERMIT

SEWAGE DISPOSAL SYSTEM

MARYLAND STATE DEPARTMENT OF HEALTH

HOWARD COUNTY

P 03399

79-760-B
A 03199

INDEXED

03-281795

ELLICOTT CITY

DISTRICT 2

DATE 3/2/61

Bob Abby

IS PERMITTED TO INSTALL ☒ ALTER ☐

ADDRESS Mineral Hill Rd., Randallstown

PHONE Builders Mt. Airy 976

A SEWAGE DISPOSAL SYSTEM LOCATED AT

SUBDIVISION River Park Estates

1127
ROAD River Rd.

LOT 5

PROPERTY OWNER Wallace Morris (Builder)

Robert & Dorothy Caprell

ADDRESS Rte. 5, Mt. Airy

SPECIFICATIONS

DRAIN FIELD _____ DEPTH _____ FEET, BOTTOM AREA _____ SQ. FT.

SEEPAGE PITS ☒ ABSORBENT SIDE-WALL AREA 500 _____ SQ. FT. below the inlet.

SEPTIC TANK CAPACITY 750 _____ GALLONS

PL. 1 GARBAGE GRINDER, INCREASE DISPOSAL AREA 225 & TANK CAPACITY 500

OTHER Place the dry well about 60 ft. to 80 ft. from the edge of River Road and about 50 ft. to 70 ft. from Lot 5.

Septic tank cannot be installed more than 5 feet below original grade.

PLANS APPROVED BY Raymond Hodges

DATE 11/18/60


FILL SEPTIC TANK AND DISTRIBUTION BOX WITH WATER BEFORE CALLING FOR AN INSPECTION. COVER NO WORK UNTIL INSPECTED AND APPROVED.

NEITHER THE HOWARD COUNTY COMMISSIONERS NOR THE HEALTH DEPARTMENT IS RESPONSIBLE FOR THE SUCCESSFUL OPERATION OF ANY SYSTEM.

SEW. PERMIT SIGNED
AND RETURNED 6-27-92
Serial # B7104570
above ground P.H.

103199

79-760-B

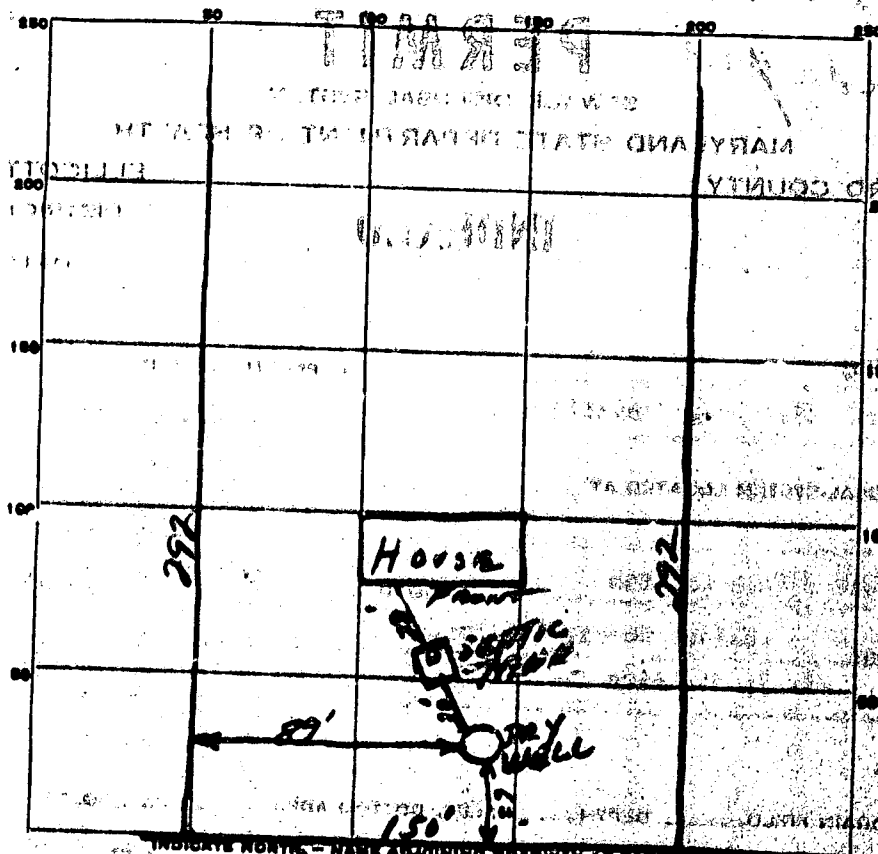

PERMIT CARD yes
 SEPTIC TANK, OK
 DISTRIBUTION BOX, None
 CLEANOUTS Standard

TILE FIELD, DEPTH _____ FT. TRENCH WIDTH _____ FT.
 GRAVEL DEPTH _____ IN. TOTAL LENGTH _____ FT.
 NUMBER OF TRENCHES _____ TOTAL BOTTOM AREA _____
 DEEPAGE PITS, INSIDE DIAMETER 10 FT. DEPTH BELOW INLET 10 FT.
 ABSORBENT AREA 310 SQ. FT.

REMARKS 3-17-61 Need stone behind dry well. To verify
for re-inspection when done JH.
3-21-61 Inspected. Gravel not apt behind
dry well JH
3-22-61 OK Gravel

DATE SYSTEM APPROVED 3-22-61 INSPECTOR J. Henry

APPLICATION

SEWAGE DISPOSAL TESTING

A 03199

P 03399

MARYLAND STATE DEPARTMENT OF HEALTH

HOWARD COUNTY 750 Gallon tank

ELLICOTT CITY

Dry Well - 300 sq ft sidewalk
area below the inlet

DISTRICT 3

DATE 11/15/60

Place the dry well about 60 ft to
80 ft from the edge of River Road and
about 50 ft to 70 ft from Lot #5

TO: THE COUNTY HEALTH OFFICER
ELLICOTT CITY, MARYLAND

I, HEREBY, APPLY FOR THE NECESSARY TESTS IN ORDER TO CONSTRUCT OR RECONSTRUCT A SEWAGE
DISPOSAL SYSTEM.

PROPERTY OWNER Norris, Wallace

ADDRESS Rt. 3, Mt. Airy

PHONE Mt. Airy 574

PROPERTY LOCATION:

SUBDIVISION River Park Estates

LOT NO. 24

ROAD AND DESCRIPTION River Rd.

OCCUPANT

PHONE

PERSON TO CONSTRUCT SYSTEM

ADDRESS

PHONE

SIZE OF LOT

1 acre

TYPE BLDG.

3

NUMBER OF RESIDENCES

IF NOT SINGLE RESIDENCE DESCRIBE

SIGNATURE OF APPLICANT

Wallace E. Norris

APPROVED BY

Raymond Hodge FOR Dry Well

DATE

11/18/60

REJECTED BY

FOR

(KIND OF SYSTEM)


DATE

HOLD PENDING FURTHER TESTS

DATE

REASONS FOR REJECTION OR HOLDING

THIS IS NOT A PERMIT

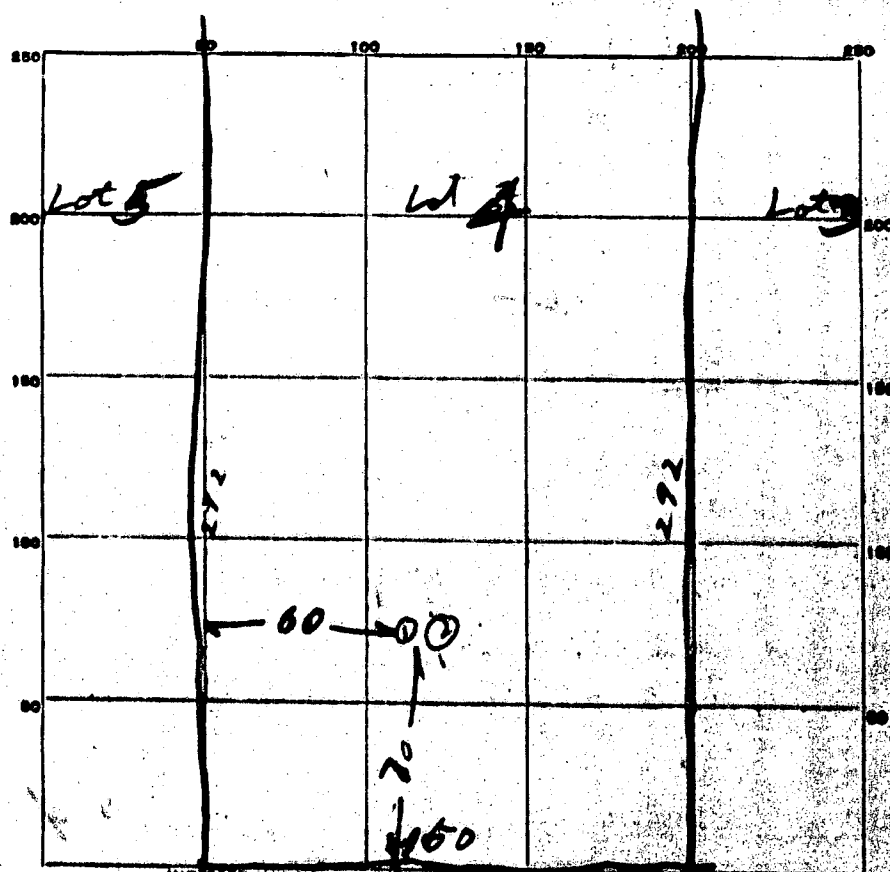[illegible]


SOIL AUGER FINDING

TESTED BY


REMARKS

ALSO PRESENT

LOT NO

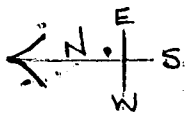

Scale: 1" = 50'

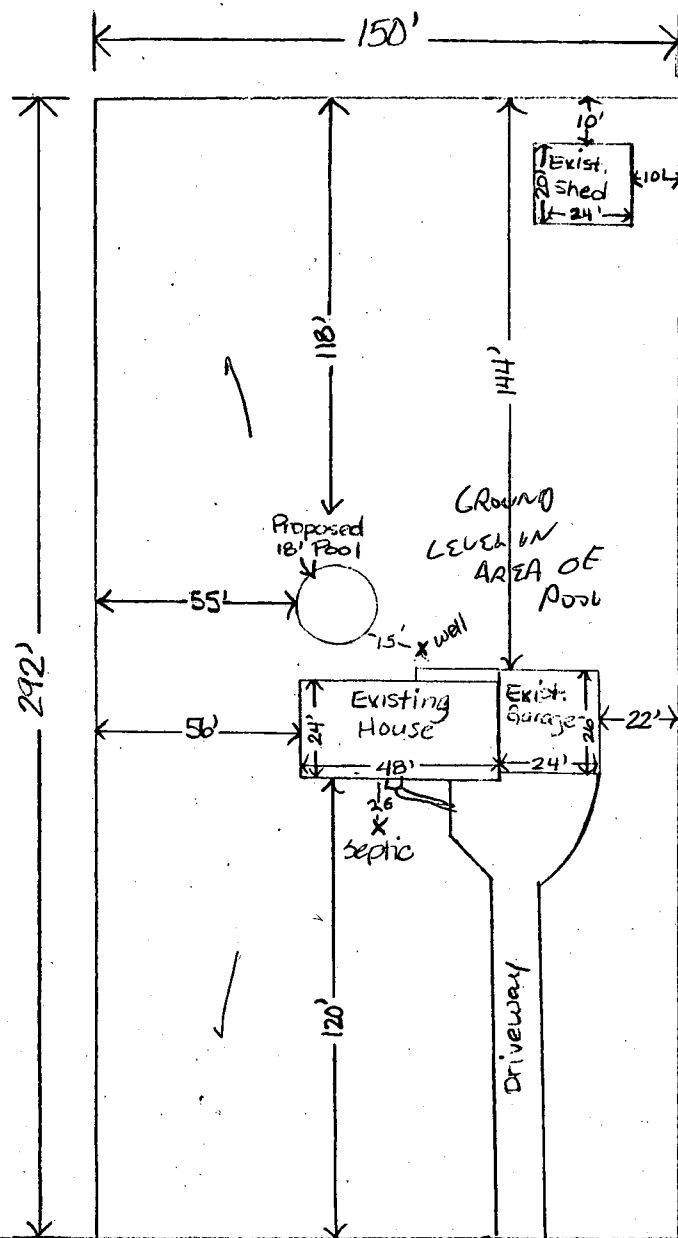

- Dimension of Property: 150' x 292'
- Distance from front of pool to front property line = 152'
- Distance from center of front street to pool = 162'
- Distance from well to pool = 18'
- Distance from house to well = 15'
- Distance from corner of lot to nearest state road = 1056'

- 3RD Election District
- Property zoned residential
- No access to public water or sewer

6/9/77

BRI SEPTIC CLEANOUT IS UNDER YARD ORNAMENT IN FRONT OF HOUSE

WELL IS BURIED - owner SAYS NO PIT, 18' FROM HOUSE, 7' FROM PORCH

PROPOSED POOL IS NO CLOSER TO WELL THAN

EXISTING HOUSE SEPTIC TANK OK TO PROCEED

JH

State Road 32