

12/17/99 C.O. 2-3pm
12/20/99
11-12
12/23/99
C.O. 2-3
12/21/99
anytime
3/13/00
1:00

PERMIT

12/21/99 needs pump
check DIS
P 5/31/06

SEWAGE DISPOSAL SYSTEM

DEPARTMENT OF HEALTH AND MENTAL HYGIENE

A 49860-B

DISTRICT _____

DATE 11/5/99

HOWARD COUNTY HEALTH DEPARTMENT

BUREAU OF ENVIRONMENTAL HEALTH

XXXXXXX 410-313-2640

DATE SYSTEM APPROVED 3/13/00

INSPECTOR ALM

05-422086

Fogle's Septic Clean, Inc. IS PERMITTED TO INSTALL ☒ ALTER _____

ADDRESS 580 Obrecht Road, Sykesville, MD 21784 PHONE 410-795-5670

SUBDIVISION Springdale LOT 1 ROAD 13704 Springdale Drive

PROPERTY OWNER Dale Thompson Builders

ADDRESS _____

TOP SEAMED TANK REQUIRED

SEPTIC TANK CAPACITY 1500 GALLONS

NUMBER OF BEDROOMS 5

180 SQUARE FEET PER BEDROOM

LINEAR FEET OF TRENCH REQUIRED 300 225

TRENCHES - Trench to be 2 feet wide. Inlet 2 feet below original grade. Bottom maximum depth 6 feet below original grade. Effective area begins at 2 feet below original grade. 4 feet of stone below distribution pipe.

LOCATION - Place the distribution box 10 feet inside the intersection of the 152.00' and 166.80' lot lines. Run trenches on contour to rear of lot.

NOTES - MAINTAIN A MINIMUM OF 100 FEET FROM THE WELL TO THE TRENCHES. No trench to exceed 100 feet in length. Provide 6" - 8" diameter cleanout and cap to grade or above on septic tank. 7/20/99 Manhole cleanout required (BB)

PUMPED SEPTIC SYSTEM PROPOSED

INSTALL: - 1-1500 GALLON TOP SEAMED PUMP CHAMBER

NOTES: - Septic pump detail to be provided by installer prior to issuance of septic permit.

- Pump performance test is necessary prior to Health Department approval of pump septic system.

12/23/99 SPECS MODIFIED TO REDUCE TRENCH LENGTH. THESE SPECS VALID FOR INITIAL SYSTEM ONLY (MR)

PLANS APPROVED BY Mark Rifkin DATE 6/08/1999

COVER NO WORK UNTIL INSPECTED AND APPROVED

NEITHER THE HOWARD COUNTY COUNCIL NOR THE HEALTH DEPARTMENT IS RESPONSIBLE FOR THE SUCCESSFUL OPERATION OF ANY SYSTEM

NOTE: CLEANOUT REQUIRED EVERY 70 FEET OF SEWER LINE AND/OR AT 90° SWEEPS IN LINES FROM HOUSE TO DRAIN FIELDS. 90° ELBOWS NOT ACCEPTABLE.

NOTE: ALL PARTS OF SEPTIC SYSTEMS (I.E. TANK, DISTRIBUTION BOX TRENCHES) TO BE 100 FEET FROM WELL (UNLESS OTHERWISE SPECIFICALLY AUTHORIZED)

NOTE: IF DEEP TRENCH(ES) ARE USED CALL FOR INSPECTION BEFORE AND AFTER PLACING GRAVEL IN TRENCH(ES)

NOTE: NO DRY WELL SHALL EXCEED 15 FOOT IN DIAMETER NO ABSORPTION TRENCH TO EXCEED 100 FEET IN LENGTH

NOTE: ALL PIPE FROM HOUSE TO SEPTIC TANK MUST BE CAST IRON OR SCHEDULE 35/40 PVC OR ABS

PERMIT VOID AFTER TWO YEARS


NOTE: INSTALL STAND PIPE ON SEPTIC TANK AND DRY WELL STAND PIPES MUST BE 6 INCHES IN DIAMETER CAST IRON, CONCRETE OR TERRA COTTA OR PVA OR ABS ACCEPTED. IF TOP OF SEPTIC TANK IS DEEPER THAN 3 FEET, MANHOLE TO GRADE REQUIRED.

NOTE: DISTRIBUTION BOXES MUST HAVE BAFFLES

*INSTALLER IS RESPONSIBLE FOR OBTAINING FINAL APPROVAL ON THIS PERMIT

*CALL 461-9933 FOR INSPECTION OF SEPTIC SYSTEM.

749860 B

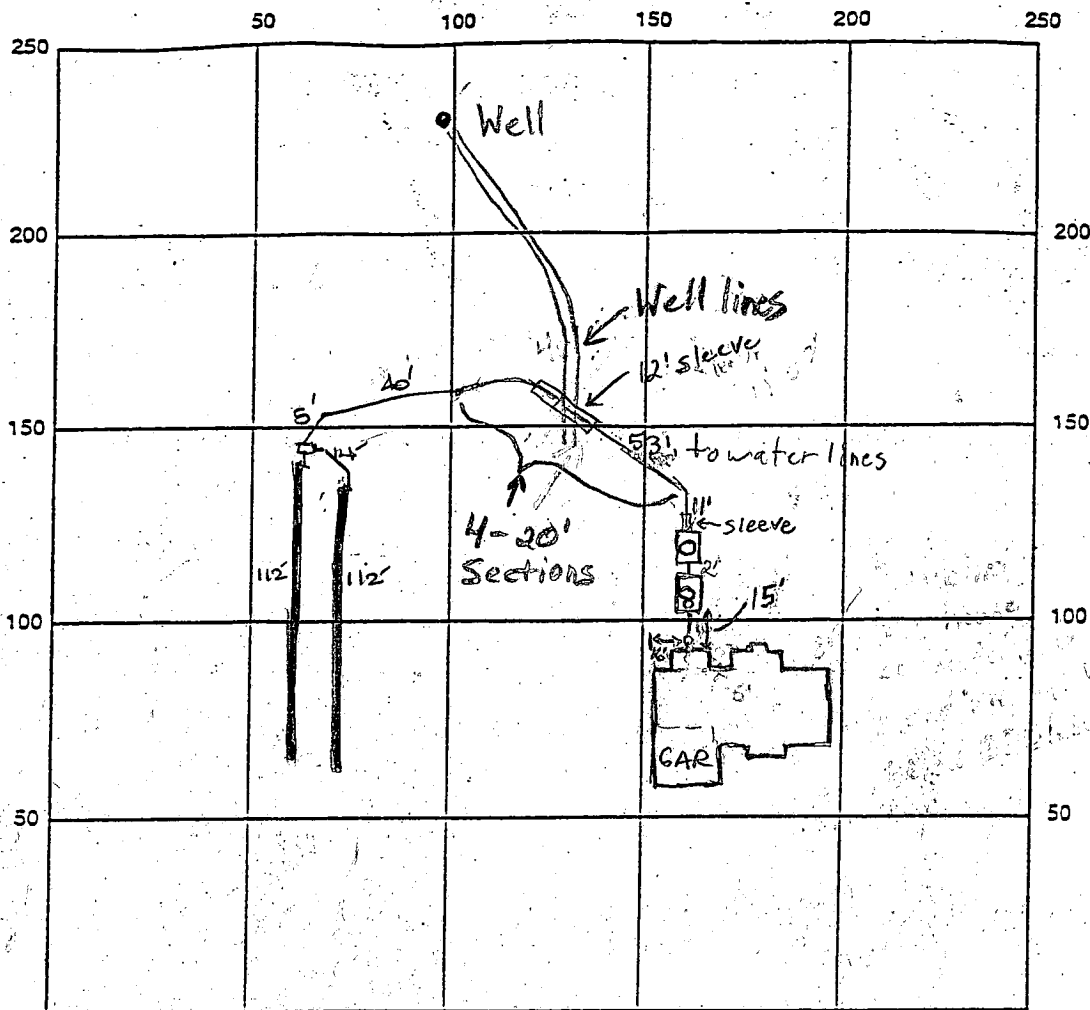

INDICATE NORTH - NAME ADJOINING ROADWAY AS BASE LINE

Springdale Drive

SEPTIC TANK LEVEL 2 - Topseamed 4500 gallon

CLEANOUTS 1-4" house, 1-6" tank, 2 manhole

DISTRIBUTION BOX LEVEL OL

DRAIN FIELD/TITLE DEPTH 6 FT.

TRENCH WIDTH 2 FT.

INLET DEPTH 2 FT.

EFFECTIVE GRAVEL DEPTH 4 FT.

TOTAL LENGTH 2x112 FT. → 224

NUMBER OF TRENCHES 2

ONE SIDEWALL/BOTTOM AREA 896 SQ. FT.

DRYWALL INSIDE DIAMETER — FT.

EFFECTIVE DEPTH BELOW INLET — FT.

ABSORBENT AREA — SQ. FT.

REMARKS: 12/17/99 System not started. System house connection installed in wrong place at incorrect elevation. (BB) ENG'R BUILDER AND CONTRACTOR ADVISED THAT PLUMBING SHOULD BE CHANGED TO CORRECT SPEC. -

ISSUE TO BE REVISITED (MR) 12/20/99 Needs house connection. O.K. to cover up to water lines (BB) 12/20/99 O.K. to keep water lines as placed. (BB)

12/23/99 OK to install trenches as specified. DKS

DATE SYSTEM APPROVED 3/13/00

INSPECTOR J. M. Muel

12/27/99 OK to cover all septic work Needs pump performance test for final. DKS 1/5/00 HOUSE COAN OK (MR) 3/13/00 Pump OK AC

APPLICATION

PERCOLATION TESTING

A 49860 B

P _____

HOWARD COUNTY HEALTH DEPARTMENT

BUREAU OF ENVIRONMENTAL HEALTH

3525-H ELLICOTT MILLS DRIVE/ELLICOTT CITY, MARYLAND 21043
TELEPHONE: 313-2640

DISTRICT _____

DATE _____

TO: THE COUNTY HEALTH OFFICER
ELLICOTT CITY, MARYLAND

I HEREBY APPLY FOR THE NECESSARY TEST PRIOR TO APPLICATION FOR PERMIT TO CONSTRUCT (OR RECONSTRUCT) A SEWAGE DISPOSAL SYSTEM.

PROPERTY OWNER DALE THOMPSON BUILDERS

ADDRESS _____ PHONE _____

AGENT OR PROSPECTIVE BUYER _____

ADDRESS _____ PHONE _____

PROPERTY LOCATION:

SUBDIVISION Springdale LOT NO. 2 1 on perc cert

ROAD AND DESCRIPTION (13704 Springdale Drive)

TAX MAP _____ PARCEL # _____

SIZE OF LOT _____ TYPE BLDG. SFD - 5 Brm
(SINGLE FAMILY DWELLING OR COMMERCIAL)

LOCAL PERMITS SECTION

AND RETURNED 8/17/94
Serial # 200118020

THE SYSTEM INSTALLED UNDER THIS APPLICATION IS ACCEPTABLE ONLY UNTIL PUBLIC FACILITIES BECOME AVAILABLE. I FULLY UNDERSTAND THE
FEE CONNECTED WITH THE FILING OF THIS PERC TEST APPLICATION IS NON-REFUNDABLE UNDER ANY CIRCUMSTANCES. I ALSO AGREE TO
COMPLY WITH ALL M.O.S.H.A. REQUIREMENTS IN TESTING THIS LOT.

(SIGNATURE OF APPLICANT)

APPROVED BY _____ FOR _____ DATE _____

DISAPPROVED BY _____ FOR _____ DATE _____

HOLD PENDING FURTHER TESTS _____

REASONS FOR REJECTION OR HOLDING HOLD FOR PLAT, PERC MARGINAL MR 8/17/94

PERCOLATION TEST PLAT/PRELIMINARY PLAT - TITLE OR I.D. # _____ DATE _____

SITE DEVELOPMENT PLAN/FINAL PLAT - TITLE OR I.D. # _____ DATE _____

THIS IS NOT A PERMIT

49860 B

COUNTY #

Lot 2

SOIL PROFILE

0' (E) (F)

brn org
sa cl
lm

3'

brn
tan si
sa lm
≤ 5% frags

10'

WATER

1 1/2'

(B)

red br
si cl
cl lm

4.5'

tan
mica
sa lm
10% frags

12.2'

13.4'

SOIL DAMP

(C)

org brn
sa cl lm


2.3'

red br
sa
mica lm

9 1/2'

WATER


12'

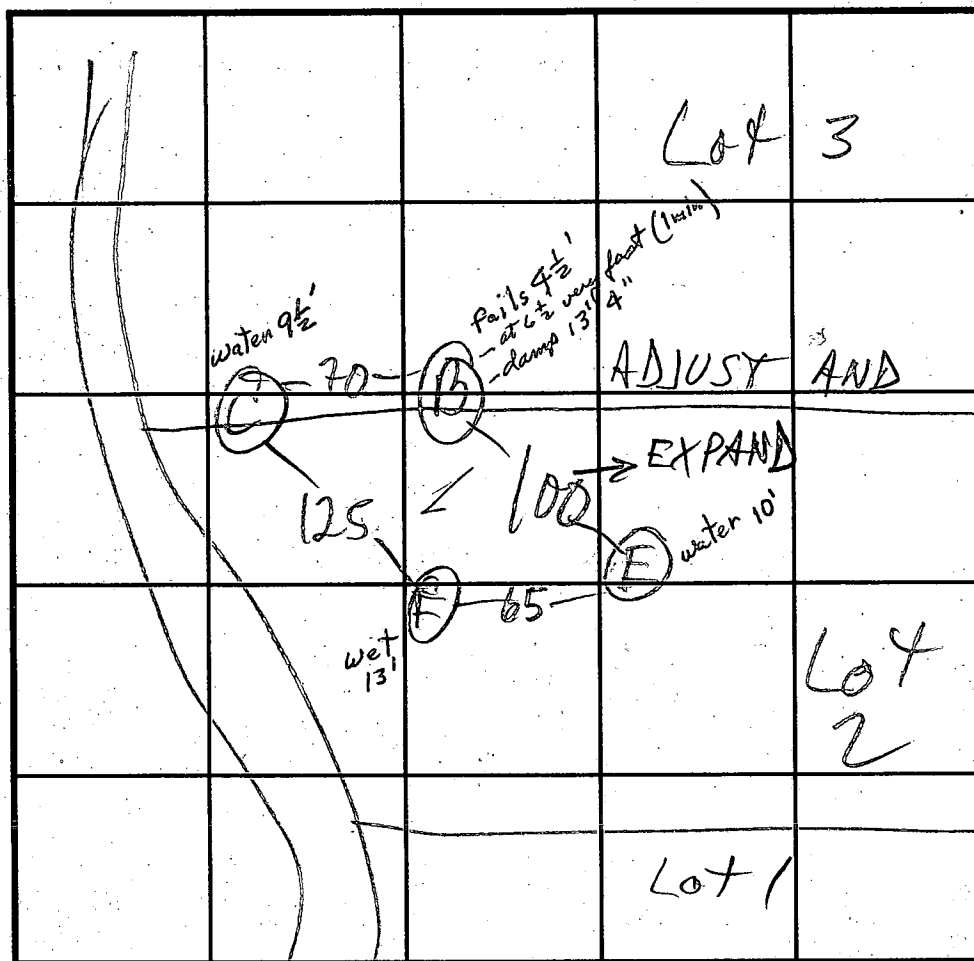

INDICATE NORTH - NAME ADJOINING ROADWAY AS BASE LINE.

SOIL PROFILE

0'

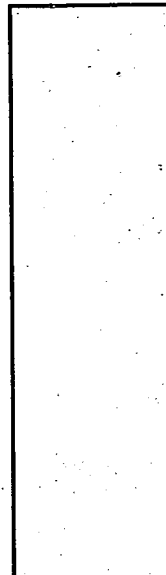

DATE	TEST NO.	DEPTH	PRE-WET		TEST - 1" DROP		TIME
			START	STOP	START	STOP	
3/7/94	ES	4 1/2	1:37	1:44	1:44	1:55	11 EST
	EV	11 1/2	H ₂ O	@ 10'			
	FS	4	1:50	1:57	1:57	2:04	7
	FV	13	SOIL	WET @	1:3'		
	BS	4 1/2	12:50	1:10	3/4"	REDIG	fail slow
		5	1:22	1:27	1:27	1:40	13 -
	BM	6 1/2	12:51	12:52	12:52	12:53	1 fail
		6 1/2	12:55	12:56	12:56	12:58	2
	BV	13 1/4"	see	profile			damp
	CH	4	1:04	1:08	1:08	1:15	7
		10 1/2	1:04	1:08	1:08	1:11	3
	CV	12	H ₂ O	@ 9 1/2			

REMARKS HOLES PER PLAN

TYPE OF SOIL

TESTED BY M. Rifkin

ALSO PRESENT Allen, R. Demmitt

TRENCH DESIGN DATA: AVERAGE PERCOLATION TIME 7

TRENCH WIDTH 3

INLET DEPTH 3

MAXIMUM BOTTOM DEPTH 5

SQ. FT./BEDROOM 180

APPLICATION

PERCOLATION TESTING

A 49860A
P _____

HOWARD COUNTY HEALTH DEPARTMENT
BUREAU OF ENVIRONMENTAL HEALTH
3525-H ELLICOTT MILLS DRIVE/ELLICOTT CITY, MARYLAND 21043
TELEPHONE: 313-2640

DISTRICT _____
DATE _____

TO: THE COUNTY HEALTH OFFICER
ELLICOTT CITY, MARYLAND

I HEREBY APPLY FOR THE NECESSARY TEST PRIOR TO APPLICATION FOR PERMIT TO CONSTRUCT (OR RECONSTRUCT) A SEWAGE DISPOSAL SYSTEM.

PROPERTY OWNER _____

ADDRESS _____ PHONE _____

AGENT OR PROSPECTIVE BUYER _____

ADDRESS _____ PHONE _____

PROPERTY LOCATION:

SUBDIVISION _____ LOT NO. 1

ROAD AND DESCRIPTION _____

TAX MAP _____ PARCEL # _____

SIZE OF LOT _____ TYPE BLDG. _____
(SINGLE FAMILY DWELLING OR COMMERCIAL)

THE SYSTEM INSTALLED UNDER THIS APPLICATION IS ACCEPTABLE ONLY UNTIL PUBLIC FACILITIES BECOME AVAILABLE. I FULLY UNDERSTAND THE
FEE CONNECTED WITH THE FILING OF THIS PERC TEST APPLICATION IS NON-REFUNDABLE UNDER ANY CIRCUMSTANCES. I ALSO AGREE TO
COMPLY WITH ALL M.O.S.H.A. REQUIREMENTS IN TESTING THIS LOT.

(SIGNATURE OF APPLICANT)

APPROVED BY _____ FOR _____ DATE _____

DISAPPROVED BY _____ FOR _____ DATE _____

HOLD PENDING FURTHER TESTS _____

REASONS FOR REJECTION OR HOLDING _____

PERCOLATION TEST PLAT/PRELIMINARY PLAT - TITLE OR I.D. # _____ DATE _____

SITE DEVELOPMENT PLAN/FINAL PLAT - TITLE OR I.D. # _____ DATE _____

THIS IS NOT A PERMIT

INLET DEPTH _____ MAXIMUM BOTTOM DEPTH _____ SQ. FT./BEDROOM _____

C1 3525

SEQUENCE NO.
(DENV USE ONLY)STATE OF MARYLAND
WELL COMPLETION REPORT
FILL IN THIS FORM COMPLETELY
PLEASE PRINT OR TYPETHIS REPORT MUST BE SUBMITTED WITHIN
45 DAYS AFTER WELL IS COMPLETED.COUNTY
NUMBER

A49860B

1 2 3 4 5 6
(THIS NUMBER TO BE PUNCHED
IN COLS. 3-6 ON ALL CARDS)ST/CO USE ONLY
DATE Received

03/03/95

DATE WELL COMPLETED

03/09/95

Depth of Well

22 165 26
(TO NEAREST FOOT)

PERMIT NO.

FROM "PERMIT TO DRILL WELL"

HO-94-0331

OWNER Demmitt Richard
last name first name
STREET OR RFD Springdale Drive TOWN Clarksville
SUBDIVISION Springdale SECTION 1 LOT 1

WELL LOG

Not required for driven wells

STATE THE KIND OF FORMATIONS
PENETRATED, THEIR COLOR, DEPTH,
THICKNESS AND IF WATER BEARINGDESCRIPTION (Use
additional sheets if needed)

FEET

Check
if water
bearingSAND
GRAY MICA
ROCK

0 62

62 165

GROUTING RECORD

WELL HAS BEEN GROUTED
(Circle Appropriate Box)yes ☒ no ☐
44 44

TYPE OF GROUTING MATERIAL

CEMENT ☒ BENTONITE CLAY ☐

NO. OF BAGS 18

NO. OF POUNDS 1692

GALLONS OF WATER 108

DEPTH OF GROUT SEAL (to nearest foot)

from 0 ft. to 54 ft.
(enter 0 if from surface)

CASING RECORD

casing
types
insert
appropriate
code
belowST CO
STEEL CONCRETE
PL OT
PLASTIC OTHERMAIN
CASING
TYPENominal diameter
top (main) casing
(nearest inch)Total depth
of main casing
(nearest foot)

ST

6

66

EACH
CASING

OTHER CASING (if used)

diameter depth (feet)
inch from to☐IN HARD ROCK AREAS, IDENTIFY SPECIFICALLY
WHERE SATURATED FRACTURES WERE OBSERVED.

WELL HYDROFRACTURED

yes ☐ no ☒
Y N

- CIRCLE APPROPRIATE LETTER
-
- A A WELL WAS ABANDONED AND SEALED
-
- WHEN THIS WELL WAS COMPLETED
-
- E ELECTRIC LOG OBTAINED
-
- P TEST WELL CONVERTED TO PRODUCTION
-
- WELL

I HEREBY CERTIFY THAT THIS WELL HAS BEEN CONSTRUCTED IN
ACCORDANCE WITH COMAR 26.04.04 "WELL CONSTRUCTION"
AND IN CONFORMANCE WITH ALL CONDITIONS STATED IN THE
ABOVE CAPTIONED PERMIT, AND THAT THE INFORMATION PRE-
SENTED HEREIN IS ACCURATE AND COMPLETE TO THE BEST OF
MY KNOWLEDGE.

DRILLERS IDENT. NO. 24

DRILLERS SIGNATURE
(MUST MATCH SIGNATURE ON APPLICATION)SITE SUPERVISOR (sign. of driller or journeyman
responsible for sitework if different from permittee)

C2

EACH
SCREEN

1 2 3 100

DEPTH (nearest ft.)

H 0 65 165

SLOT SIZE 1 2 3

DIAMETER OF SCREEN (NEAREST INCH)

GRAVEL PACK

IF WELL DRILLED WAS
FLOWING WELL INSERT
F IN BOX 68MDE USE ONLY
(NOT TO BE FILLED IN BY DRILLER)

T

(E.R.O.S.)

W Q

TELESCOPE
CASINGLOG
INDICATOR

OTHER DATA

C3

1 2

PUMPING TEST

HOURS PUMPED (nearest hour) 3

PUMPING RATE (gal. per min. to nearest gal.) 15

METHOD USED TO MEASURE PUMPING RATE Bucket

WATER LEVEL (distance from land surface)

BEFORE PUMPING 26

WHEN PUMPING 40

TYPE OF PUMP USED (for test)

A air P piston T turbine
C centrifugal R rotary O other (describe below)
J jet S submersible

PUMP INSTALLED

DRILLER WILL INSTALL PUMP YES NO

IF DRILLER INSTALLS PUMP, THIS SECTION
MUST BE COMPLETED FOR ALL WELLS
EXCEPT HOME USE
TYPE OF PUMP INSTALLED
PLACE (A,C,J,P,R,S,T,O)
IN BOX - SEE ABOVE:CAPACITY:
GALLONS PER MINUTE (to nearest gallon)

PUMP HORSE POWER

PUMP COLUMN LENGTH (nearest ft.)

CASING HEIGHT (circle appropriate box
and enter casing height)

LAND SURFACE (nearest foot)

LOCATION OF WELL ON LOT
SHOW PERMANENT STRUCTURE SUCH AS
BUILDING, SEPTIC TANKS, AND/OR
LANDMARKS AND INDICATE NOT LESS
THAN TWO DISTANCES
(MEASUREMENTS TO WELL)See Attached
location


COUNTY



REVISED WSD
 SHEET
 SPRINGDALE ESTATES
 ON
 BRIGHTON DAM ROAD

REVISED LOCATION
 OF POINTS 1-J, 1K

1" = 100'
 1/19/95

2-J
 3-K
 11-F

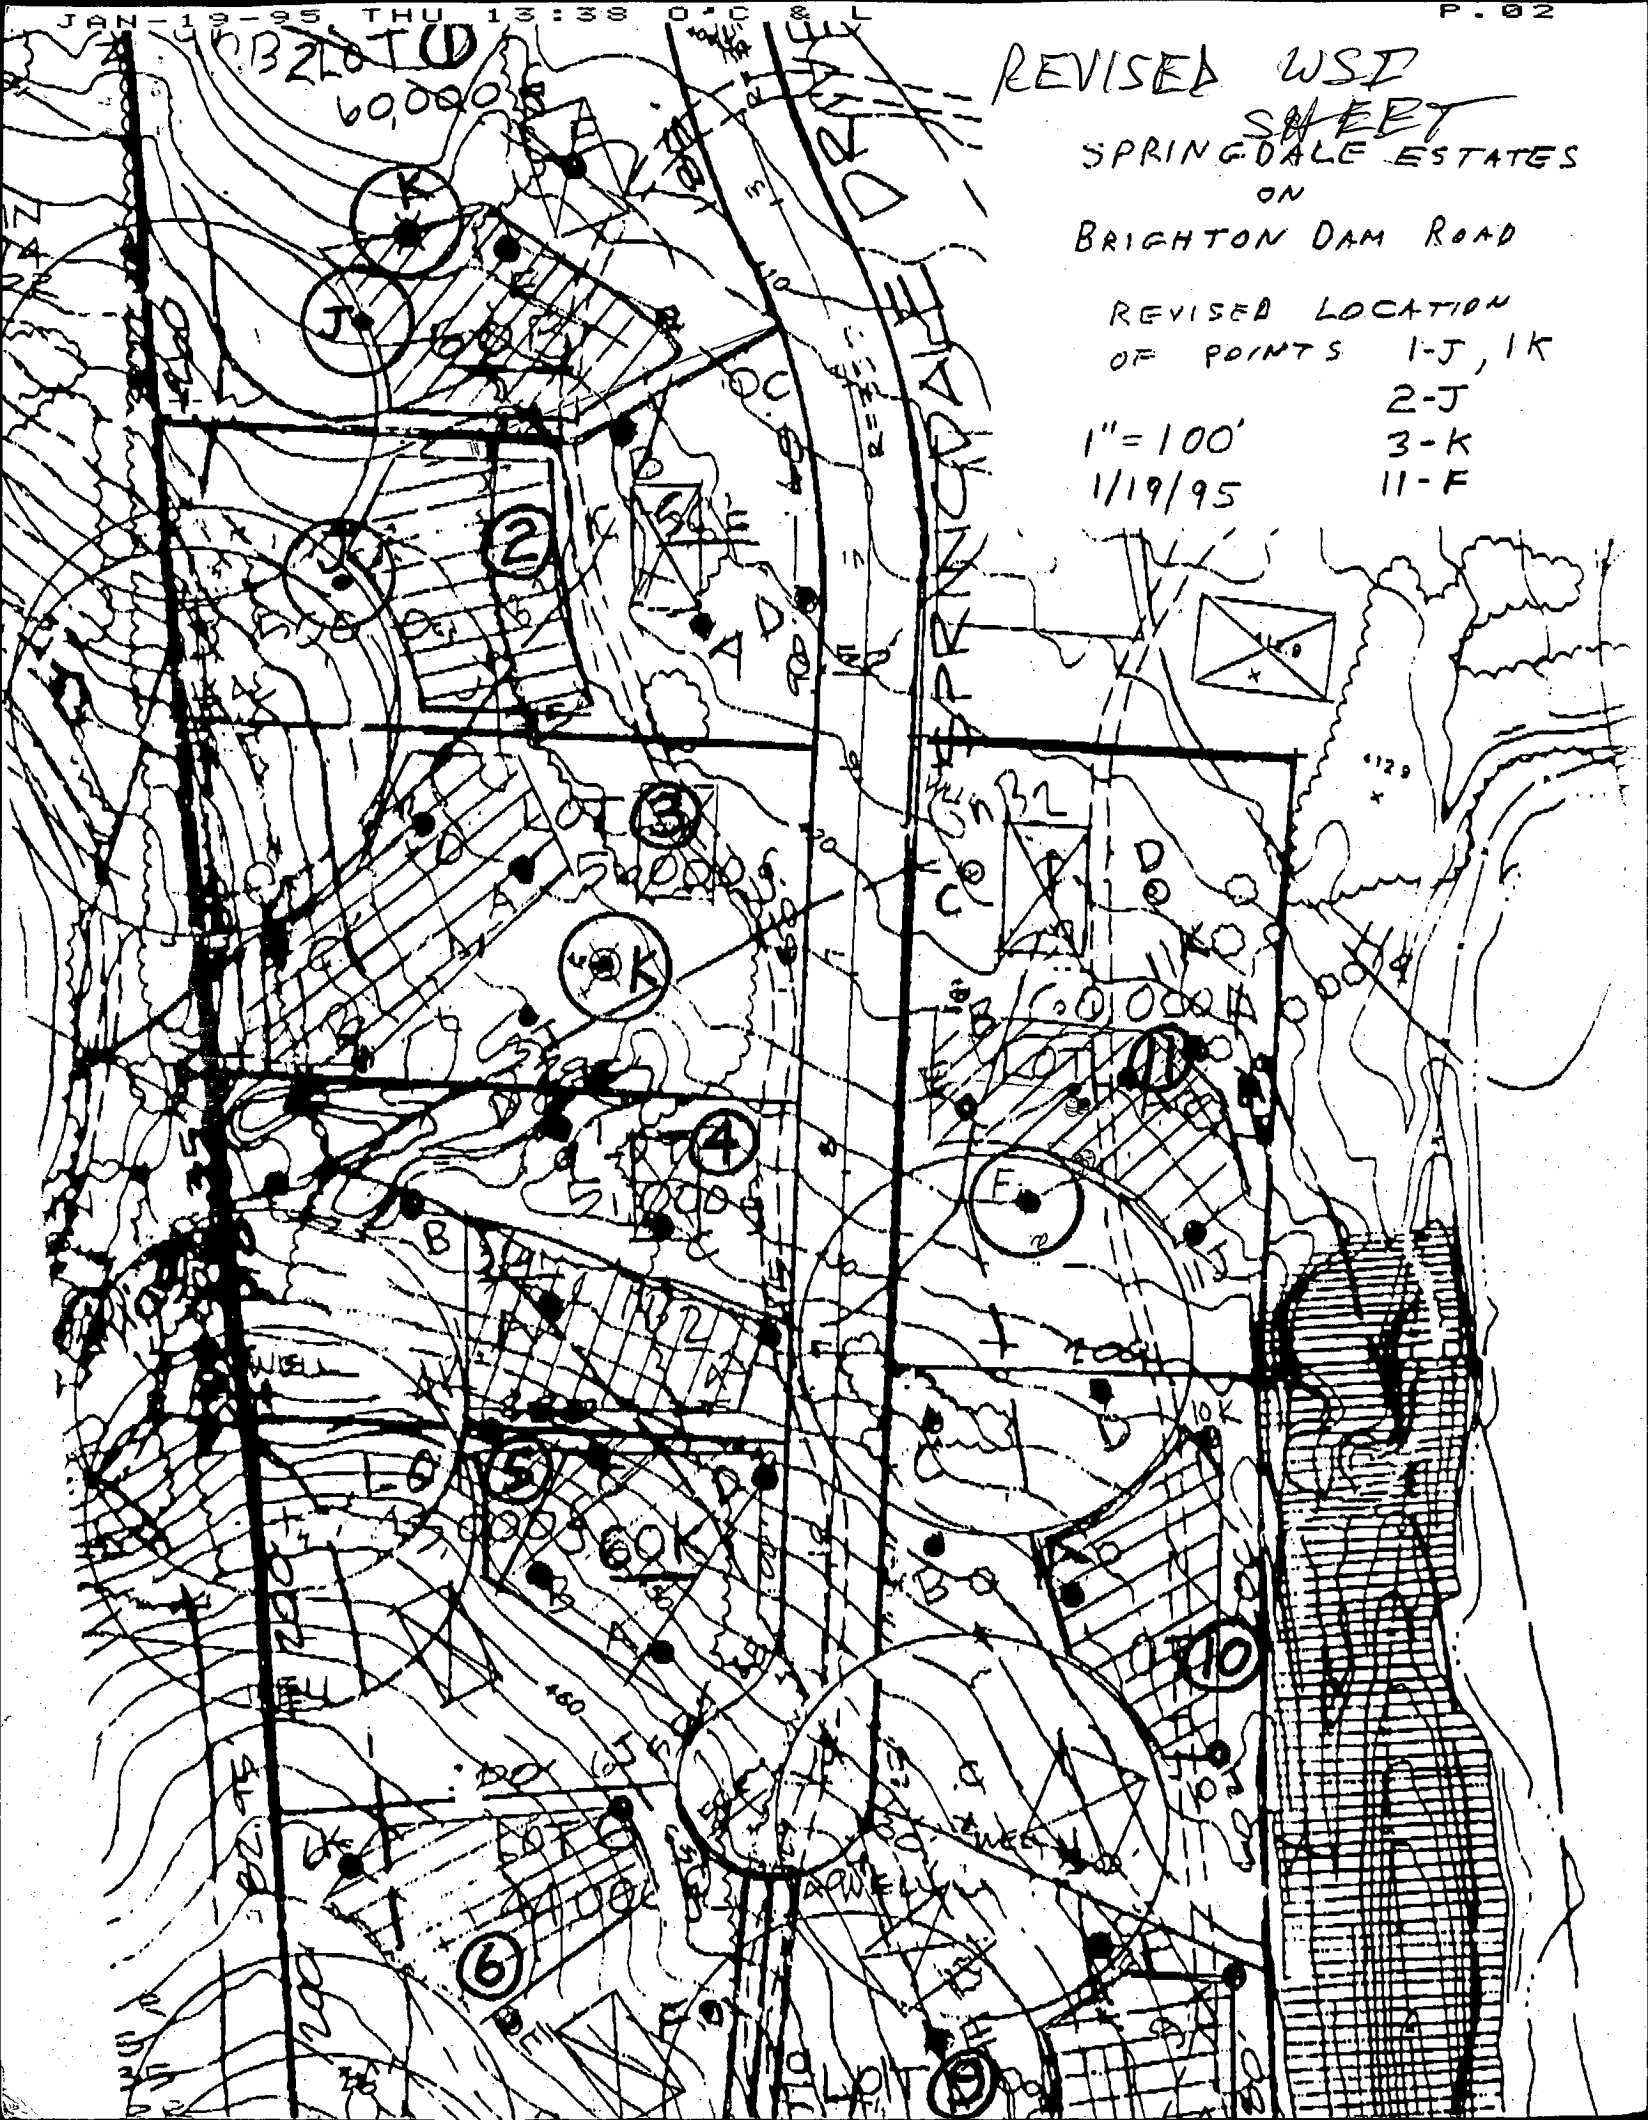

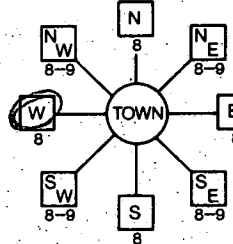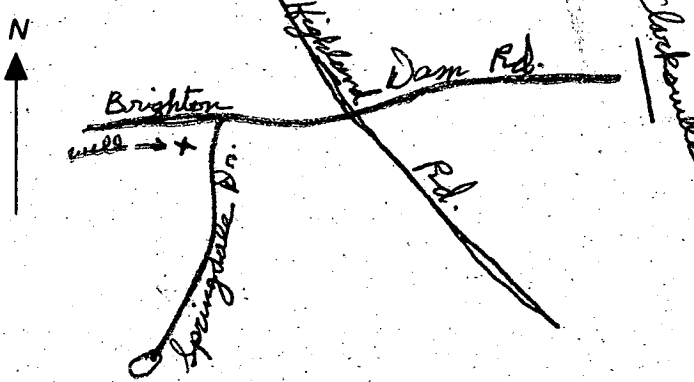B 1 5362	SEQUENCE NO. (DP USE ONLY)	STATE OF MARYLAND APPLICATION FOR PERMIT TO DRILL WELL please print or type	STATE PERMIT NUMBER 40-94-0331 70 fill in this form completely 79
Date Received (APA) 121294		B 3 LOCATION OF WELL	
OWNER INFORMATION 15 Last Name Demmitt 34 Owner First Name RICHARD 36 Street or RFD BOX 228 55 57 Town CLARKSVILLE 70 State 72 MD Zip 76 21029		8 COUNTY HOWARD 21 23 SUBDIVISION SPRINGDALE 42 SECTION 1 LOT 1 44 46 48 50 52 NEAREST TOWN CLARKSVILLE 71 MILES FROM TOWN (enter 0 if in town) 3 73 MI 76 77 78	
DRILLER INFORMATION Driller's Name Joseph L. Mayne 77 License No. 80 24 Firm Name Joseph L. Mayne Well Drilling Address 5512 Ridge Rd. Mt. Airy, Md. 21771 Signature Joseph L. Mayne Date 12/10/94		B 4 DIRECTION OF WELL FROM TOWN (CIRCLE BOX) 	
B 2 WELL INFORMATION APPROX. PUMPING RATE (GAL. PER MIN.) 5 8 12 AVERAGE DAILY QUANTITY NEEDED (GAL. PER DAY) 500 14 20		11' Springdale Drive 30 NEAR WHAT ROAD ON WHICH SIDE OF ROAD (CIRCLE APPROPRIATE BOX) 34 290 37 DISTANCE FROM ROAD ENTER FT OR MI FT 38 39 TAX MAP: _____ BLK: _____ PARCEL: _____	
USE FOR WATER (CIRCLE APPROPRIATE BOX) ☒ HOME (SINGLE OR DOUBLE HOUSEHOLD UNIT ONLY) ☐ FARMING (LIVESTOCK WATERING & AGRICULTURAL IRRIGATION) ☐ INDUSTRIAL, COMMERCIAL, STATE AND FEDERAL GOV. OTHER (REQUIRES APPROPRIATION PERMIT) ☐ PUBLIC OR PRIVATE WATER COMPANY (REQUIRES APPROPRIATION PERMIT AND STATE HEALTH DEPARTMENT APPROVAL) ☐ TEST, OBSERVATION, MONITORING (MAY REQUIRE APPROPRIATION PERMIT)		NOT TO BE FILLED IN BY DRILLER HEALTH DEPARTMENT APPROVAL COUNTY NAME Howard COUNTY NO. A49860 B STATE SIGNATURE _____ DATE ISSUED 021095 INSERT S Mark E. Rifkin 41 43 NORTH GRID 496000 55 EAST GRID 0804000 57 63 50 55 57 63	
APPROXIMATE DEPTH OF WELL 265 24 28 FEET		SHOW MAJOR FEATURES OF BOX & LOCATE WELL WITH AN X SOURCES OF DRILLING WATER 1. WELL 2. 3.	
APPROXIMATE DIAMETER OF WELL 6 INCH NEAREST		WRITE THE BOX NUMBER FROM THE MAP HERE E 8004 N 4906	
METHOD OF DRILLING (circle one) 30 BORED (or Augered) 37 JETTED Jetted & DRIVEN AIR-ROTARY AIR-PERCussion ROTARY (Hydraulic Rotary) CABLE REVERSE-ROTARY Drive-POINT other		DRAW A SKETCH BELOW SHOWING LOCATION OF WELL IN RELATION TO NEARBY TOWNS AND ROADS AND GIVE DISTANCE FROM WELL TO NEAREST ROAD JUNCTION 	
REPLACEMENT OR DEEPEMED WELLS (CIRCLE APPROPRIATE BOX) ☒ THIS WELL WILL NOT REPLACE AN EXISTING WELL ☐ THIS WELL WILL REPLACE A WELL THAT WILL BE ABANDONED AND SEALED 39 ☐ THIS WELL WILL REPLACE A WELL THAT WILL BE USED AS A STANDBY-CONTACT LOCAL APPROVING AUTHORITY FOR POLICY ON STANDBY WELLS ☐ THIS WELL WILL DEEPEMED AN EXISTING WELL PERMIT NUMBER OF WELL TO BE REPLACED OR DEEPEMED (IF AVAILABLE) 41 _____ 52		Not to be filled in by driller (OEP USE ONLY) APPROX. PERMIT NUMBER GAP 54 63 FORCE MR WRITE INITIALS IN BOX PERMIT No. 40-94-0331 70 71 72 73 74 75 76 77 78 79	
SPECIAL CONDITIONS NOTE = APPROVING AUTHORITIES SHOULD USE SEPARATE SHEET IF NEEDED =			

HOWARD COUNTY HEALTH DEPARTMENT
Bureau of Environmental Health
3626-N Ellicott Mills Drive
Ellicott City, MD 21043
461-6933

APPLICATION FOR PITLESS ADAPTER, WELL PUMP AND PRESSURE TANK INSTALLATION

New Installation ☒
Replacement ☐

Receipt # _____
Date _____

Name of Installer

W. Houghby Plumbing, Inc.

Telephone 410-781-7051

License Number

#6792

Certified Well Pump Installer

Well Driller

Registered Plumber ☒

Name of Property Owner

DALE THOMPSON BUILDER

Telephone 410-995-1673

Subdivision

SPRINGDALE BIRCHES Lot 5

Well Tag # 410-94-0337

Site Address

13704 Springdale Dr

CLARKSVILLE, MD 21046

Pump

Motor

Pitless Adapter

1. Type

1. horsepower 1/2 HP

1. Make

HARVARD

a. Deep well jet

2. RPM

2. Model #

b. Shallow well jet

3. Voltage

3. Depth

c. Submersible ☒

a. 110

b. 220 ☒

2. Make

JACUZZI

3. Model #

4. Capacity

5 GPM

5. Pump exceeds well capacity Yes ☐ No ☒

6. If Yes, is low pressure cutoff switch installed? Yes ☐ No ☒

7. What methods are used to protect the pump and electrical wiring from vibrations? Torque arrestors ☒ Cable guards ☒ Other TAPE

Tank

1. Capacity

40 gal

2. Pressure relief

valve? ☒

Piping

1. Type

CRESTLINE

2. Size

1/2"

3. NSF and/or BOCA

Codes approved ☒

4. Depth of supply

line 4 ft

Well data

1. Depth

16.5 ft.

2. Yield

15 GPM

3. Static water

level _____ ft.

4. Will motor supply

be disinfected by

installer? ☒

I understand that it is my responsibility to notify the Howard County Health Department when the installation is ready for inspection (otherwise this permit is null and void).

All information given above is true to the best of my knowledge.

Signature of Applicant:


Chris Hellaughby

Date:

10/19/99

A notation indicating approval/status of the installation will be placed on the well casing at the time of the inspection.

10-215

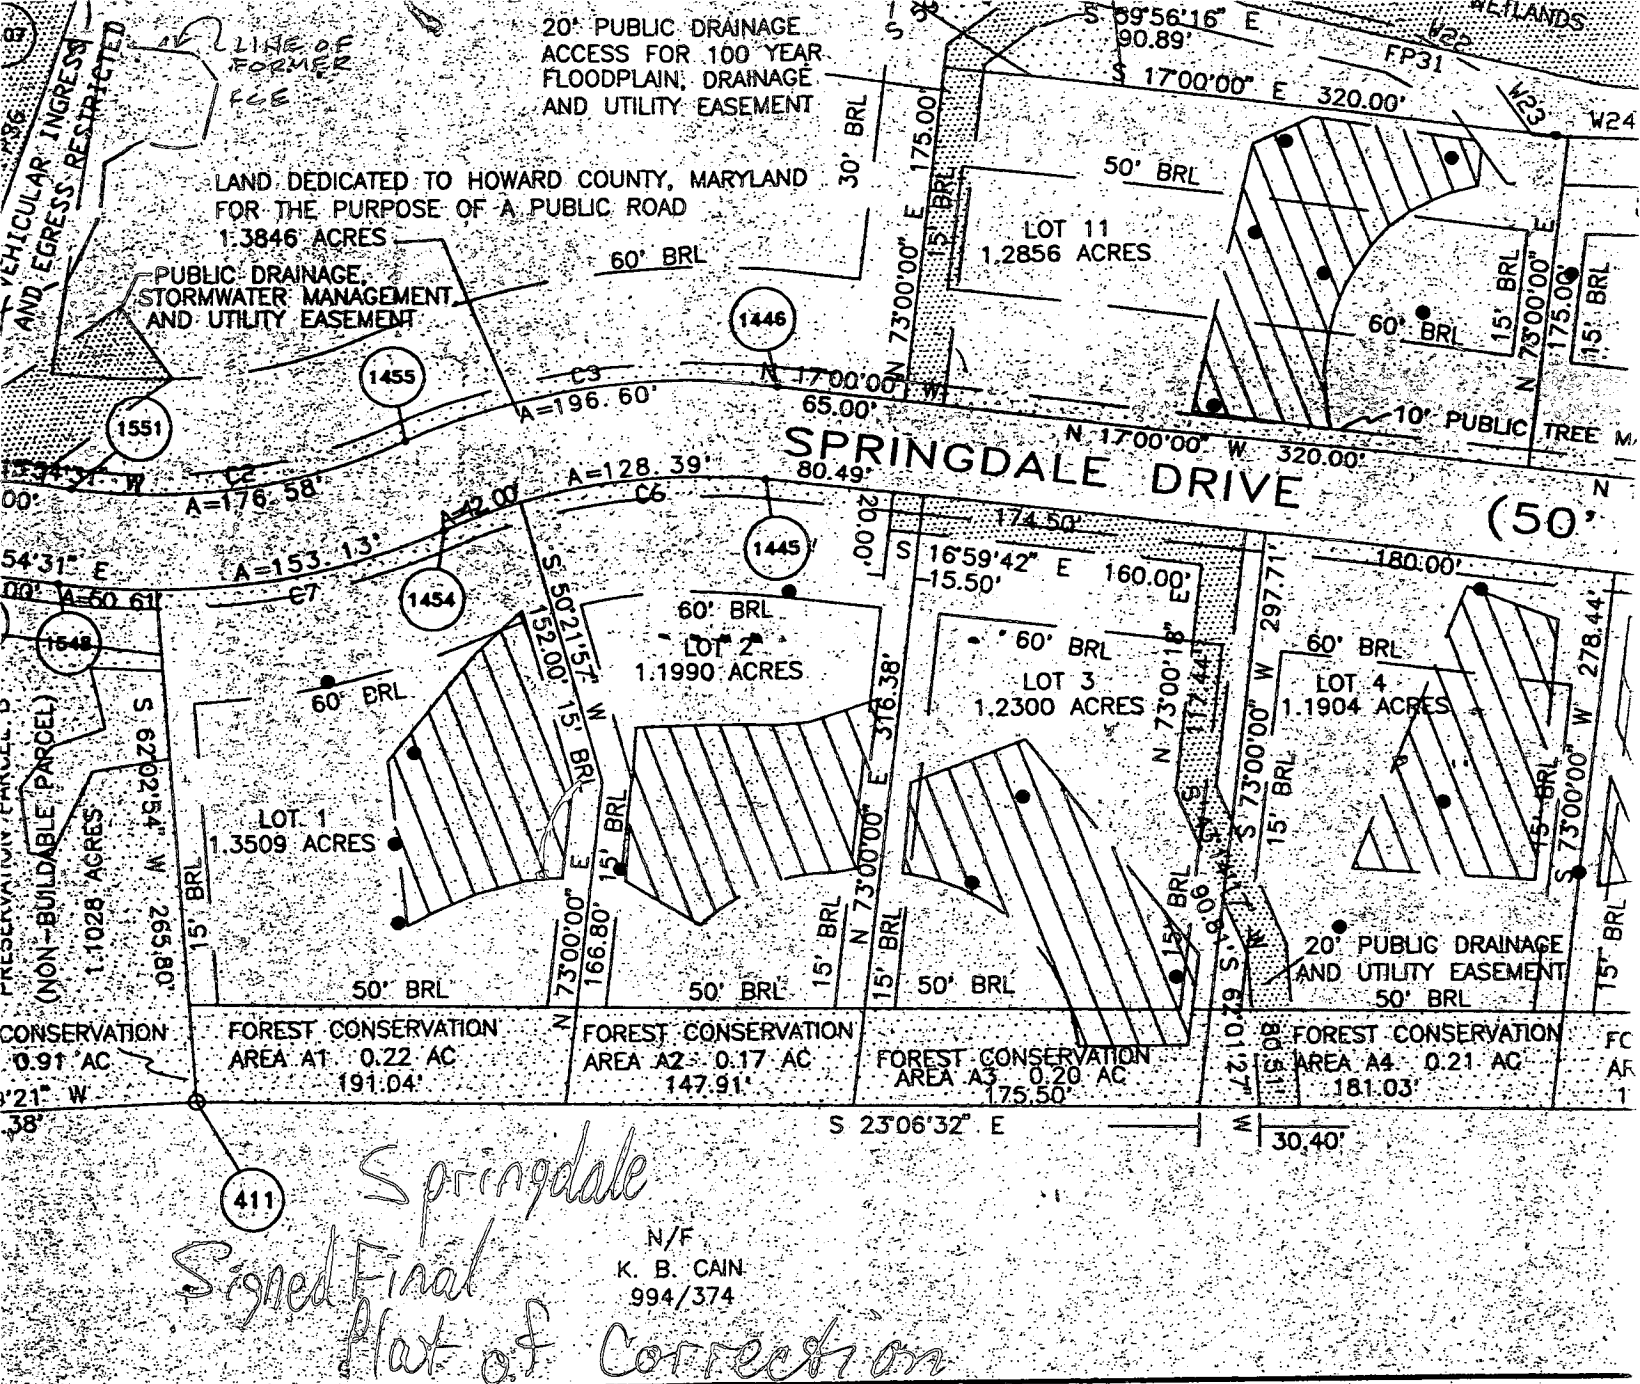

OWNER'S CERTIFICATE

I, the undersigned, by Richard J. Demmitt, President, owner of the Corporation, hereby adopt this plan of subdivision, and in approval of this final plan by the Department of Planning and Public Works, and grant unto Howard County, Maryland, and assigns, (1) the right to lay, construct and maintain streets and other municipal utilities and services in and under all of the lots and the specific easement areas shown hereon, (2) the right and option to Howard County to acquire the fee interest in the streets and/or roads and floodplains, storm drainage easements, where applicable, (3) the right to require dedication of easements for the specific purpose of their construction, repair and maintenance, that no building or similar structure of any kind shall be constructed on the easements and rights-of-way.

This 6th Day of September, 1996

Richard J. Demmitt
President

John N. Thayer
Witness

SURVEYOR'S CERTIFICATE

I hereby certify that the final plat shown is a subdivision of all of the land owned by the Estate of Gary P. Smith by her Attorney in Fact Gary P. Smith, Margaret N. Lear (George M. Lear, Personal Representative), Thomas G. Nichols, Jr., Jennie B. Nichols, Jr., and The Estate of Myrtle M. Nichols, Norman V. Filbert, Personal Representative, Development Corporation, by deed dated and recorded in Liber 3655 at Folio 232 of Howard County, Maryland and that the same place or will be in place prior to the streets in the subdivision by Howard County in accordance with the Annotated Code of Maryland.

Jefferson D. Lawrence
Jefferson D. Lawrence
Md. Reg. Prof. Land Surveyor #5216

UNIT OF

