

4/29/98
2:00
4/30/98
CO. REP

PERMIT

Need to get water line near septic area
Need House Connection

SEWAGE DISPOSAL SYSTEM

DEPARTMENT OF HEALTH AND MENTAL HYGIENE

05-422094

P 510109

A 49860-E

DISTRICT 5th

DATE 4-23-98

HOWARD COUNTY HEALTH DEPARTMENT

BUREAU OF ENVIRONMENTAL HEALTH

410-313-2640

DATE SYSTEM APPROVED 10/1/98

INSPECTOR

Fogle's Septic Clean, Inc. IS PERMITTED TO INSTALL ☒ ALTER

ADDRESS 550 Obrecht Rd, Sykesville, MD 21784 PHONE 410-795-5674

SUBDIVISION Springdale LOT 2 ROAD 13708 Springdale Drive

PROPERTY OWNER Alexander S. Thomas

ADDRESS

SEPTIC TANK CAPACITY 1250 GALLONS TOP SEAMED TANK

NUMBER OF BEDROOMS 4

180 SQUARE FEET PER BEDROOM

LINEAR FEET OF TRENCH REQUIRED 240

TRENCHES - Trench to be 3 feet wide. Inlet 3 feet below original grade. Bottom maximum depth 5 feet below original grade. Effective area begins at 3 feet below original grade. 2 feet of stone below distribution pipe.

LOCATION - Starting from the left rear lot corner, place the distribution box 100 feet down the left lot line and 55 feet off this same lot line. Run trenches on contour in both directions. MAINTAIN 100 FEET FROM TWO (2) NEARBY WELLS TO ALL PARTS OF THE SEPTIC SYSTEM.

NOTES - No trench to exceed 100 feet in length. Provide 6" - 8" diameter cleanout and cap to grade or above on septic tank. OK 4/22/98

PLANS APPROVED BY Mark Rifkin REVISED DATE 04/17/98

COVER NO WORK UNTIL INSPECTED AND APPROVED

NEITHER THE HOWARD COUNTY COUNCIL NOR THE HEALTH DEPARTMENT IS RESPONSIBLE FOR THE SUCCESSFUL OPERATION OF ANY SYSTEM

NOTE: CLEANOUT REQUIRED EVERY 70 FEET OF SEWER LINE AND/OR AT 90° SWEEPS IN LINES FROM HOUSE TO DRAIN FIELDS, 90° ELBOWS NOT ACCEPTABLE.

NOTE: ALL PARTS OF SEPTIC SYSTEMS (I.E. TANK, DISTRIBUTION BOX TRENCHES) TO BE 100 FEET FROM WELL (UNLESS OTHERWISE SPECIFICALLY AUTHORIZED)

NOTE: IF DEEP TRENCH(ES) ARE USED CALL FOR INSPECTION BEFORE AND AFTER PLACING GRAVEL IN TRENCH(ES)

NOTE: NO DRY WELL SHALL EXCEED 15 FOOT IN DIAMETER NO ABSORPTION TRENCH TO EXCEED 100 FEET IN LENGTH

NOTE: ALL PIPE FROM HOUSE TO SEPTIC TANK MUST BE CAST IRON OR SCHEDULE 35/40 PVC OR ABS

PERMIT VOID AFTER TWO YEARS

NOTE: INSTALL STAND PIPE ON SEPTIC TANK AND DRY WELL STAND PIPES MUST BE 6 INCHES IN DIAMETER CAST IRON, CONCRETE OR TERRA COTTA OR PVA OR ABS ACCEPTED. IF TOP OF SEPTIC TANK IS DEEPER THAN 3 FEET. MANHOLE TO GRADE REQUIRED.

NOTE: DISTRIBUTION BOXES MUST HAVE BAFFLES

*INSTALLER IS RESPONSIBLE FOR OBTAINING FINAL APPROVAL ON THIS PERMIT

A 49860 E

WPF
6/25/98

HOWARD COUNTY HEALTH DEPARTMENT
Bureau of Environmental Health
3525-N Ellicott Mills Drive
Ellicott City, MD 21043
461-0233

6.25.98
needs 2 piece cap
P.A. 4.0' below grade
Casing 10" above grade
line steered out of house
(KMO)

P01

APPLICATION FOR PITLESS ADAPTER, WELL PUMP AND PRESSURE TANK INSTALLATION

New Installation ☒ Replacement ☐
Name of Installer Willoughby Plumbing Receipt # _____ Date _____
License Number 6992 Telephone 410-781-7051
Certified Well Pump Installer _____ Well Driller _____ Registered Plumber ☒
Name of Property Owner Alexander Thomas Telephone _____
Subdivision SPRINGFIELD ESTATES Lot # 2 Well Tag # HO-94-0332
Site Address 11081 SPRINGDALE DRIVE
CLARK

PUMP
1. Type
a. Deep well jet _____
b. Shallow well jet _____
c. Submersible ☒
2. Make JACO
3. Model # _____
4. Capacity _____ GPM
5. Pump exceeds well capacity Yes _____ No ☒
6. If Yes, is low pressure cutoff switch installed? Yes _____ No _____
7. What methods are used to protect the pump and electrical wiring from vibration? _____
Torque arresters ☒ Cable guards ☒ Other TAPE
TANK
1. Capacity 40gal
2. Pressure relief valve? yes
Piping CRESTLINE
1. Type _____
2. Size 1"
3. NSF and/or BOCA Code approved YES
4. Depth of supply line 4 ft
Well data
1. Depth 70 ft.
2. Yield 15 GPM
3. Static water level 33 ft.
4. Will water supply be affected by installer? _____

I understand that it is my responsibility to notify the Howard County Health Department when the installation is ready for inspection (otherwise this permit is null and void).

All information given above is true to the best of my knowledge.

Signature of Applicant: Chris Willoughby Pres
Date: 6/25/98

Note: A sticker indicating approval/status of the installation will be placed on the well casing at the time of the inspection.

Approved Septic System Plan
Howard County Health Department

Mark E. R. Khan 4/3/98
Signature Date

SEWERAGE EASEMENT
TO BE ABANDONED —

PRIVATE SEWERAGE
EASEMENT

SEWERAGE EASEMENT
TO BE ADDED

FOREST CONSERVATION

NORTH

SPRINGDALE DRIVE

FF. 423.5
BASE 44.5

SEPTIC
TANK /
DISTRIBUTION BOX
CLEANOUTS (2)

See Septic Profile
~~This Sheet~~

Total linear feet of trench
required 240 feet

Width of trench(es) 3 feet

Depth of trench(es) 5 feet

Depth of stone required below
distribution pipe 2 feet

Septic Grades & Elevations		Inv.	Grade
INVERT @ DISTRIBUTION		420.0	423.4
INVERT @ TANK OUTLET		420.7	423.5
INVERT @ TANK INLET		421.0	423.5
INVERT @ HOUSE		421.3	423.8

APPLICATION

PERCOLATION TESTING

A 49860 E

P _____

HOWARD COUNTY HEALTH DEPARTMENT

BUREAU OF ENVIRONMENTAL HEALTH

3525-H ELLICOTT MILLS DRIVE/ELLICOTT CITY, MARYLAND 21043
TELEPHONE: 313-2640

DISTRICT _____

DATE _____

TO: THE COUNTY HEALTH OFFICER
ELLICOTT CITY, MARYLAND

I HEREBY APPLY FOR THE NECESSARY TEST PRIOR TO APPLICATION FOR PERMIT TO CONSTRUCT (OR RECONSTRUCT) A SEWAGE DISPOSAL SYSTEM.

PROPERTY OWNER ALEXANDER S. THOMAS

ADDRESS _____ PHONE _____

AGENT OR PROSPECTIVE BUYER _____

ADDRESS _____ PHONE _____

PROPERTY LOCATION:

SUBDIVISION Springdale LOT NO. Lot B 2 on perc cert

ROAD AND DESCRIPTION (13708 Springdale Estates)

TAX MAP _____ PARCEL # _____

SIZE OF LOT _____ TYPE BLDG. _____

BLDG. PERMIT SIGNED

AND RETURNED 4-3-98

Serial # 81110159

SFD - 4000

(SINGLE FAMILY DWELLING OR COMMERCIAL)

THE SYSTEM INSTALLED UNDER THIS APPLICATION IS ACCEPTABLE ONLY UNTIL PUBLIC FACILITIES BECOME AVAILABLE. I FULLY UNDERSTAND THE

FEE CONNECTED WITH THE FILING OF THIS PERC TEST APPLICATION IS NON-REFUNDABLE UNDER ANY CIRCUMSTANCES. I ALSO AGREE TO

COMPLY WITH ALL M.O.S.H.A. REQUIREMENTS IN TESTING THIS LOT. _____

(SIGNATURE OF APPLICANT)

APPROVED BY _____ FOR _____ DATE _____

DISAPPROVED BY _____ FOR _____ DATE _____

HOLD PENDING FURTHER TESTS _____

REASONS FOR REJECTION OR HOLDING PERC OK, HOLD FOR PLAT MR 8/17/94

PERCOLATION TEST PLAT/PRELIMINARY PLAT - TITLE OR I.D. # _____ DATE _____

SITE DEVELOPMENT PLAN/FINAL PLAT - TITLE OR I.D. # _____ DATE _____

THIS IS NOT A PERMIT

49860 E

COUNTY #

Lot 3

SOIL PROFILE

0'

org yel
si cl lm
tan
gray
brn
si sa
lm
L5%
frags

14 1/2

①

FILL

2 1/2

3 1/2

old
topsoil
dk-brn
lt. gray
tan org
si sa
mica lm
L5% frags

14


②

red br
si cl
cl lm
tan
mica
sa
lm
10% frags

4.5

SOIL DAMP

13' 4"

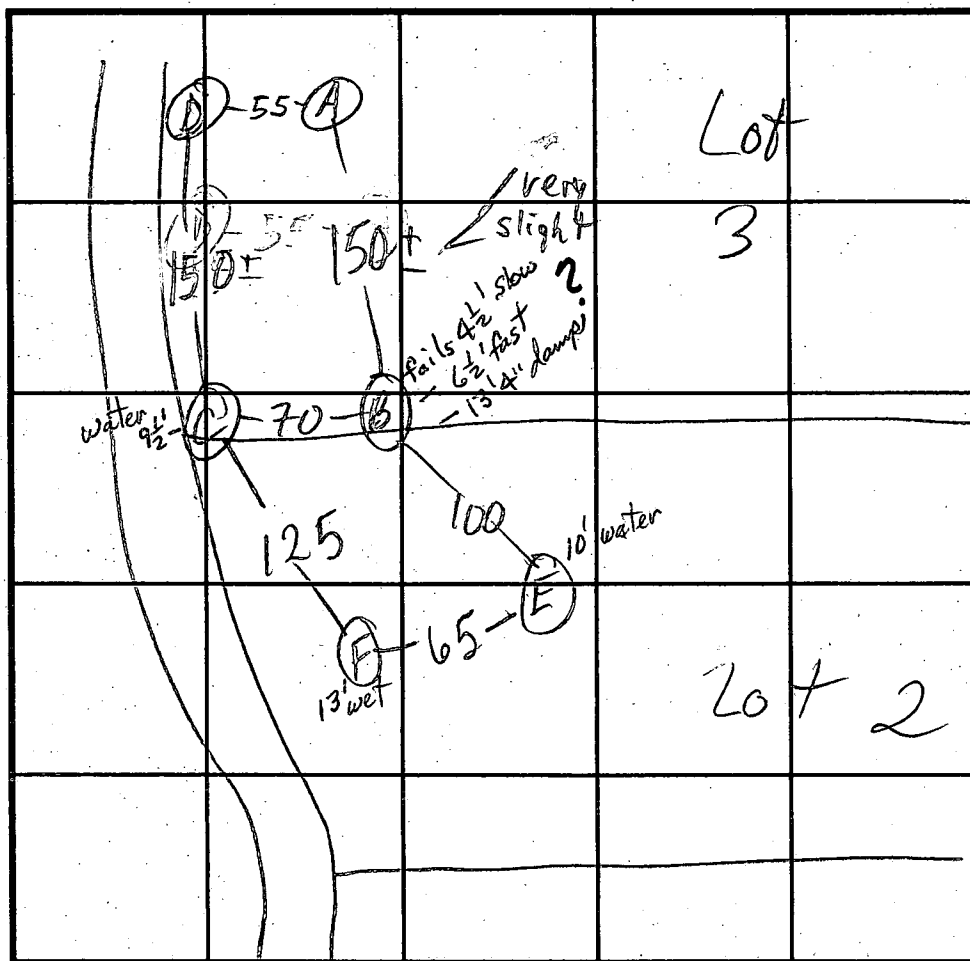

INDICATE NORTH - NAME ADJOINING ROADWAY AS BASE LINE.

SOIL PROFILE

0'

org
brn
red
br
sa mica
lm
WATER

2-3

9 1/2

12

DATE	TEST NO.	DEPTH	PRE-WET		TEST - 1" DROP		TIME
			START	STOP	START	STOP	
3/7/84	A S	14 1/2	12:13	12:17	STORM	THAN IN HOLE	3
	A V	14 1/2	see	profile			
	D S	4 1/2	12:18	12:20	12:20	12:25	5 EST
	D V	14	see	profile			
	C S	4	1:04	1:08	1:08	1:15	7
	C M	10 1/2	1:04	1:08	1:08	1:11	3
	C V	12	H ₂ O	@ 9 1/2			
	B M	4 1/2	12:50	1:00	12:53	FAST	
	B M	6 1/2	12:51				
	B V	13' 4"	12:55	12:56	12:56	12:58	2
	B S2	5	1:22	1:27	1:27	1:40	13

REMARKS HOLES PER PLAN

TYPE OF SOIL

TESTED BY M. Rifkin

ALSO PRESENT Allen, Demmitt

TRENCH DESIGN DATA: AVERAGE PERCOLATION TIME 5 1/2

TRENCH WIDTH 3

INLET DEPTH 3

MAXIMUM BOTTOM DEPTH 5

SQ. FT./BEDROOM 180

APPLICATION

PERCOLATION TESTING

A _____

P _____

HOWARD COUNTY HEALTH DEPARTMENT

BUREAU OF ENVIRONMENTAL HEALTH

3525-H ELLICOTT MILLS DRIVE/ELLICOTT CITY, MARYLAND 21043
TELEPHONE: 313-2640

DISTRICT _____

DATE _____

TO: THE COUNTY HEALTH OFFICER
ELLICOTT CITY, MARYLAND

I HEREBY APPLY FOR THE NECESSARY TEST PRIOR TO APPLICATION FOR PERMIT TO CONSTRUCT (OR RECONSTRUCT) A SEWAGE DISPOSAL SYSTEM.

PROPERTY OWNER _____

ADDRESS _____ PHONE _____

AGENT OR PROSPECTIVE BUYER _____

ADDRESS _____ PHONE _____

PROPERTY LOCATION:

SUBDIVISION _____ LOT NO. 2

ROAD AND DESCRIPTION _____

TAX MAP _____ PARCEL # _____

SIZE OF LOT _____ TYPE BLDG. _____
(SINGLE FAMILY DWELLING OR COMMERCIAL)

THE SYSTEM INSTALLED UNDER THIS APPLICATION IS ACCEPTABLE ONLY UNTIL PUBLIC FACILITIES BECOME AVAILABLE. I FULLY UNDERSTAND THE
FEE CONNECTED WITH THE FILING OF THIS PERC TEST APPLICATION IS NON-REFUNDABLE UNDER ANY CIRCUMSTANCES. I ALSO AGREE TO
COMPLY WITH ALL M.O.S.H.A. REQUIREMENTS IN TESTING THIS LOT. _____

(SIGNATURE OF APPLICANT)

APPROVED BY _____ FOR _____ DATE _____

DISAPPROVED BY _____ FOR _____ DATE _____

HOLD PENDING FURTHER TESTS _____

REASONS FOR REJECTION OR HOLDING _____


PERCOLATION TEST PLAT/PRELIMINARY PLAT - TITLE OR I.D. # _____ DATE _____

SITE DEVELOPMENT PLAN/FINAL PLAT - TITLE OR I.D. # _____ DATE _____

THIS IS NOT A PERMIT

$12\frac{1}{2}$

0

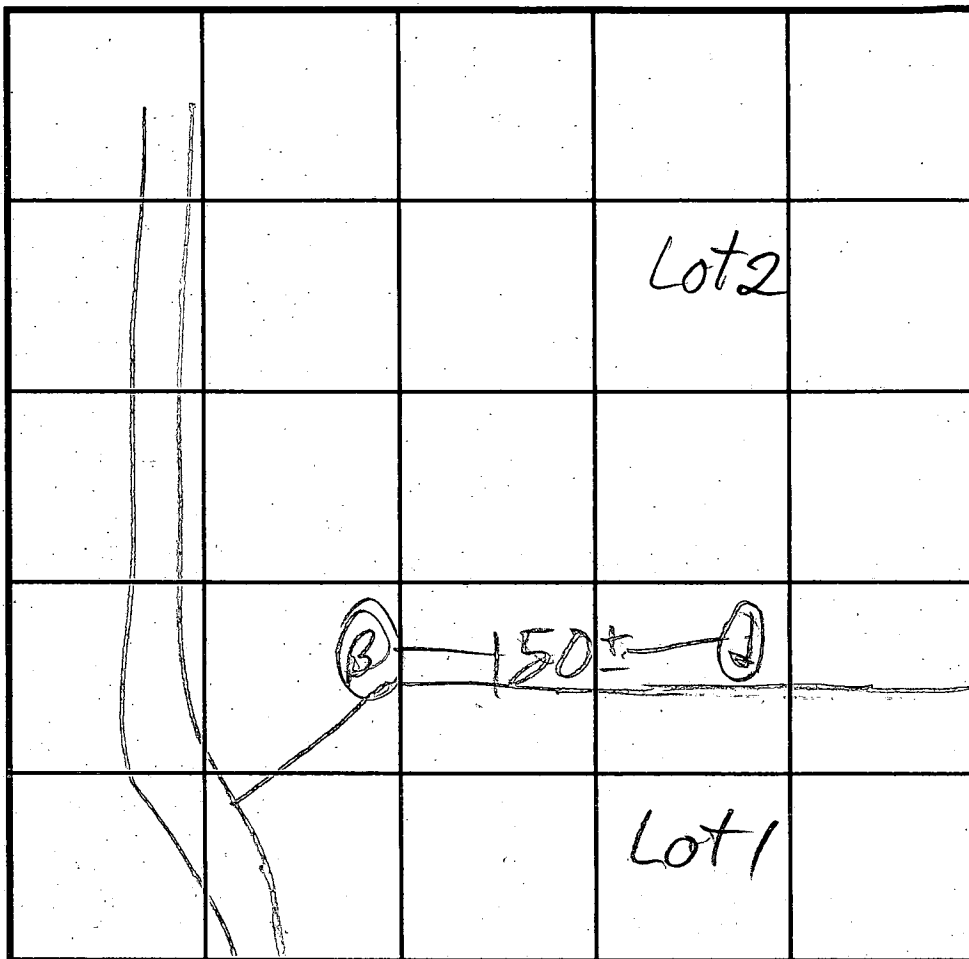

INDICATE NORTH - NAME ADJOINING ROADWAY AS BASE LINE.

[illegible]

REMARKS _____

TYPE OF SOIL _____

TESTED BY M. Kitchin ALSO PRESENT R. D. J. Allen


TRENCH DESIGN DATA: AVERAGE PERCOLATION TIME 2 TRENCH WIDTH 1

INLET DEPTH	MAXIMUM BOTTOM DEPTH	SQ. FT./BEDROOM

PUBLIC 100 YEAR FLOODPLAIN, DRAINAGE,
AND UTILITY EASEMENT

5' STREAMBANK BUFFER

PUBLIC 100 YEAR FLOODPLAIN, DRAINAGE, ACCESS FOR
100 YEAR FLOODPLAIN, DRAINAGE AND UTILITY EASEMENT
25' WETLANDS BUFFER
LIMIT OF WETLANDS
W13

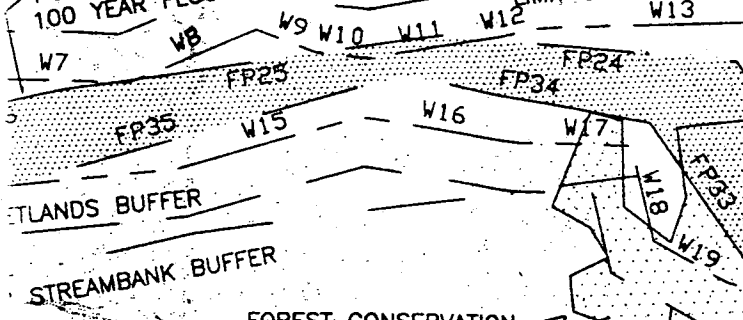


FOREST CONSERVATION
AREA C 0.38 AC

20' PUBLIC DRAINAGE
ACCESS FOR 100 YEAR
FLOODPLAIN, DRAINAGE
AND UTILITY EASEMENT

AND DEDICATED TO HOWARD COUNTY, MARYLAND
FOR THE PURPOSE OF A PUBLIC ROAD
3846 ACRES

DRAINAGE,
WATER MANAGEMENT,
UTILITY EASEMENT

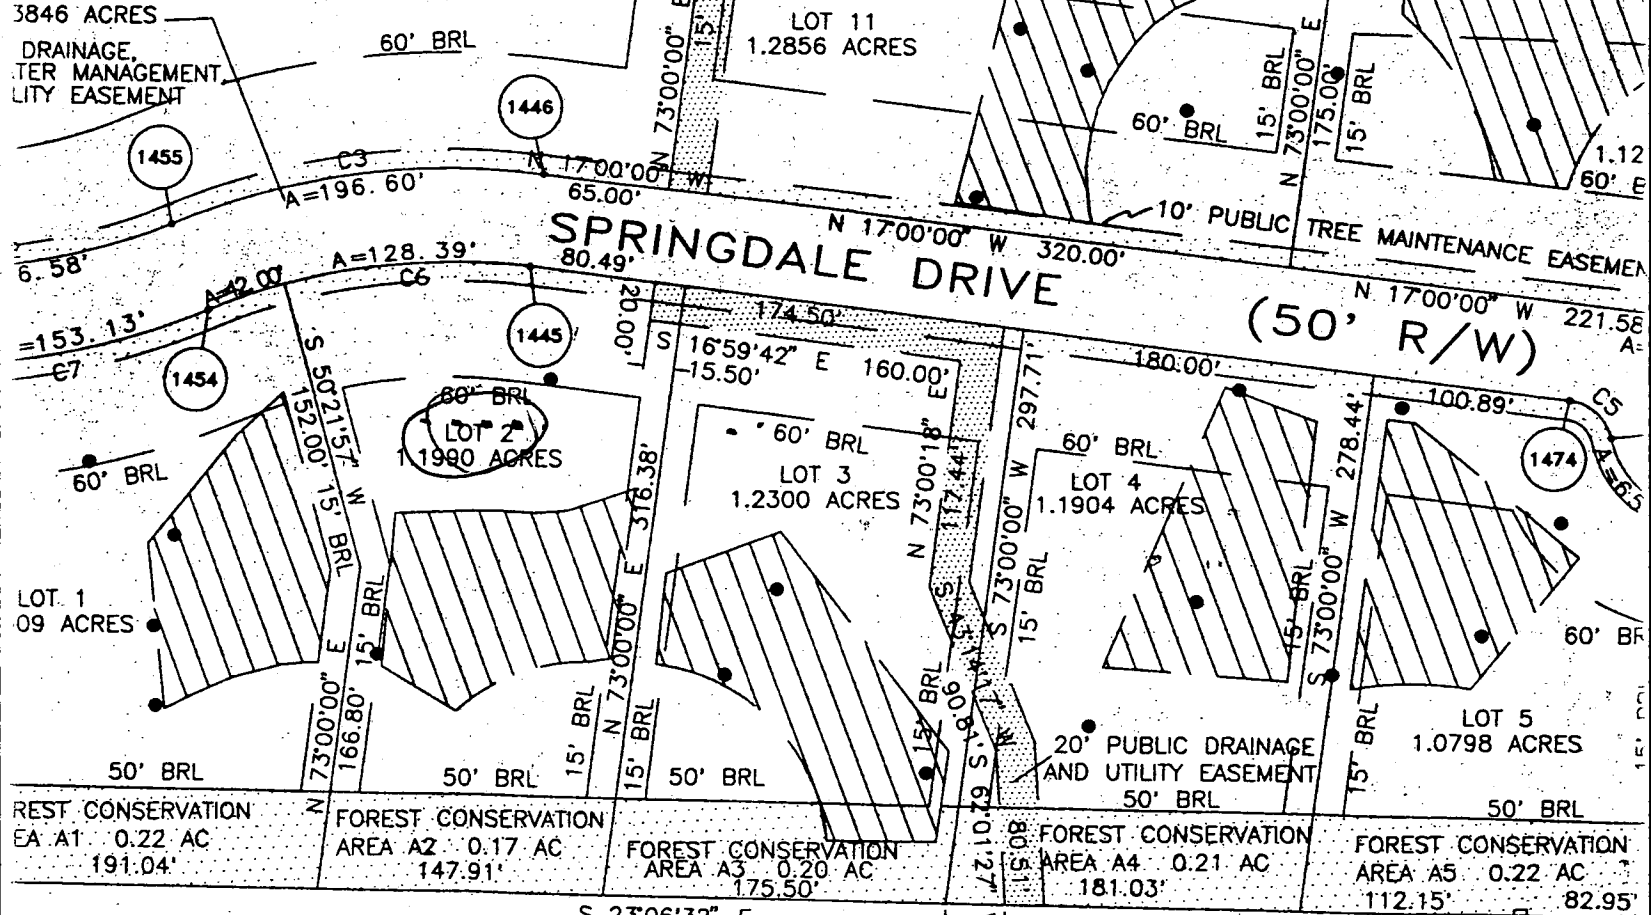

SPRINGDALE DRIVE

(50' R/W)

N/F
K. B. CAIN
994/374

Signed Final
F-97-47

CERTIFICATE

SURVEYOR'S CERTIFICATE

APPLICATION

HOWARD COUNTY

PERMIT APPLICATION

DEPARTMENT OF INSPECTIONS, LICENSES & PERMIT
3430 COURT HOUSE DRIVE, ELLICOTT CITY, MARYLAND 21043

SERIAL NUMBER

B00110159

BUILDING ADDRESS (HOUSE NO., STREET, TOWN OR AREA)

13708 SPRINGDALE DRIVE
CLARKENVILLE, MD 21029GRADING/SEDIMENT CONTROL ☐ YES ☐ NO

SDP #

DESCRIPTION OF WORK AUTHORIZED

UNFINISHED BASEMENT

4 BRS

3 1/2 BATHS

1 FP

NO DECK

2-CAZ GARAGE ATTACHED

SINGLE FAMILY
DWELLING

LOT NO. PARCEL NO. SEC. AREA BLOCK NO. LIBER FOLIO

2 60 - - 14 - -
SUB DIVISION ZONE ZONE MAP ELEC. DIST. CENSUS TR.
SPRINGDALE ESTATE 34 5 60510

OWNER NAME AND ADDRESS

PHONE NO.

ALEXANDER S. THOMAS
9409 N. PENFIELD RD.
COLUMBIA, MD 21045

PHONE NO.

SAME AS ABOVE

ARCHITECT OR ENGINEER'S NAME AND ADDRESS

PHONE NO.

DALE THOMPSON BUILDERS
8005 OLD COLUMBIA RD.
COLUMBIA, MD 21046

PHONE NO.

CONTRACTOR'S NAME AND ADDRESS

SAME AS ABOVE

EXISTING USE

PROPOSED USE

UNIMPROVED LOT

SINGLE FAMILY
DWELLING

EST. CONSTRUCTION COST

\$350,000

LICENSE NUMBER

914941

PERMIT FEE

W/S CODE

FOR OFFICE USE ONLY

DISTANCE IN FEET FROM R/W LINE TO FRONT BUILDING LINE

SIDE YARD

(DISTANCE IN FEET FROM SIDE BLDG. LINE TO SIDE PROPERTY LINE)

TO SIDE BUILDING LINE

DISTANCE IN FEET, REAR YD. REQUIRING SET

BACK (CORNER LOT ONLY)

SDP #

Check payable to: DIRECTOR OF FINANCE OF HOWARD COUNTY

CAUTION

To begin construction before a permit placard has been issued and displayed on the job is a violation of the law.

Use and occupancy permit must be applied for two weeks before it will be issued.

IMPORTANT: PLEASE SHOW ZIP CODES AND AREA CODES WHEREVER REQUIRED.

LP-69-591

11950

Distribution of Copies:

White - Building Official
Green - Planning & Zoning

Yellow - Engineering

Pink - Health Dept.
Gold - S.H.A.

FUNCTION	DATE	SIGNATURE APPROVAL
ZONING/PLANNING	X	
SHA	X	
SEDIMENT/GRADING	X	
BUILDING OFFICIAL	X	
WATER & SEWER		
HEALTH DEPT.	4/3/98	Mark E. [Signature]
FIRE PROTECTION		
STORM WATER MGMT	X	

APPROVED

DATE



HOWARD COUNTY HEALTH DEPARTMENT

Joyce M. Boyd, M.D., County Health Officer

February 27, 1998

MEMORANDUM

TO: Mr. Alexander S. Thomas
9409 N. Penfield Road
Columbia, MD 21045

FROM: Donna K. Soe, R.S.
Water and Sewerage Program

RE: BP# B00110159
13708 Springdale Drive

This office has recently received the above referenced building permit application. However, we are unable to approve the application at this time for the following reason(s):

- ☐ No water supply has been established to serve the proposed dwelling. (Please submit a copy of the well completion report for review, along with a revised site plan showing actual well location.)
- ☐ No septic elevations have been provided on the site plan submitted.
- ☐ Incorrect septic specifications utilized in proposed septic system design. (See enclosure)
- ☐ No invert elevation(s) provided for: _____
- ☐ Proposed house to _____ less than _____ feet.
- ☐ Existing well to _____ less than _____ feet.
- ☐ Sewage easement location/configuration incorrect. (See enclosure)
- ☒ Other: proposed modification to septic easement not acceptable due to location of existing well on Lot #1.

If you have any questions or concerns, please contact Donna K. Soe
at (410) 313-2640.

Enclosure
cc: file / Dale Thompson Builders

Bureau of Environmental Health
3525-H Ellicott Mills Drive Ellicott City, Maryland 21043-4544
Water and Sewerage, Permits (410) 313-2640 Community Environmental Health (410) 313-2644
Food Protection Program (410) 313-2642 TDD (410) 313-2323

C 1 3526

SEQUENCE NO.
(DENV USE ONLY)STATE OF MARYLAND
WELL COMPLETION REPORT
FILL IN THIS FORM COMPLETELY
PLEASE PRINT OR TYPETHIS REPORT MUST BE SUBMITTED WITHIN
45 DAYS AFTER WELL IS COMPLETED.COUNTY
NUMBER A49860EST/CO USE ONLY
DATE Received

032395

DATE WELL COMPLETED

031095

Depth of Well

22 70 26
(TO NEAREST FOOT)PERMIT NO.
FROM "PERMIT TO DRILL WELL"

H0-94-0332

OWNER Demmitt Richard
STREET OR RFD Springdale Drive first name TOWN Clarksville
SUBDIVISION Springdale SECTION LOT 2

WELL LOG

Not required for driven wells

STATE THE KIND OF FORMATIONS
PENETRATED, THEIR COLOR, DEPTH,
THICKNESS AND IF WATER BEARING

DESCRIPTION (Use additional sheets if needed)	FEET		Check if water bearing
	FROM	TO	
SAND & GRAVEL mixed	0	62	✓
GRAY MICAC ROCK	62	70	✓

GROUTING RECORD

WELL HAS BEEN GROUTED.
(Circle Appropriate Box)yes ☒ no ☐
44 44

TYPE OF GROUTING MATERIAL

CEMENT ☒ BENTONITE CLAY ☒NO. OF BAGS 21 NO. OF POUNDS 1974GALLONS OF WATER 126

DEPTH OF GROUT SEAL (to nearest foot)

from 0 ft. to 57 ft.
(enter 0 if from surface)

CASING RECORD

casing
types
insert
appropriate
code
belowST CO
STEEL CONCRETE
PL OT
PLASTIC OTHERMAIN CASING TYPE Nominal diameter
top (main) casing (nearest inch) Total depth
of main casing (nearest foot)

ST 6 66

OTHER CASING (if used)
diameter depth (feet)
inch from toscreen type or open hole
insert appropriate code below
ST BR HO
STEEL BRASS OPEN
PL BRONZE HOLE
PLASTIC OTHERIN HARD ROCK AREAS, IDENTIFY SPECIFICALLY
WHERE SATURATED FRACTURES WERE OBSERVED.

WELL HYDROFRACTURED

yes ☐ no ☒
Y N

CIRCLE APPROPRIATE LETTER

A A WELL WAS ABANDONED AND SEALED
WHEN THIS WELL WAS COMPLETED

E ELECTRIC LOG OBTAINED

P TEST WELL CONVERTED TO PRODUCTION
WELLI HEREBY CERTIFY THAT THIS WELL HAS BEEN CONSTRUCTED IN
ACCORDANCE WITH COMAR 26.04.04 "WELL CONSTRUCTION"
AND IN CONFORMANCE WITH ALL CONDITIONS STATED IN THE
ABOVE CAPTIONED PERMIT, AND THAT THE INFORMATION PRE-
SENTED HEREIN IS ACCURATE AND COMPLETE TO THE BEST OF
MY KNOWLEDGE.DRILLERS IDENT. NO. 24DRILLERS SIGNATURE
(MUST MATCH SIGNATURE ON APPLICATION)SITE SUPERVISOR (sign. of driller or journeyman
responsible for sitework if different from permittee)GRAVEL PACK
IF WELL DRILLED WAS
FLOWING WELL INSERT
F IN BOX 68MDE USE ONLY
(NOT TO BE FILLED IN BY DRILLER)

T (E.R.O.S.)

70 72

TELESCOPE CASING LOG
INDICATOR

W Q

74 75 76

OTHER DATA

C 3

PUMPING TEST

HOURS PUMPED (nearest hour) 3PUMPING RATE (gal. per min. to nearest gal.) 1.5METHOD USED TO MEASURE PUMPING RATE Bucket

WATER LEVEL (distance from land surface)

BEFORE PUMPING 33WHEN PUMPING 33

TYPE OF PUMP USED (for test)

A air P piston T turbine
C centrifugal R rotary O other (describe below)
J jet S submersible

PUMP INSTALLED

DRILLER WILL INSTALL PUMP YES ☒ NO ☐IF DRILLER INSTALLS PUMP, THIS SECTION
MUST BE COMPLETED FOR ALL WELLS
EXCEPT HOME USETYPE OF PUMP INSTALLED
PLACE (A,C,J,P,R,S,T,O)
IN BOX - SEE ABOVE:CAPACITY:
GALLONS PER MINUTE (to nearest gallon)

PUMP HORSE POWER

PUMP COLUMN LENGTH (nearest ft.)

CASING HEIGHT (circle appropriate box and enter casing height)

LAND SURFACE (nearest foot)

LOCATION OF WELL: ON LOT

SHOW PERMANENT STRUCTURE SUCH AS
BUILDING, SEPTIC TANKS, AND/OR
LANDMARKS AND INDICATE NOT LESS
THAN TWO DISTANCES
(MEASUREMENTS TO WELL)See Attached
location

COUNTY



HOWARD COUNTY HEALTH DEPARTMENT

Joyce M. Boyd, M.D., County Health Officer

February 13, 1995

MEMORANDUM

TO: Mr. Richard Demmitt
P. O. Box 228
Clarksville, Maryland 21029

FROM: Mark Rifkin, R. S. *(MR/cw)*
Water and Sewerage Program
Howard County Health Department


RE: Well Construction Permit
Permit Numbers: HO-94-0331 thru HO-94-0334
Springdale - Lots 1 - 3 and Lot 11
Springdale Drive

This is to confirm that the above referenced well construction permit applications were issued without a re-inspection of well stakes. Once all wells are drilled, engineer's certification of actual well locations will be required before record plat approval.

If you have any questions regarding this matter, please call me at 313-2640.

MR:jr

cc: Joseph L. Mayne
File

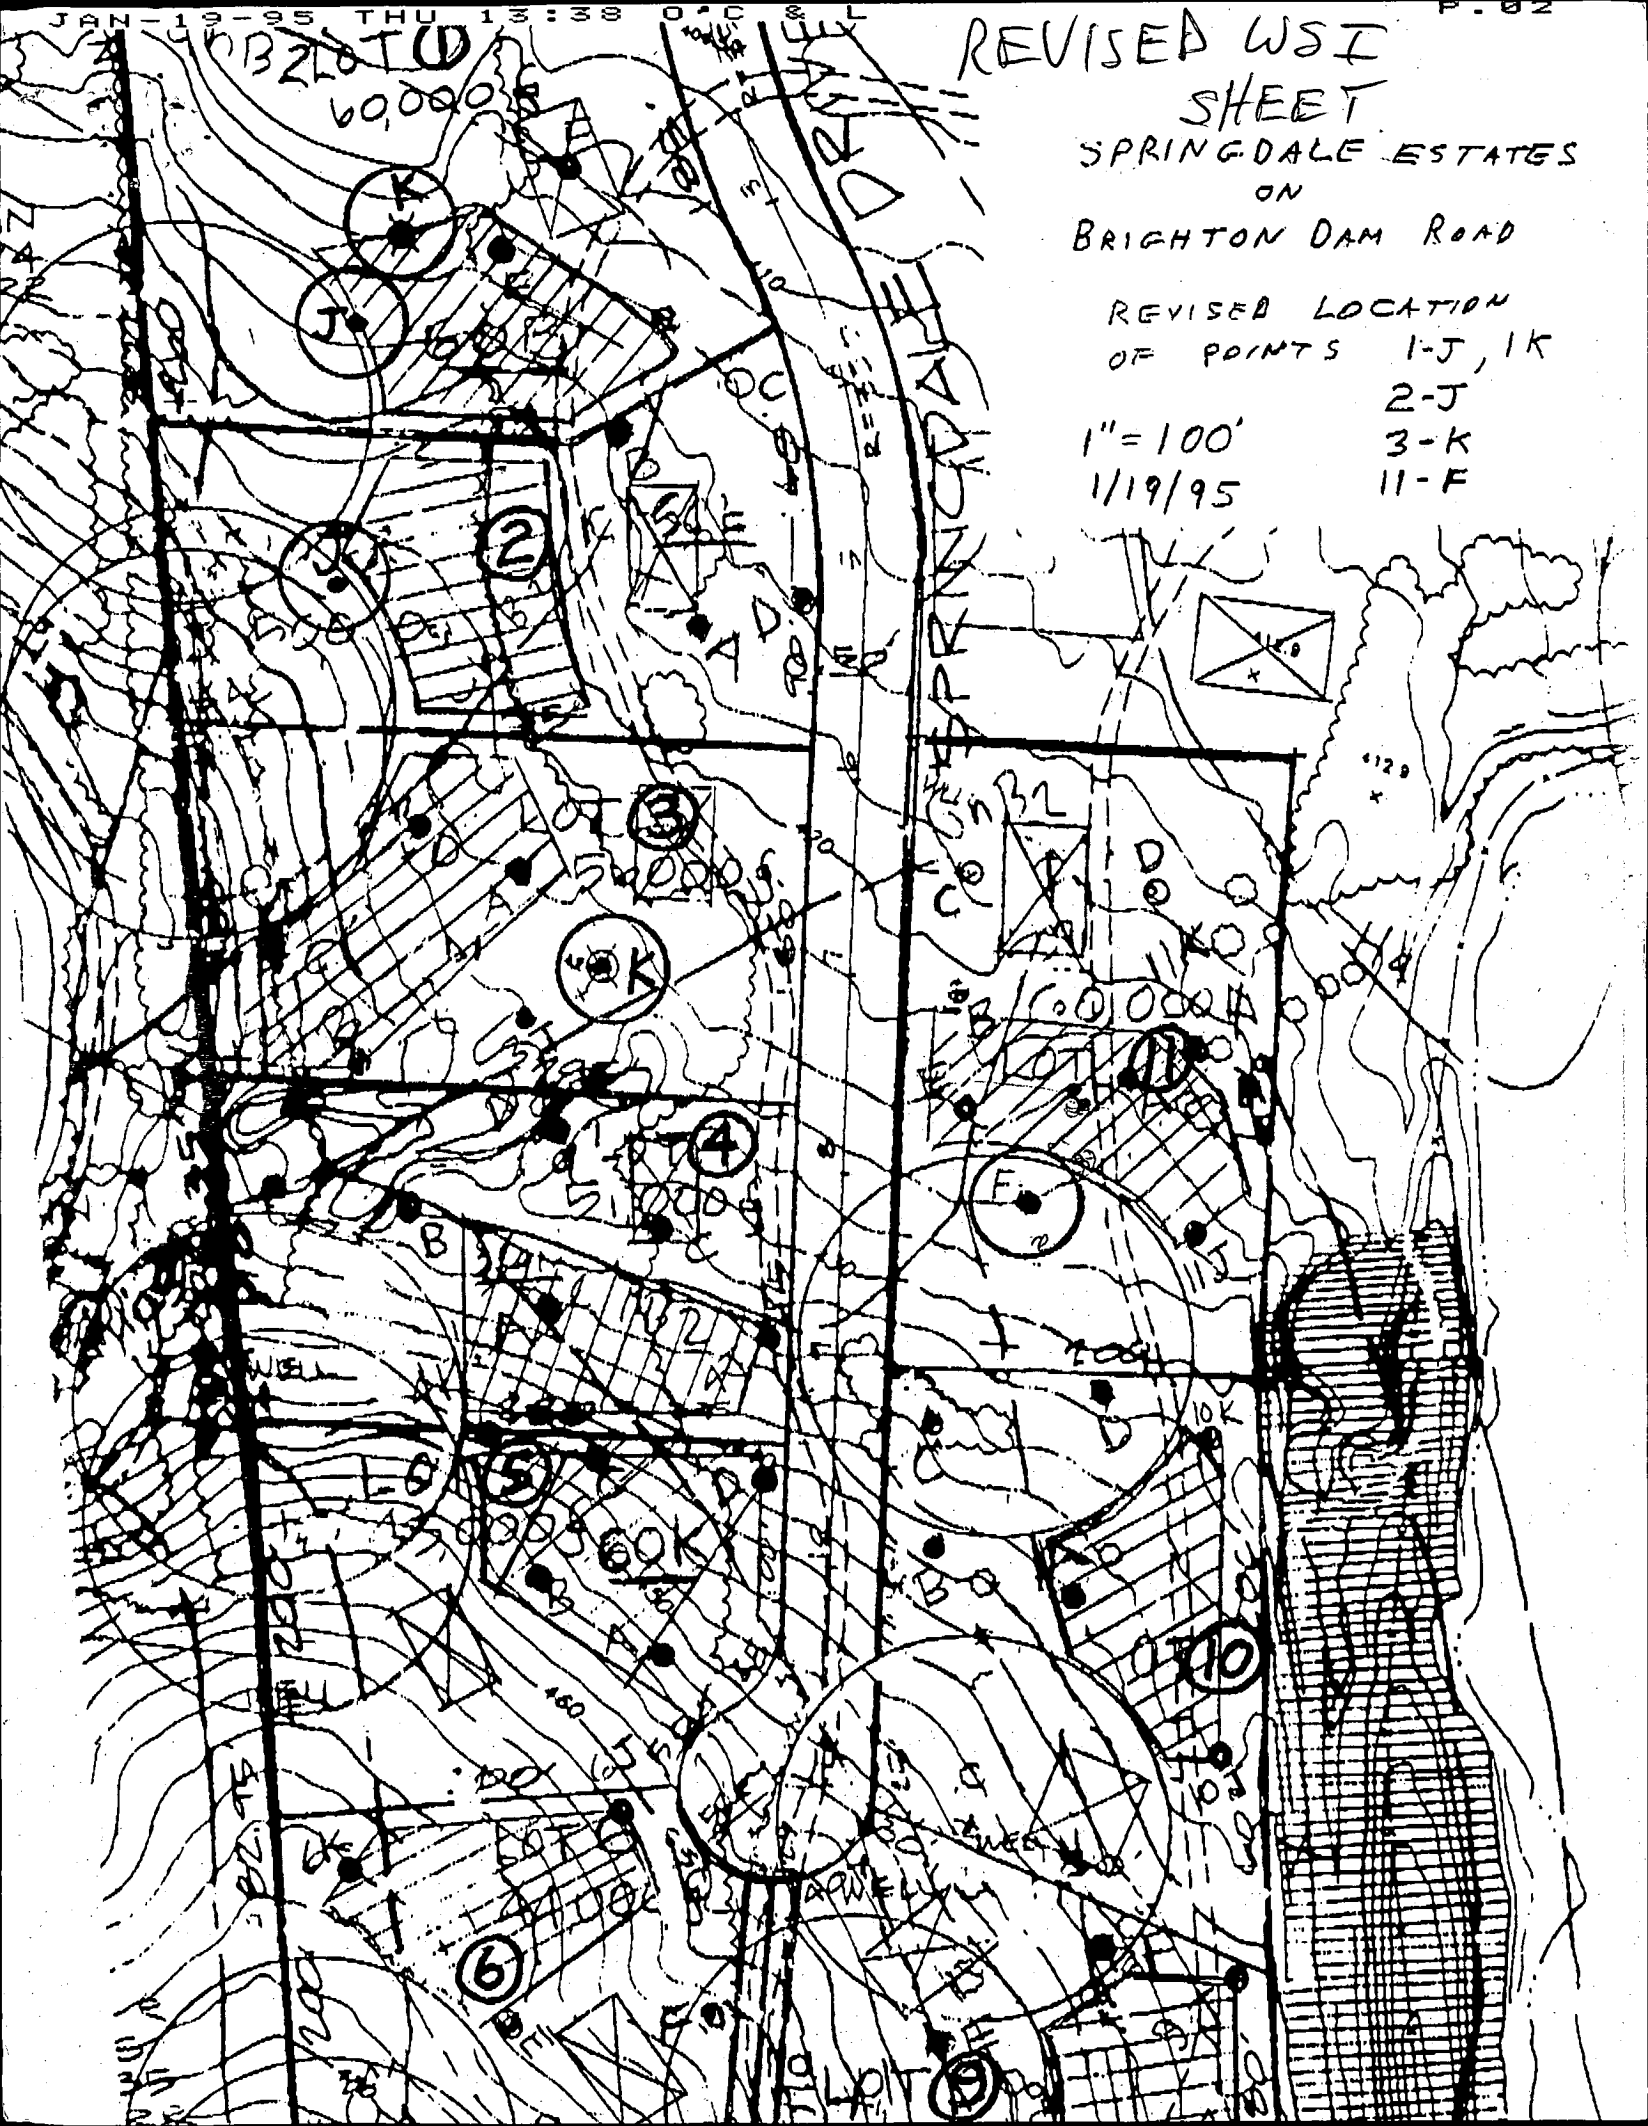

REVISED WSI
SHEET
SPRINGDALE ESTATES
ON
BRIGHTON DAM ROAD

REVISED LOCATION
OF POINTS 1-J, 1K

1" = 100'
1/19/95

2-J
3-K
11-F

