

10/2/97
12:00 E.O. & WA
10/16/97
C.O. 2-3pm
10/27/97
signature

PERMIT

SEWAGE DISPOSAL SYSTEM

DEPARTMENT OF HEALTH AND MENTAL HYGIENE

05-422108

P 58579

A 49860-H

DISTRICT 5th

DATE 7/22/97

DATE SYSTEM APPROVED 10/2/97

INSPECTOR KM

HOWARD COUNTY HEALTH DEPARTMENT

BUREAU OF ENVIRONMENTAL HEALTH

~~461-9933~~

313-2640

INDEXED

Fogle's Septic Clean, Inc.

IS PERMITTED TO INSTALL X ALTER

ADDRESS 558 Obrecht Road Sykesville, Maryland 21784 PHONE (410) 795-5674

SUBDIVISION Springdale Estates LOT 3 ROAD 13712 Springdale Drive

PROPERTY OWNER Eric Mann

ADDRESS

SEPTIC TANK CAPACITY 1250 GALLONS top-seamed tank & 1000 gallon top-seamed tank to serve
as future pump pit

NUMBER OF BEDROOMS 4

180 SQUARE FEET PER BEDROOM

LINEAR FEET OF TRENCH REQUIRED 240

TRENCHES - Trench to be 3 feet wide. Inlet 2 1/2 feet below original grade. Bottom maximum depth 4 1/2 feet below original grade. Effective area begins at 2 1/2 feet below original grade. 2 feet of stone below distribution pipe.

LOCATION - Place the distribution box as high as possible on gravity, or approximately as follows: 145 feet up the right lot line and 90 feet off this same lot line.

Run trenches on contour to right side of lot.

NOTES - No trench to exceed 100 feet in length. Provide 6" - 8" diameter cleanout and cap to grade or above on septic tank.

OK KM 4/16/97

PLANS APPROVED BY Mark Rifkin

REVISED DATE 03/27/97

COVER NO WORK UNTIL INSPECTED AND APPROVED

NEITHER THE HOWARD COUNTY COUNCIL NOR THE HEALTH DEPARTMENT IS RESPONSIBLE FOR THE SUCCESSFUL OPERATION OF ANY SYSTEM

NOTE: CLEANOUT REQUIRED EVERY 70 FEET OF SEWER LINE AND/OR AT 90° SWEEPS IN LINES FROM HOUSE TO DRAIN FIELDS, 90° ELBOWS NOT ACCEPTABLE.

NOTE: ALL PARTS OF SEPTIC SYSTEMS (I.E. TANK, DISTRIBUTION BOX TRENCHES) TO BE 100 FEET FROM WELL (UNLESS OTHERWISE SPECIFICALLY AUTHORIZED)

NOTE: IF DEEP TRENCH(ES) ARE USED CALL FOR INSPECTION BEFORE AND AFTER PLACING GRAVEL IN TRENCH(ES)

NOTE: NO DRY WELL SHALL EXCEED 15 FOOT IN DIAMETER NO ABSORPTION TRENCH TO EXCEED 100 FEET IN LENGTH

NOTE: ALL PIPE FROM HOUSE TO SEPTIC TANK MUST BE CAST IRON OR SCHEDULE 35/40 PVC OR ABS

PERMIT VOID AFTER TWO YEARS

NOTE: INSTALL STAND PIPE ON SEPTIC TANK AND DRY WELL STAND PIPES MUST BE 6 INCHES IN DIAMETER CAST IRON, CONCRETE OR TERRA COTTA OR PVA OR ABS ACCEPTED. IF TOP OF SEPTIC TANK IS DEEPER THAN 3 FEET. MANHOLE TO GRADE REQUIRED.

NOTE: DISTRIBUTION BOXES MUST HAVE BAFFLES

*INSTALLER IS RESPONSIBLE FOR OBTAINING FINAL APPROVAL ON THIS PERMIT

A 49860-H

Post-it® Fax-Note

7671

Date

5/17/01

of

pages 1

To

Eric Mann

From

Brian Baker

Co./Dept.

Co.

Ho Co. Env. Health


Phone #

Phone #

Fax #

(301) 480-0803

Fax #

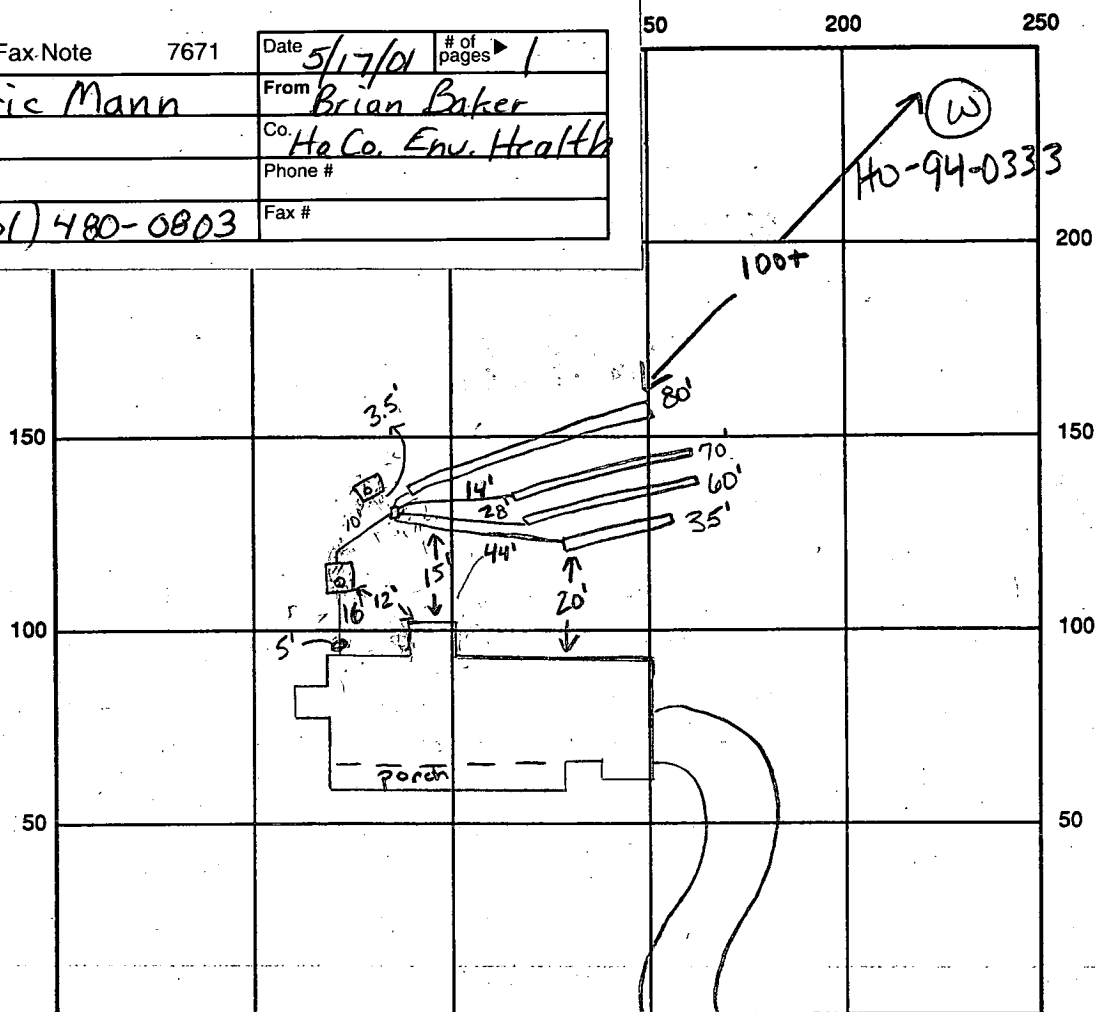

INDICATE NORTH - NAME ADJOINING ROADWAY AS BASE LINE

Springdale Drive

1000 gallon top-seamed pump tank

SEPTIC TANK LEVEL OK, 1250 top-seamed tank CLEANOUTS 1 at house, 1 on tank, 1 on pump pitDISTRIBUTION BOX LEVEL OKDRAIN FIELD/TITLE DEPTH 4.5 FT.TRENCH WIDTH 3 FT.INLET DEPTH 2.5 FT.EFFECTIVE GRAVEL DEPTH 2.0 FT.TOTAL LENGTH $\frac{1 \times 35}{1 \times 60} \frac{1 \times 80}{1 \times 70}$ FT. $\rightarrow 245$ NUMBER OF TRENCHES 4ONE SIDEWALL/BOTTOM AREA 735 SQ. FT.DRYWALL INSIDE DIAMETER FT.EFFECTIVE DEPTH BELOW INLET FT.ABSORBENT AREA SQ. FT.REMARKS: 10/2/97 has house connection, ok to cover all work. (km)10/22/97 Septic tank was ran over w/ dump truck & top collapsed - Replace tank if any damage to tank ALM10/27/97 New 1250 top-seamed tank installed has 3 T'S and center haffle (km)10/2/97 WPI - ok to cover well line, P.A. 4.0' below grade, casing 2.0' above grade, has 2 piece cap (km)DATE SYSTEM APPROVED 10/2/97INSPECTOR Kim Maisto



HOWARD COUNTY HEALTH DEPARTMENT

Joyce M. Boyd, M.D., County Health Officer

November 17, 1997

Mr. Dale Thompson
10005 Old Columbia Road
Columbia, Maryland 21046

RE: Septic Installation Permit P-58579A
Springdale Estates, Lot 3
13712 Springdale Road

Dear Mr. Thompson:

This is to acknowledge that the issue raised in my letter of October 7, 1997 regarding the above referenced septic system installation has been satisfactorily resolved.

The original septic tank has been replaced by a larger tank, accomplishing the same objective that would have been obtaining by plumbing a second tank "in-series". The second tank remains available for service as a pump pit at such future time as a replacement disposal field may become necessary.

If you have any questions regarding this matter, please contact me at the below address or by calling 410-313-2640.

Thank you for your cooperation.

Very truly yours,

Craig Williams, Program Director
Water and Sewerage Program

CW:jr

cc: Fogle's Septic Clean ✓
File



Post/In 26/92 Date 2/6/92 # of pages 1
 Fax Note Mark Rifkin
 To Mark Rifkin
 Fax# 313-2698
 From Dale
 Phone# 995-6736

Mark Rifkin

Bureau of Environmental Health

3525 Ellicott Mills Drive

Ellicott City, Md. 21043

Re: Lot 4 @ Springdale

Permit #: B00103789

Dear Mark,

At your request, I am writing to request that the septic disposal system for lot 4 at Springdale Estates be approved as a gravity drain system feeding the lower portion of the approved septic easement. I understand that it is the Health Departments objective to first utilize the upper area of a septic easement leaving the lower areas for recovery systems however, in this instance, reaching the upper area would require the use of a pump. That being the case, I believe the homeowner is best served by using a gravity feed system for the initial design and install a buried tank to house a pump for the future need to pump to the highest area for the second recovery area. This leaves the third recovery area to be located between the upper and lower areas which would not be utilized until after the lower area had a chance to "rest" during the life span of the second system.

I have reviewed the details of this request extensively with the owners of this property and they are in concurrence with the request that I am making. They fully understand that any replacement system which may or may not be required in the future would utilize a whole house pump. Should you have any questions regarding this system, please call myself or Luanne Lavalley at 995-6736.

Sincerely,

Dale Thompson
 Dale Thompson

*DALE -
 WE APPROVE
 SEE OTHER SIDE
 (CW)*

cc: Mr. and Mrs. Mann,
 Owners, Lot 4 Springdale

DALE —

SERVICE TO THE HIGHEST PART OF
THE AREA IS OUR NORMAL EXPECTATION. THIS ALLOWS
FOR GREATEST EFFICIENCY ON FUTURE REPAIR.
IN AN ATTEMPT TO PROVIDE A REASONABLE
AND PRACTICAL ALTERNATIVE, WE HAVE
BEGUN ALLOWING GRAVITY SERVICE TO
MID-PORTIONS OF THE

3018 11/10/82
11/10/82
11/10/82

APPLICATION

PERCOLATION TESTING

A 498604

P _____

HOWARD COUNTY HEALTH DEPARTMENT
BUREAU OF ENVIRONMENTAL HEALTH
3525-H ELLICOTT MILLS DRIVE/ELLICOTT CITY, MARYLAND 21043
TELEPHONE: 313-2640

DISTRICT _____

DATE _____

TO: THE COUNTY HEALTH OFFICER
ELLICOTT CITY, MARYLAND

I HEREBY APPLY FOR THE NECESSARY TEST PRIOR TO APPLICATION FOR PERMIT TO CONSTRUCT (OR RECONSTRUCT) A SEWAGE DISPOSAL SYSTEM.

PROPERTY OWNER ERIC MANN

ADDRESS _____ PHONE _____

AGENT OR PROSPECTIVE BUYER _____

ADDRESS 13712 Springdale Drive PHONE _____

PROPERTY LOCATION:

SUBDIVISION Springdale LOT NO. # 3 on perc cert

ROAD AND DESCRIPTION _____

BLDG. PERMIT SIGNED

~~AND RETURNED~~ 3/21/97

Serial # B10103788

SFD - 4 Bmar

BLDG. PERMIT SIGNED

~~AND RETURNED~~ 3/21/97

Serial # B10103789

addition - 2 car garage

TAX MAP _____ PARCEL # _____

SIZE OF LOT _____ TYPE BLDG. _____
(SINGLE FAMILY DWELLING OR COMMERCIAL)

THE SYSTEM INSTALLED UNDER THIS APPLICATION IS ACCEPTABLE ONLY UNTIL PUBLIC FACILITIES BECOME AVAILABLE. I FULLY UNDERSTAND THE
FEE CONNECTED WITH THE FILING OF THIS PERC TEST APPLICATION IS NON-REFUNDABLE UNDER ANY CIRCUMSTANCES. I ALSO AGREE TO
COMPLY WITH ALL M.O.S.H.A. REQUIREMENTS IN TESTING THIS LOT.

(SIGNATURE OF APPLICANT)

APPROVED BY _____ FOR _____ DATE _____

DISAPPROVED BY _____ FOR _____ DATE _____

HOLD PENDING FURTHER TESTS _____

REASONS FOR REJECTION OR HOLDING HOLD FOR PLAT, PERC OK MR 8/17/94

PERCOLATION TEST PLAT/PRELIMINARY PLAT - TITLE OR I.D. # _____ DATE _____

SITE DEVELOPMENT PLAN/FINAL PLAT - TITLE OR I.D. # _____ DATE _____

THIS IS NOT A PERMIT

49860 H

COUNTY #

Lot 4

SOIL PROFILE

0'

top soil
fired
sa c / lm

2'

tan
red brn
coarse
mica
sa. lm
5-15%
blocky or
saprolite
frags

WATER

in (A) (D)

46"

FILL

brn
sa c /
lm

2'

brn
si lm

8 1/2'

dull dk
brn
bright
red arg.

12'

moist silt

19"

FILL

brn arg
sa c /
lm

3' 9"

brn
red
sa lm

11"

WATER

12"

Lot 5

road

swale

sharp, deeper
swale

Lot 4

Lot 3

SOIL PROFILE

0'

INDICATE NORTH - NAME ADJOINING ROADWAY AS BASE LINE.

DATE	TEST NO.	DEPTH	PRE-WET		TEST - 1" DROP		TIME
			START	STOP	START	STOP	
3/11/94	D	3	11:46	11:49	11:49	11:55	6
	D	11	H ₂ O @ 11"				
	A	3	11:49	11:52	11:52	11:58	6 EST
	A	11	H ₂ O @ 10"				
	C S	3	11:59	12:01	12:01	12:06	5
	C M	6	11:58	12:00	12:00	12:04	4
	C v	12	see	profile			
	B S	4' 3"	12:05	12:09	12:09	12:16	7
	B v	12 1/2	see	profile			
4/2/94	J S	3' 3" / 12	3:50	3:54	3:54	4:00	6
2/1/95	K v	12	H ₂ O @ 11"			6 HRS ±	

REMARKS REDIG A VES 12 NO DRYER PLAN 3' 11" ±

TYPE OF SOIL ALL HOLES NOT PER PLAN

TESTED BY M. Riffin

ALSO PRESENT Allen, Demmitt

TRENCH DESIGN DATA: AVERAGE PERCOLATION TIME


6

TRENCH WIDTH 3


INLET DEPTH 2 1/2

MAXIMUM BOTTOM DEPTH 4 1/2

SQ. FT/BEDROOM 180

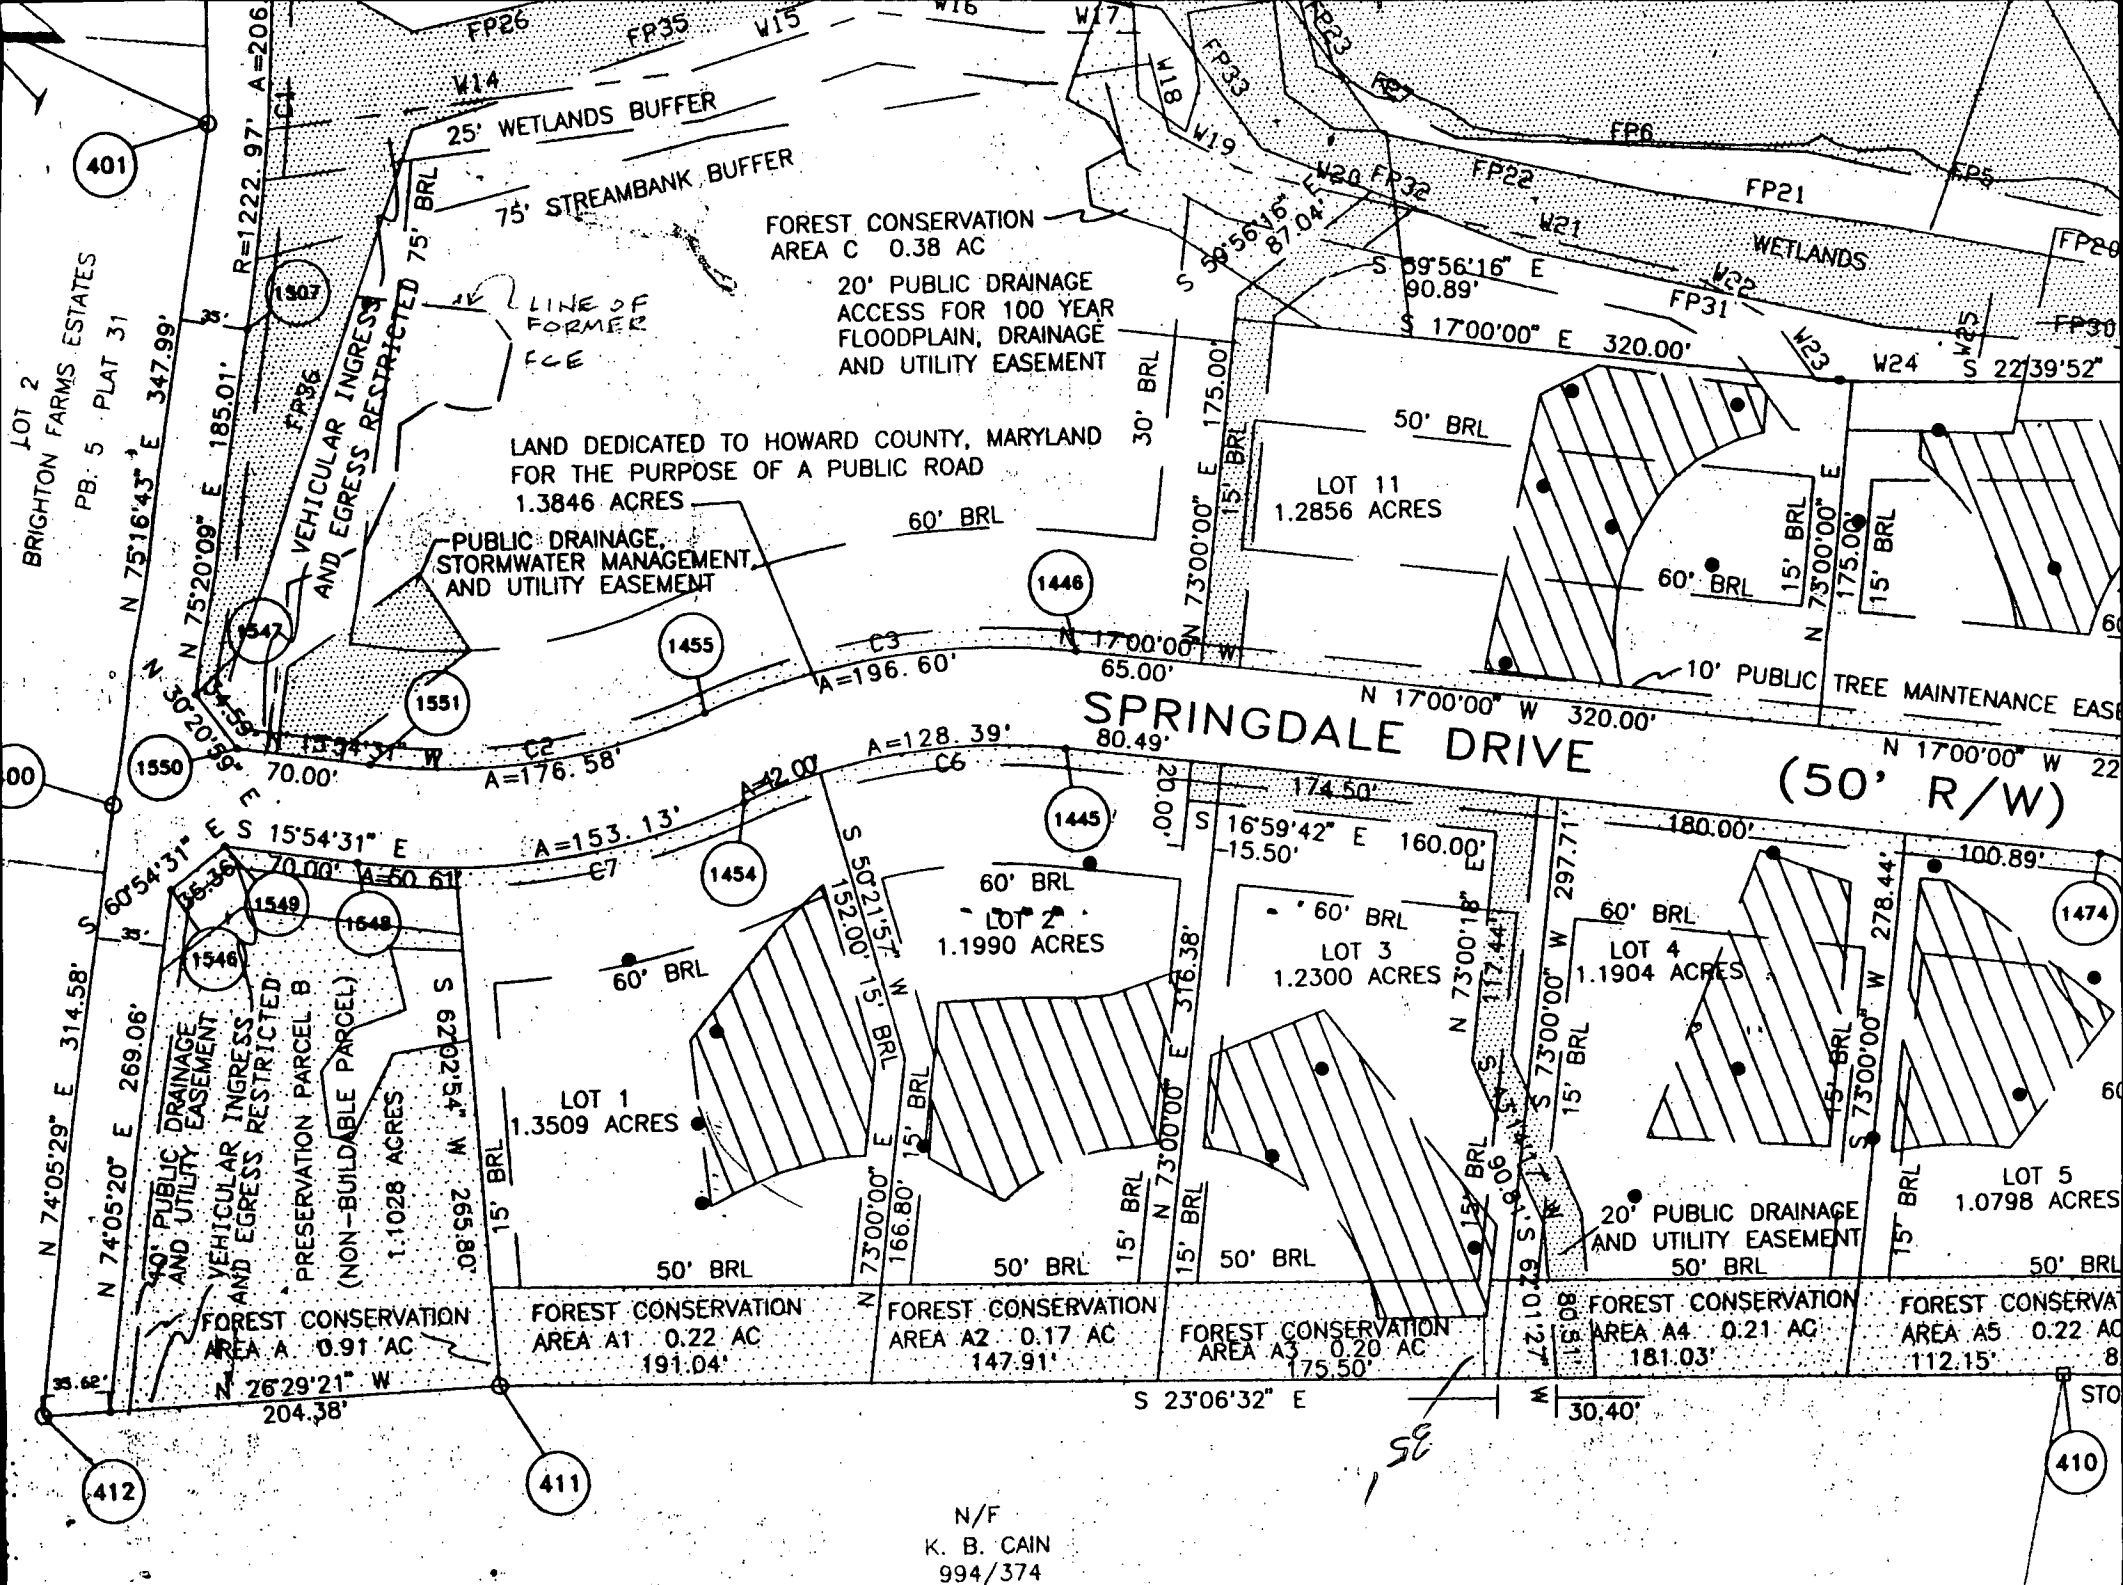


N/F
K. B. CAIN
994/374

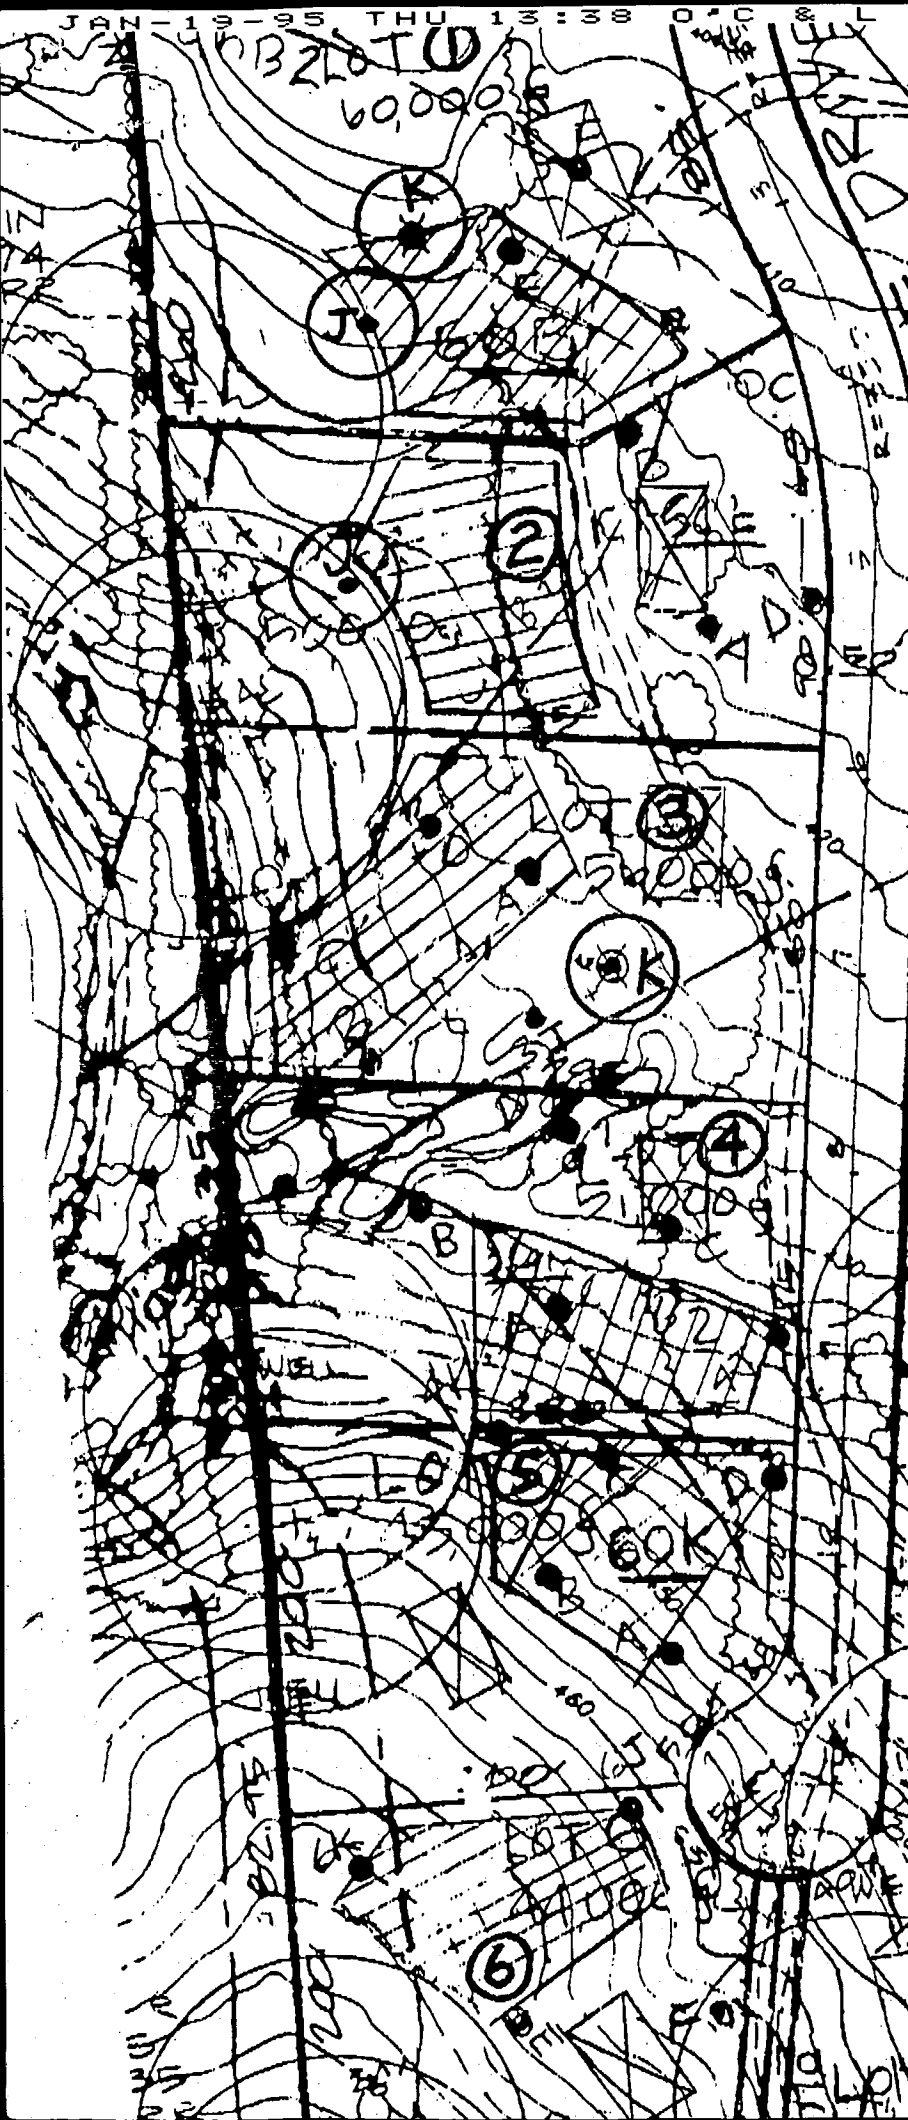


REVISED WSI PLAN

SPRINGDALE ESTATES
ON
BRIGHTON DAM ROAD

REVISED LOCATION
OF POINTS 1-J, 1K
2-J
3-K
11-F
1"=100'
1/19/95


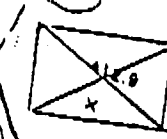


Approved Septic System Plan
Howard County Health Department

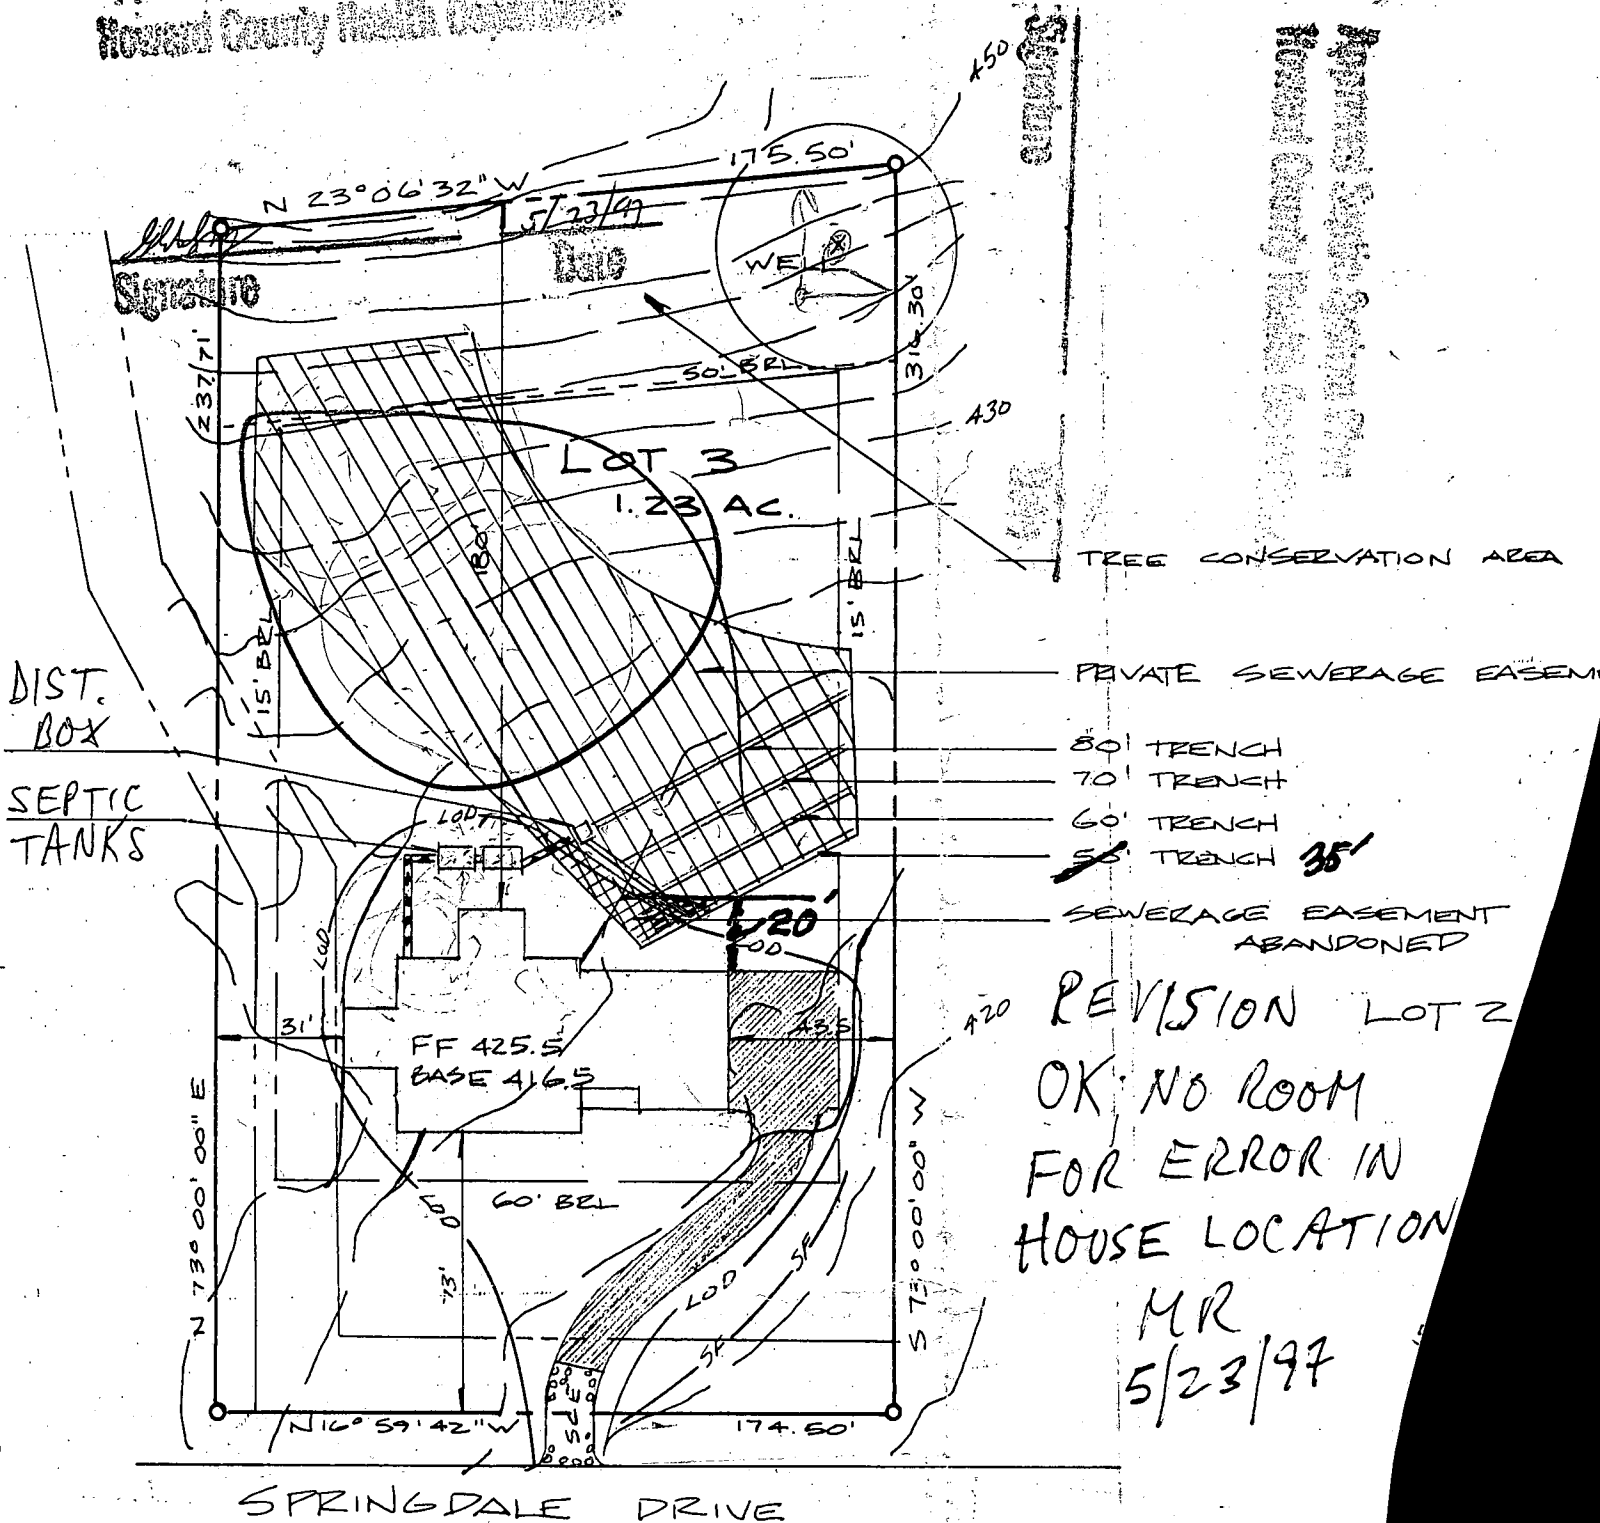

Septic Grades & Elevations		
	Inv.	Grade
INVERT @ HOUSE	421.00	421.00
INVERT @ ENT 1 ST TANK 1,250 GALS	423.50	
INVERT @ EXIT "	423.25	
INVERT @ ENT 2 ND TANK 1,000 GALS	423.0	
INVERT @ EXIT "	422.75	
INVERT @ DIST. BOX	422.5	424.5

COUNTY

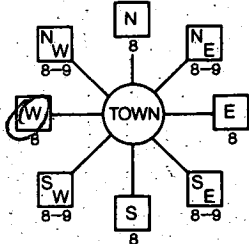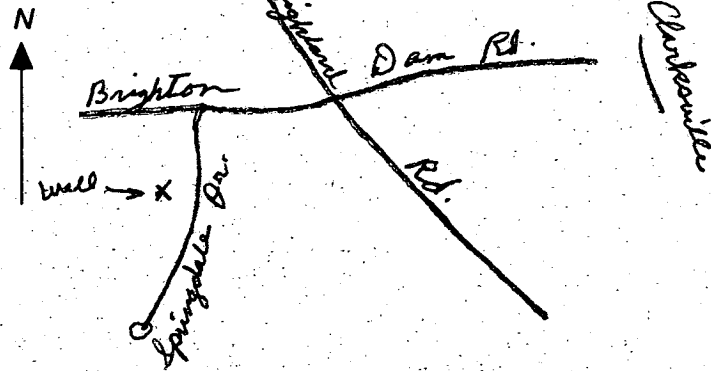B 1 5364	SEQUENCE NO. (DP USE ONLY)	STATE OF MARYLAND APPLICATION FOR PERMIT TO DRILL WELL please print or type	STATE PERMIT NUMBER 40-94-0333 fill in this form completely
Date Received (APA) 121294		B 3 LOCATION OF WELL	
OWNER INFORMATION 15 Last Name Demmitt 34 Owner First Name RICHARD 36 Street or RFD Box 228 55 57 Town CLARKSVILLE 70 State 72 MD 74 Zip 76 21029		8 COUNTY HOWARD 21 23 SUBDIVISION SPRINGDALE 42 SECTION 44 46 LOT 3 50 52 NEAREST TOWN CLARKSVILLE 71 MILES FROM TOWN (enter 0 if in town) 3 73 MI 76 77 78	
DRILLER INFORMATION Driller's Name Joseph R. Wayne 77 License No. 80 24 Firm Name Joseph R. Wayne WELL DRILLING Address 5512 Ridge Rd. Mt. Airy, Md. 21771 Signature Joseph R. Wayne Date 12/10/94		B 4 DIRECTION OF WELL FROM TOWN (CIRCLE BOX) 	
B 2 WELL INFORMATION APPROX. PUMPING RATE (GAL. PER MIN.) 5 8 AVERAGE DAILY QUANTITY NEEDED (GAL. PER DAY) 500 12 14 20		11 Springdale Drive 30 NEAR WHAT ROAD ON WHICH SIDE OF ROAD (CIRCLE APPROPRIATE BOX) 34 305 37 DISTANCE FROM ROAD ENTER FT OR MI FT 38 39 TAX MAP: _____ BLK: _____ PARCEL: _____	
USE FOR WATER (CIRCLE APPROPRIATE BOX) ☒ HOME (SINGLE OR DOUBLE HOUSEHOLD UNIT ONLY) ☐ FARMING (LIVESTOCK WATERING & AGRICULTURAL IRRIGATION) ☐ INDUSTRIAL, COMMERCIAL, STATE AND FEDERAL GOV. OTHER (REQUIRES APPROPRIATION PERMIT) ☐ PUBLIC OR PRIVATE WATER COMPANY (REQUIRES APPROPRIATION PERMIT AND STATE HEALTH DEPARTMENT APPROVAL) ☐ TEST, OBSERVATION, MONITORING (MAY REQUIRE APPROPRIATION PERMIT)		NOT TO BE FILLED IN BY DRILLER HEALTH DEPARTMENT APPROVAL COUNTY NAME Howard COUNTY NO. A 49860H STATE SIGNATURE _____ DATE ISSUED 021095 INSERT S 41 CO SIGNATURE Mark E. Ruffin EKP. DATE 02/10/96 NORTH GRID 496000 50 55 EAST GRID 0804000 57 63	
APPROXIMATE DEPTH OF WELL 265 24 FEET 28		SHOW MAJOR FEATURES OF BOX & LOCATE WELL WITH AN X SOURCES OF DRILLING WATER 1. WELL 2. 3.	
APPROXIMATE DIAMETER OF WELL 6 INCH NEAREST INCH		WRITE THE BOX NUMBER FROM THE MAP HERE E 8024 N 4926 000 000	
METHOD OF DRILLING (circle one) 30 BORED (or Augered) ☒ JETTED ☐ Jetted & DRIVEN 37 AIR-ROTARY ☐ AIR-PERCussion ☐ ROTARY (Hydraulic Rotary) CABLE ☐ REVERSE-ROTARY ☐ Drive-POINT ☐ other _____		DRAW A SKETCH BELOW SHOWING LOCATION OF WELL IN RELATION TO NEARBY TOWNS AND ROADS AND GIVE DISTANCE FROM WELL TO NEAREST ROAD JUNCTION 	
REPLACEMENT OR DEEPEMED WELLS (CIRCLE APPROPRIATE BOX) ☒ THIS WELL WILL NOT REPLACE AN EXISTING WELL ☐ THIS WELL WILL REPLACE A WELL THAT WILL BE ABANDONED AND SEALED 39 ☐ THIS WELL WILL REPLACE A WELL THAT WILL BE USED AS A STANDBY-CONTACT LOCAL APPROVING AUTHORITY FOR POLICY ON STANDBY WELLS ☐ THIS WELL WILL DEEPEN AN EXISTING WELL PERMIT NUMBER OF WELL TO BE REPLACED OR DEEPEMED (IF AVAILABLE) 41 1 52		Not to be filled in by driller (OEP USE ONLY) APPROX. PERMIT NUMBER GAP 54 63 FORCE M12 WRITE INITIALS IN BOX 67 68 PERMIT No. 40-94-0333 70 71 72 73 74 75 76 77 78 79	
SPECIAL CONDITIONS NOTE = APPROVING AUTHORITIES SHOULD USE SEPARATE SHEET IF NEEDED =			



HOWARD COUNTY HEALTH DEPARTMENT

Joyce M. Boyd, M.D., County Health Officer

February 13, 1995

MEMORANDUM

TO: Mr. Richard Demmitt
P. O. Box 228
Clarksville, Maryland 21029

FROM: Mark Rifkin, R. S. *MR/cw*
Water and Sewerage Program
Howard County Health Department

RE: Well Construction Permit
Permit Numbers: HO-94-0331 thru HO-94-0334
Springdale - Lots 1 - 3 and Lot 11
Springdale Drive

This is to confirm that the above referenced well construction permit applications were issued without a re-inspection of well stakes. Once all wells are drilled, engineer's certification of actual well locations will be required before record plat approval.

If you have any questions regarding this matter, please call me at 313-2640.

MR:jr

cc: Joseph L. Mayne
File

HOWARD COUNTY HEALTH DEPARTMENT
Bureau of Environmental Health
3925-N Ellicott Mills Drive
Ellicott City, MD 21043
410-9833

APPLICATION FOR FITLESS ADAPTER, WELL PUMP AND PRESSURE TANK INSTALLATION

How Installation ✓
Replacement

Receipt #
Date 10/19/97

Name of Installer Whitoughy Plumbing

Telephone 410-781-7051

License Number #6997

Certified Well Pump Installer Well Driller Registered Plumber ✓

Name of Property Owner ERIC Mann

Telephone

Subdivision SPRINGDALE STARS Lot # 3

Well Tag # NO-94-03-33

Site Address 1302 SPRINGDALE DR
CLARKSVILLE, MD 20770

Pump

1. Type

a. Deep well jet

b. Shallow well jet

c. Submersible

2. Model #

3. Capacity 15 GPM

4. Pump exceeds well capacity Yes No ✓

5. If Yes, is low pressure cutoff switch installed? Yes No

6. What methods are used to protect the pump and electrical wiring from vibrations? Torque arrestors ✓ Cable guards ✓ Other

Motor

1. Horsepower 3/4

2. RPM

3. Voltage

a. 110

b. 220 ✓

Fitless Adapter

1. Make Norwood

2. Model # 444

3. Depth 444

Tank

1. Capacity 40 gal.

2. Pressure relief valve? YES

Piping

1. Type 3" CORRTLINE

2. Size 1"

3. NSF and/or ECCA Code approved YES

4. Depth of supply line 4 ft.

Well data

1. Depth 400 ft.

2. Yield 15 GPM

3. Static water level ft.

4. Will water supply be disinfected by installer? NO

I understand that it is my responsibility to notify the Howard County Health Department when the installation is ready for inspection (otherwise this permit is null and void).

All information given above is true to the best of my knowledge.

Signature of Applicant: Chris Whitoughy

Date: 10/10/97