

6/11/00
ASAP + Later
6/9/00 2:00 - 4:00
8/11/00
House Connection
ASAP

6/12/00 Needs house
Conn

PERMIT

SEWAGE DISPOSAL SYSTEM

DEPARTMENT OF HEALTH AND MENTAL HYGIENE

P 5/3596

A 49861-G

DISTRICT

DATE 5/18/2000

DATE SYSTEM APPROVED 8/11/00

INSPECTOR S.R.K

HOWARD COUNTY HEALTH DEPARTMENT INDEXED

BUREAU OF ENVIRONMENTAL HEALTH

~~XXXXXX~~ 410-313-2640

65-422248

Fogle's Septic Clean, Inc.

IS PERMITTED TO INSTALL X ALTER

ADDRESS 580 Obrecht Road, Sykesville, MD 21784 PHONE 410-795-5670

SUBDIVISION Springdale LOT 16 ROAD 13517 Silent Lake Drive

PROPERTY OWNER Don J. Park/Elizabeth S. Campell

ADDRESS

SEPTIC TANK CAPACITY 1250 GALLONS

NUMBER OF BEDROOMS 4

180 SQUARE FEET PER BEDROOM

LINEAR FEET OF TRENCH REQUIRED 240

TRENCHES - Trench to be 3 feet wide. Inlet 2 1/2 feet below original grade. Bottom maximum depth 4 1/2 feet below original grade. Effective area begins at 2 1/2 feet below original grade. 2 feet of stone below distribution pipe.

LOCATION - Starting from the right rear lot corner, place the distribution box 165 feet down the right (406.19') lot line and 55 feet off this same lot line. Run trenches on contour to right side of lot.

NOTES - No trench to exceed 100 feet in length. Provide 6" - 8" diameter cleanout and cap to grade or above on septic tank. 10/6/99 O.R. (BB)

PLANS APPROVED BY Mark E. Rifkin/Ronald J. Pinkley

DATE 9-16-1999

COVER NO WORK UNTIL INSPECTED AND APPROVED

NEITHER THE HOWARD COUNTY COUNCIL NOR THE HEALTH DEPARTMENT IS RESPONSIBLE FOR THE SUCCESSFUL OPERATION OF ANY SYSTEM

NOTE: CLEANOUT REQUIRED EVERY 70 FEET OF SEWER LINE AND/OR AT 90° SWEEPS IN LINES FROM HOUSE TO DRAIN FIELDS, 90° ELBOWS NOT ACCEPTABLE.

NOTE: ALL PARTS OF SEPTIC SYSTEMS (I.E. TANK, DISTRIBUTION BOX TRENCHES) TO BE 100 FEET FROM WELL (UNLESS OTHERWISE SPECIFICALLY AUTHORIZED)

NOTE: IF DEEP TRENCH(ES) ARE USED CALL FOR INSPECTION BEFORE AND AFTER PLACING GRAVEL IN TRENCH(ES)

NOTE: NO DRY WELL SHALL EXCEED 15 FOOT IN DIAMETER NO ABSORPTION TRENCH TO EXCEED 100 FEET IN LENGTH

NOTE: ALL PIPE FROM HOUSE TO SEPTIC TANK MUST BE CAST IRON OR SCHEDULE 35/40 PVC OR ABS

PERMIT VOID AFTER TWO YEARS


NOTE: INSTALL STAND PIPE ON SEPTIC TANK AND DRY WELL STAND PIPES MUST BE 6 INCHES IN DIAMETER CAST IRON, CONCRETE OR TERRA COTTA OR PVA OR ABS ACCEPTED. IF TOP OF SEPTIC TANK IS DEEPER THAN 3 FEET, MANHOLE TO GRADE REQUIRED.

NOTE: DISTRIBUTION BOXES MUST HAVE BAFFLES

*INSTALLER IS RESPONSIBLE FOR OBTAINING FINAL APPROVAL ON THIS PERMIT

*CALL 461-9933 FOR INSPECTION OF SEPTIC SYSTEM.

NOT TO SCALE

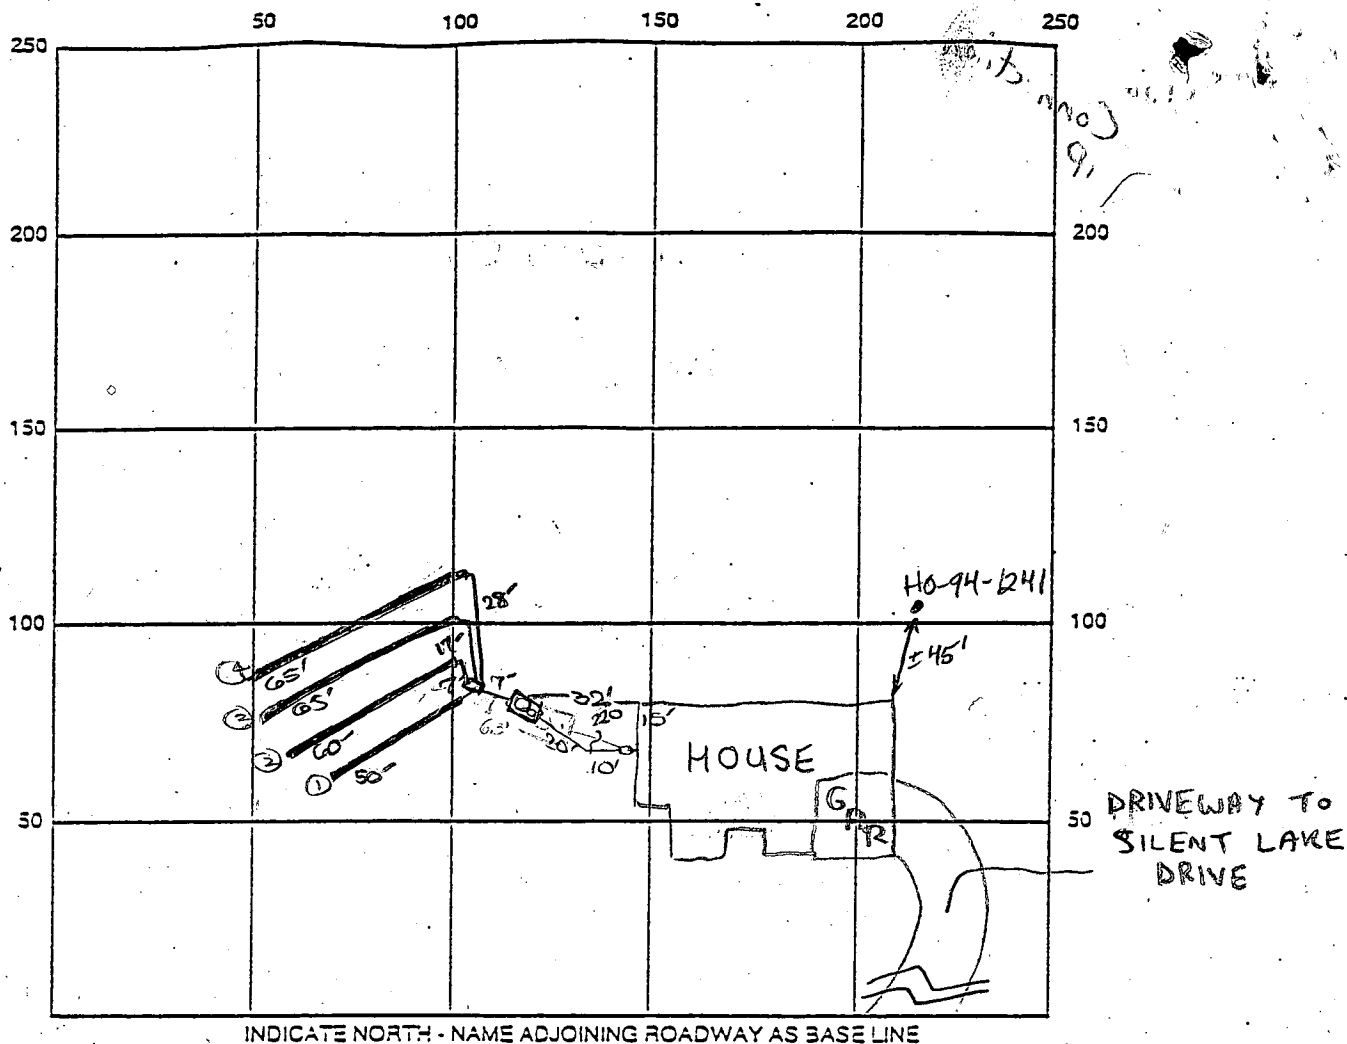

SEPTIC TANK LEVEL 1250 MS CLEANOUTS one at house, one on s.t. manhole on s.t.

DISTRIBUTION BOX LEVEL OK

DRAIN FIELD ^{TILE} 1/2-4 TILES DEPTH 5/4.5 FT. TRENCH WIDTH 3 FT. INLET DEPTH 3/2.5 FT.

EFFECTIVE GRAVEL DEPTH 2 FT. TOTAL LENGTH 240 FT.

NUMBER OF TRENCHES 4 ONE SIDEWALL/BOTTOM AREA 720 SQ. FT.

^{DRY WELL} DRYWELL INSIDE DIAMETER N/A FT. EFFECTIVE DEPTH BELOW INLET N/A FT.

ABSORBENT AREA N/A SQ. FT.

REMARKS: 6/1/00-MET BUILDER AND CONTRACTOR IN FIELD AT SITE, DRAINAGE SWALE CUT TOO DEEP TO ALLOW FOR APPROPRIATE AMOUNT OF FILL ON TOP OF PIPE FROM HOUSE TO TANK, BUILDER TO STAKE ALL CORNERS OF SEPTIC EASEMENT, PLUMBER TO SET HOUSE SEWER AT BP. PLAN'S SPECIFIED DEPTH, CONTRACTOR TO SHOOT GRADES, BUILDER TO BRING IN PROPER AMOUNT OF FILL TO COVER PIPE FROM HOUSE TO TANK AND CONTRACTOR TO CALL FOR REINSPECTION (SRK) Tank and distribution box set. No house connection. Trench 1 will be deeper than planned in order to maximize use of easement area. (BB)

DATE SYSTEM APPROVED 8/11/00 INSPECTOR Steven R. King

6/12/00 OK to cover all septic work - Needs house connection check prior to final approval (SRK) 8/11/00- House conn. verified to have been done by builder (SRK)

HOWARD COUNTY HEALTH DEPARTMENT
Bureau of Environmental Health
3525-H Ellicott Mills Drive
Ellicott City, MD 21043
461-9933

APPLICATION FOR PITLESS ADAPTER, WELL PUMP AND PRESSURE TANK INSTALLATION

New Installation X
Replacement _____

Receipt # _____
Date 8/11/00

Name of Installer THOMPSON PUMPING

Telephone 443-535-0600

License Number 1801

Certified Well Pump Installer X Well Driller _____ Registered Plumber X

Name of Property Owner DON J. PARK

Telephone 410-707-6665

Subdivision SPRINGDALE Lot # 16

Well Tag # HO-94-1241

Site Address 13517 SILENT LAKE DR

Pump

1. Type
 - a. Deep well jet _____
 - b. Shallow well jet _____
 - c. Submersible X
2. Make Myers
3. Model # _____
4. Capacity 5 GPM

Motor

1. Horsepower 1/2
2. RPM 3200
3. Voltage _____
 - a. 110 _____
 - b. 220 X

Pitless Adapter

1. Make BARNET
2. Model # _____
3. Depth 900 RBS/WT

5. Pump exceeds well capacity Yes _____ No X
6. If Yes, is low pressure cutoff switch installed? Yes _____ No _____
7. What methods are used to protect the pump and electrical wiring from vibrations? Torque arrestors X Cable guards X Other _____

Tank

1. Capacity 40-60
2. Pressure relief valve? yes

Piping

1. Type 160 LB
2. Size 1"
3. NSF and/or BOCA Code approved yes
4. Depth of supply line 1/2"

Well data

1. Depth 220 ft.
2. Yield 15 GPM
3. Static water level 30 ft.
4. Will water supply be disinfected by installer? yes

I understand that it is my responsibility to notify the Howard County Health Department when the installation is ready for inspection (otherwise this permit is null and void).

All information given above is true to the best of my knowledge.

6/9/00-WPT
OK (BB) SRM

Signature of Applicant: [Signature]

Date: 8-11-00

Note: A sticker indicating approval/status of the installation will be placed on the well casing at the time of the inspection.

ROBERT H. VOYE RE N. 12/82

APPLICATION

PERCOLATION TESTING

A 49861 G

P _____

HOWARD COUNTY HEALTH DEPARTMENT

BUREAU OF ENVIRONMENTAL HEALTH

3525-H ELLICOTT MILLS DRIVE/ELLICOTT CITY, MARYLAND 21043
TELEPHONE: 313-2640

DISTRICT _____

DATE _____

TO: THE COUNTY HEALTH OFFICER
ELLICOTT CITY, MARYLAND

I HEREBY APPLY FOR THE NECESSARY TEST PRIOR TO APPLICATION FOR PERMIT TO CONSTRUCT (OR RECONSTRUCT) A SEWAGE DISPOSAL SYSTEM.

PROPERTY OWNER Don Parks / Campbell

ADDRESS _____ PHONE _____

AGENT OR PROSPECTIVE BUYER _____

ADDRESS _____ PHONE _____

PROPERTY LOCATION:

SUBDIVISION Springdale LOT NO. 16

ROAD AND DESCRIPTION 13517 Silent Lake Drive

TAX MAP 34 PARCEL # 60

SIZE OF LOT _____ TYPE BLDG. _____

~~ORIGINAL PERMIT SIGNED~~

~~AND RETURNED~~ 9-16-99

Serial # B-10120364

SFD - 4 Brms

(SINGLE FAMILY DWELLING OR COMMERCIAL)

THE SYSTEM INSTALLED UNDER THIS APPLICATION IS ACCEPTABLE ONLY UNTIL PUBLIC FACILITIES BECOME AVAILABLE. I FULLY UNDERSTAND THE
FEE CONNECTED WITH THE FILING OF THIS PERC TEST APPLICATION IS NON-REFUNDABLE UNDER ANY CIRCUMSTANCES. I ALSO AGREE TO
COMPLY WITH ALL M.O.S.H.A. REQUIREMENTS IN TESTING THIS LOT.

(SIGNATURE OF APPLICANT)

APPROVED BY _____ FOR _____ DATE _____

DISAPPROVED BY _____ FOR _____ DATE _____

HOLD PENDING FURTHER TESTS _____

REASONS FOR REJECTION OR HOLDING _____

PERCOLATION TEST PLAT/PRELIMINARY PLAT - TITLE OR I.D. # _____ DATE _____

SITE DEVELOPMENT PLAN/FINAL PLAT - TITLE OR I.D. # _____ DATE _____

THIS IS NOT A PERMIT

49861 G

COUNTY #

Lot 16

SOIL PROFILE

brn
sil

lm

15%
platy

FragS

3

brn pink

salm

15%

platy

FragS

1 1/2

10

brn

or g

brn

sac/lm

3-4

wh. beige

gray

purple

coarse

salm

14

lg. blocky

Flagstone

FragS

@ one

end

50%

tan

or g s

clay lm

4-5

fine

tan

salm

15% pl.

FragS

SOIL PROFILE

3F9

sac/lm

15%

Flagstone

2-3

brn


gray

salm

20%-35%

Flagstone

10

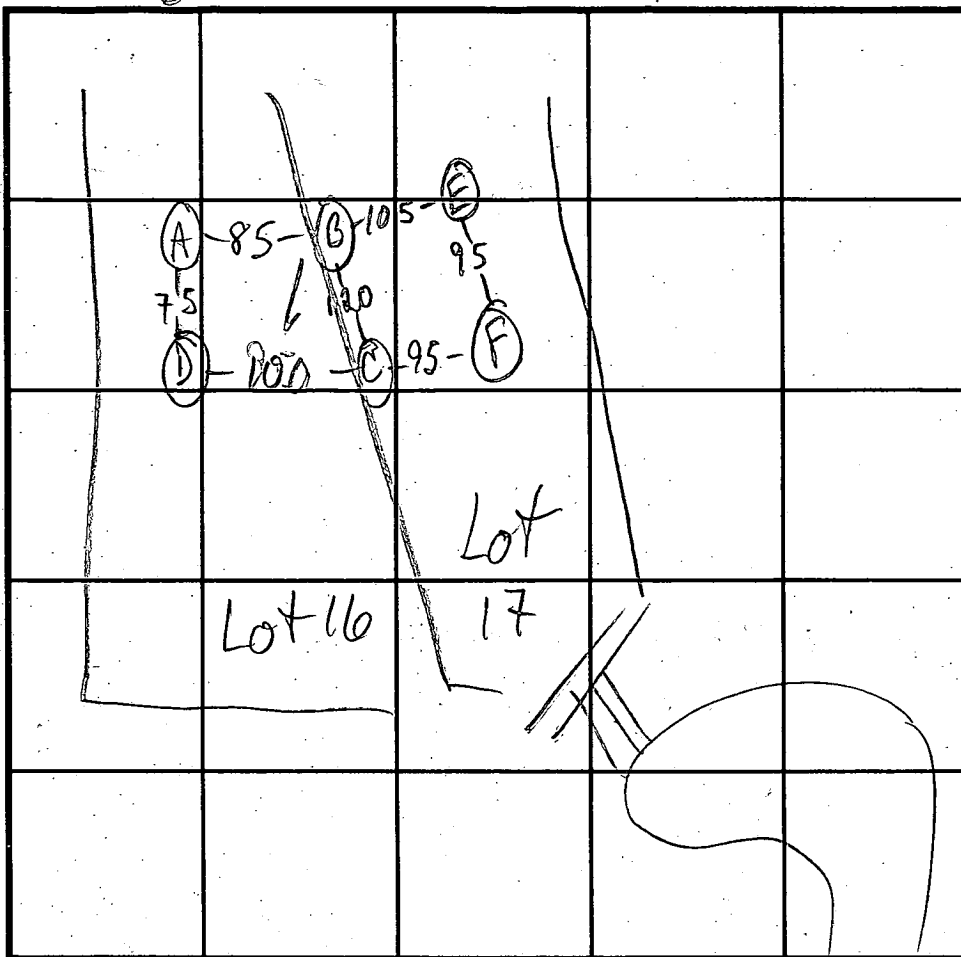

INDICATE NORTH - NAME ADJOINING ROADWAY AS BASE LINE.

DATE	TEST NO.	DEPTH	PRE-WET		TEST - 1" DROP		TIME
			START	STOP	START	STOP	
3/11/94	FS	3	1:03	1:05	1:05	1:09	4
3/8/94	FR	10					
3/11/94	CS	3	1:06	1:07	1:07	1:11	4
3/8/94	CV	10 1/2					
3/11/94	ES	3 1/2	1:32	1:35	1:35	1:42	7
3/8/94	EV	14					
3/11/94	BS	2 1/2	1:18	1:21	1:21	1:24	3
3/11/94	BM	5	1:23	1:26	1:26	1:27	1?
3/11/94	BM	5 REPOUR	1:29	1:31	1:31	1:33	2
3/8/94	BV	11 1/2					
3/11/94	AS	2'8"	1:16	1:20	1:20	1:26	6
3/8/94	AV	11					


REMARKS 3/11/94 DS 2'8" 1:09 1:12 1:12 1:19 7


TYPE OF SOIL 3/8/94 DV 10

TESTED BY M. Ripkin ALSO PRESENT Allen, Demmitt

TRENCH DESIGN DATA: AVERAGE PERCOLATION TIME 5 TRENCH WIDTH 3

INLET DEPTH 2 1/2 MAXIMUM BOTTOM DEPTH 4 1/2 SQ. FT./BEDROOM 180

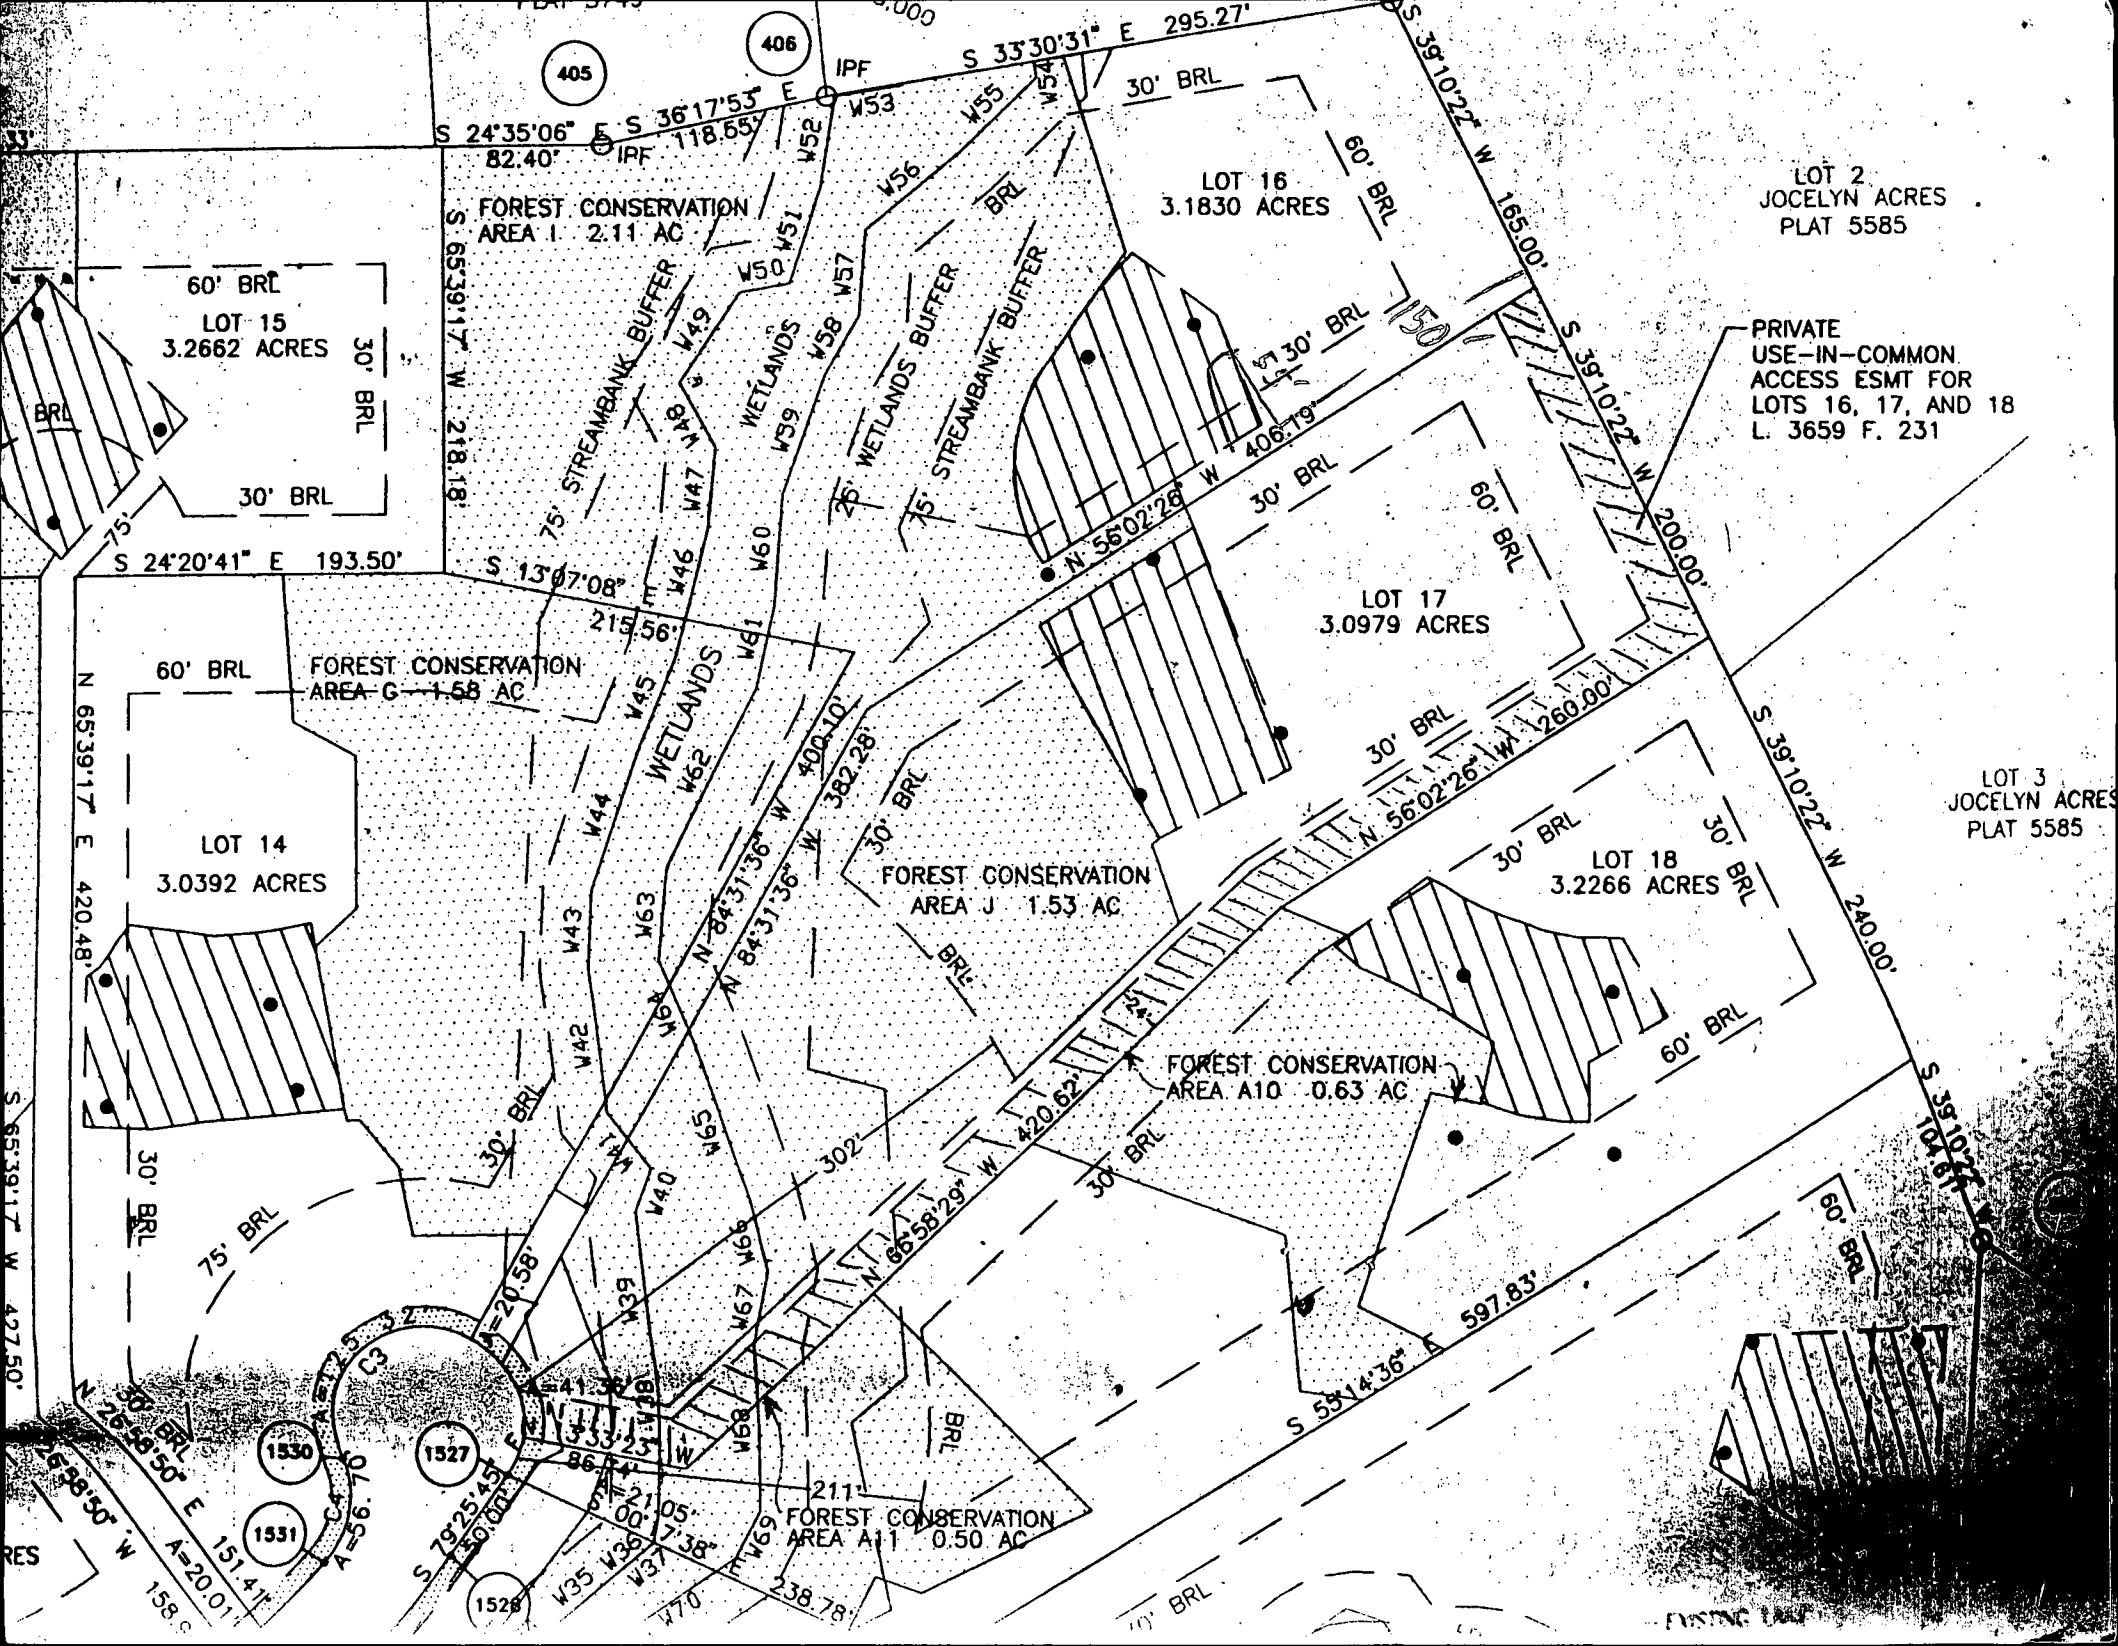

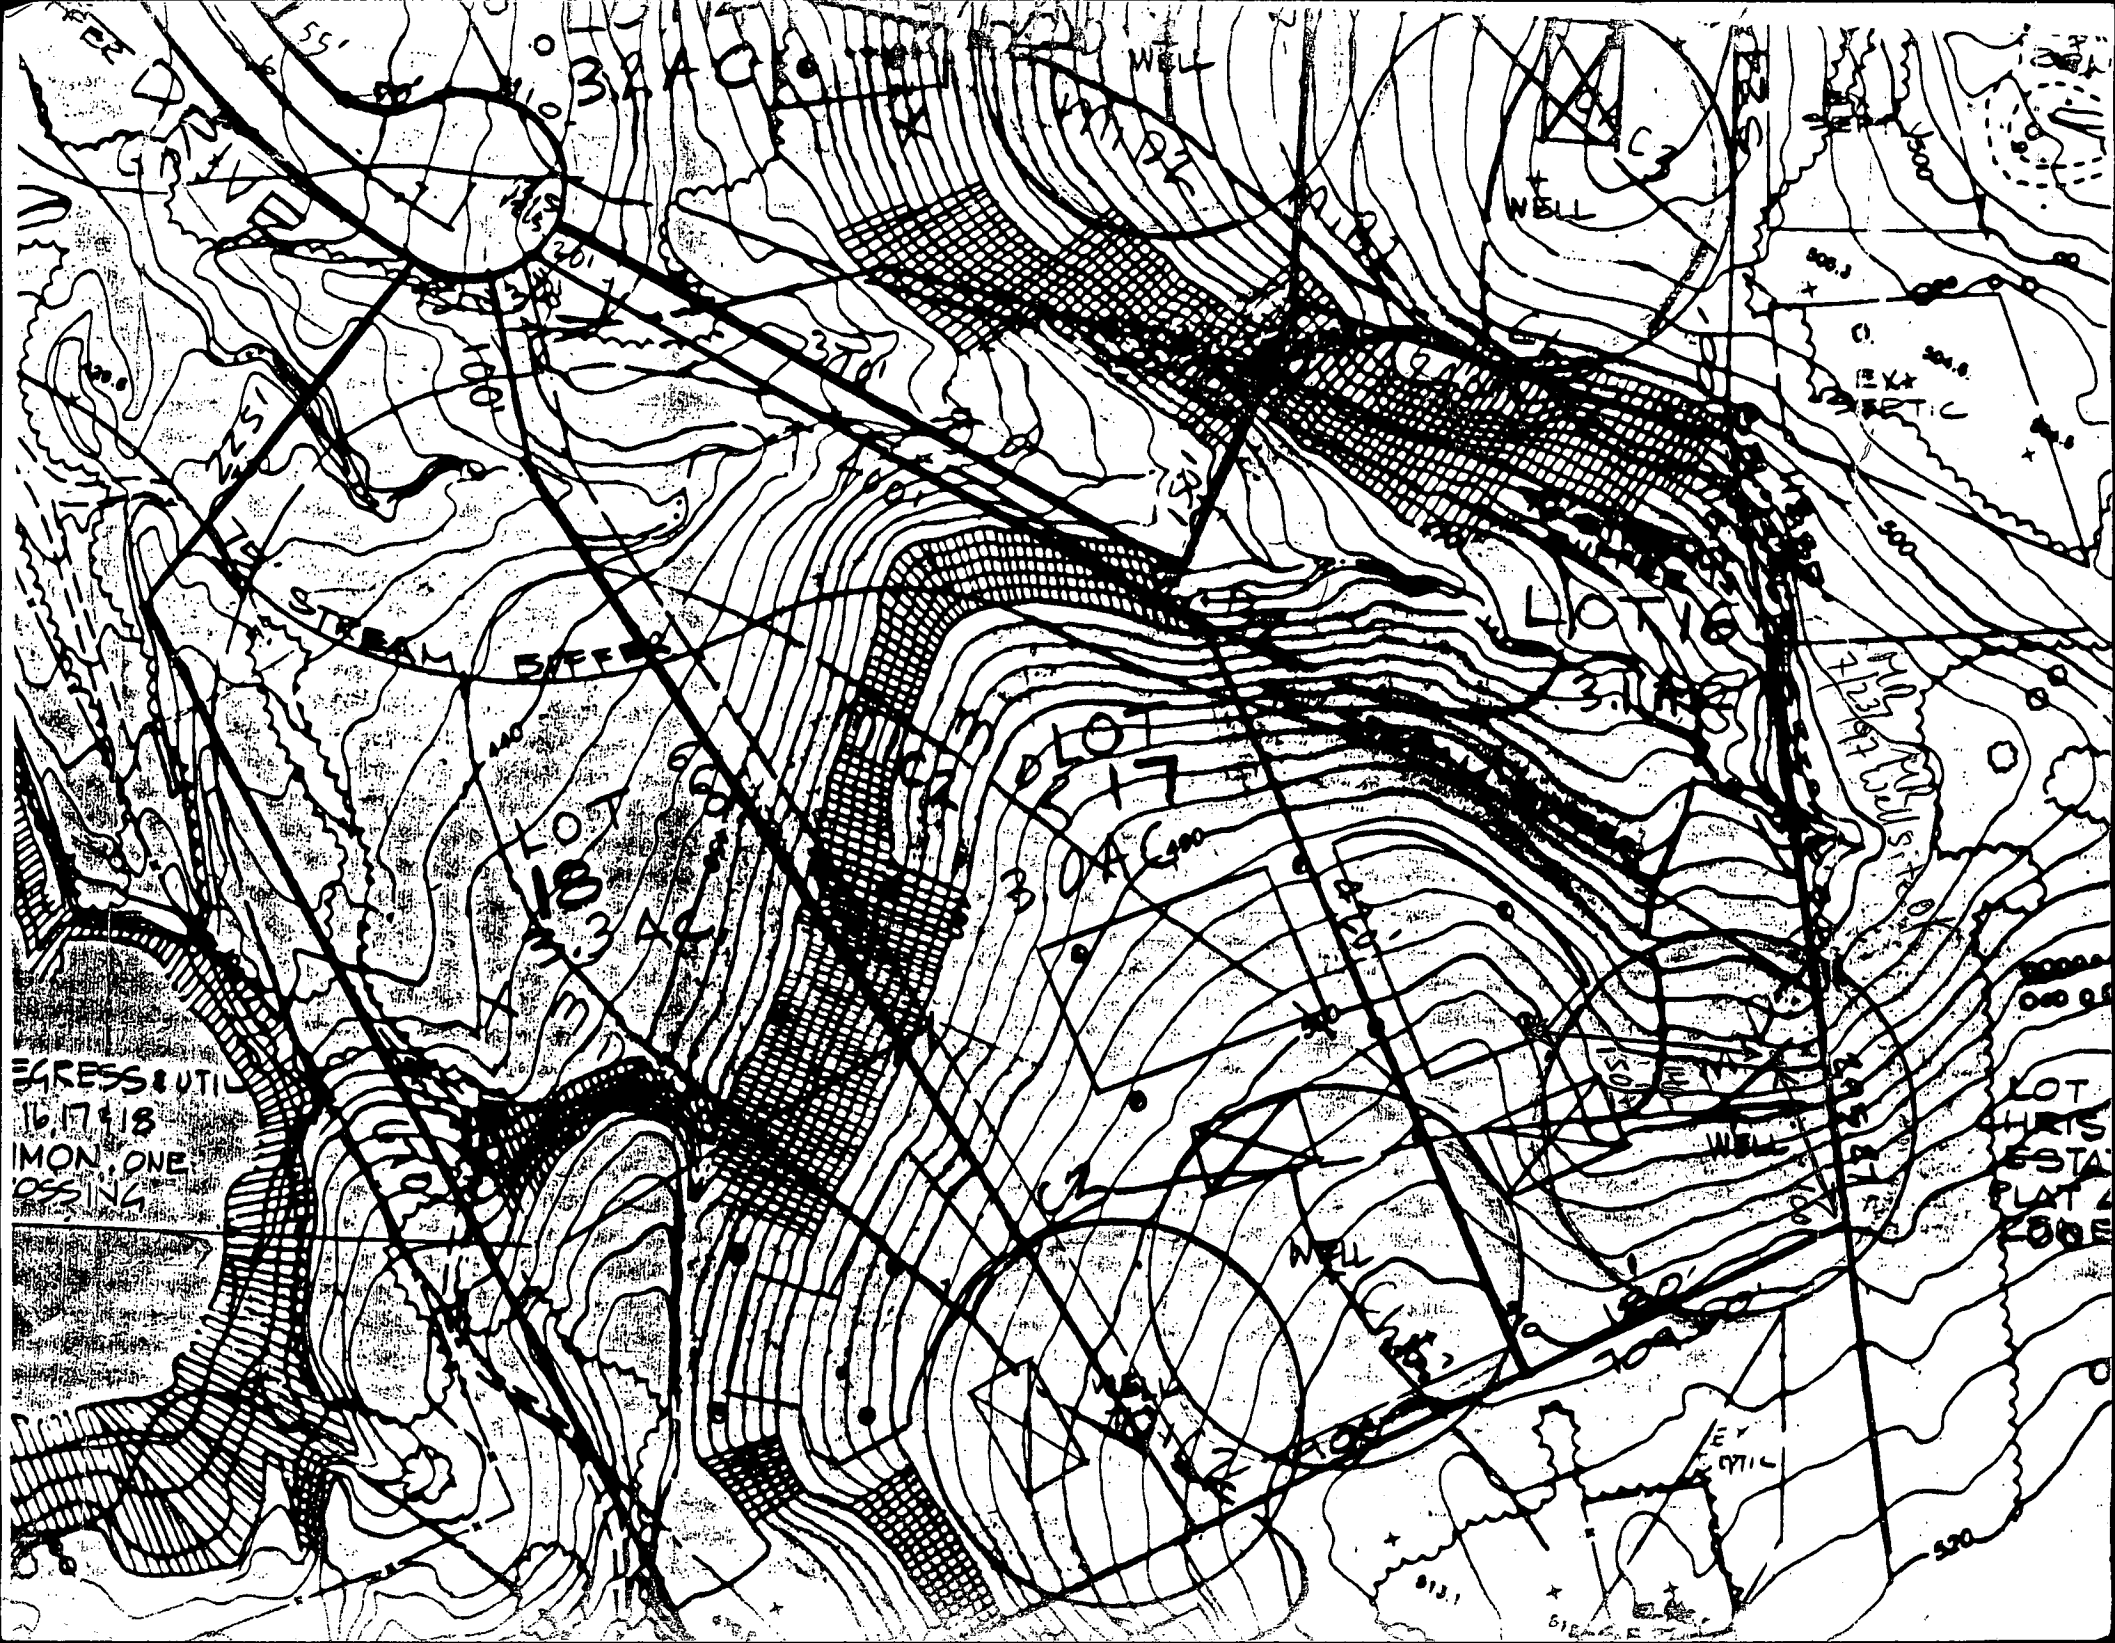

C 1 9733 SEQUENCE NO. (MDE USE ONLY)

STATE OF MARYLAND
WELL COMPLETION REPORT
FILL IN THIS FORM COMPLETELY
PLEASE PRINT OR TYPETHIS REPORT MUST BE SUBMITTED WITHIN
45 DAYS AFTER WELL IS COMPLETED.COUNTY
NUMBER A 49861 G1 2 3 6
(THIS NUMBER IS TO BE PUNCHED
IN COLS. 3-6 ON ALL CARDS)ST/CO USE ONLY
DATE Received
MM DD YY

DATE WELL COMPLETED

8 25 97

Depth of Well

22 160 26
(TO NEAREST FOOT)PERMIT NO.
FROM "PERMIT TO DRILL WELL"
HO - 94 - 1241OWNER Thompson Dale
STREET OR RFD Silent Lake Dr.
SUBDIVISION SPRING LAKE EST. SECTION TOWN CLARKSVILLE LOT 16

WELL LOG

Not required for driven wells

STATE THE KIND OF FORMATIONS PENETRATED, THEIR
COLOR, DEPTH, THICKNESS AND IF WATER BEARINGDESCRIPTION (Use
additional sheets if needed)

FEET

FROM

TO

check
if water
bearing

Sand

0

18

Gray Granite

18

160

GROUTING RECORD

WELL HAS BEEN GROUTED
(Circle Appropriate Box)yes no
Y N

TYPE OF GROUTING MATERIAL (Circle one)

CEMENT CM

BENTONITE CLAY BC

NO. OF BAGS 7

NO. OF POUNDS 658

GALLONS OF WATER 42

DEPTH OF GROUT SEAL (to nearest foot)

from 0 ft. to 20 ft.
(enter 0 if from surface)

CASING RECORD

casing
types
insert
appropriate
code
below

ST

STEEL

CO

CONCRETE

PL

PLASTIC

OT

OTHER

MAIN
CASING
TYPE
STNominal diameter
top (main) casing
(nearest inch) 6Total depth
of main casing
(nearest foot) 24

OTHER CASING (if used)

EACH CASING diameter depth (feet)
inch from toscreen type
or open hole
(insert
appropriate
code
below)

SCREEN RECORD

ST

STEEL

BR

BRASS

BRONZE

PL

PLASTIC

HO

OPEN

HOLE

OT

OTHER

NUMBER OF UNSUCCESSFUL WELLS: 0

WELL HYDROFRACTURED

yes no
Y N

CIRCLE APPROPRIATE LETTER

A A WELL WAS ABANDONED AND SEALED
WHEN THIS WELL WAS COMPLETED

E ELECTRIC LOG OBTAINED

P TEST WELL CONVERTED TO PRODUCTION
WELLI HEREBY CERTIFY THAT THIS WELL HAS BEEN CONSTRUCTED IN
ACCORDANCE WITH COMAR 26.04.04 "WELL CONSTRUCTION" AND
IN CONFORMANCE WITH ALL CONDITIONS STATED IN THE ABOVE
CAPTIONED PERMIT, AND THAT THE INFORMATION PRESENTED
HEREIN IS ACCURATE AND COMPLETE TO THE BEST OF MY
KNOWLEDGE.

DRILLERS LIC. NO. 1 MSD 24

DRILLERS SIGNATURE

(MUST MATCH SIGNATURE ON APPLICATION)

LIC. NO. 1 M D

SITE SUPERVISOR (sign. of driller or journeyman
responsible for sitework if different from permittee)

DEPTH (nearest ft.)

1 2 3 100

DIAMETER OF SCREEN (NEAREST INCH)
56 60
from toGRAVEL PACK
IF WELL DRILLED
WAS FLOWING WELL
INSERT F IN BOX 68MDE USE ONLY
(NOT TO BE FILLED IN BY DRILLER)

T

(E.R.O.S.)

W Q

70 TELESCOPE
CASING72 LOG
INDICATOR74 75 76
OTHER DATA

C 3

PUMPING TEST

HOURS PUMPED (nearest hour) 3

PUMPING RATE (gal. per min.) 15

METHOD USED TO
MEASURE PUMPING RATE Bucket

WATER LEVEL (distance from land surface)

BEFORE PUMPING 5 ft.

WHEN PUMPING 49 ft.

TYPE OF PUMP USED (for test)

A air

P piston

T turbine

C centrifugal

R rotary

O other
(describe
below)

J jet

S submersible

PUMP INSTALLED

DRILLER WILL INSTALL PUMP YES NO

IF DRILLER INSTALLS PUMP, THIS SECTION
MUST BE COMPLETED FOR ALL WELLS.TYPE OF PUMP INSTALLED
PLACE (A,C,J,P,R,S,T,O)
IN BOX 29.CAPACITY:
GALLONS PER MINUTE
(to nearest gallon) 31 35

PUMP HORSE POWER 37 41

PUMP COLUMN LENGTH
(nearest ft.) 43 47CASING HEIGHT (circle appropriate box
and enter casing height)

+ above

LAND SURFACE


- below

3 (nearest
foot)

LOCATION OF WELL ON LOT

SHOW PERMANENT STRUCTURE SUCH AS
BUILDING, SEPTIC TANKS, AND /OR
LANDMARKS AND INDICATE NOT LESS
THAN TWO DISTANCES
(MEASUREMENTS TO WELL)

Silent Lake Dr.

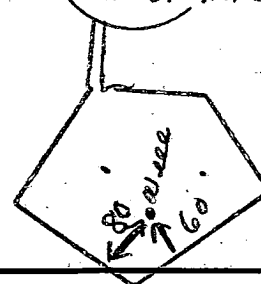

B 1 <div style="border: 1px solid black; padding: 2px; display: inline-block;">3023</div> <small>(THIS NUMBER IS TO BE PUNCHED IN COLS. 3-6 ON ALL CARDS)</small>	SEQUENCE NO. (MDE USE ONLY)	STATE OF MARYLAND PERMIT TO DRILL WELL please print or type	STATE PERMIT NUMBER <div style="border: 1px solid black; padding: 2px; display: inline-block;">H0-94-1241</div> <small>fill in this form completely</small>	
Date Received (APA) <div style="border: 1px solid black; padding: 2px; display: inline-block;">042296</div> OWNER INFORMATION <div style="display: flex; justify-content: space-between;"> <div style="width: 45%;"> <small>15 Last Name</small> <div style="border: 1px solid black; padding: 2px; display: inline-block;">THOMPSON</div> </div> <div style="width: 45%;"> <small>34 First Name</small> <div style="border: 1px solid black; padding: 2px; display: inline-block;">DALE</div> </div> </div> <div style="display: flex; justify-content: space-between;"> <div style="width: 45%;"> <small>36 Street or RFD</small> <div style="border: 1px solid black; padding: 2px; display: inline-block;">10005040 COLUMBIA RD</div> </div> <div style="width: 45%;"> <small>55</small> <div style="border: 1px solid black; padding: 2px; display: inline-block;">COLUMBIA</div> </div> </div> <div style="display: flex; justify-content: space-between;"> <div style="width: 45%;"> <small>57 Town</small> <div style="border: 1px solid black; padding: 2px; display: inline-block;">MD 21046</div> </div> <div style="width: 45%;"> <small>70 State 72 Zip 76</small> <div style="border: 1px solid black; padding: 2px; display: inline-block;">MD 21046</div> </div> </div>		B 3 LOCATION OF WELL <div style="display: flex; justify-content: space-between;"> <div style="width: 45%;"> <small>8 COUNTY</small> <div style="border: 1px solid black; padding: 2px; display: inline-block;">HOWARD</div> </div> <div style="width: 45%;"> <small>21</small> <div style="border: 1px solid black; padding: 2px; display: inline-block;">SPRINGDALE ESTATES</div> </div> </div> <div style="display: flex; justify-content: space-between;"> <div style="width: 45%;"> <small>23 SUBDIVISION</small> <div style="border: 1px solid black; padding: 2px; display: inline-block;">CLARKSVILLE</div> </div> <div style="width: 45%;"> <small>42</small> <div style="border: 1px solid black; padding: 2px; display: inline-block;">CLARKSVILLE</div> </div> </div> <div style="display: flex; justify-content: space-between;"> <div style="width: 45%;"> <small>44 SECTION</small> <div style="border: 1px solid black; padding: 2px; display: inline-block;">16</div> </div> <div style="width: 45%;"> <small>46 LOT</small> <div style="border: 1px solid black; padding: 2px; display: inline-block;">16</div> </div> </div> <div style="display: flex; justify-content: space-between;"> <div style="width: 45%;"> <small>52 NEAREST TOWN</small> <div style="border: 1px solid black; padding: 2px; display: inline-block;">CLARKSVILLE</div> </div> <div style="width: 45%;"> <small>71</small> <div style="border: 1px solid black; padding: 2px; display: inline-block;">CLARKSVILLE</div> </div> </div> <div style="display: flex; justify-content: space-between;"> <div style="width: 45%;"> <small>73 MILES FROM TOWN (enter 0 if in town)</small> <div style="border: 1px solid black; padding: 2px; display: inline-block;">4</div> </div> <div style="width: 45%;"> <small>76 77 78</small> <div style="border: 1px solid black; padding: 2px; display: inline-block;">MI</div> </div> </div>		
B 2 DRILLER INFORMATION <div style="display: flex; justify-content: space-between;"> <div style="width: 45%;"> <small>Driller's Name</small> <div style="border: 1px solid black; padding: 2px; display: inline-block;">Joseph P. Mayne</div> </div> <div style="width: 45%;"> <small>77 License No. 80</small> <div style="border: 1px solid black; padding: 2px; display: inline-block;">24</div> </div> </div> <div style="display: flex; justify-content: space-between;"> <div style="width: 45%;"> <small>Firm Name</small> <div style="border: 1px solid black; padding: 2px; display: inline-block;">Joseph P. Mayne Well Drilling</div> </div> <div style="width: 45%;"> <small>Address</small> <div style="border: 1px solid black; padding: 2px; display: inline-block;">5512 Ridge Rd. Mt Airy Md. 21771</div> </div> </div> <div style="display: flex; justify-content: space-between;"> <div style="width: 45%;"> <small>Signature</small> <div style="border: 1px solid black; padding: 2px; display: inline-block;">Joseph P Mayne 4/22/96</div> </div> <div style="width: 45%;"> <small>Date</small> <div style="border: 1px solid black; padding: 2px; display: inline-block;">4/22/96</div> </div> </div>		B 4 DIRECTION OF WELL FROM TOWN (CIRCLE BOX) 		NEAR WHAT ROAD <div style="border: 1px solid black; padding: 2px; display: inline-block;">Silent Lake Dr.</div> ON WHICH SIDE OF ROAD (CIRCLE APPROPRIATE BOX) <div style="display: flex; justify-content: space-around;"> <div style="text-align: center;"> <small>WEST</small> <div style="border: 1px solid black; padding: 2px; display: inline-block;">W</div> </div> <div style="text-align: center;"> <small>EAST</small> <div style="border: 1px solid black; padding: 2px; display: inline-block;">E</div> </div> </div> <div style="display: flex; justify-content: space-around;"> <div style="text-align: center;"> <small>34 DISTANCE FROM ROAD</small> <div style="border: 1px solid black; padding: 2px; display: inline-block;">750</div> </div> <div style="text-align: center;"> <small>37</small> <div style="border: 1px solid black; padding: 2px; display: inline-block;">FT</div> </div> </div> <div style="display: flex; justify-content: space-around;"> <div style="text-align: center;"> <small>ENTER FT OR MI</small> <div style="border: 1px solid black; padding: 2px; display: inline-block;">FT</div> </div> <div style="text-align: center;"> <small>38 39</small> <div style="border: 1px solid black; padding: 2px; display: inline-block;">FT</div> </div> </div> <div style="display: flex; justify-content: space-between;"> <div style="width: 45%;"> <small>TAX MAP</small> <div style="border: 1px solid black; padding: 2px; display: inline-block;">34</div> </div> <div style="width: 45%;"> <small>BLK</small> <div style="border: 1px solid black; padding: 2px; display: inline-block;">14</div> </div> </div> <div style="display: flex; justify-content: space-between;"> <div style="width: 45%;"> <small>PARCEL</small> <div style="border: 1px solid black; padding: 2px; display: inline-block;">60</div> </div> <div style="width: 45%;"> <small>60</small> <div style="border: 1px solid black; padding: 2px; display: inline-block;">60</div> </div> </div>
USE FOR WATER (CIRCLE APPROPRIATE BOX) <div style="display: flex; flex-wrap: wrap;"> <div style="width: 50%;"> <input checked="" type="checkbox"/> HOME (SINGLE OR DOUBLE HOUSEHOLD UNIT ONLY) </div> <div style="width: 50%;"> <input type="checkbox"/> FARMING (LIVESTOCK WATERING & AGRICULTURAL IRRIGATION) </div> <div style="width: 50%;"> <input type="checkbox"/> INDUSTRIAL, COMMERCIAL, STATE AND FEDERAL GOV. OTHER (REQUIRES APPROPRIATION PERMIT) </div> <div style="width: 50%;"> <input type="checkbox"/> PUBLIC OR PRIVATE WATER COMPANY (REQUIRES APPROPRIATION PERMIT AND STATE HEALTH DEPARTMENT APPROVAL) </div> <div style="width: 50%;"> <input type="checkbox"/> TEST, OBSERVATION, MONITORING (MAY REQUIRE APPROPRIATION PERMIT) </div> </div>		NOT TO BE FILLED IN BY DRILLER HEALTH DEPARTMENT APPROVAL <div style="display: flex; justify-content: space-between;"> <div style="width: 45%;"> <small>COUNTY NAME</small> <div style="border: 1px solid black; padding: 2px; display: inline-block;">Howard</div> </div> <div style="width: 45%;"> <small>COUNTY NO.</small> <div style="border: 1px solid black; padding: 2px; display: inline-block;">A49861G</div> </div> </div> <div style="display: flex; justify-content: space-between;"> <div style="width: 45%;"> <small>STATE SIGNATURE</small> <div style="border: 1px solid black; padding: 2px; display: inline-block;">Mark E. Rifkin</div> </div> <div style="width: 45%;"> <small>DATE ISSUED</small> <div style="border: 1px solid black; padding: 2px; display: inline-block;">7/28/98</div> </div> </div> <div style="display: flex; justify-content: space-between;"> <div style="width: 45%;"> <small>43 NORTH GRID</small> <div style="border: 1px solid black; padding: 2px; display: inline-block;">497000</div> </div> <div style="width: 45%;"> <small>48 CO SIGNATURE</small> <div style="border: 1px solid black; padding: 2px; display: inline-block;">Mark E. Rifkin</div> </div> </div> <div style="display: flex; justify-content: space-between;"> <div style="width: 45%;"> <small>50 EAST GRID</small> <div style="border: 1px solid black; padding: 2px; display: inline-block;">0805000</div> </div> <div style="width: 45%;"> <small>55 EXP. DATE</small> <div style="border: 1px solid black; padding: 2px; display: inline-block;">8/25/97</div> </div> </div>		
APPROXIMATE DEPTH OF WELL <div style="border: 1px solid black; padding: 2px; display: inline-block;">280</div> FEET <small>24 28</small>		SHOW MAJOR FEATURES OF BOX & LOCATE WELL WITH AN X SOURCES OF DRILLING WATER 1. Well 2. 3. WRITE THE BOX NUMBER FROM THE MAP HERE <div style="display: flex; justify-content: space-around;"> <div style="text-align: center;"> <small>E</small> <div style="border: 1px solid black; padding: 2px; display: inline-block;">805</div> </div> <div style="text-align: center;"> <small>N</small> <div style="border: 1px solid black; padding: 2px; display: inline-block;">497</div> </div> </div>		
APPROXIMATE DIAMETER OF WELL <div style="border: 1px solid black; padding: 2px; display: inline-block;">6</div> INCH <small>NEAREST INCH</small>		METHOD OF DRILLING (circle one) <div style="display: flex; justify-content: space-between;"> <div style="width: 45%;"> <small>BORED (or Augered)</small> <div style="border: 1px solid black; padding: 2px; display: inline-block;">GABLE</div> </div> <div style="width: 45%;"> <small>JETTED</small> <div style="border: 1px solid black; padding: 2px; display: inline-block;">JETTED & DRIVEN</div> </div> </div> <div style="display: flex; justify-content: space-between;"> <div style="width: 45%;"> <small>30 AIR-ROTARY</small> <div style="border: 1px solid black; padding: 2px; display: inline-block;">GABLE</div> </div> <div style="width: 45%;"> <small>37 AIR-PERCussion</small> <div style="border: 1px solid black; padding: 2px; display: inline-block;">ROTARY (Hydraulic Rotary)</div> </div> </div> <div style="display: flex; justify-content: space-between;"> <div style="width: 45%;"> <small>REVERSE-ROTARY</small> <div style="border: 1px solid black; padding: 2px; display: inline-block;">Drive-POINT</div> </div> <div style="width: 45%;"> <small>other</small> <div style="border: 1px solid black; padding: 2px; display: inline-block;"></div> </div> </div>		
REPLACEMENT OR DEEPEMED WELLS (CIRCLE APPROPRIATE BOX) <div style="display: flex; flex-wrap: wrap;"> <div style="width: 50%;"> <input checked="" type="checkbox"/> THIS WELL WILL NOT REPLACE AN EXISTING WELL </div> <div style="width: 50%;"> <input type="checkbox"/> THIS WELL WILL REPLACE A WELL THAT WILL BE ABANDONED AND SEALED </div> <div style="width: 50%;"> <input type="checkbox"/> THIS WELL WILL REPLACE A WELL THAT WILL BE USED AS A STANDBY-CONTACT LOCAL APPROVING AUTHORITY FOR POLICY ON STANDBY WELLS </div> <div style="width: 50%;"> <input type="checkbox"/> THIS WELL WILL DEEPEMED AN EXISTING WELL </div> </div> <div style="display: flex; justify-content: space-between;"> <div style="width: 45%;"> <small>PERMIT NUMBER OF WELL TO BE REPLACED OR DEEPEMED (IF AVAILABLE)</small> <div style="border: 1px solid black; padding: 2px; display: inline-block;">41</div> </div> <div style="width: 45%;"> <small>52</small> <div style="border: 1px solid black; padding: 2px; display: inline-block;">52</div> </div> </div>		DRAW A SKETCH BELOW SHOWING LOCATION OF WELL IN RELATION TO NEARBY TOWNS AND ROADS AND GIVE DISTANCE FROM WELL TO NEAREST ROAD JUNCTION <div style="text-align: center;"> <small>N</small> </div>		
Not to be filled in by driller (MDE OR COUNTY USE ONLY) APPROX. PERMIT NUMBER <div style="border: 1px solid black; padding: 2px; display: inline-block;">GAP</div> <small>54 63</small>				
FORCE <div style="border: 1px solid black; padding: 2px; display: inline-block;">M2</div> <small>67 68</small>				
PERMIT No. <div style="border: 1px solid black; padding: 2px; display: inline-block;">H0-94-1241</div> <small>70 71 72 73 74 75 76 77 78 79</small>				
SPECIAL CONDITIONS <small>NOTE - APPROVING AUTHORITIES SHOULD USE SEPARATE SHEET IF NEEDED</small>				