

PERMIT

SEWAGE DISPOSAL SYSTEM

DEPARTMENT OF HEALTH AND MENTAL HYGIENE

P 59801

A 49914-E

DISTRICT

DATE 2-2-98

DATE SYSTEM APPROVED 2/26/98

INSPECTOR Km

HOWARD COUNTY HEALTH DEPARTMENT

BUREAU OF ENVIRONMENTAL HEALTH

XXXX-9933XX

410-313-2640

INDEXED

South Carroll Backhoe, Inc.

IS PERMITTED TO INSTALL ☒ ALTER

ADDRESS 4410 Salem Bottom Road Westminster, Maryland 21157 PHONE (410) 875-4197

SUBDIVISION Sobus Farms LOT 838 ROAD 3016 Sobus Drive

PROPERTY OWNER Altieri Homes / Wayne Patrick

ADDRESS

SEPTIC TANK CAPACITY 1250 GALLONS

NUMBER OF BEDROOMS 4

180 SQUARE FEET PER BEDROOM

LINEAR FEET OF TRENCH REQUIRED 240

TRENCHES -- Trench to be 2 feet wide. Inlet 3 feet below original grade. Bottom maximum depth 6 feet below original grade. Effective area begins at 2 feet below original grade. 34 feet of stone below distribution pipe.

LOCATION - Place distribution box 185 feet up the left (277.35') lot line and 90 feet off that same lot line as seen when facing the lot from Sobus Drive. Run trenches on contour toward the back (460.00') lot line.

NOTES - No trench to exceed 100 feet in length. Provide 6" - 8" diameter cleanout and cap to grade or above on septic tank.

ok Km 11/13/97

PLANS APPROVED BY Amy McMillen

DATE 11/12/97

COVER NO WORK UNTIL INSPECTED AND APPROVED

NEITHER THE HOWARD COUNTY COUNCIL NOR THE HEALTH DEPARTMENT IS RESPONSIBLE FOR THE SUCCESSFUL OPERATION OF ANY SYSTEM

NOTE: CLEANOUT REQUIRED EVERY 70 FEET OF SEWER LINE AND/OR AT 90° SWEEPS IN LINES FROM HOUSE TO DRAIN FIELDS, 90° ELBOWS NOT ACCEPTABLE.

NOTE: ALL PARTS OF SEPTIC SYSTEMS (I.E. TANK, DISTRIBUTION BOX TRENCHES) TO BE 100 FEET FROM WELL (UNLESS OTHERWISE SPECIFICALLY AUTHORIZED)

NOTE: IF DEEP TRENCH(ES) ARE USED CALL FOR INSPECTION BEFORE AND AFTER PLACING GRAVEL IN TRENCH(ES)

NOTE: NO DRY WELL SHALL EXCEED 15 FOOT IN DIAMETER NO ABSORPTION TRENCH TO EXCEED 100 FEET IN LENGTH

NOTE: ALL PIPE FROM HOUSE TO SEPTIC TANK MUST BE CAST IRON OR SCHEDULE 35/40 PVC OR ABS

PERMIT VOID AFTER TWO YEARS

NOTE: INSTALL STAND PIPE ON SEPTIC TANK AND DRY WELL STAND PIPES MUST BE 6 INCHES IN DIAMETER CAST IRON. CONCRETE OR TERRA COTTA OR PVA OR ABS ACCEPTED. IF TOP OF SEPTIC TANK IS DEEPER THAN 3 FEET. MANHOLE TO GRADE REQUIRED.

NOTE: DISTRIBUTION BOXES MUST HAVE BAFFLES

*INSTALLER IS RESPONSIBLE FOR OBTAINING FINAL APPROVAL ON THIS PERMIT

HD-260(6-90)

*CALL 461-9933 FOR INSPECTION OF SEPTIC SYSTEM.


ORIGINAL PERMIT SIGNATURE

DATE 6-18-98

SERIAL # 5011574

done

A 49914-E

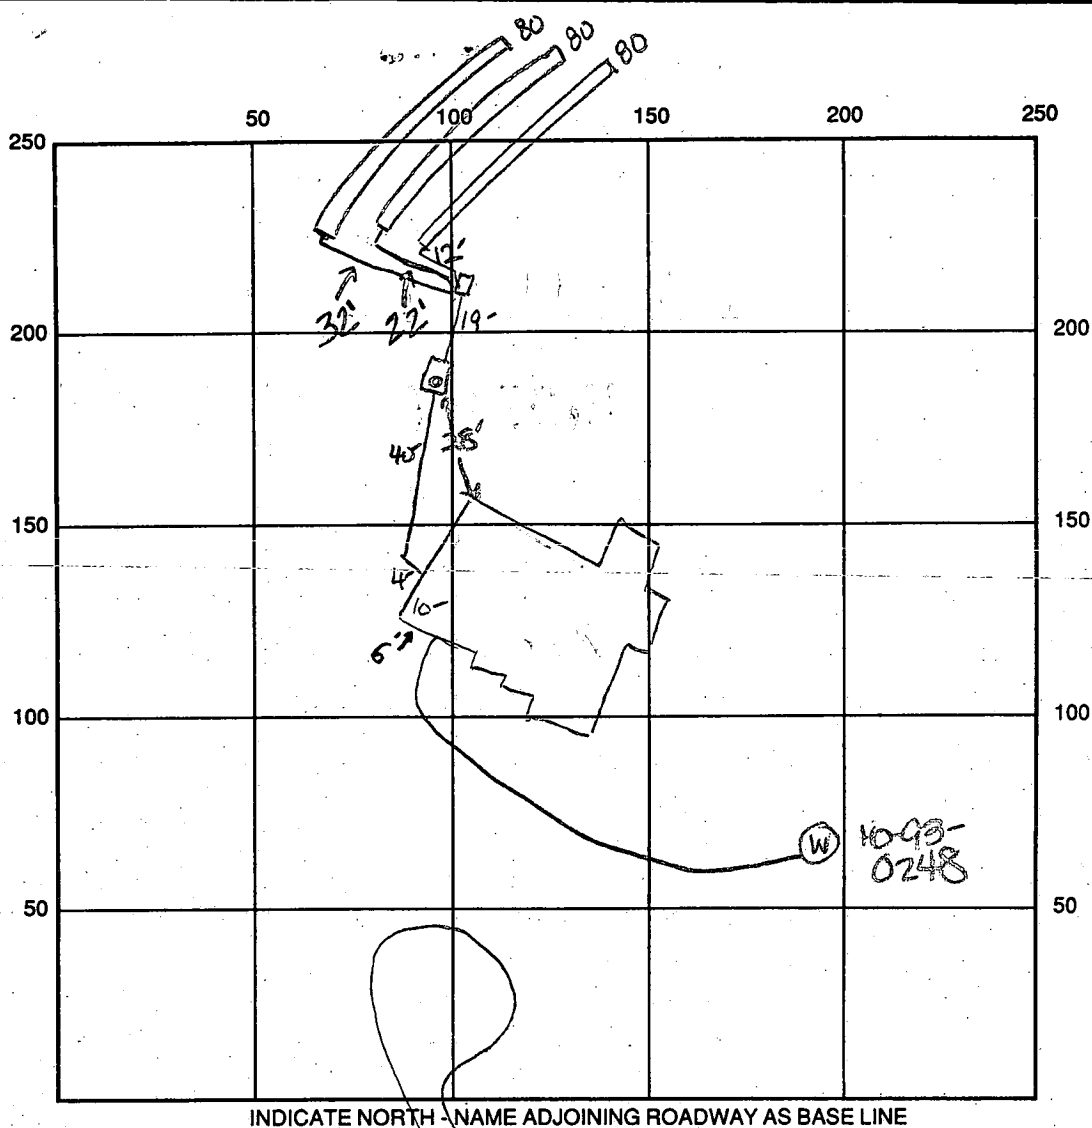

INDICATE NORTH - NAME ADJOINING ROADWAY AS BASE LINE

SEPTIC TANK LEVEL OK- 1250 gal Sobus Drive CLEANOUTS 1 on tank

DISTRIBUTION BOX LEVEL OK

DRAIN FIELD/TITLE DEPTH 6 FT. TRENCH WIDTH 2 FT. INLET DEPTH 3 FT.

EFFECTIVE GRAVEL DEPTH 3 FT. TOTAL LENGTH 80x3 FT. → 240


NUMBER OF TRENCHES 3 ONE SIDEWALL/BOTTOM AREA 720 SQ. FT.

DRYWALL INSIDE DIAMETER — FT. EFFECTIVE DEPTH BELOW INLET — FT.

ABSORBENT AREA — SQ. FT.

REMARKS: 2/25/98 A.M. - OK to continue work. DKS
2/25/98 P.M. OK to store 1st trench and continue. DKS
2/26/98 has house connection, OK to finish storing last trench and
cover all work (ENT)

DATE SYSTEM APPROVED 2/26/98 INSPECTOR Kimberly Maister

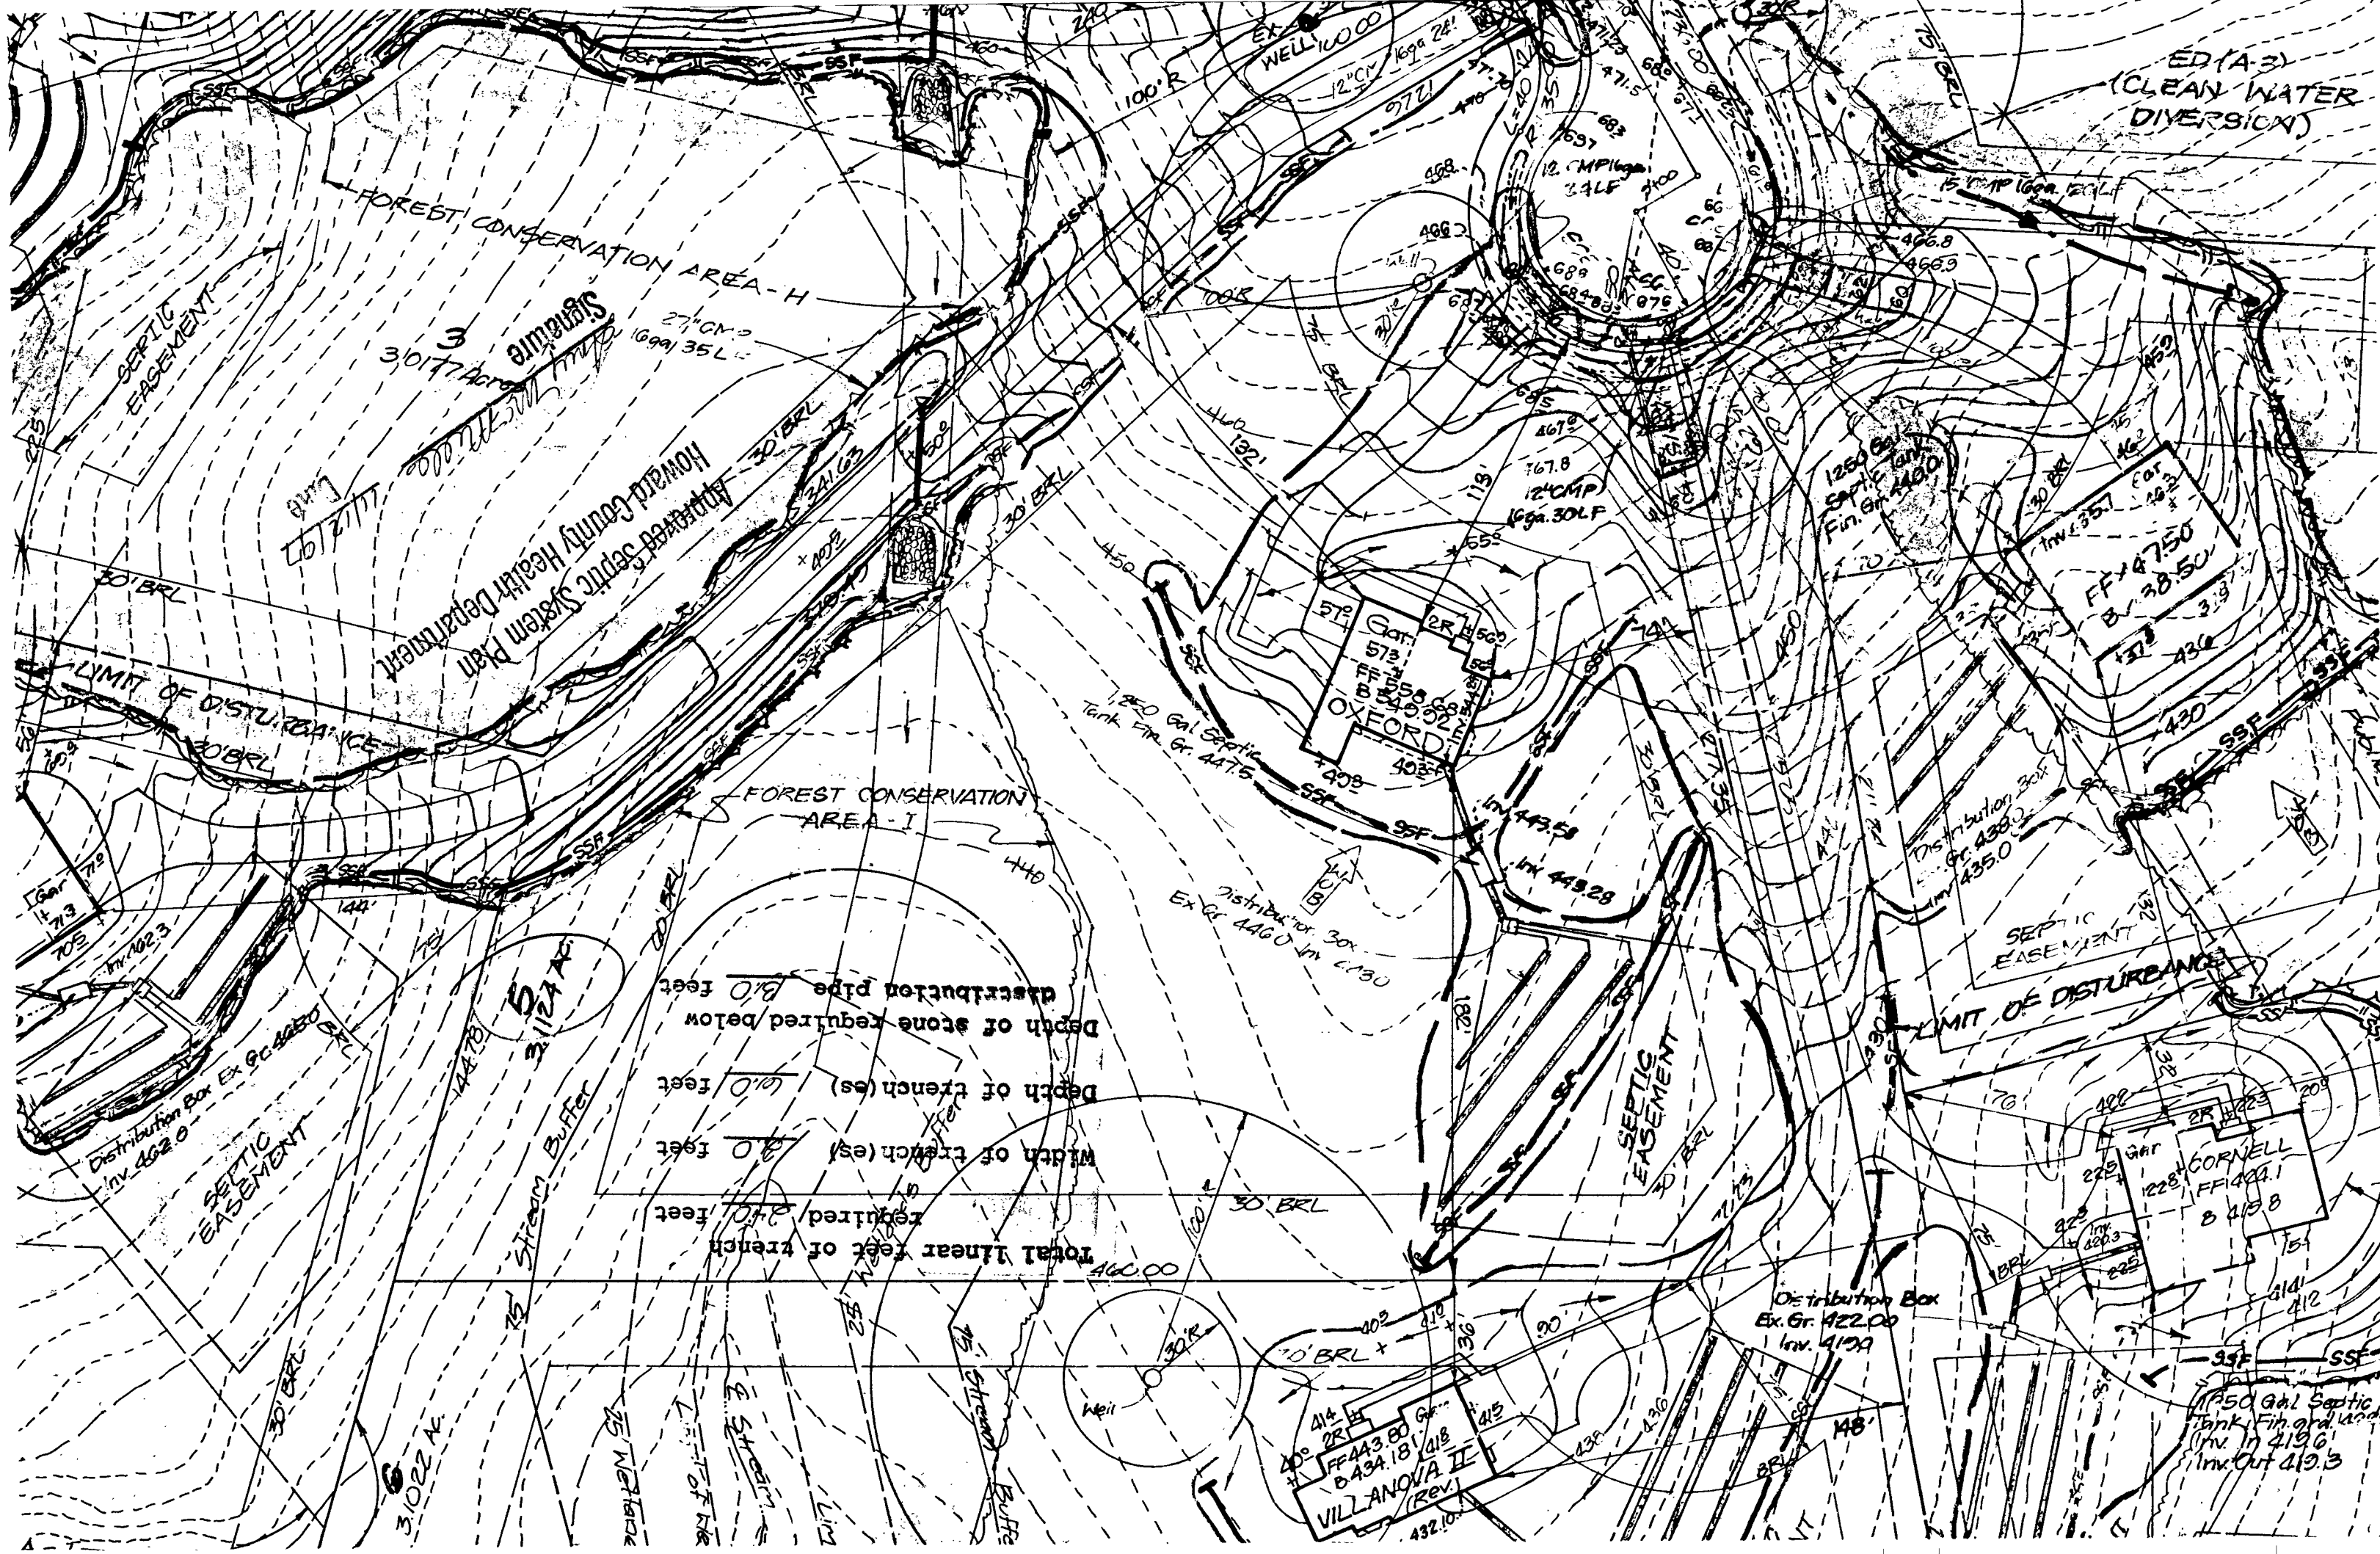

Depth of trench below
distribution pipe 8.0 feet

Depth of trench(es) 4.0 feet

Width of trench(es) 2.0 feet

Total linear feet of trench
required 240 feet

ED (A-3)
(CLEAN WATER
DIVERSION)

FOREST CONSERVATION AREA - H

FOREST CONSERVATION
AREA - I

Howard County Health Department
Approved Septic System Plan
Signature
30177

SEPTIC EASEMENT
LIMIT OF DISTURBANCE

VILLANOVA II
(REV.)
FF 44380
B 43481
414
415
416
1250 Gal Septic
Tank Fin. Gr. 4400
Inv. 4196
Inv. Out 4193

Distribution Box
Ex. Gr. 4422.00
Inv. 4199

Distribution Box Ex. Gr. 4460.0
Inv. 4662.0

31022 AC

Stream Buffer
31124 AC

APPLICATION

8/16/94
Notes are still on lot 5
(PERC. CERT) But not being
used. AM

PERCOLATION TESTING

A 49914E

P _____

HOWARD COUNTY HEALTH DEPARTMENT

BUREAU OF ENVIRONMENTAL HEALTH

3525-H ELLICOTT MILLS DRIVE/ELLICOTT CITY, MARYLAND 21043
TELEPHONE: 313-2640

DISTRICT 3

DATE 3/9/94

TO: THE COUNTY HEALTH OFFICER
ELLICOTT CITY, MARYLAND

I HEREBY APPLY FOR THE NECESSARY TEST PRIOR TO APPLICATION FOR PERMIT TO CONSTRUCT (OR RECONSTRUCT) A SEWAGE DISPOSAL SYSTEM.

PROPERTY OWNER Hilltop Development Corporation A/Tieri Homes

ADDRESS P.O. Box 208, Clarksville, Md. 21029 PHONE 410-531-5539

AGENT OR PROSPECTIVE BUYER Richard Demmitt

ADDRESS P.O. Box 208, Clarksville Md. 21029 PHONE 410-531-5539

PROPERTY LOCATION:

SUBDIVISION Sabus Farms LOT NO. 5 (Five)

ROAD AND DESCRIPTION at the end of Winfield Rd. (3016 Sabus Drive)

BLDG. PERMIT SIGNED

AND RETURNED 11-12-97

Serial # 200108731

TAX MAP 15 PARCEL # 269 154

SIZE OF LOT 3 acres + TYPE BLDG. S.F.D. - 4 Bdr
(SINGLE FAMILY DWELLING OR COMMERCIAL)

THE SYSTEM INSTALLED UNDER THIS APPLICATION IS ACCEPTABLE ONLY UNTIL PUBLIC FACILITIES BECOME AVAILABLE. I FULLY UNDERSTAND THE

FEE CONNECTED WITH THE FILING OF THIS PERC TEST APPLICATION IS NON-REFUNDABLE UNDER ANY CIRCUMSTANCES. I ALSO AGREE TO

COMPLY WITH ALL M.O.S.H.A. REQUIREMENTS IN TESTING THIS LOT. Richard Demmitt
(SIGNATURE OF APPLICANT)

APPROVED BY _____ FOR _____ DATE _____

DISAPPROVED BY _____ FOR _____ DATE _____

HOLD PENDING FURTHER TESTS _____

REASONS FOR REJECTION OR HOLDING _____

PERCOLATION TEST PLAT/PRELIMINARY PLAT - TITLE OR I.D. # _____ DATE _____

SITE DEVELOPMENT PLAN/FINAL PLAT - TITLE OR I.D. # _____ DATE _____

THIS IS NOT A PERMIT

A49914E

COUNTY #

SOIL PROFILE

A/E


0' brn / orange
S.L mica
2' brn
S(L)
w mica
some
Saprolite
<5%
12'

B

tan / brn
S.L
1' brn
S(L)
w mica
some
Saprolite
OK
same
as
A
11 1/2'

C

dkr
brn
SSIL
2' lgt
tan / brn
S.L
mica
throughout
mica
Saprolite
OK
11'

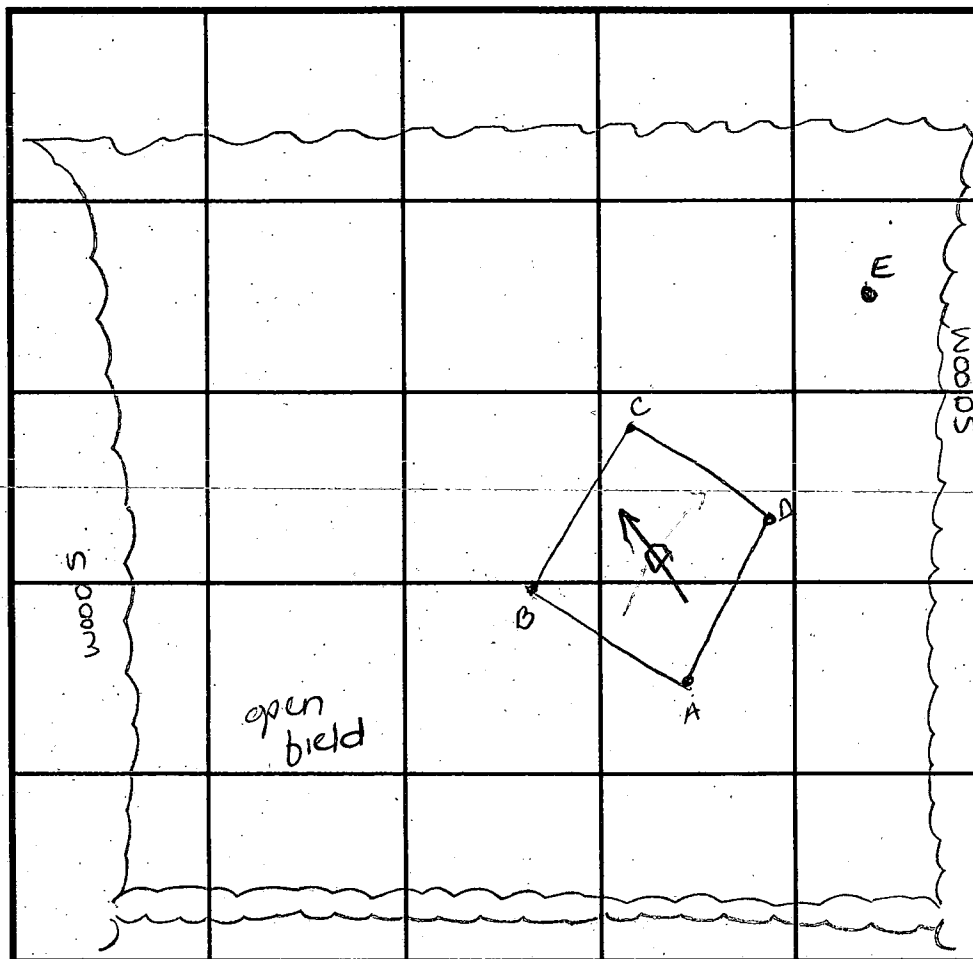

INDICATE NORTH - NAME ADJOINING ROADWAY AS BASE LINE.

SOIL PROFILE

D

0' bright
orange /
brn
S.L
2 1/2' tan /
brn
S.L
mica
10 1/2'

DATE	TEST NO.	DEPTH	PRE-WET		TEST - 1" DROP		TIME
			START	STOP	START	STOP	
3/22/94	A	3' V12'	1:45 ¹⁰	1:46 ⁴⁵	1:46 ³⁰	1:47 ³⁰	1 1/2 min
		6' V12'	1:44 ⁴⁵	1:45 ³⁰	1:45 ³⁰	1:46 ⁴⁵	1 1/4 min
	B	3 1/2' V11 1/2'	1:53 ¹⁵	1:54 ¹⁵	1:54 ¹⁵	1:56 ¹⁵	2 min
	C	3' V11'	1:58 ³⁰	1:59 ³⁰	1:59 ³⁰	2:02 ³⁰	2 1/2 min
	D	3 1/2' V10 1/2'	2:03 ³⁰	2:05 ¹⁵	2:05 ¹⁵	2:07 ⁴⁵	2 1/2 min
		7' V10 1/2'	2:02 ⁴⁵	2:03 ³⁰	2:03 ³⁰	2:05 ³⁰	1 1/2 min
9-21-94	E	2' 8" V12'	1:51	1:52 ³⁰	1:52 ³⁰	1:54 ³⁰	2 min DKS

REMARKS

TYPE OF SOIL Chc₂ Chester Silt Loam

TESTED BY A. Mcmillen / M. Ripkin ALSO PRESENT R. Denett

TRENCH DESIGN DATA: AVERAGE PERCOLATION TIME 2 min TRENCH WIDTH 2'

INLET DEPTH 2' MAXIMUM BOTTOM DEPTH 6' SQ. FT./BEDROOM 180 ft²

[illegible]

25' COR
AVES
LOT 5

Copy
P-95-15

LOT 20

49149' W

LOT 19

LOT #6

AC

M.B.

EX 12

FF=44.3
BF=34.0

75' STREAM BUFFER

ESMT

LOT #5

LOT #3

AC

DRAINAGE

473

15' BRL

15' BRL

15' BRL

15' BRL


15' BRL

FF=76.0
BF=66.0

LOT #4

LOT #2

LOT #1

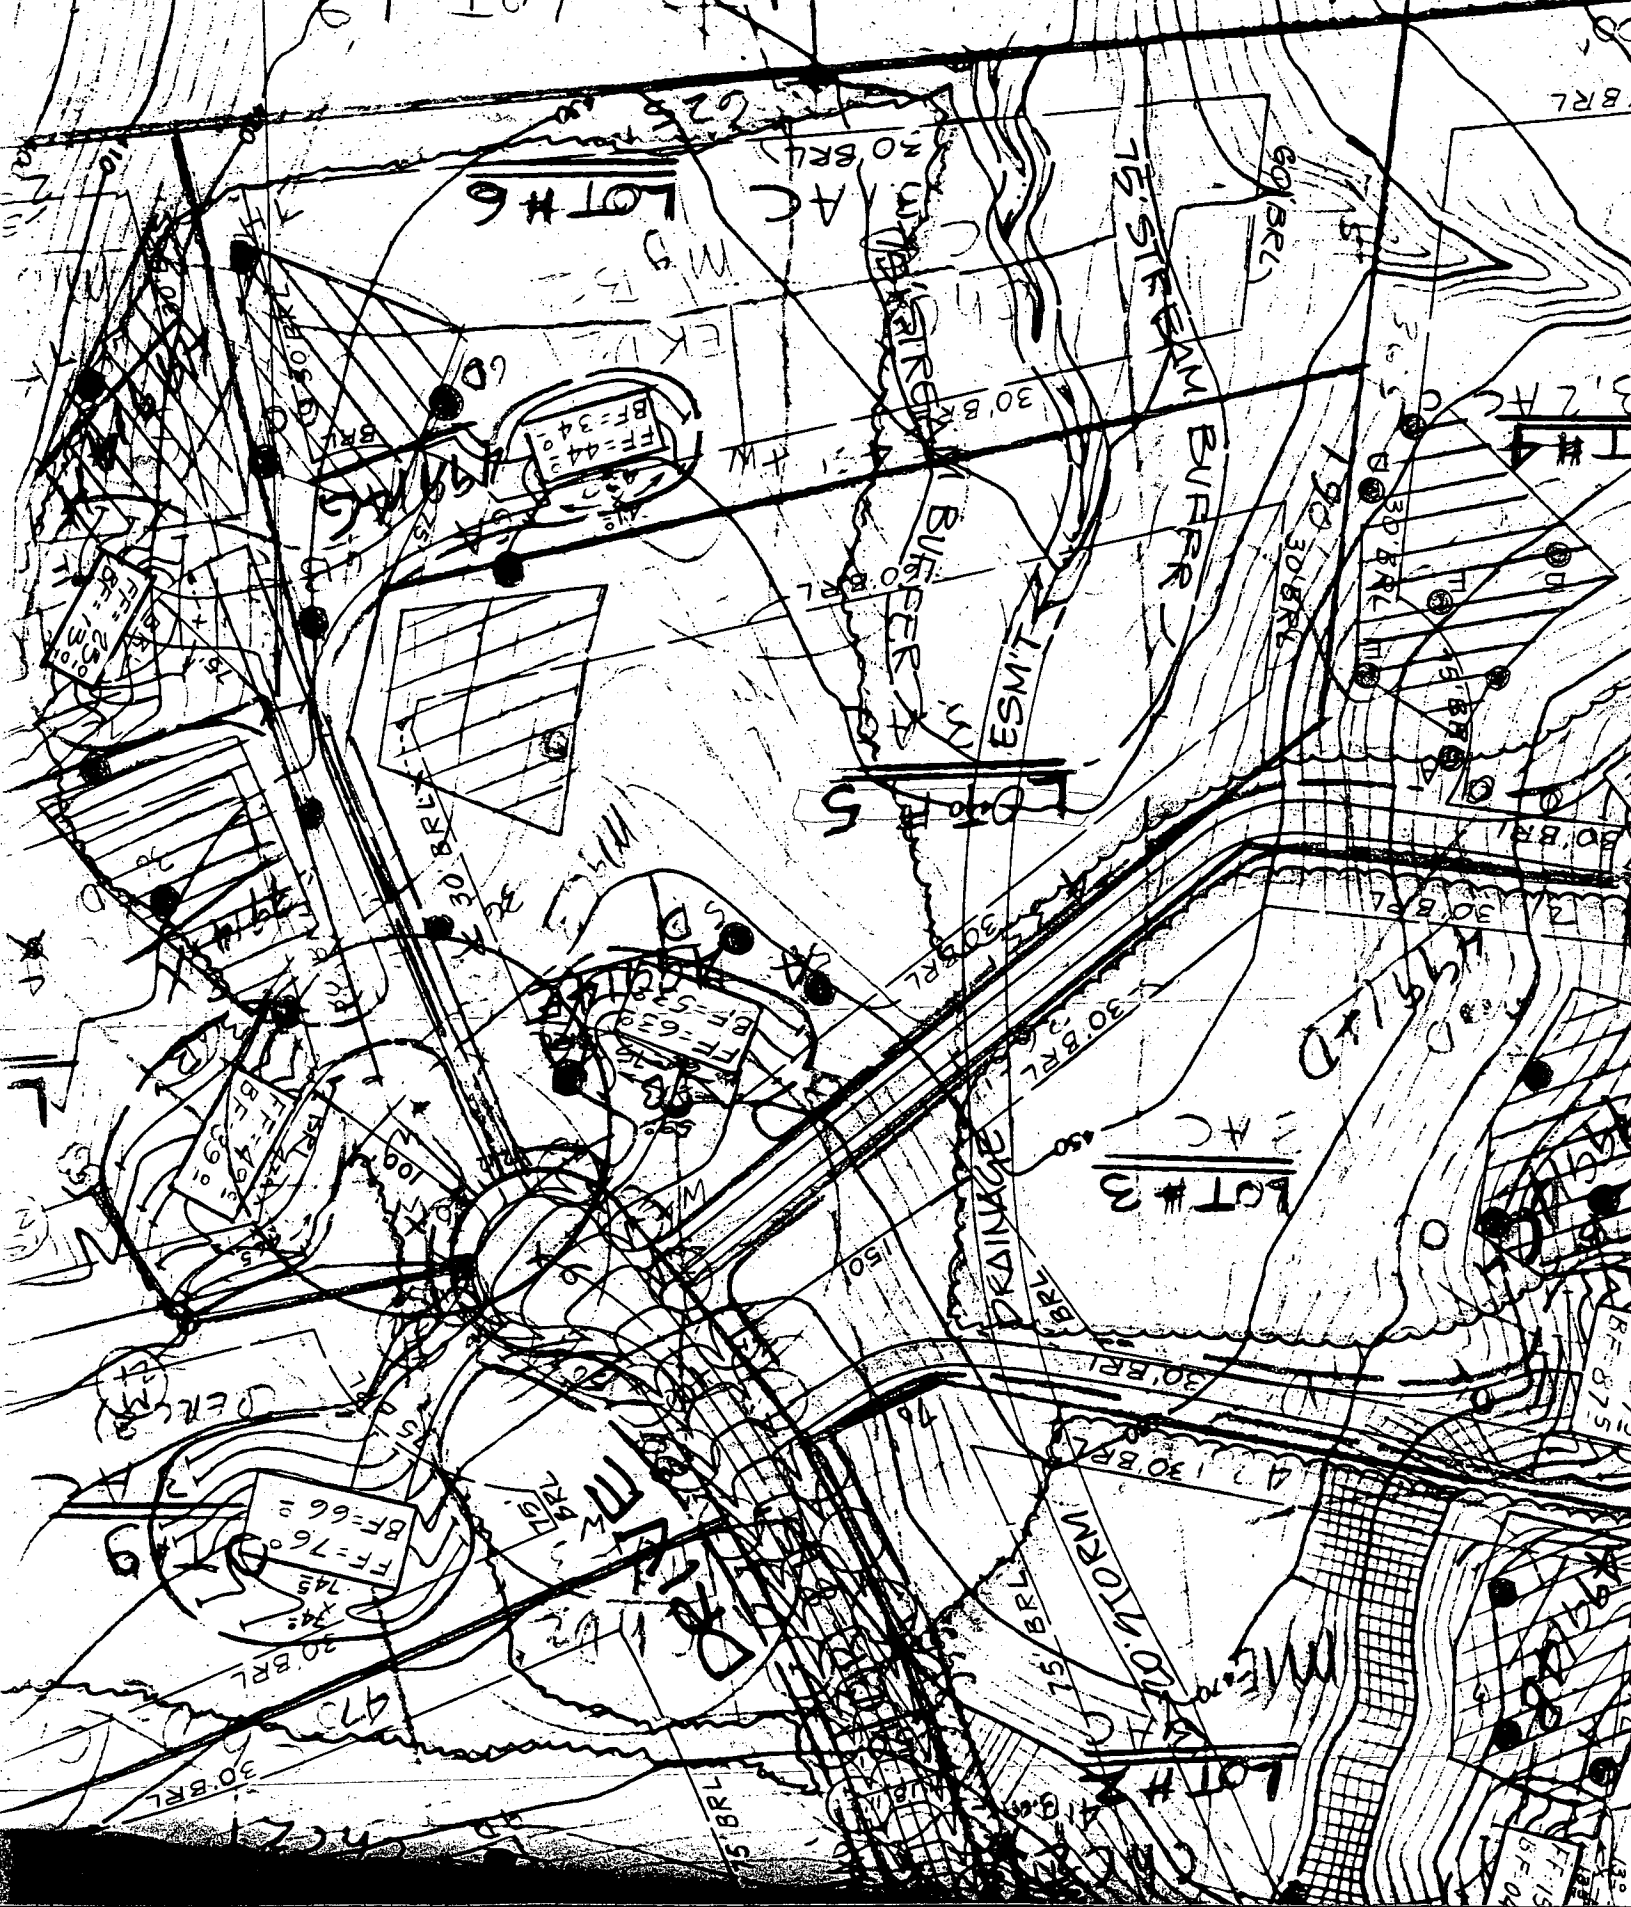

EMERGENCY/TEMP NO. IF ANY

B 1 1939		SEQUENCE NO. (MDE USE ONLY)		STATE OF MARYLAND PERMIT TO DRILL WELL please print or type		STATE PERMIT NUMBER 40-93-0248 70 fill in this form completely 79	
Date Received (APA) 11/27/95 8 13				OWNER INFORMATION Demmitt RICHARD 15 Last Name 34 First Name PO BOX 228 36 Street or RFD 55 CLARKSVILLE MD 21029 57 Town 70 State 72 Zip 76			
DRILLER INFORMATION Joseph L. Mayne Driller's Name 77 License No. 80 Joseph L. Mayne Well Drilling Firm Name 5512 Ridge Rd. Mt. Airy MD 21771 Address Joseph L. Mayne 11/27/95 Signature Date				LOCATION OF WELL Howard 8 COUNTY 21 SOBUS FARMS 23 SUBDIVISION 42 SECTION 44 46 LOT 5 48 50 West Friendship 52 NEAREST TOWN 71 MILES FROM TOWN (enter 0 if in town) 1 1/2 MI 73 76 77 78			
WELL INFORMATION APPROX. PUMPING RATE (GAL. PER MIN.) 5 8 12 AVERAGE DAILY QUANTITY NEEDED (GAL. PER DAY) 500 14 20				DIRECTION OF WELL FROM TOWN (CIRCLE BOX) NEAR WHAT ROAD SOBUS DR. 11 30 ON WHICH SIDE OF ROAD (CIRCLE APPROPRIATE BOX) 20 34 37 DISTANCE FROM ROAD ENTER FT OR MI FT 38 39 TAX MAP: BLK: PARCEL:			
USE FOR WATER (CIRCLE APPROPRIATE BOX) ☒ HOME (SINGLE OR DOUBLE HOUSEHOLD UNIT ONLY) ☐ FARMING (LIVESTOCK WATERING & AGRICULTURAL IRRIGATION) ☐ INDUSTRIAL, COMMERCIAL, STATE AND FEDERAL GOV. OTHER (REQUIRES APPROPRIATION PERMIT) ☐ PUBLIC OR PRIVATE WATER COMPANY (REQUIRES APPROPRIATION PERMIT AND STATE HEALTH DEPARTMENT APPROVAL) ☐ TEST, OBSERVATION, MONITORING (MAY REQUIRE APPROPRIATION PERMIT)				NOT TO BE FILLED IN BY DRILLER HEALTH DEPARTMENT APPROVAL Howard Co. A 49914-E COUNTY NAME COUNTY NO. STATE SIGNATURE DATE ISSUED 01/26/96 A. McMeel 11/26/97 43 48 CO SIGNATURE EXP. DATE NORTH GRID 530000 EAST GRID 0817000 50 55 57 63			
APPROXIMATE DEPTH OF WELL 300 FEET 24 28				SHOW MAJOR FEATURES OF BOX & LOCATE WELL WITH AN X SOURCES OF DRILLING WATER 1. Well 2. 3. WRITE THE BOX NUMBER FROM THE MAP HERE E 817 N 530 000 000			
APPROXIMATE DIAMETER OF WELL 6 INCH NEAREST INCH				DRAW A SKETCH BELOW SHOWING LOCATION OF WELL IN RELATION TO NEARBY TOWNS AND ROADS AND GIVE DISTANCE FROM WELL TO NEAREST ROAD JUNCTION 			
METHOD OF DRILLING (circle one) BORED (or Augered) JETTED Jetted & DRIVEN AIR-ROTARY AIR-PERCussion ROTARY (Hydraulic Rotary) CABLE REVERSE-ROTARY DRIVE-POINT other				REPLACEMENT OR DEEPEMED WELLS (CIRCLE APPROPRIATE BOX) ☒ THIS WELL WILL NOT REPLACE AN EXISTING WELL ☐ THIS WELL WILL REPLACE A WELL THAT WILL BE ABANDONED AND SEALED ☒ THIS WELL WILL REPLACE A WELL THAT WILL BE USED AS A STANDBY-CONTACT LOCAL APPROVING AUTHORITY FOR POLICY ON STANDBY WELLS ☐ THIS WELL WILL DEEPEMED AN EXISTING WELL PERMIT NUMBER OF WELL TO BE REPLACED OR DEEPEMED (IF AVAILABLE) 41 52			
Not to be filled in by driller (MDE OR COUNTY USE ONLY) APPROP. PERMIT NUMBER 54 GAP 63 FORCE AM WRITE INITIALS IN BOX PERMIT No. 40-93-0248 67 68 70 71 72 73 74 75 76 77 78 79				SPECIAL CONDITIONS NOTE - APPROVING AUTHORITIES SHOULD USE SEPARATE SHEET IF NEEDED			

COUNTY

C1	0223	SEQUENCE NO. (MDE USE ONLY)	STATE OF MARYLAND WELL COMPLETION REPORT		THIS REPORT MUST BE SUBMITTED WITHIN 45 DAYS AFTER WELL IS COMPLETED.		
							COUNTY NUMBER
(THIS NUMBER IS TO BE PUNCHED IN C.O.S. 3-6 ON ALL CARDS)			FILL IN THIS FORM COMPLETELY PLEASE PRINT OR TYPE		A-49914-E		
ST/CO USE ONLY DATE RECEIVED		DATE WELL COMPLETED		Depth of Well		PERMIT NO. FROM "PERMIT TO DRILL WELL"	
8 13		15 20		22 26		28 37	
		031296		260		H0-93-0248	
				(TO NEAREST FOOT)			

OWNER	Demmitt	Richard	last name	first name	TOWN	West Friendship
STREET OR RFD	Sobus Drive					
SUBDIVISION	Sobus Farms				SECTION	LOT 5

WELL LOG		
Not required for driven wells.		
STATE THE KIND OF FORMATIONS PENETRATED, THEIR COLOR, DEPTH, THICKNESS AND IF WATER BEARING		
DESCRIPTION (Use additional sheets if needed)	FEET FROM TO	check if water bearing
Sand	0 49	
Gray Mica Rock	49 260	

GROUTING RECORD	
WELL HAS BEEN GROUTED (Circle Appropriate Box)	
TYPE OF GROUTING MATERIAL (Circle one)	
CEMENT ☒ CM	BENTONITE CLAY ☒ BC
NO. OF BAGS 23	NO. OF POUNDS 2162
GALLONS OF WATER 138	
DEPTH OF GROUT SEAL (to nearest foot)	
from 0	ft to 49
(enter 0 if from surface)	

CASING RECORD		
casing types insert appropriate code below	STEEL ☒ ST	CONCRETE ☒ CO
	PLASTIC ☒ PL	OTHER ☒ OT
	MAIN CASING TYPE	
	Nominal diameter top (main) casing (nearest inch): 6	
Total depth of main casing (nearest foot): 53		

OTHER CASING (if used)	
diameter inch	depth (feet) from to

SCREEN RECORD			
screen type or open hole	STEEL ☒ ST	BRASS BRONZE ☒ BR	OPEN HOLE ☒ HO
insert appropriate code below	PLASTIC ☒ PL	OTHER ☒ OT	

NUMBER OF UNSUCCESSFUL WELLS:	yes ☒ Y	no ☒ N
-------------------------------	---	--

CIRCLE APPROPRIATE LETTER
A A WELL WAS ABANDONED AND SEALED WHEN THIS WELL WAS COMPLETED
E ELECTRIC LOG OBTAINED
P TEST WELL CONVERTED TO PRODUCTION WELL

I HEREBY CERTIFY THAT THIS WELL HAS BEEN CONSTRUCTED IN ACCORDANCE WITH COMAR 26.04.04 "WELL CONSTRUCTION" AND IN CONFORMANCE WITH ALL CONDITIONS STATED IN THE ABOVE CAPTIONED PERMIT, AND THAT THE INFORMATION PRESENTED HEREIN IS ACCURATE AND COMPLETE TO THE BEST OF MY KNOWLEDGE.

TYPE: MWD/MSD/MGD
DRILLERS LIC. NO. 24

DRILLERS SIGNATURE
(MUST MATCH SIGNATURE ON APPLICATION)

LIC. NO.

SITE SUPERVISOR (sign. of driller or journeyman responsible for sitework if different from permittee)

DEPTH (nearest ft.)	
1 2	3 4
5 6	7 8
9 10	11 12
13 14	15 16
17 18	19 20
21 22	23 24
25 26	27 28
29 30	31 32
33 34	35 36
37 38	39 40
41 42	43 44
45 46	47 48
49 50	51 52
SLOT SIZE 1 2 3	
DIAMETER OF SCREEN (NEAREST INCH)	
56 60	

GRAVEL PACK	from to
IF WELL DRILLED WAS FLOWING WELL INSERT F IN BOX 68	

MDE USE ONLY (NOT TO BE FILLED IN BY DRILLER) T (E.R.O.S.) W Q	
70	72
TELESCOPE CASING	LOG INDICATOR
OTHER DATA	

PUMPING TEST		
HOURS PUMPED (nearest hour)	3	
PUMPING RATE (gal. per min.)	008.5	
METHOD USED TO MEASURE PUMPING RATE Bucket		
WATER LEVEL (distance from land surface)		
BEFORE PUMPING	61	
WHEN PUMPING	224	
TYPE OF PUMP USED (for test)		
A air	P piston	T turbine
C centrifugal	R rotary	O other (describe below)
J jet	S submersible	


PUMP INSTALLED	
DRILLER WILL INSTALL PUMP (CIRCLE) (YES or NO)	YES NO
IF DRILLER INSTALLS PUMP, THIS SECTION MUST BE COMPLETED FOR ALL WELLS.	
TYPE OF PUMP INSTALLED PLACE (A,C,J,P,R,S,T,O) IN BOX 29	
CAPACITY: GALLONS PER MINUTE (to nearest gallon)	
PUMP HORSE POWER	
PUMP COLUMN LENGTH (nearest ft.)	
CASING HEIGHT (circle appropriate box and enter casing height)	
+ above	LAND SURFACE
- below	2 (nearest foot)

LOCATION OF WELL ON LOT

SHOW PERMANENT STRUCTURE SUCH AS BUILDING, SEPTIC TANKS, AND/OR LANDMARKS AND INDICATE NOT LESS THAN TWO DISTANCES (MEASUREMENTS TO WELL)

Well 70' 75' 80'

Sobus Dr.

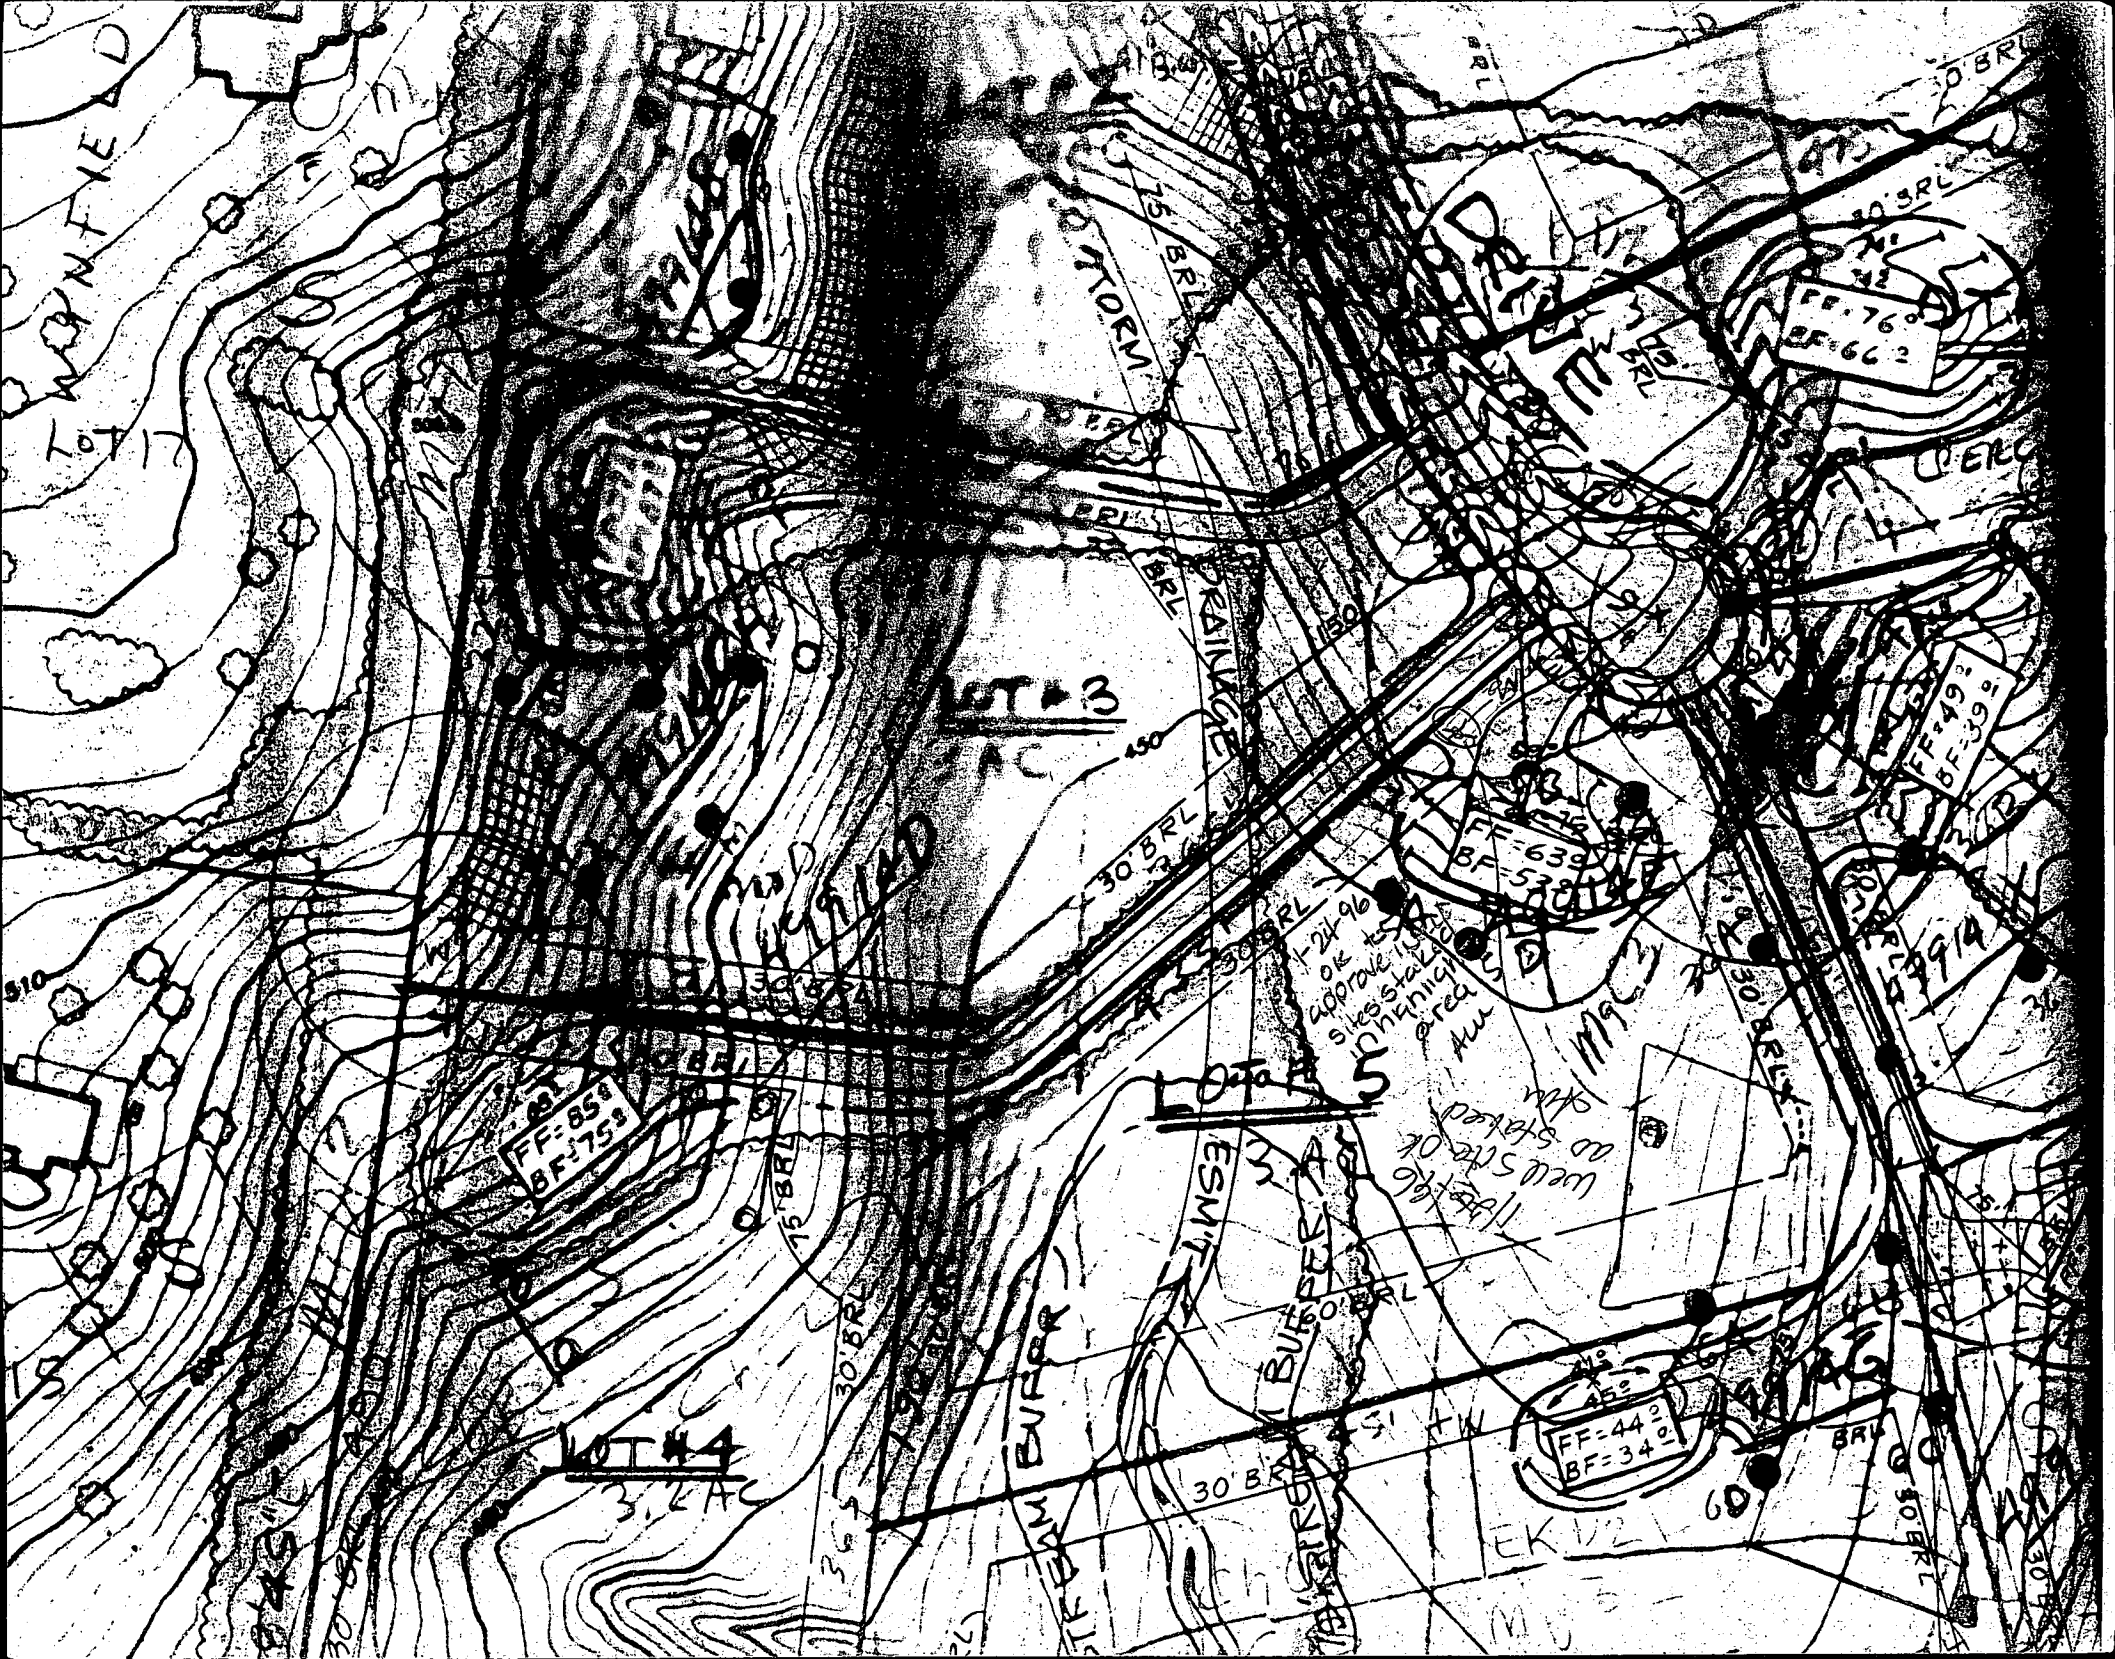

2/27/98
WPT OK
JH

HOWARD COUNTY HEALTH DEPARTMENT
Bureau of Environmental Health
3525-H Ellicott Mills Drive
Ellicott City, MD 21043
Fax 313-2643 313-2640

APPLICATION FOR PITLESS ADAPTER, WELL PUMP AND PRESSURE TANK INSTALLATION

New Installation ☒
Replacement ☐

Receipt \$
Date

2/27/98

Name of Installer ROBERT L. FREEZER CO. INC.

Telephone 410-781-4655

License Number 2122

Certified Well Pump Installer ☒ Well Driller ☐ Registered Plumber ☒

Name of Property Owner ALTIERI HOMES

Telephone 410-795-1405

Subdivision SOBULS FARMS Lot # 5

Well Tag # HC-93-0248

Site Address LOT 5 SOBULS DRIVE

Pump

1. Type

- a. Deep well jet ☐
b. Shallow well jet ☐
c. Submersible ☒

2. Make SPRINT

3. Model # SP4C02JL

4. Capacity 5 GPM

5. Pump exceeds well capacity Yes ☐ No ☒

6. If Yes, is low pressure cutoff switch installed? Yes ☐ No ☐

7. What methods are used to protect the pump and electrical wiring from vibrations? Torque arrestors ☐ Cable guards ☒ Other ☐

Motor

1. Horsepower 1/2
2. RPM 3450
3. Voltage ☐
a. 110 ☐
b. 220 ☒

Pitless Adapter

1. Make HARVEY
2. Model # 77-800
3. Depth 42"

Tank

CAPTIVE AIR-WAY-205
WATER TANK

1. Capacity 34 GALS.
2. Pressure relief valve? YES

Piping

1. Type PVC
2. Size 1"
3. NSF and/or BOCA Code approved YES
4. Depth of supply line 42"

Well data

1. Depth 260 ft.
2. Yield 8.5 GPM
3. Static water level ft.
4. Will water supply be disinfected by installer? YES


I understand that it is my responsibility to notify the Howard County Health Department when the installation is ready for inspection (otherwise this permit is null and void).

All information given above is true to the best of my knowledge.

Signature of Applicant: [Signature]

Date: 2/27/98

Note: A sticker indicating approval/status of the installation will be placed on the well casing at the time of the inspection.

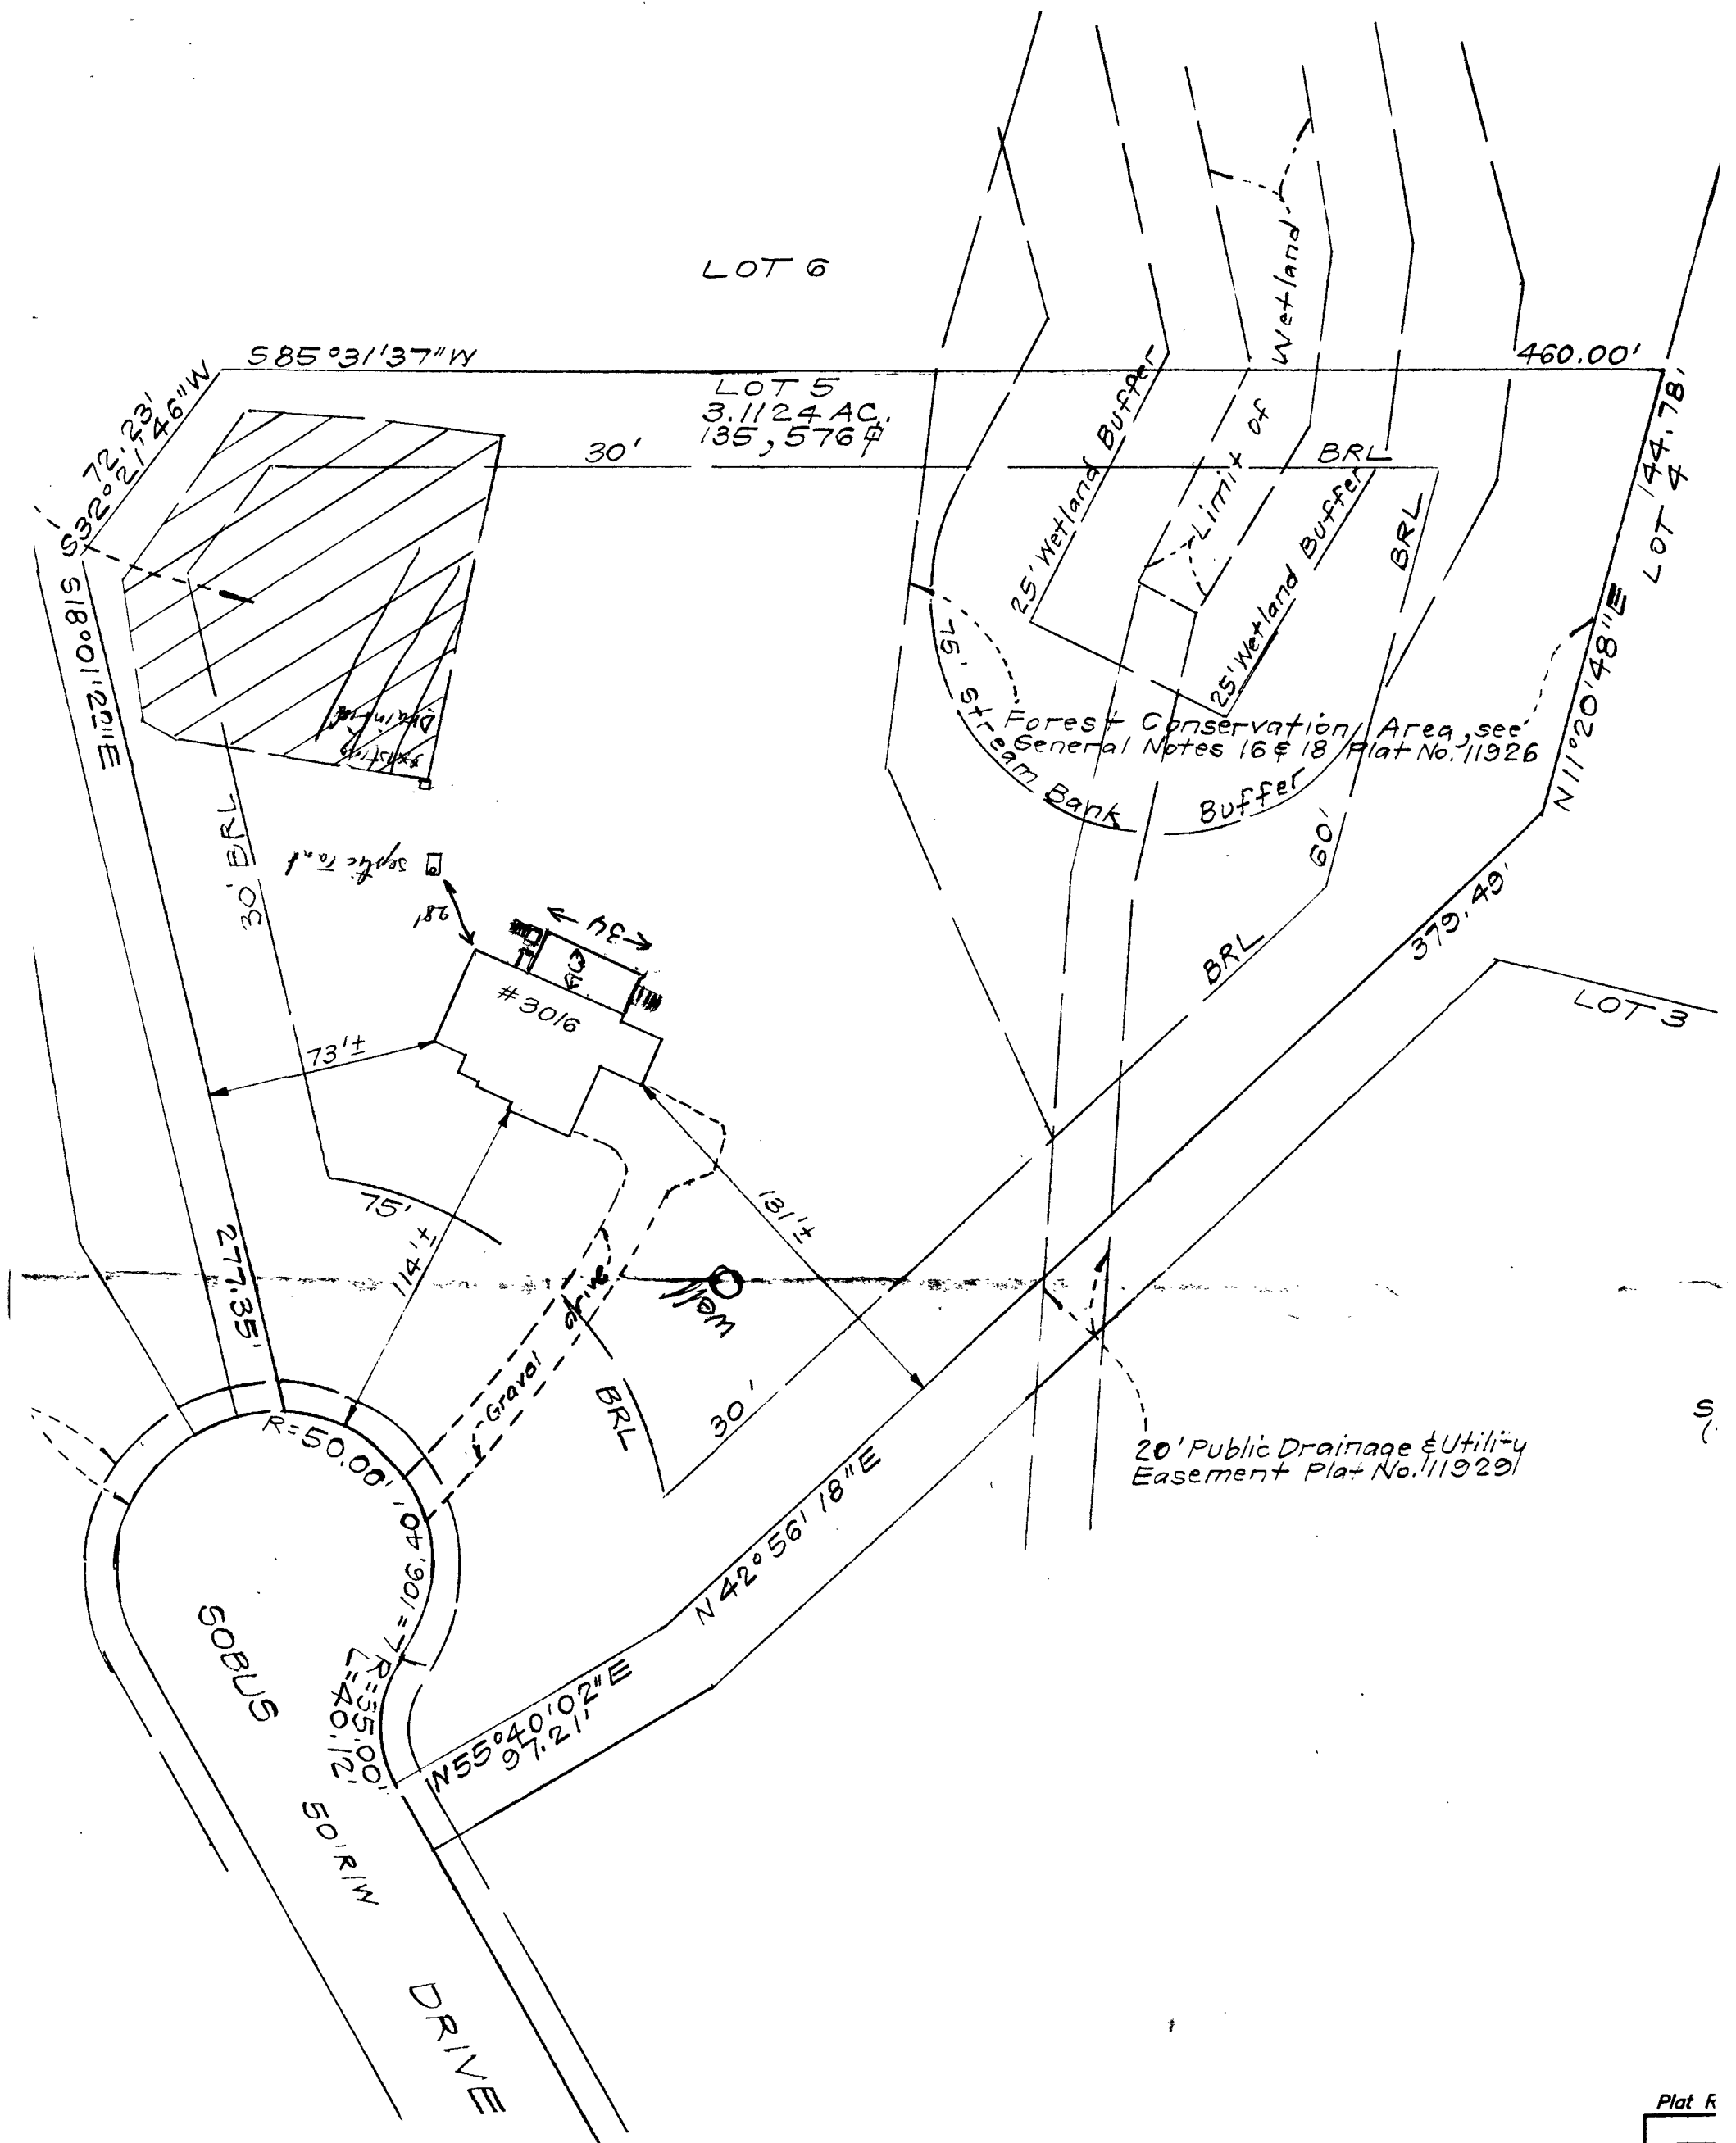

NOTES:

1. The ± setback distance accuracy = 1'

Plat R



71

DESIGN

DRAWN

KV

CHECK

P

DATE:

2



§ 3-108, The Real Property Article, Maryland, 1988 Replacement Volume, as far as they relate to the making of platting of markers, have been complied with.

SUBVEYOR
Allison C. Wade
ALLISON C. WADE

RECORDED:	
LOTS:	2
TO BE RECORDED:	2
TO BE RECORDED:	0
TO BE RECORDED:	0
TO BE RECORDED:	6.2146 AC.
TO BE RECORDED:	0
TO BE RECORDED:	0.00 AC.
TO BE RECORDED:	0.00 AC.
TO BE RECORDED:	6.2146 AC.
PRIVATE SEWERAGE SYSTEMS	
HEALTH DEPARTMENT	

F-99-114
HOUSE ON LOT 6
BUILT OVER THE
B.R.L. RESULTING
NECESSARY

SOBUS DRIVE
50' R/W PLAT NO. 11929

1. Subdivision
2. Cooperation of the project with the 15CA Station
3. 4" x 4"
4. O ind
5. All areas
6. B.R.L. den
7. Lots shown and lot area Health Regul
8. Driveways which of the Howard
9. Department of the Improvements of sewage is available connection to a private sewage easement shall not be necessary
10. For flag or pipestem maintenance are provided road right-of-way and
11. This plat is based on a formed on September 2
12. The Sobus Farms HOA Ar. State Department of Asse
13. The Forest Conserva

16. Developer reserves unto itself, its successors and assigns, all easements shown on this plat for storm drainage, other public utilities, and forest conservation, located in, over and through Lots 38 and 39 or portions thereof, and shown on this plat whether or not expressly stated in the easements herein. Developer shall execute and complete description of the County.