

PERMIT

SEWAGE DISPOSAL SYSTEM

DEPARTMENT OF HEALTH AND MENTAL HYGIENE

P 510134

A 49914V

DISTRICT _____

DATE 5/8/98

DATE SYSTEM APPROVED 7.22.98

INSPECTOR KM

HOWARD COUNTY HEALTH DEPARTMENT

BUREAU OF ENVIRONMENTAL HEALTH

XX 461-9933 X

313-2640

03-319822

South Carroll Backhoe, Inc.

IS PERMITTED TO INSTALL X ALTER _____

ADDRESS 4410 Salem Bottom Rd, Westminster, MD 21157 PHONE 410-875-4197

SUBDIVISION Sobus Farms LOT 15 ROAD 2900 Summer Hill Drive

PROPERTY OWNER Altieri Homes

ADDRESS _____

SEPTIC TANK CAPACITY 1000 GALLONS

(500 gal for seamed)

NUMBER OF BEDROOMS 3

180 SQUARE FEET PER BEDROOM

LINEAR FEET OF TRENCH REQUIRED 135

TRENCHES - Trench to be 2 feet wide. Inlet 4 feet below original grade. Bottom maximum depth 8 feet below original grade. Effective area begins at 4 feet below original grade. 4 feet of stone below distribution pipe.

LOCATION - Start the first trench 150 feet from the front lot line and 155 feet from Wynfield Road (Right Lot Line). Run trenches on contour to left side of lot.

NOTES - No trench to exceed 100 feet in length. Provide 6" - 8" diameter cleanout and cap to grade or above on septic tank. OK KM 2-25-97

PLANS APPROVED BY Amy McMillen

DATE 2/19/97

COVER NO WORK UNTIL INSPECTED AND APPROVED

NEITHER THE HOWARD COUNTY COUNCIL NOR THE HEALTH DEPARTMENT IS RESPONSIBLE FOR THE SUCCESSFUL OPERATION OF ANY SYSTEM

NOTE: CLEANOUT REQUIRED EVERY 70 FEET OF SEWER LINE AND/OR AT 90° SWEEPS IN LINES FROM HOUSE TO DRAIN FIELDS, 90° ELBOWS NOT ACCEPTABLE.

NOTE: ALL PARTS OF SEPTIC SYSTEMS (I.E. TANK, DISTRIBUTION BOX TRENCHES) TO BE 100 FEET FROM WELL (UNLESS OTHERWISE SPECIFICALLY AUTHORIZED)

NOTE: IF DEEP TRENCH(ES) ARE USED CALL FOR INSPECTION BEFORE AND AFTER PLACING GRAVEL IN TRENCH(ES)

NOTE: NO DRY WELL SHALL EXCEED 15 FOOT IN DIAMETER NO ABSORPTION TRENCH TO EXCEED 100 FEET IN LENGTH

NOTE: ALL PIPE FROM HOUSE TO SEPTIC TANK MUST BE CAST IRON OR SCHEDULE 35/40 PVC OR ABS


PERMIT VOID AFTER TWO YEARS

NOTE: INSTALL STAND PIPE ON SEPTIC TANK AND DRY WELL STAND PIPES MUST BE 6 INCHES IN DIAMETER CAST IRON. CONCRETE OR TERRA COTTA OR PVA OR ABS ACCEPTED. IF TOP OF SEPTIC TANK IS DEEPER THAN 3 FEET. MANHOLE TO GRADE REQUIRED.

NOTE: DISTRIBUTION BOXES MUST HAVE BAFFLES

***INSTALLER IS RESPONSIBLE FOR OBTAINING FINAL APPROVAL ON THIS PERMIT**

A 49914V

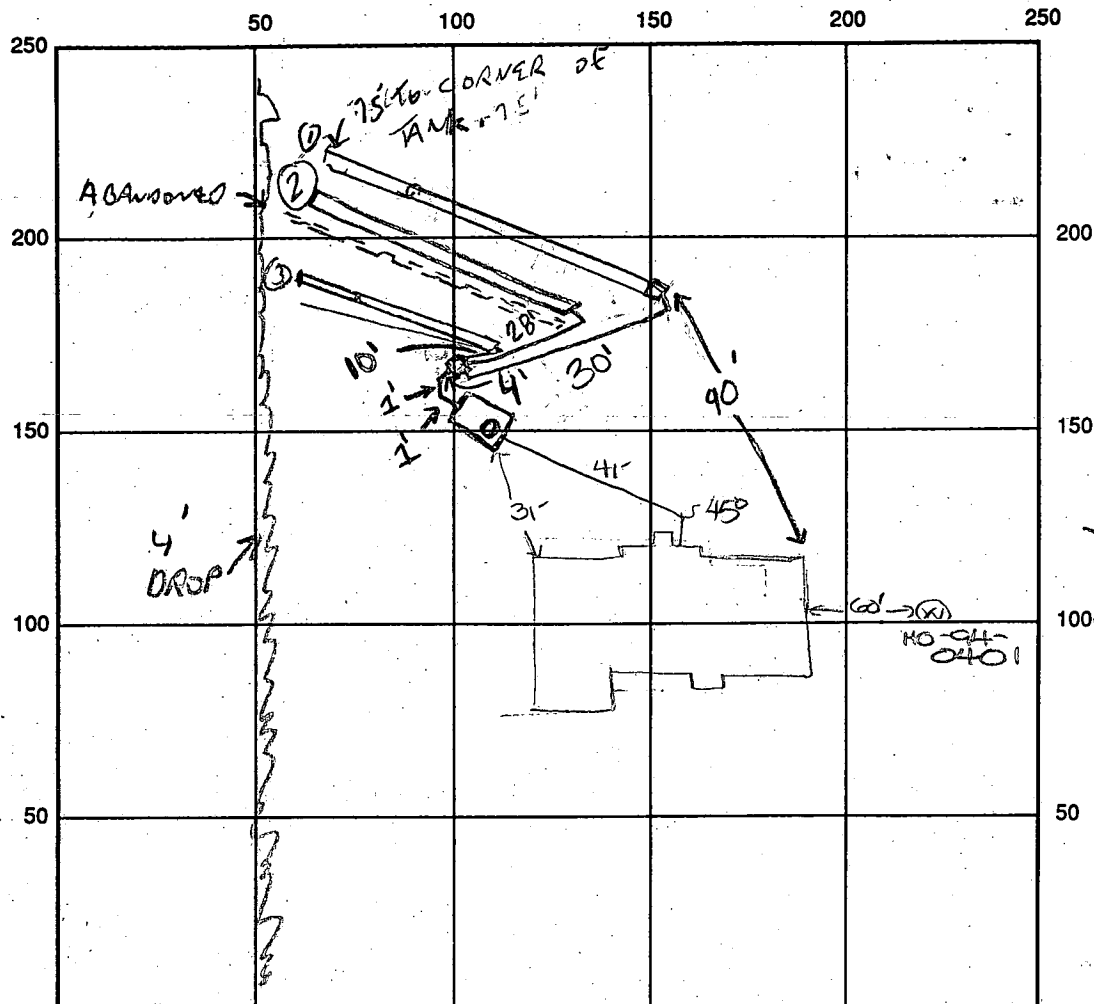

INDICATE NORTH - NAME ADJOINING ROADWAY AS BASE LINE

Summer Hill Drive

SEPTIC TANK LEVEL OK-1500 gal top sealed CLEANOUTS 1 on tank

DISTRIBUTION BOX LEVEL OK-NEEDS CEMENT ON OUTLETS

DRAIN FIELD/TITLE DEPTH 8 FT. TRENCH WIDTH 2 FT. INLET DEPTH 4 FT.

EFFECTIVE GRAVEL DEPTH 4 FT. TOTAL LENGTH $\frac{113}{37} \frac{4}{32} = 141$ FT.

NUMBER OF TRENCHES 3 ~~ONE~~ SIDEWALL BOTTOM AREA 564 SQ. FT.

DRYWALL INSIDE DIAMETER — FT. EFFECTIVE DEPTH BELOW INLET — FT.

ABSORBENT AREA — SQ. FT.

REMARKS: 7/20/98 OK to cover from house to septic tank -
OK to continue. (Due to presence of small
hill(?) along left portion of septic area, along property
line, slight modification in layout necessary) (OKS)

7.21.98 1st TRENCH OK TO START, CONTINUE - LEAVE ENDS OPEN. 7/21 2nd TRENCH
ABANDONED DUE TO SHALLOW ROCK, NEED TO SEE DIST BOX + TRENCH CONNECTIONS AT TRENCH

DATE SYSTEM APPROVED 7.22.98 INSPECTOR Jim Miste
FOR FINAL, #

APPLICATION

HOWARD COUNTY

SERIAL NUMBER

PERMIT APPLICATION

DEPARTMENT OF INSPECTIONS, LICENSES & PERMIT
3430 COURT HOUSE DRIVE, ELLICOTT CITY, MARYLAND 21043

B0018902

BUILDING ADDRESS (HOUSE NO., STREET, TOWN OR AREA)

2900 Summer Hill Drive
West Friendship, MD. 21094

28113

GRADING/SEDIMENT CONTROL ☐ YES ☐ NO45.44
SDP #

DESCRIPTION OF WORK AUTHORIZED

Erecting Sales Trailer for 1 yr.
w/ Deck + Handicap ramp
12' x 60'

LOT NO. PARCEL NO. SEC. AREA BLOCK NO. LIBER FOLIO

15

26

-

-

24

-

-

SUB DIVISION ZONE ZONE MAP ELEC. DIST. CENSUS TR.

Sobus Farms

PR-10

15

3

6030

OWNER NAME AND ADDRESS

PHONE NO.

Altieri Homes
9017 Red Branch Rd, Suite 901
Columbia MD. 21045

410-715-4500

OCCUPANT'S NAME AND ADDRESS

PHONE NO.

Altieri Homes
9017 Red Branch Rd
Columbia MD. 21045

410-715-4500

ARCHITECT OR ENGINEER'S NAME AND ADDRESS

PHONE NO.

Clark, Fineback & Suckett
7135 Minstrel Way
Columbia MD. 21045

410-351-7500

CONTRACTOR'S NAME AND ADDRESS

PHONE NO.

Altieri Homes
9017 Red Branch Rd
Columbia, MD. 21045

410-715-4500

EXISTING USE

PROPOSED USE

Vacant lot

Sales Construction Trailer

EST. CONSTRUCTION COST

LICENSE NUMBER

PERMIT FEE

70,000

W/S CODE

FOR OFFICE USE ONLY

Daren Altieri

DISTANCE IN FEET FROM R/W LINE TO FRONT BUILDING LINE

SIDE YARD

(DISTANCE IN FEET FROM SIDE BLDG. LINE TO SIDE PROPERTY LINE)

TO SIDE BUILDING LINE

DISTANCE IN FEET, REAR YD. REQUIRING SET

BACK (CORNER LOT ONLY)

SDP #

Check payable to: DIRECTOR OF FINANCE OF HOWARD COUNTY

CAUTION

To begin construction before a permit placard has been issued
and displayed on the job is a violation of the law.Use and occupancy permit must be applied for two weeks
before it will be issued.

IMPORTANT: PLEASE SHOW ZIP CODES AND AREA CODES WHEREVER REQUIRED

LP-69-591


19808


Distribution of Copies:
White - Building Official
Green - Planning & ZoningYellow - Engineering
Pink - Health Dept.
Gold - S.H.A.

APPROVED

DATE

CA

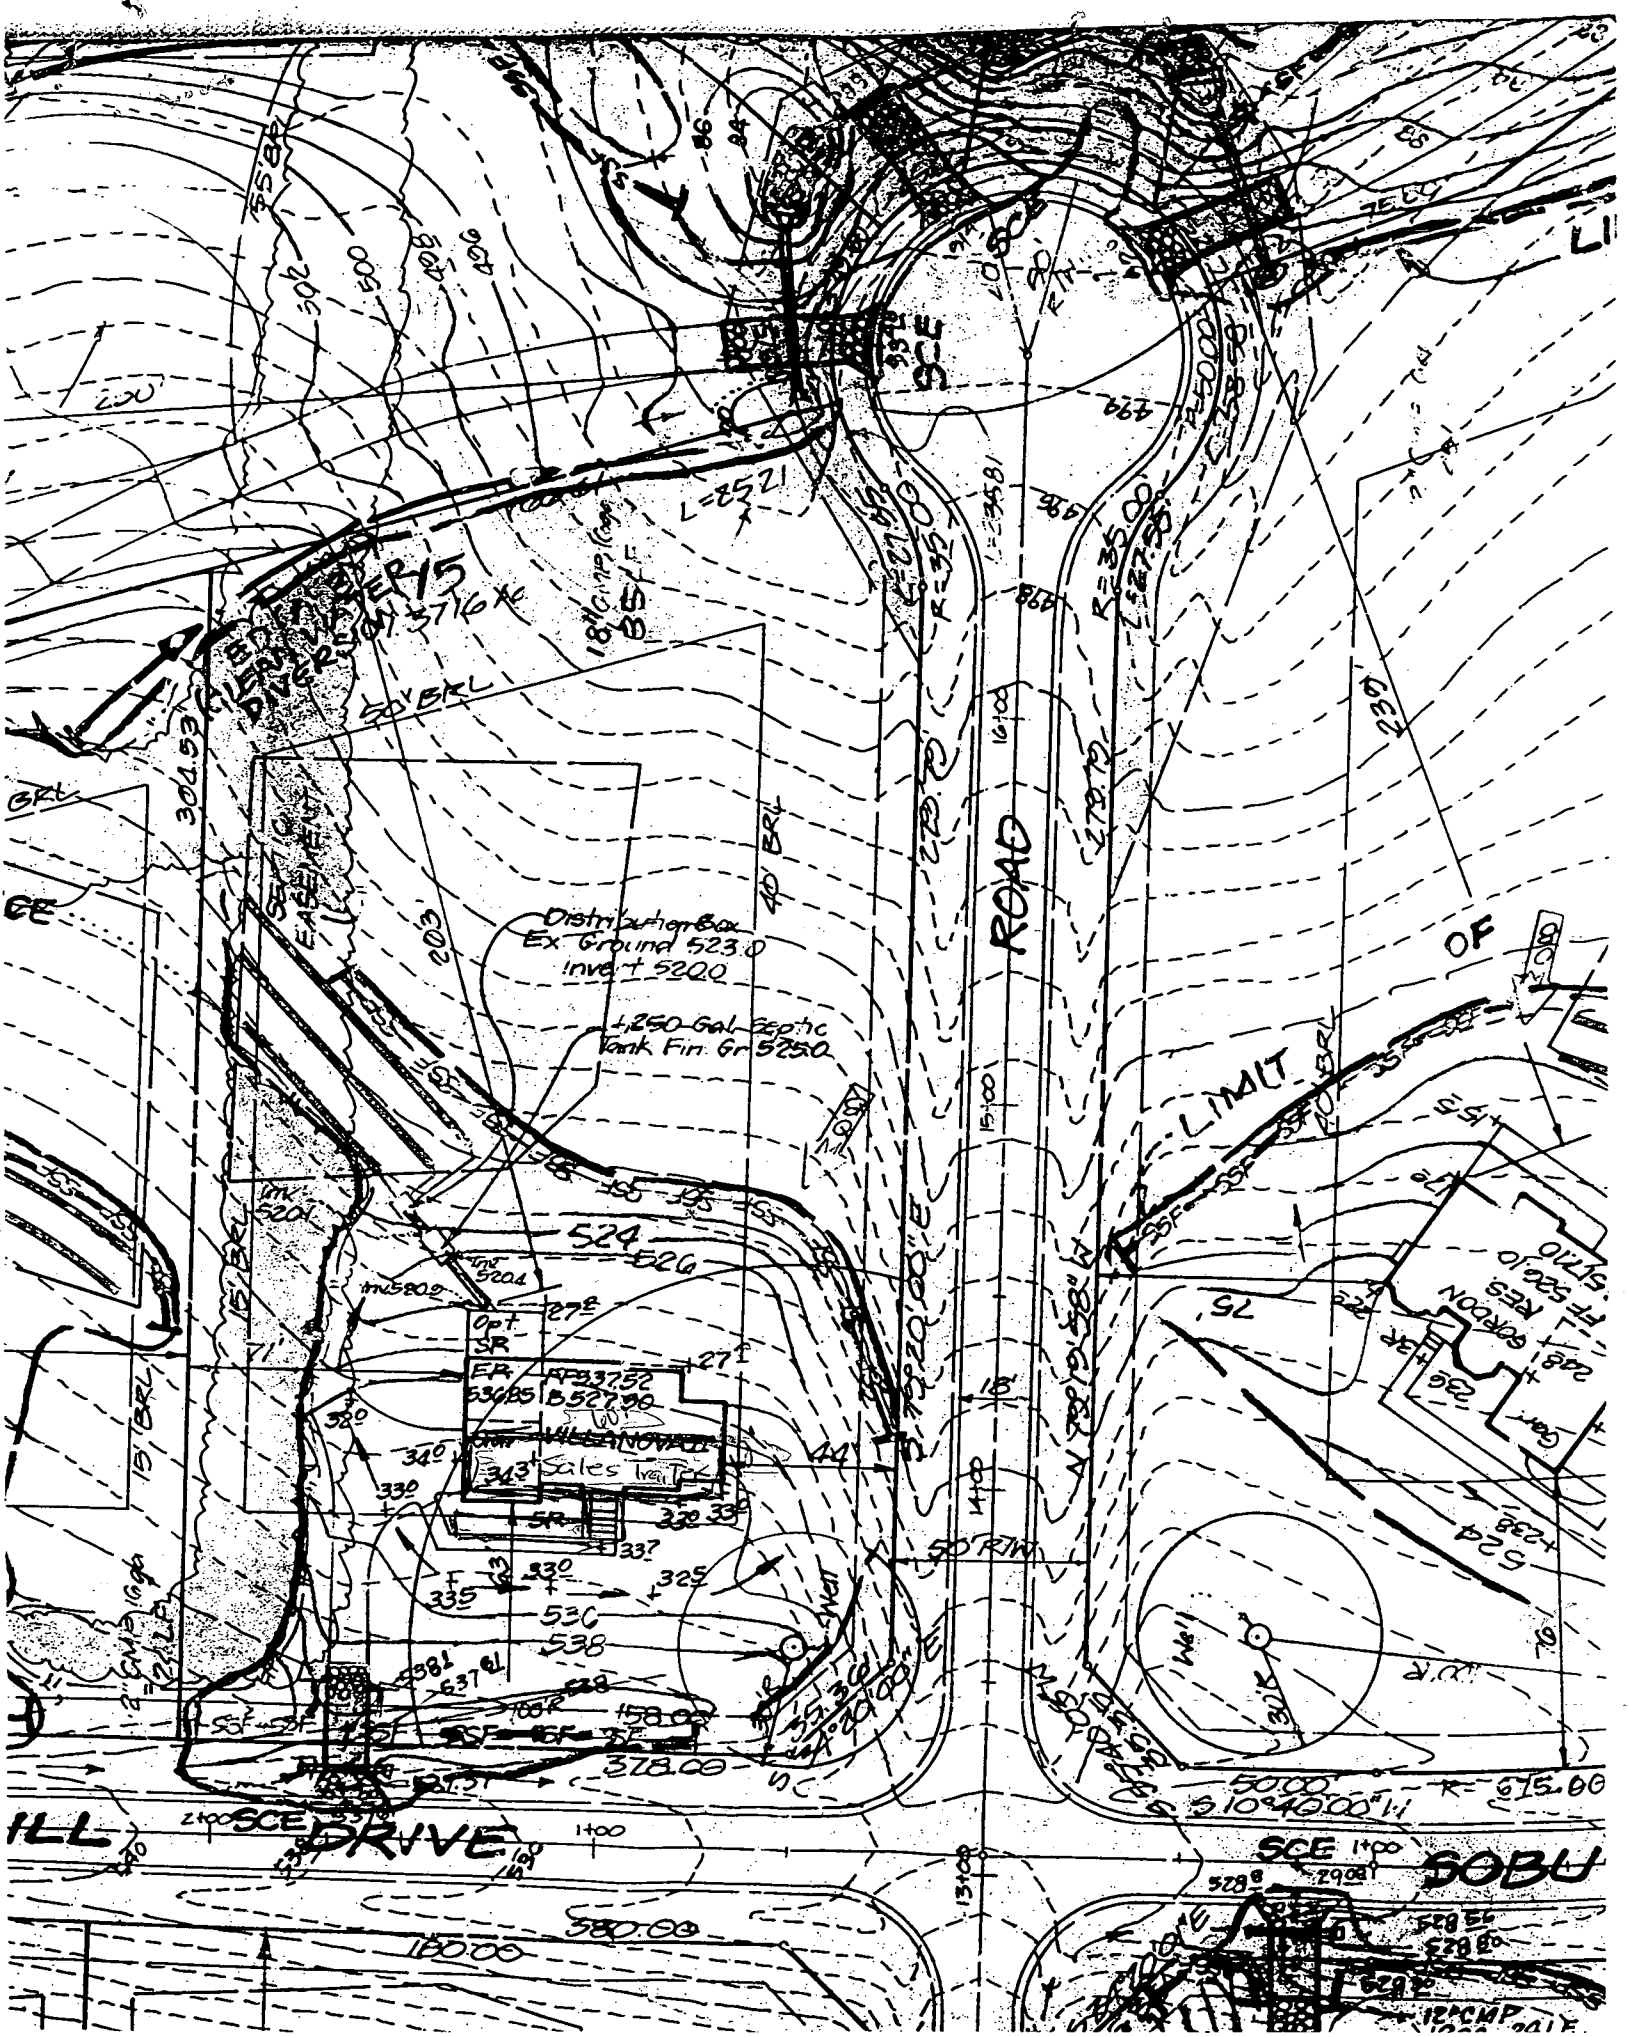

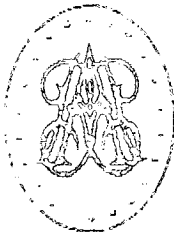

ALTIERI HOMES

A Division of Altier Enterprises
Custom Home Builders

B00108902

11/26/97

T.C. W/ DAREN ALTIERI,
HOLD BP FOR LETTER
DESCRIBING HOW SEPTIC
FACILITIES FOR SALES TRUCK
ARE TO BE HANDLED.

Memorandum

To: Glen Savage
From: Daren B. Altieri, President
Date: November 26, 1997
Subject: Lot 15, Sobus Farms
Trailer Permit #B00108902

GS

This letter will confirm that we will be providing a portable toilet on the inside of the trailer at Lot 15, Sobus Farms. We will not be hooking up to the septic system.

If any additional information is needed, please do not hesitate to contact me.

Daren B. Altieri

12/3/97 9:00 spoke to Phil Henderson - no further issue to resolve - OK to proceed. (DKS)

12/1/97 11:49 a.m. Observed proposed trailer already in place - Sobus Farms, Lot 15. I called Enforcement (x1804) - Bonnie will check on permit and let us know. (DKS)

8/24/98
anytime

Ellicott City, MD 21043

Fax 313-2648 313-2640

APPLICATION FOR PITLESS ADAPTER, WELL PUMP AND PRESSURE TANK INSTALLATION

New Installation ☒

Replacement ☐

Receipt \$

Date

8/21/98

Name of Installer

ROBERT L. FREEZER CO. INC.

Telephone

410-781-4655

License Number

2122

Certified Well Pump Installer ☒

Well Driller ☐

Registered Plumber ☒

Name of Property Owner

ALTIERI HOMES

Telephone

410-795-1405

Subdivision

SOBUS FARMS

Lot # 15

Well Tag #

HO-94-0401

Site Address

SUMMER HILL DRIVE

Pump

1. Type

a. Deep well jet

b. Shallow well jet

c. Submersible ☒

2. Make

RED JACKET

3. Model #

75CSNO2

4. Capacity

5 GPM

5. Pump exceeds well capacity

Yes

No ☒

6. If Yes, is low pressure cutoff switch installed? Yes

No ☒

7. What methods are used to protect the pump and electrical wiring from

vibrations? Torque arrestors

Cable guards

Other NONE

Motor

1. Horsepower

3/4

2. RPM

3450

3. Voltage

a. 110

b. 220 ☒

Pitless Adapter

1. Make

HARVARD

2. Model #

71800

3. Depth

42'

Tank

1. Capacity

36 GALS

2. Pressure relief

valve? YES

Piping

1. Type

Poly.

2. Size

1"

3. NSF and/or BOCA

Code approved YES

4. Depth of supply

line 42"

Well data

1. Depth

345 ft.

2. Yield

4 GPM

3. Static water

level 22 ft.

4. Will water supply

be disinfected by

installer? YES

I understand that it is my responsibility to notify the Howard County Health Department when the installation is ready for inspection (otherwise this permit is null and void).


All information given above is true to the best of my knowledge

Signature of Applicant

Robert L. Freezer
8/21/98

Date:

Note: A sticker indicating approval/status of the installation will be placed on the well casing at the time of the inspection.

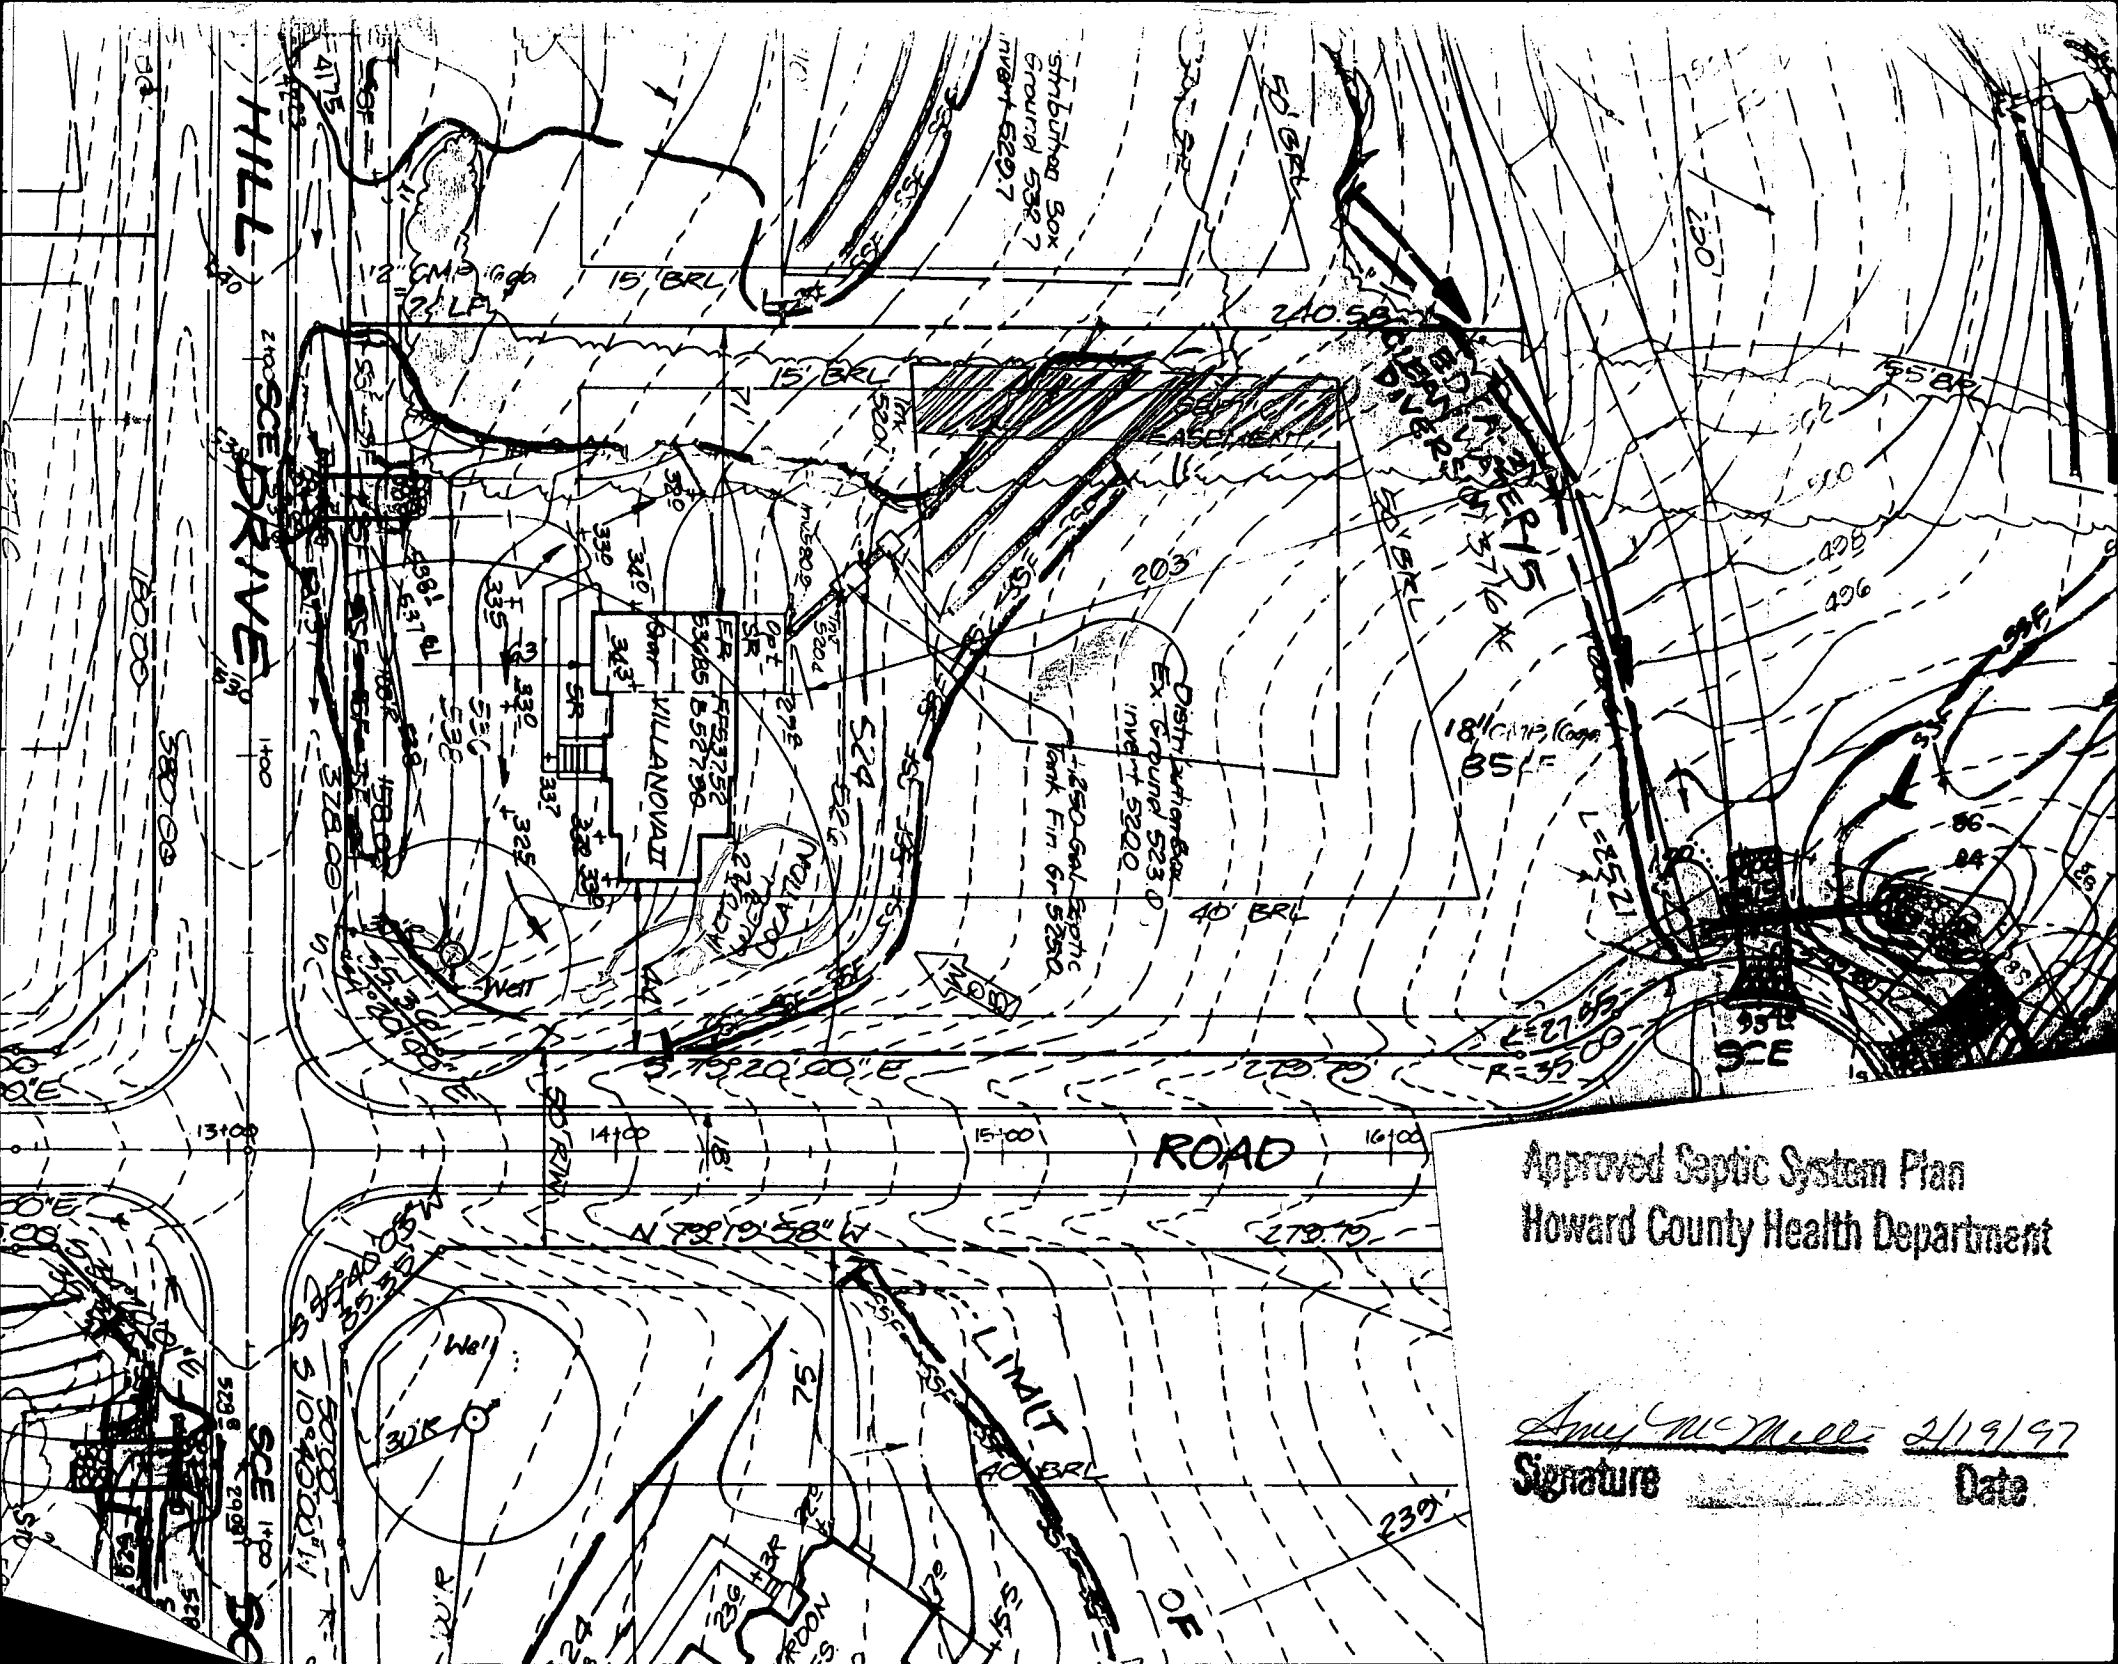

Approved Septic System Plan
Howard County Health Department

Amy McMillen 2/19/97
Signature Date

APPLICATION

PERCOLATION TESTING

A 49914V

P _____

HOWARD COUNTY HEALTH DEPARTMENT

BUREAU OF ENVIRONMENTAL HEALTH

3525-H ELLICOTT MILLS DRIVE/ELLICOTT CITY, MARYLAND 21043
TELEPHONE: 313-2640

DISTRICT 3

DATE 3/9/94

TO: THE COUNTY HEALTH OFFICER
ELLICOTT CITY, MARYLAND

I HEREBY APPLY FOR THE NECESSARY TEST PRIOR TO APPLICATION FOR PERMIT TO CONSTRUCT (OR RECONSTRUCT) A SEWAGE DISPOSAL SYSTEM.

PROPERTY OWNER Hilltop Development Corporation Alticki Homes

ADDRESS P.O. Box 208 Clarksville Md. 21029 PHONE 410-531-5539

AGENT OR PROSPECTIVE BUYER Richard Demmitt

ADDRESS P.O. Box 208 Clarksville Md. 21029 PHONE 410-531-5539

PROPERTY LOCATION:

SUBDIVISION Sabus Farms LOT NO. 15 (Fourteen)

ROAD AND DESCRIPTION at the end of Winfield Rd.

(2900 Summer Hill Drive)

TAX MAP 15 PARCEL # 26 & 154

SIZE OF LOT 1 acre + TYPE BLDG. _____

BLDG PERMIT SIGNED

AND RETURNED 2/19/97

Serial # 201103987

S.F.D. - 3 Bm

(SINGLE FAMILY DWELLING OR COMMERCIAL)

THE SYSTEM INSTALLED UNDER THIS APPLICATION IS ACCEPTABLE ONLY UNTIL PUBLIC FACILITIES BECOME AVAILABLE. I FULLY UNDERSTAND THE

FEE CONNECTED WITH THE FILING OF THIS PERC TEST APPLICATION IS NON-REFUNDABLE UNDER ANY CIRCUMSTANCES. I ALSO AGREE TO

COMPLY WITH ALL M.O.S.H.A. REQUIREMENTS IN TESTING THIS LOT. _____

(SIGNATURE OF APPLICANT)

APPROVED BY _____ FOR _____ DATE _____

DISAPPROVED BY _____ FOR _____ DATE _____

HOLD PENDING FURTHER TESTS _____

REASONS FOR REJECTION OR HOLDING _____

PERCOLATION TEST PLAT/PRELIMINARY PLAT - TITLE OR I.D. # _____ DATE _____

SITE DEVELOPMENT PLAN/FINAL PLAT - TITLE OR I.D. # _____ DATE _____

BLDG. PERMIT SIGNED

AND RETURNED 12-3-97

Serial # 201108902

Curt Sales Truck

THIS IS NOT A PERMIT

A49914V

COUNTY #

SOIL PROFILE

A-D

0' bright red SCL

4' tan/brn SL
mica chunks <5%
~~some~~ few large rock frags OK

12'

C-B

brn SCL

4' dkr brn SL
20% shale frags


12 1/2'

B

brn SCL

3' dkr brn SL
15%

12'

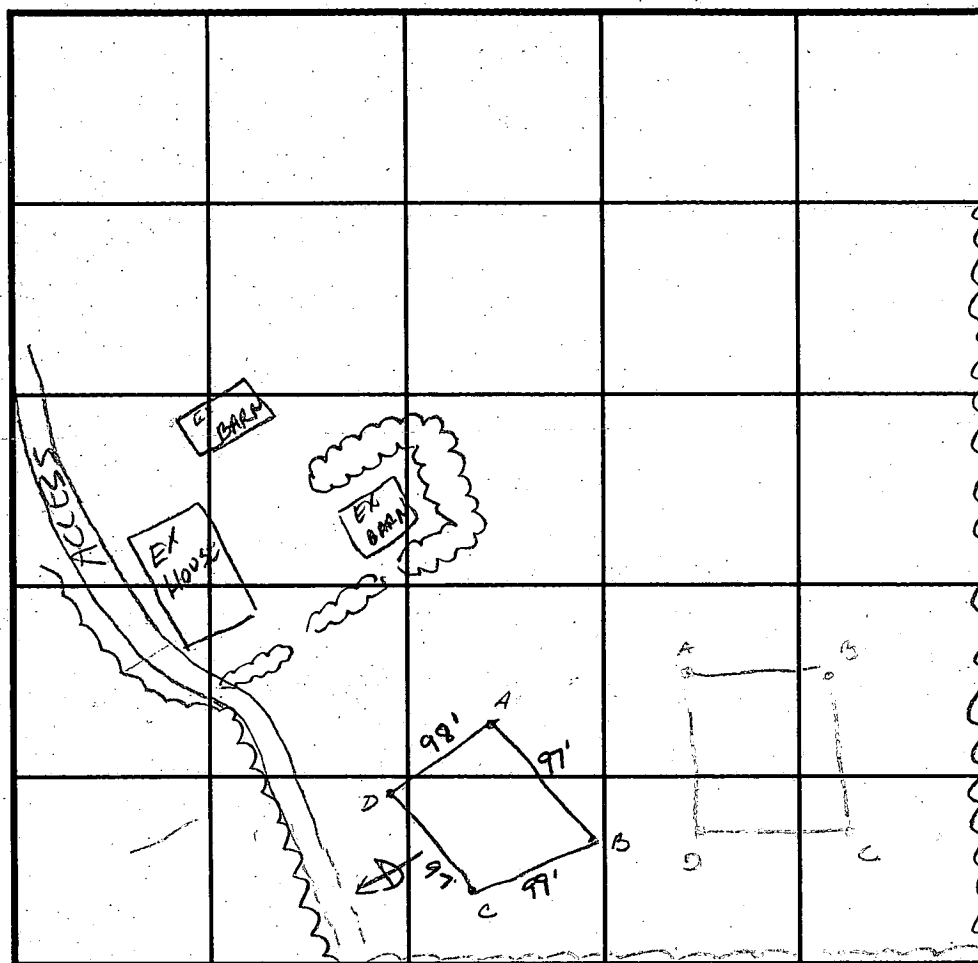

INDICATE NORTH - NAME ADJOINING ROADWAY AS BASE LINE.

SOIL PROFILE

0'

DATE	TEST NO.	DEPTH	PRE-WET		TEST - 1" DROP		TIME
			START	STOP	START	STOP	
2/23/94	2/2A	6' V12'	1:29 ³⁰	1:30	1:30	1:31	1min
	A	3' V12'	1:30	1:30 ¹⁰	1:30 ¹⁰	1:30 ²⁵	15sec
	A	repour	1:32 ¹⁵	1:33 ⁴⁵	1:33 ⁴⁵	1:36 ¹⁵	2 1/2min
	D	3' V11 1/2'	1:42 ³⁰	1:43	1:43	1:43 ⁴⁵	45sec
	D	6 1/2' V11 1/2'	1:42	1:43	1:43	1:44	1min
	C	3 1/2' V12 1/2'	1:45 ⁴⁵	1:30	min	—	F
	B	4' V12	1:47 ¹⁵	1:48 ³⁰	1:48 ³⁰	1:50	1 1/2min
	C	4 1/2' V12 1/2'	3:16 ³⁰	3:19 ³⁰	3:19 ³⁰	3:24	4 1/2min

REMARKS need to show existing well's depth on existing house

TYPE OF SOIL ChD₂ Chester silt loam

TESTED BY A McMillen / m Rifkin ALSO PRESENT R. DeWitt

TRENCH DESIGN DATA: AVERAGE PERCOLATION TIME 2min TRENCH WIDTH 2'

INLET DEPTH 4' MAXIMUM BOTTOM DEPTH 8' SQ. FT./BEDROOM 180 ft²

CLUSTER DEV.

SHEET 2

COPY OF SIGNED PERC CERT 5/94-33

LOT #17

LOT #6

LOT #15

LOT #14

49914E

49914W

49914V (PERC 14)

49914T

49914S

DRIVE

DITCH

3.0 AC.

TO BE REMOVED


TO REMAIN

HOUSE

SECRET 2

DATE _____

DEVELOP

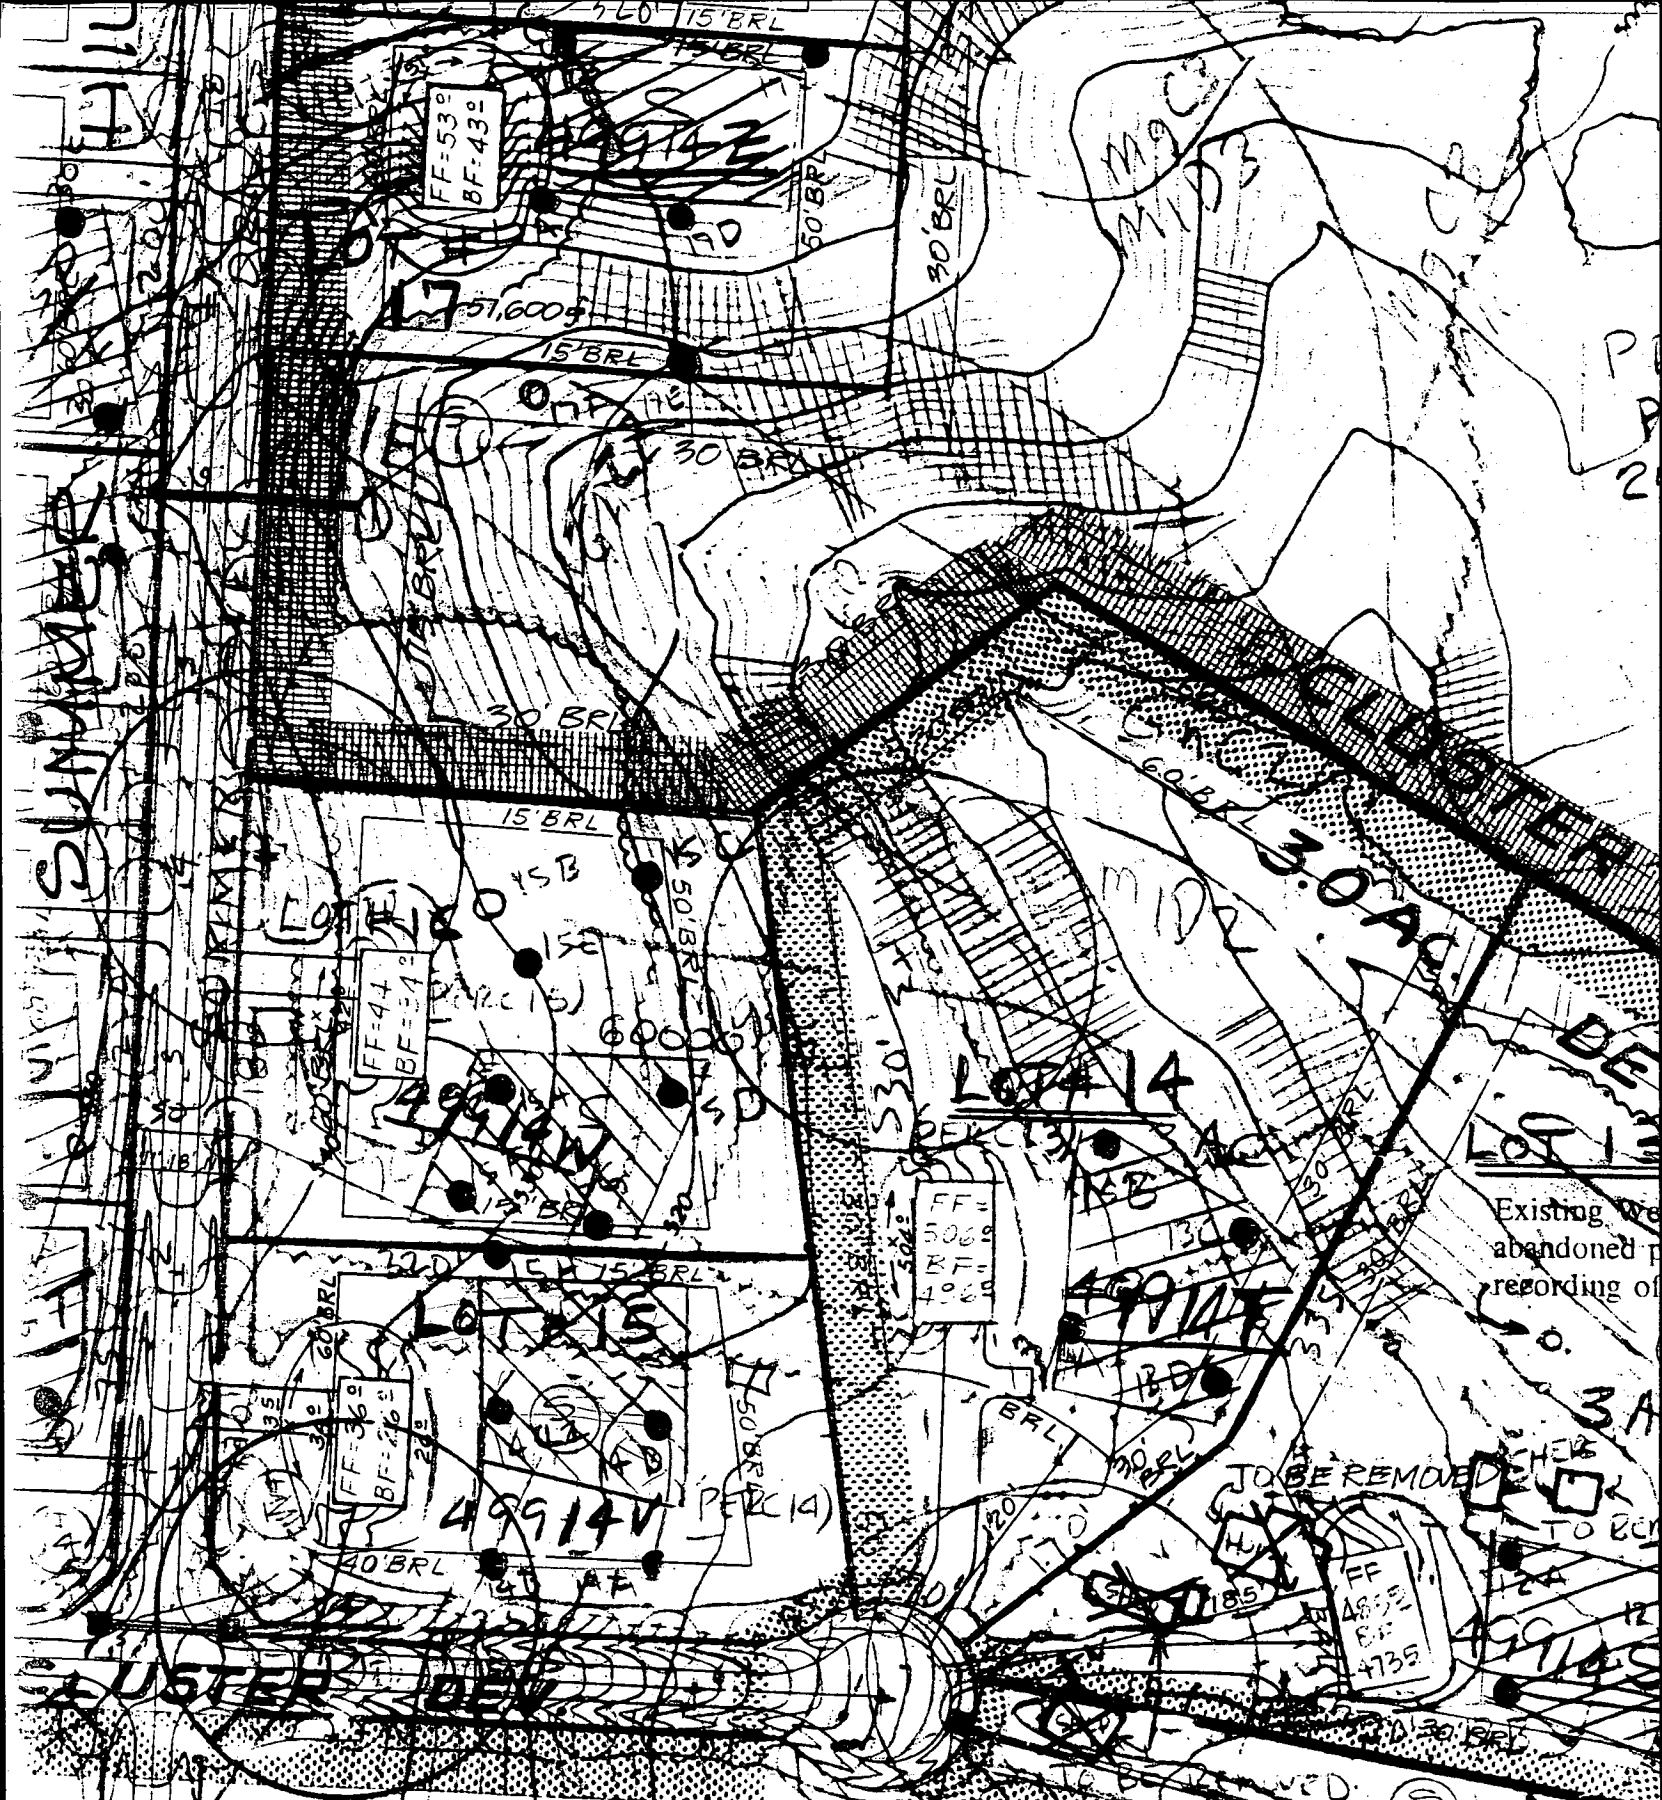

SHEET 2 ROAD


COPY P-95-15 DATE

6-6-95
6-6-95



DEVELOPMENT
CONSULTANTS

1582

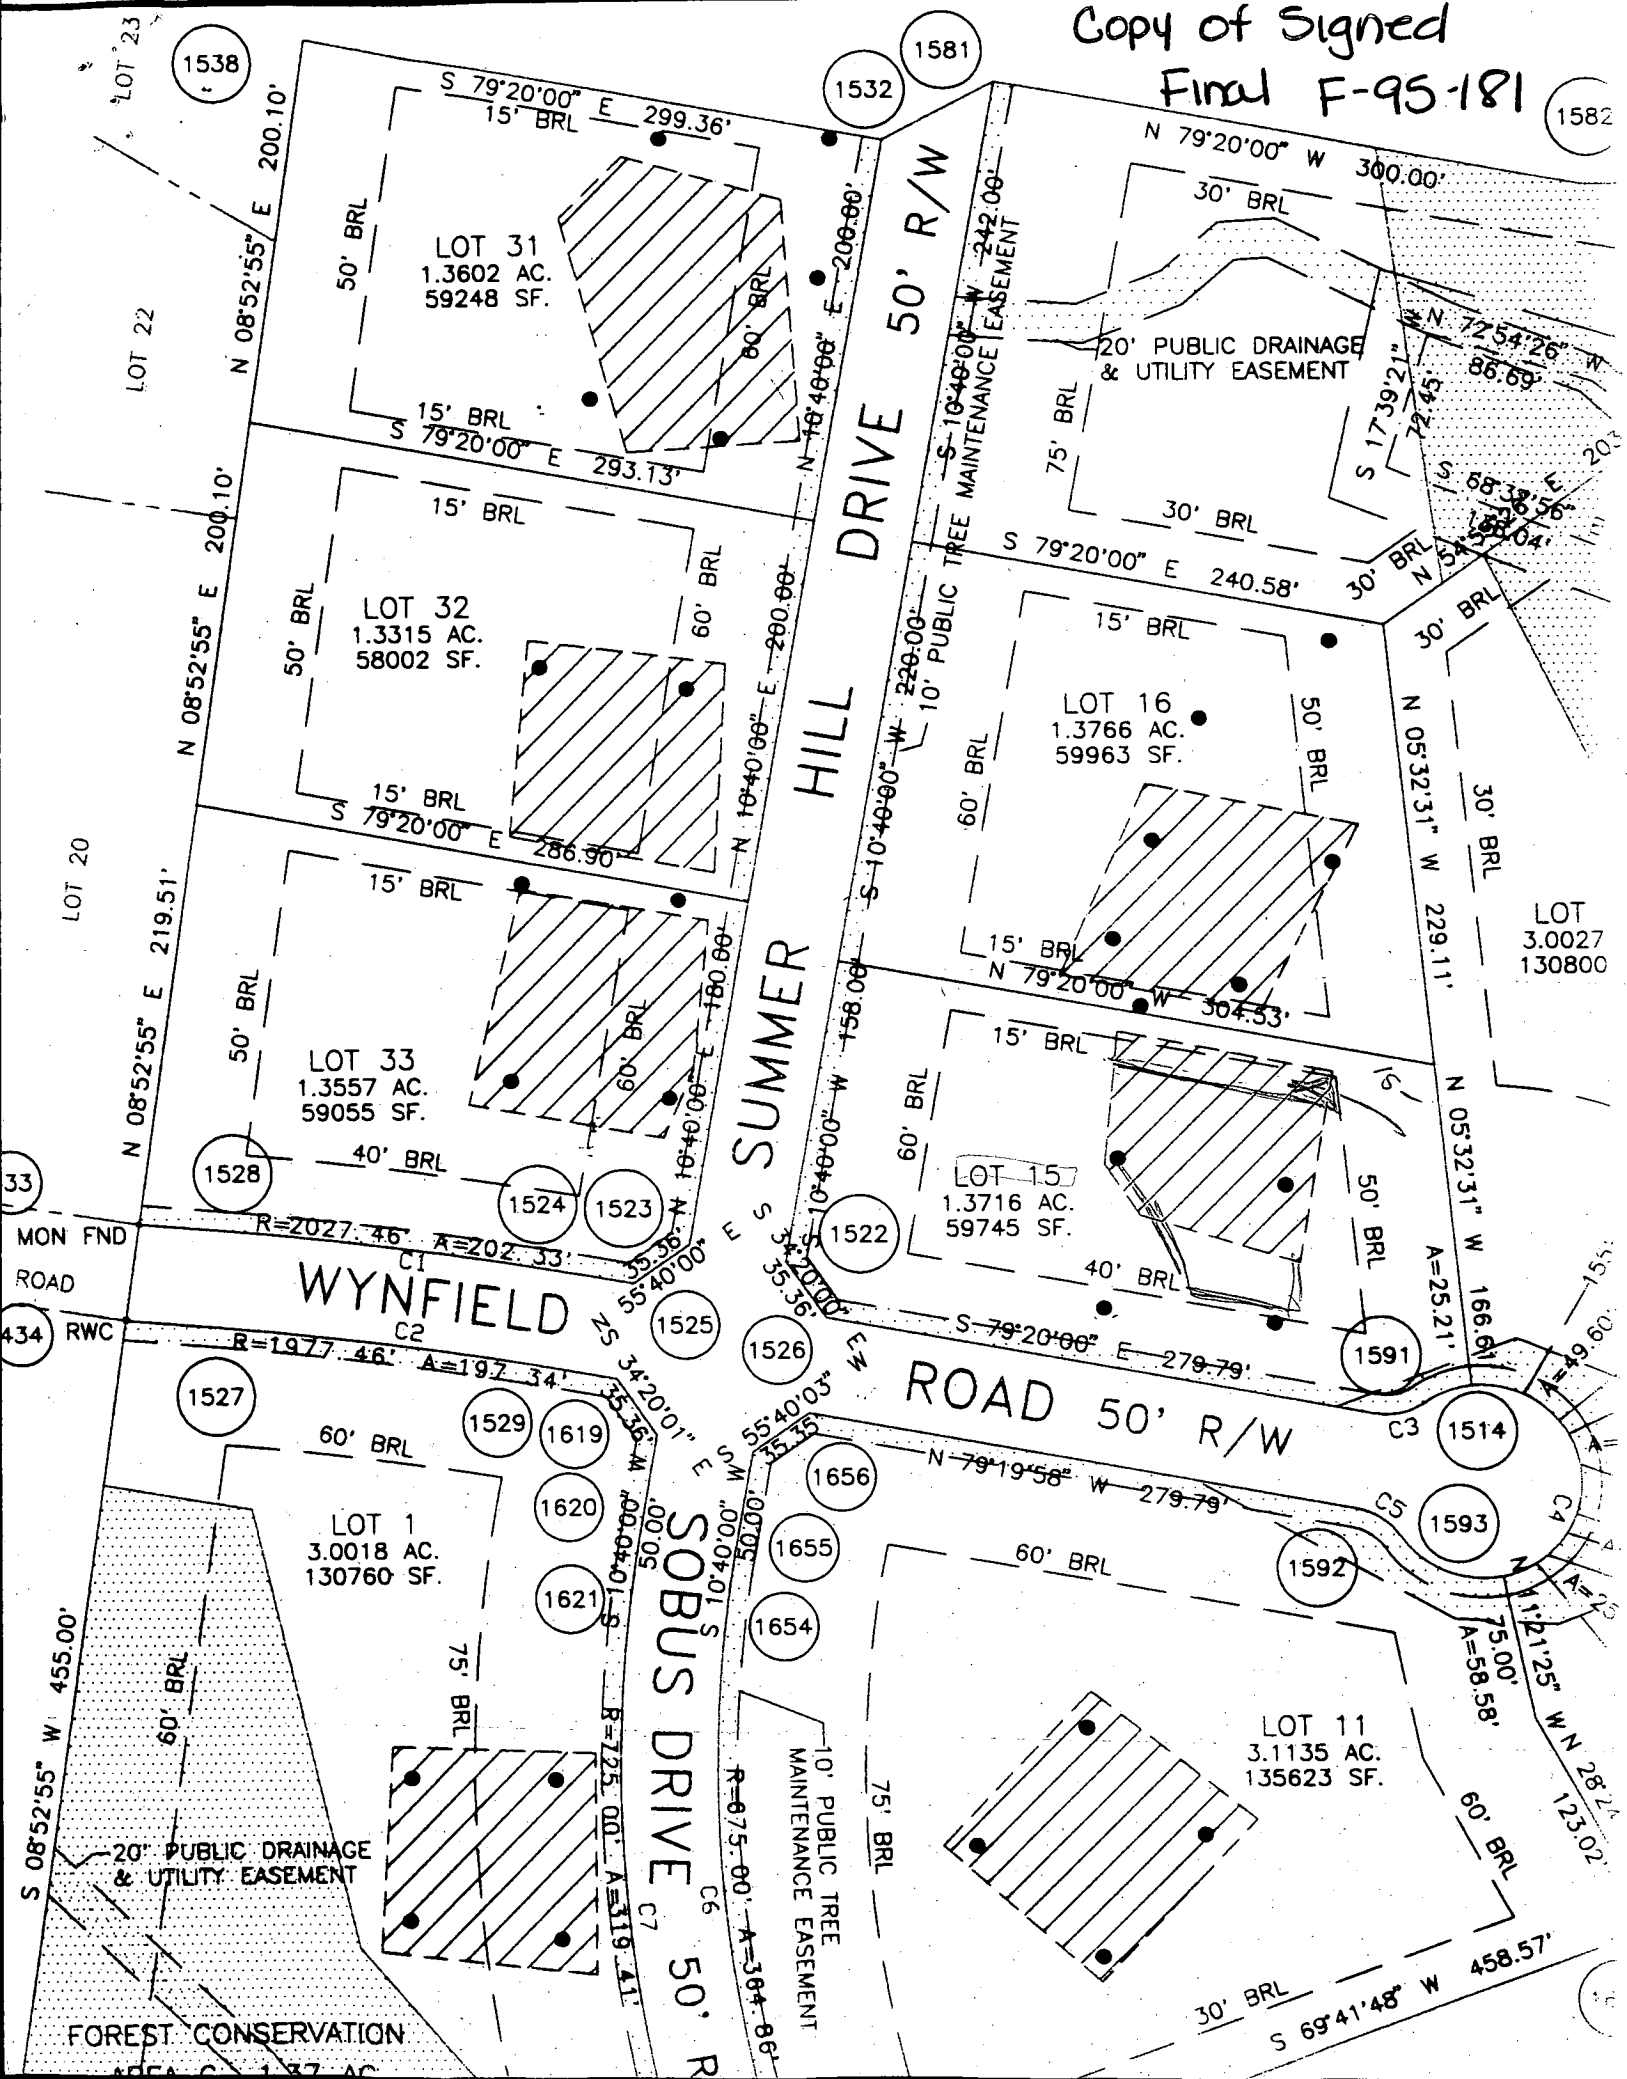

C1 8199 SEQUENCE NO. (DENV USE ONLY)
(THIS NUMBER IS TO BE PUNCHED IN C.O.S. 3-6 ON ALL CARDS)

STATE OF MARYLAND
WELL COMPLETION REPORT
FILL IN THIS FORM COMPLETELY
PLEASE PRINT OR TYPE

THIS REPORT MUST BE SUBMITTED WITHIN 45 DAYS AFTER WELL IS COMPLETED.
COUNTY NUMBER A 49914 V

ST/CO USE ONLY DATE Received: DATE WELL COMPLETED 041095 Depth of Well 345 (TO NEAREST FOOT) PERMIT NO. FROM "PERMIT TO DRILL WELL" HO-94-0491

OWNER Demmitt last name SUMMER HILLS DR first name RICHARD TOWN M. FRIENDSHIP SUBDIVISION 50645 FARMS SECTION LOT 15

WELL LOG Not required for driven wells
STATE THE KIND OF FORMATIONS PENETRATED, THEIR COLOR, DEPTH, THICKNESS AND IF WATER BEARING
DESCRIPTION (Use additional sheets if needed) FEET FROM TO Check if water bearing
SAND Stone 0 31
GRAY Micr Rock 31 345
3 Dry Wells 560, 480, 100' filled in with cement & drilling materials

GROUTING RECORD
WELL HAS BEEN GROUTED (Circle Appropriate Box) YES Y NO N
TYPE OF GROUTING MATERIAL CEMENT CM BENTONITE CLAY BC
NO. OF BAGS 9 NO. OF POUNDS 846
GALLONS OF WATER 54
DEPTH OF GROUT SEAL (to nearest foot) from 0 ft. to 31 ft.
CASING RECORD
casing types insert appropriate code below
ST CO STEEL CONCRETE
PL OT PLASTIC OTHER
MAIN CASING TYPE Nominal diameter (nearest inch) Total depth of main casing (nearest foot)
PL 6 34

OTHER CASING (if used) diameter inch depth (feet) from to

SCREEN RECORD
screen type or open hole insert appropriate code below
ST BR HO STEEL BRASS OPEN HOLE
PL OT PLASTIC OTHER

DEPTH (nearest ft.)
H0 33 345
SLOT SIZE 1 2 3
DIAMETER OF SCREEN (NEAREST INCH)
from to

GRAVEL PACK IF WELL DRILLED WAS FLOWING WELL INSERT F IN BOX 68

OEP USE ONLY (NOT TO BE FILLED IN BY DRILLER)
T (E.R.O.S.) W Q
70 72 74 75 76
TELESCOPE CASING LOG INDICATOR OTHER DATA

PUMPING TEST
HOURS PUMPED (nearest hour) 3
PUMPING RATE (gal. per min. to nearest gal.) 4
METHOD USED TO MEASURE PUMPING RATE Bucket
WATER LEVEL (distance from land surface) BEFORE PUMPING 40 WHEN PUMPING 150
TYPE OF PUMP USED (for test) A air P piston T turbine C centrifugal R rotary O other (describe below) J jet S submersible

PUMP INSTALLED
DRILLER WILL INSTALL PUMP YES NO
IF DRILLER INSTALLS PUMP, THIS SECTION MUST BE COMPLETED FOR ALL WELLS EXCEPT HOME USE
TYPE OF PUMP INSTALLED
PLACE (A,C,J,P,R,S,T,O) IN BOX - SEE ABOVE:
CAPACITY: GALLONS PER MINUTE (to nearest gallon) 31 35
PUMP HORSE POWER 37 41
PUMP COLUMN LENGTH (nearest ft.) 43 47
CASING HEIGHT (circle appropriate box and enter casing height) (+) above (-) below LAND SURFACE 1 (nearest foot)

LOCATION OF WELL ON LOT
SHOW PERMANENT STRUCTURE SUCH AS BUILDING, SEPTIC TANKS, AND/OR LANDMARKS AND INDICATE NOT LESS THAN TWO DISTANCES (MEASUREMENTS TO WELL)

CIRCLE APPROPRIATE LETTER
A A WELL WAS ABANDONED AND SEALED WHEN THIS WELL WAS COMPLETED
E ELECTRIC LOG OBTAINED
P TEST WELL CONVERTED TO PRODUCTION WELL

I HEREBY CERTIFY THAT THIS WELL HAS BEEN CONSTRUCTED IN ACCORDANCE WITH COMAR 26.04.04 "WELL CONSTRUCTION" AND IN CONFORMANCE WITH ALL CONDITIONS STATED IN THE ABOVE CAPTIONED PERMIT, AND THAT THE INFORMATION PRESENTED HEREIN IS ACCURATE AND COMPLETE TO THE BEST OF MY KNOWLEDGE.

DRILLERS IDENT. NO. 24
DRILLERS SIGNATURE (MUST MATCH SIGNATURE ON APPLICATION)

SITE SUPERVISOR (sign. of driller or journeyman responsible for sitework if different from permittee)

See Attached Locations

[illegible]

00000 300'

LOT # 31

LOT # 32

60000 32E 72'

LOT # 33

60000 278'

LOT # 14

3.0 AC

LOT # 15

3.0 AC

LOT # 16

3.0 AC

CLUSTER DEV.

SEE SHEET 2

EXISTING WELL TO BE AB PRI RT

TO REMAIN

TO BE REMOVED

[illegible]

00000 300'

LOT # 31

LOT # 32

60000 32E 7E

499155

300'

LOT # 33

60000 278

LOT # 14

3.0 AC

LOT # 15

3.0 AC

LOT # 16

3.0 AC

CLUSTER DEV.

DRY MEADOW

GOODWELL

TO BE REMOVED

SEE SHEET 2

YAKUB 2

LOT #31

LOT #32 60000 499155

LOT #33 60000 278

LOT #14 3.0 AC 49914

LOT #15 3.0 AC 49915


LOT #16 3.0 AC 49916

CLUSTER DEV.

DRY WOOD

TO BE REMOVED

SEE SHEET 2

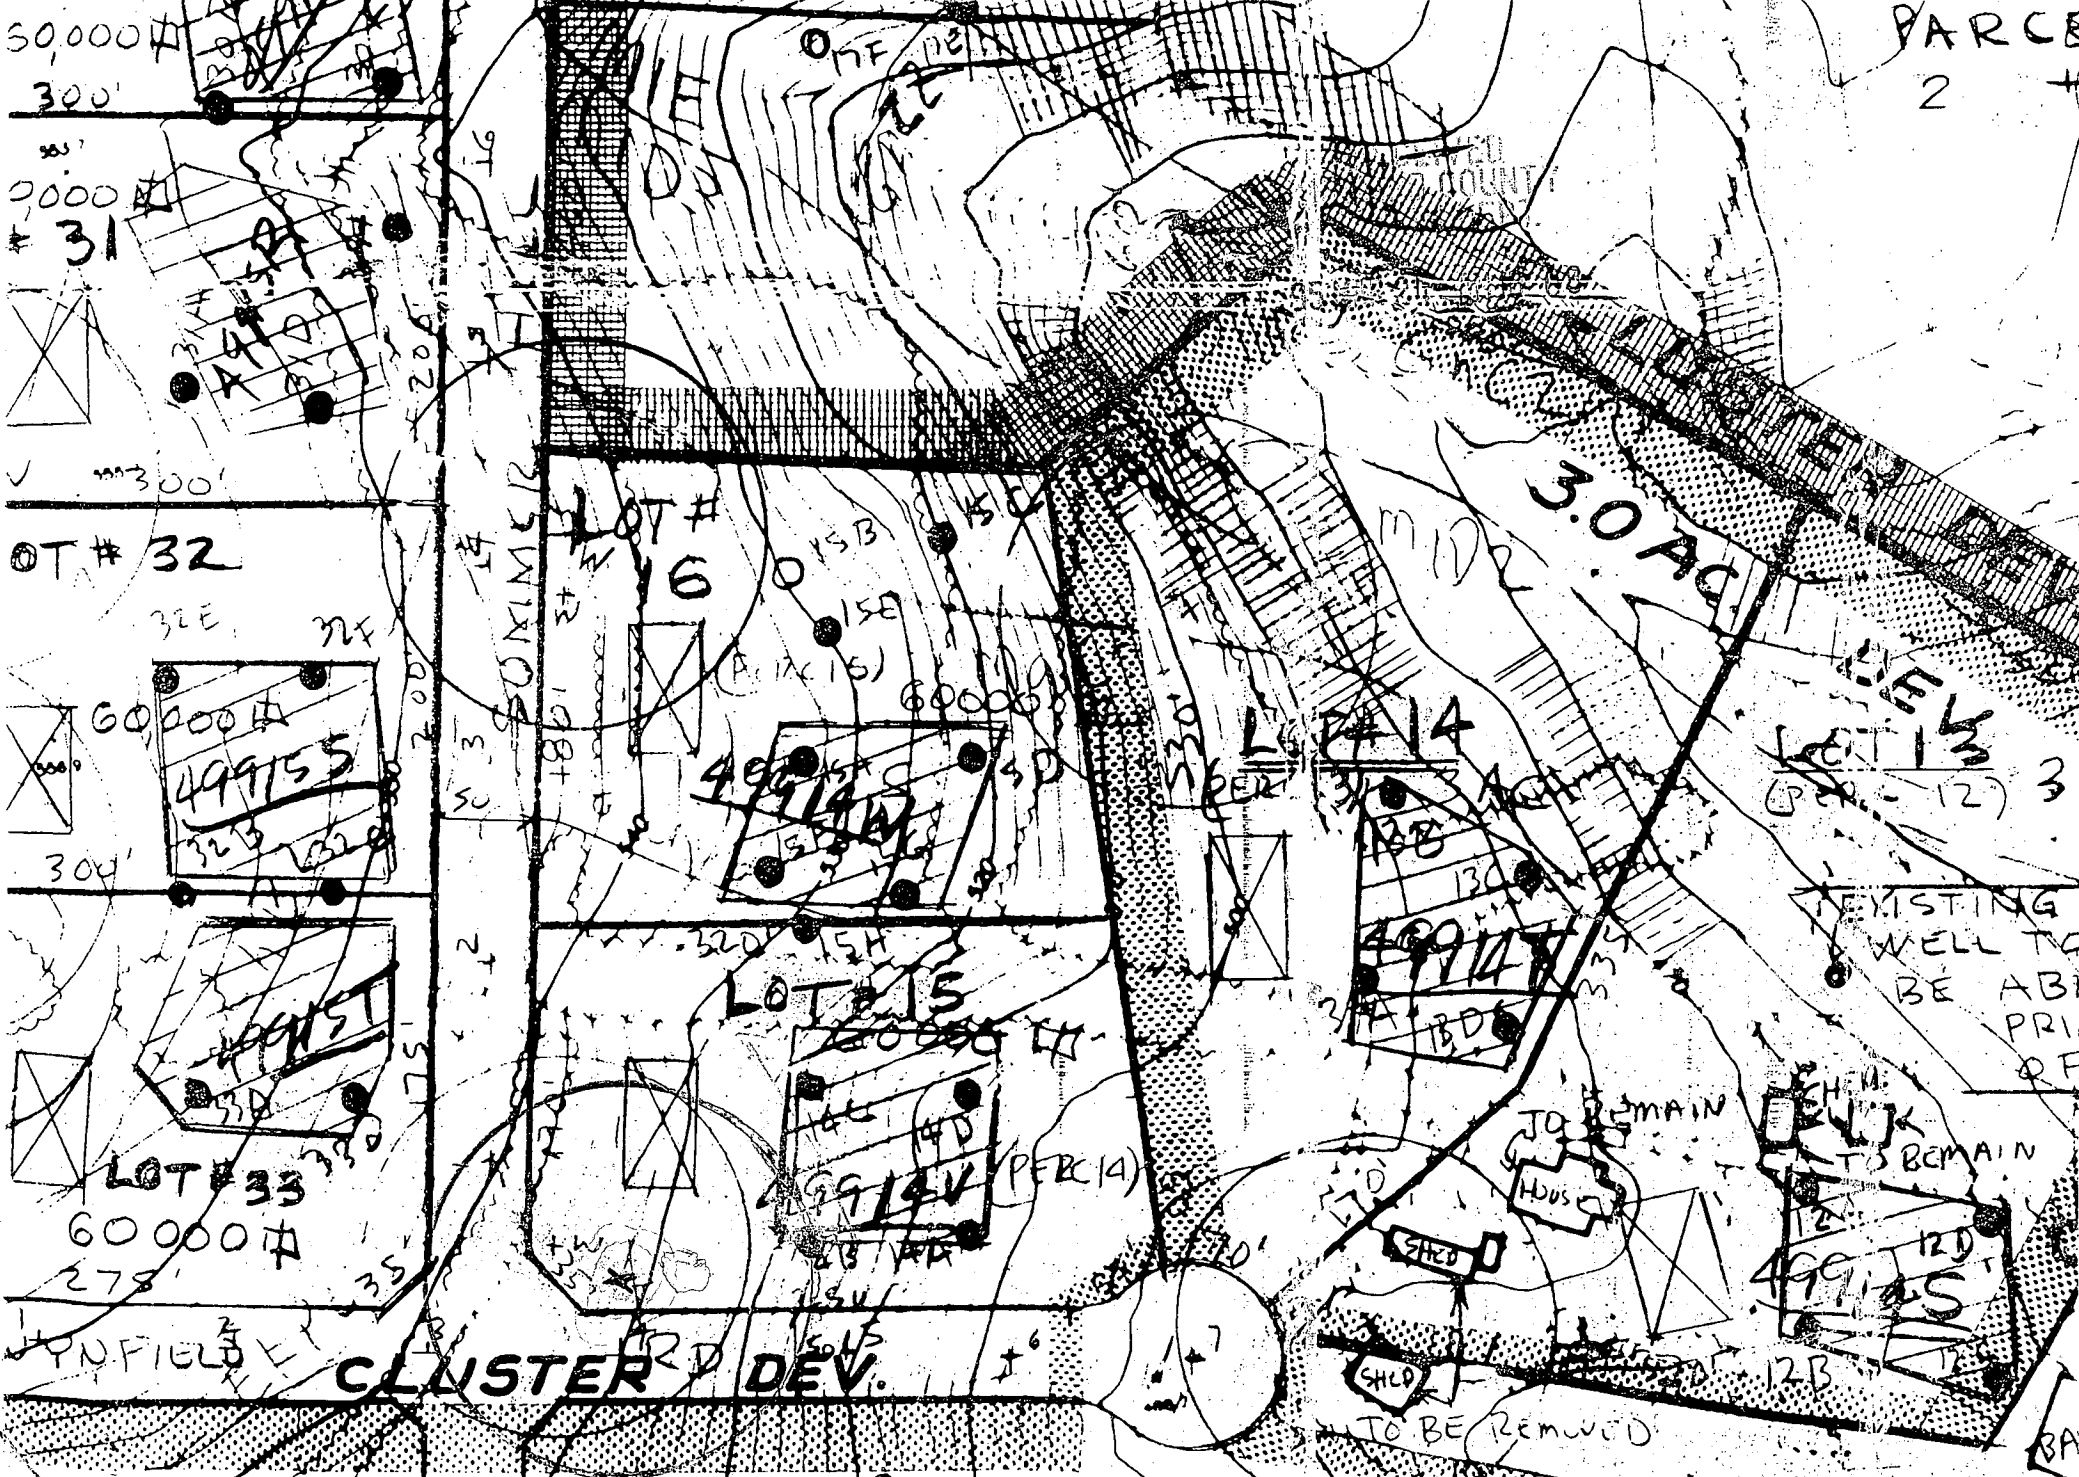

50,000 #
300'
2000 #
* 31
300'
300'

LOT # 32

60,000 #
499155

304'

LOT # 33

60,000 #

278'

HUNFIELD

CLUSTER DEV.

SEE SHEET 3-24-95
A61660 3/24/95 (CW)

Request to Move well on lot 15
40' DOWN HILL SDA to Be Adjusted.

PARCE
2

3.0 AC

LOT # 14

49914

TO REMAIN

TO BE REMOVED

LOT # 15

EXISTING WELL TO BE ABANDONED

TO REMAIN

49915

TO BE REMOVED

corrected OK
2/19/98 JPP

APPLICATION

HOWARD COUNTY

PERMIT APPLICATION

DEPARTMENT OF INSPECTIONS, LICENSES & PERMIT
3430 COURT HOUSE DRIVE, ELLICOTT CITY, MARYLAND 21043

SERIAL NUMBER

B00103987

#25

BUILDING ADDRESS (HOUSE NO., STREET, TOWN OR AREA)

27900 Scumma Hill Dr.
West Friendship Md 21794

GRADING/SEDIMENT CONTROL ☐ YES ☐ NO

SDP #

DESCRIPTION OF WORK AUTHORIZED

VILL II / SUBDIVISION

3BR

LOT NO.	PARCEL NO.	SEC	AREA	BLOCK NO.	LIBER	FOLIO
15	26	N/A	N/A	24		
SUB DIVISION		ZONE	ZONE MAP	ELEC. DIST.	CENSUS TR.	
		RR	15	3	6030	

OWNER NAME AND ADDRESS

Abner H. Home

3017 Rockwood Rd. Baltimore, Md 21215

OCCUPANT'S NAME AND ADDRESS

OWNER

ARCHITECT OR ENGINEER'S NAME AND ADDRESS

2111 E. Fainton St. Baltimore, Md 21204

CONTRACTOR'S NAME AND ADDRESS

Al-Harbi, Inc.

11111 Rockwood Rd. Baltimore, Md 21215

EXISTING USE

Vacant Lot

PROPOSED USE

Subdiv

EST. CONSTRUCTION COST

1400000

LICENSE NUMBER

1500

PERMIT FEE

1000

SIZE OF BLDG.

FRONT	DEPTH	HEIGHT

TYPE OF BLDG.

AREA	VOLUME	ROOF

FOOTINGS

FOUNDATION	S. WALLS

UTILITIES

WATER/WELL	SEWER/SEPTIC	GAS	ELECTRICITY	TYPE OF HEAT	AC

I have carefully examined and read this application and know the same is true and correct, and that in doing this work, all provisions of Howard County Ordinances and the State Laws of Maryland will be complied with, whether specified or not; and I will notify the Department of Inspections, and Permits twenty-four hours in advance when I am ready for the inspections called for elsewhere in the application; and that no work will be covered up until such inspections have been complied with.

SIGNATURE

Al-Harbi, Inc.

TITLE

DATE

W/S CODE FOR OFFICE USE ONLY

DISTANCE IN FEET FROM R/W LINE TO FRONT BUILDING LINE

SIDE YARD (DISTANCE IN FEET FROM SIDE BLDG. LINE TO SIDE PROPERTY LINE)

TO SIDE BUILDING LINE

DISTANCE IN FEET, REAR YD. REQUIRING SET

BACK (CORNER LOT ONLY)

SDP #

Check payable to: DIRECTOR OF FINANCE OF HOWARD COUNTY

CAUTION

To begin construction before a permit placard has been issued and displayed on the job is a violation of the law.

Use and occupancy permit must be applied for two weeks before it will be issued.

IMPORTANT: PLEASE SHOW ZIP CODES AND AREA CODES WHEREVER REQUIRED.

LP-69-591

R15076

FUNCTION

ZONING/PLANNING

SHA

SEDIMENT/GRADING

BUILDING OFFICIAL

WATER & SEWER

HEALTH DEPT.

FIRE PROTECTION

STORM WATER MGMT.

APPROVED

DATE

Distribution of Copies:
White - Building Official
Green - Planning & Zoning

Yellow - Engineering
Pink - Health Dept.
Gold - S.H.A.

A