

6/21/96
12:00 later clp
6/24/96
WPI anytime
6/27/96 11:00 later

PERMIT

SEWAGE DISPOSAL SYSTEM

DEPARTMENT OF HEALTH AND MENTAL HYGIENE

P 56626A

A 49915A

DISTRICT 3rd

HOWARD COUNTY HEALTH DEPARTMENT

BUREAU OF ENVIRONMENTAL HEALTH

~~XXXXXXXX~~ 313-2640

DATE 5/15/96

DATE SYSTEM APPROVED 6/27/96

INSPECTOR M. Riffin

INDEXED

South Carroll Backhoe, Inc.

IS PERMITTED TO INSTALL ☒ ALTER

ADDRESS 4410 Salem Bottom Road, Westminster, MD 21157

PHONE 875-4197

SUBDIVISION Sobus Farms

LOT 19

ROAD 2926 Summer Hill Drive

PROPERTY OWNER Altieri Homes, Inc. / Buchardt

ADDRESS

SEPTIC TANK CAPACITY 1250 GALLONS

NUMBER OF BEDROOMS 4

180 SQUARE FEET PER BEDROOM

LINEAR FEET OF TRENCH REQUIRED 180

TRENCHES - Trench to be 2 feet wide. Inlet 2 feet below original grade. Bottom maximum depth 6 feet below original grade. Effective area begins at 2 feet below original grade. 4 feet of stone below distribution pipe.

LOCATION - Place distribution box 180 feet up the right (350.00') lot line and 20 feet off that same lot line as seen when facing the lot from Summer Hill Drive. Run trenches on contour toward the left lot line.

NOTES - No trench to exceed 100 feet in length. Provide 6" - 8" diameter cleanout and cap to grade or above on septic tank. ok/cw

PLANS APPROVED BY Amy McMillen

DATE 09/26/95

COVER NO WORK UNTIL INSPECTED AND APPROVED

jr

NEITHER THE HOWARD COUNTY COUNCIL NOR THE HEALTH DEPARTMENT IS RESPONSIBLE FOR THE SUCCESSFUL OPERATION OF ANY SYSTEM

NOTE: CLEANOUT REQUIRED EVERY 70 FEET OF SEWER LINE AND/OR AT 90° SWEEPS IN LINES FROM HOUSE TO DRAIN FIELDS, 90° ELBOWS NOT ACCEPTABLE.

NOTE: ALL PARTS OF SEPTIC SYSTEMS (I.E. TANK, DISTRIBUTION BOX TRENCHES) TO BE 100 FEET FROM WELL (UNLESS OTHERWISE SPECIFICALLY AUTHORIZED)

NOTE: IF DEEP TRENCH(ES) ARE USED CALL FOR INSPECTION BEFORE AND AFTER PLACING GRAVEL IN TRENCH(ES)

NOTE: NO DRY WELL SHALL EXCEED 15 FOOT IN DIAMETER NO ABSORPTION TRENCH TO EXCEED 100 FEET IN LENGTH

NOTE: ALL PIPE FROM HOUSE TO SEPTIC TANK MUST BE CAST IRON OR SCHEDULE 35/40 PVC OR ABS

PERMIT VOID AFTER TWO YEARS

NOTE: INSTALL STAND PIPE ON SEPTIC TANK AND DRY WELL STAND PIPES MUST BE 6 INCHES IN DIAMETER CAST IRON, CONCRETE OR TERRA COTTA OR PVA OR ABS ACCEPTED. IF TOP OF SEPTIC TANK IS DEEPER THAN 3 FEET. MANHOLE TO GRADE REQUIRED.

NOTE: DISTRIBUTION BOXES MUST HAVE BAFFLES


*INSTALLER IS RESPONSIBLE FOR OBTAINING FINAL APPROVAL ON THIS PERMIT

ADD. PERMIT SIGNED
AND RETURNED 11-5-98

Serial # B10114944

detached garage

A 49915A

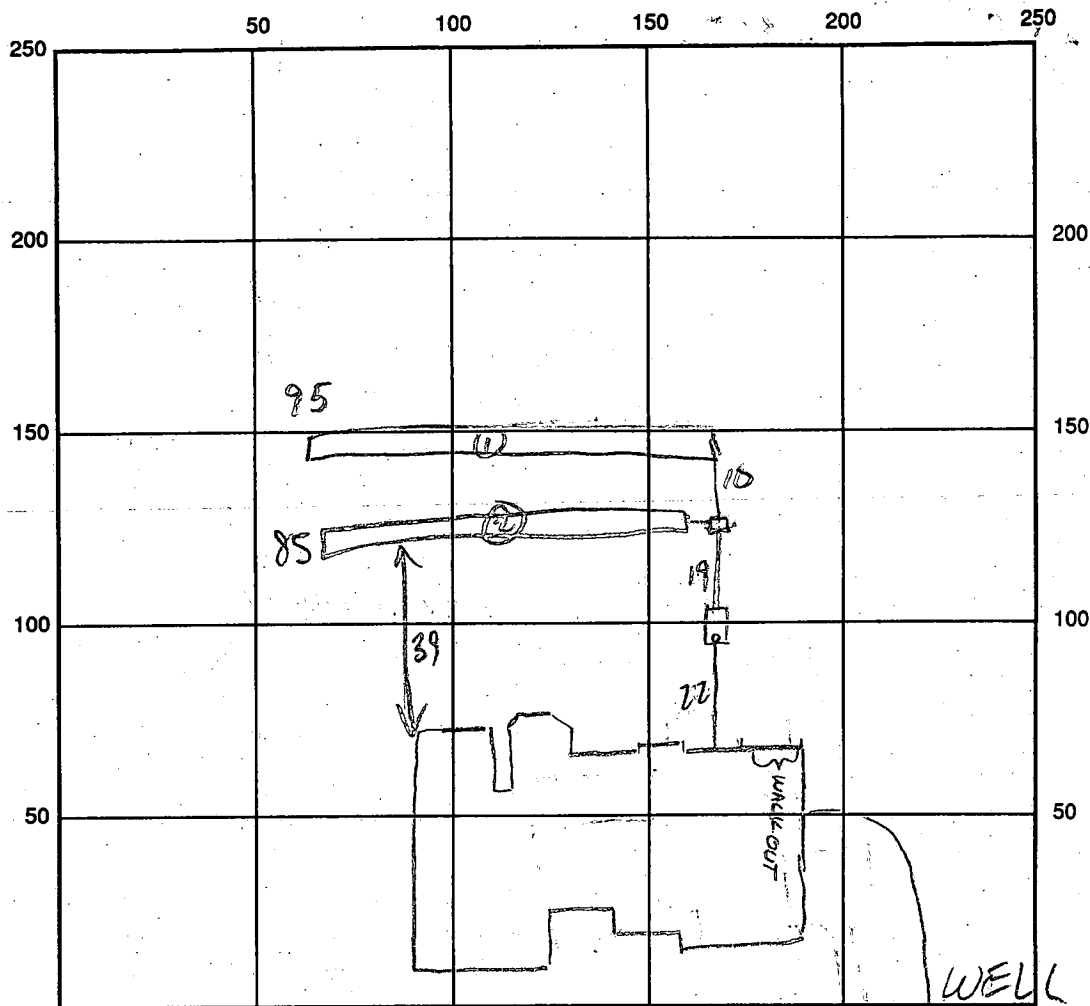

INDICATE NORTH - NAME ADJOINING ROADWAY AS BASE LINE

HO-93-0087

SEPTIC TANK LEVEL 1250 GAL OK

CLEANOUTS OK

DISTRIBUTION BOX LEVEL OK BAFFLE IN

DRAIN FIELD/TITLE DEPTH 16-6 1/2 FT.

TRENCH WIDTH 2 FT.

INLET DEPTH 2 FT.

EFFECTIVE GRAVEL DEPTH 4 FT.

TOTAL LENGTH 195 285 FT.

NUMBER OF TRENCHES 2

ONE SIDEWALL/BOTTOM AREA 380 2340 SQ. FT.

DRYWALL INSIDE DIAMETER — FT.

EFFECTIVE DEPTH BELOW INLET — FT.

ABSORBENT AREA 720 SQ. FT.

REMARKS: 6/27/96 OK to cover house to DB Au

6/27/96 #2 TRENCH BOTTOMS NOT OBS'D; ACCEPTED

INSTALLER'S REPORT OF TRENCH DEPTHS; OK TO COVER

MR

6/21/96 WPI OK to cover 5.5 below grade Au

DATE SYSTEM APPROVED 6/27/96

INSPECTOR M.R. Pkin

APPLICATION

PERCOLATION TESTING

A 499/5A

P _____

HOWARD COUNTY HEALTH DEPARTMENT

BUREAU OF ENVIRONMENTAL HEALTH

3525-H ELLICOTT MILLS DRIVE/ELLICOTT CITY, MARYLAND 21043
TELEPHONE: 313-2640

DISTRICT 3

DATE 3/9/94

TO: THE COUNTY HEALTH OFFICER
ELLICOTT CITY, MARYLAND

I HEREBY APPLY FOR THE NECESSARY TEST PRIOR TO APPLICATION FOR PERMIT TO CONSTRUCT (OR RECONSTRUCT) A SEWAGE DISPOSAL SYSTEM.

PROPERTY OWNER ~~Altieri Homes, Inc.~~ Nitro Development Corporation

ADDRESS P.O. Box 208, Clarksville, Md. 21029 PHONE 410-796-5206
410-531-5539

AGENT OR PROSPECTIVE BUYER Richard Demmitt

ADDRESS P.O. Box 208, Clarksville, Md. 21029 PHONE 410-531-5539

PROPERTY LOCATION:

SUBDIVISION Sobus Farms LOT NO. 19 (nineteen)

ROAD AND DESCRIPTION at the end of Winfield Rd.
(2926 Summer Hill Drive)

TAX MAP 15 PARCEL # 26 & 154

SIZE OF LOT 1 acre + TYPE BLDG. _____
(SINGLE FAMILY DWELLING OR COMMERCIAL)

BLDG. PERMIT SIGNED

AND RETURNED 1/26/94

Serial # 63 222-SFD-4Bm
S.F.D.

THE SYSTEM INSTALLED UNDER THIS APPLICATION IS ACCEPTABLE ONLY UNTIL PUBLIC FACILITIES BECOME AVAILABLE. I FULLY UNDERSTAND THE
FEE CONNECTED WITH THE FILING OF THIS PERC TEST APPLICATION IS NON-REFUNDABLE UNDER ANY CIRCUMSTANCES. I ALSO AGREE TO
COMPLY WITH ALL M.O.S.H.A. REQUIREMENTS IN TESTING THIS LOT.

Richard Demmitt
(SIGNATURE OF APPLICANT)

APPROVED BY _____ FOR _____ DATE _____

DISAPPROVED BY _____ FOR _____ DATE _____

HOLD PENDING FURTHER TESTS _____

REASONS FOR REJECTION OR HOLDING _____

PERCOLATION TEST PLAT/PRELIMINARY PLAT - TITLE OR I.D. # _____ DATE _____

SITE DEVELOPMENT PLAN/FINAL PLAT - TITLE OR I.D. # _____ DATE _____

THIS IS NOT A PERMIT

A49915A

COUNTY #

SOIL PROFILE
F

0' red/orange SCL
1' lgt yell/tan SL
15% mica
OK
10'

E


same as F but
5-10% mica
11'

B

red brn CL
brn SL
3' lgt grey SL
25% shale
11 1/2'

SOIL PROFILE
C

0' bright red CSL
3' yell/tan SL
mica chunks
59%
12'

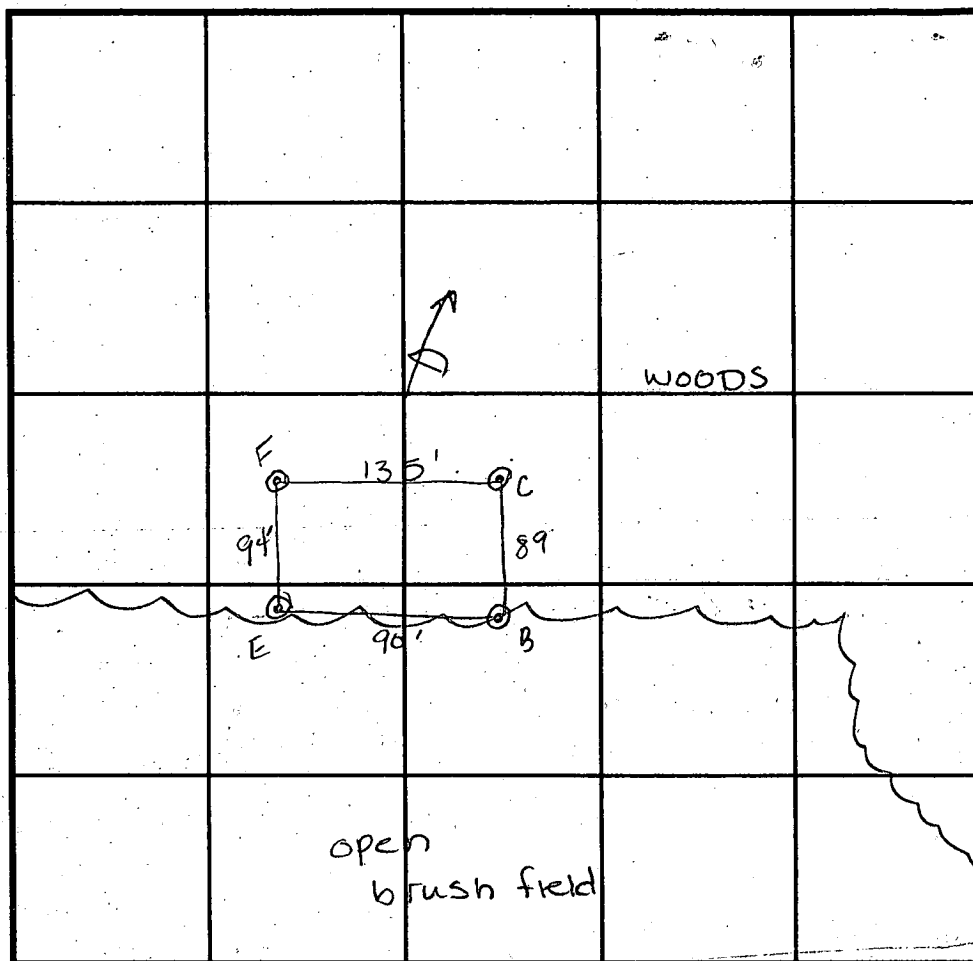

INDICATE NORTH - NAME ADJOINING ROADWAY AS BASE LINE.

DATE	TEST NO.	DEPTH	PRE-WET		TEST - 1" DROP		TIME
			START	STOP	START	STOP	
3/25/94	F	3' V 10'	11:29 ¹⁰	11:30 ⁰⁵	11:30 ⁰⁵	11:31 ⁰⁵	1 min
	E	4' V 11'	11:33 ¹⁵	11:33 ⁵⁰	11:33 ⁵⁰	11:34 ⁴⁰	50 sec
	B	3' V 11 1/2'	11:23 ²⁰	11:23 ⁴⁰	11:23 ⁴⁰	11:24 ¹⁵	35 sec
		5' V 11 1/2'	11:22 ⁰⁵	11:22 ²⁵	11:22 ²⁵	11:23 ⁰⁵	40 sec
		repour	11:25 ⁰⁵	11:25 ⁵³	11:25 ⁵⁵	11:26 ⁵⁰	1 min
	C	5 1/2' V 12	11:14 ¹⁵	11:15 ¹⁵	11:15 ¹⁵	11:16 ³⁰	1 1/4 min
		3' V 12	11:15 ¹⁵	11:15 ⁴⁵	11:15 ⁴⁵	11:16 ⁴⁵	1 min


REMARKS

TYPE OF SOIL Ch B₂ Chester Silt Loam

TESTED BY A. McMillen/M. Rifkin ALSO PRESENT R. Demitt

TRENCH DESIGN DATA: AVERAGE PERCOLATION TIME 2 min TRENCH WIDTH 2'

INLET DEPTH 2' MAXIMUM BOTTOM DEPTH 6' SQ. FT./BEDROOM 180 ft²

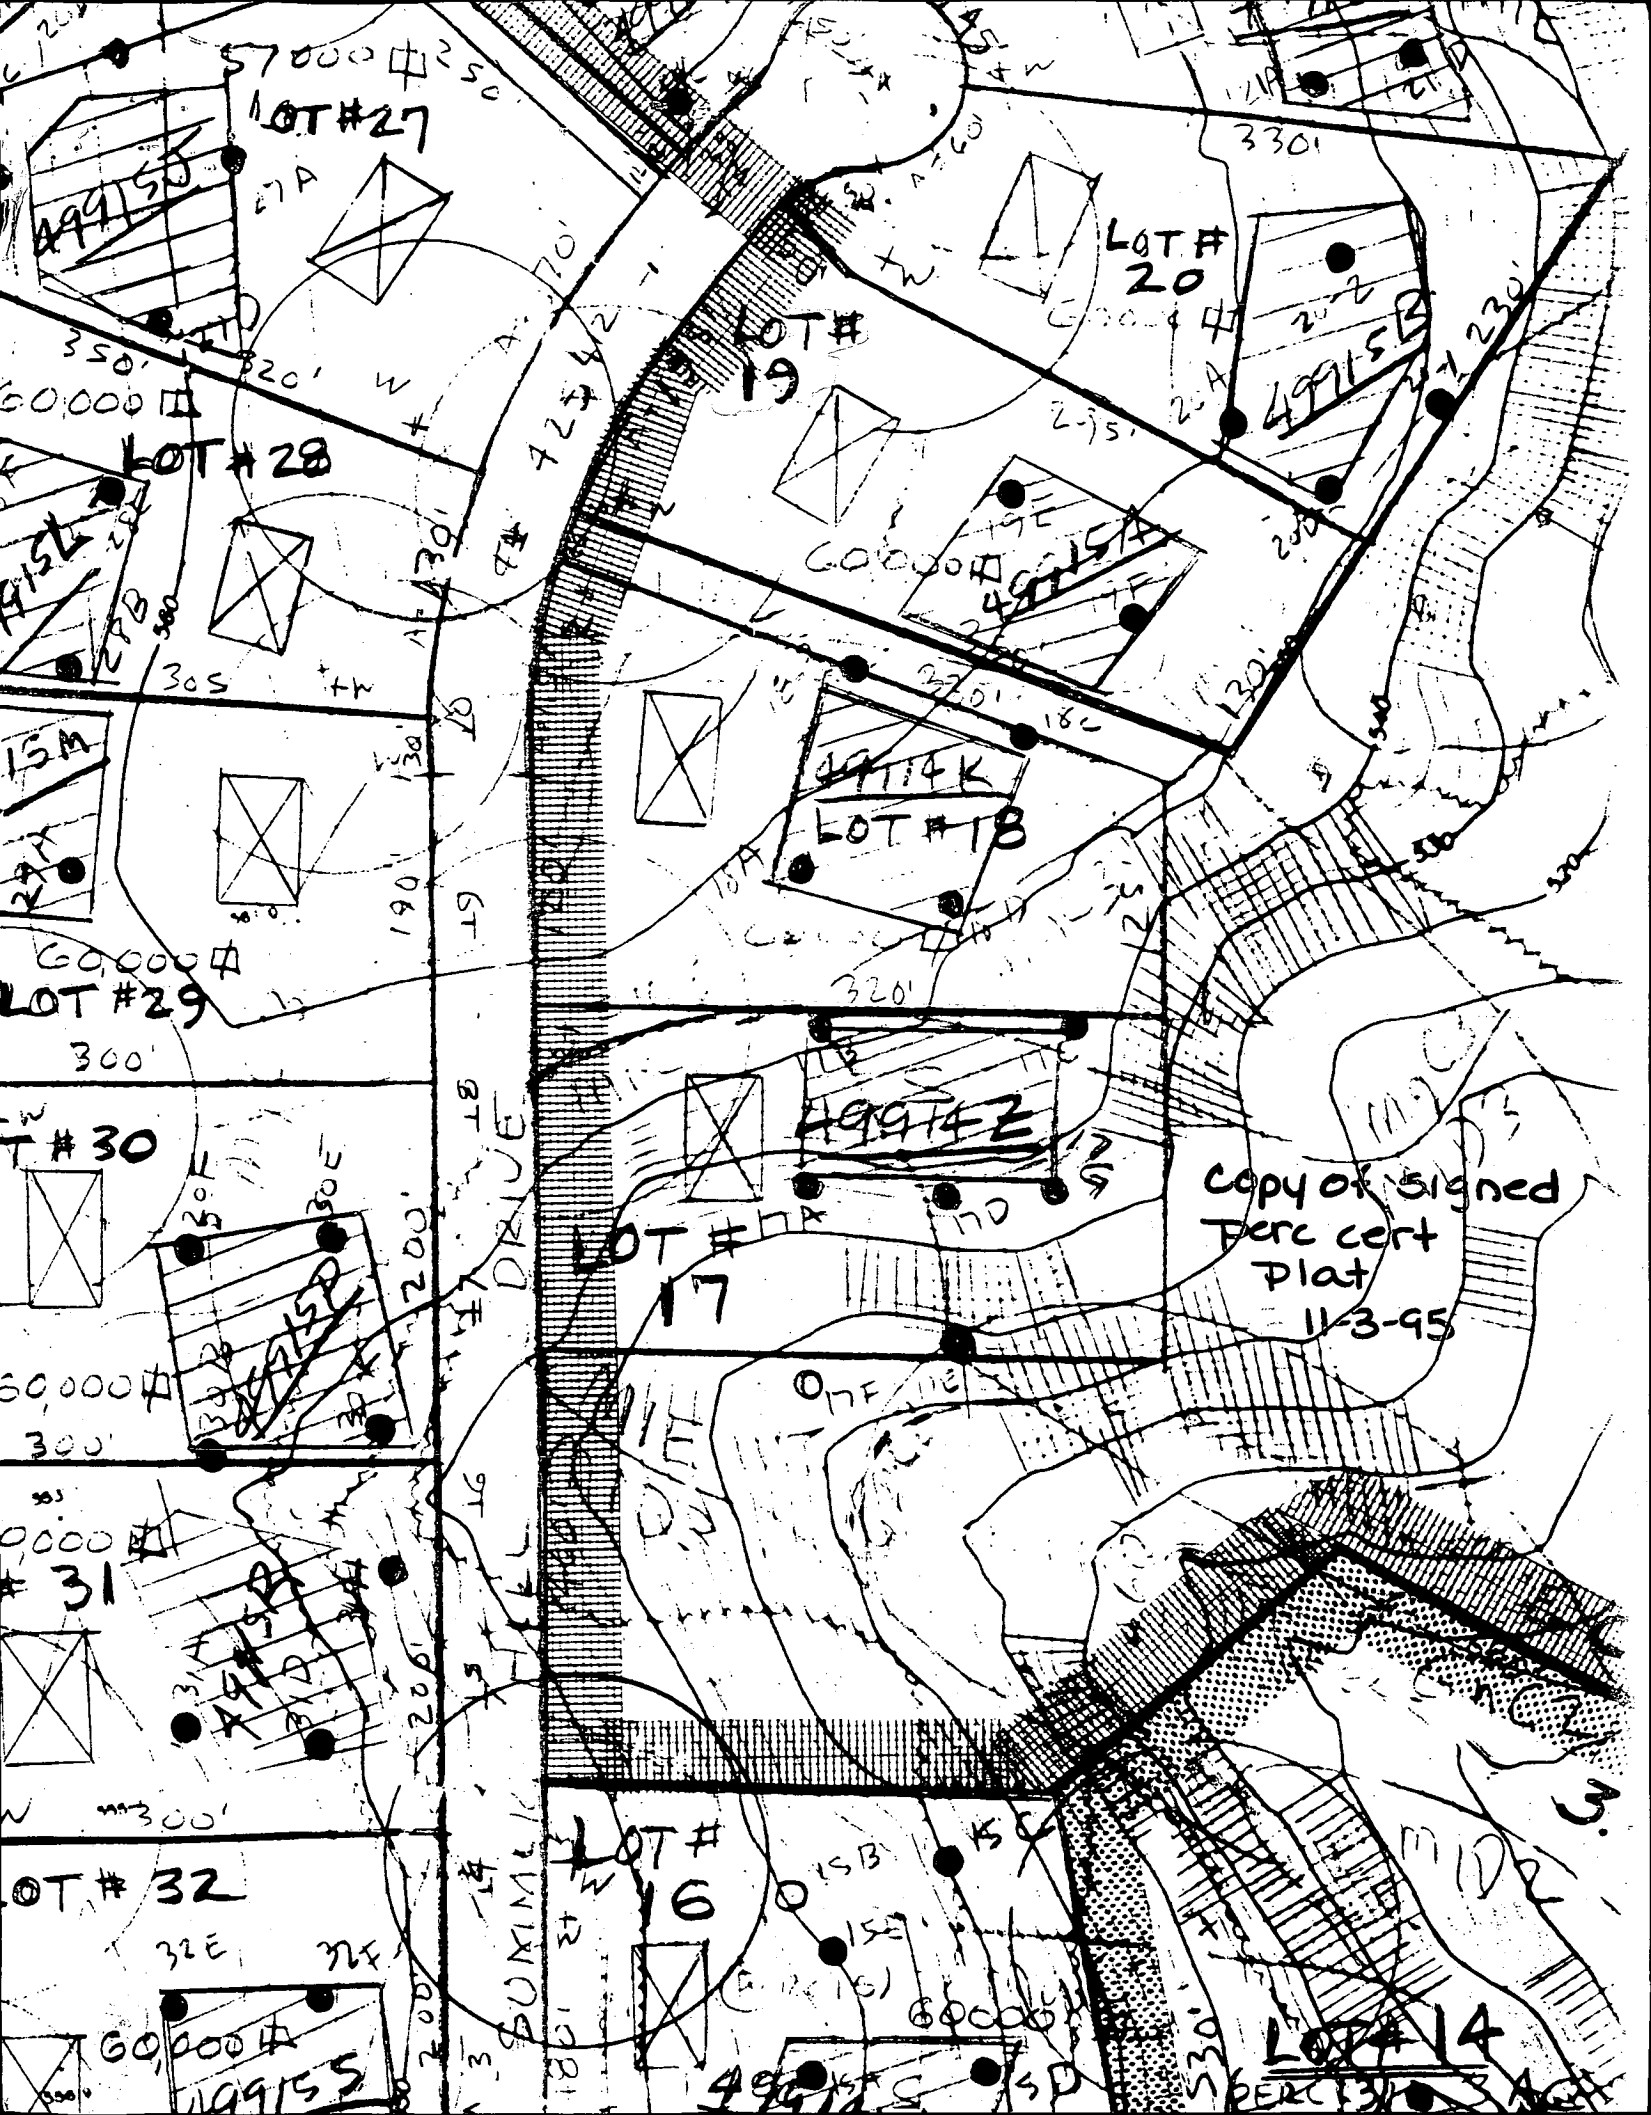

LOT #27

LOT #20

LOT #19

LOT #28

LOT #18

LOT #29

LOT #17

LOT #30

LOT #31

LOT #32

LOT #16

LOT #14

Copy of signed
Perc cert
Plat
11-3-95

ST. B. DRIVE

ONE

MID

49915C

499155

499155

49915B

49915A

49914K

49914E

49915D

49915A

15B

15C

15D

15E

15F

15G

15H

15I

15J

15K

15L

15M

15N

15O

15P

15Q

15R

15S

15T

15U

15V

15W

15X

15Y

15Z

15AA

15AB

15AC

15AD

15AE

15AF

15AG

15AH

15AI

15AJ

15AK

15AL

15AM

15AN

15AO

15AP

15AQ

15AR

15AS

15AT

15AU

15AV

15AW

15AX

15AY

15AZ

15BA

15BB

15BC

15BD

15BE

15BF

15BG

15BH

15BI

15BJ

15BK

15BL

15BM

15BN

15BO

15BP

15BQ

15BR

15BS

15BT

15BU

15BV

15BW

15BX

15BY

15BZ

15CA

15CB

15CC

15CD

15CE

15CF

15CG

15CH

15CI

15CJ

15CK

15CL

15CM

15CN

15CO

15CP

15CQ

15CR

15CS

15CT

15CU

15CV

15CW

15CX

15CY

15CZ

15DA

15DB

15DC

15DD

15DE

15DF

15DG

15DH

15DI

15DJ

15DK

15DL

15DM

15DN

15DO

15DP

15DQ

15DR

15DS

15DT

15DU

15DV

15DW

15DX

15DY

15DZ

15EA

15EB

15EC

15ED

15EE

15EF

15EG

15EH

15EI

15EJ

15EK

15EL

15EM

15EN

15EO

15EP

15EQ

15ER

15ES

15ET

15EU

15EV

15EW

15EX

15EY

15EZ

15FA

15FB

15FC

15FD

15FE

15FF

15FG

15FH

15FI

15FJ

15FK

15FL

15FM

15FN

15FO

15FP

15FQ

15FR

15FS

15FT

15FU

15FV

15FW

15FX

15FY

15FZ

15GA

15GB

15GC

15GD

15GE

15GF

15GG

15GH

15GI

15GJ

15GK

15GL

15GM

15GN

15GO

15GP

15GQ

15GR

15GS

15GT

15GU

15GV

15GW

15GX

15GY

15GZ

15HA

15HB

15HC

15HD

15HE

15HF

15HG

15HH

15HI

15HJ

15HK

15HL

15HM

15HN

15HO

15HP

15HQ

15HR

15HS

15HT

15HU

15HV

15HW

15HX

15HY

15HZ

15IA

15IB

15IC

15ID

15IE

15IF

15IG

15IH

15II

15IJ

15IK

15IL

15IM

15IN

15IO

15IP

15IQ

15IR

15IS

15IT

15IU

15IV

15IW

15IX

15IY

15IZ

15JA

15JB

15JC

15JD

15JE

15JF

15JG

15JH

15JI

15JJ

15JK

15JL

15JM

15JN

15JO

15JP

15JQ

15JR

15JS

15JT

15JU

15JV

15JW

15JX

15JY

15JZ

15KA

15KB

15KC

15KD

15KE


15KF

15KG

15KH


15KI

C3	50.00'	235.54'	70.77'	S 30°24'19" E	269°54'32"	50.00'
C4	35.00'	30.33'	29.39'	N 79°43'27" E	49°38'58"	16.00'
C5	400.00'	308.80'	301.19'	N 32°46'59" E	44°13'58"	162.00'

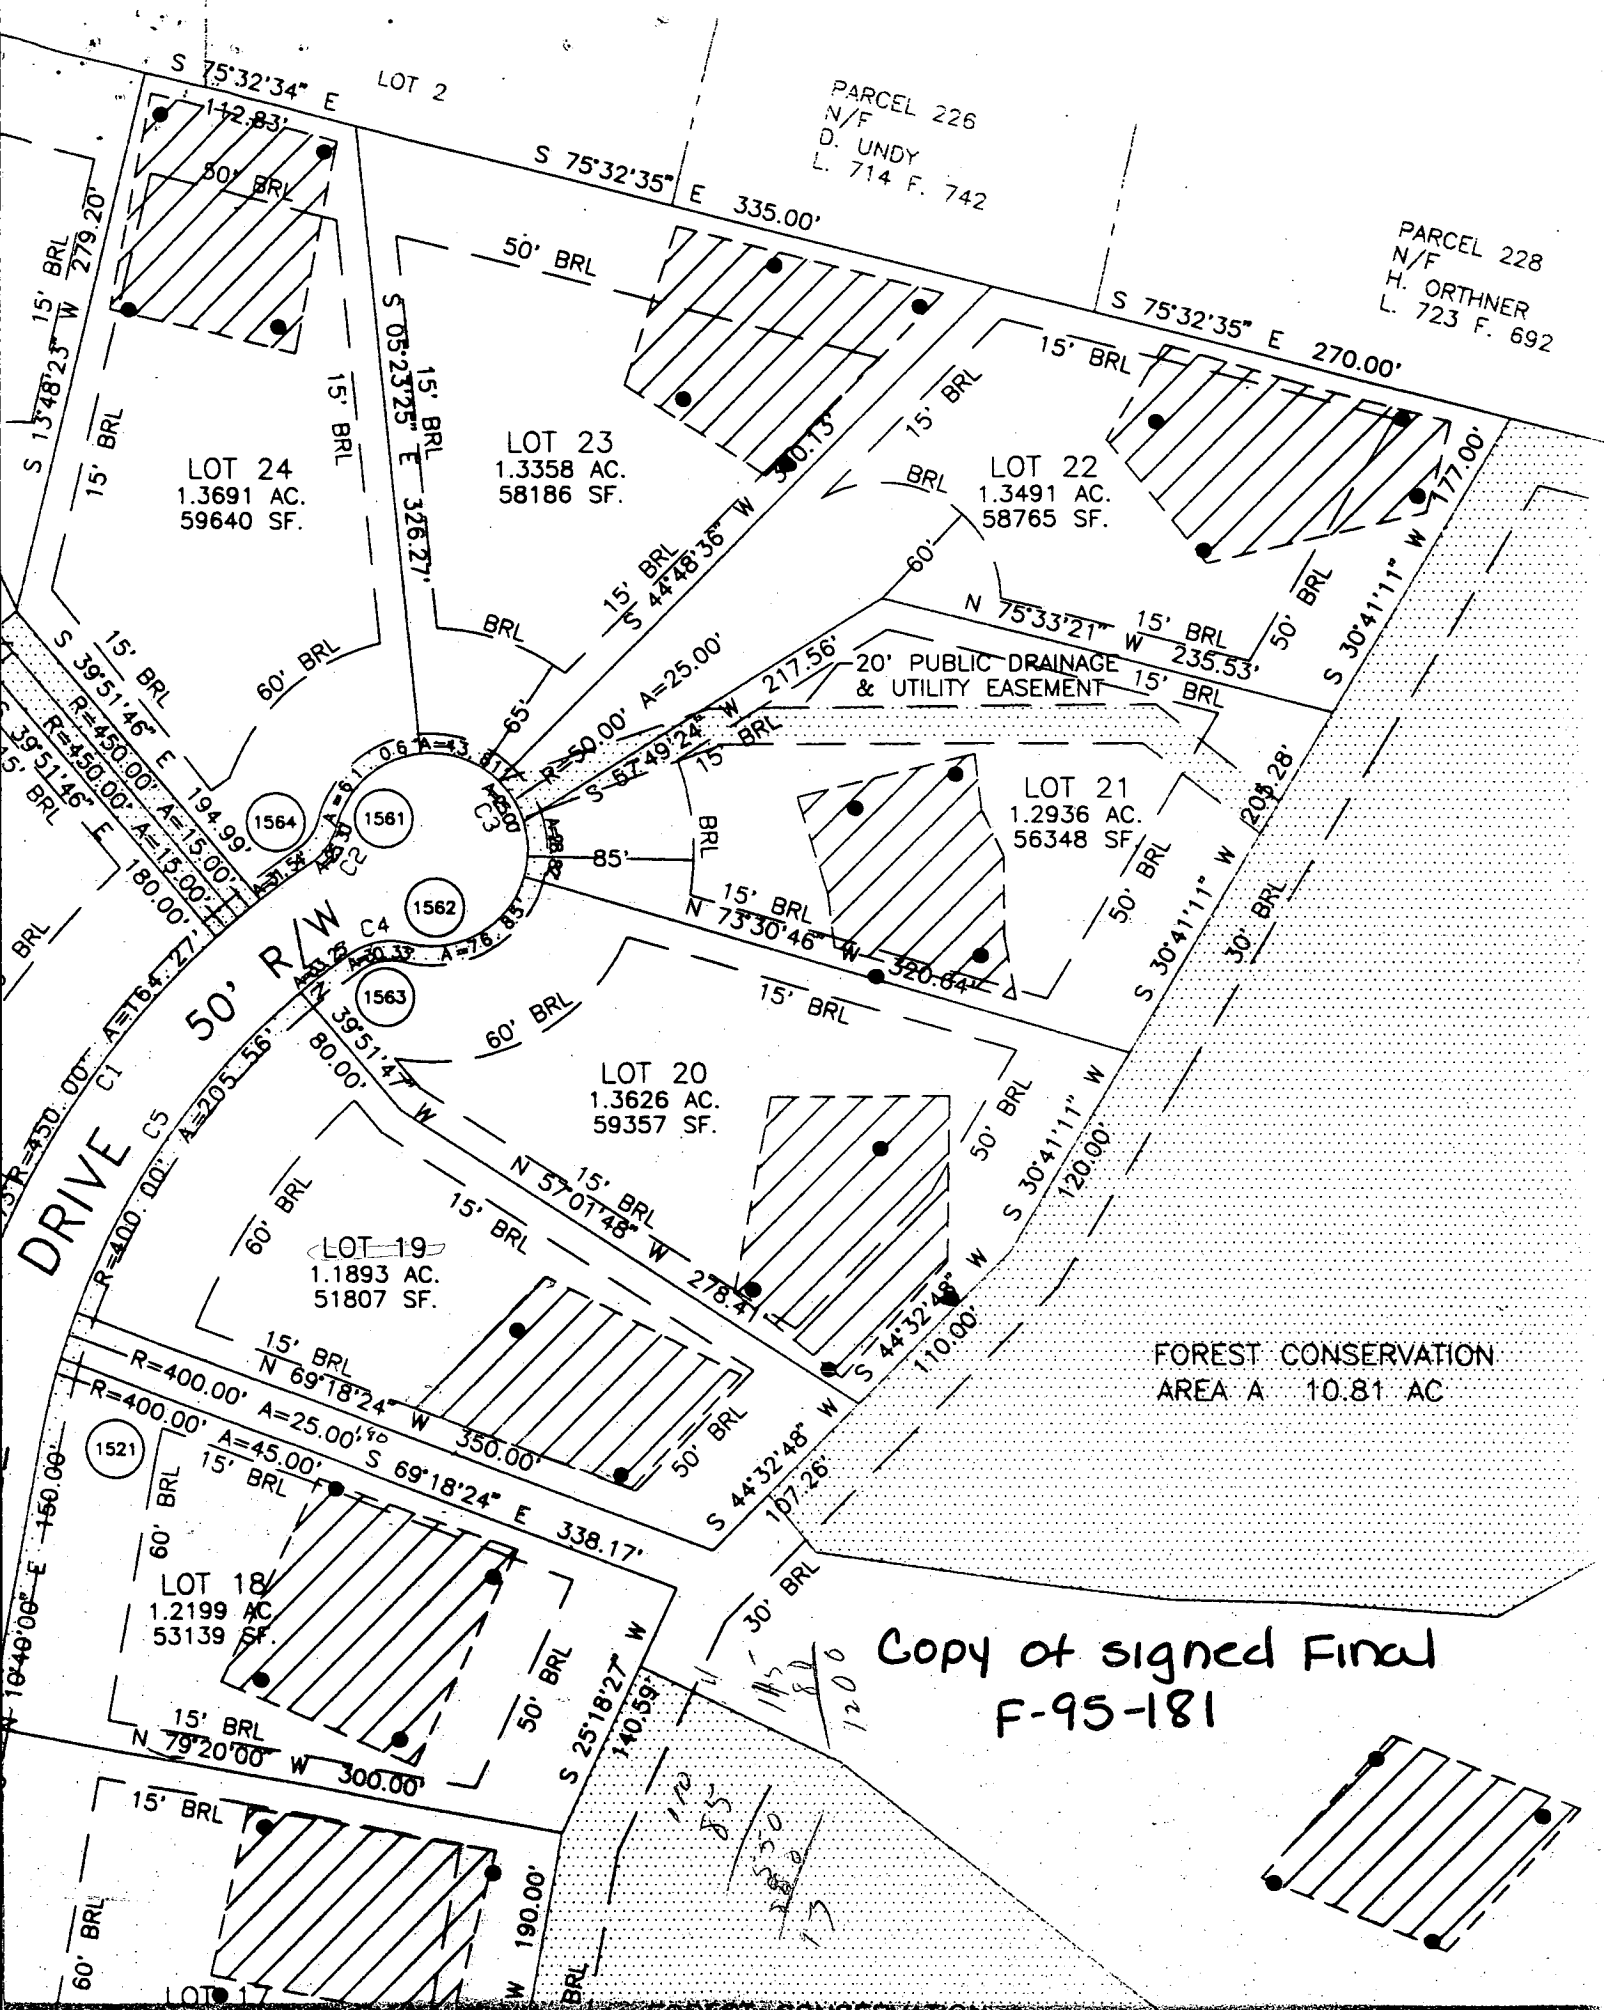


Approved Septic System Plan
Howard County Health Department

Signature *[Signature]* Date 1/26/96

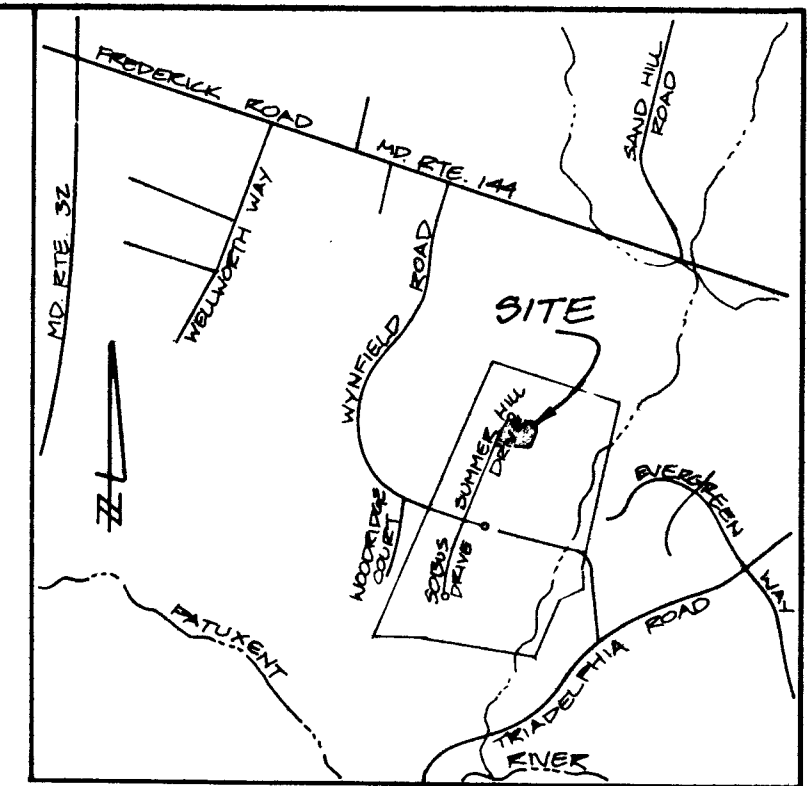

SITE VICINITY MAP
SCALE: 1"=2000'

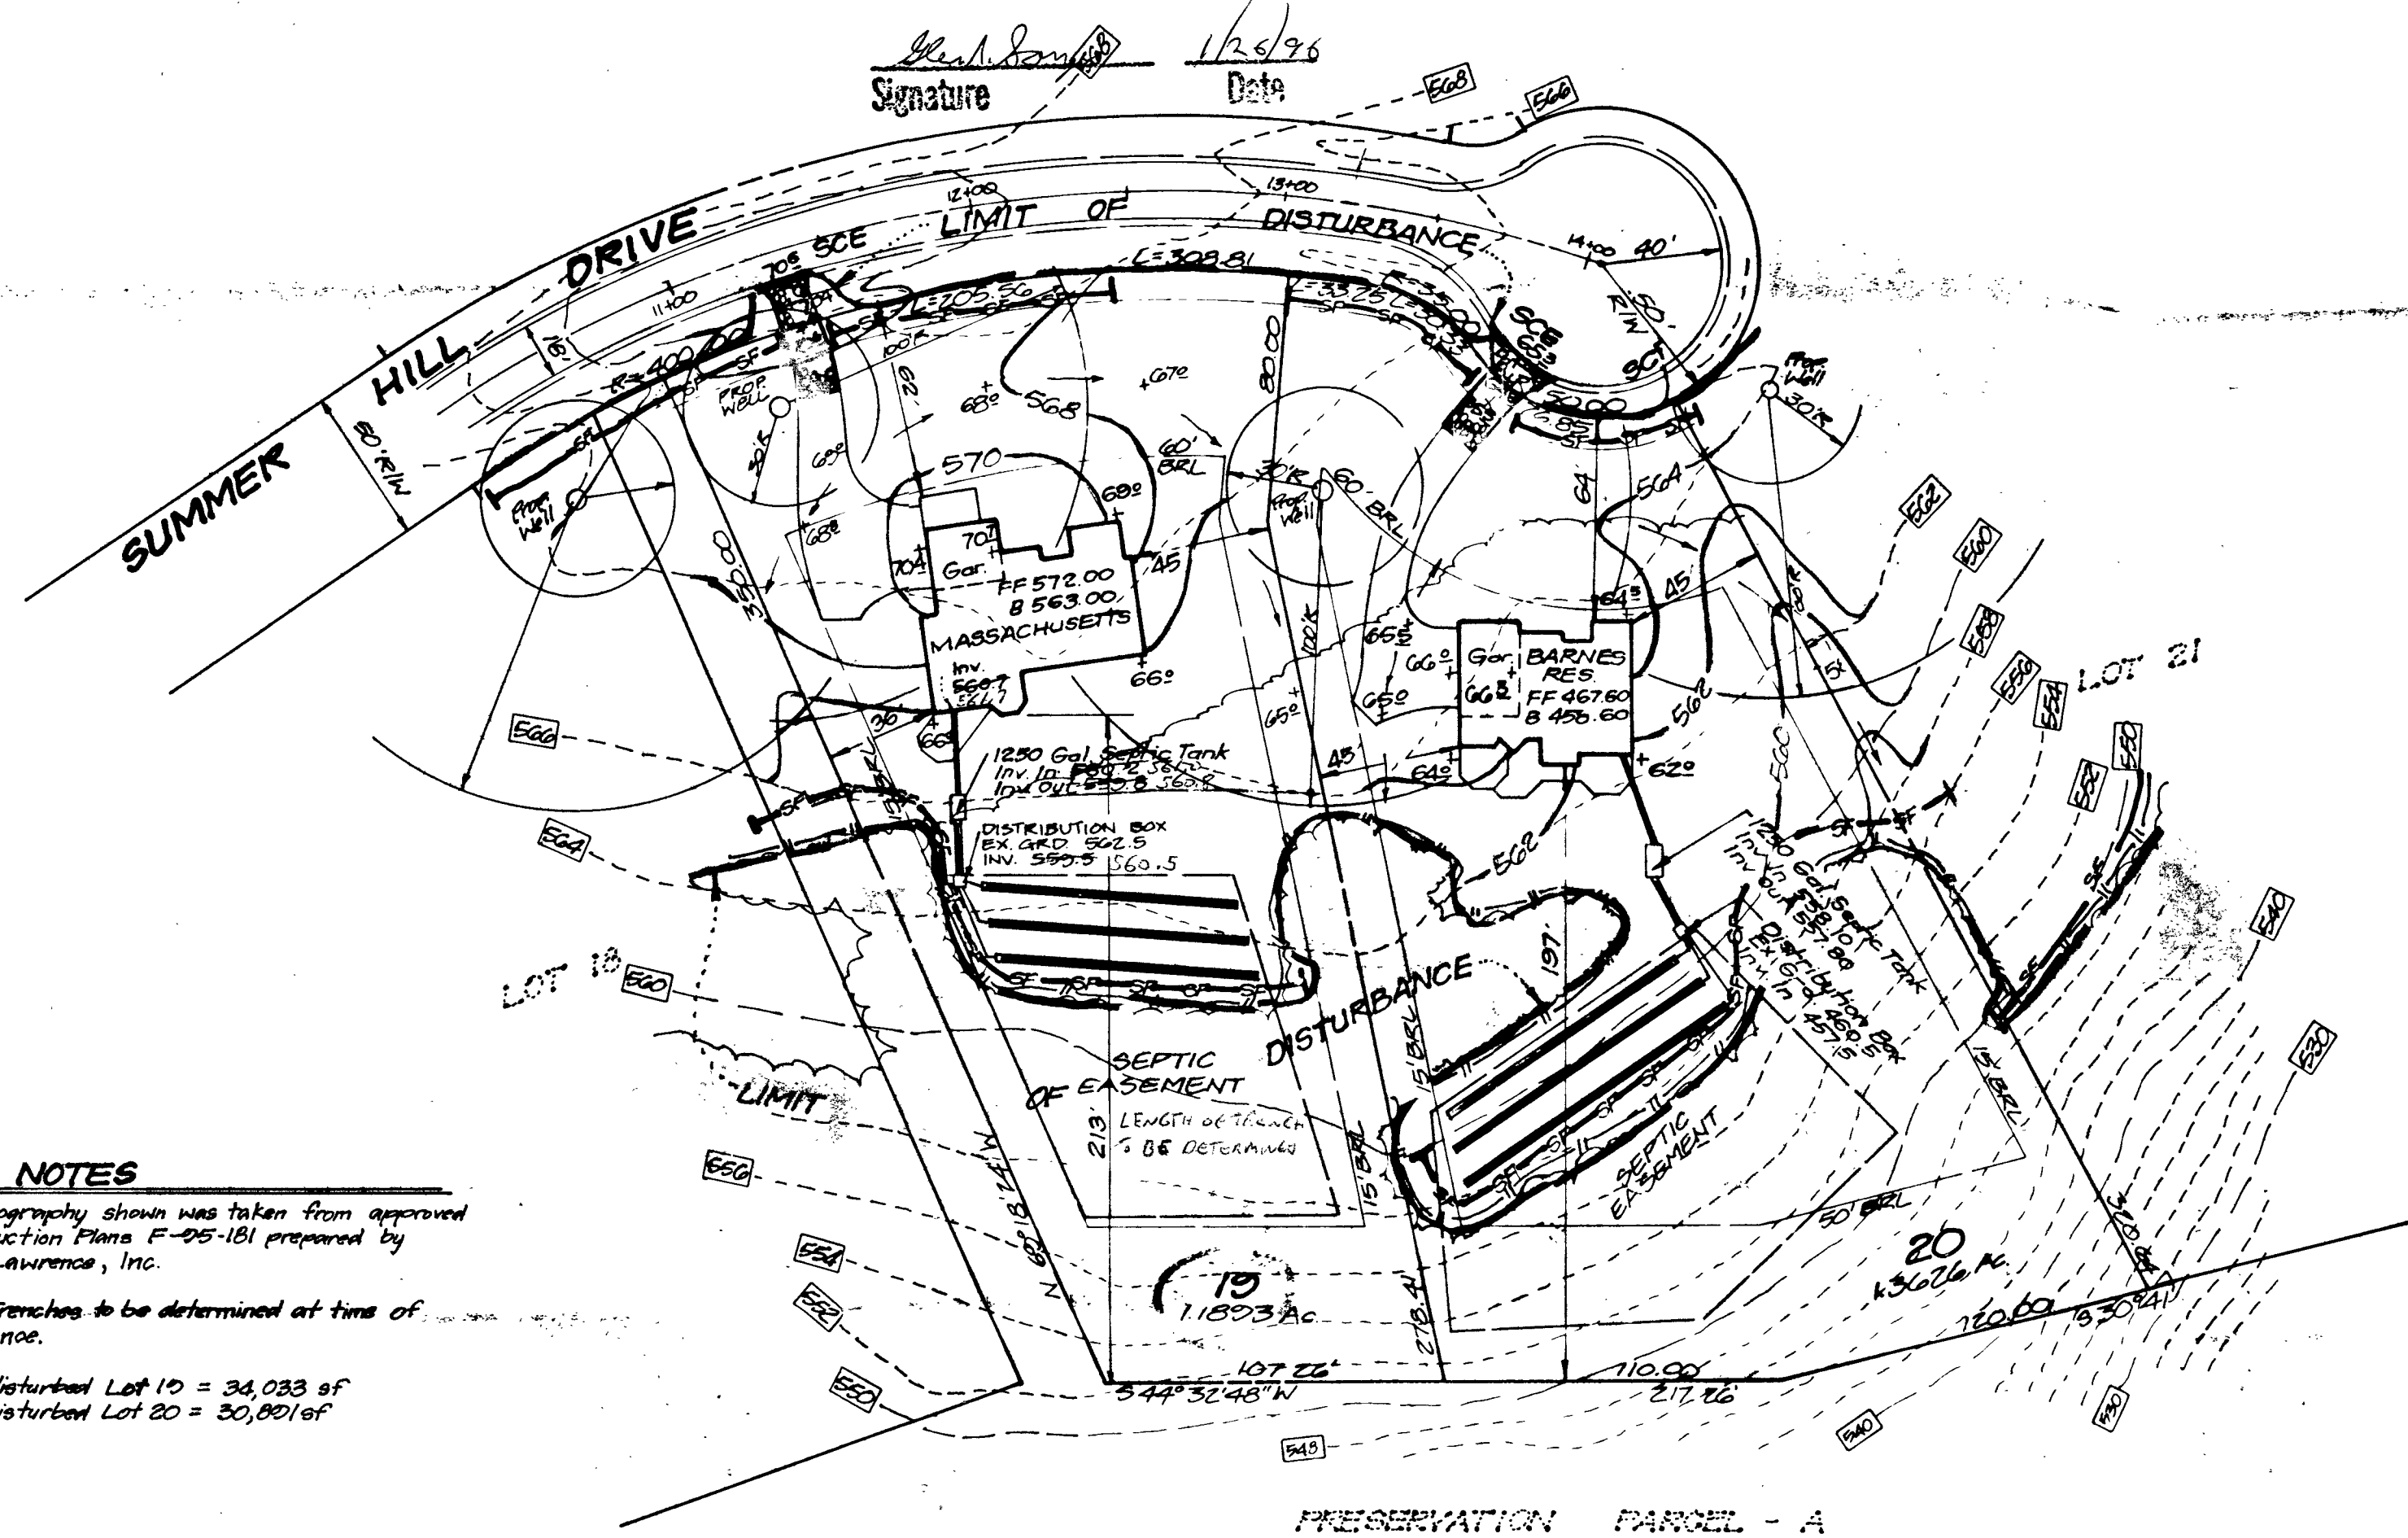


LEGEND

- Contour Interval 2 Ft.
- Existing Contour ——— 570 ———
- Proposed Contour ——— 570 ———
- Spot Elevation + 70 ±
- Direction of Drainage ———> ———
- Walkout Basement
- Existing Trees To Be Saved
- Tree Protection Fence ——— || ———
- Silt Fence ——— SF ——— SF ——— SF ———
- Super Silt Fence ——— SSF ——— SSF ———
- Earth Dike ——— E.D. (A-1) ———
- Stabilized Construction Entrance

GENERAL NOTES



1. Existing Topography shown was taken from approved Road Construction Plans F-95-181 prepared by O'Connell & Lawrence, Inc.
2. Length of Trenches to be determined at time of Permit Issuance.
3. Total Area disturbed Lot 19 = 34,033 sf
Total Area disturbed Lot 20 = 30,801 sf


210' /
105' /
90' /
70' /
50' /
240'

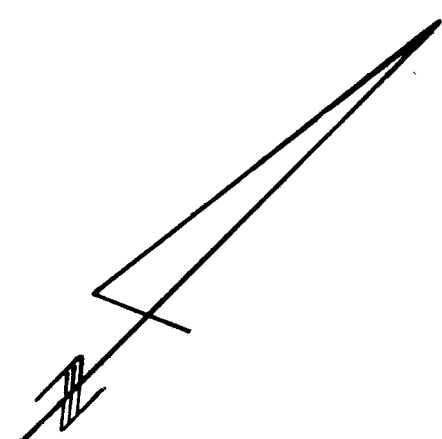

		CLARK • FINEFROCK & SACKETT, INC. ENGINEERS • PLANNERS • SURVEYORS 7135 MINSTREL WAY • COLUMBIA, MD 21045 • (410) 381-7500 - BALTO • (301) 621-8100 - WASH	
DESIGNED JME KIWM	SEDIMENT and EROSION CONTROL PLAN		SCALE 1"=50'
DRAWN PB	SOBUS FARMS LOTS 19 AND 20		DRAWING 1 OF 1
CHECKED JME	TAX MAP: 15 PARCELS: 26 & 154 3rd ELECTION DISTRICT HOWARD COUNTY, MARYLAND		JOB NO. 95-209
DATE 1-22-96	FOR: ALTIERI HOMES, INC. 7349 Gardenvue Drive Elkridge, MD 21227		FILE NO. 95-209X

C1 2896		SEQUENCE NO. (MDE USE ONLY)		STATE OF MARYLAND WELL COMPLETION REPORT FILL IN THIS FORM COMPLETELY PLEASE PRINT OR TYPE		THIS REPORT MUST BE SUBMITTED WITHIN 45 DAYS AFTER WELL IS COMPLETED.	
(THIS NUMBER IS TO BE PUNCHED IN COLS. 3-6 ON ALL CARDS)						COUNTY NUMBER A49915A	
ST/CO USE ONLY DATE Received		DATE WELL COMPLETED		Depth of Well		PERMIT NO. FROM "PERMIT TO DRILL WELL"	
8 13		15 20		22 26		28 29 30 31 32 33 34 35 36 37	
		112295		380 (TO NEAREST FOOT)		HO-93-0087	
OWNER		Demmitt		Richard			
STREET OR RFD		Summer Hill Dr		TOWN		W. Friendship	
SUBDIVISION		SOBUS FARMS		SECTION		LOT 19	
WELL LOG		GRROUTING RECORD		C3		PUMPING TEST	
Not required for driven wells		WELL HAS BEEN GROUTED (Circle Appropriate Box)		YES NO Y N		HOURS PUMPED (nearest hour)	
STATE THE KIND OF FORMATIONS PENETRATED, THEIR COLOR, DEPTH, THICKNESS AND IF WATER BEARING		TYPE OF GROUTING MATERIAL (Circle one)		CEMENT BENTONITE CLAY		PUMPING RATE (gal. per min.)	
DESCRIPTION (Use additional sheets if needed)		FEET		check if water bearing		METHOD USED TO MEASURE PUMPING RATE	
FROM TO						Bucket	
Sand		0 24				WATER LEVEL (distance from land surface)	
Gray Mica Rock		24 380				BEFORE PUMPING	
						WHEN PUMPING	
						TYPE OF PUMP USED (for test)	
						A air P piston T turbine	
						C centrifugal R rotary O other (describe below)	
						J jet S submersible	
						PUMP INSTALLED	
						DRILLER WILL INSTALL PUMP (CIRCLE) (YES or NO)	
						IF DRILLER INSTALLS PUMP, THIS SECTION MUST BE COMPLETED FOR ALL WELLS.	
						TYPE OF PUMP INSTALLED	
						PLACE (A,C,J,P,R,S,T,O) IN BOX 29	
						CAPACITY: GALLONS PER MINUTE (to nearest gallon)	
						PUMP HORSE POWER	
						PUMP COLUMN LENGTH (nearest ft.)	
						CASING HEIGHT (circle appropriate box and enter casing height)	
						LAND SURFACE	
						LOCATION OF WELL ON LOT	
						SHOW PERMANENT STRUCTURE SUCH AS BUILDING, SEPTIC TANKS, AND /OR LANDMARKS AND INDICATE NOT LESS THAN TWO DISTANCES (MEASUREMENTS TO WELL)	
NUMBER OF UNSUCCESSFUL WELLS: 0		WELL HYDROFRACTURED		C2		DEPTH (nearest ft.)	
yes no Y N		H0		26		380	
CIRCLE APPROPRIATE LETTER		A A WELL WAS ABANDONED AND SEALED WHEN THIS WELL WAS COMPLETED		E ELECTRIC LOG OBTAINED		P TEST WELL CONVERTED TO PRODUCTION WELL	
I HEREBY CERTIFY THAT THIS WELL HAS BEEN CONSTRUCTED IN ACCORDANCE WITH COMAR 26.04.04, "WELL CONSTRUCTION" AND IN CONFORMANCE WITH ALL CONDITIONS STATED IN THE ABOVE CAPTIONED PERMIT, AND THAT THE INFORMATION PRESENTED HEREIN IS ACCURATE AND COMPLETE TO THE BEST OF MY KNOWLEDGE.		TYPE: MWD/MSD/MGD		DRILLERS LIC. NO. 24		DRILLERS SIGNATURE	
DRILLERS SIGNATURE (MUST MATCH SIGNATURE ON APPLICATION)		LIC. NO.		SITE SUPERVISOR (sign. of driller or journeyman responsible for sitework if different from permittee)		TELESCOPE CASING	
						LOG INDICATOR	
						OTHER DATA	
						COUNTY	

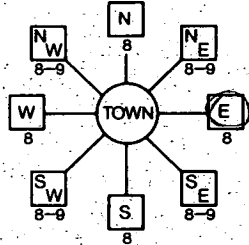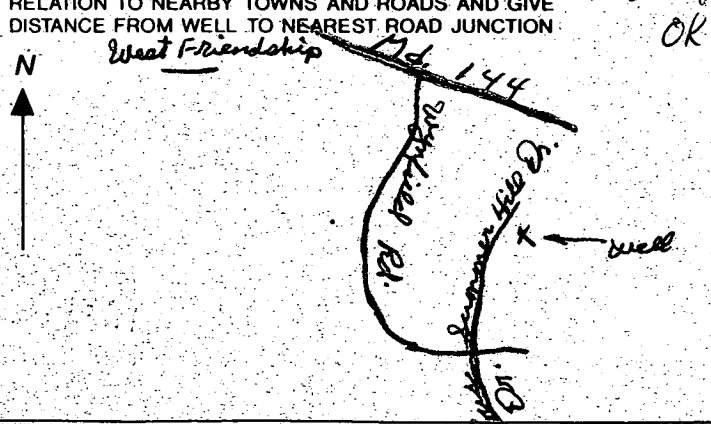B 1 1 2 3 4 5 6 1991 (THIS NUMBER IS TO BE PUNCHED IN COLS. 3-6 ON ALL CARDS)	SEQUENCE NO. (MDE USE ONLY)	STATE OF MARYLAND PERMIT TO DRILL WELL please print or type	STATE PERMIT NUMBER HO-93-0087 70 fill in this form completely 79
Date Received (APA) 102395 8 13		B 3 LOCATION OF WELL 1 2 HOWARD 8 COUNTY SOBUS FARMS 23 SUBDIVISION 42 SECTION 44 46 LOT 19 48 50 WEST FRIENDSHIP 52 NEAREST TOWN 71 MILES FROM TOWN (enter 0 if in town) 1 1/2 M I 73 76 77 78	
OWNER INFORMATION Demmitt RICHARD 15 Last Name 34 PO BOX 228 36 Street or RFD 55 CLARKSVILLE MD 21029 57 Town 70 State 72 Zip 76		B 4 DIRECTION OF WELL FROM TOWN (CIRCLE BOX) 	
DRILLER INFORMATION CIRCLE: MSD/MGD/MWD Joseph R. Mayne 24 Driller's Name 77 License No. 80 Joseph R. Mayne WELL DRILLING Firm Name 5512 Ridge Rd. Mt. Airy, Md. 21771 Address Joseph R. Mayne 10/23/95 Signature Date		NEAR WHAT ROAD Summer Hill Drive 11 30 ON WHICH SIDE OF ROAD (CIRCLE APPROPRIATE BOX) 34 37 20 DISTANCE FROM ROAD ENTER FT OR MI FT 38 39 TAX MAP: 15 BLK: _____ PARCEL 26	
B 2 WELL INFORMATION 1 2 APPROX. PUMPING RATE (GAL. PER MIN.) 5 8 12 AVERAGE DAILY QUANTITY NEEDED (GAL. PER DAY) 500 14 20		USE FOR WATER (CIRCLE APPROPRIATE BOX) ☒ HOME (SINGLE OR DOUBLE HOUSEHOLD UNIT ONLY) ☐ FARMING (LIVESTOCK WATERING & AGRICULTURAL IRRIGATION) ☐ INDUSTRIAL, COMMERCIAL, STATE AND FEDERAL GOV. OTHER (REQUIRES APPROPRIATION PERMIT) ☐ PUBLIC OR PRIVATE WATER COMPANY (REQUIRES APPROPRIATION PERMIT AND STATE HEALTH DEPARTMENT APPROVAL) ☐ TEST, OBSERVATION, MONITORING (MAY REQUIRE APPROPRIATION PERMIT)	
APPROXIMATE DEPTH OF WELL 300 FEET 24 28		NOT TO BE FILLED IN BY DRILLER HEALTH DEPARTMENT APPROVAL Howard A49915A COUNTY NAME COUNTY NO. STATE SIGNATURE Mark E. Riffkin 11/8/96 DATE ISSUED EXPI. DATE NORTH GRID 531000 EAST GRID 0818000 50 55 57 63	
APPROXIMATE DIAMETER OF WELL 6 INCH NEAREST INCH		SHOW MAJOR FEATURES OF BOX & LOCATE WELL WITH AN X SOURCES OF DRILLING WATER 1. WELL 2. 3. WRITE THE BOX NUMBER FROM THE MAP HERE E 8128 N 5321 000 000	
METHOD OF DRILLING (circle one) BORED (or Augered) <u>JETTED</u> Jetted & <u>DRIVEN</u> 30 37 AIR-ROTARY <u>AIR-PERCUSION</u> <u>ROTARY</u> (Hydraulic Rotary) CABLE <u>REVERSE-ROTARY</u> <u>DRIVE-POINT</u> other _____		1/22/95 9:30 27' CASING 24' OPEN 7 BAGS 1' CASING A.G. TAG OK OK	
REPLACEMENT OR DEEPEMED WELLS (CIRCLE APPROPRIATE BOX) ☒ THIS WELL WILL NOT REPLACE AN EXISTING WELL ☐ THIS WELL WILL REPLACE A WELL THAT WILL BE ABANDONED AND SEALED 39 ☐ THIS WELL WILL REPLACE A WELL THAT WILL BE USED AS A STANDBY-CONTACT LOCAL APPROVING AUTHORITY FOR POLICY ON STANDBY WELLS ☐ THIS WELL WILL DEEPEMED AN EXISTING WELL PERMIT NUMBER OF WELL TO BE REPLACED OR DEEPEMED (IF AVAILABLE) 41 _____ 52		DRAW A SKETCH BELOW SHOWING LOCATION OF WELL IN RELATION TO NEARBY TOWNS AND ROADS AND GIVE DISTANCE FROM WELL TO NEAREST ROAD JUNCTION 	
Not to be filled in by driller (MDE OR COUNTY USE ONLY) APPROP. PERMIT NUMBER _____ GAP _____ 54 63 FORCE MR WRITE INITIALS IN BOX PERMIT No. HO-93-0087 67 68 70 71 72 73 74 75 76 77 78 79			
SPECIAL CONDITIONS NOTE - APPROVING AUTHORITIES SHOULD USE SEPARATE SHEET IF NEEDED -			

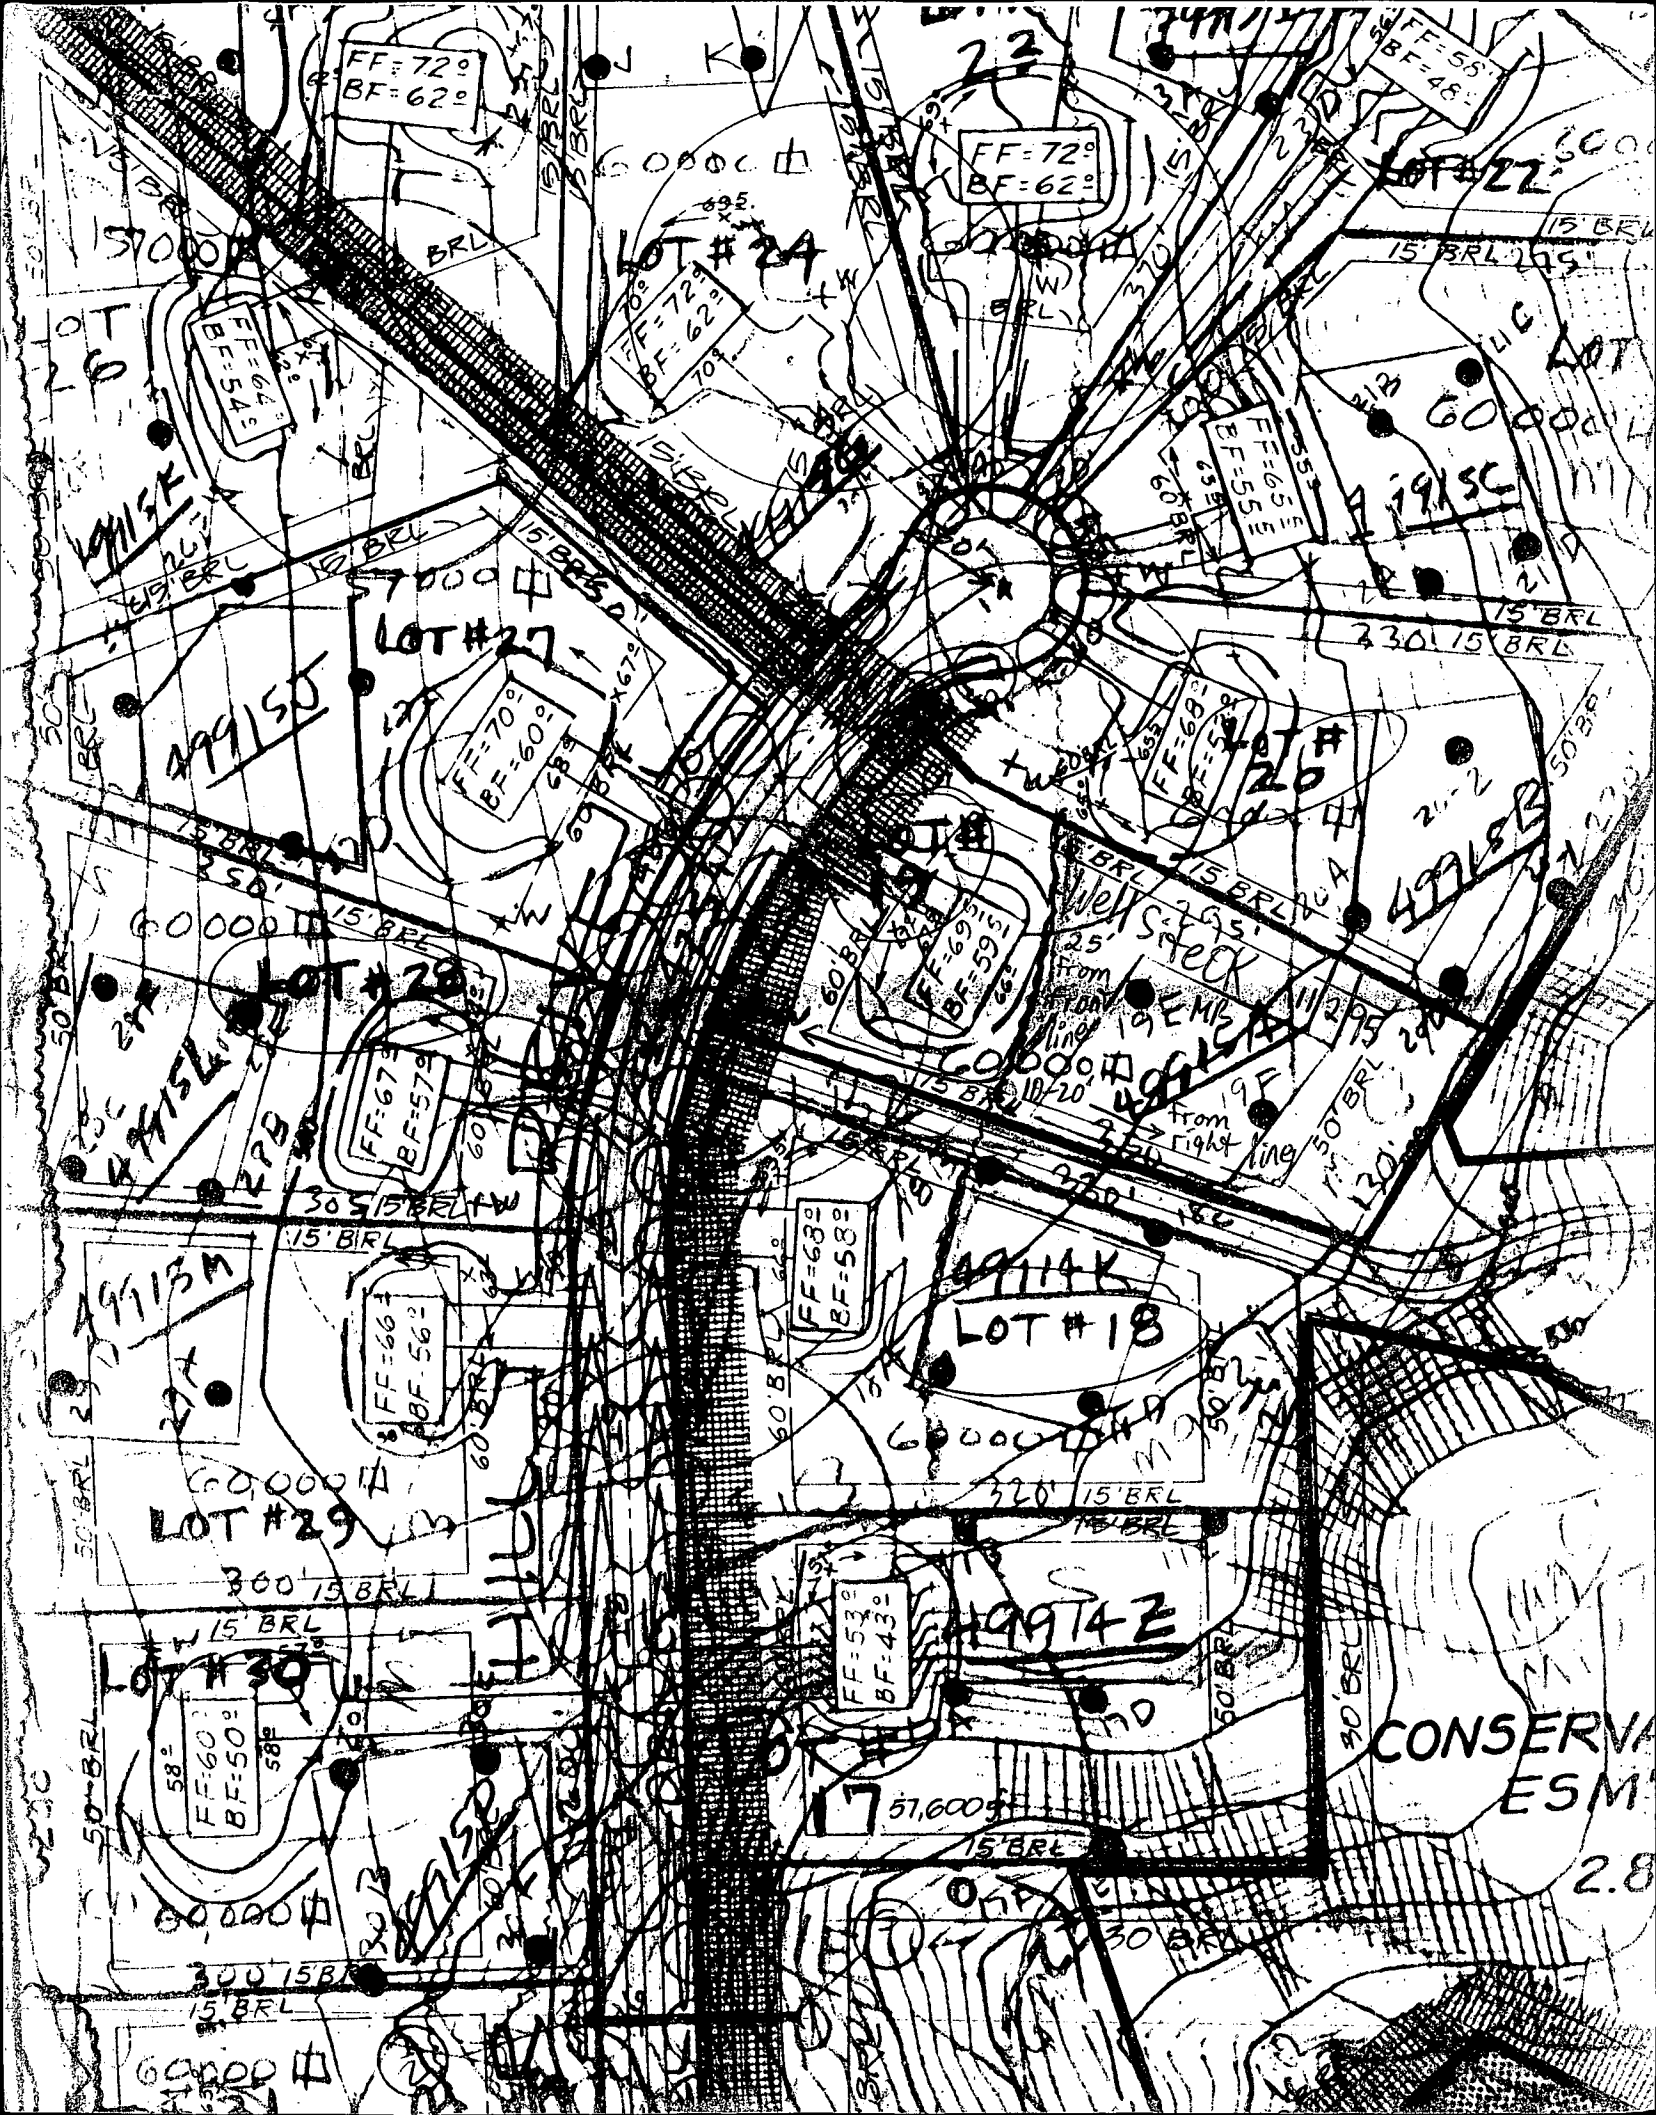

DEPARTMENT OF INSPECTIONS, LICENSES AND PERMITS 3430 COURT HOUSE DRIVE ELLICOTT CITY, MD 21043 PERMITS (410)313-2455 INSPECTIONS (410)313-1810 AUTOMATED INFORMATION (410) 313-3800	HOWARD COUNTY PERMIT APPLICATION	PERMIT NUMBER B00114944
---	-------------------------------------	----------------------------

Building Address <u>2924 Summer Hill Dr.</u> <u>West Friendship, MD 21794</u>	Owner's Name <u>Doug & Debbie Burchard</u>
Suite/Apt. #: _____ SDP/WP/Petition #: _____	Address <u>SAME</u>
Census Tract _____ Subdivision <u>Solus Farms</u>	City _____ State _____ Zip Code _____
Section _____ Area _____ Lot <u>19</u>	Home Phone <u>410-489-5120</u> Work Phone <u>410-461-7600</u>
Tax Map _____ Parcel _____ Grid _____	Applicant's Name & Mailing Address, (if other than stated hereon): _____
Zoning _____ Map Coordinates _____ Lot size _____	Phone _____ Fax _____
Existing Use <u>SFD</u>	Contractor Company <u>Coastal Builders, Inc</u>
Proposed Use <u>Detached Garage</u>	Contact Person <u>John M. Watts</u>
Estimated Construction Cost \$ <u>15,000.00</u>	Address <u>PO Box 1613</u>
Description of Work <u>Build 18'x22' Detached</u> <u>Garage</u>	City <u>Ellicott City</u> State <u>MD</u> Zip Code <u>21041</u>
Occupant or Tenant <u>OWNER</u>	License No. <u>38013</u>
Contact Name _____	Phone <u>410-461-9908</u> Fax <u>410-750-3570</u>
Address _____	Engineer or Architect Company _____
City _____ State _____ Zip Code _____	Contact Person _____
Phone _____ Fax _____	Address _____
	City _____ State _____ Zip Code _____
	Phone _____ Fax _____

BUILDING DESCRIPTION - COMMERCIAL		BUILDING DESCRIPTION - RESIDENTIAL	
<u>Building Characteristics</u>	<u>Utilities</u>	<u>Building Characteristics</u>	<u>Utilities</u>
Height: _____	Water Supply: _____	SF Dwelling ☐ SF Townhouse ☐	Water Supply: _____
No. of stories: _____	Public ☐ Private ☐	Depth _____ Width _____	Public ☐ Private ☒
Gross area, sq. ft. per floor: _____	Sewage Disposal: _____	1st floor: _____	Sewage Disposal: _____
Use group: _____	Public ☐ Private ☐	2nd floor: _____	Public ☐ Private ☒
Construction type: _____	Electric Yes ☐ No ☐	Basement: _____	Electric Yes ☒ No ☐
Reinforced Concrete _____	Gas Yes ☐ No ☐	Finished Basement ☐ Unfinished Basement ☐	Gas Yes ☐ No ☒
Structural Steel _____	Heating System: _____	Crawl space ☐ Slab on Grade ☒	Heating System: _____
Masonry _____	Electric ☐ Oil ☐	No. of Bedrooms _____	Electric ☐ Oil ☐
Wood Frame _____	Natural Gas ☐	Multi-family dwellings: _____	Natural Gas ☐
State Certified Modular _____	Propane Gas ☐	No. of efficiency units: _____	Propane Gas ☐ <u>NONE</u>
	Sprinkler system: N/A ☐	No. of 1 BR units: _____	Heating System: _____
	NFPA #13 _____	No. of 2 BR units: _____	Electric ☐ Oil ☐
	Full _____	No. of 3 BR units: _____	Natural Gas ☐
	Partial _____	Other: <u>Garage (detached)</u>	Propane Gas ☐ <u>NONE</u>
	Other Suppression _____	Dimensions: <u>18'x22'</u>	Sprinkler system: N/A ☐
		Footings: <u>8" CONC</u>	NFPA #13D _____
		Roof: <u>A</u>	NFPA #13R _____
		State Certified Modular _____	Other: _____
		Manufactured Home _____	

THE UNDERSIGNED HEREBY CERTIFIES AND AGREES AS FOLLOWS: (1) THAT HE/SHE IS AUTHORIZED TO MAKE THIS APPLICATION; (2) THAT THE INFORMATION IS CORRECT; (3) THAT HE/SHE WILL COMPLY WITH ALL REGULATIONS OF HOWARD COUNTY WHICH ARE APPLICABLE THERETO; (4) THAT HE/SHE WILL PERFORM NO WORK ON THE ABOVE REFERENCED PROPERTY NOT SPECIFICALLY DESCRIBED IN THIS APPLICATION; (5) THAT HE/SHE GRANTS COUNTY OFFICIALS THE RIGHT TO ENTER ONTO THIS PROPERTY FOR THE PURPOSE OF INSPECTING THE WORK PERMITTED AND POSTING NOTICES.

John M. Watts
Applicant's Signature
John M. Watts
Print Name
President, Coastal Builders, Inc.
Title/Company
11/4/98
Date


Checks payable to: DIRECTOR OF FINANCE OF HOWARD COUNTY
** PLEASE WRITE NEATLY AND LEGIBLY. **

- FOR OFFICE USE ONLY -

AGENCY	DATE	SIGNATURE APPROVAL	DPZ SETBACK INFORMATION	PROPERTY ID#:
Land Development, DPZ			Front: _____	Filing Fee \$ _____
State Highways			Rear: _____	Permit Fee \$ _____
Building Official			Side: _____	(.10 sq. ft. ☐ (.15 sq. ft. ☐)
Dev. Engineering, DPZ			Side St.: _____	Excise Tax \$ _____
Health	<u>11/5/98</u>	<u>Jim Maisto</u>	All minimum setbacks met?	(.40 sq. ft. ☐ (.80 sq. ft. ☐)
Fire Protection			YES ☐ NO ☐	TOTAL FEES _____
Is Sediment Control approval required prior to issuance?			Is Entrance Permit required?	Check # _____
YES ☐ NO ☐			YES ☐ NO ☐	Validation # _____
CONTINGENCY CONSTRUCTION START: ☐			Historic District?	Accepted by: _____
ONE STOP SHOP: ☐			YES ☐ NO ☐	
			Lot Coverage for New Town Zone _____	
			SDP/Red-line approval date _____	

BURCHARDT - LOT 19

PRESERVATION PARCEL A

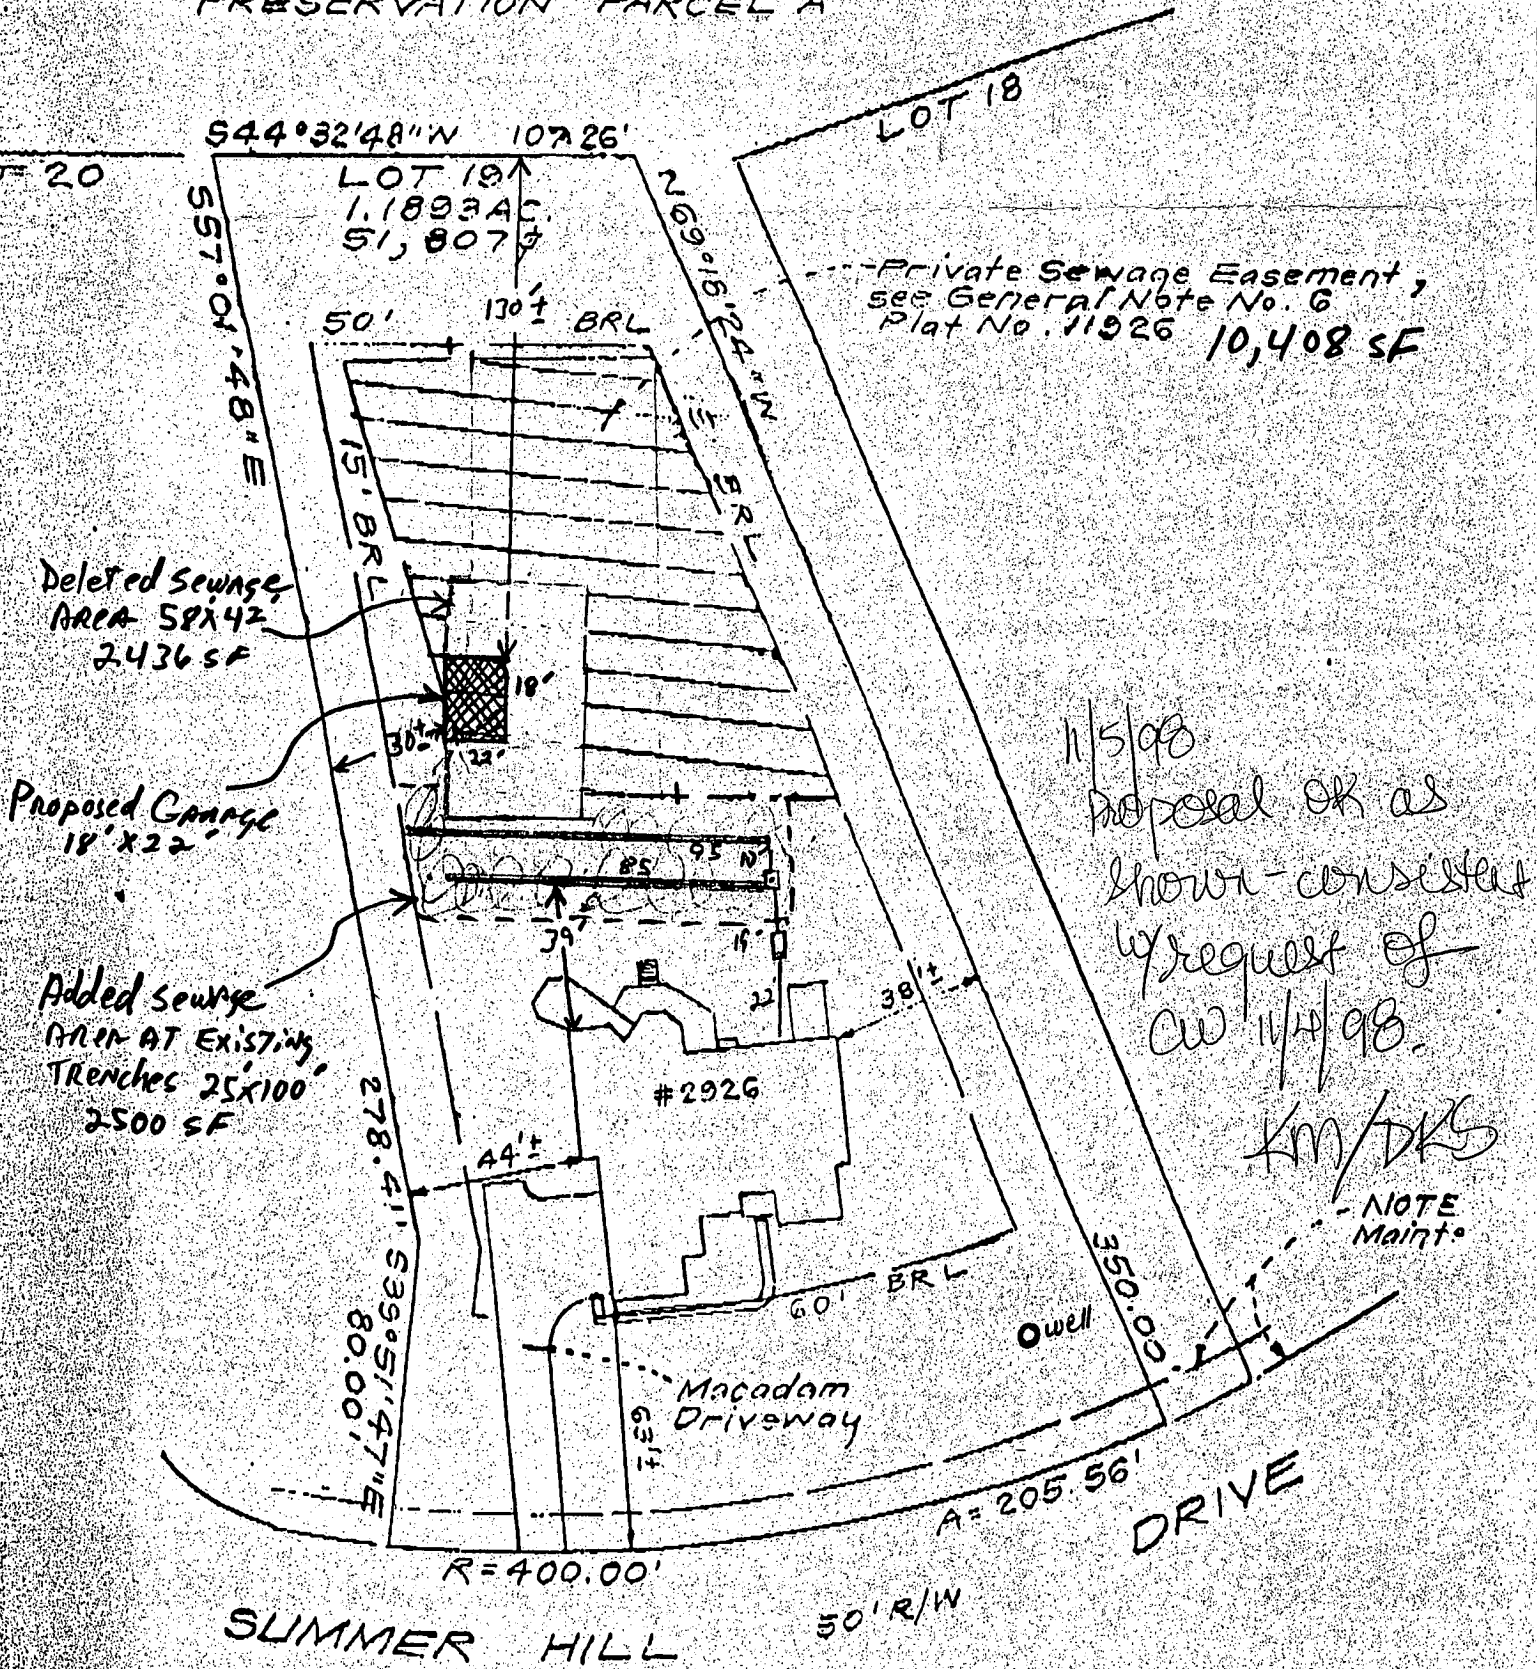


11/5/98
 Proposal OK as
 shown - consistent
 by request of
 CW 11/4/98.

Km/DKS

NOTE
 Mainto

SCALE 50' = 1"

Burchardt Garage
 2926 Summer Hill Dr.
 West Friendship, MD 21794
 Coastal Builders, Inc.
 410-461-9908

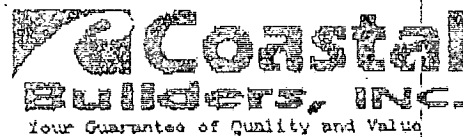

P.O. Box 1613, Ellicott City, Maryland 21041-1613
Telephone: 410-461-9908 Fax: 410-750-3570

FAX COVER SHEET

Attn: Craig Williams Fax #: 313-2688
Company: Bureau of Environmental Health Date: 11/5/98
Number of pages including cover sheet 2


Description or message:

Mr. Williams - here is the revised site plan per our conversation yesterday RE Sobus Farms lot #19, showing the "as built" trenches and adding the area they encumpane. I have deleted the area of the buildings and a 20' buffer around it. Making the original area yielded 10,408 SF. We are adding 2436 SF where the existing trenches are and deleting 2436 SF for the garage. The new total sewage area is now 10,472 SF, or virtually identical to the area initially. I just want to make sure this will fly so I can get the permit today. Please page me at 410-582-7850 to discuss this when

From: you get it

Thanks,
Alan M. Watts


PRESERVATION PARCEL A

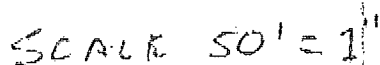

Coastal Builders, Inc.
410-461-5508

BURCHARDT - LOT 19

PRESERVATION PARCEL A

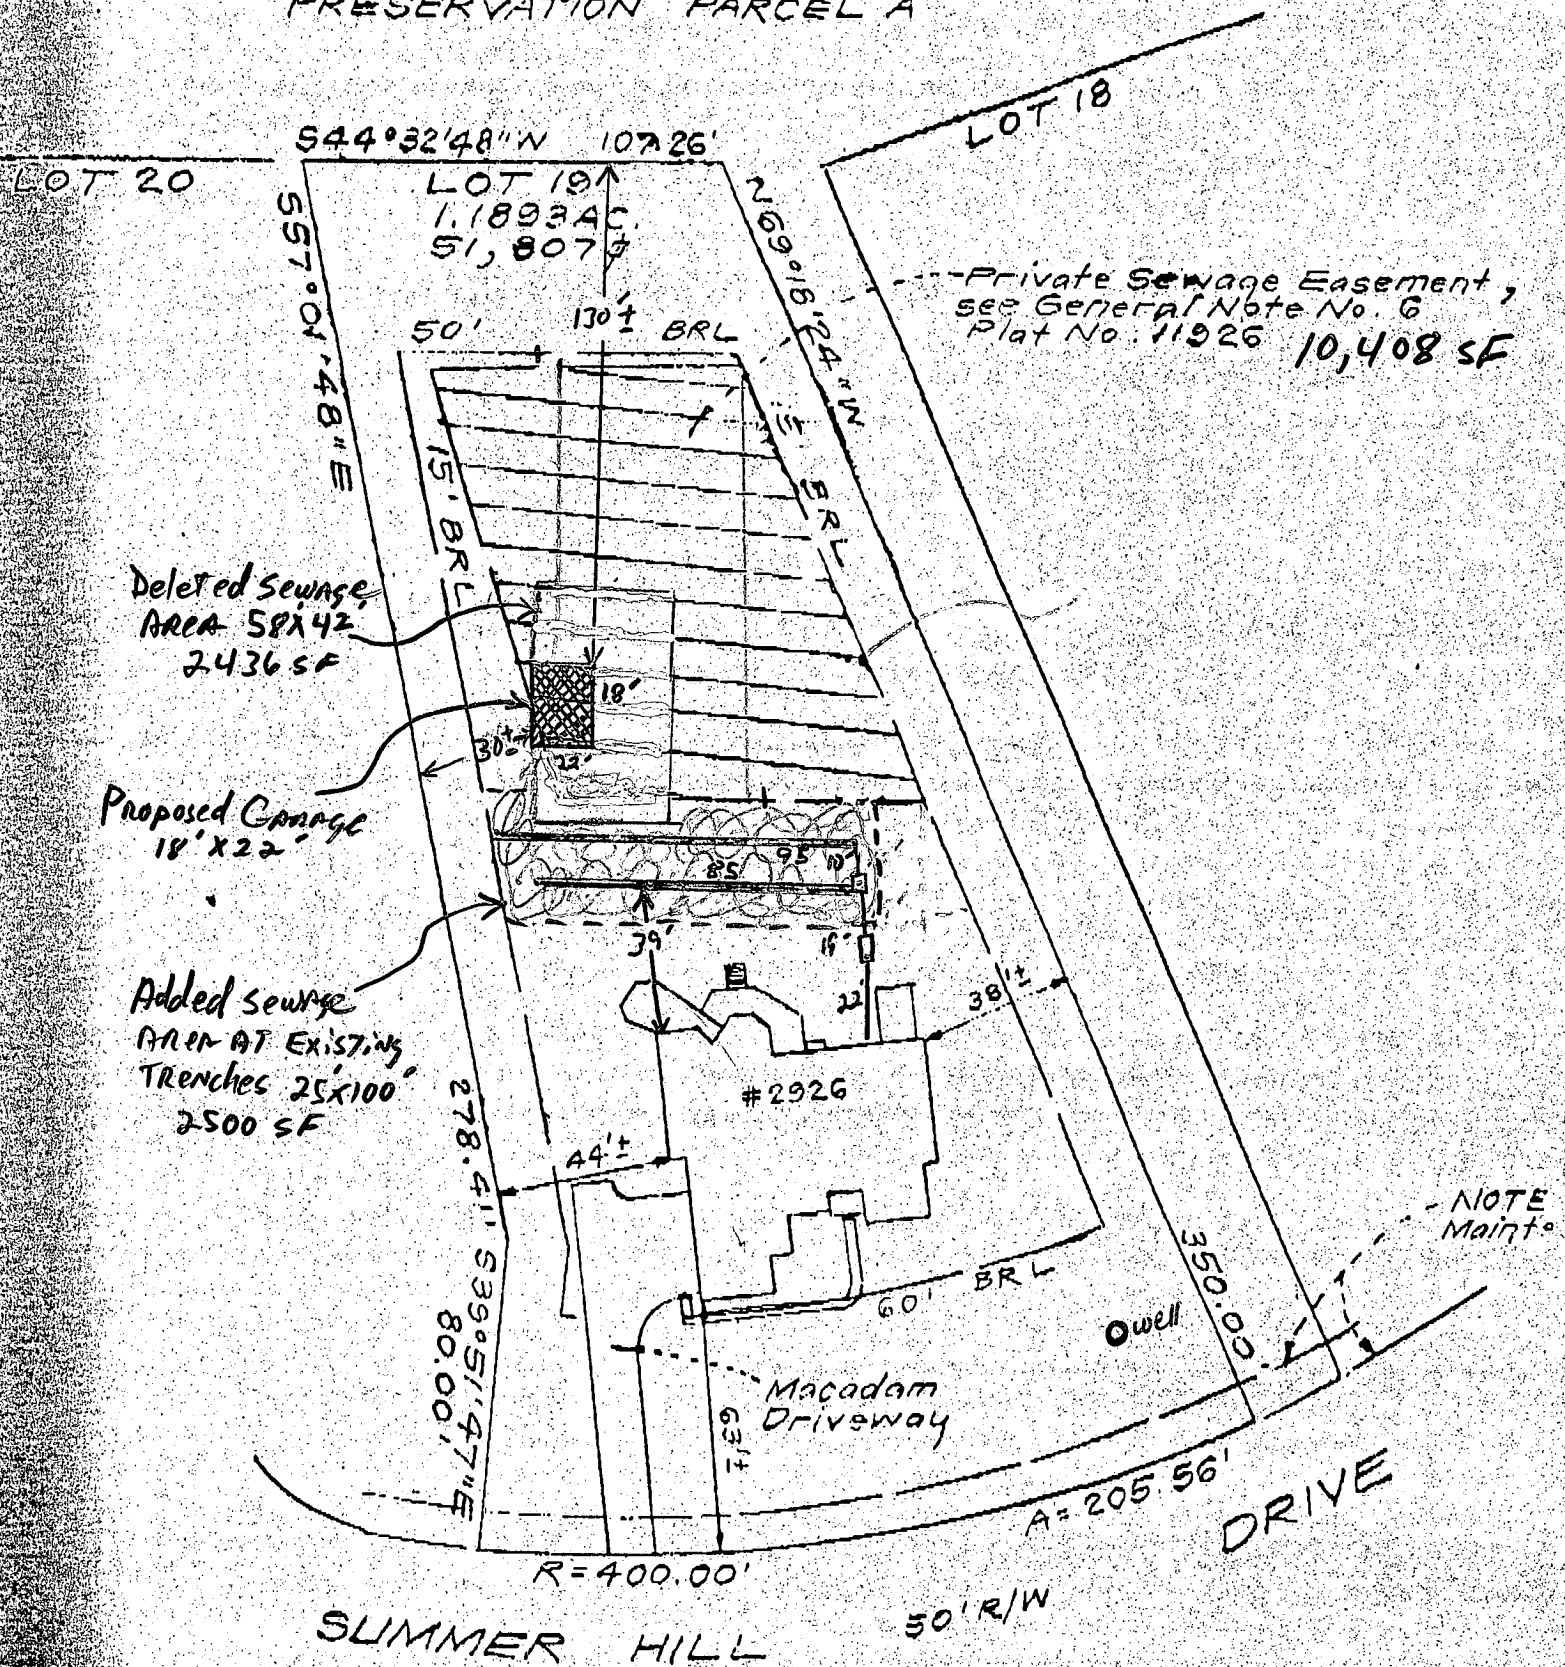

Burchardt Garage
2926 Summer Hill Dr.
West Friendship, MD 21794
Constal Builders, Inc.
410-461-9908