

PERMIT

SEWAGE DISPOSAL SYSTEM

DEPARTMENT OF HEALTH AND MENTAL HYGIENE

HOWARD COUNTY HEALTH DEPARTMENT
BUREAU OF ENVIRONMENTAL HEALTH
XXXX-XXXX 410-313-2640

P 57553-B

A 49915-K

DISTRICT 3rd

DATE 11-14-96

DATE SYSTEM APPROVED 10/10/97

INSPECTOR [Signature]

INDEXED
03-319454

South Carroll Backhoe, Inc.

IS PERMITTED TO INSTALL ☒ ALTER

ADDRESS 4410 Salem Bottom Road, Westminster, Maryland 21157 PHONE 410-875-4197

SUBDIVISION Sobus Farms LOT 26 ROAD 2929 Summer Hill Drive

PROPERTY OWNER SCOTT RICTER Altieri Homes W. FRIENDSHIP 21794

ADDRESS 5410 442-4471

SEPTIC TANK CAPACITY 1250 GALLONS

NUMBER OF BEDROOMS 4

180 SQUARE FEET PER BEDROOM

LINEAR FEET OF TRENCH REQUIRED 180

TRENCHES - Trench to be 2 feet wide. Inlet 3.5 feet below original grade. Bottom maximum depth 7.5 feet below original grade. Effective area begins at 3.5 feet below original grade. 4 feet of stone below distribution pipe.

LOCATION - Place distribution box 345 feet up the right (562.03') lot line and 75 feet off that same lot line as seen when facing the lot from Summer Hill Drive. Run trenches on contour toward the 562.03 lot line.

NOTES - No trench to exceed 100 feet in length. Provide 6" - 8" diameter cleanout and cap to grade or above on septic tank.

PLANS APPROVED BY C. Williams/Kim Maiste/Mark Rifkin 0/5 of 8-5-97 REVISED DATE 08/04/97

COVER NO WORK UNTIL INSPECTED AND APPROVED

NEITHER THE HOWARD COUNTY COUNCIL NOR THE HEALTH DEPARTMENT IS RESPONSIBLE FOR THE SUCCESSFUL OPERATION OF ANY SYSTEM

NOTE: CLEANOUT REQUIRED EVERY 70 FEET OF SEWER LINE AND/OR AT 90° SWEEPS IN LINES FROM HOUSE TO DRAIN FIELDS, 90° ELBOWS NOT ACCEPTABLE.

NOTE: ALL PARTS OF SEPTIC SYSTEMS (I.E. TANK, DISTRIBUTION BOX TRENCHES) TO BE 100 FEET FROM WELL (UNLESS OTHERWISE SPECIFICALLY AUTHORIZED)

NOTE: IF DEEP TRENCH(ES) ARE USED CALL FOR INSPECTION BEFORE AND AFTER PLACING GRAVEL IN TRENCH(ES) 300/28751

NOTE: NO DRY WELL SHALL EXCEED 15 FOOT IN DIAMETER NO ABSORPTION TRENCH TO EXCEED 100 FEET IN LENGTH

NOTE: ALL PIPE FROM HOUSE TO SEPTIC TANK MUST BE CAST IRON OR SCHEDULE 35/40 PVC OR ABS

PERMIT VOID AFTER TWO YEARS


NOTE: INSTALL STAND PIPE ON SEPTIC TANK AND DRY WELL STAND PIPES MUST BE 6 INCHES IN DIAMETER CAST IRON. CONCRETE OR TERRA COTTA OR PVA OR ABS ACCEPTED. IF TOP OF SEPTIC TANK IS DEEPER THAN 3 FEET. MANHOLE TO GRADE REQUIRED.

NOTE: DISTRIBUTION BOXES MUST HAVE BAFFLES

*INSTALLER IS RESPONSIBLE FOR OBTAINING FINAL APPROVAL ON THIS PERMIT

OLD PERMIT SIGNED
AND RETURNED 3/8/2001
300/28751
ADDITION W/ FAMILY ROOM
BASEMENT
OLD PERMIT SIGNED
AND RETURNED 7-15-98
Serial # B1112988

A 49915-K

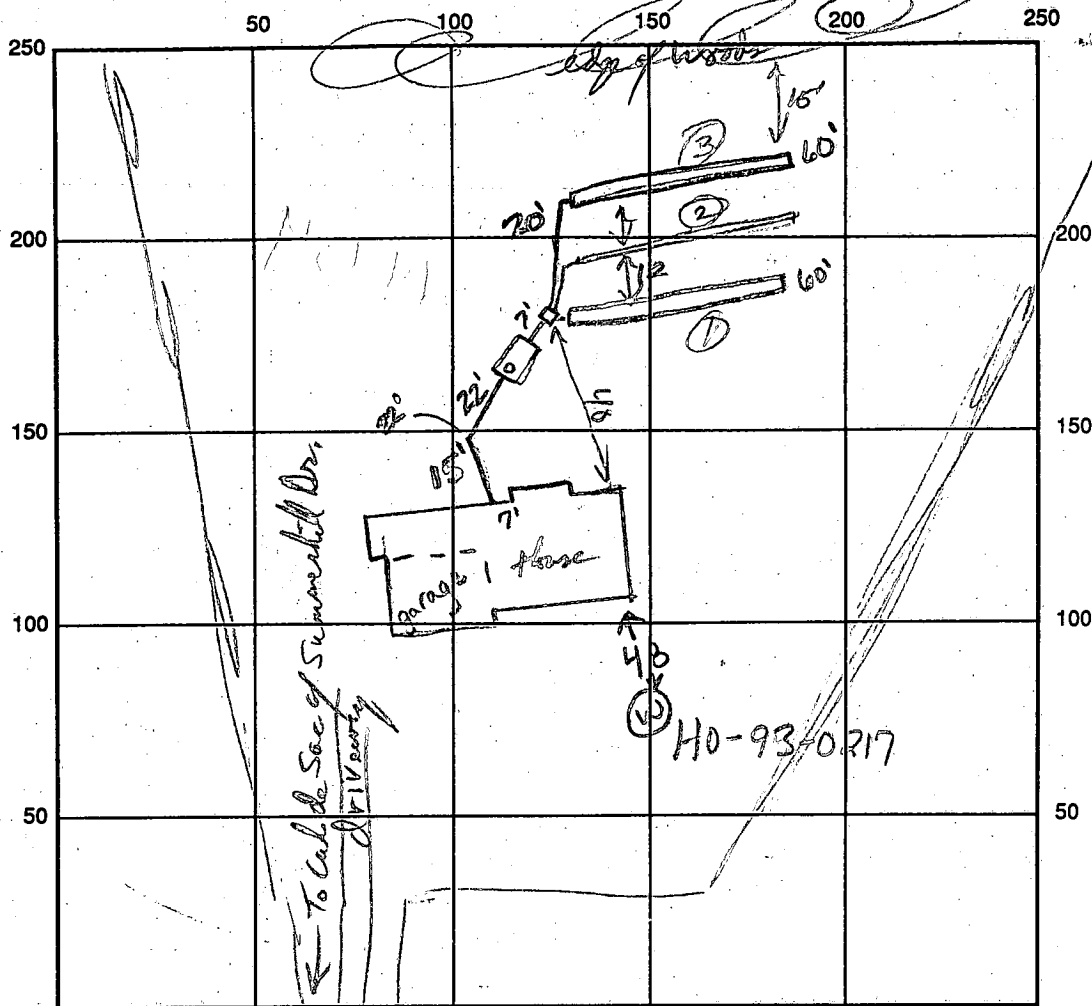

INDICATE NORTH - NAME ADJOINING ROADWAY AS BASE LINE

SEPTIC TANK LEVEL OK, 1250 gallons CLEANOUTS 1 on tank
 DISTRIBUTION BOX LEVEL OK, baffle in
 DRAIN FIELD/TITLE DEPTH 7.5 FT. TRENCH WIDTH 2 FT. INLET DEPTH 3.5 FT.
 EFFECTIVE GRAVEL DEPTH 4.0 FT. TOTAL LENGTH 60/60/60 FT.
 NUMBER OF TRENCHES _____ ONE SIDEWALL/BOTTOM AREA _____ SQ. FT.
 DRYWALL INSIDE DIAMETER _____ FT. EFFECTIVE DEPTH BELOW INLET _____ FT.
 ABSORBENT AREA _____ SQ. FT.

REMARKS: 10/9/97 has house conn. OK to continue (KM)
10/9/97 OK to color up to distribution box (KM) N. & S. 10/10/97
Last trench OK to cover 10/10/97 HP.
1-9-98 TC w/ KEN SCHWISLER / S. CARROLL BACKHOE, HE RE ATTACHED LOOSE
CLEANOUT ON S.T., AND CEMENTED CAP FOR ODOR CONTROL. SEE COMPANY IN FILE. KEN FEELS
THAT ODOR MAY BE DUE TO HANDSOME AND WEATHER CONDITIONS, LOCATION OF VENT. HP

DATE SYSTEM APPROVED 10/10/97 INSPECTOR HP

3/30/98 SEPTIC TANK CLEANOUT REPAIRED. CHECKED FOR ODOR, RECOMMENDED BY OWNER. HAVE FOUND
OTHER THAN MUSTY SMELL IN TOWER TANKS, TANKS HAVE SOME FINE SAND / SILT IN BOTTOM.

APPLICATION

PERCOLATION TESTING

A 49915K

P _____

HOWARD COUNTY HEALTH DEPARTMENT

BUREAU OF ENVIRONMENTAL HEALTH

3525-H ELLICOTT MILLS DRIVE/ELLICOTT CITY, MARYLAND 21043
TELEPHONE: 313-2640

DISTRICT 3

DATE 3/9/94

TO: THE COUNTY HEALTH OFFICER
ELLICOTT CITY, MARYLAND

I HEREBY APPLY FOR THE NECESSARY TEST PRIOR TO APPLICATION FOR PERMIT TO CONSTRUCT (OR RECONSTRUCT) A SEWAGE DISPOSAL SYSTEM.

PROPERTY OWNER Hittop Development Corporation Altick Homes

ADDRESS P.O. Box 208, Clarksville, Md. 21029 PHONE 410-531-5539

AGENT OR PROSPECTIVE BUYER Richard Demmitt

ADDRESS P.O. Box 208, Clarksville, Md. 21029 PHONE 410-531-5539

PROPERTY LOCATION:

SUBDIVISION Sobus Farms LOT NO. 26 (Twenty-six)

ROAD AND DESCRIPTION at the end of Winfield Rd.
(2929 Summer Hill Drive)

TAX MAP 15 PARCEL # 26 d 154

SIZE OF LOT 1 acre + TYPE BLDG. S.F.D - 4 Bm
(SINGLE FAMILY DWELLING OR COMMERCIAL)

OLDG. PERMIT SIGNED

AND RETURNED 8-4-97

Serial # BR106954

THE SYSTEM INSTALLED UNDER THIS APPLICATION IS ACCEPTABLE ONLY UNTIL PUBLIC FACILITIES BECOME AVAILABLE. I FULLY UNDERSTAND THE
FEE CONNECTED WITH THE FILING OF THIS PERC TEST APPLICATION IS NON-REFUNDABLE UNDER ANY CIRCUMSTANCES. I ALSO AGREE TO
COMPLY WITH ALL M.O.S.H.A. REQUIREMENTS IN TESTING THIS LOT.

Richard Demmitt
(SIGNATURE OF APPLICANT)

APPROVED BY _____ FOR _____ DATE _____

DISAPPROVED BY _____ FOR _____ DATE _____

HOLD PENDING FURTHER TESTS _____

REASONS FOR REJECTION OR HOLDING _____

PERCOLATION TEST PLAT/PRELIMINARY PLAT - TITLE OR I.D. # _____ DATE _____

SITE DEVELOPMENT PLAN/FINAL PLAT - TITLE OR I.D. # _____ DATE _____

THIS IS NOT A PERMIT

A49915 K

COUNTY #

SOIL PROFILE


0' F
bright red CL
3 1/2' tan/brn SL mica shale <5% (black shale)
12'

E

3' bright red CL
red/brn SL mica 5% saprolite & shale mix OK
11 1/2'

C

3 1/2' orange/brn CSL
tan/brn SL mica some shale <5% OK
12'

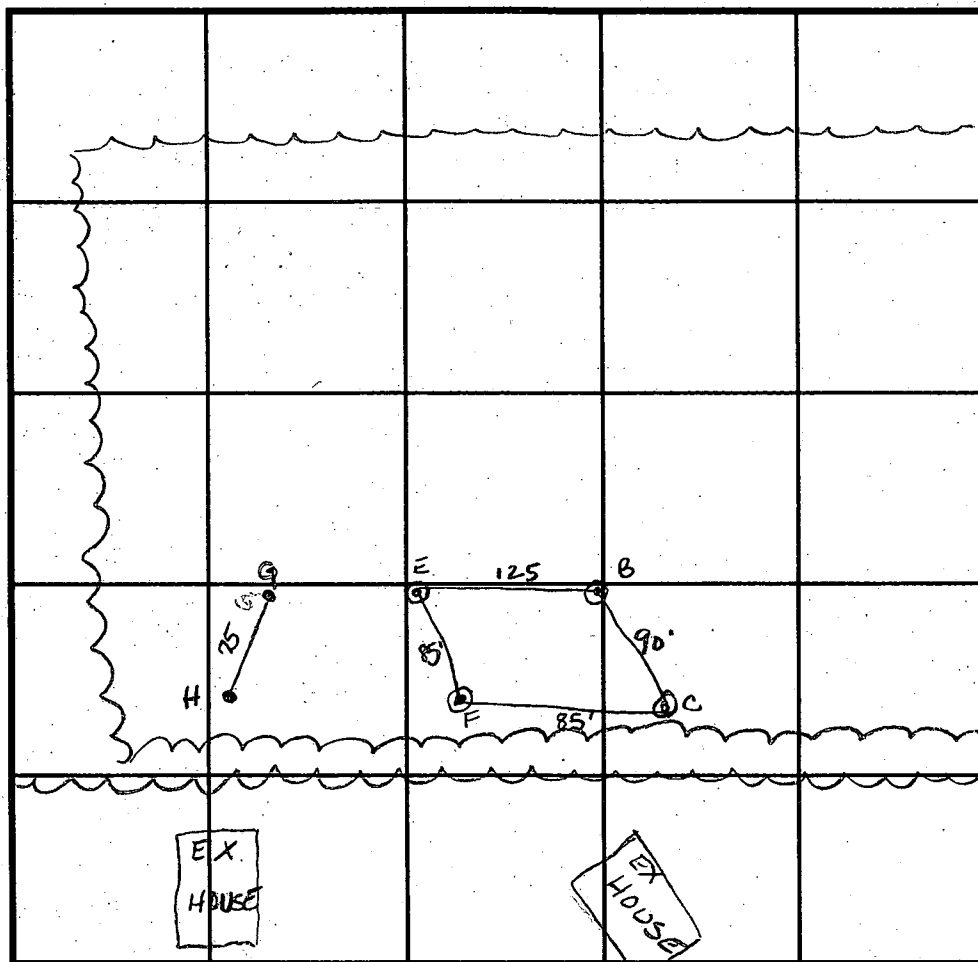

INDICATE NORTH - NAME ADJOINING ROADWAY AS BASE LINE.

SOIL PROFILE

0' B
brn/orange CL
2 1/2' lg+ grey/brn SL shale frags <5% large mica frags also
12'

DATE	TEST NO.	DEPTH	PRE-WET START	PRE-WET STOP	TEST - 1" DROP START	TEST - 1" DROP STOP	TIME
3/24/94	F	4' V12	11:45	11:46	11:46	11:47	1 min
	E	4' VII 1/2	11:49	11:49 ⁴⁵	11:49 ⁴⁵	11:50 ³⁰	45 sec
		repour	11:51 ¹⁵	11:52 ³⁰	11:52 ³⁰	11:53 ⁴⁵	1 1/4 min
	B	3' V12	11:19	11:21	11:21	11:23	2 min
		6' V12	11:18 ³⁰	11:19	11:19	11:19 ³⁰	30 sec
	C	7' V12	11:28 ³⁰	11:30	11:30	11:31 ⁴⁵	1 3/4 min
		4 1/2' V12	11:30 ¹⁵	11:32	11:32	11:37	5 min
9-21-94	G	2' 8" V12.5	1:04	1:05 ³⁰	1:05 ³⁰	1:07 ³⁰	2 min DICKS
	H	5' V12.5	1:04 ³⁰	1:05 ³⁰	1:05 ³⁰	1:07	1 1/2 min

REMARKS

TYPE OF SOIL ChB₂ Chester Silt loam

TESTED BY A. McMullen / M. Rifkin ALSO PRESENT R. Demuth

TRENCH DESIGN DATA: AVERAGE PERCOLATION TIME 2 min TRENCH WIDTH 2'

INLET DEPTH 3 1/2' MAXIMUM BOTTOM DEPTH 7 1/2' SQ. FT./BEDROOM 180 ft²

EMERGENCY/TEMP NO. IF ANY

B 1 1946		SEQUENCE NO. (MDE USE ONLY)		STATE OF MARYLAND PERMIT TO DRILL WELL please print or type		STATE PERMIT NUMBER H0-93-0217 70 fill in this form completely 79	
Date Received (APA) 11-27-95				OWNER INFORMATION			
Demmitt RICHARD				PO BOX 228			
CLARKSVILLE				MD 21029			
DRILLER INFORMATION				CIRCLE: MSD/MGD/WMD			
Joseph L. Mayne				24			
Joseph L. Mayne Well Drilling				5512 Ridge Rd. Mt. Airy MD. 21771			
Joseph L. Mayne 11/27/95							
B 2		WELL INFORMATION					
APPROX. PUMPING RATE (GAL. PER MIN.)		5					
AVERAGE DAILY QUANTITY NEEDED (GAL. PER DAY)		500					
USE FOR WATER (CIRCLE APPROPRIATE BOX)							
☒ HOME (SINGLE OR DOUBLE HOUSEHOLD UNIT ONLY)							
☐ FARMING (LIVESTOCK WATERING & AGRICULTURAL IRRIGATION)							
☐ INDUSTRIAL, COMMERCIAL, STATE AND FEDERAL GOV. OTHER (REQUIRES APPROPRIATION PERMIT)							
☐ PUBLIC OR PRIVATE WATER COMPANY (REQUIRES APPROPRIATION PERMIT AND STATE HEALTH DEPARTMENT APPROVAL)							
☐ TEST, OBSERVATION, MONITORING (MAY REQUIRE APPROPRIATION PERMIT)							
APPROXIMATE DEPTH OF WELL		300 FEET					
APPROXIMATE DIAMETER OF WELL		6 INCH					
METHOD OF DRILLING (circle one)							
☒ BORED (or Augered)		☐ JETTED					
☒ AIR-ROTARY		☐ AIR-PERCussion					
☐ CABLE		☐ ROTARY (Hydraulic Rotary)					
☐ other		☐ REVERSE-ROTARY					
☐ DRIVE-POINT							
REPLACEMENT OR DEEPEINED WELLS (CIRCLE APPROPRIATE BOX)							
☒ THIS WELL WILL NOT REPLACE AN EXISTING WELL							
☐ THIS WELL WILL REPLACE A WELL THAT WILL BE ABANDONED AND SEALED							
☐ THIS WELL WILL REPLACE A WELL THAT WILL BE USED AS A STANDBY-CONTACT LOCAL APPROVING AUTHORITY FOR POLICY ON STANDBY WELLS							
☐ THIS WELL WILL DEEPEIN AN EXISTING WELL							
PERMIT NUMBER OF WELL TO BE REPLACED OR DEEPEINED (IF AVAILABLE)							
Not to be filled in by driller (MDE OR COUNTY USE ONLY)							
APPROX. PERMIT NUMBER		GAP					
FORCE		WRITE INITIALS IN BOX					
PERMIT No.		H0-93-0217					
SPECIAL CONDITIONS		NOTE - APPROVING AUTHORITIES SHOULD USE SEPARATE SHEET IF NEEDED -					

LOCATION OF WELL
8 COUNTY: HOWARD
23 SUBDIVISION: SOBYS FARMS
SECTION: 44 LOT: 26
52 NEAREST TOWN: WESTERLENDOSH
MILES FROM TOWN (enter 0 if in town): 1.5 MI
DIRECTION OF WELL FROM TOWN (CIRCLE BOX)

11 NEAR WHAT ROAD: Summer Hill Dr.
ON WHICH SIDE OF ROAD (CIRCLE APPROPRIATE BOX): 34 260 37
DISTANCE FROM ROAD: ENTER FT. OR MI: 1.5
TAX MAP: BLK: PARCEL:
NOT TO BE FILLED IN BY DRILLER HEALTH DEPARTMENT APPROVAL
COUNTY NAME: HOWARD COUNTY NO.: A49915K
STATE SIGNATURE: DATE ISSUED: 12/11/95
CO SIGNATURE: 12/10/96
NORTH GRID: 531000 EAST GRID: 0817000
SHOW MAJOR FEATURES OF BOX & LOCATE WELL WITH AN X
SOURCES OF DRILLING WATER:
1. WELL
2.
3.
WRITE THE BOX NUMBER FROM THE MAP HERE:
E 810.7
N 5301
DRAW A SKETCH BELOW SHOWING LOCATION OF WELL IN RELATION TO NEARBY TOWNS AND ROADS AND GIVE DISTANCE FROM WELL TO NEAREST ROAD JUNCTION:
N West Friendship
MD 44
Sobys Dr.
Summer Hill Dr.
1.5 mi

COUNTY

C1 1699

SEQUENCE NO.
(DENV USE ONLY)STATE OF MARYLAND
WELL COMPLETION REPORT
FILL IN THIS FORM COMPLETELY
PLEASE PRINT OR TYPETHIS REPORT MUST BE SUBMITTED WITHIN
45 DAYS AFTER WELL IS COMPLETED.COUNTY
NUMBER

A 49915 K

(THIS NUMBER IS TO BE PUNCHED
IN COLS. 3-8 ON ALL CARDS)ST/CO USE ONLY
DATE Received

8 13

DATE WELL COMPLETED

01/17/96

Depth of Well

22 520 26
(TO NEAREST FOOT)PERMIT NO.
FROM "PERMIT TO DRILL WELL"

HD-93-0217

OWNER Demmitt
STREET OR RFD Summer Hill Dr
SUBDIVISION Sabys FARMSfirst name Richard

TOWN

West Friendship

SECTION

LOT

26

WELL LOG

Not required for driven wells

STATE THE KIND OF FORMATIONS
PENETRATED, THEIR COLOR, DEPTH,
THICKNESS AND IF WATER BEARINGDESCRIPTION (Use
additional sheets if needed)FEET
FROM TOCheck
if water
bearing

Sand
Gray Mica
Rock

0 49
49 520

GROUTING RECORD

WELL HAS BEEN GROUTED.
(Circle Appropriate Box)yes ☒ no ☐
Y N

TYPE OF GROUTING MATERIAL

CEMENT ☒ BENTONITE CLAY ☐NO. OF BAGS 20 NO. OF POUNDS 1880GALLONS OF WATER 120
DEPTH OF GROUT SEAL (to nearest foot)from 0 ft. to 49 ft.
48 52 TOP 54 BOTTOM 58
(enter 0 if from surface)

CASING RECORD

casing
types
insert
appropriate
code
belowST CO
STEEL CONCRETE
PL OT
PLASTIC OTHERMAIN CASING TYPE Nominal diameter
top (main) casing
(nearest inch)Total depth
of main casing
(nearest foot)ST 6 52
60 61 63 64 66 70OTHER CASING (if used)
diameter depth (feet)
inch from to

EACH CASING

screen type
or open hole
insert
appropriate
code
below

SCREEN RECORD

ST BR HO
STEEL BRASS OPEN
PL BRONZE HOLE
PLASTIC OTHERIN HARD ROCK AREAS, IDENTIFY SPECIFICALLY
WHERE SATURATED FRACTURES WERE OBSERVED.

WELL HYDROFRACTURED

yes ☐ no ☒
Y N

CIRCLE APPROPRIATE LETTER

A A WELL WAS ABANDONED AND SEALED
WHEN THIS WELL WAS COMPLETED

E ELECTRIC LOG OBTAINED

P TEST WELL CONVERTED TO PRODUCTION
WELLI HEREBY CERTIFY THAT THIS WELL HAS BEEN CONSTRUCTED IN
ACCORDANCE WITH COMAR 26.04.04 "WELL CONSTRUCTION"
AND IN CONFORMANCE WITH ALL CONDITIONS STATED IN THE
ABOVE CAPTIONED PERMIT, AND THAT THE INFORMATION PRE-
SENTED HEREIN IS ACCURATE AND COMPLETE TO THE BEST OF
MY KNOWLEDGE.DRILLERS IDENT. NO. 24

DRILLERS SIGNATURE

(MUST MATCH SIGNATURE ON APPLICATION)

SITE SUPERVISOR (sign. of driller or journeyman
responsible for sitework if different from permittee)GRAVEL PACK
IF WELL DRILLED WAS
FLOWING WELL INSERT
F IN BOX 68MDE USE ONLY
(NOT TO BE FILLED IN BY DRILLER)

T (E.R.O.S.)

70 72

TELESCOPE
CASINGLOG
INDICATOR

W Q

74 75 76

OTHER DATA

C 3

PUMPING TEST

HOURS PUMPED (nearest hour) 6PUMPING RATE (gal. per min. 2
to nearest gal.)METHOD USED TO
MEASURE PUMPING RATE Bucket

WATER LEVEL (distance from land surface)

BEFORE PUMPING 37WHEN PUMPING 366

TYPE OF PUMP USED (for test)

A air P piston T turbine


C centrifugal R rotary O other
(describe below)

J jet S submersible


PUMP INSTALLED

DRILLER WILL INSTALL PUMP YES ☒ NO ☐IF DRILLER INSTALLS PUMP, THIS SECTION
MUST BE COMPLETED FOR ALL WELLS
EXCEPT HOME USE
TYPE OF PUMP INSTALLED
PLACE (A,C,J,P,R,S,T,O)
IN BOX - SEE ABOVE:CAPACITY:
GALLONS PER MINUTE 31
(to nearest gallon)PUMP HORSE POWER 37PUMP COLUMN LENGTH
(nearest ft.) 43CASING HEIGHT (circle appropriate box
and enter casing height)+ above } LAND SURFACE 1 (nearest
- below } foot)

LOCATION OF WELL ON LOT

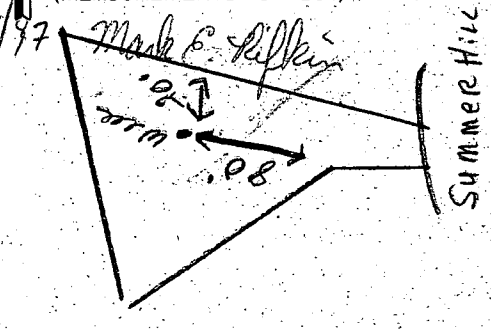SHOW PERMANENT STRUCTURE SUCH AS
BUILDING, SEPTIC TANKS, AND/OR
LANDMARKS AND INDICATE NOT LESS
THAN TWO DISTANCES
(MEASUREMENTS TO WELL)

COUNTY

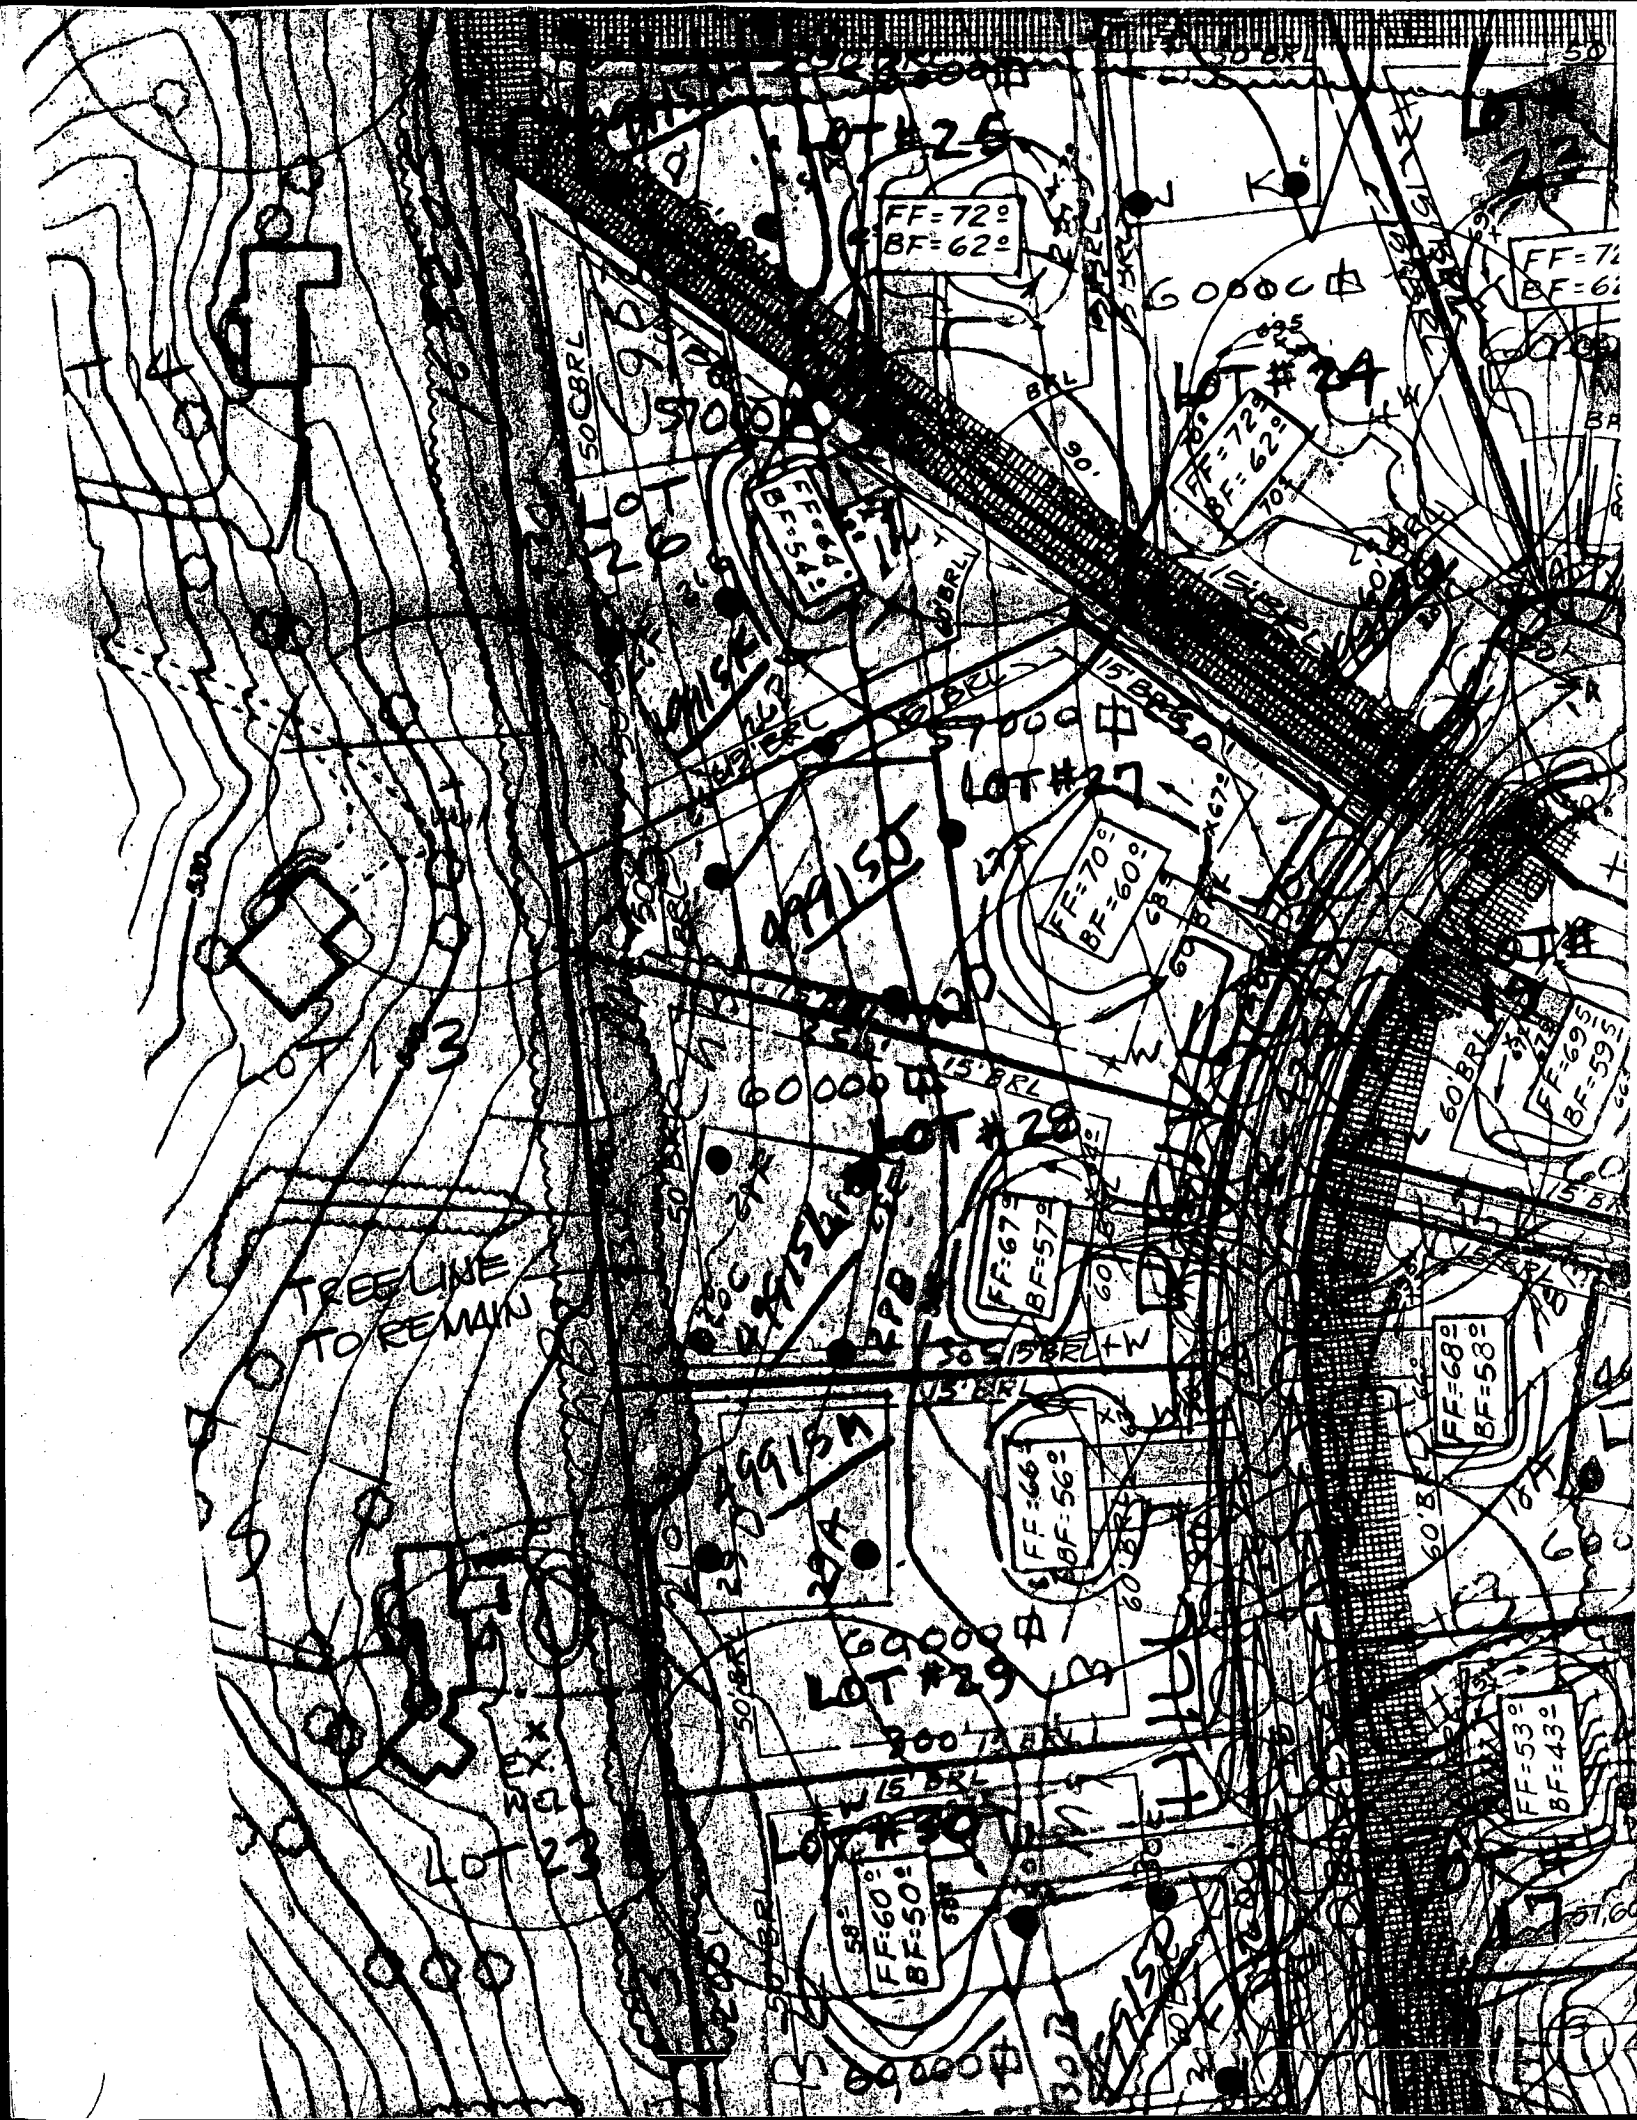

HOWARD COUNTY HEALTH DEPARTMENT
Bureau of Environmental Health
3525-H Ellicott Mills Drive
Ellicott City, MD 21043

Fax 313-2648 • 313-2640

APPLICATION FOR PITLESS ADAPTER, WELL PUMP AND PRESSURE TANK INSTALLATION

New Installation ☒
Replacement ☐

Receipt #

Date

Name of Installer

ROBERT L. FEEZER Co. Inc.

Telephone

781-4655

License Number

2122

Certified Well Pump Installer

Well Driller

Registered Plumber

Name of Property Owner

ALTIERI HOMES

Telephone

410-715-4500

Subdivision

YARLEY HUNT

Lot #

26

Well Tag #

HO-93-0217

Site Address

SUMMER HILL DRIVE

Pump

1. Type

a. Deep well jet

b. Shallow well jet

c. Submersible ☒

2. Make

GOULD

3. Model #

50310412

4. Capacity

5

GPM

5. Pump exceeds well capacity

Yes

No

6. If Yes, is low pressure cutoff switch installed?

Yes

No

7. What methods are used to protect the pump and electrical wiring from vibrations?

Torque arrestors

Cable guards ☒

Other

Motor

1. Horsepower

2. RPM

3450

3. Voltage

a. 110

b. 220 ☒

Pitless Adapter

1. Make

AM GRABBY

2. Model #

PT300

3. Depth

42"

Tank

1. Capacity

2. Pressure relief valve?

Piping

1. Type

POLYETHYLENE

2. Size

1"

3. ☒ NSF and/or BOCA

Code approved

4. Depth of supply line

42" +

Well data

1. Depth

540 ft.

2. Yield

GPM

3. Static water level

ft.

4. Will water supply be disinfected by installer?

☒

I understand that it is my responsibility to notify the Howard County Health Department when the installation is ready for inspection (otherwise this permit is null and void).

All information given above is true to the best of my knowledge.

Signature of Applicant:

Date:


Note: A sticker indicating approval/status of the installation will be placed on the well casing at the time of the inspection.

Approved Septic System Plan
Howard County Health Department

BY COPY OF THIS PLAN THE HEALTH DEPT. ACCEPTS THIS MODIFICATION TO THE RECORDED SEPTIC EASEMENT.

Mark E. Rife
Signature
8/4/97
Date


PLAN BY CFVS
7/31/97

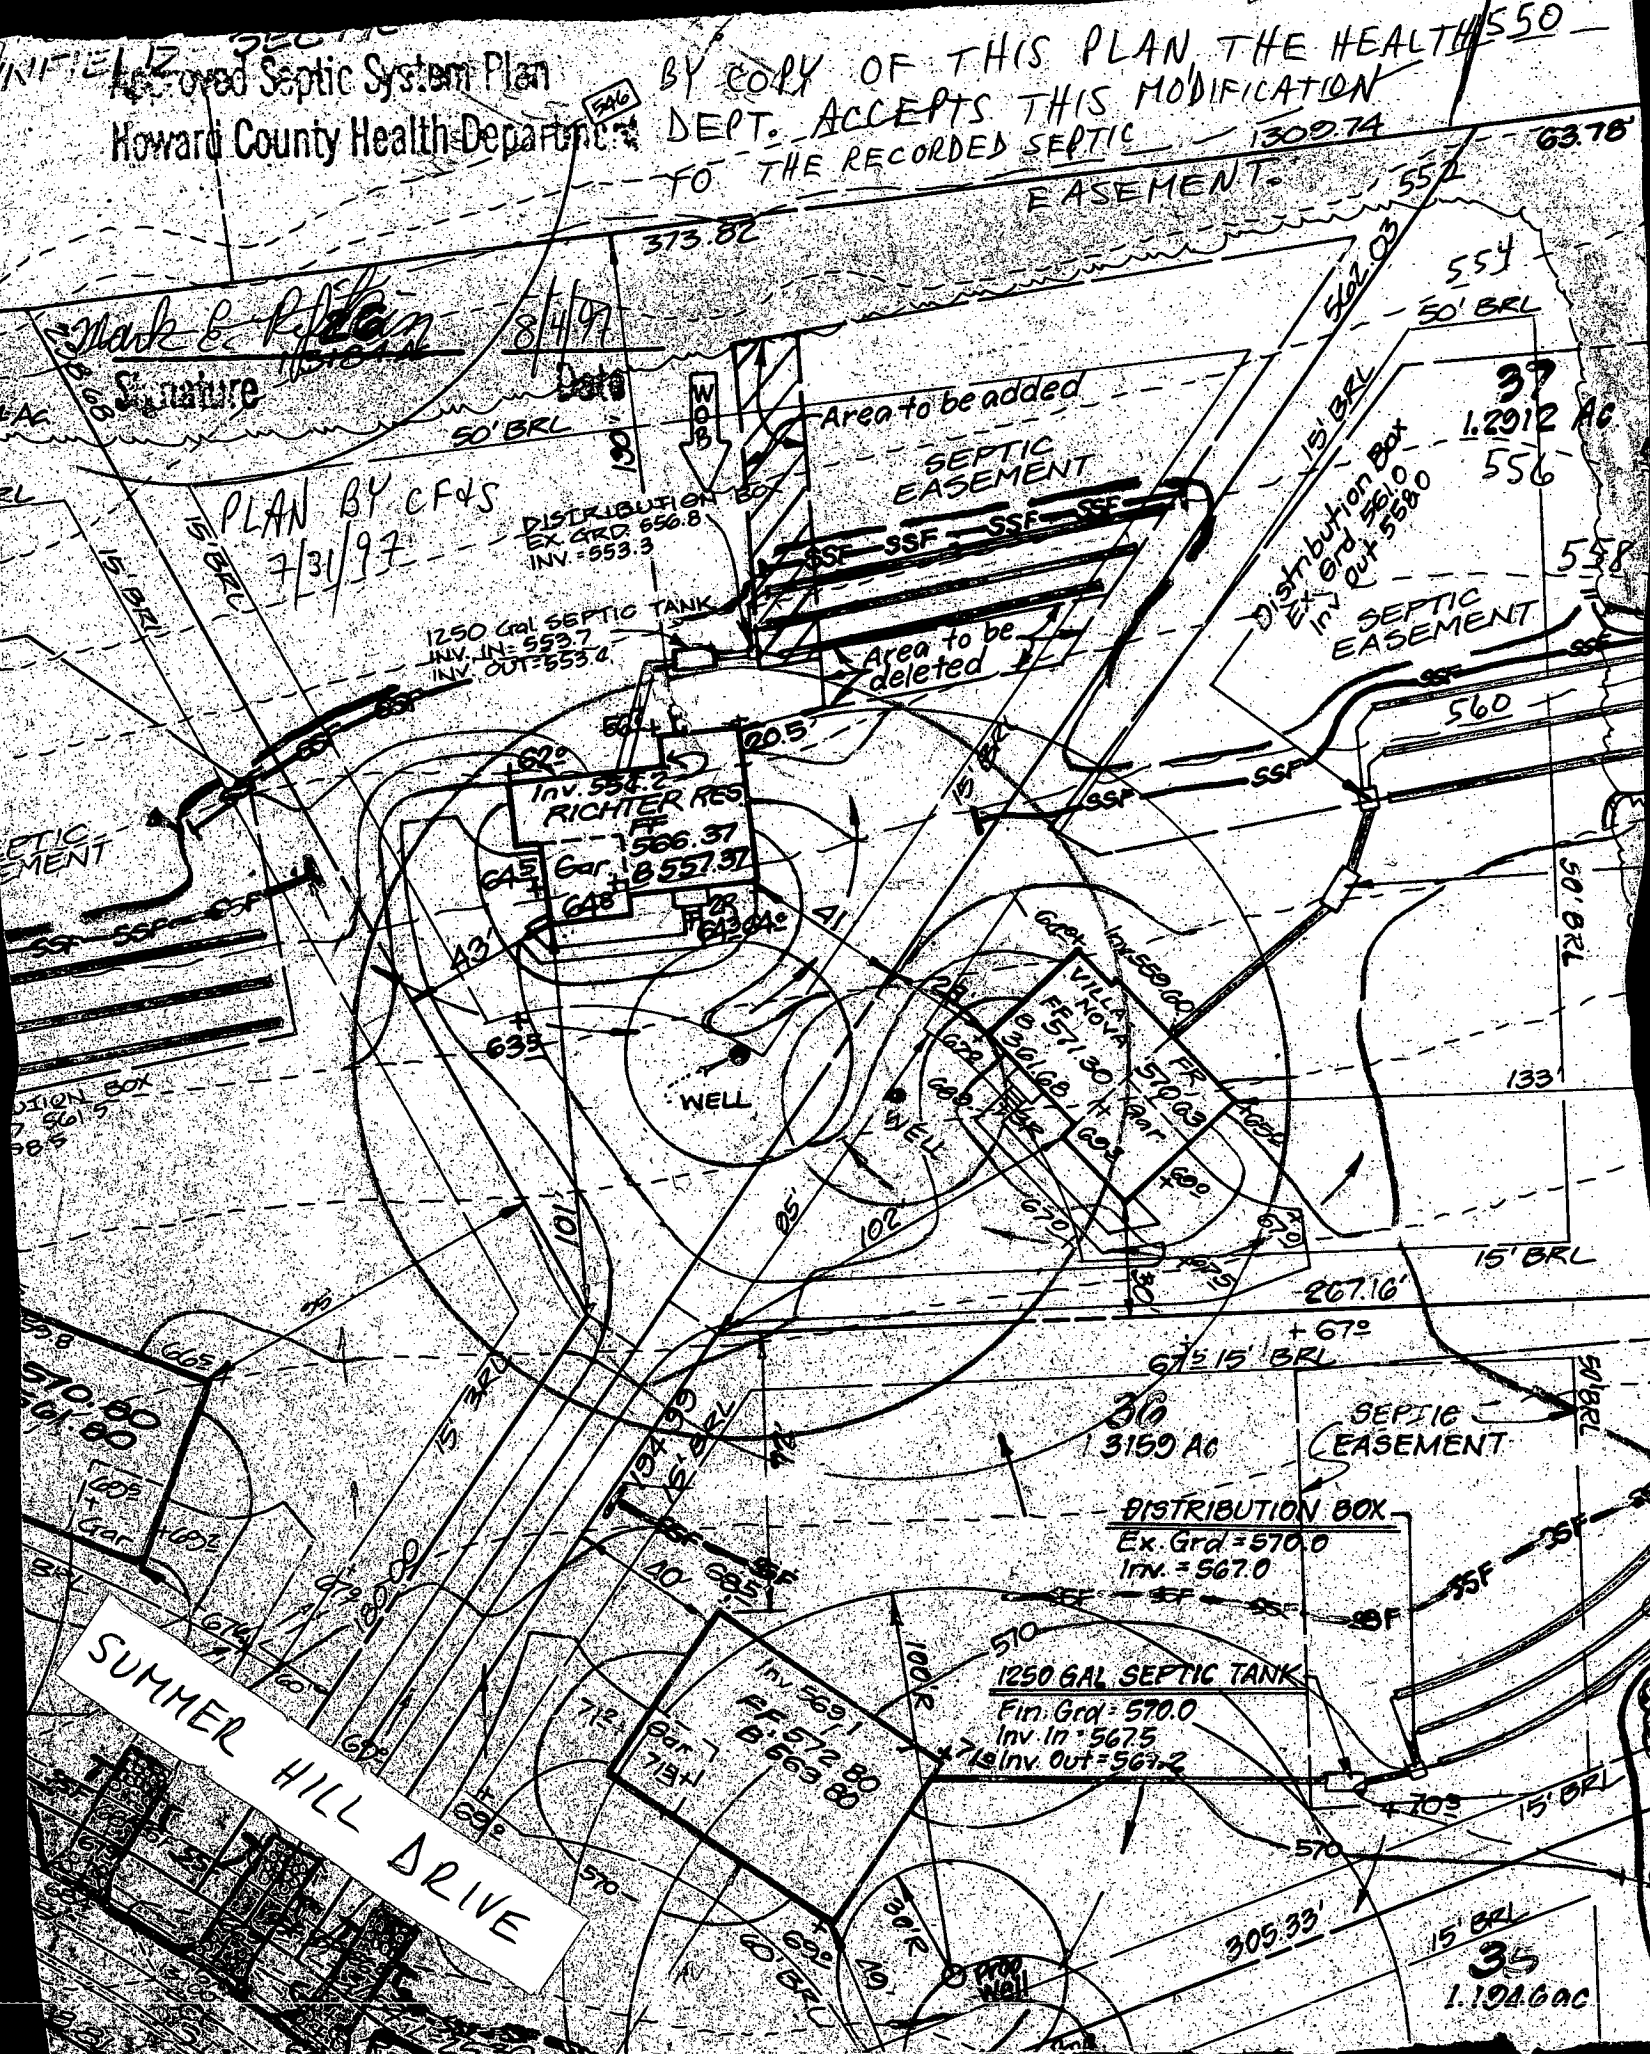

SUMMER HILL DRIVE


35
1.1246 AC

Copy of signed perc.
cert. Plat
11-3-94

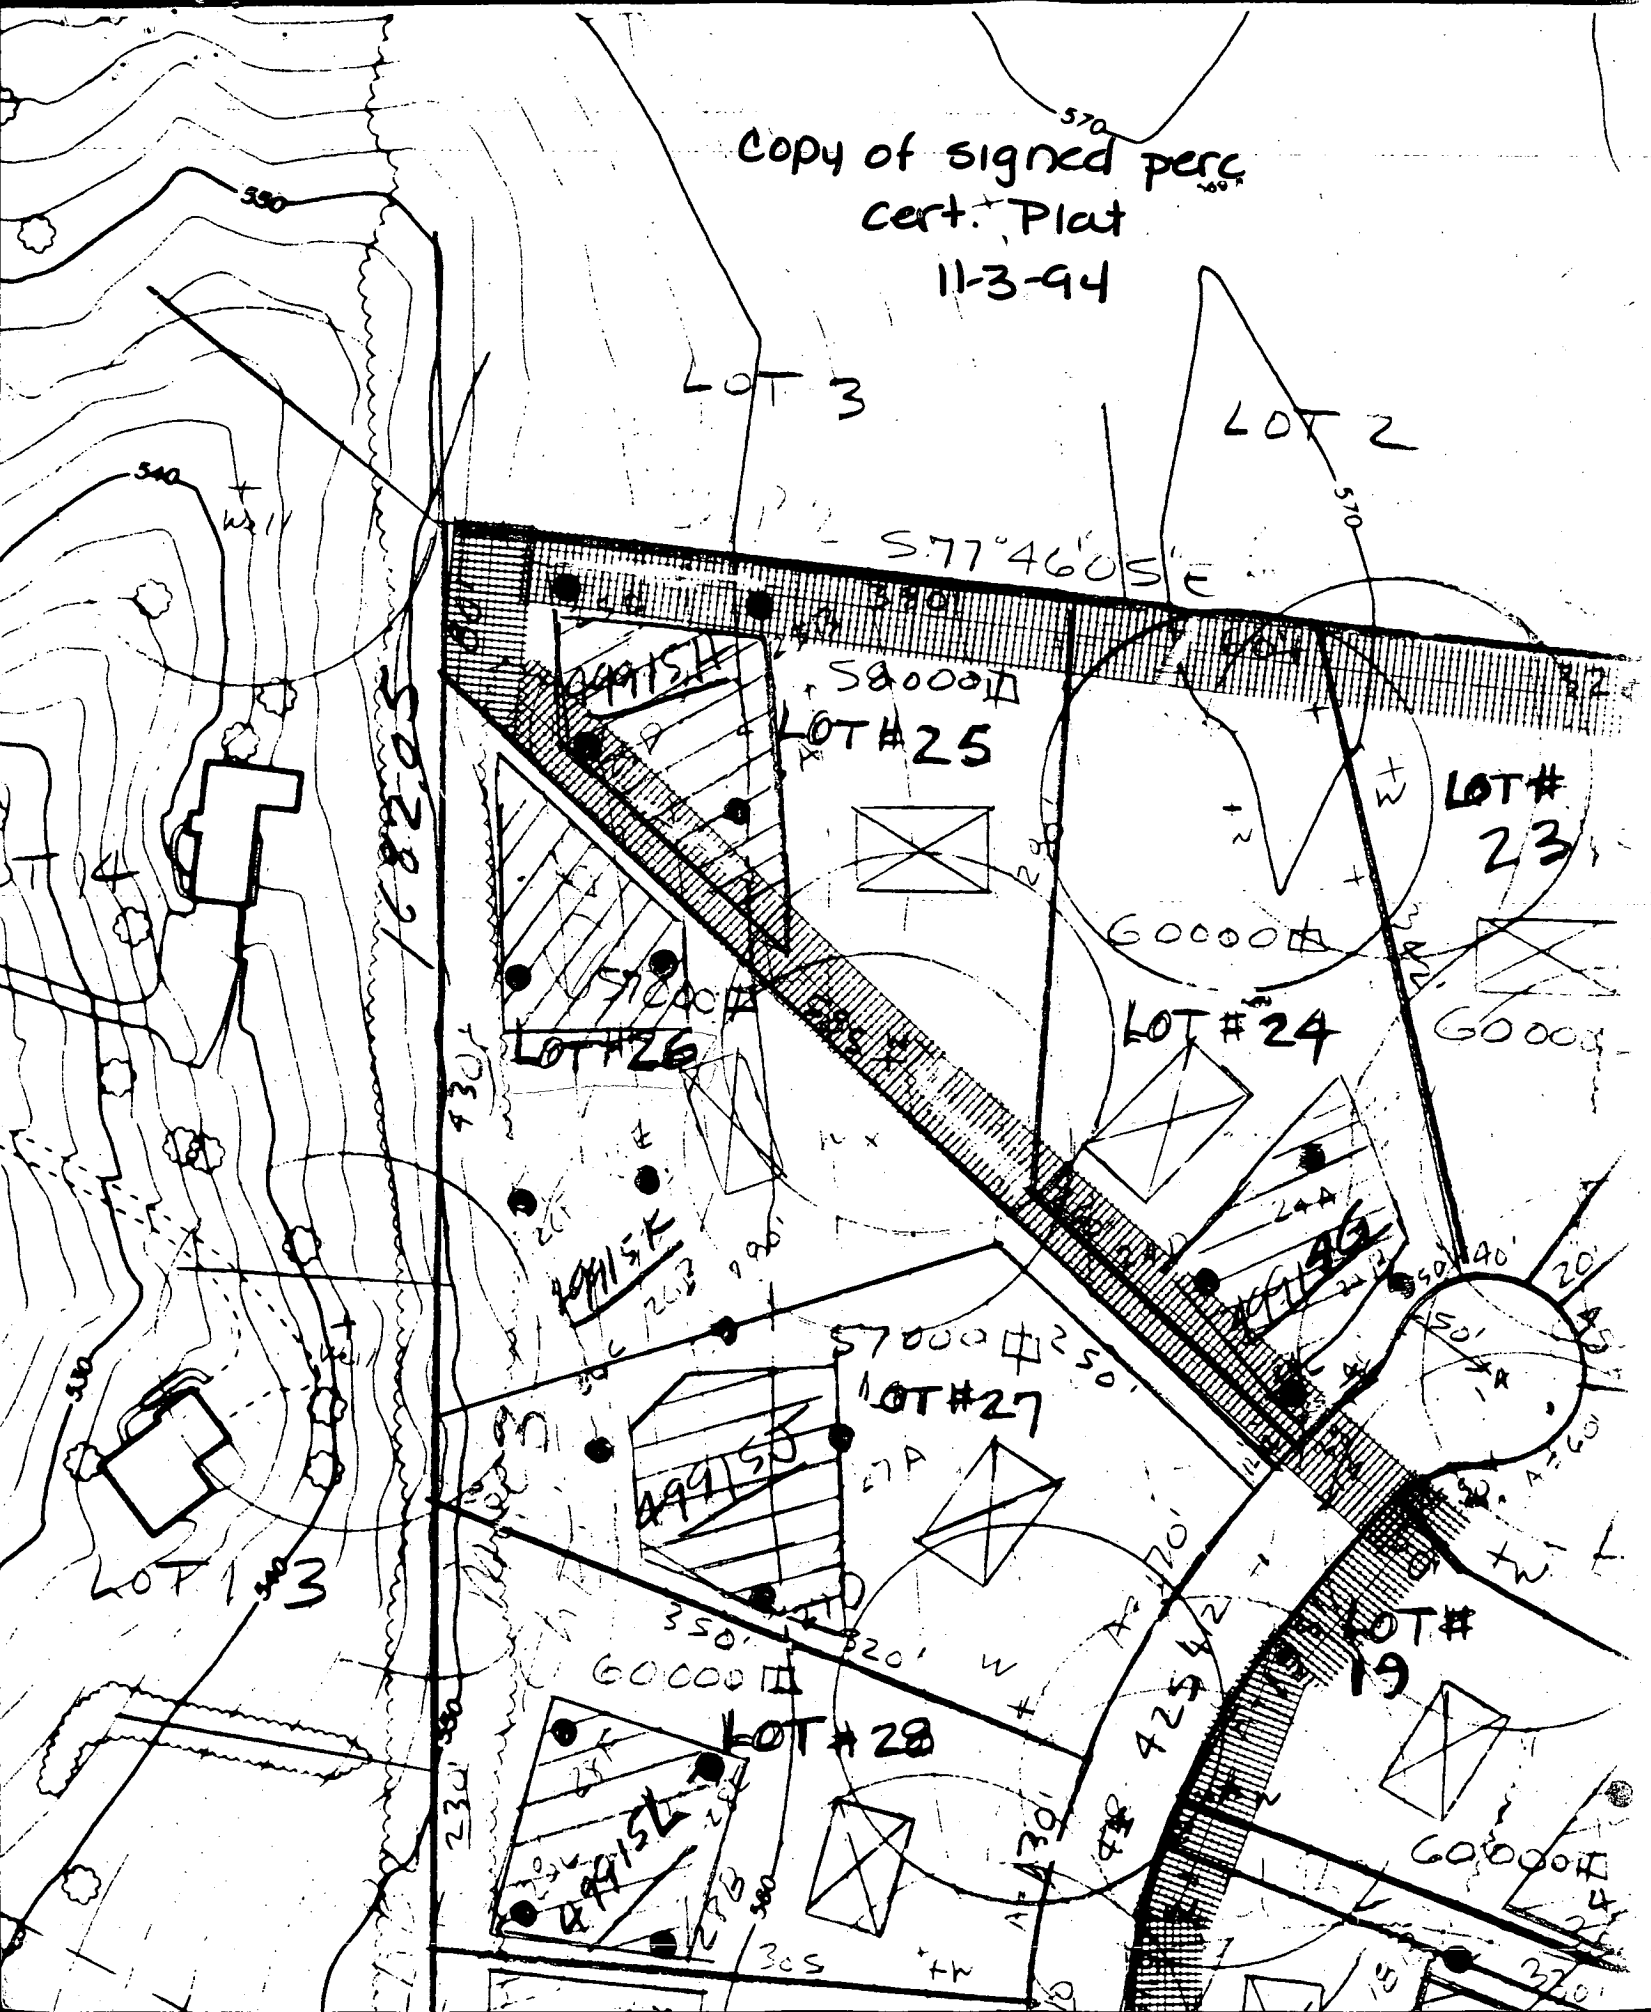

LOT 2
TREELINE
TO REMAIN

dh B2 \$77°46'05"

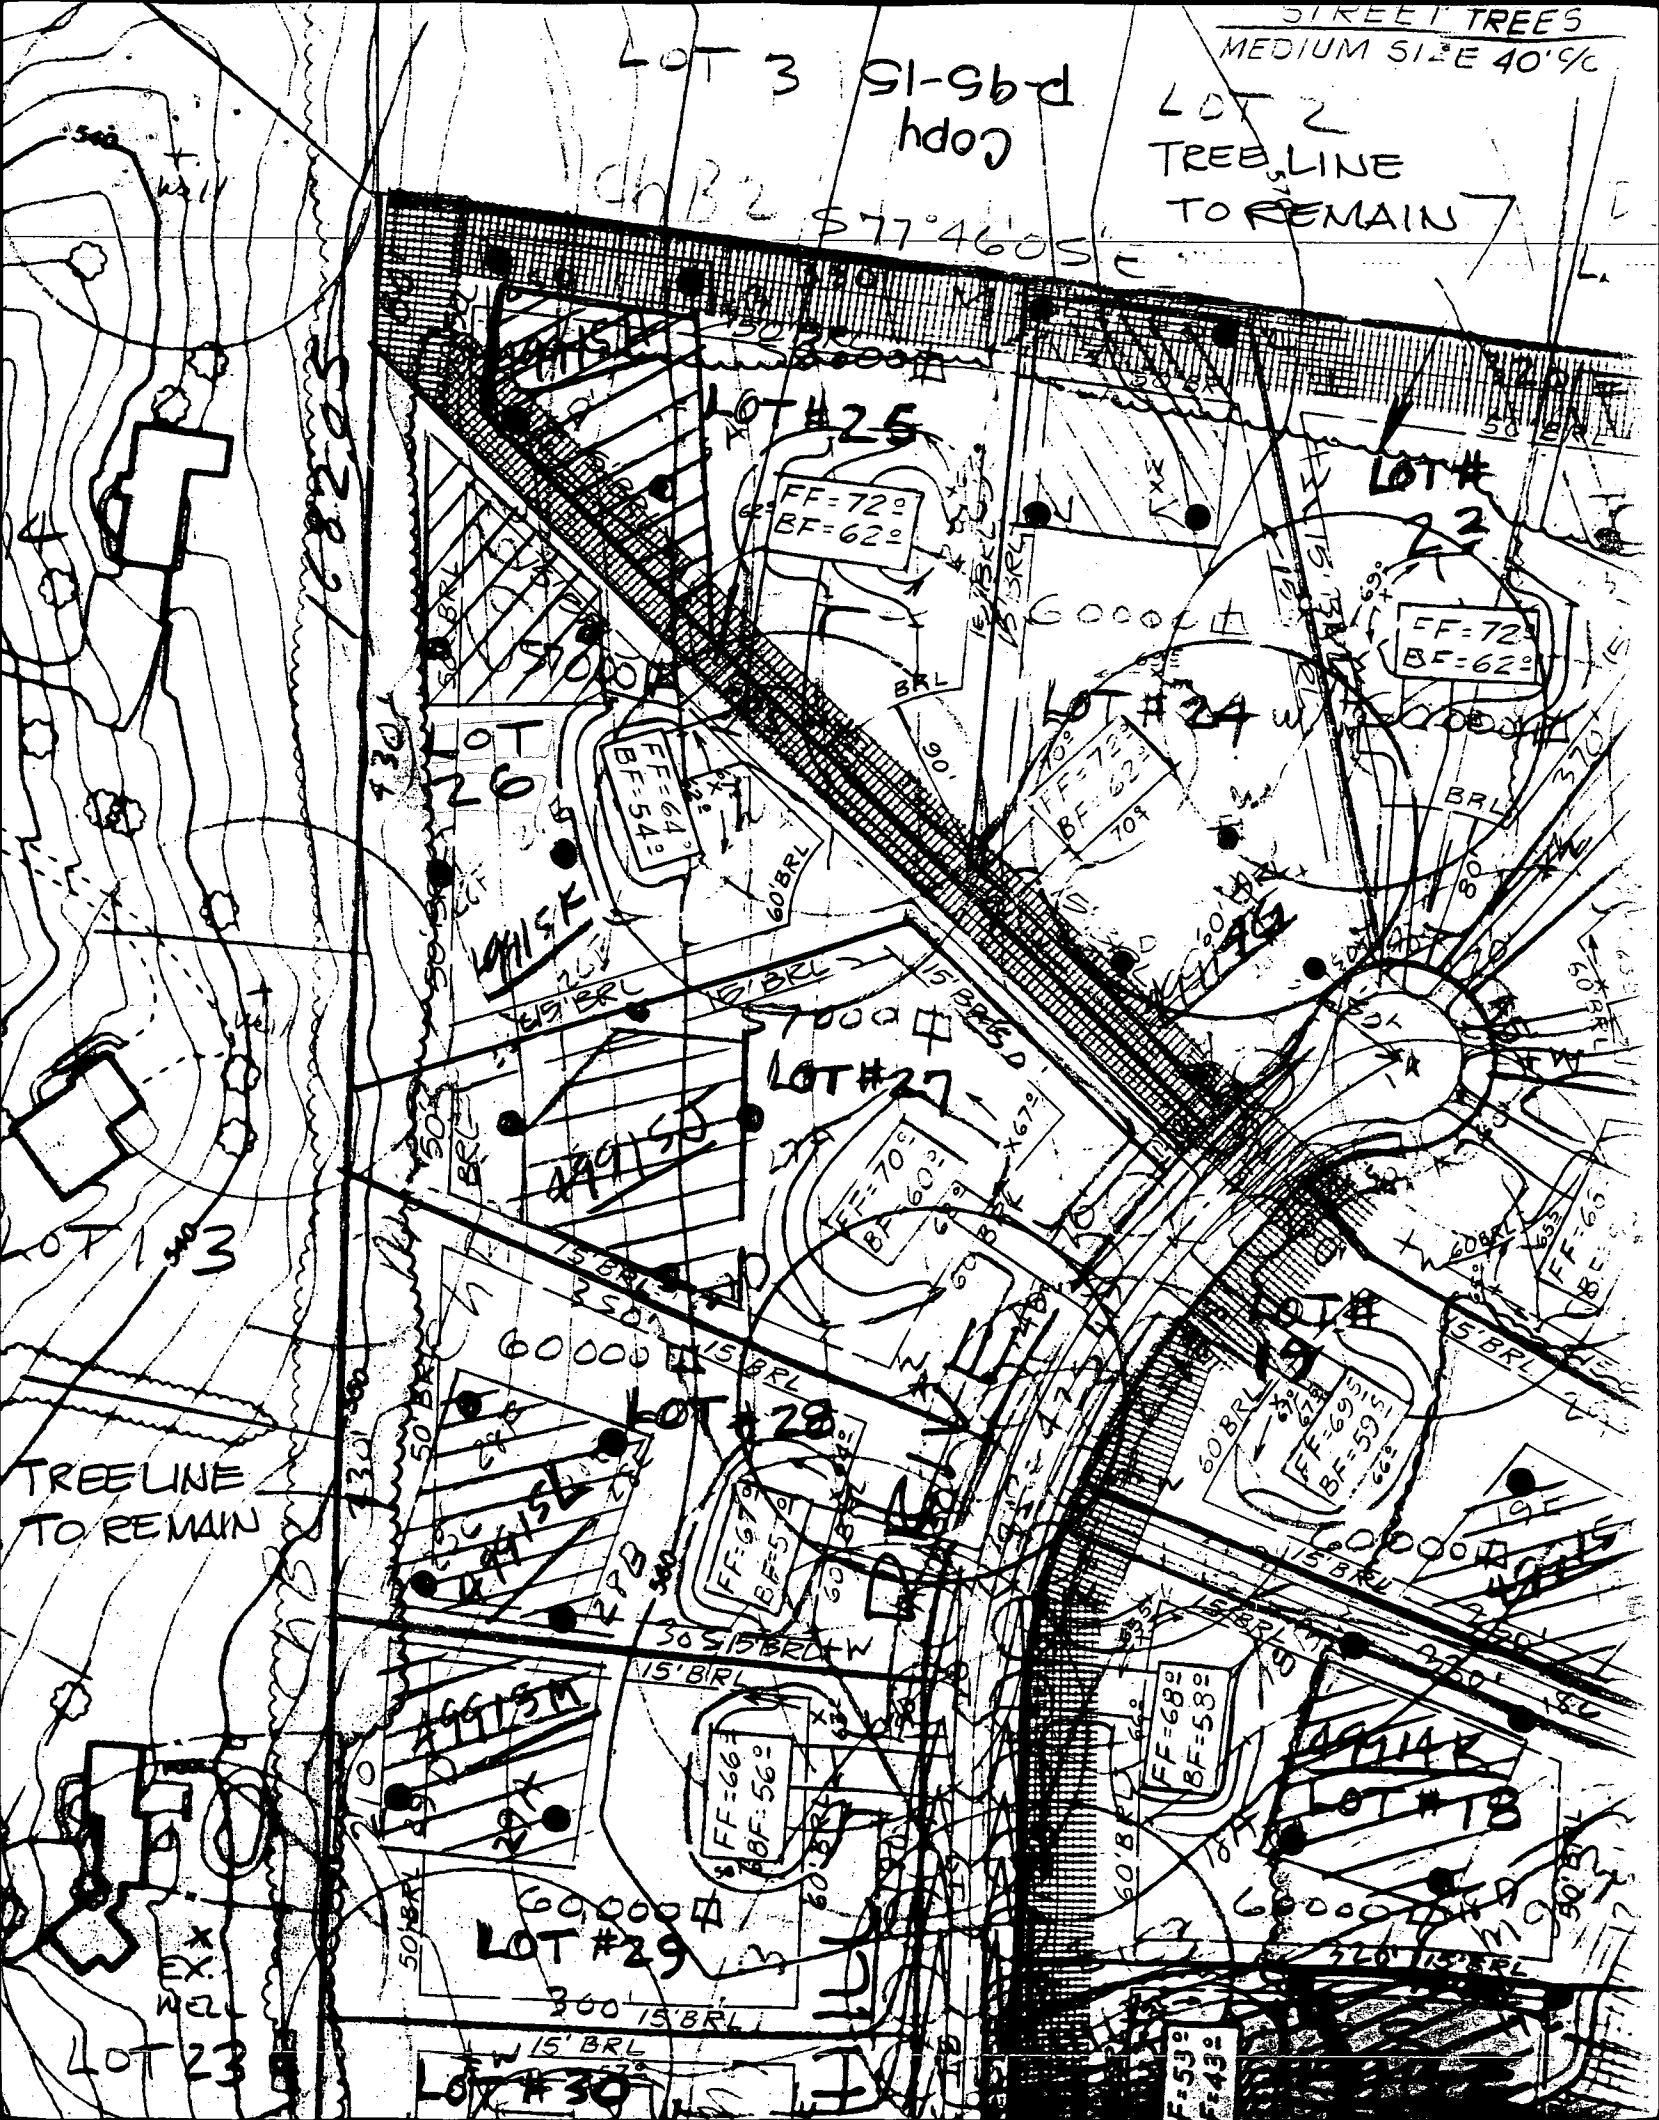

WYNFIELD
PLAT 6043

LOT 23

F-95-181

Copy of
Signed
Final Plat

LOT 13

LOT 14

82,500
E 1,329,000

52°55' E 190.09'

N 08°52'55" E 190.09'

N 08°52'55" E 229.83'

40.00'

N 08°52'55" E 373.82'

N 08°52'55" E

50' BRL

50' BRL

1 P.F.

LOT 3
S 75°32'35" E 312.17'

LOT 30
1.3187 AC.
57,440 SF.

LOT 29
1.3445 AC.
58,565 SF.

LOT 28
1.3319 AC.
58,016 SF.

LOT 27
1.3694 AC.
59,653 SF.

LOT 26
1.3184 AC.
57,432 SF.

LOT 25
1.4421 AC.
62,816 SF.

10' PUBLIC TREE
MAINTENANCE EASEMENT

SUMMER

HILL

DRIVE

50' R/W

10°40'00" E 190.00'

10°40'00" E 150.00'

60' BRL

15' BRL

60' BRL

60' BRL

60' BRL

60' BRL

15' BRL

15' BRL

LOT 17
1.3085 AC.
57,000 SF.

LOT 18
1.2199 AC.
53,139 SF.

LOT 19
1.1893 AC.
51,807 SF.

LOT 20
1.3626 AC.
59,357 SF.

LOT 23
1.3358 AC.
58,186 SF.

LOT 24
1.3691 AC.
59,640 SF.

LOT 2

S 75°32'35" E 335.00'

40°00' W 190.00'

S 25°18'27" W

30' BRL

140.50'

REGION _____

AREA _____ RATING _____

ACKNOWLEDGMENT AND CONTROLS	DATE

Howard County Department of Health
BUREAU OF ENVIRONMENTAL HEALTH

RECORD OF INVESTIGATION

DISPOSITION	DATE

LOCATION 2929 Summer Hill Drive ZIP _____OWNER ☒ SCOTT J. RICHTER ADDRESS SAME PHONE 410-442-1841OCCUPANT ☐ _____ ADDRESS _____ PHONE _____

COMPLAINANT _____ ADDRESS _____ PHONE _____

REASON FOR INVESTIGATION sewage odor around house

CODES _____

RECEIVED BY Craig Williams DATE 12-15-97 ASSIGNED TO G. SAVAGE DATE _____DATE OF INVESTIGATION 12/19/97 TIME NOON WEATHER 40's, OVERCAST, SLIGHT BREEZEREPORT OUTSIDE INSPECTION AROUND HOUSE DID NOT REVEAL AN OBVIOUS SOURCE OFCOMPLAINT. NO ODOR DETECTED.

NOTE: TANK CLEANOUT IS TIPPED SLIGHTLY - NOT SEATED ON
TANK - REQUEST BUILDER FIX (OWNER REQUEST) - LETTER
TO BE SENT

(WOMAN) WHOSE NAME I FAILED TO WRITE DOWN
CALLED THIS IN;
SCOTT RICHTER SAID HE WAS UNAWARE OF
THE REPAIRS

DATE SUBMITTED 12/19/97SANITARIAN Bludny



HOWARD COUNTY HEALTH DEPARTMENT

Joyce M. Boyd, M.D., County Health Officer

January 6, 1998

Mr. Scott J. Richter
2929 Summer Hill Drive
West Friendship, MD 21794

Dear Mr. Richter:

On December 19, 1997, an inspection was performed at the above referenced address for the purpose of locating an outdoor sewage odor.

During the course of the inspection, it was noted that the septic tank cleanout did not appear to be securely fastened to the septic tank. This situation could cause septic odor, and of allow entry of groundwater in to your septic system, leading to a reduction in system life. In addition, utilization of the cleanout for its intended purpose may be difficult.

It is suggested that you make arrangements to repair the septic tank, restoring the tank to the watertight condition originally intended by this office.

No other problems were noted during the course of the inspection.

If you have any questions, you may contact me at the above referenced address, or by calling me at 410-313-2640.

Sincerely,

Glen M. Savage, R.S.

cc: Alteri Homes
file

GS:gs
sobus26.let

A49915-K

FIELD - SECTION 2
PLAT 5457

LOT 14

N08°52'55"E

373.82'

LC
PL
122

LOT 26
1.3184 AC
57,432

N7°10'36"W

50'

E.R.L.

562.03'

E.R.L.

12' x 14'
Porch Reinforced
14 x 24 OPEN DECK
steps

#2929

Private Sewage
see General N
Plat No. 11926

7.15.98
PROPOSED
DECK OK *ff*

Macadam
Driveway

80' E.R.L.

298.68'
180.00'

LOT 36
PLAT NO. 12256

Use-In-Common Access
Area For Lots 26 And 37
L.3538 F.533

Tree
cut

Macadam
Driveway

N33°51'46"W
N33°51'46"E

WYNFIELD SECTION 2
PLAT 5457

LOT 14

N08°52'55"E

373.82'

LOT 26
1.3184 AC.
57,432

LOT
PLAT
1225

S77°10'38"W

50'
15'
BRL

BRL

562.03'

---Private Sewage
see General No.
Plat No. 11926

#2929

3/8/01

NO OBS. TO
FAMILY ROOM ADD'N

(MR)

Macadam Driveway

WELL

LOT 36
PLAT NO. 12256

Public Tree
segment

Macadam Driveway

Use-In-Common Access
Area For Lots 26 And 37
L.3538 F.533

N39°51'46"W
S39°51'46"E

R=450.00'
=15.00'

DRIVE

DEPARTMENT OF INSPECTIONS, LICENSES AND PERMITS 3430 COURT HOUSE DRIVE ELLICOTT CITY, MD 21043 PERMITS (410)313-2455 INSPECTIONS (410)313-1810 AUTOMATED INFORMATION (410) 313-3800		HOWARD COUNTY PERMIT APPLICATION		PERMIT NUMBER 800128751	
Building Address <u>2929 Summer Hill Drive</u> <u>10000 Frankfort Rd 21794</u> Suite/Apt. #: _____ SDP/WP/Petition #: _____ Census Tract <u>111</u> Subdivision <u>Sobus Farms</u> Section _____ Area _____ Lot <u>26</u> Tax Map <u>15</u> Parcel <u>D11</u> Grid <u>10</u> Zoning <u>R-1</u> Map Coordinates <u>10 0 5</u> Lot size <u>57,000</u>			Property Owner's Name <u>John S. Richter</u> Address _____ City <u>1st Township</u> State <u>MD</u> Zip Code <u>21794</u> Home Phone <u>410-442-1820</u> Work Phone <u>5 AM 7:06</u> Applicant's Name & Mailing Address, (if other than stated hereon) _____ Phone _____ Fax <u>410-750-2596</u>		
Existing Use <u>Single Family Residence</u> Proposed Use _____ Estimated Construction Cost \$ <u>100,000</u> Description of Work <u>15x22 addition w/ unfinished bsmt, FP</u>			Contractor Company <u>Catonsville Home S.</u> Contact Person <u>Samuel Stanton</u> Address <u>10753 Birchmicham Ln</u> City <u>Woodstock</u> State <u>MD</u> Zip Code <u>21163</u> License No. <u>990</u> Phone <u>410-750-1200</u> Fax <u>410-750-2596</u>		
Occupant or Tenant <u>owner</u> Contact Name _____ Address _____ City _____ State _____ Zip Code _____ Phone _____ Fax _____			Engineer or Architect Company <u>owner</u> Contact Person _____ Address _____ City _____ State _____ Zip Code _____ Phone _____ Fax _____		
BUILDING DESCRIPTION - COMMERCIAL			BUILDING DESCRIPTION - RESIDENTIAL		
Building Characteristics Height: _____ No. of stories: _____ Gross area, sq. ft. per floor: _____ Use group: _____ Construction type: ☐ Reinforced Concrete ☐ Structural Steel ☐ Masonry ☐ Wood Frame ☐ State Certified Modular			Utilities Water Supply: ☐ Public ☐ Private Sewage Disposal: ☐ Public ☐ Private Electric Yes ☐ No ☐ Gas Yes ☐ No ☐ Heating System: Electric ☐ Oil ☐ Natural Gas ☐ Propane Gas ☐ Sprinkler system: N/A ☐ ☐ Full ☐ Partial ☐ Other Suppression ☐ # of Heads		
Building Characteristics SF Dwelling ☐ SF Townhouse ☐ Depth _____ Width _____ 1st floor: _____ 2nd floor: _____ Basement: <u>RR</u> <u>15'4"</u> Finished Basement ☐ Unfinished Basement ☒ Crawl space ☐ Slab on Grade ☐ No. of Bedrooms _____ Multi-family dwellings: No. of efficiency units: _____ No. of 1 BR units: _____ No. of 2 BR units: _____ No. of 3 BR units: _____ Other Structure: _____ Dimensions: _____ Footings: _____ Roof: _____ ☐ State Certified Modular ☐ Manufactured Home			Utilities Water Supply: ☐ Public ☒ Private Sewage Disposal: ☐ Public ☒ Private Electric Yes ☐ No ☐ Gas Yes ☒ No ☐ Heating System: Electric ☐ Oil ☐ Natural Gas ☒ Propane Gas ☐ Sprinkler system: N/A ☐ ☐ NFPA #13D ☐ NFPA #13R ☐ Other:		

THE UNDERSIGNED HEREBY CERTIFIES AND AGREES AS FOLLOWS: (1) THAT HE/SHE IS AUTHORIZED TO MAKE THIS APPLICATION; (2) THAT THE INFORMATION IS CORRECT; (3) THAT HE/SHE WILL COMPLY WITH ALL REGULATIONS OF HOWARD COUNTY WHICH ARE APPLICABLE THEREUNTO; (4) THAT HE/SHE WILL PERFORM NO WORK ON THE ABOVE REFERENCED PROPERTY NOT SPECIFICALLY DESCRIBED IN THIS APPLICATION; (5) THAT HE/SHE GRANTS COUNTY OFFICIALS THE RIGHT TO ENTER ONTO THIS PROPERTY FOR THE PURPOSE OF INSPECTING THE WORK PERMITTED AND POSTING NOTICES.

Applicant's Signature _____
 Title/Company _____

Print Name Samuel Stanton
 Date 3/2/01

Checks payable to: **DIRECTOR OF FINANCE OF HOWARD COUNTY**
**** PLEASE WRITE NEATLY AND LEGIBLY. ****
- FOR OFFICE USE ONLY -

AGENCY Land Development DPZ DATE 3/8/01 SIGNATURE APPROVAL Mark Lipton
☒ State Highways
☒ Building Official
☒ Dev. Engineering DPZ
☒ Health
 Fire Protection _____
 Is Sediment Control approval required prior to issuance?
 YES ☐ NO ☐

DPZ SETBACK INFORMATION
 Front: _____
 Rear: _____
 Side: _____
 Side St: _____
 All minimum setbacks met?
 YES ☐ NO ☐
 Is Entrance Permit required?
 YES ☐ NO ☐
 Historic District?
 YES ☐ NO ☐
 Lot Coverage for NewTown Zone _____
 SDP/Red-line approval date _____

PROPERTY ID# 30988
 Filing fee \$ 26.22
 Permit fee \$ _____
 Excise tax \$ _____
 Sub-total paid \$ _____
 Add'l permit fee \$ _____
 TOTAL FEES \$ _____
 Balance due \$ _____
 Check # 1269
 Validation # 30696

CONTINGENCY CONSTRUCTION START: ☐
 ONE STOP SHOP: ☐

Distribution of Copies: White: Building Official Green: LDD, DPZ Yellow: DED, DPZ Pink: Health Gold: SHA