

PERMIT

SEWAGE DISPOSAL SYSTEM

DEPARTMENT OF HEALTH AND MENTAL HYGIENE

HOWARD COUNTY HEALTH DEPARTMENT

BUREAU OF ENVIRONMENTAL HEALTH

~~461-9933~~ 313-2640

P 49035

A REPAIR

DISTRICT _____

DATE 3/8/93

DATE SYSTEM APPROVED 12/2/92

INSPECTOR [Signature]

A 30777
INDEXED

Collins Utility
Jack Fyock Septic Service

IS PERMITTED TO INSTALL _____ ALTER X

ADDRESS 13775 Triadelphia Road, Glenelg, Maryland PHONE 988-9270

SUBDIVISION Talbot's Last Shift LOT 9B ROAD 5261 Talbot's Landing Road

PROPERTY OWNER Nunn

ADDRESS 5261 Talbot's Landing Road
Ellicott City, Maryland

SEPTIC TANK CAPACITY 1250 GALLONS

NUMBER OF BEDROOMS 4

 SQUARE FEET PER BEDROOM

LINEAR FEET OF TRENCH REQUIRED 135'

REPAIR - PURPOSE - SEPTIC SYSTEM HAS FAILED.

Call for inspection when ground is opened so sanitarian can recommend repair. 5/18/93

PLANS APPROVED BY _____ DATE _____

COVER NO WORK UNTIL INSPECTED AND APPROVED

NEITHER THE HOWARD COUNTY COUNCIL NOR THE HEALTH DEPARTMENT IS RESPONSIBLE FOR THE SUCCESSFUL OPERATION OF ANY SYSTEM

NOTE: CLEANOUT REQUIRED EVERY 70 FEET OF SEWER LINE AND/OR AT 90° SWEEPS IN LINES FROM HOUSE TO DRAIN FIELDS, 90° ELBOWS NOT ACCEPTABLE.

NOTE: ALL PARTS OF SEPTIC SYSTEMS (I.E. TANK, DISTRIBUTION BOX TRENCHES) TO BE 100 FEET FROM WELL (UNLESS OTHERWISE SPECIFICALLY AUTHORIZED)

NOTE: IF DEEP TRENCH(ES) ARE USED CALL FOR INSPECTION BEFORE AND AFTER PLACING GRAVEL IN TRENCH **BUILDING PERMIT SIGNED**

NOTE: NO DRY WELL SHALL EXCEED 15 FOOT IN DIAMETER NO ABSORPTION TRENCH TO EXCEED 100 FEET IN LENGTH **AND RETURNED** 6/5/02

NOTE: ALL PIPE FROM HOUSE TO SEPTIC TANK MUST BE CAST IRON OR SCHEDULE 35/40 PVC OR ABS 300 136677 SUNROOM

PERMIT VOID AFTER TWO YEARS


NOTE: INSTALL STAND PIPE ON SEPTIC TANK AND DRY WELL STAND PIPES MUST BE 6 INCHES IN DIAMETER CAST IRON, CONCRETE OR TERRA COTTA OR PVA OR ABS ACCEPTED. IF TOP OF SEPTIC TANK IS DEEPER THAN 3 FEET, MANHOLE TO GRADE REQUIRED.

NOTE: DISTRIBUTION BOXES MUST HAVE BAFFLES

***INSTALLER IS RESPONSIBLE FOR OBTAINING FINAL APPROVAL ON THIS PERMIT**

P 49035

9:47
FAIL AT 6'
10:10

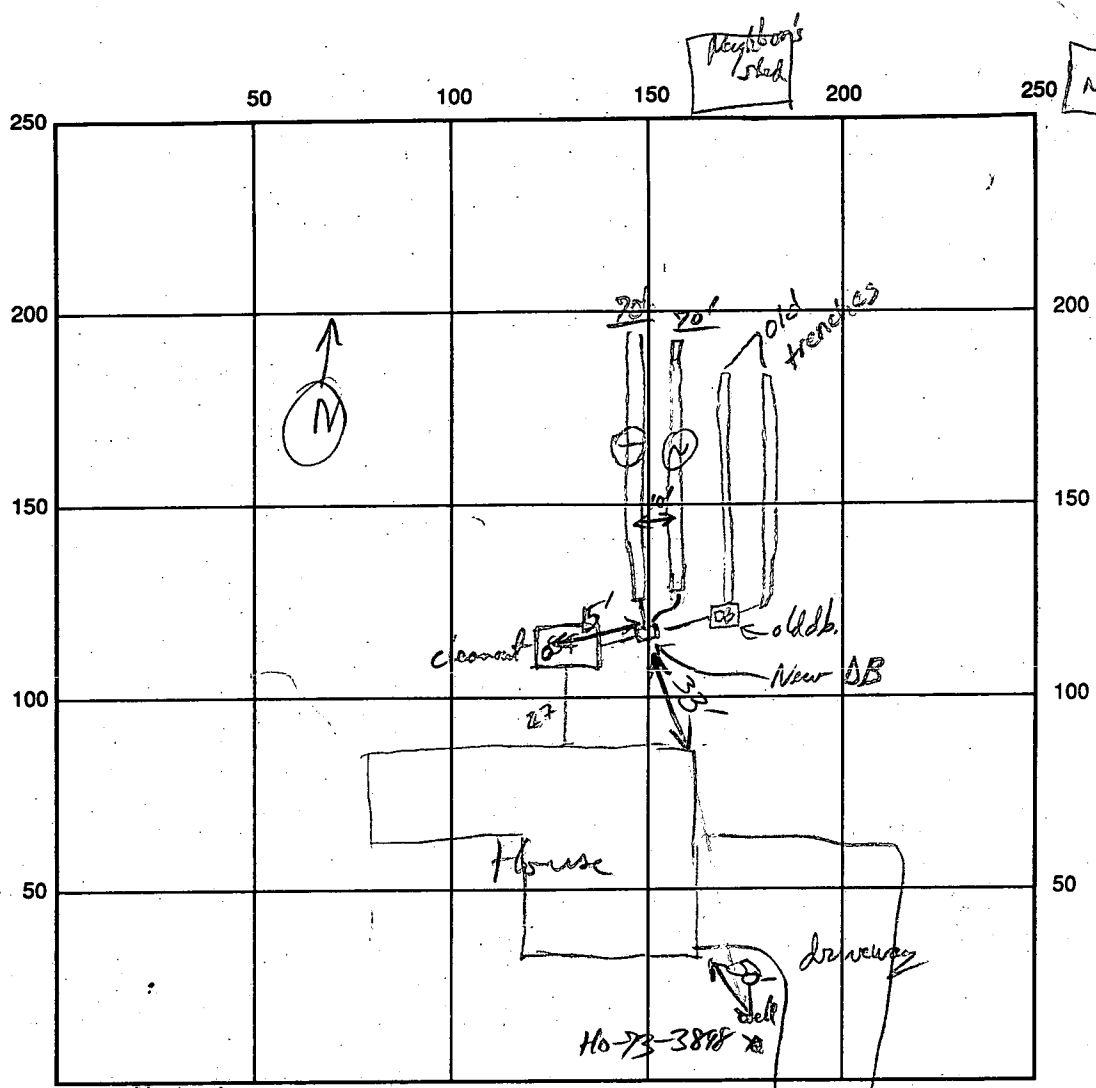

Talbot's Landing Rd INDICATE NORTH - NAME ADJOINING ROADWAY AS BASE LINE

SEPTIC TANK LEVEL exist 1000gal CLEANOUTS NA

DISTRIBUTION BOX LEVEL ✓

DRAIN FIELD/TITLE DEPTH 9' FT. TRENCH WIDTH 3 FT. INLET DEPTH 6' FT.

EFFECTIVE GRAVEL DEPTH 3 FT. TOTAL LENGTH 70/70 FT.

NUMBER OF TRENCHES 2 ^{Total} ONE SIDEWALL/BOTTOM AREA 420 SQ. FT.

DRYWALL INSIDE DIAMETER _____ FT. EFFECTIVE DEPTH BELOW INLET _____ FT.

ABSORBENT AREA _____ SQ. FT.

REMARKS: 12/6/93 Place 2 70' trenches parallel to existing (10' away) on contour
12/6/93 12/13/93 12/13/93 12/13/93 12/13/93 12/13/93 12/13/93 12/13/93 12/13/93 12/13/93
12/6/93 OK to place 2 trenches OK to place 2 trenches OK to place 2 trenches
12/7/93 OK to place 2 trenches OK to place 2 trenches OK to place 2 trenches

DATE SYSTEM APPROVED 12/7/93 INSPECTOR Paul Piller

PERMIT

SEWAGE DISPOSAL SYSTEM

MARYLAND STATE DEPARTMENT OF HEALTH

HOWARD COUNTY

ELLICOTT CITY

DISTRICT 1st

DATE 9/30/82

INDEX

Otis Ketterman

IS PERMITTED TO INSTALL ☒ ALTER ☐

ADDRESS 4647 Manor Lane, Ellicott City, Maryland 21043 PHONE 992-0062

SUBDIVISION Talbot's Last Shift ROAD 5081 Ilchester Road LOT X 9B

PROPERTY OWNER James Nunn

ADDRESS 102 S. Symington Avenue, Baltimore, Md. 21228 Phone: 788-2818

SPECIFICATIONS 3 bedrooms

SEPTIC TANK CAPACITY 1000 GALLONS

DRAIN FIELD _____ DEPTH _____ FEET, BOTTOM AREA _____ SQ. FT.

DEEP TRENCH _____ DEPTH _____ FEET, BOTTOM AREA _____ SQ. FT.

SEEPAGE PITS _____ ABSORBENT SIDE-WALL AREA _____ SQ. FT.

INLET PIPE _____ FT. BELOW ORIGINAL GRADE. MAXIMUM DEPTH _____ FT. BELOW ORIGINAL GRADE

EFFECTIVE DEPTH AT _____ FT. BELOW ORIGINAL GRADE.

LOCATE DISPOSAL AREA _____ FT. FROM _____ LOT LINE AND _____ FT. FROM _____ LOT LINE AS SEEN WHEN

NOTE: IF GARBAGE DISPOSAL IS INSTALLED TANK CAPACITY MUST BE INCREASED BY 50% AND SEWAGE DISPOSAL ~~TANK~~ AREA INCREASED BY 22%.

TRENCHES - Minimum total square feet in system to be 540 sq. ft. Trench to be 2 ft. wide; Inlet at 4½ ft. below original grade; and Maximum depth 10 ft. below original grade. Effective area begins at 4½ ft. below original grade. 5½ feet of stone below distribution pipe. NO TRENCH SHALL EXCEED 100 FEET IN LENGTH. IF MORE THAN ONE TRENCH USED, A DISTRIBUTION BOX IS REQUIRED. TRENCHES TO BE INSTALLED ON LEVEL GROUND. Start the trench ~~at~~ 180 ft. from the front (1088.89') lot line and 30 ft. from the right (335.62') lot line, as seen when facing the lot from the front (1088.89') lot line.

PLANS APPROVED BY Stephen Kiel and Frank Skinner DATE 5/11/81 & 12/16/81

COVER NO WORK UNTIL INSPECTED AND APPROVED.

NEITHER THE HOWARD COUNTY COUNCIL NOR THE HEALTH DEPARTMENT IS RESPONSIBLE FOR THE SUCCESSFUL OPERATION OF ANY SYSTEM.

NOTE: IF TRENCH IS USED CALL FOR INSPECTION BEFORE PLACING GRAVEL IN TRENCH.

NOTE: NO DRY WELL SHALL EXCEED 15 FOOT IN DIAMETER.

NOTE: ALL PIPE FROM HOUSE TO DISPOSAL AREA MUST BE CAST IRON.

PERMIT VOID AFTER THREE YEARS.

NOTE: INSTALL STAND PIPE ON SEPTIC TANK AND DRY WELL. STAND PIPES MUST BE 6 INCHES IN DIAMETER. CAST IRON, CONCRETE OR TERRA COTTA ACCEPTED.

BLOG. PERMIT SIGNED


AND RETURNED 5/11/89

Serial # 25263 - Sheet

*INSTALLER IS RESPONSIBLE FOR OBTAINING FINAL APPROVAL ON THIS PERMIT.

11/9/82 Plumbing out of house deeper than plan indicates, O.K. to use 2 trenches total of 135 linear feet, inlet 6' max. depth 10' in highest part of sewer.

180
3
540

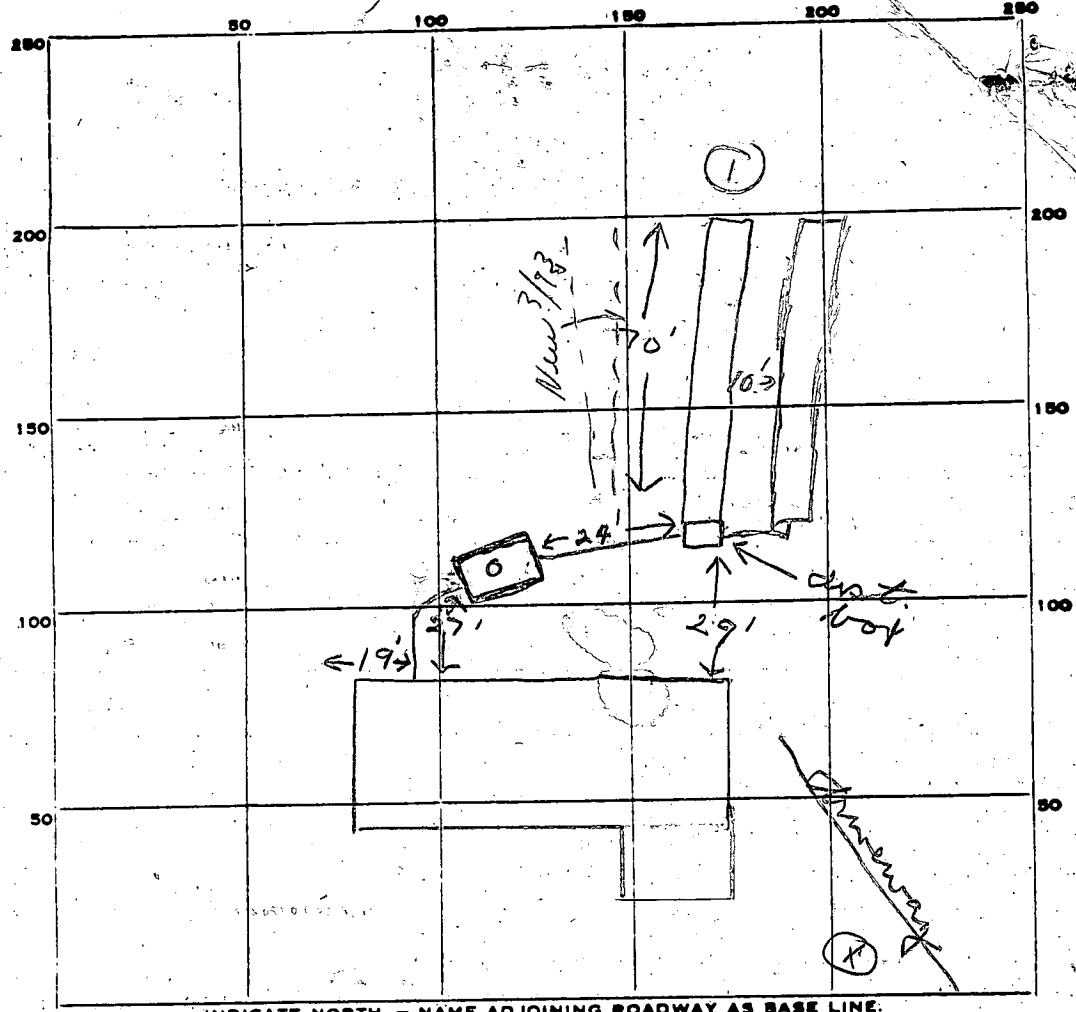

INDICATE NORTH. - NAME ADJOINING ROADWAY AS BASE LINE.

Road

PERMIT CARD _____

SEPTIC TANK, LEVEL ✓ 1500 gal CLEANOUTS ✓ ST

DISTRIBUTION BOX, LEVEL ✓

TILE FIELD, DEPTH 10 FT. TRENCH WIDTH 2 FT.

GRAVEL DEPTH 4 IN. TOTAL LENGTH 70 FT.

NUMBER OF TRENCHES 2 TOTAL BOTTOM AREA 560

SEEPAGE PITS, INSIDE DIAMETER _____ FT. DEPTH BELOW INLET _____ FT.

ABSORBENT AREA _____ SQ. FT.

REMARKS 11/8/82 Not ready. JS OK for inlet to be 6 ft deep per F.S.

11/9/82 OK to cover pipe to septic tank, also pipe to dist. box. OK to add stone in #1 trench. JS

11/10/82 2ND DITCH OK. ADD GRAVEL + CLEANOUT. CW

11-10-82 GRAVEL + DITCH OK. CW

DATE SYSTEM APPROVED 11-10-82 INSPECTOR C. William

APPLICATION

SEWAGE DISPOSAL TESTING

STATE OF MARYLAND - DEPARTMENT OF HEALTH AND MENTAL HYGIENE

HOWARD COUNTY HEALTH DEPARTMENT
ENVIRONMENTAL HEALTH SERVICES

P.O. BOX 476 ELLICOTT, MARYLAND 21043
TELEPHONE: 992-2330

A 30777
P _____

DISTRICT 1st
DATE 7/14/80

BLDG. PERMIT SIGNED
AND RETURNED 12/31/81
Serial # 48327

TO: THE COUNTY HEALTH OFFICER
ELLICOTT CITY, MARYLAND

I HEREBY APPLY FOR THE NECESSARY TEST IN ORDER TO CONSTRUCT (OR RECONSTRUCT) A SEWAGE DISPOSAL SYSTEM

PROPERTY OWNER James B. Nunn
ADDRESS Balto. 21228 PHONE 788-2818

PROPERTY LOCATION:

SUBDIVISION Talbot's Last Shift LOT NO. 9B
ROAD AND DESCRIPTION I DeRose Rd - 5881 11chester Road

SIZE OF LOT _____ TYPE BLDG. _____

THE SYSTEM INSTALLED UNDER THIS APPLICATION IS ACCEPTABLE ONLY UNTIL PUBLIC FACILITIES BECOME AVAILABLE.

I FULLY UNDERSTAND THE FEE CONNECTED WITH THE FILING OF THIS PERC TEST APPLICATION IS NON-REFUNDABLE UNDER ANY CIRCUMSTANCES.

SIGNATURE OF APPLICANT _____

APPROVED BY Stephen Hill & F Skomins DATE 5/11/81

REJECTED BY _____ FOR _____ DATE _____

HOLD PENDING FURTHER TESTS _____ DATE _____

REASONS FOR REJECTION OR HOLDING Hold for rectified holes SK 7-14-80

THIS IS NOT A PERMIT

SOIL PROFILE

Test per
Stake

clay

Very
Sandy
Loam

POWER LINE R/W

POWER LINE
TOWER

Lowest

Highest

DIRT RD

INDICATE NORTH - NAME ADJOINING ROADWAY AS BASE LINE

$$\overline{x} = 11$$
REMARKS

TYPE OF SOIL


TESTED BY


Tested Cornfield 6' high, no Lat lines Held for certified
halves.

B/H J S + S K 7-14-80

ALSO PRESENT

Kellerman
C Hudson

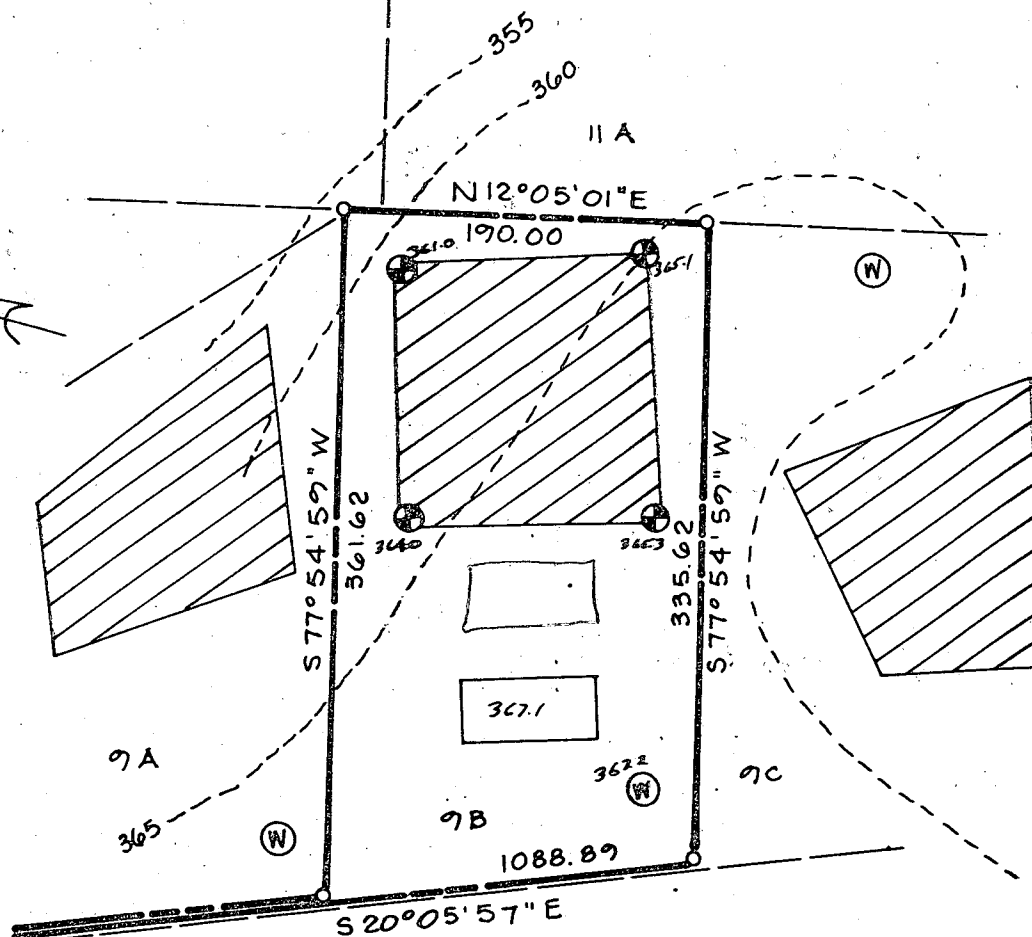

 This area indicates a private easement of approximately 10,000 square feet as required by the Maryland State Department of Health and Mental Hygiene for individual disposal. Improvements of any kind in this area are restricted until public sewage is available and servicing any residential structures constructed on this site. This easement shall become null and void upon connection to a public sewage system. Percolation test holes shown hereon have been field located and shown as "⊕".


The lots shown hereon comply with the minimum ownership width and lot areas as required by the Maryland State Department of Health and Mental Hygiene. Percolation areas and water wells for adjoining lots have been shown where pertinent.

APPROVED: For Private Water and Private Sewage Systems

County Health Officer

Date

11-12-80

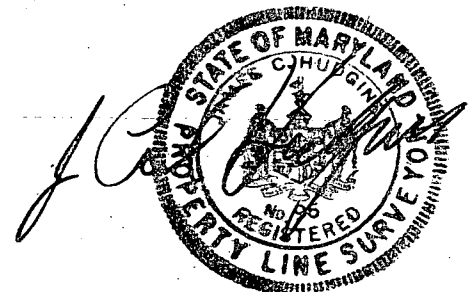

PERCOLATION TEST PLAT

PARCEL 9B

TALBOT'S LAST SHIFT

PROPERTY OF

HOWARD ASSOCIATES

ILCHESTER ROAD

1st Election District

Howard County Maryland

Scale: 1"=100' Date: 7-18-80

NTT Associates

Suite 307

Clark Bldg.

Columbia Md. 21044

321-0307

B 1 0317

SEQUENCE NO.
WRA USE ONLY

STATE OF MARYLAND

APPLICATION FOR PERMIT TO DRILL WELL

WRA PERMIT NUMBER

H0-733898

(THIS FORM IS TO BE PUNCHED
IN COLUMNS 3-6 ON ALL CARDS)

please print or type

fill in this form completely

DATE RECEIVED

4/30/81

8 (WRA USE ONLY) 13

OWNER INFORMATION

LAST NAME

OWNER

FIRST NAME

102 S Symington Ave

Balto.

STREET OR RFD

MD

21228

TOWN

STATE

ZIP

B 1 CONTINUED

DRILLER INFORMATION

DRILLER'S NAME

Stanley W. Bollinger Jr 308

SIGNATURE

DATE

B 2

WELL INFORMATION

APPROX. PUMPING RATE (GAL. PER MIN)

5

AVERAGE DAILY QUANTITY NEEDED (GAL. PER DAY)

550

USE FOR WATER (CIRCLE APPROPRIATE BOX)

- ☒ HOME (SINGLE OR DOUBLE HOUSEHOLD UNIT ONLY)
- ☐ FARMING (LIVESTOCK WATERING & AGRICULTURAL IRRIGATION)
- ☐ INDUSTRIAL, COMMERCIAL, STATE AND FEDERAL GOV. OTHER (REQUIRES APPROPRIATION PERMIT)
- ☐ PUBLIC OR PRIVATE WATER COMPANY (REQUIRES APPROPRIATION PERMIT AND STATE HEALTH DEPARTMENT APPROVAL)
- ☐ TEST, OBSERVATION, MONITORING (MAY REQUIRE APPROPRIATION PERMIT)

APPROXIMATE DEPTH OF WELL

185

FEET

APPROXIMATE DIAMETER OF WELL

6

NEAREST INCH

Method of Drilling (circle one)

- ☐ BORED (OR AUGERED) ☒ JETTED ☐ JETTED & DRIVEN
- ☐ AIR ROTARY ☒ AIR PERCUSSION ☐ ROTARY (HYDRAULIC)
- ☐ CABLE ☐ REVERSE ROTARY ☐ DRIVE POINT
- other

REPLACEMENT OR DEEPEMED WELLS

(Circle Appropriate Box)

- ☒ THIS WELL WILL NOT REPLACE AN EXISTING WELL
- ☐ THIS WELL WILL REPLACE A WELL THAT WILL BE ABANDONED AND SEALED
- ☐ THIS WELL WILL REPLACE A WELL THAT WILL BE USED AS A STANDBY
- ☐ THIS WELL WILL DEEPEMED AN EXISTING WELL
- PERMIT NUMBER OF WELL TO BE REPLACED OR DEEPEMED (IF AVAILABLE) 41 52

Not to be filled in by driller (WRA USE ONLY)

APPROX. PERMIT NUMBER

GAP

FORCE

WRITE

INITIALS

CONDITIONS

A E N S G W Q C L U

B 5

SPECIAL CONDITIONS

(WRA USE ONLY)

B 3

LOCATION OF WELL

COUNTY

Howard

SUBDIVISION

Howard Associates Prop.

SECTION

LOT 9B

NEAREST TOWN

Ellicott City


MILES FROM TOWN

3 1/2

(enter 0 if in town)

B 4


DIRECTION OF WELL FROM TOWN (CIRCLE BOX)

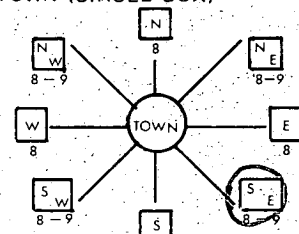

Ilchester Rd

NEAR WHAT ROAD

ON WHICH SIDE OF ROAD (CIRCLE APPROPRIATE BOX)

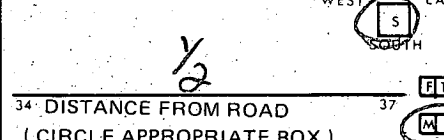

DISTANCE FROM ROAD (CIRCLE APPROPRIATE BOX)

SHOW LOCATION OF WELL WITH AN "X" IN THIS BOX

22' - casing
2' - above
19' - opening
4' - bags cement
7/15/81
JS

WRITE THE BOX NUMBER FROM THE MAP HERE

860 4
500 6

DRAW A SKETCH BELOW SHOWING LOCATION OF WELL IN RELATION TO NEARBY TOWNS AND ROADS AND GIVE DISTANCE FROM WELL TO NEAREST ROAD JUNCTION



B 4

NOT TO BE FILLED IN BY DRILLER HEALTH DEPARTMENT APPROVAL

COUNTY NAME

Howard

COUNTY NO.

A30777

EHA SIGNATURE

STATE HEALTH CIRCLE BOX

MO DAY YR

Frank Skinner, Sanitarian

MO DAY YR

Frank Skinner

NORTH

506

EAST

0864

ELEV. (FT.)

GRID

50

GRID

57

GRID


63


GRID

65

GRID

68

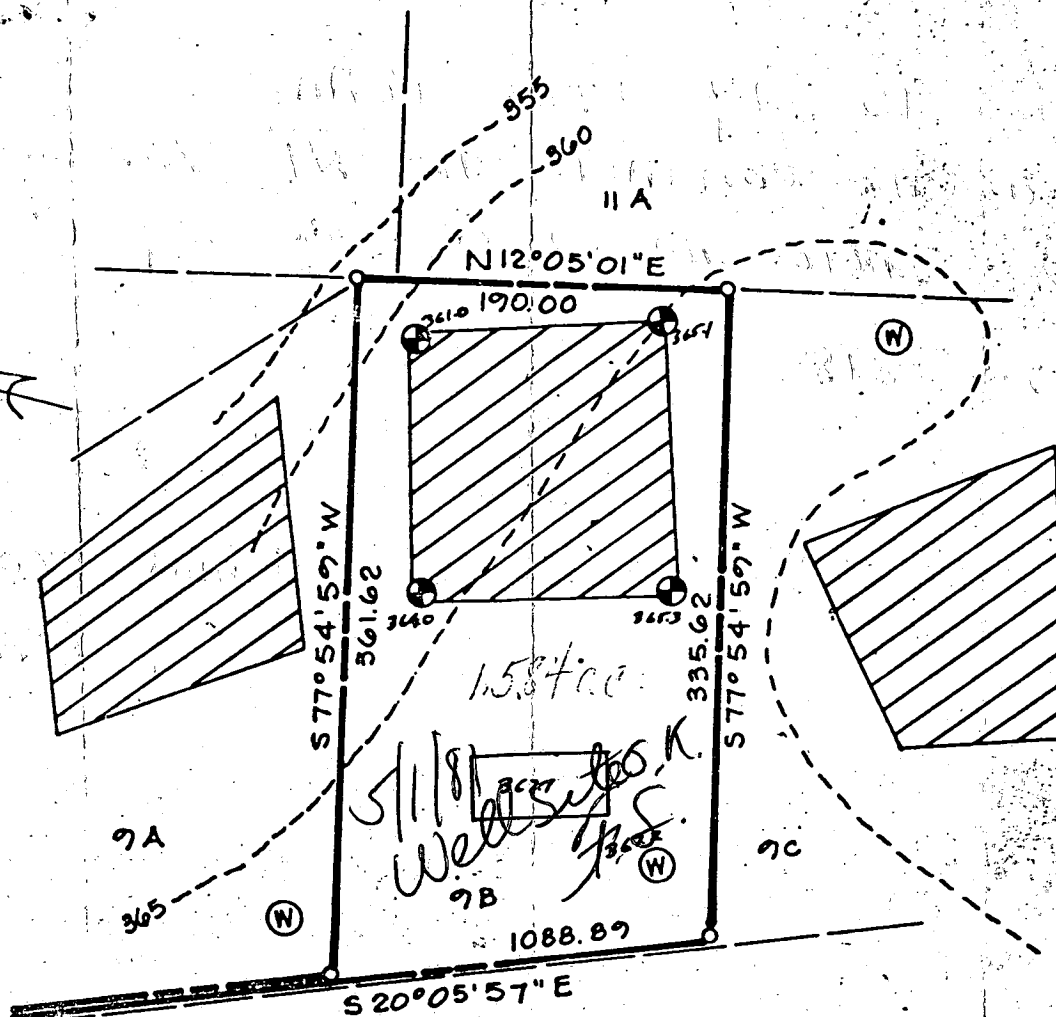

 This area indicates a private easement of approximately 10,000 square feet as required by the Maryland State Department of Health and Mental Hygiene for individual disposal. Improvements of any kind in this area are restricted until public sewage is available and servicing any residential structures constructed on this site. This easement shall become null and void upon connection to a public sewage system. Percolation test holes shown hereon have been field located and shown as "⊕".

The lots shown hereon comply with the minimum ownership width and lot areas as required by the Maryland State Department of Health and Mental Hygiene. Percolation areas and water wells for adjoining lots have been shown where pertinent.

APPROVED: For Private Water and Private Sewage Systems

Joann Byler
County Health Officer

11-12-80
Date



PERCOLATION TEST PLAT
PARCEL 7B
TALBOT'S LAST SHIFT
PROPERTY OF
HOWARD ASSOCIATES
ILCHESTER ROAD
1st Election District
Howard County Maryland
Scale: 1"=100' Date: 7-18-80

NTT Associates
Suite 307
Clark Bldg.
Columbia Md. 21044
321-0307

STAN,

THIS IS MY PLOT PLAN
YOU CAN CONTACT ME AT 102 S. Symington
Ave. BALTO. MD 21228 OR MY # IS
788-2818.

Thank you
Jim Munn

DIVISION OF
ENVIRONMENTAL
HEALTH

APR 30 : PM 1981

HC
HC

C 1	8266	SEQUENCE NO. (WRA USE ONLY)	STATE OF MARYLAND WELL COMPLETION REPORT FILL IN THIS FORM COMPLETELY PLEASE PRINT OR TYPE	THIS REPORT MUST BE SUBMITTED WITHIN 30 DAYS AFTER WELL IS COMPLETED COUNTY NUMBER A30777
-----	------	--------------------------------	---	---

Date Received (WRA use only)	7/14/81 DATE WELL COMPLETED	Depth of Well 175 (TO NEAREST FOOT)	PERMIT NO. FROM "PERMIT TO DRILL WELL" 40-73-3898
---------------------------------	---------------------------------------	--	--

OWNER	Nunn last name	Jim first name
STREET OR RFD	Ilchester Road	
TOWN	Ellicott City	
SUBDIVISION	Howard Assoc. - Talbots Last Shift	SECTION
LOT	9B	

WELL LOG Not required for driven wells		
STATE THE KIND OF FORMATIONS PENETRATED, THEIR COLOR, DEPTH, THICKNESS AND IF WATER BEARING		
DESCRIPTION (Use additional sheets if needed)	FEET FROM TO	Check if water bearing
Top Soil	0 2	
Brown Clay	2 6	
Brown Sandstone	6 18	
Granite	18 121	
Granite	121 124	J10
Granite	124 175	

GROUTING RECORD WELL HAS BEEN GROUTED (Circle Appropriate Box)		
YES <input checked="" type="checkbox"/> NO <input type="checkbox"/>		
TYPE OF GROUTING MATERIAL		
CEMENT <input checked="" type="checkbox"/>	BENTONITE CLAY <input type="checkbox"/>	
NO. OF BAGS 4	NO. OF POUNDS 376	
GALLONS OF WATER 24		
DEPTH OF GROUT SEAL (to nearest foot)		
from 0 ft. to 19 ft.		
TOP (enter 0 if from surface) BOTTOM		
CASING RECORD		
casing types insert appropriate code below	<input checked="" type="checkbox"/> ST	<input type="checkbox"/> CO
	STEEL	CONCRETE
	<input type="checkbox"/> PL	<input type="checkbox"/> OT
	PLASTIC	OTHER
MAIN CASING TYPE		
Nominal diameter top(main)casing (nearest inch)		
Total depth of main casing (nearest foot)		
5 6 22		

OTHER CASING (if used)		
EACH CASING	diameter inch	depth (feet) from to
<input type="checkbox"/>		
<input type="checkbox"/>		

SCREEN RECORD			
screen type or openhole	insert appropriate code below		
EACH SCREEN	<input checked="" type="checkbox"/> ST	<input type="checkbox"/> BR	<input type="checkbox"/> HO
	STEEL	BRASS, BRONZE	OPEN HOLE
	<input type="checkbox"/> PL	<input type="checkbox"/> OT	
	PLASTIC	OTHER	

C 2 (seq. no.)		
DEPTH (nearest ft.)		
40 19 175		
EACH SCREEN	SLOT SIZE	
<input type="checkbox"/>	1 2 3	
<input type="checkbox"/>		
<input type="checkbox"/>		
DIAMETER OF SCREEN (NEAREST INCH)		
from to		
GRAVEL PACK		
IF WELL DRILLED WAS FLOWING WELL CIRCLE BOX <input type="checkbox"/>		


WRA USE ONLY (NOT TO BE FILLED IN BY DRILLER)		
T (E.R.O.S.)		
W Q		
70 <input type="checkbox"/> 72 <input type="checkbox"/> 74 <input type="checkbox"/> 75 <input type="checkbox"/> 76 <input type="checkbox"/>		
TELESCOPE CASING LOG INDICATOR OTHER DATA		

C 3 (seq. no.)		
PUMPING TEST		
HOURS PUMPED (nearest hour) 2		
PUMPING RATE (gal. per min. to nearest gal.) 10		
METHOD USED TO MEASURE PUMPING RATE Bucket		
WATER LEVEL (distance from land surface)		
BEFORE PUMPING 40		
WHEN PUMPING 175		
TYPE OF PUMP USED (for test)		
<input checked="" type="checkbox"/> A air	<input type="checkbox"/> P piston	<input type="checkbox"/> T turbine
<input type="checkbox"/> C centrifugal	<input type="checkbox"/> R rotary	<input type="checkbox"/> O other (describe below)
<input type="checkbox"/> J jet	<input type="checkbox"/> S submersible	

PUMP INSTALLED YES NO		
DRILLER WILL INSTALL PUMP (CIRCLE APPROPRIATE BOX) <input type="checkbox"/> <input checked="" type="checkbox"/>		
IF DRILLER INSTALLS PUMP, THIS SECTION MUST BE COMPLETED FOR ALL WELLS EXCEPT HOME USE		
TYPE OF PUMP (WRITE APPROPRIATE LETTER IN BOX - SEE ABOVE: (A, C, J, P, R, S, T, O))		
CAPACITY: GALLONS PER MINUTE (to nearest gallon)		
PUMP HORSE POWER		
PUMP COLUMN LENGTH (nearest ft.)		
CASING HEIGHT (circle appropriate box and enter casing height)		
<input checked="" type="checkbox"/> above		
LAND SURFACE		
<input type="checkbox"/> below 2 (nearest foot)		

LOCATION OF WELL ON LOT		
SHOW PERMANENT STRUCTURE SUCH AS BUILDING, SEPTIC TANKS, AND/OR LANDMARKS AND INDICATE NOT LESS THAN TWO DISTANCES (MEASUREMENTS TO WELL)		

CIRCLE APPROPRIATE BOX		
<input checked="" type="checkbox"/> A A WELL WAS ABANDONED AND SEALED WHEN THIS WELL WAS COMPLETED		
<input type="checkbox"/> E ELECTRIC LOG OBTAINED		
<input type="checkbox"/> P TEST WELL CONVERTED TO PRODUCTION WELL		
I HEREBY CERTIFY THAT I HAVE COMPLIED WITH ALL CONDITIONS STATED ON THE ABOVE-CAPTIONED "PERMIT TO DRILL WELL", AND THAT INFORMATION CONTAINED IN THIS REPORT IS TRUE, ACCURATE, AND COMPLETE TO THE BEST OF MY KNOWLEDGE, INFORMATION AND BELIEF.		
DRILLERS IDENT. NO. 308		
DRILLERS SIGNATURE (MUST MATCH SIGNATURE ON APPLICATION)		
SITE SUPERVISOR (sign. of driller or journeyman responsible for sitework if different from permittee)		

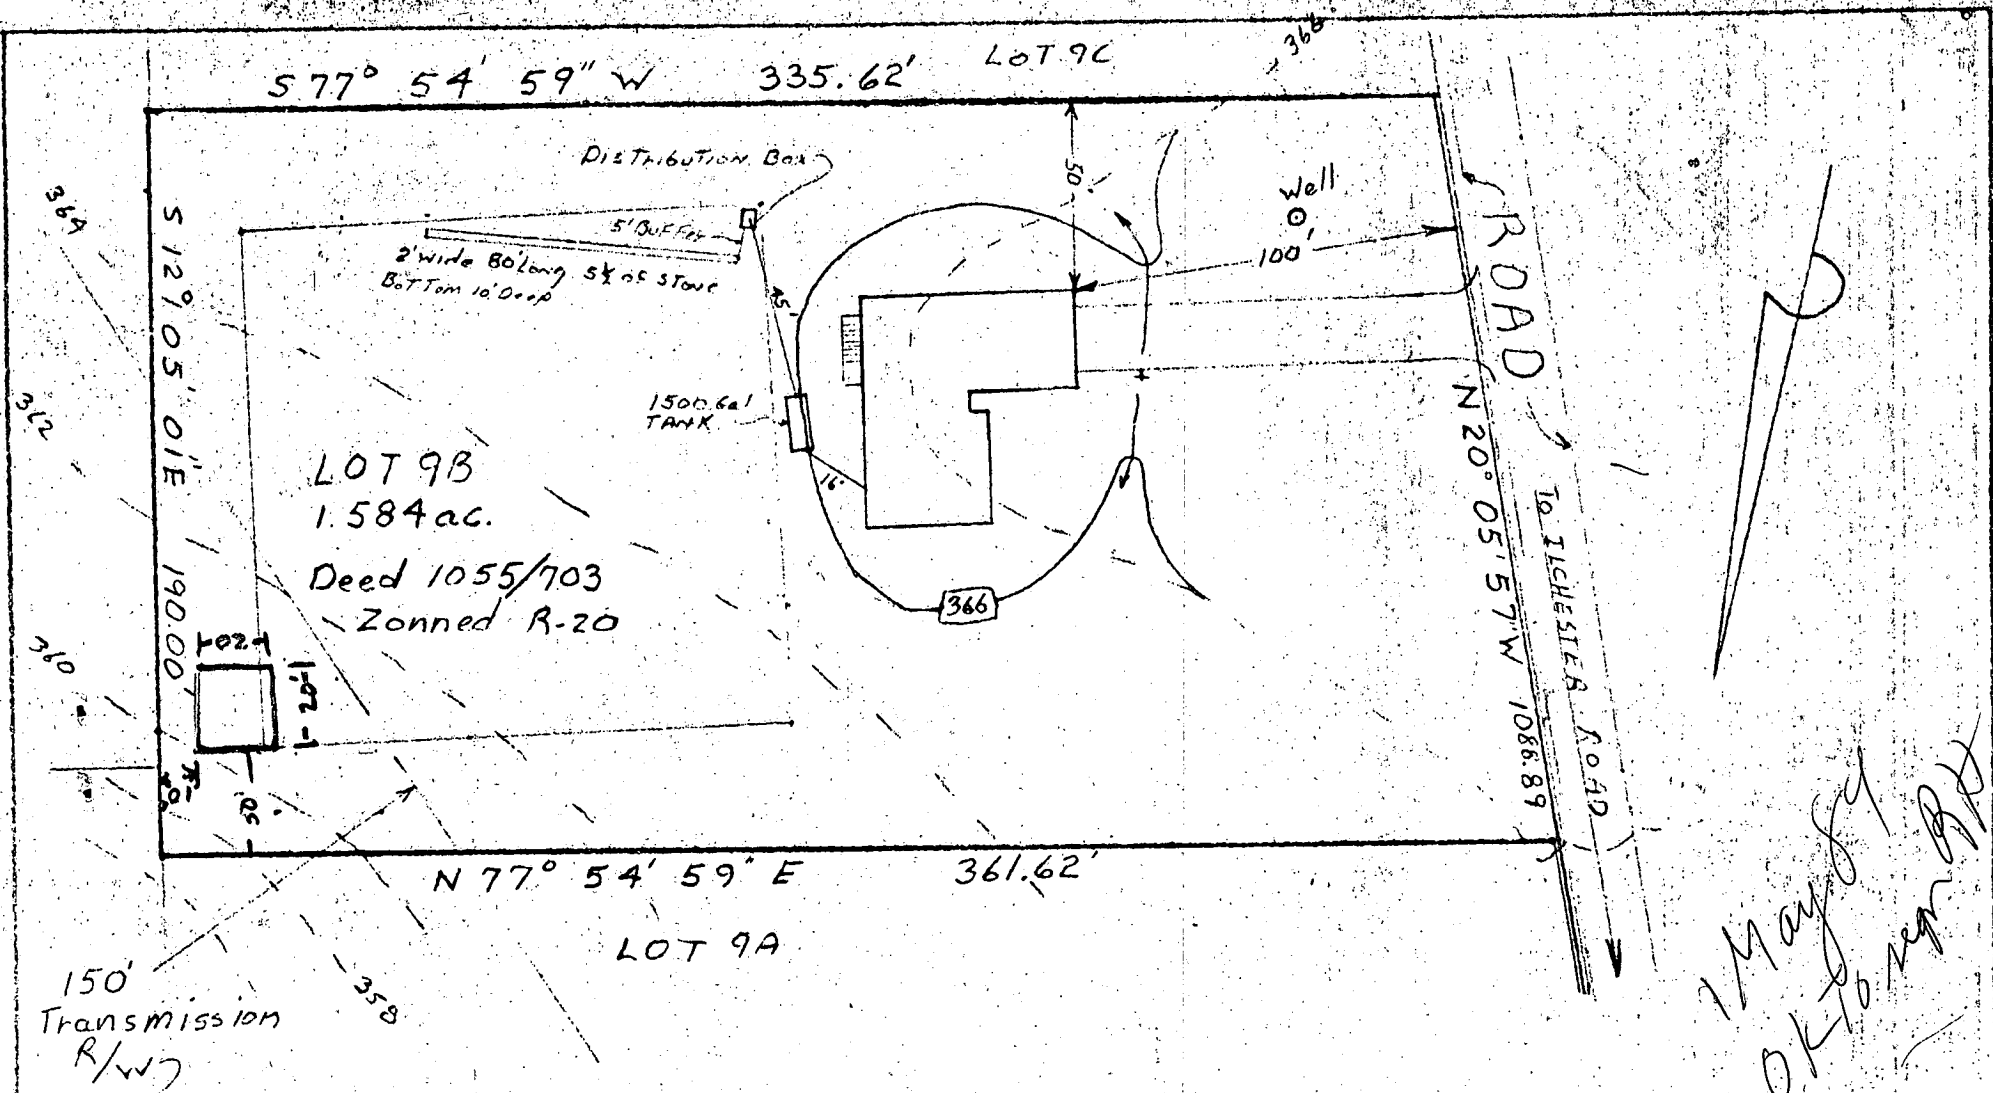

HOUSE:
 FIRST FLOOR ELEV. 368.0
 BASEMENT ELEV. 359.5
 INVERT @ HOUSE 361.85
 SEPTIC TANK:
 EXISTING GRADE 365.0
 PROPOSED GRADE 366.0
 INVERT IN TANK 361.52
 DISTRIBUTION BOX:
 EXISTING GRADE 365.30
 PROPOSED GRADE 365.30
 INVERT 360.80

I certify the above measurements &
 elevations are actual and true for
 for this property.

J. Carl Hudgins
 J. Carl Hudgins

GRADING STUDY LOT 9B

PARCEL # 698

TAX MAP # 31

TALBOTS LAST SHIFT

1st ELECTION DISTRICT

HOWARD COUNTY MARYLAND

SCALE 1"=50' DATE 11/11/81

N 77° 54' 59" E 367.15'

LOT 9A
1.296 AC

150' WIDE EIGHT OF

S 12° 05' 01" E
158.54'

S 77° 54' 59" W 344.78'

LOT 9B
1.445 AC

190.00'

Location of S.T. to
addition 10' OK
317.98' 6/5/02 KN

S 77° 54' 59" W

160.11' N 20° 06' 49" W
TALBOT'S LANDING 50' R/W
191.88'



PLAT OF PROPERTY
OF
James S. Nunn
&
Mark A West
1ST ELECTION DISTRICT
HOWARD COUNTY MD
SCALE 1"=50'