

PERMIT

SEWAGE DISPOSAL SYSTEM

DEPARTMENT OF HEALTH AND MENTAL HYGIENE

INDEXED

HOWARD COUNTY HEALTH DEPARTMENT BUREAU OF ENVIRONMENTAL HEALTH

313-2640

P 49074
A REPAIR

DISTRICT 5th

DATE 3/18/93

DATE SYSTEM APPROVED 4/6/93

INSPECTOR R.H.

Connor Construction, Inc.

IS PERMITTED TO INSTALL ☒ ALTER

ADDRESS 8455 B Baltimore National Pike, Ellicott City, MD PHONE 410-465-9531

SUBDIVISION Mooresfield LOT 9C ROAD 11710 Wayneridge Court

PROPERTY OWNER Maxwell G. Strange
ADDRESS 11710 Wayneridge Court
Fulton, Maryland 20759

SEPTIC TANK CAPACITY 1250 GALLONS + PUMP PIT 500-1000 GAL TANK

NUMBER OF BEDROOMS 4 DUAL EFFLUENT PUMPS & ALARM

180 SQUARE FEET PER BEDROOM

LINEAR FEET OF TRENCH REQUIRED 104 NEEDED CONTRACTOR TO SUPPLY PUMP DETAIL
LATER INSTEAD OF SEPTIC PERMITS

REPAIR - PURPOSE - TO ESTABLISH ADEQUATE SEPTIC CAPACITY TO SUPPORT ADDITION - BUILDING

PERMIT SERIAL NUMBER: 47394.

Call for inspection when ground is opened so sanitarian can recommend repair. 03/17/93

TRENCH 10 FT DEEP INLET 7 FT 7 FT STONE 10 FT
LONG 2 FT WIDE. PLACE THE TRENCHES BETWEEN
PERC HOLES (3) & (4) RUNNING 10-15 FT FROM THE
RIGHT SIDE LINE & PARALLEL TO RIGHT SIDE LINE
FILL IN OLD SYSTEM

PLANS APPROVED BY DATE

COVER NO WORK UNTIL INSPECTED AND APPROVED USE TOP SEAMED TANKS FOR
NEW SYSTEM BECAUSE OF UNDER-
NEITHER THE HOWARD COUNTY COUNCIL NOR THE HEALTH DEPARTMENT IS RESPONSIBLE FOR THE SUCCESSFUL OPERATION OF ANY SYSTEM
GROUND WATER

NOTE: CLEANOUT REQUIRED EVERY 70 FEET OF SEWER LINE AND/OR AT 90° SWEEPS IN LINES FROM HOUSE TO DRAIN FIELDS/90° ELBOWS NOT
ACCEPTABLE.

NOTE: ALL PARTS OF SEPTIC SYSTEMS (I.E. TANK, DISTRIBUTION BOX TRENCHES) TO BE 100 FEET FROM WELL (UNLESS OTHERWISE SPECIFICALLY
AUTHORIZED) FROM WAYNER RIDGE COURT

NOTE: IF DEEP TRENCH(ES) ARE USED CALL FOR INSPECTION BEFORE AND AFTER PLACING GRAVEL IN TRENCH(ES)

NOTE: NO DRY WELL SHALL EXCEED 15 FOOT IN DIAMETER NO ABSORPTION TRENCH TO EXCEED 100 FEET IN LENGTH

NOTE: ALL PIPE FROM HOUSE TO SEPTIC TANK MUST BE CAST IRON OR SCHEDULE 35/40 PVC OR ABS


PERMIT VOID AFTER TWO YEARS

NOTE: INSTALL STAND PIPE ON SEPTIC TANK AND DRY WELL STAND PIPES MUST BE 6 INCHES IN DIAMETER CAST IRON, CONCRETE OR TERRAZO OR
PVA OR ABS ACCEPTED. IF TOP OF SEPTIC TANK IS DEEPER THAN 3 FEET, MANHOLE TO GRADE REQUIRED.

NOTE: DISTRIBUTION BOXES MUST HAVE BAFFLES

*INSTALLER IS RESPONSIBLE FOR OBTAINING FINAL APPROVAL ON THIS PERMIT

49074

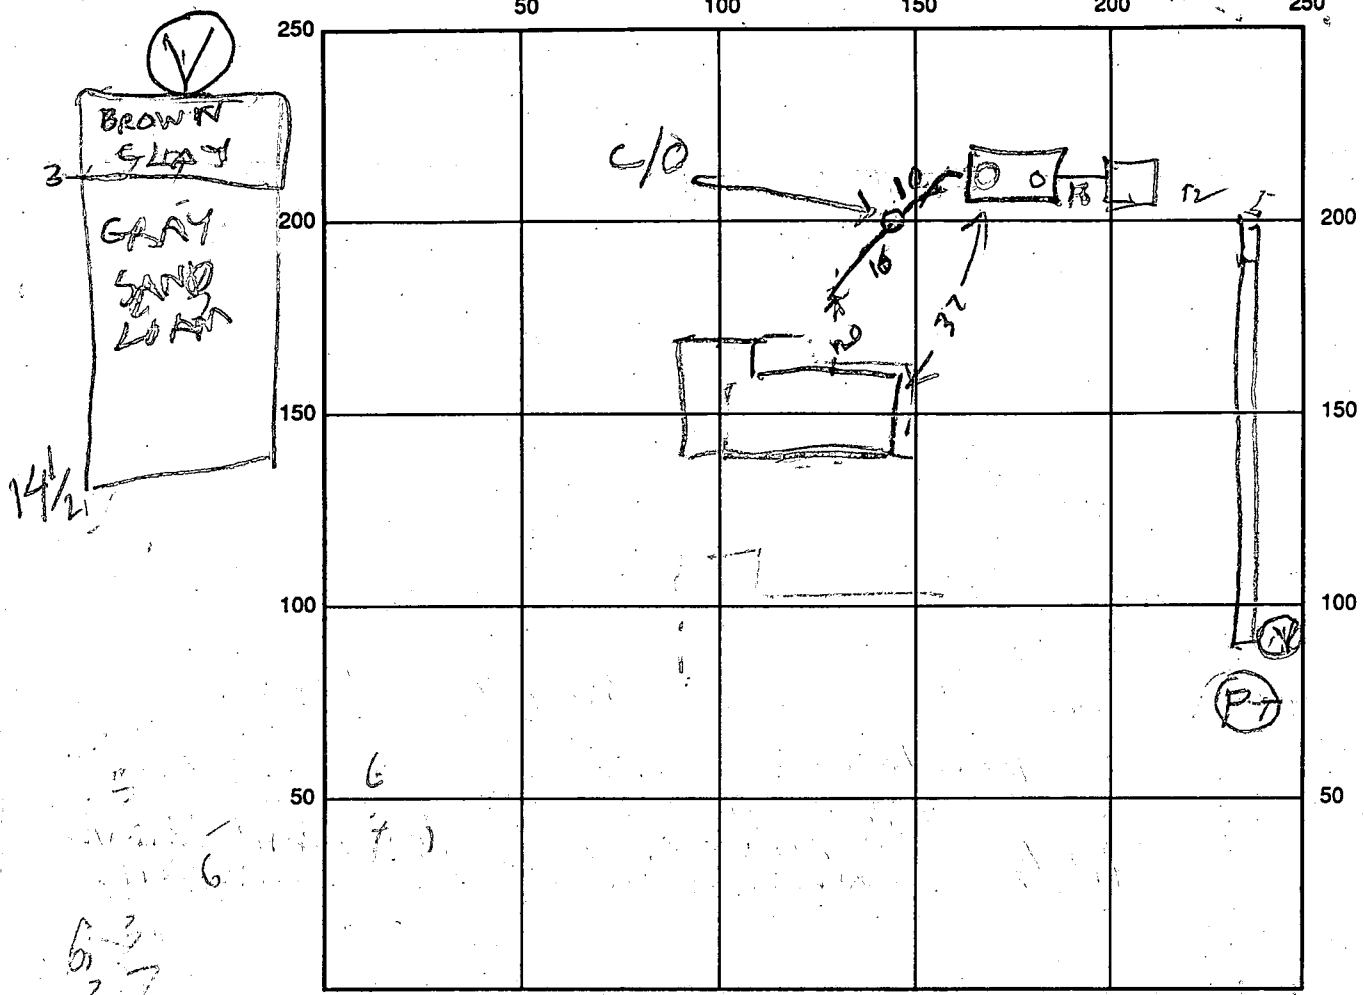

INDICATE NORTH - NAME ADJOINING ROADWAY AS BASE LINE

SEPTIC TANK LEVEL 2000 TOP SEAM CLEANOUTS 0
500 PUMP PIT

DISTRIBUTION BOX LEVEL _____

DRAIN FIELD/TITLE DEPTH 12-15 FT. TRENCH WIDTH 2 FT. INLET DEPTH 2-8 FT.

EFFECTIVE GRAVEL DEPTH _____ FT. TOTAL LENGTH 110 FT.

NUMBER OF TRENCHES 1 ONE SIDEWALL/BOTTOM AREA _____ SQ. FT.

DRYWALL INSIDE DIAMETER _____ FT. EFFECTIVE DEPTH BELOW INLET _____ FT.

ABSORBENT AREA _____ SQ. FT.

REMARKS: 3/23/93 SEE ATTACHED PERC REPORTS FOR TEST RESULTS

4/6/93 NEED TO SUPPLY PUMP DETAIL FOR SECOND TRENCH
DUG 15 FT DEEP BUT SOIL OK VISUAL HOLE DUG 14 1/2 FT DEEP

AT END OF TRENCH. (V) = VISUAL HOLE (P) = OLD PERC TEST

OK TO DIG 15 FT TRENCH SOIL OK, COVER TANK & HOSE SEWER & TRENCH

SUBMIT PAPER WORK ABOUT PUMPS. INSPECTION OF PUMPS OPERATING NEEDED

DATE SYSTEM COMPLETE APPROVED 4/6/93 INSPECTOR R HODGES

NO FURTHER CONTACT AS OF 5/20/95 - PUMPS PRESSURED & OPERATIONAL
INDEX AS COMPLETE (CW)

214.02'
10' UTILITY EASEMENT

LOT 9
95.799 #

LOT 10

3/17/93
PER TODD CONNER
TANK 1' TO ADDITION

20-25' TO EDGE OF
DAYWALK ON
RIGHT HAND
SIDE


51
22
1.4

I Recommend holding decision
until get better info on
Addn location & size, use
PP 2-29-93
Need precise bearing (t. scale)
of all Addn. Also show
distance to
Septic. High 10' ST-Addn
available. However, 100'
setback from stream
severely limits available
Septic repairs
SCA Approx 40' x 130' less
loss to landscape topography)
also only 7500 sq ft.
How much of a Addn
is Addn t will there?
No Septic problem evident at
this time.

SCALE 1" = 50'
BP 47394
3/12/93

BUILDING PERMIT
APPLICATION
REJECTED
SEE OTHER SIDE R/D

59
32
2

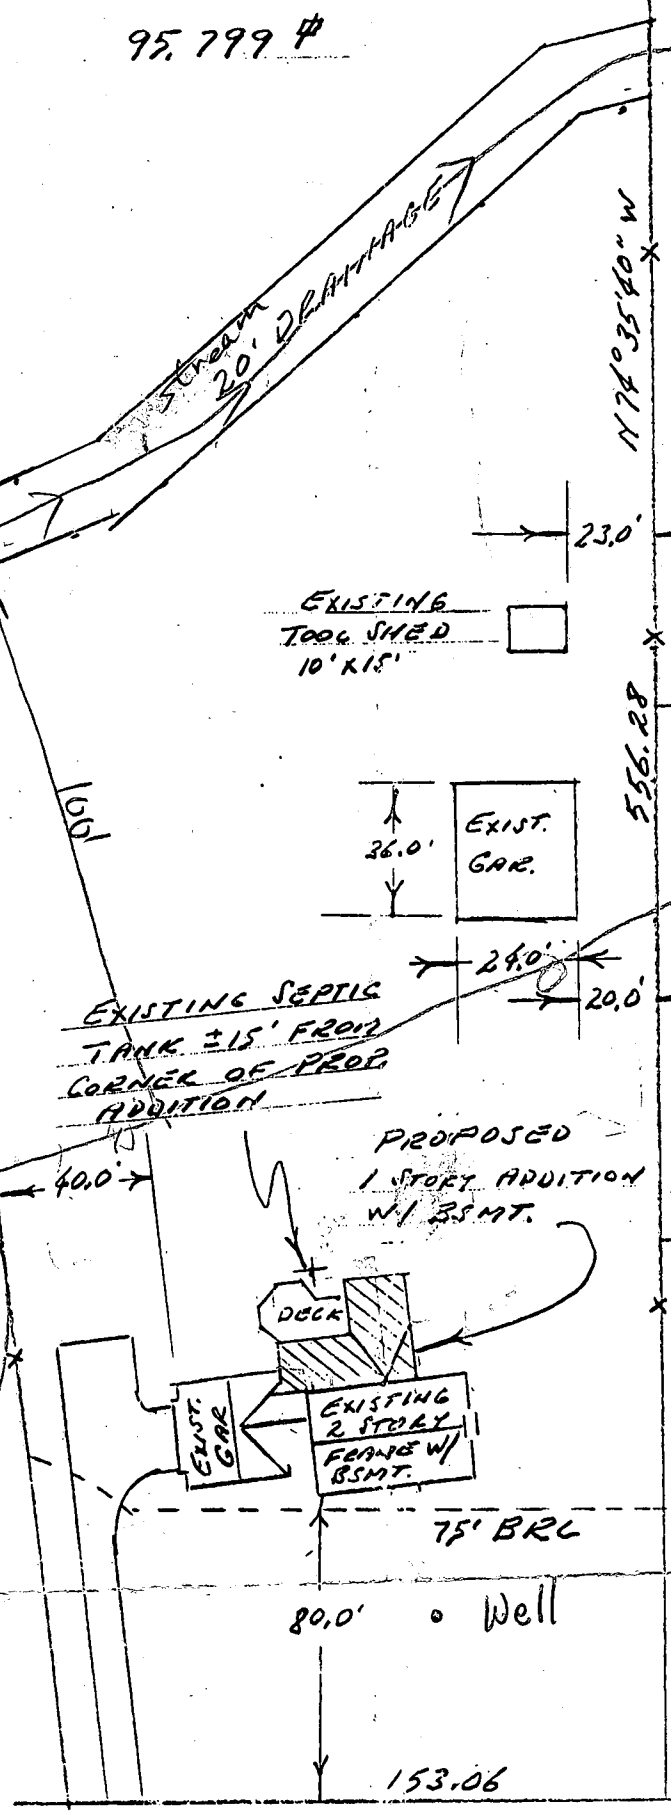

WAYNERIDGE COURT
50' R.W.

SITE PLAN
STRANGE RESIDENCE
11710 WAYNERIDGE CT.
FULTON, MD 20759
LOT #9 - SECTION II
MOORESFIELD

STREAM
(NO OVERFLOW SEWER)

CONTRACTOR

COULD NOT FIND 2ND WELL




?



TANK FULL

EDGE OF TANK
UNDER FUTURE
ROOM ADDITION

93 FEB 19 PM 1:25

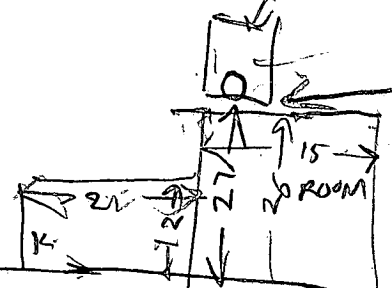

EXIST
HOUSE



9
7
3
4

WAYNE RIDGE RD

APPLICATION

PERCOLATION TESTING

A _____

P 49074

HOWARD COUNTY HEALTH DEPARTMENT
BUREAU OF ENVIRONMENTAL HEALTH
P.O. BOX 476 ELLICOTT CITY, MARYLAND 21043
TELEPHONE: 461-9933

REPAIR PERC

DISTRICT _____

DATE _____

TO: THE COUNTY HEALTH OFFICER
ELLICOTT CITY, MARYLAND

I, HEREBY, APPLY FOR THE NECESSARY TEST IN ORDER TO CONSTRUCT (OR RECONSTRUCT) A SEWAGE DISPOSAL SYSTEM.

PROPERTY OWNER MAXWELL STRANGE

ADDRESS 17710 WAYNERIDGE CT PHONE _____
FELTON MD 20759

PROSPECTIVE BUYER _____

ADDRESS _____ PHONE _____

PROPERTY LOCATION:

SUBDIVISION _____ LOT NO. _____

ROAD AND DESCRIPTION 11710 WAYNERIDGE COURT

TAX MAP _____ PARCEL # _____

SIZE OF LOT _____ TYPE BLDG. SFD
(SINGLE FAMILY DWELLING OR COMMERCIAL)

~~COPIES PERMITS SIGNED~~

~~AND RETURNED~~ 3-25-93

Serial # 47394

THE SYSTEM INSTALLED UNDER THIS APPLICATION IS ACCEPTABLE ONLY UNTIL PUBLIC FACILITIES BECOME AVAILABLE. I FULLY UNDERSTAND THE
FEE CONNECTED WITH THE FILING OF THIS PERC TEST APPLICATION IS NON-REFUNDABLE UNDER ANY CIRCUMSTANCES. I ALSO AGREE TO COMPLY
WITH ALL M.O.S.H.A. REQUIREMENTS IN TESTING THIS LOT.

(SIGNATURE OF APPLICANT)

APPROVED BY _____ FOR _____ DATE _____

REJECTED BY _____ FOR _____ DATE _____

HOLD PENDING FURTHER TESTS _____ DATE _____

REASONS FOR REJECTION OR HOLDING _____

HD-216

THIS IS NOT A PERMIT

MAX WELLS
STRANGE

APPLICATION

PERCOLATION TESTING

HOWARD COUNTY HEALTH DEPARTMENT
BUREAU OF ENVIRONMENTAL HEALTH
P.O. BOX 476 ELLICOTT CITY, MARYLAND 21043
TELEPHONE: 461-9933

REPAIR PER

A _____
P 49084

DISTRICT _____

DATE _____

TO: THE COUNTY HEALTH OFFICER
ELLICOTT CITY, MARYLAND

I, HEREBY, APPLY FOR THE NECESSARY TEST IN ORDER TO CONSTRUCT (OR RECONSTRUCT) A SEWAGE DISPOSAL SYSTEM.

PROPERTY OWNER MAX WEL G STRANGE

ADDRESS 11710 WAYNERIDGE CT PHONE 723 3858

FULTON MD

PROSPECTIVE BUYER _____

ADDRESS _____ PHONE _____

PROPERTY LOCATION:

SUBDIVISION MOORES FIELD LOT NO. 9

ROAD AND DESCRIPTION 11710 WAYNERIDGE CT

TAX MAP _____ PARCEL # _____

SIZE OF LOT _____ TYPE BLDG. _____
(SINGLE FAMILY DWELLING OR COMMERCIAL)

THE SYSTEM INSTALLED UNDER THIS APPLICATION IS ACCEPTABLE ONLY UNTIL PUBLIC FACILITIES BECOME AVAILABLE. I FULLY UNDERSTAND THE
FEE CONNECTED WITH THE FILING OF THIS PERC TEST APPLICATION IS NON-REFUNDABLE UNDER ANY CIRCUMSTANCES. I ALSO AGREE TO COMPLY
WITH ALL M.O.S.H.A. REQUIREMENTS IN TESTING THIS LOT. _____

(SIGNATURE OF APPLICANT)

APPROVED BY _____ FOR _____ DATE _____

REJECTED BY _____ FOR _____ DATE _____

HOLD PENDING FURTHER TESTS _____ DATE _____

REASONS FOR REJECTION OR HOLDING _____


HD-216

THIS IS NOT A PERMIT

②
SOIL PROFILE

7.18
class
- 6.15

BUL
BROWN
SAND
WITH
FEW
FOIL

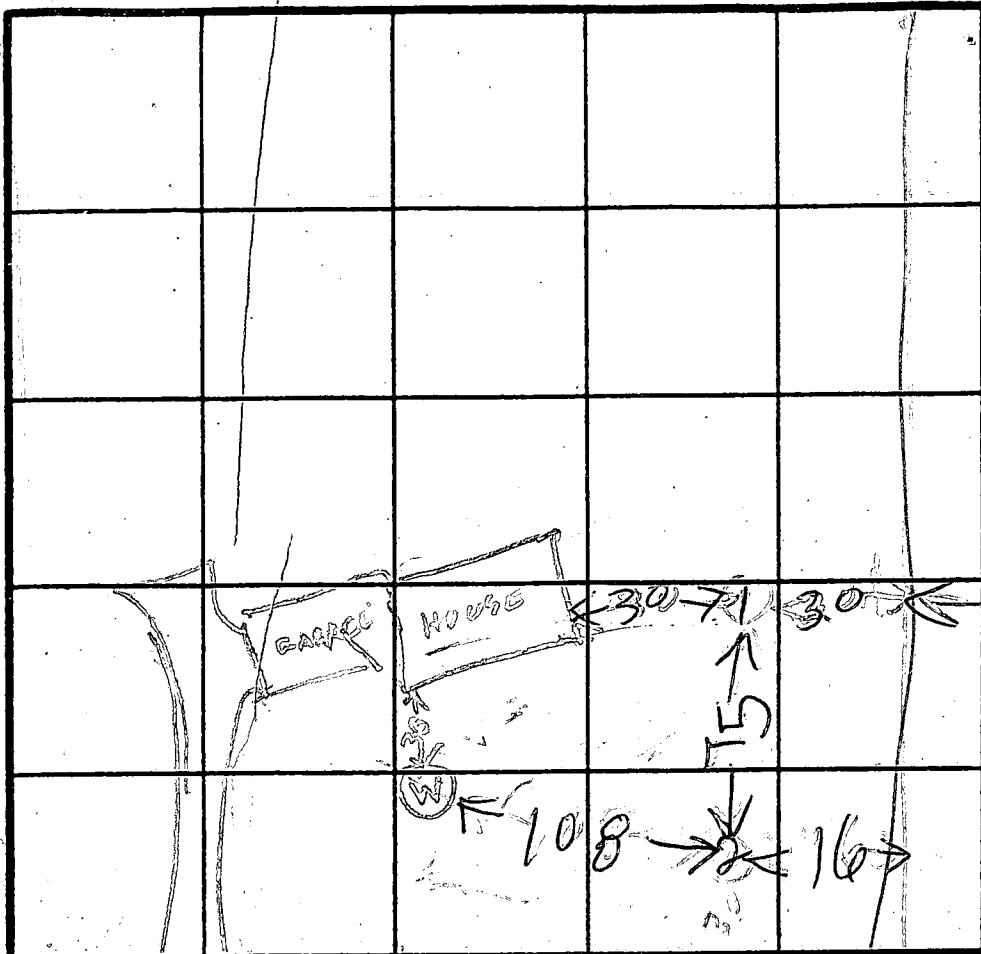

INDICATE NORTH - NAME ADJOINING ROADWAY AS BASE LINE.

WAYNERIDGE

DATE	TEST NO.	DEPTH	PRE-WET		TEST - 1" DROP		TIME
			START	STOP	START	STOP	
2/23/93	3 S	4	143	153	135	210	115
	3 V	11	OK				
	4 S	4 1/2	207	212	118	250	112
	4 V	11	OK				

REMARKS _____

TYPE OF SOIL _____

TESTED BY RAYMOND J. G. G. G. ALSO PRESENT Devin

PERMIT

SEWAGE DISPOSAL SYSTEM

MARYLAND STATE DEPARTMENT OF HEALTH

HOWARD COUNTY

ELLICOTT CITY

DISTRICT 5

DATE 7/1/65

INDEXED

R. W. Dubin

IS PERMITTED TO INSTALL ☒ ALTER

ADDRESS Brookeville, Maryland

PHONE 774-9615

A SEWAGE DISPOSAL SYSTEM LOCATED AT

SUBDIVISION Moorefield

ROAD Wayne Ridge Ct.

LOT 9 C

PROPERTY OWNER McHenry Co.

Maxwell G. Strange

ADDRESS Clarksville, Maryland

SPECIFICATIONS - 3 bedrooms

DRAIN FIELD _____ DEPTH _____ FEET, BOTTOM AREA _____ SQ. FT.

SEEPAGE PITS _____ ABSORBENT SIDE-WALL AREA _____ SQ. FT.

SEPTIC TANK CAPACITY 750 GALLONS

FOR GARBAGE GRINDER, INCREASE DISPOSAL AREA 22% & TANK CAPACITY 50%.

OTHER Dry well - 390 sq. ft. absorbent sidewall area below inlet pipe.

Locate dry well 150' from front lot line and 56' from right side line as lot is seen facing from Wayneridge St.

Distribution box not required on this job.

PLANS APPROVED BY Ronald Fletcher

DATE 3/17/64

FILL SEPTIC TANK AND DISTRIBUTION BOX WITH WATER BEFORE CALLING FOR AN INSPECTION. COVER NO WORK UNTIL INSPECTED AND APPROVED.

NEITHER THE HOWARD COUNTY COMMISSIONERS NOR THE HEALTH DEPARTMENT IS RESPONSIBLE FOR THE SUCCESSFUL OPERATION OF ANY SYSTEM.


BLDG. PERMIT SIGNED
AND RETURNED 5/19/67

Serial # 11898
garage

A 08144

1428
68
1496

194.20
68
126020

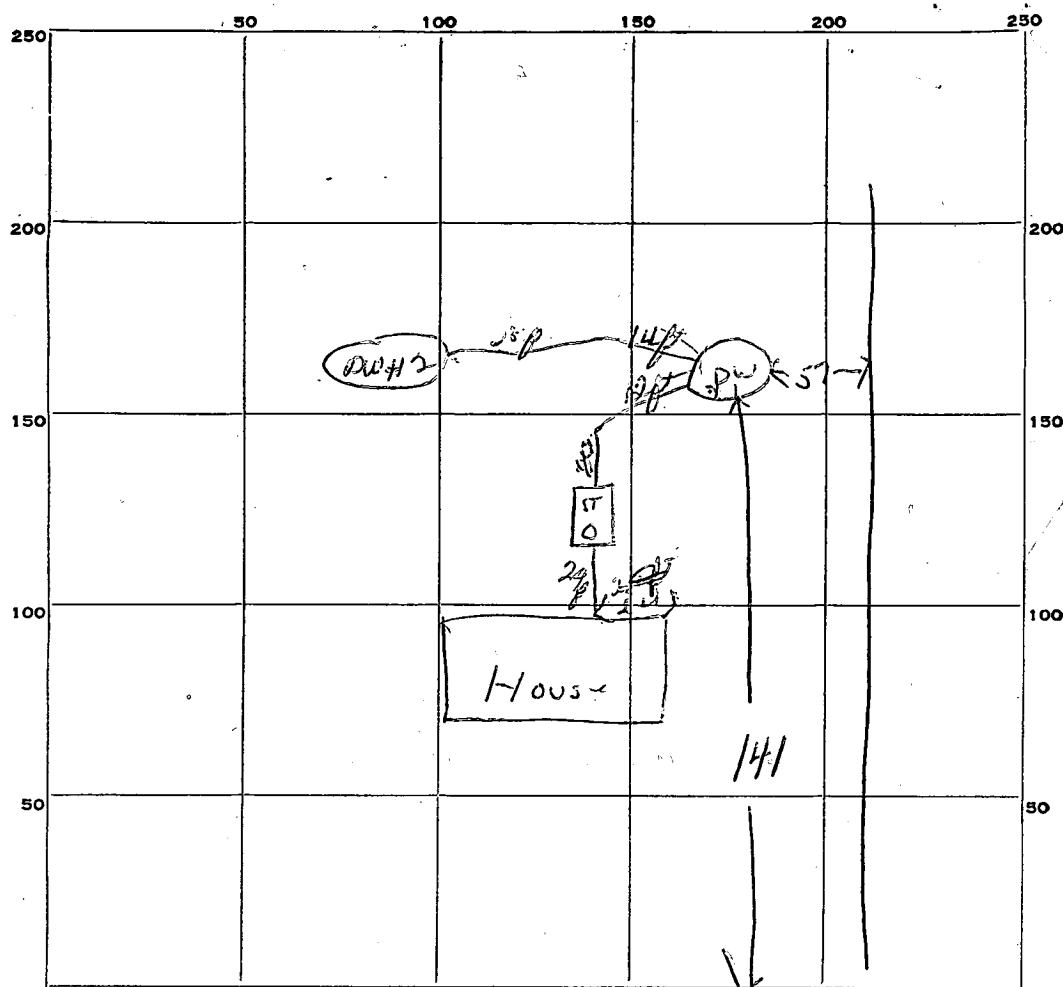**PERMIT CARD**

SEPTIC TANK, LEVEL

CLEANOUTS

DISTRIBUTION BOX, LEVEL

TILE FIELD, DEPTH _____ FT. TRENCH WIDTH _____ FT.

GRAVEL DEPTH _____ IN. TOTAL LENGTH _____ FT.

NUMBER OF TRENCHES_____ TOTAL BOTTOM AREA_____

SEEPAGE PITS, INSIDE DIAMETER_____FT. DEPTH BELOW INLET_____FT.

ABSORBENT AREA _____ SQ. FT.

REMARKS

REMARKS Dry Wall # 1. Dist Wall to Dist wall diameter is 13 1/2" average + Epitaxial bulge on lat = 204" $\frac{1}{2}$ in

Dry Wall # 2. " " " 13 1/2" avg x 5" = 204" $\frac{1}{2}$ in

Line from house to Septic Tank ~~not~~ installed - call for final inspection

When this is done. SW. M - ckt cover from Tank to Dry Wells. sur
8/4/65 - House sewer still not yet installed B. J. H

DATE SYSTEM APPROVED

INSPECTOR

APPLICATION

A 08144

P _____

SEWAGE DISPOSAL TESTING

MARYLAND STATE DEPARTMENT OF HEALTH

HOWARD COUNTY

ELLICOTT CITY

DISTRICT 5

DATE 3/11/64

Septic tank - 750 gal.
Drywell - 390 sq. ft. absorbent sidewall area
below inlet pipe
Locate drywell 150' from front lot line and 56' from
right sideline as lot is seen facing from Wayneridge St.

TO: THE COUNTY HEALTH OFFICER
ELLICOTT CITY, MARYLAND

I, HEREBY, APPLY FOR THE NECESSARY TESTS IN ORDER TO CONSTRUCT (OR RECONSTRUCT) A SEWAGE DISPOSAL SYSTEM.

PROPERTY OWNER McHenry Co.

ADDRESS Clarksville, Maryland PHONE _____

PROPERTY LOCATION:

SUBDIVISION Moorefield LOT NO. 9 C

ROAD AND DESCRIPTION Wayne Ridge Rd. Court

OCCUPANT _____ PHONE _____

PERSON TO CONSTRUCT SYSTEM _____

ADDRESS _____ PHONE _____

SIZE OF LOT 1 acre TYPE BLDG. 3

NUMBER OF BEDROOMS

IF NOT SINGLE RESIDENCE DESCRIBE _____

SIGNATURE OF APPLICANT David Scager

✓ APPROVED BY Ronald F. Miller FOR Drywell DATE 3/17/64

(KIND OF SYSTEM)


REJECTED BY _____ FOR _____ DATE _____

(KIND OF SYSTEM)

HOLD PENDING FURTHER TESTS _____ DATE _____

REASONS FOR REJECTION OR HOLDING _____

THIS IS NOT A PERMIT

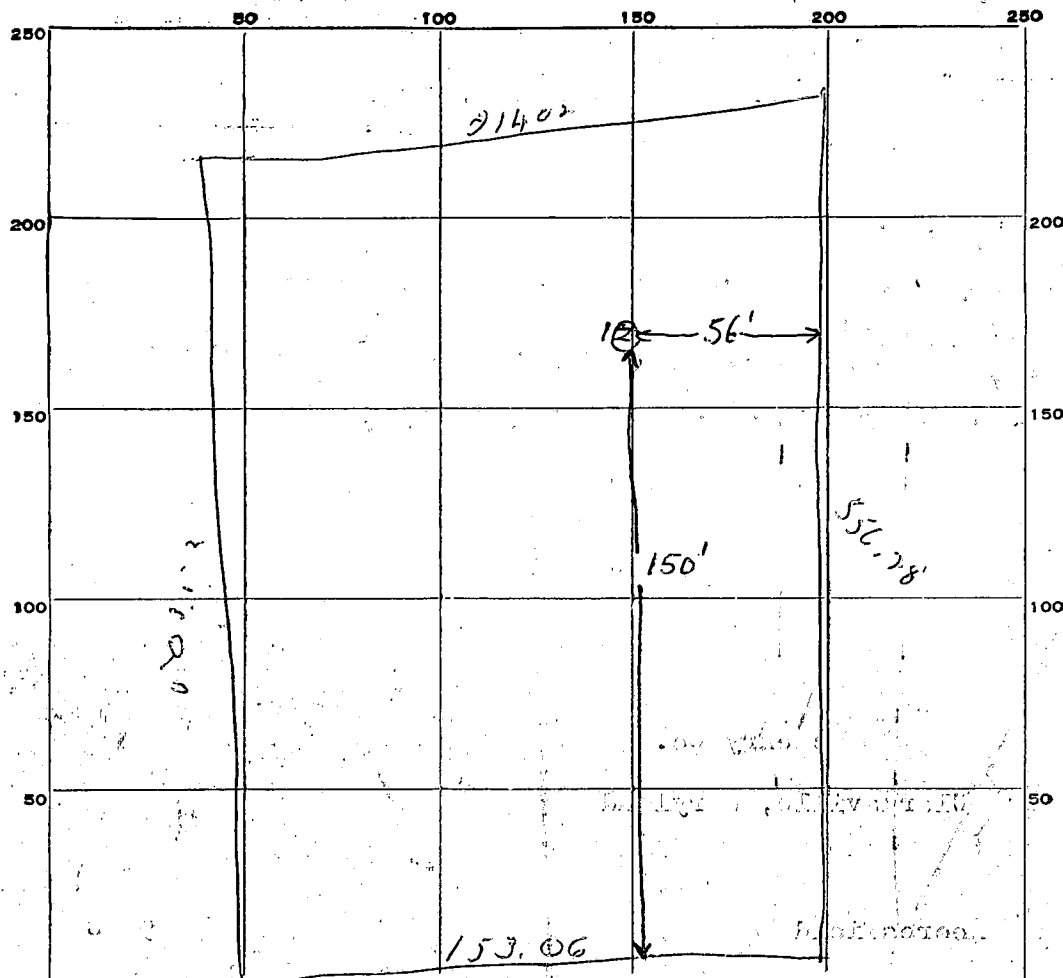

INDICATE NORTH. - NAME ADJOINING ROADWAY AS BASE LINE.

Wayne Ridge Co.

DATE	TEST NO.	DEPTH	PRE-WET		TEST - 1" DROP		TIME
			START	STOP	START	STOP	
3/17/64	1	9 ft	1016	1019	1019	1022	3 min.
	2	4 1/2 ft	1016	1026	1026	1049	23 min.

SOIL AUGER FINDING

TESTED BY *RDF DWM 3/17/64*

REMARKS


ALSO PRESENT *David Scagg*

LOT NO. *9C*

5/14/67 copy made

18' 11" 11' 11'

LOT 10

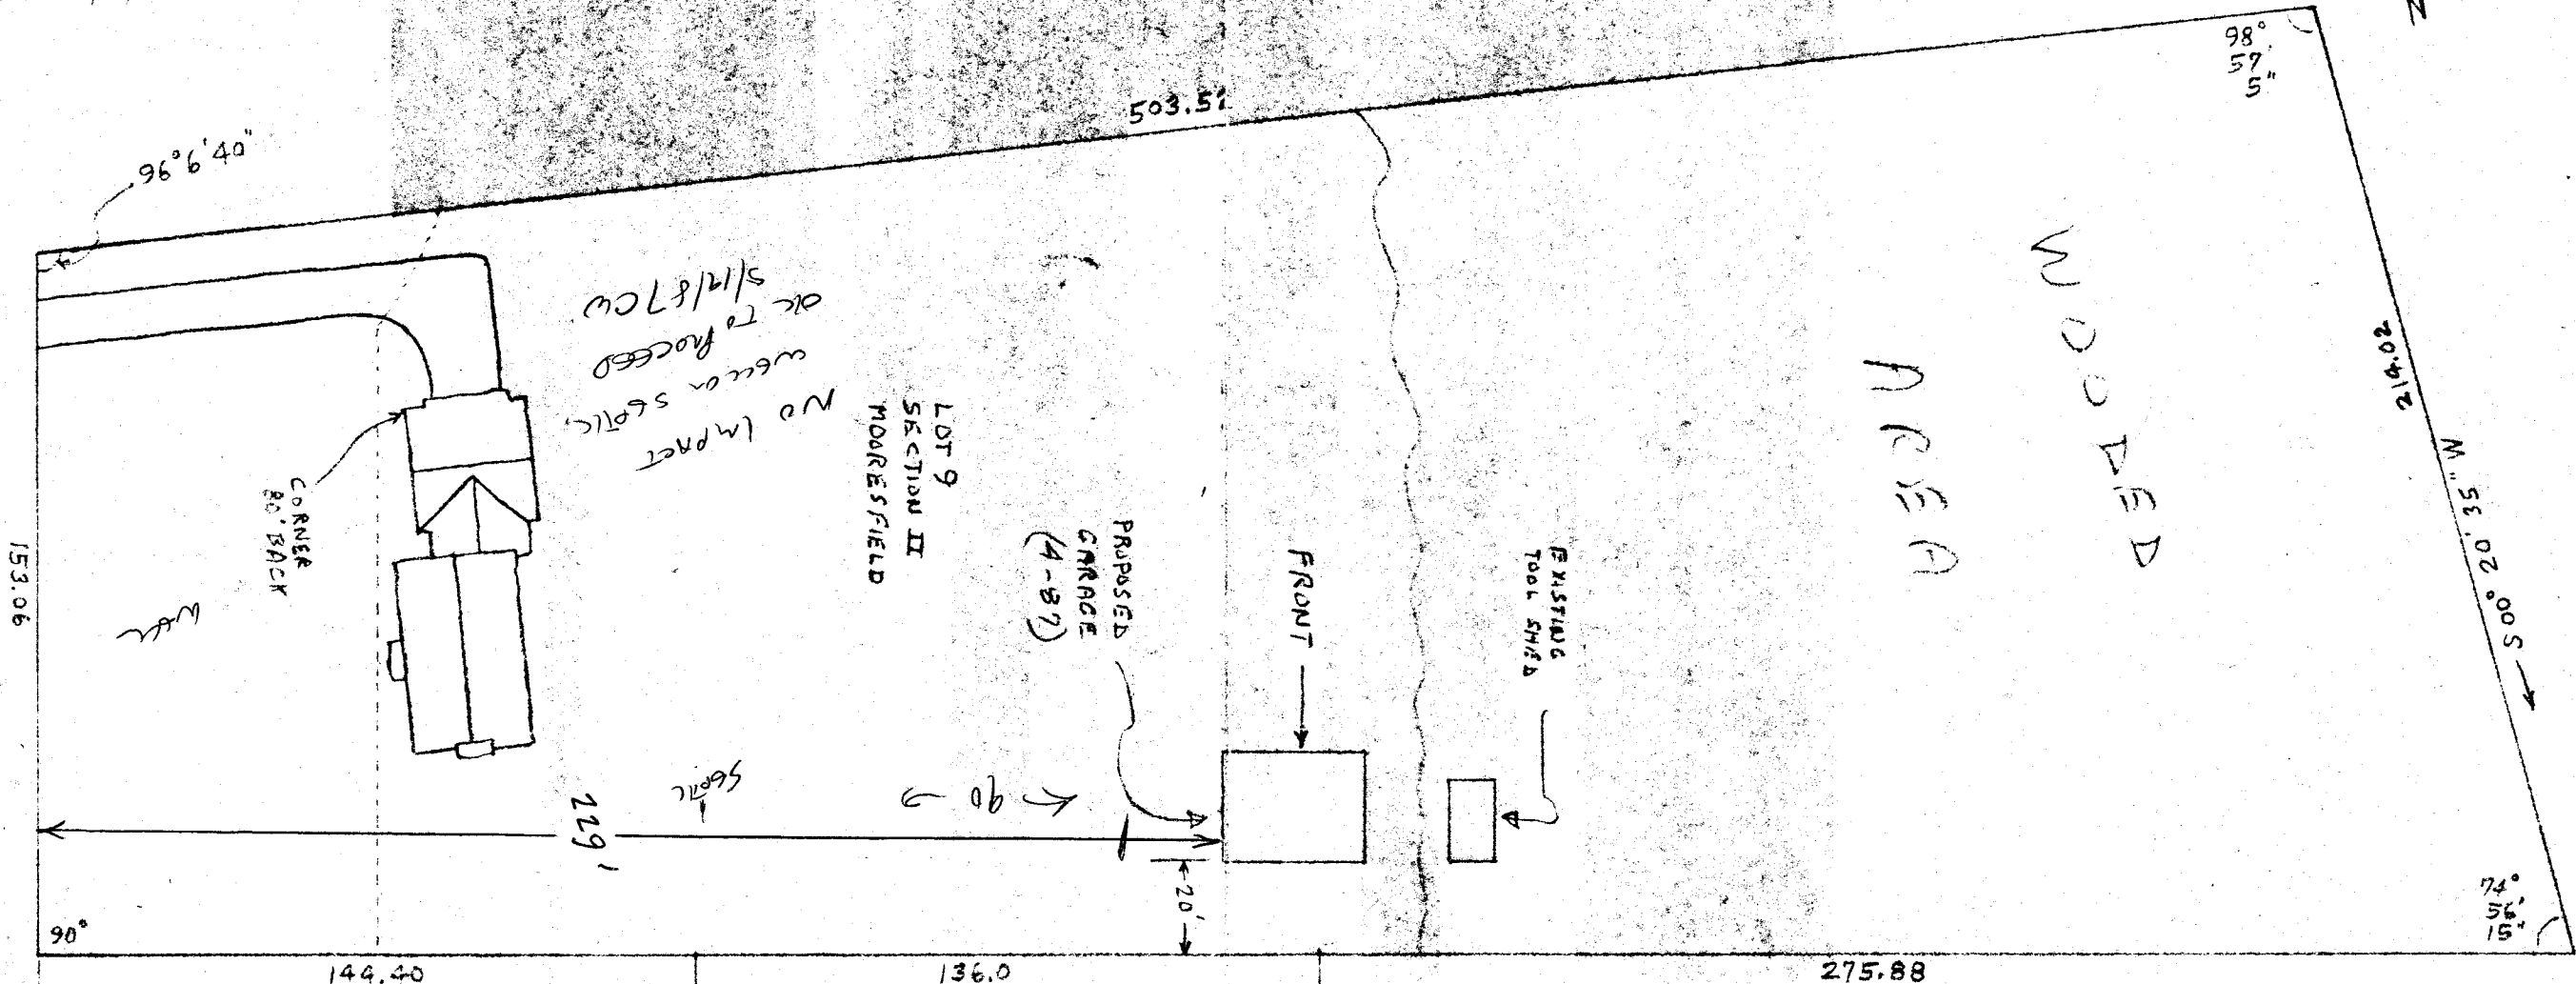

86 811

LOT 6

LOT 7

SCALE: 1" = 40'
M. STRANGE
10-12-64

