

# PERMIT

## SEWAGE DISPOSAL SYSTEM

### DEPARTMENT OF HEALTH AND MENTAL HYGIENE

INDEXED

#### HOWARD COUNTY HEALTH DEPARTMENT

BUREAU OF ENVIRONMENTAL HEALTH

461-9933

313-2640

NO RECORDS OF ADDITIONAL  
INSPECTION REQUEST  
AS OF 8/21/95  
INDEX (CW)

P 49177

A REPAIR

DISTRICT

DATE 4/22/93

DATE SYSTEM APPROVED 9/14/92

INSPECTED

INSPECTOR RH

Jack Fyock

IS PERMITTED TO INSTALL ALTER X

ADDRESS 13775 Triadelphia Road, Glenelg, Maryland 21737 PHONE 988-9270

SUBDIVISION LOT ROAD 2871 Route 32

PROPERTY OWNER John & Catherine Dorsey

2871 Route 32

ADDRESS West Friendship, Maryland

SEPTIC TANK CAPACITY 1020 GALLONS TOP SEAM CONCRETE

NUMBER OF BEDROOMS 2

1 SQUARE FEET PER BEDROOM

LINEAR FEET OF TRENCH REQUIRED 64

REPAIR - PURPOSE - Septic System has failed. OLD STEEL TANK MAY CAVE IN ANYTIME  
Call for inspection when ground is opened so sanitarian can recommend repair. 9/14/92

BLDG. PERMIT SIGNED

AND RETURNED 1/23/97

Serial # BT103737

right price

PLANS APPROVED BY DATE

COVER NO WORK UNTIL INSPECTED AND APPROVED

NEITHER THE HOWARD COUNTY COUNCIL NOR THE HEALTH DEPARTMENT IS RESPONSIBLE FOR THE SUCCESSFUL OPERATION OF ANY SYSTEM

NOTE: CLEANOUT REQUIRED EVERY 70 FEET OF SEWER LINE AND/OR AT 90° SWEEPS IN LINES FROM HOUSE TO DRAIN FIELDS, 90° ELBOWS NOT ACCEPTABLE.

NOTE: ALL PARTS OF SEPTIC SYSTEMS (I.E. TANK, DISTRIBUTION BOX TRENCHES) TO BE 100 FEET FROM WELL (UNLESS OTHERWISE SPECIFICALLY AUTHORIZED)

NOTE: IF DEEP TRENCH(ES) ARE USED CALL FOR INSPECTION BEFORE AND AFTER PLACING GRAVEL IN TRENCH(ES)

NOTE: NO DRY WELL SHALL EXCEED 15 FOOT IN DIAMETER NO ABSORPTION TRENCH TO EXCEED 100 FEET IN LENGTH

NOTE: ALL PIPE FROM HOUSE TO SEPTIC TANK MUST BE CAST IRON OR SCHEDULE 35/40 PVC OR ABS

PERMIT VOID AFTER TWO YEARS

NOTE: INSTALL STAND PIPE ON SEPTIC TANK AND DRY WELL STAND PIPES MUST BE 6 INCHES IN DIAMETER CAST IRON. CONCRETE OR TERRA COTTA OR PVA OR ABS ACCEPTED. IF TOP OF SEPTIC TANK IS DEEPER THAN 3 FEET. MANHOLE TO GRADE REQUIRED.


NOTE: DISTRIBUTION BOXES MUST HAVE BAFFLES

\*INSTALLER IS RESPONSIBLE FOR OBTAINING FINAL APPROVAL ON THIS PERMIT

49177

3  
14  
Brown  
Loam  
Brown  
sand  
MICA  
Loam

OLD TANK  
LESS THAN  
50 FT FROM  
DRILLED WELL

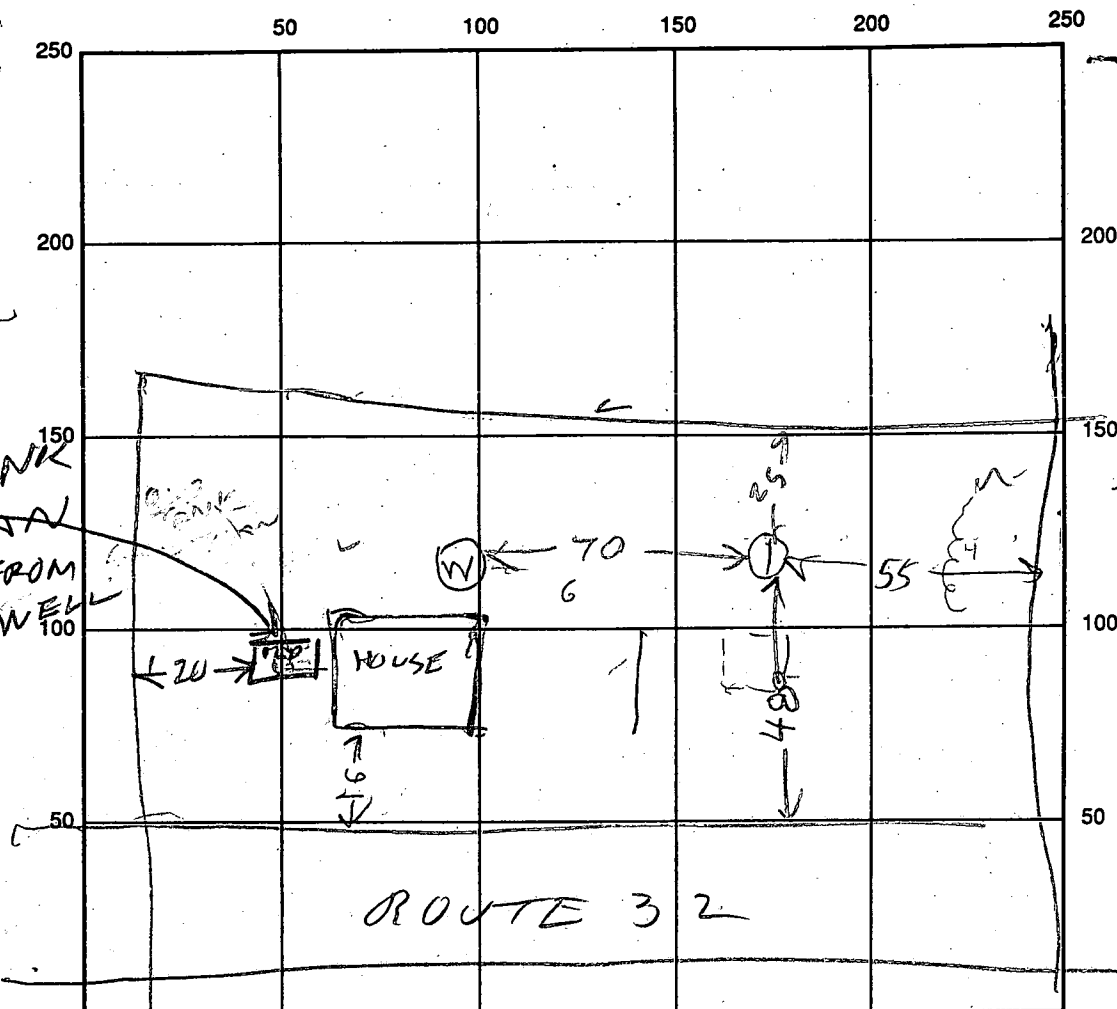

SEPTIC TANK LEVEL

CLEANOUTS

DISTRIBUTION BOX LEVEL

DRAIN FIELD/TITLE DEPTH

FT.

TRENCH WIDTH

FT.

INLET DEPTH

FT.

EFFECTIVE GRAVEL DEPTH

FT.

TOTAL LENGTH

FT.

NUMBER OF TRENCHES

ONE SIDEWALL/BOTTOM AREA

SQ. FT.

DRYWALL INSIDE DIAMETER

FT.

EFFECTIVE DEPTH BELOW INLET

FT.

ABSORBENT AREA

SQ. FT.

REMARKS:

9/14/92/4/1201/1202/1202/1203/1/1 PER OK

VERY CONFINED AREA MUST HAVE TRENCHES ABOUT 70  
FT FROM WELL. TANK TO BE ONLY 60 FT FROM WELL  
BUT TOP SEAM TANK TO BE USED. EXISTING STEEL TANK  
LESS THAN 50 FT FROM WELL & MUST BE REPLACED

DATE SYSTEM APPROVED

INSPECTOR

ROUTE 144

NORMAN C. CAVEY JR  
11946 FREDERICK Rd  
Ellicott City, Md. 21043

44-20-88

WELL SITE Approval not given.

Paper septic Area not known, New well in Driveway  
Hand dug well must be abandoned - SFB

H-531-2934  
W-465-7261

RECEIVED

