

8/12/93
ASAP

PERMIT

SEWAGE DISPOSAL SYSTEM

DEPARTMENT OF HEALTH AND MENTAL HYGIENE

05-370485

HOWARD COUNTY HEALTH DEPARTMENT

BUREAU OF ENVIRONMENTAL HEALTH

~~461-9933~~ 313-2640

INDEXED

P 49549

A REPAIR

DISTRICT _____

DATE 8/24/93

DATE SYSTEM APPROVED 8/12/93

INSPECTOR M. Rifkin

Jack Fyock Septic Service IS PERMITTED TO INSTALL _____ ALTER X

ADDRESS _____ PHONE 988-9270

SUBDIVISION _____ LOT _____ ROAD 11991 Route 216

PROPERTY OWNER Sutton ~~Matthew Canim~~ prev Meabe 1963

ADDRESS 11991 Route 216
Fulton, Maryland 21059

SEPTIC TANK CAPACITY 1000 GALLONS

DIRECTIONS: Property is located directly across from Pindell School Road

NUMBER OF BEDROOMS 3

125 SQUARE FEET PER BEDROOM

LINEAR FEET OF TRENCH REQUIRED 70

REPAIR - PURPOSE - SEPTIC SYSTEM HAS FAILED.

Call for inspection when ground is opened so sanitarian can recommend repair. 08/11/93

INLET 3 1/2', BOT 9', 6 1/2' STONE MR

PLANS APPROVED BY _____ DATE _____

COVER NO WORK UNTIL INSPECTED AND APPROVED

NEITHER THE HOWARD COUNTY COUNCIL NOR THE HEALTH DEPARTMENT IS RESPONSIBLE FOR THE SUCCESSFUL OPERATION OF ANY SYSTEM

NOTE: CLEANOUT REQUIRED EVERY 70 FEET OF SEWER LINE AND/OR AT 90° SWEEPS IN LINES FROM HOUSE TO DRAIN FIELDS, 90° ELBOWS NOT ACCEPTABLE.

NOTE: ALL PARTS OF SEPTIC SYSTEMS (I.E. TANK, DISTRIBUTION BOX TRENCHES) TO BE 100 FEET FROM WELL (UNLESS OTHERWISE SPECIFICALLY AUTHORIZED)

NOTE: IF DEEP TRENCH(ES) ARE USED CALL FOR INSPECTION BEFORE AND AFTER PLACING GRAVEL IN TRENCH(ES)

NOTE: NO DRY WELL SHALL EXCEED 15 FOOT IN DIAMETER NO ABSORPTION TRENCH TO EXCEED 100 FEET IN LENGTH

NOTE: ALL PIPE FROM HOUSE TO SEPTIC TANK MUST BE CAST IRON OR SCHEDULE 35/40 PVC OR ABS


PERMIT VOID AFTER TWO YEARS

NOTE: INSTALL STAND PIPE ON SEPTIC TANK AND DRY WELL STAND PIPES MUST BE 6 INCHES IN DIAMETER CAST IRON. CONCRETE OR TERRA COTTA OR PVA OR ABS ACCEPTED. IF TOP OF SEPTIC TANK IS DEEPER THAN 3 FEET. MANHOLE TO GRADE REQUIRED.

NOTE: DISTRIBUTION BOXES MUST HAVE BAFFLES

***INSTALLER IS RESPONSIBLE FOR OBTAINING FINAL APPROVAL ON THIS PERMIT**

P 49549

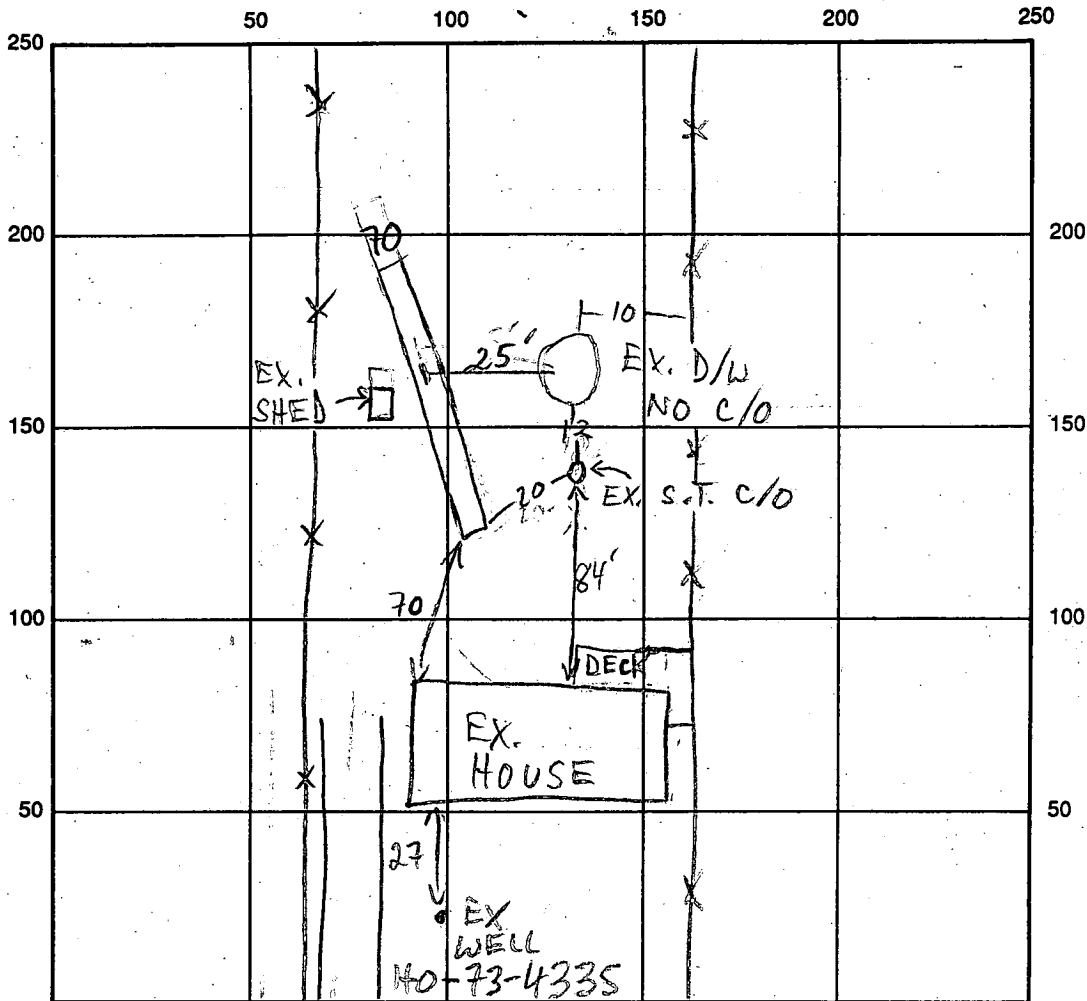

①
brn org
sa cl
1m
3 1/2
brn
sa mica
1m
10
loam w/
mica
saprolite
11
12
DAMP MICA

RT. 216

INDICATE NORTH - NAME ADJOINING ROADWAY AS BASE LINE

SEPTIC TANK LEVEL EX. 1000 GAL-OK

CLEANOUTS S.T. - OK

DISTRIBUTION BOX LEVEL —

DRAIN FIELD/TITLE DEPTH 9 FT.

TRENCH WIDTH 2 FT.

INLET DEPTH 3 1/2 FT.

EFFECTIVE GRAVEL DEPTH 5 1/2 FT.

TOTAL LENGTH 70 FT.

NUMBER OF TRENCHES 1

ONE SIDEWALL/BOTTOM AREA 385 SQ. FT.

DRYWALL INSIDE DIAMETER — FT.

EFFECTIVE DEPTH BELOW INLET — FT.

ABSORBENT AREA 385 SQ. FT.

REMARKS: 8/12/93 OK TO COVER MR

DATE SYSTEM APPROVED

8/12/93

INSPECTOR

M. Rifkin

SITE INSPECTION SHEET

OWNER: Sutton PHONE #: _____


ADDRESS: 11991 Rt 216 CONTRACTOR: _____

Fulton WELL TAG #: _____

SUBDIVISION: _____ LOT: _____ COUNTY #: _____

PROPOSAL: 8/25/04 Possible buyer wants to know if 30x40
garage permit would be approved prior to prop.
purchase

LOCATION DIAGRAM

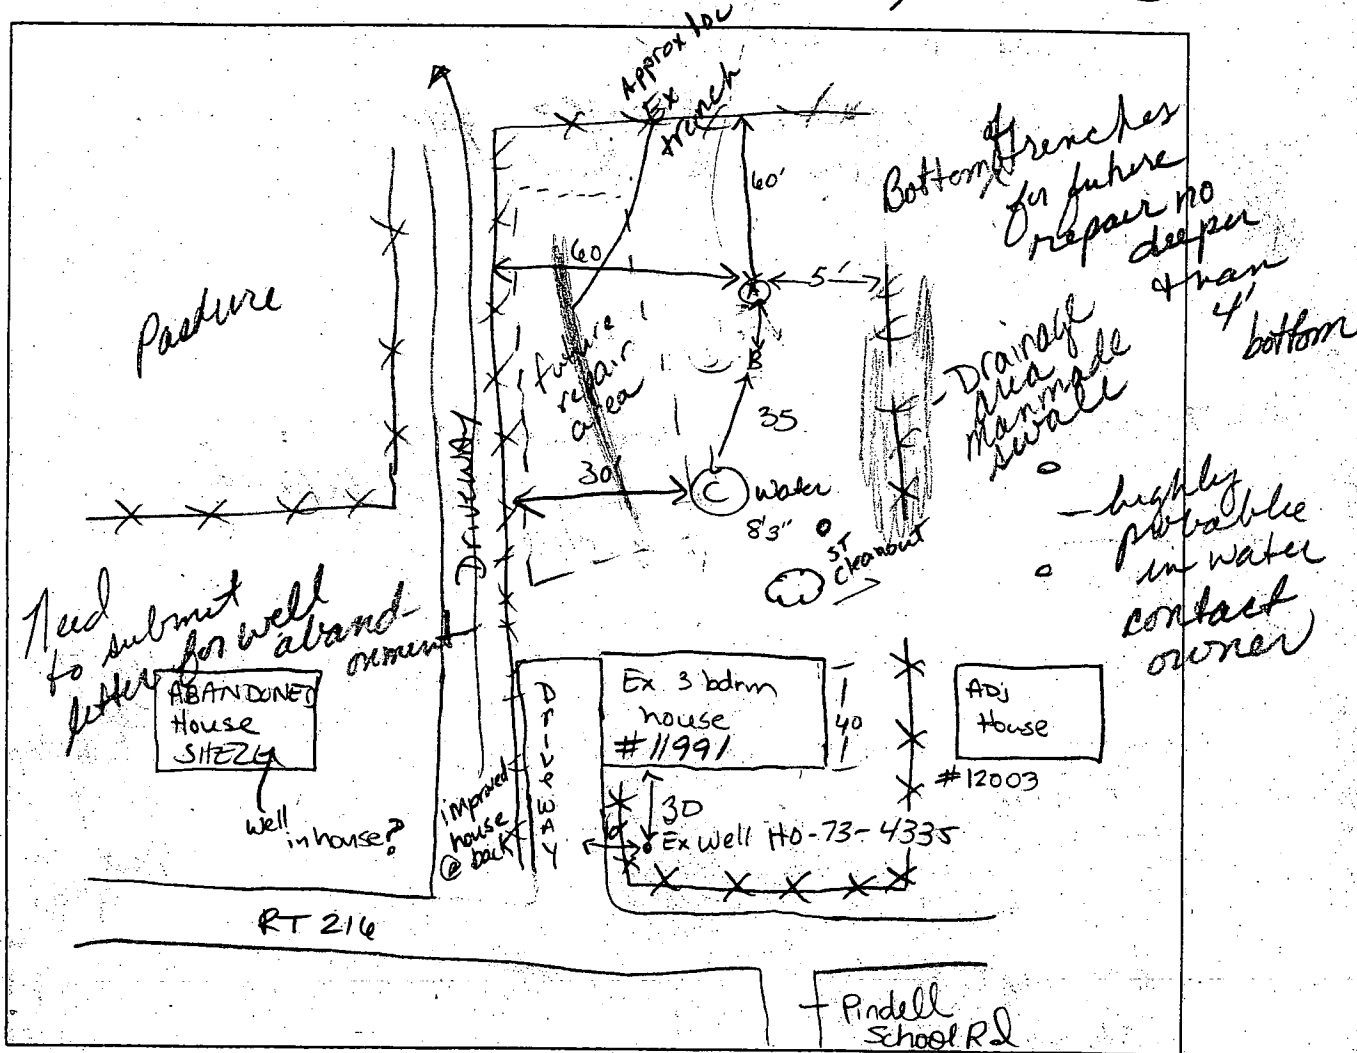

COMMENTS: 8/25/04 See soil descriptions on back. Due to
lack of area & considering soil descriptions,
highest area on east side of prop only area
avail for septic repair. Building permits for

DATE: 8/25/04 INSPECTOR: KN/PI

additional buildings not approvable until further
testing/back hoe on site for excavation.

Carol
Hill

301-596-9229

301-704-4787

fax: 301-596-9380

(A)

3' 7.5 YR 4/5, 3, 2 pgr loam

17' silty loam, micaceous,
7.5 YR 5/4

25' loam micaceous

heavy loam / clay increases / 10 to 15% clay.
cleans the thumb

34' int. lg rock

(B)

7.5 YR 4/6
loam
2 pgr.

17' L w/ pockets
of sil
mica 2-10%
1 pgr / 1 wsbk
7.5 YR 5/8

26' 10 YR 5/6
hvy L-sil
structure
mica 1-25%

3' 10 YR 5/1, grey
5/6 ybrn
vertical, flat
prismatic struct
sil-cll

45'

55' abrupt A
SL
w/ pockets CL
10 YR 5/8
10 YR 3/1

B - Cont'd

60" Qtz Rock 2"x3"x3"±

64" SCL - hvy L / Refusal
due to gtz

(C) see MR's
soil
description
on 8/12/93

However,
grey, white
silty L
w/ high
mica 20-70%
water @
8'3"

10 YR 5/8
10 YR 6/3

JANE

CAN YOU LOCATE RECORD OF
RECENT REPAIR?

JULY/AUG 93

(FYOCK)

OWNER

GANNIN

11991 ROUTE 216

864-6464

PAGE EXISTING DAYWELL COLLAPSED.

WOULD LIKE HELP DEPT ASSESSMENT
OF WORKMANSHIP.


OWNER REPORTS DAYWELL BID WAS
MADE OF WOOD.

THANKS

10/25/93 CW

10/8/93

NO FURTHER CONTACT FROM OWNER - REFILE (CW)

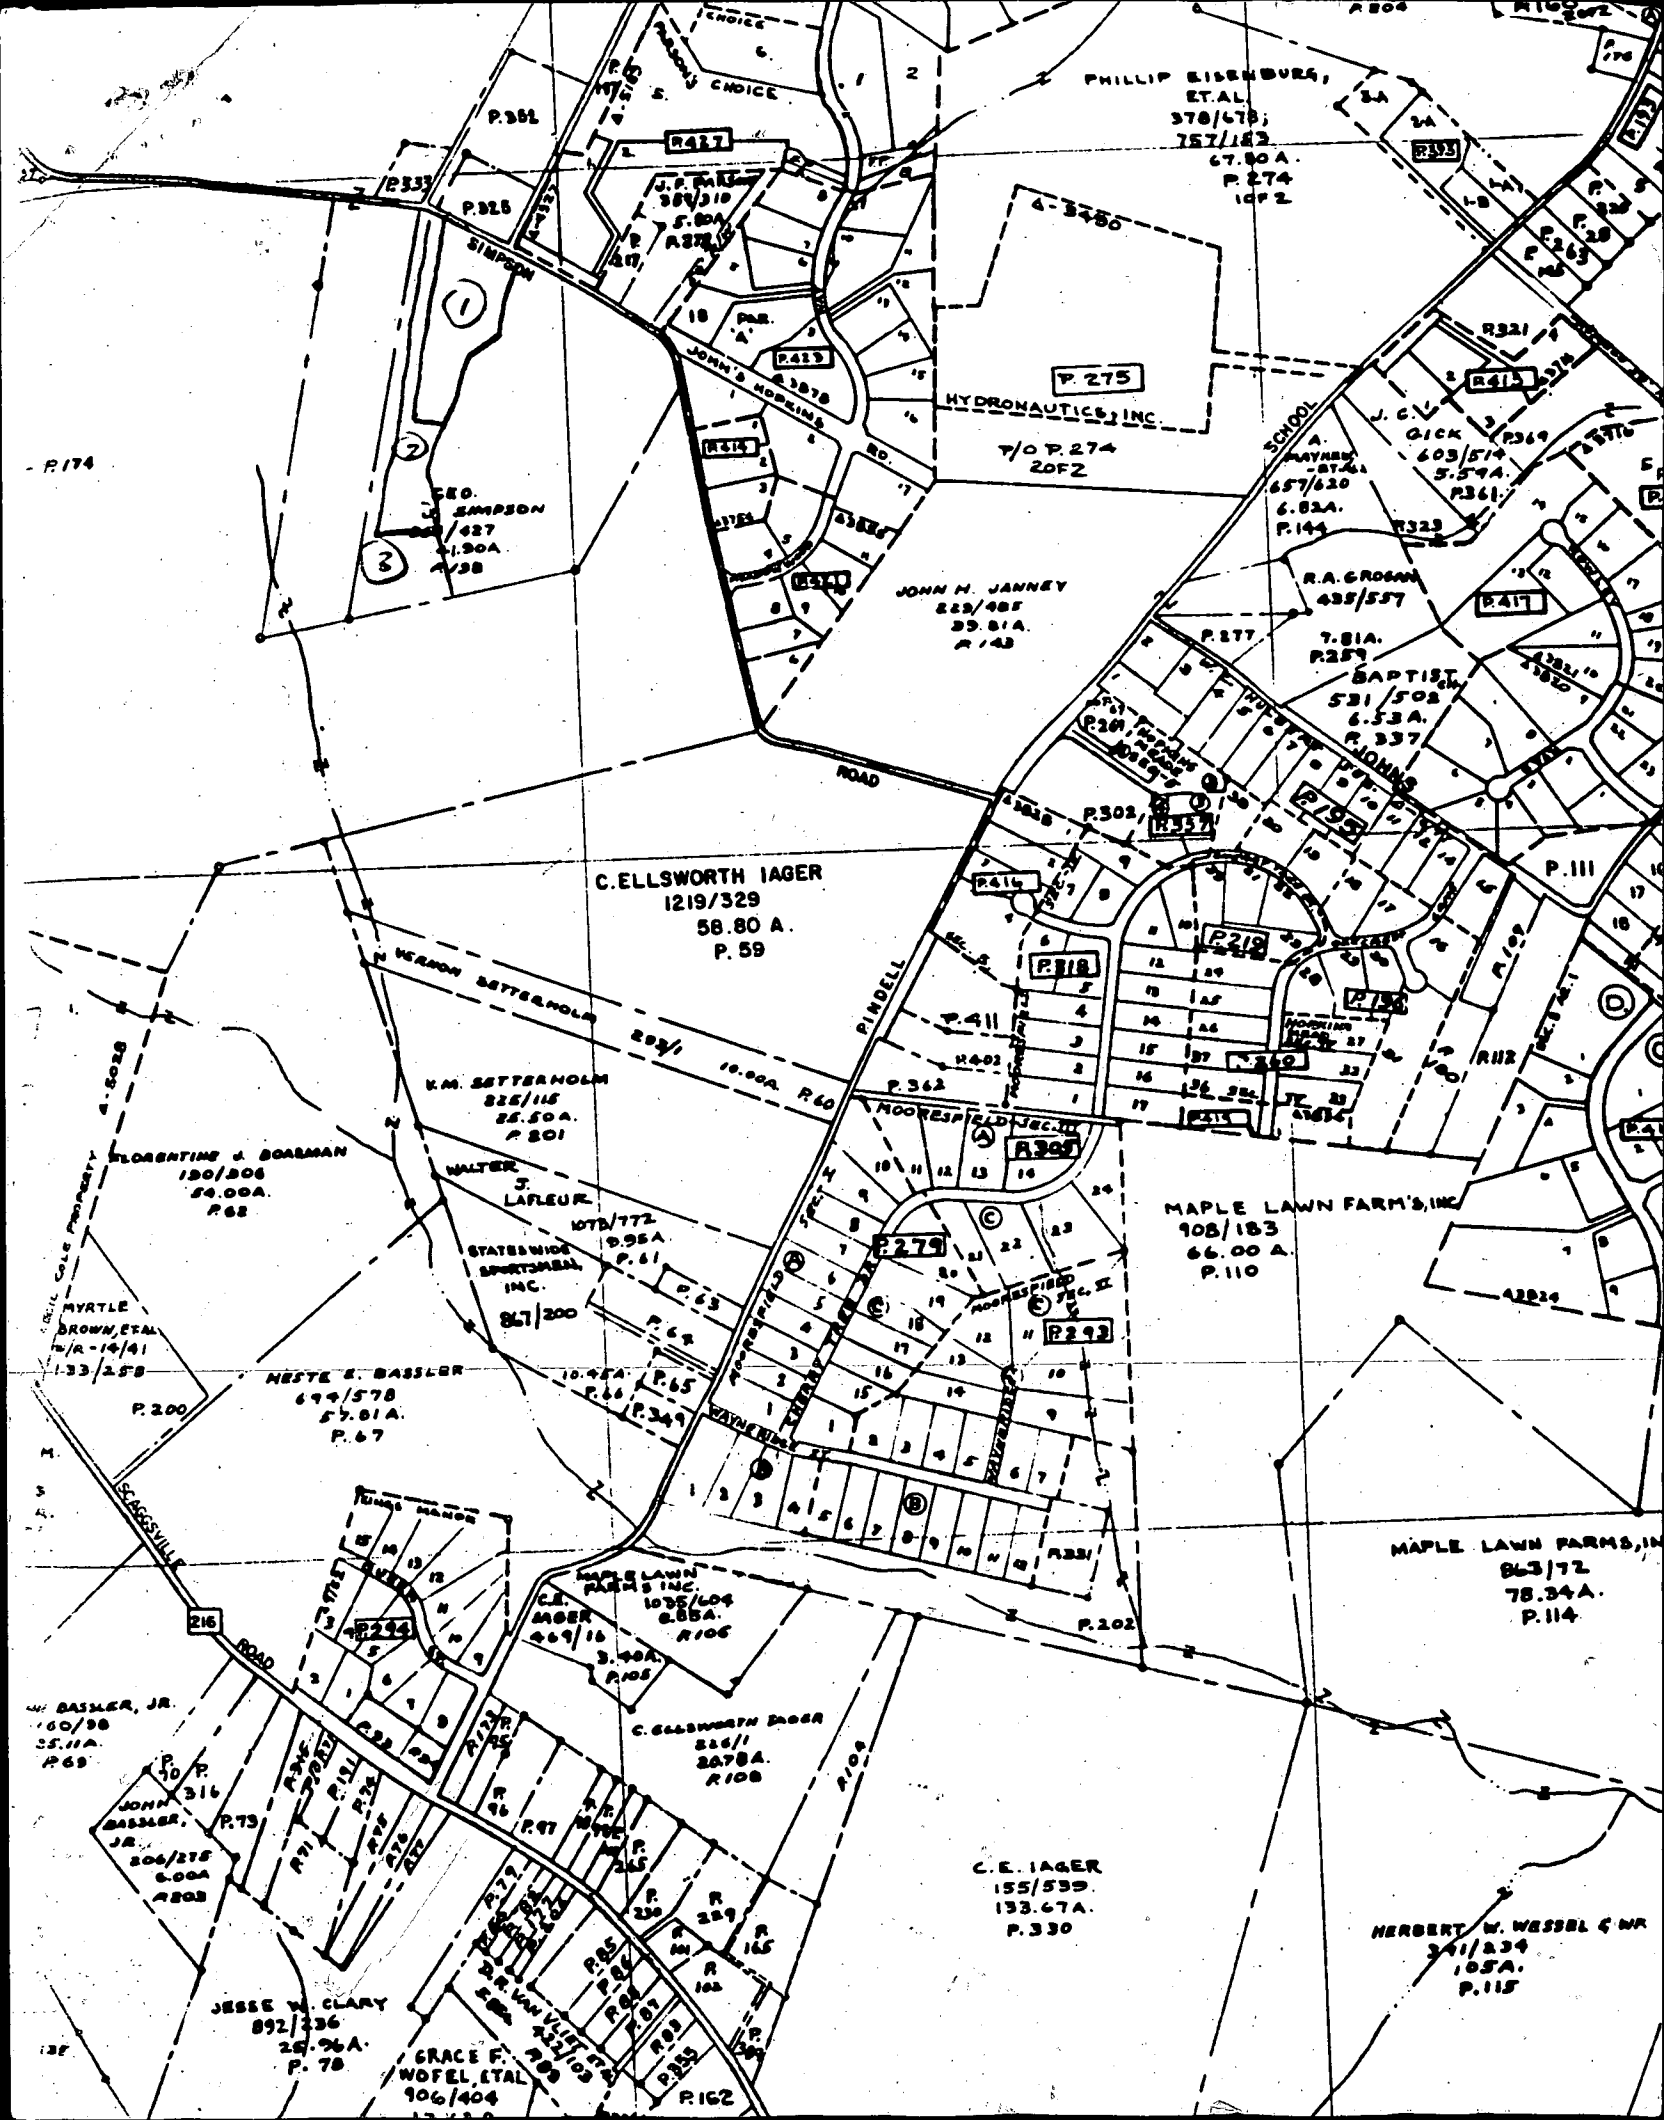


SITE INSPECTION SHEET

OWNER: Sutton PHONE #: _____
 ADDRESS: 11991 Rt 216 CONTRACTOR: _____
Fulton WELL TAG #: _____
 SUBDIVISION: _____ LOT: _____ COUNTY #: _____

PROPOSAL: 8/25/04 Possible buyer wants to know if 30x40
garage permit would be approved prior to prop.
purchase

LOCATION DIAGRAM

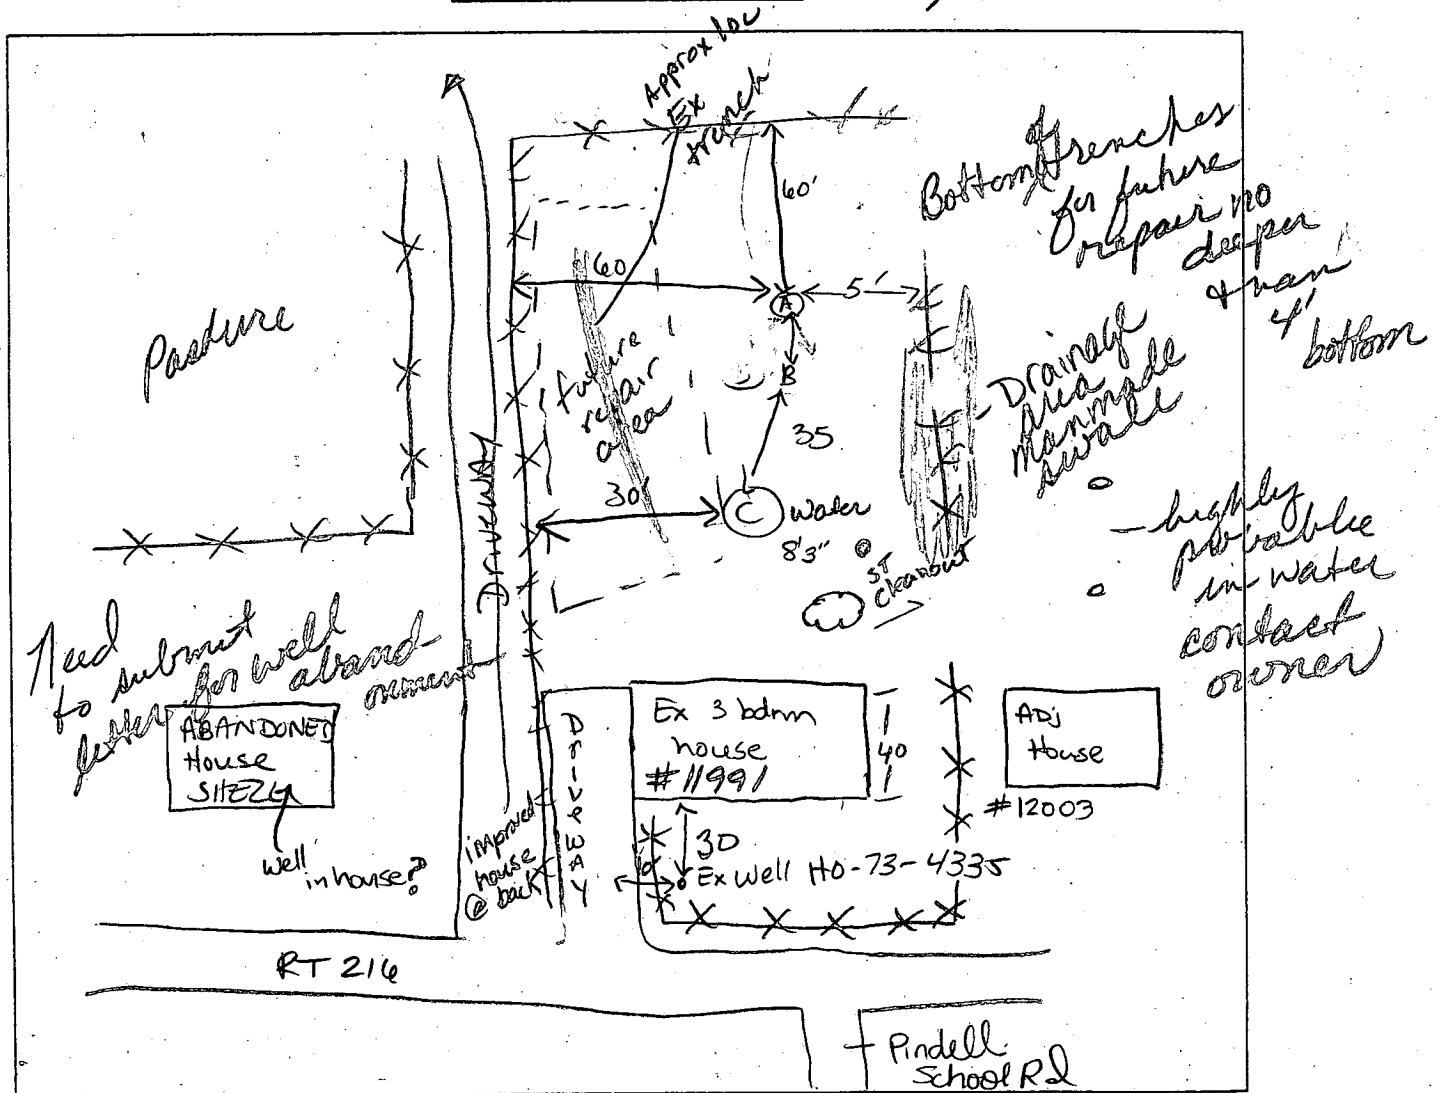

COMMENTS: 8/25/04 See soil descriptions on back. Due to
lack of area & considering soil descriptions,
highest area on east side of prop. only area
avail for septic repair. Building permits for
 DATE: 8/25/04 INSPECTOR: KN / PJ

additional buildings not approvable until further
testing/backhoe on site for excavation.

Carol
Hill

301-596-9229

301-704-4787

fax: 301-596-9380

(A)

3' 7.5 YR 4/5, 3, 2 pgr loam



silly loam, micaceous,
7.5 YR 5/4

loam micaceous

heavy loam / clay increases / 10 to 15 - clay.
leans the thumb

wt 1st rock

B - Cont'd

(B)

7.5 YR 4/6
loam
2 pgr.

17"

L w/ pockets
of sil

mica ~ 100%

1 pgr / 1 wsbk

7.5 YR 5/8

26"

10 YR 5/6

hvy L - sil

structure

mica ~ 25%

3"

10 YR 5/1, grey

5/6 ybrn

45"

vertical, flat
prismatic struct.

sil - CLL

55"

abrupt A

SL

w/ pockets CL

10 YR 5/8

10 YR 3/1

60" Qtz Rock 2"x3"x3"±

64" sil - hvy L / refusal
due to gtz

© see MR's
soil
description
on 8/12/93

However,
grey, white
silly L
w/ high
mica ~ 60-70%
water @
8'3"

10 YR 5/8
10 YR 6/3