

PERMIT

SEWAGE DISPOSAL SYSTEM

DEPARTMENT OF HEALTH AND MENTAL HYGIENE

03-286568

HOWARD COUNTY HEALTH DEPARTMENT

BUREAU OF ENVIRONMENTAL HEALTH

~~XX-1-1993~~ 313-2640

INDEXED

P 49550

A REPAIR

DISTRICT

DATE 8/24/93

DATE SYSTEM APPROVED 8/17/93

INSPECTOR RH

Jack Fyock Septic Service

IS PERMITTED TO INSTALL ☒ ALTER

ADDRESS 13775 Triadelphia Road, Glenelg, Maryland 21737 PHONE 988-9270

SUBDIVISION River Park Estates LOT 9 ROAD 1045 River Road

PROPERTY OWNER Weigle

ADDRESS 1045 River Road
Sykesville, Maryland 21784

SEPTIC TANK CAPACITY 1000 GALLONS

NUMBER OF BEDROOMS 3

125 SQUARE FEET PER BEDROOM

LINEAR FEET OF TRENCH REQUIRED 54

REPAIR - PURPOSE - SEPTIC SYSTEM HAS FAILED.

Call for inspection when grounds ie opened so sanitarian can recommend repair. 08/13/93

08/17/93 - TRENCH - 10 FT DEEP, 2 FT WIDE
54 FT LONG INLET 3 FT BELOW ORIGINAL GRADE
RUN TRENCH OFF OLD DRY WELL
TOWARD THE BACK LOT LINE R/H

PLANS APPROVED BY DATE

COVER NO WORK UNTIL INSPECTED AND APPROVED

NEITHER THE HOWARD COUNTY COUNCIL NOR THE HEALTH DEPARTMENT IS RESPONSIBLE FOR THE SUCCESSFUL OPERATION OF ANY SYSTEM

NOTE: CLEANOUT REQUIRED EVERY 70 FEET OF SEWER LINE AND/OR AT 90° SWEEPS IN LINES FROM HOUSE TO DRAIN FIELDS, 90° ELBOWS NOT ACCEPTABLE.

NOTE: ALL PARTS OF SEPTIC SYSTEMS (I.E. TANK, DISTRIBUTION BOX TRENCHES) TO BE 100 FEET FROM WELL (UNLESS OTHERWISE SPECIFICALLY AUTHORIZED)

NOTE: IF DEEP TRENCH(ES) ARE USED CALL FOR INSPECTION BEFORE AND AFTER PLACING GRAVEL IN TRENCH(ES)

NOTE: NO DRY WELL SHALL EXCEED 15 FOOT IN DIAMETER NO ABSORPTION TRENCH TO EXCEED 100 FEET IN LENGTH

NOTE: ALL PIPE FROM HOUSE TO SEPTIC TANK MUST BE CAST IRON OR SCHEDULE 35/40 PVC OR ABS

PERMIT VOID AFTER TWO YEARS


NOTE: INSTALL STAND PIPE ON SEPTIC TANK AND DRY WELL STAND PIPES MUST BE 6 INCHES IN DIAMETER CAST IRON. CONCRETE OR TERRA COTTA OR PVA OR ABS ACCEPTED. IF TOP OF SEPTIC TANK IS DEEPER THAN 3 FEET. MANHOLE TO GRADE REQUIRED.

NOTE: DISTRIBUTION BOXES MUST HAVE BAFFLES

*INSTALLER IS RESPONSIBLE FOR OBTAINING FINAL APPROVAL ON THIS PERMIT

R 49550

①
BROWN
CLAY
TAN
SAND
LOAM

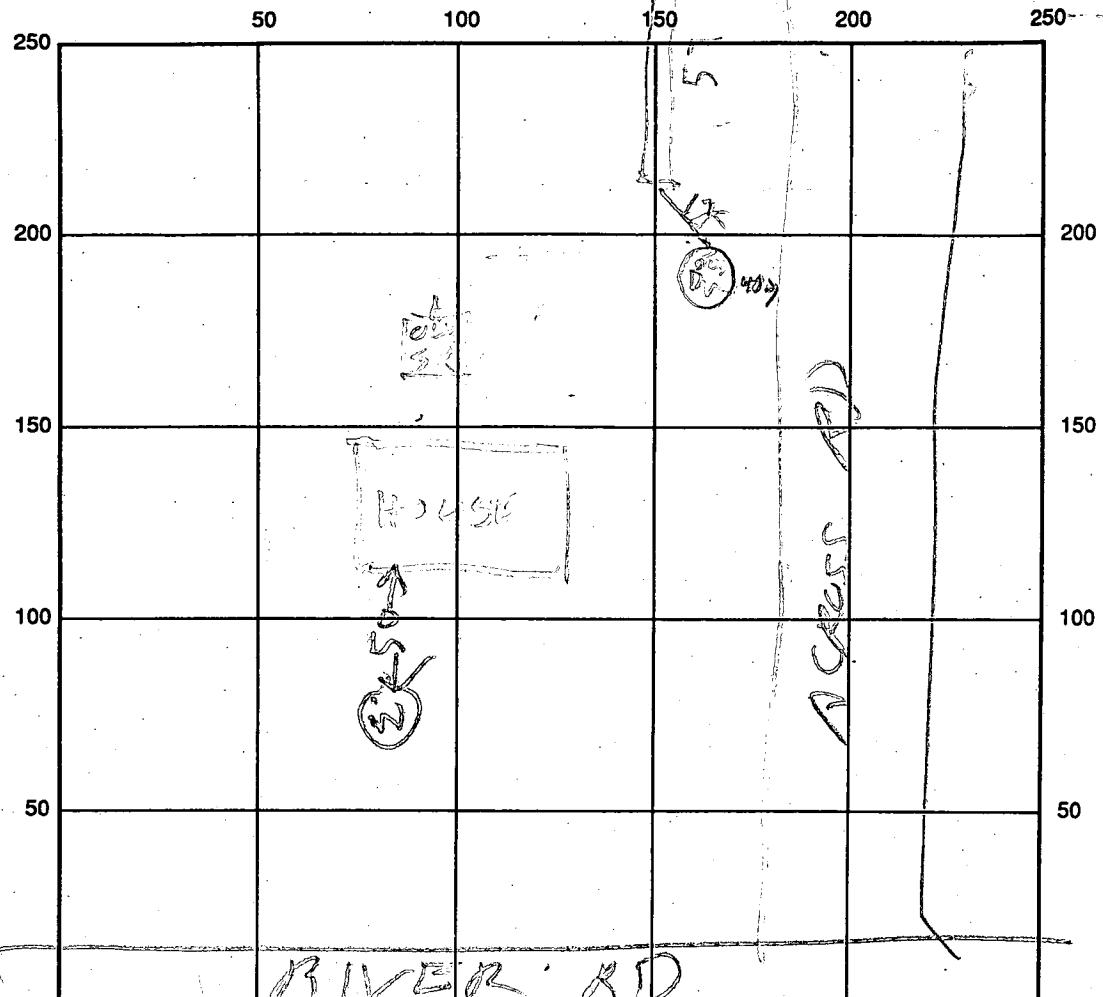

INDICATE NORTH - NAME ADJOINING ROADWAY AS BASE LINE

SEPTIC TANK LEVEL _____ CLEANOUTS _____
 DISTRIBUTION BOX LEVEL _____
 DRAIN FIELD/TITLE DEPTH 10 FT. TRENCH WIDTH 2 FT. INLET DEPTH 3 FT.
 EFFECTIVE GRAVEL DEPTH 7 FT. TOTAL LENGTH 57 FT.
 NUMBER OF TRENCHES 1 ONE SIDEWALL/BOTTOM AREA _____ SQ. FT.
 DRYWALL INSIDE DIAMETER _____ FT. EFFECTIVE DEPTH BELOW INLET _____ FT.
 ABSORBENT AREA _____ SQ. FT.

REMARKS: 8/17/93 TRENCH TO BE ABOUT 10 FT LONGEST
TO GET RID OF EXTRA STONE TRENCH
ALREADY LONG ENOUGH

DATE SYSTEM APPROVED 8/17/93 INSPECTOR Raymond Hodge

8/28/68
8/31/68
Jody

PERMIT

SEWAGE DISPOSAL SYSTEM

MARYLAND STATE DEPARTMENT OF HEALTH

HOWARD COUNTY

ELLICOTT CITY

DISTRICT 3

DATE 8/16/68

INDEXED

app-8-29-68
perm
P 13841
A 11525

Catonsville Plumbing & Heating Co., Inc. IS PERMITTED TO INSTALL E ALTER

ADDRESS 918 Frederick Road, Catonsville, Md. PHONE RI 7-7350

A SEWAGE DISPOSAL SYSTEM LOCATED AT _____

SUBDIVISION River Park Estates ROAD River Road LOT 9

PROPERTY OWNER Percy Warfield

ADDRESS _____

SPECIFICATIONS 3 bedrooms

DRAIN FIELD _____ DEPTH _____ FEET, BOTTOM AREA _____ SQ. FT.

SEEPAGE PITS _____ ABSORBENT SIDE-WALL AREA _____ SQ. FT.

SEPTIC TANK CAPACITY 750 GALLONS

FOR GARBAGE GRINDER, INCREASE DISPOSAL AREA 22% & TANK CAPACITY 50%.

OTHER Dry well - 300 sq. ft. absorbent sidewall area below the inlet pipe
located 148 ft. from front lot line and 10 ft. from right side lot line
as seen when facing lot from River Rd.

MAXIMUM DEPTH PERMITTED 12' below original grade.

PERMIT VOID AFTER THREE YEARS.

PLANS APPROVED BY J. H. Kilmore DATE 10/5/66

FILL SEPTIC TANK AND DISTRIBUTION BOX WITH WATER BEFORE CALLING FOR AN INSPECTION. COVER NO WORK UNTIL INSPECTED AND APPROVED.


NEITHER THE HOWARD COUNTY COMMISSIONERS NOR THE HEALTH DEPARTMENT IS RESPONSIBLE FOR THE SUCCESSFUL OPERATION OF ANY SYSTEM.

**NOTIFY THE HEALTH DEPARTMENT 48 HOURS
BEFORE EXCAVATIONS ARE TO BE BACK FILLED.**

18
3
64
19
7/125
2
35

11525

3.14
1.3
2

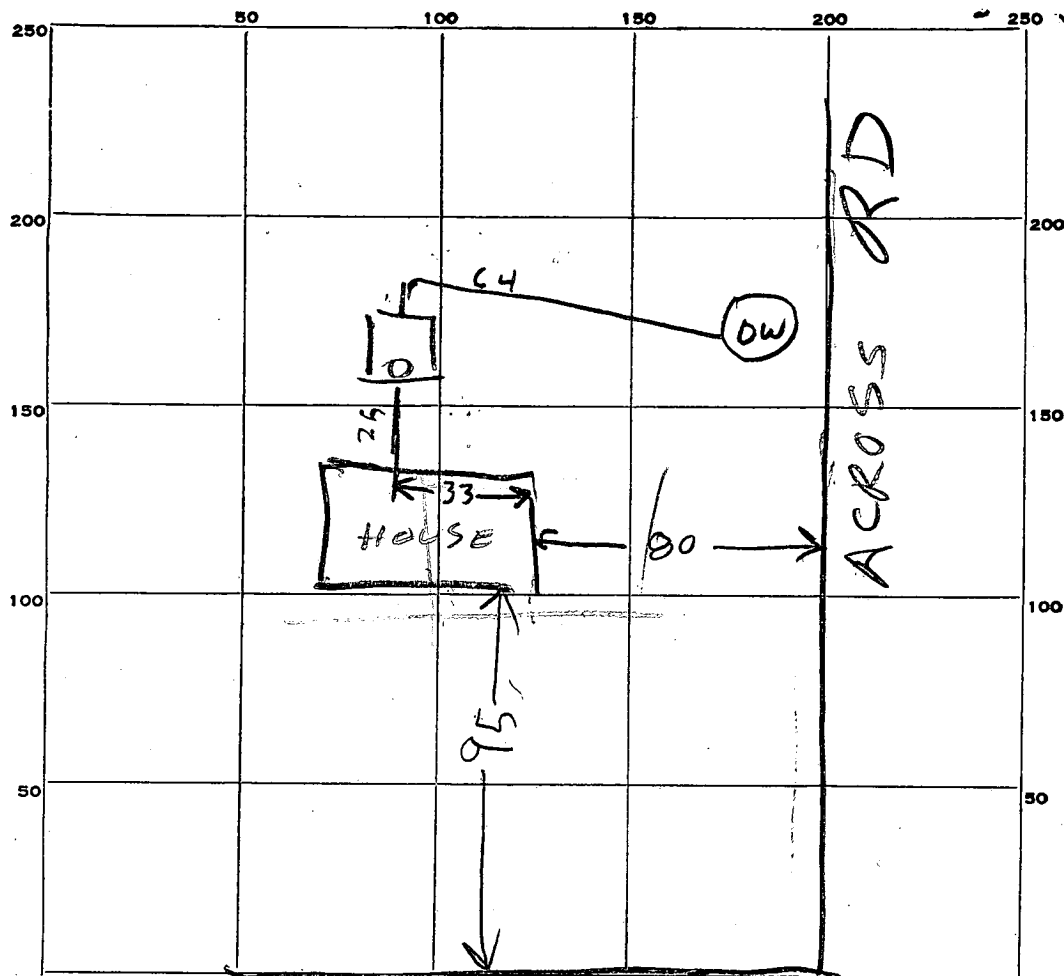

INDICATE NORTH - NAME ADJOINING ROADWAY AS BASE LINE.
RIVER RD

PERMIT CARD OK

SEPTIC TANK, LEVEL OK concrete top CLEANOUTS OK
1 ft below grade
DISTRIBUTION BOX, LEVEL _____

TILE FIELD, DEPTH _____ FT. TRENCH WIDTH _____ FT.

GRAVEL DEPTH _____ IN. TOTAL LENGTH _____ FT.

NUMBER OF TRENCHES _____ TOTAL BOTTOM AREA _____

SEE PAGE PITS, outside INSIDE DIAMETER 10 FT. DEPTH BELOW INLET 11 FT.

ABSORBENT AREA 649 SQ. FT.

REMARKS _____

DATE SYSTEM APPROVED 8-29-68 INSPECTOR [Signature]

APPLICATION

A 11525

P

SEWAGE DISPOSAL TESTING

MARYLAND STATE DEPARTMENT OF HEALTH

HOWARD COUNTY

ELLICOTT CITY

Septic Tank - 750 gallons

DISTRICT 3

DATE 3/3/66

Dry well - 300 sq. ft. absorbent sidewall area below the inlet pipe located 148 ft from front lot line and 10 ft from right side lot line as seen when facing lot from River Rd.

TO: THE COUNTY HEALTH OFFICER
ELLICOTT CITY, MARYLAND

I, HEREBY, APPLY FOR THE NECESSARY TESTS IN ORDER TO CONSTRUCT (OR RECONSTRUCT) A SEWAGE DISPOSAL SYSTEM.

PROPERTY OWNER Percy Warfield

ADDRESS 826 Glen Allen Drive, Baltimore, Md. 21229 PHONE WI 5-5095

PROPERTY LOCATION:

SUBDIVISION River Park Estates LOT NO. 9

ROAD AND DESCRIPTION River Road

OCCUPANT PHONE

PERSON TO CONSTRUCT SYSTEM

ADDRESS PHONE

SIZE OF LOT 170' x 300' TYPE BLDG. 3

NUMBER OF BEDROOMS

IF NOT SINGLE RESIDENCE DESCRIBE

SIGNATURE OF APPLICANT /s/ Percy Warfield

APPROVED BY J. H. Kilmore FOR Dry well (KIND OF SYSTEM) DATE 10/5/66

REJECTED BY FOR (KIND OF SYSTEM) DATE

HOLD PENDING FURTHER TESTS DATE

REASONS FOR REJECTION OR HOLDING

THIS IS NOT A PERMIT

APPLICATION

SEWAGE DISPOSAL TESTING

MARYLAND STATE DEPARTMENT OF HEALTH

HOWARD COUNTY

ELLICOTT CITY

DISTRICT 3

DATE 3/3/66

TO: THE COUNTY HEALTH OFFICER
ELLICOTT CITY, MARYLAND

I, HEREBY, APPLY FOR THE NECESSARY TESTS IN ORDER TO CONSTRUCT (OR RECONSTRUCT) A SEWAGE DISPOSAL SYSTEM.

PROPERTY OWNER Percy Warfield

ADDRESS 826 Glen Allen Drive, Baltimore, Md. 21229 PHONE WI 5-5095

PROPERTY LOCATION:

SUBDIVISION River Park Estates LOT NO. 9

ROAD AND DESCRIPTION River Road

OCCUPANT _____ PHONE _____

PERSON TO CONSTRUCT SYSTEM _____

ADDRESS _____ PHONE _____

SIZE OF LOT 170' x 300' TYPE BLDG. 3
NUMBER OF BEDROOMS

IF NOT SINGLE RESIDENCE DESCRIBE _____

SIGNATURE OF APPLICANT /s/ Percy Warfield

APPROVED BY J. H. Kilmore FOR Dry well DATE 10/5/66
(KIND OF SYSTEM)

REJECTED BY _____ FOR _____ DATE _____
(KIND OF SYSTEM)

HOLD PENDING FURTHER TESTS _____ DATE _____

REASONS FOR REJECTION OR HOLDING _____

THIS IS NOT A PERMIT

DEPARTMENT OF
WATER RESOURCESRECEIVED
APPLICATION MUST BE SUBMIT-
TED AND PERMIT RECEIVED BE-
FORE DRILLING IS STARTED.

APPLICATION FOR PERMIT TO DRILL WELL

No. 4721


Owner John Angel
Street or R. F. D. 428 Montemar Ave
Post Office Catonsville MdQuantity of Water to be Produced 7 Gallons Per Minute
Total Quantity Needed For Use 500 Gallons Per DayUse for Water Home
Approximate Depth of Well (feet) 75Method of Drilling to be used SpudgerIs this a Replacement Well? Yes - No
If YES, indicate date abandoned well is to be sealed: _____
and by whom: _____PERMIT TO DRILL WELL
(Not To Be Filled In By Driller)Well Permit No. H0690042Samples of Cuttings Required by Department: ☒ Yes ☐ No
Owner Requires Permit to Appropriate Water: ☒ Yes ☐ No
Owner Has Permit to Appropriate Water: ☒ Yes ☐ No

Appropriation Permit No.

The applicant is herewith granted a permit to drill this well subject to the conditions stipulated.

David L. McKee
Director083068
Date Coc.**THIS PERMIT IS NOT TRANSFERRABLE**
WITHOUT WRITTEN PERMISSION FROM THE DEPARTMENT
Special conditions that must be observed: _____County Permit No. _____
Health Department Approval of Application
Howard County Department of Healthor ☐ State Department of Health
Approved by John E. Wines
Title Director, Environmental Health
Date 8/29/68Driller W. H. Edmondson License Number 310
Street or R. F. D. _____
Post Office Margm Ave Sykesville Md
Date Aug 19 1968Location of Well Howard CountySubdivision Indian HillsSection _____ Lot 9Nearest Town SykesvilleDistance from Town 3 milesDirection from Town SouthDescription of Location of Well
(This information MUST BE ACCURATE, and should be definite enough to permit locating well on a county map).Near what road River RoadOn which side of road South
(North, East, South, West)Distance from road 300 ft

Draw a sketch below showing location of well in relation to nearby towns, roads and streams with NORTH in the direction of the arrow, and give distance from well to nearest road junction or stream crossing shown on the sketch. Distances may be approximate, but must be indicated.

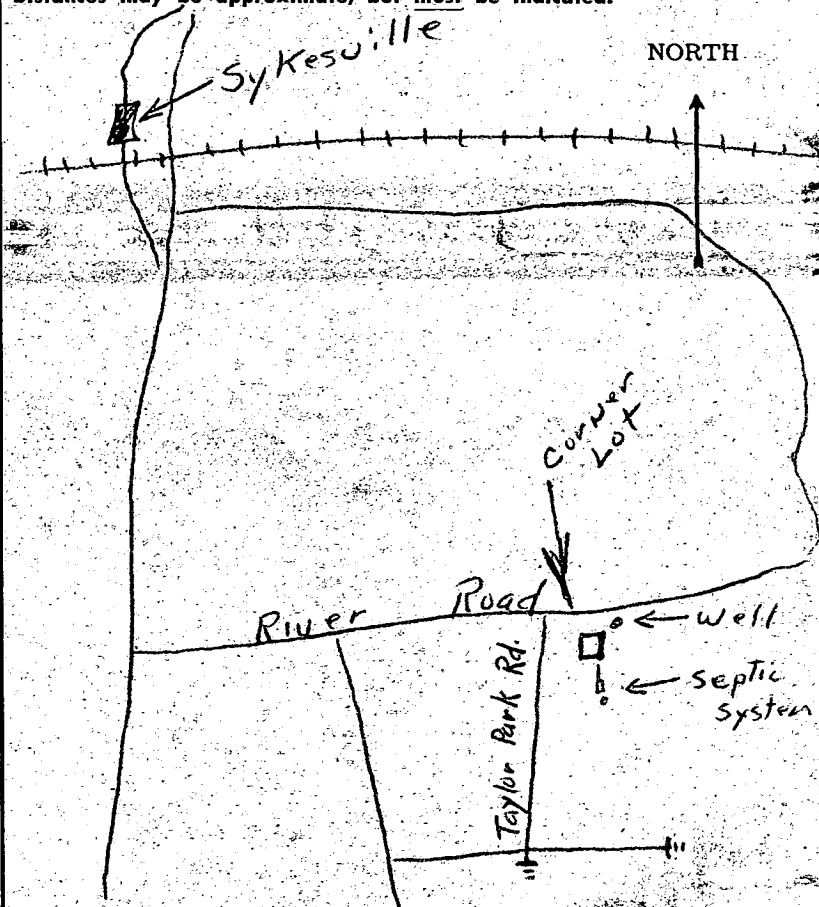

WELL COMPLETION REPORT

WELL DESCRIPTION

WATER RESOURCES

A

WELL LOG

State the kind of formations penetrated, their color, their depth, their thickness, and if water-bearing

B

CASING AND SCREEN RECORD

State the kind and size and position of casing, liner, shoe, screen, and other accessories (if no casing used, give diameter of well).

FEET
from ___ to ___

DIAM.
(inches)

FEET
from ___ to ___

Dirt

0-15

.188
WWC

6 1/4

0-44

Quartz

15-19

Sand + Mud

19-35

Quartz

35-37

Sand + Mud

37-42

Hard Brown
Rock

42-55

water

Gray-Green
Rock

55-65

Permit Number 40 6900 45

Owner John Angel

Address Catoonsville Md

Subdivision Indian Hills

Section ___ Lot 9

County Permit Number ___

PUMPING TEST

Hours Pumped Two

Type of Pump Used Boyer

Pumping Rate 2 P.M.

Gallons per Minute 15

WATER LEVEL

(Distance from land surface to water)

Before Pumping 40 Ft.

When Pumping 45 Ft.

APPEARANCE OF WATER

Clear ☒ Cloudy ☐

Taste None

Odor None

Height of Casing Above Land

Surface 3 Ft.

PUMP INSTALLED

Type ___

Capacity

Gallons per Minute ___

Gallons per Hour ___

Pump Column Length ___ Ft.


LOCATION OF WELL ON LOT

Show permanent structures such as building(s), septic tank, and/or other landmarks and indicate not less than 2 distances (measurements) to well.

River Rd.

Across Rd.

NORTH

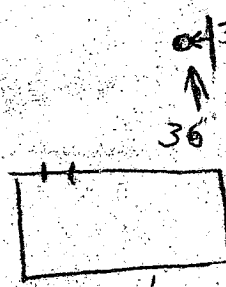

DATE
WELL WAS
COMPLETED

I hereby affirm that this report contains no willful misrepresentation or falsifications and that information given in this report is true, accurate and complete to the best of my knowledge and belief.

Walter A. Colquhoun, Well Driller

Well Driller License No.: 310

Oct 5