

7/21/93
(11:00 a.m. - 3:00 p.m.)
Done seen
left out added
new
hold for

PERMIT

File

SEWAGE DISPOSAL SYSTEM

DEPARTMENT OF HEALTH AND MENTAL HYGIENE

HOWARD COUNTY HEALTH DEPARTMENT
BUREAU OF ENVIRONMENTAL HEALTH
461-9933

03-307375
7/21
INDEXED (3:00 P.M.)

P 49551

A REPAIR

DISTRICT 3rd

DATE 8/24/93

DATE SYSTEM APPROVED 7/21/93

INSPECTOR C.B.D.

Jack Fyock

IS PERMITTED TO INSTALL ALTER X

ADDRESS 13775 Triadelphia Road, Glenelg, Maryland 21737 PHONE 988-9270

SUBDIVISION Farside LOT 60 ROAD 11730 Spring Haven Court

PROPERTY OWNER Robert Riedy

(To 20' off Existing Split Rail Fence)

ADDRESS 11730 Spring Haven Court, Ellicott City, Maryland 21042 PHONE: 730-4350

SEPTIC TANK CAPACITY GALLONS

NUMBER OF BEDROOMS 5

(270⁺ SQUARE FEET PER BEDROOM)

LINEAR FEET OF TRENCH REQUIRED

(Part adapter on trench end @ Dist. Box.)
Only 1 trench tank system
[New Trench @ end of old 1' old]

REPAIR - PURPOSE - To repair an overflowing septic system.

CALL FOR AN INSPECTION WHEN GROUND IS OPENED UP AND SANITARIAN WILL RECOMMEND REPAIR

SYSTEM. 1 Trench (old) 3' Maximum Depth 9 1/2' 60' + in length

+ (1) trench to be 2' wide with 360' + trench, 6' of stone under pipe

connect off old 1' trench, as discussed; C.B.D.

Place 11'3" from tree run on contour to road to 20' off

PLANS APPROVED BY Craig D. Williams

(C.B.D. at site)

DATE 5/12/93

COVER NO WORK UNTIL INSPECTED AND APPROVED

See original 03/21/6 also

NEITHER THE HOWARD COUNTY COUNCIL NOR THE HEALTH DEPARTMENT IS RESPONSIBLE FOR THE SUCCESSFUL OPERATION OF ANY SYSTEM

NOTE: CLEANOUT REQUIRED EVERY 70 FEET OF SEWER LINE AND/OR AT 90° SWEEPS IN LINES FROM HOUSE TO DRAIN FIELDS, 90° ELBOWS NOT ACCEPTABLE.

NOTE: ALL PARTS OF SEPTIC SYSTEMS (I.E. TANK, DISTRIBUTION BOX TRENCHES) TO BE 100 FEET FROM WELL (UNLESS OTHERWISE SPECIFICALLY AUTHORIZED)

NOTE: IF DEEP TRENCH(ES) ARE USED CALL FOR INSPECTION BEFORE AND AFTER PLACING GRAVEL IN TRENCH(ES)

NOTE: NO DRY WELL SHALL EXCEED 15 FOOT IN DIAMETER NO ABSORPTION TRENCH TO EXCEED 100 FEET IN LENGTH

NOTE: ALL PIPE FROM HOUSE TO SEPTIC TANK MUST BE CAST IRON OR SCHEDULE 35/40 PVC OR ABS

PERMIT VOID AFTER TWO YEARS

NOTE: INSTALL STAND PIPE ON SEPTIC TANK AND DRY WELL STAND PIPES MUST BE 6 INCHES IN DIAMETER CAST IRON. CONCRETE OR TERRA COTTA OR PVA OR ABS ACCEPTED. IF TOP OF SEPTIC TANK IS DEEPER THAN 3 FEET. MANHOLE TO GRADE REQUIRED.

NOTE: DISTRIBUTION BOXES MUST HAVE BAFFLES

*INSTALLER IS RESPONSIBLE FOR OBTAINING FINAL APPROVAL ON THIS PERMIT

49551

PERMIT

SEWAGE DISPOSAL SYSTEM

MARYLAND STATE DEPARTMENT OF HEALTH

HOWARD COUNTY

ELLICOTT CITY

DISTRICT 3rd

DATE 8/4/81

INDEX

Robert L. Orndorff

IS PERMITTED TO INSTALL X ALTER

ADDRESS 13938 Highland Road, Clarksville, Md 21029 PHONE 596-9394

SUBDIVISION Farside ROAD 11730 Spring Haven Court LOT 60

PROPERTY OWNER Robert Riedy

ADDRESS 4913 W. Running Brook, Columbia, Maryland 21044

SPECIFICATIONS 5 bedrooms

SEPTIC TANK CAPACITY 1500 GALLONS

DRAIN FIELD _____ DEPTH _____ FEET. BOTTOM AREA _____ SQ. FT.

DEEP TRENCH _____ DEPTH _____ FEET. BOTTOM AREA _____ SQ. FT.

SEEPAGE PITS _____ ABSORBENT SIDE-WALL AREA _____ SQ. FT.

INLET PIPE _____ FT. BELOW ORIGINAL GRADE. MAXIMUM DEPTH _____ FT. BELOW ORIGINAL GRADE

EFFECTIVE DEPTH AT _____ FT. BELOW ORIGINAL GRADE.

LOCATE DISPOSAL AREA _____ FT. FROM _____ LOT LINE AND _____ FT. FROM _____ LOT LINE AS SEEN WHEN

TRENCHES

~~XXXXXXXXXXXX~~
150' per bedroom. Trench 2' wide inlet 2 1/2' below original grade, Maximum depth 5' below original grade, effective area begins at 3' below original grade. 2 1/2' of stone below distribution pipe.

NOTE: 1. No trench to exceed 100' in length. 2. If more than one trench used, a distribution box is required. 3. Trenches to be installed on level ground.

LOCATION: Start trenches 105' from existing paving along the front of the lot, and 230' from the left (276.16') lot line.

PLANS APPROVED BY Frank Skinner DATE 5/1/81

COVER NO WORK UNTIL INSPECTED AND APPROVED.

NEITHER THE HOWARD COUNTY COUNCIL NOR THE HEALTH DEPARTMENT IS RESPONSIBLE FOR THE SUCCESSFUL OPERATION OF ANY SYSTEM.

NOTE: IF TRENCH IS USED CALL FOR INSPECTION BEFORE PLACING GRAVEL IN TRENCH.

NOTE: NO DRY WELL SHALL EXCEED 15 FOOT IN DIAMETER.

NOTE: ALL PIPE FROM HOUSE TO DISPOSAL AREA MUST BE CAST IRON.

PERMIT VOID AFTER THREE YEARS.

NOTE: INSTALL STAND PIPE ON SEPTIC TANK AND DRY WELL. STAND PIPES MUST BE 6 INCHES IN DIAMETER. CAST IRON, CONCRETE OR TERRA COTTA ACCEPTED.

*INSTALLER IS RESPONSIBLE FOR OBTAINING FINAL APPROVAL ON THIS PERMIT.

BLDG. PERMIT SIGNED
AND RETURNED 8/15/81

Serial # 72289
Sumner

BLDG. PERMIT SIGNED
AND RETURNED 4/21/83


Serial # 54472
ST-20
addition cedar deck
& concrete patio

BLDG. PERMIT SIGNED
AND RETURNED 4/21/83

Serial # 54460
Port.

EH-2-1079

overflow
+
Repair
7/21/81

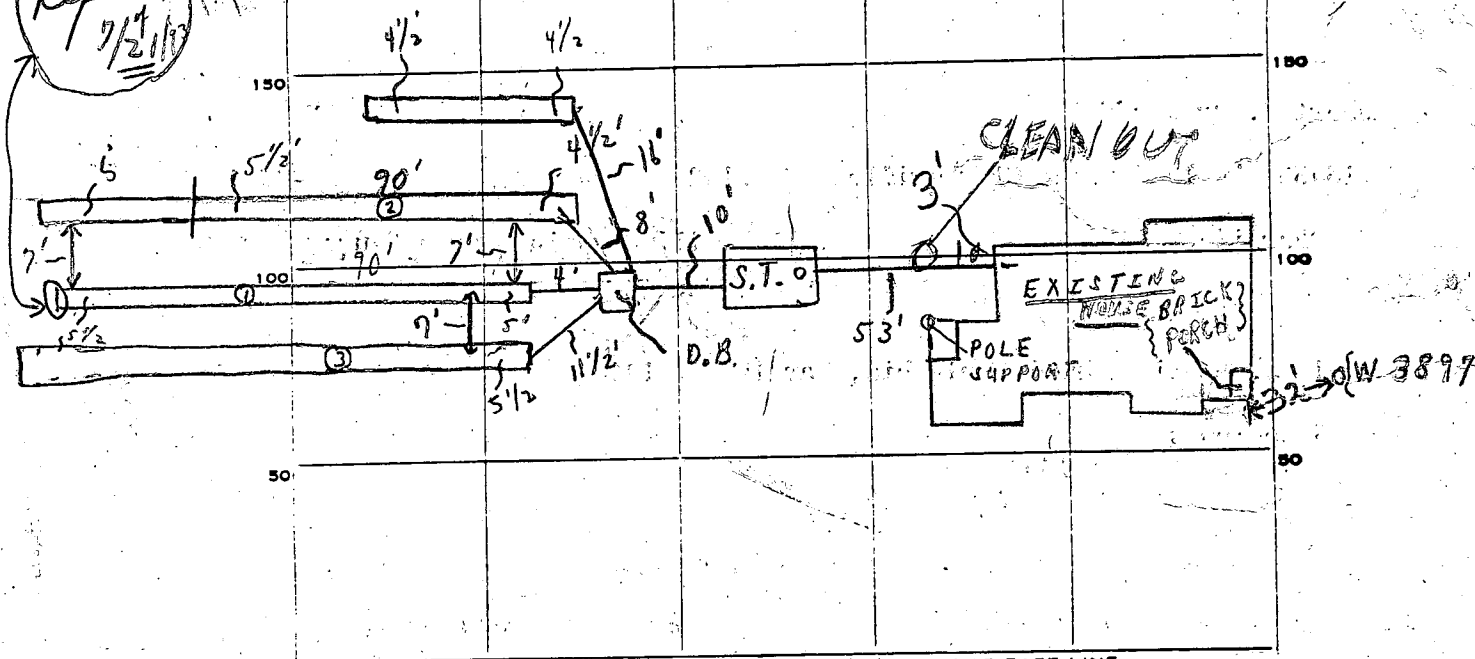

INDICATE NORTH - NAME ADJOINING ROADWAY AS BASE LINE.
SPRING HAVEN COURT

PERMIT CARD ☒

SEPTIC TANK, LEVEL ☒

CLEANOUTS ☒

DISTRIBUTION BOX, LEVEL ☒

TILE FIELD, DEPTH ① 5' + AVC. ② 5' AVC. FT. TRENCH WIDTH ③ 2 FT.

GRAVEL DEPTH ③ 3 AVG. IN. TOTAL LENGTH ① 90' ② 90' ③ 90' ④ 30' } 300 FT.

NUMBER OF TRENCHES 4 TOTAL BOTTOM AREA

SEEPAGE PITS, INSIDE DIAMETER FT. DEPTH BELOW INLET FT.

ABSORBENT AREA 900⁺ SQ. FT.

REMARKS 9/10/81 (1) CHECKED ① + ② TRENCHES - ONLY OK FOR STONE; NEED CLEANOUT BETWEEN

SEPTIC TANK AND HOUSE - PARTIAL (2) PM 3 TRENCHES @ 90' EACH - OK

FOR STONE & PIPE; DO NOT COVER TIL INSPECTED - PARTIAL

9/14/81 (1) ② TRENCH OK TO COVER & ③ TRENCH OK TO COVER FIRST 65'

(2) 30' OF TRENCH #④ OK FOR STONE ONLY, (3) OK TO COVER FROM

TRENCHES TO SEPTIC TANK ONLY; STILL NEED CLEANOUT BETWEEN HOUSE

AND TANK. PARTIAL

DATE SYSTEM APPROVED

INSPECTOR

9/17/81

9/17/81 CLEANOUT INSTALLED
Hodge

Subdivision: ~~Farview~~

Lot # 60

TRENCHES

150 sq. ft. / bdrm

3 bdrm

SEPTIC TANK

1000 GAL.

Minimum Total Sq. Ft.

450

4 bdrm

1250 GAL.

600

5 bdrm

1500 GAL

750

per B.H.# 469175.S

300
25 | 7500

TRENCH 2 WIDTH

INLET 2 1/2 ft below ORIGINAL GRADE

MAXIMUM DEPTH 5 ft below ORIGINAL GRADE

EFFECTIVE AREA BEGINS AT 3 ft below ORIG. GD.

2 1/2 ft OF STONE below distribution pipe.

NOTE: ① NO TRENCH TO EXCEED 100 ft IN LENGTH

② IF MORE THAN ONE TRENCH USED, A
distribution box is REQUIRED

③ TRENCHES TO BE INSTALLED ON LEVEL
ground.

LOCATION: Start trenches 105' from existing paving
along the front of the lot, and 230' from the
left (276.16') lot line

APPLICATION

SEWAGE DISPOSAL TESTING

STATE OF MARYLAND - DEPARTMENT OF HEALTH AND MENTAL HYGIENE

HOWARD COUNTY HEALTH DEPARTMENT
ENVIRONMENTAL HEALTH SERVICES

P. O. BOX 473 ELLICOTT CITY, MARYLAND 21043
TELEPHONE: 992-2330

A 3/2/81

P _____

DISTRICT 3

DATE MARCH 10, 1981

BLDG. PERMIT SIGNED
AND RETURNED 7/7/81
Serial # 46917

TO: THE COUNTY HEALTH OFFICER
ELLICOTT CITY, MARYLAND

I, HEREBY, APPLY FOR THE NECESSARY TEST IN ORDER TO CONSTRUCT (OR RECONSTRUCT) A SEWAGE DISPOSAL SYSTEM.

PROPERTY OWNER WOODMARK, INC. Robert Riedy
4913 W. Running Brook
ADDRESS 12150 MT ALBERT CT 21043 PHONE 730-4350
Columbia, Md 21044 531-5072

PROPERTY LOCATION:

SUBDIVISION FAR SIDE LOT NO. 60
11730
ROAD AND DESCRIPTION SPRING HAVEN COURT

SIZE OF LOT 3.714 TYPE BLDG. _____
(NUMBER OF BEDROOMS)

THE SYSTEM INSTALLED UNDER THIS APPLICATION IS ACCEPTABLE ONLY UNTIL PUBLIC FACILITIES BECOME AVAILABLE. I FULLY UNDERSTAND THE
FEE CONNECTED WITH THE FILING OF THIS PERC TEST APPLICATION IS NON-REFUNDABLE UNDER ANY CIRCUMSTANCES. I ALSO AGREE TO COMPLY
WITH ALL M.O.S.H.A. REQUIREMENTS IN TESTING THIS LOT.

Philip C. Smith
(SIGNATURE OF APPLICANT)

APPROVED BY Frank Skinner FOR _____ DATE 5/1/81

REJECTED BY _____ FOR _____ DATE _____

HOLD PENDING FURTHER TESTS _____ DATE _____

REASONS FOR REJECTION OR HOLDING _____

THIS IS NOT A PERMIT

EH-12-1079

APPLICATION

SEWAGE DISPOSAL TESTING

STATE OF MARYLAND - DEPARTMENT OF HEALTH AND MENTAL HYGIENE

HOWARD COUNTY HEALTH DEPARTMENT
ENVIRONMENTAL HEALTH SERVICES

P. O. BOX 473 ELLICOTT CITY, MARYLAND 21043
TELEPHONE: 992-2330

A 3/2/81

P _____

DISTRICT 3

DATE MARCH 10, 1981

TO: THE COUNTY HEALTH OFFICER
ELLICOTT CITY, MARYLAND

I HEREBY APPLY FOR THE NECESSARY TEST IN ORDER TO CONSTRUCT (OR RECONSTRUCT) A SEWAGE DISPOSAL SYSTEM.

PROPERTY OWNER WOODMARK, INC.

ADDRESS 12150 MT ALBERT CT 21043 PHONE 531-5072

PROPERTY LOCATION:

SUBDIVISION FAR SIDE LOT NO. 60

ROAD AND DESCRIPTION SPRING HAVEN COURT

SIZE OF LOT 3.714 TYPE BLDG. _____
(NUMBER OF BEDROOMS)

THE SYSTEM INSTALLED UNDER THIS APPLICATION IS ACCEPTABLE ONLY UNTIL PUBLIC FACILITIES BECOME AVAILABLE. I FULLY UNDERSTAND THE
FEE CONNECTED WITH THE FILING OF THIS PERC TEST APPLICATION IS NON-REFUNDABLE UNDER ANY CIRCUMSTANCES. I ALSO AGREE TO COMPLY
WITH ALL M.O.S.H.A. REQUIREMENTS IN TESTING THIS LOT.

Philip C. Smith
(SIGNATURE OF APPLICANT)

APPROVED BY _____ FOR _____ DATE _____

REJECTED BY _____ FOR _____ DATE _____

HOLD PENDING FURTHER TESTS _____ DATE _____

REASONS FOR REJECTION OR HOLDING _____

THIS IS NOT A PERMIT

CUR

OLD HOLES

3


CLAY
BROWN
SANDY
LOAM
ROCK
SAND

2

CLAY
BROWN
JAWY
SANDY
LOAM
ROCKY
SANDY
LOAM
HARD
SANDY
LOAM
HARD
ROCK

SOIL PROFILE

CLAY
VERY
SANDY
LOAM
ROCK
SOLID

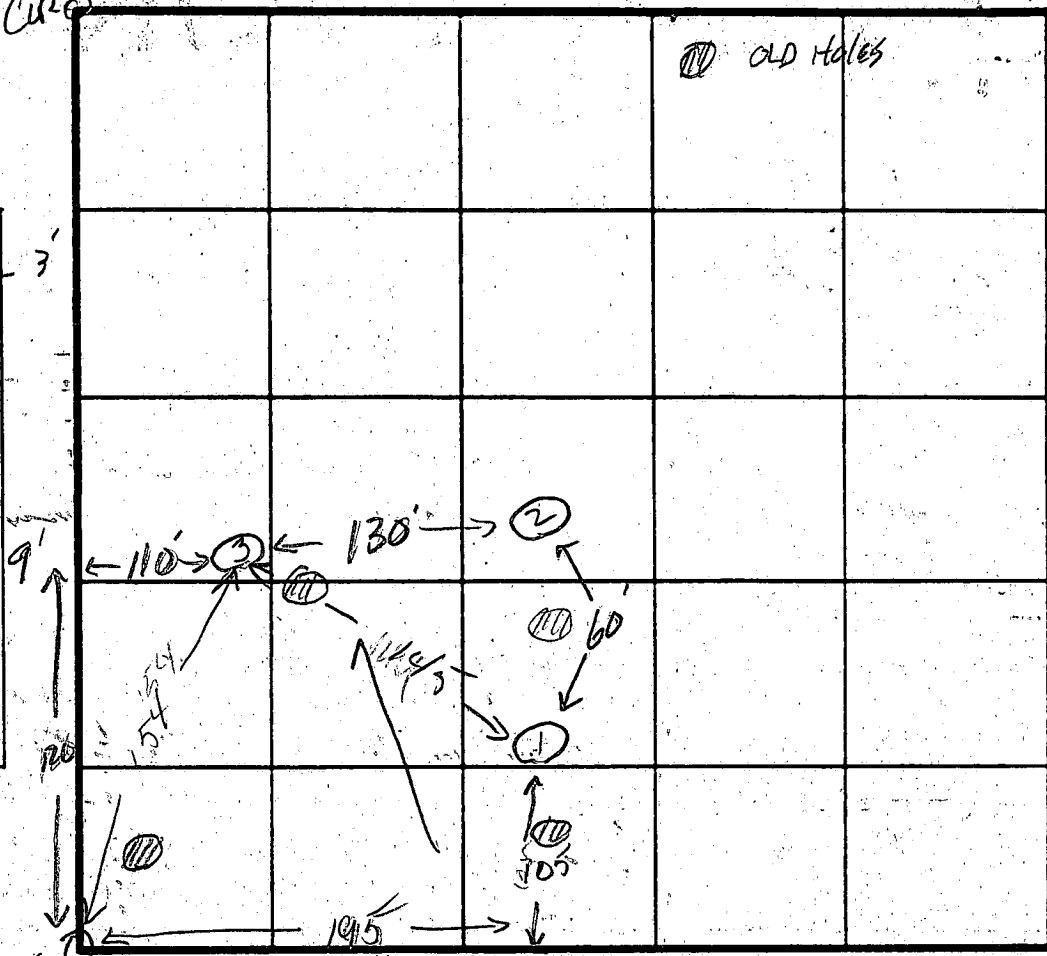

INDICATE NORTH - NAME ADJOINING ROADWAY AS BASE LINE.

SPRING HAVEN COURT

DATE	TEST NO.	DEPTH	PRE-WET		TEST - 1" DROP		TIME
			START	STOP	START	STOP	
3/18/81	13	3'	9:41	9:42	9:42	9:44	2
	1M	8'	9:53	9:54	9:54	9:56	2
	10	9'					
	23	3'	9:43	9:48	9:48	10:00	12
	2M	7'	10:25	10:26	10:26	10:29	3
	20						
	33	4'	9:45	9:47	9:47	9:51	4
	3M	8'	9:58	10:00	10:00	10:04	4
	30	10'					

REMARKS

Rituel

TYPE OF SOIL

TESTED BY

SK 3/18/81

ALSO PRESENT

APPLICATION

28318

A 28319

P _____

SEWAGE DISPOSAL TESTING

STATE OF MARYLAND - DEPARTMENT OF HEALTH AND MENTAL HYGIENE

HOWARD COUNTY HEALTH DEPARTMENT
ENVIRONMENTAL HEALTH SERVICESP. O. BOX 476, ELLICOTT CITY, MARYLAND 21043
TELEPHONE: 465-5000, EXT. 356DISTRICT 1000 gallonsDATE May 12, 19781250 gallonsTO: THE COUNTY HEALTH OFFICER
ELLICOTT CITY, MARYLAND

I, HEREBY, APPLY FOR THE NECESSARY TEST IN ORDER TO CONSTRUCT (OR RECONSTRUCT) A SEWAGE DISPOSAL SYSTEM.

PROPERTY OWNER Woodmark, Inc.ADDRESS 9267 Balto. Nat'l. PikePHONE 461-2889

PROPERTY LOCATION:

SUBDIVISION FarsideLOT NO. 62 60ROAD AND DESCRIPTION Rt. 40 West to left on Rt. 144, left on Folly Quarter, left on
Homewood, 1 mile to property on leftSIZE OF LOT 3 plus acresTYPE BLDG. 11
NUMBER OF BEDROOMS

IF NOT SINGLE RESIDENCE DESCRIBE _____

THE SYSTEM INSTALLED UNDER THIS APPLICATION IS ACCEPTABLE ONLY UNTIL PUBLIC FACILITIES BECOME AVAILABLE.

SIGNATURE OF APPLICANT R. J. O'Connell

APPROVED BY _____

FOR _____

(KIND OF SYSTEM)

DATE 1 1

REJECTED BY _____

FOR _____

(KIND OF SYSTEM)

DATE _____

HOLD PENDING FURTHER TESTS _____

DATE _____

REASONS FOR REJECTION OR HOLDING _____

THIS IS NOT A PERMIT



Sail Profile

UNNAMED ROAD

150 sq ft.
per bedroom

DATE	TEST NO.	DEPTH	PRE-WET		TEST		TIME
			START	STOP	START	STOP	
7/7/78	1 pu.	4'	1:00	1:01	1:01	1:03	2m
	(A) 2 J	12'	1:00	1:02	1:02	1:05	3m
	3 A	3'-3 1/2'	1:05	1:11	Pulled pig 1:19		
	(L) 4	10'	1:05	1:08	1:08	1:18	10m
	5	3 1/2'	Visual		similar		
	6	10 1/2'			to		
	7	12'			others		
	3 B	4'	1:42	1:44	1:44	1:55	11m
							4 26

Test
near
slaps

4' index

7m
ang

REMARKS

(Test in open field)

TYPE OF SOIL


TESTED BY

C. B. ✓ & J. ✓

ALSO PRESENT

Same as yesterday

5/1/81
original sent to Dr Boyd
for signature
H. S.

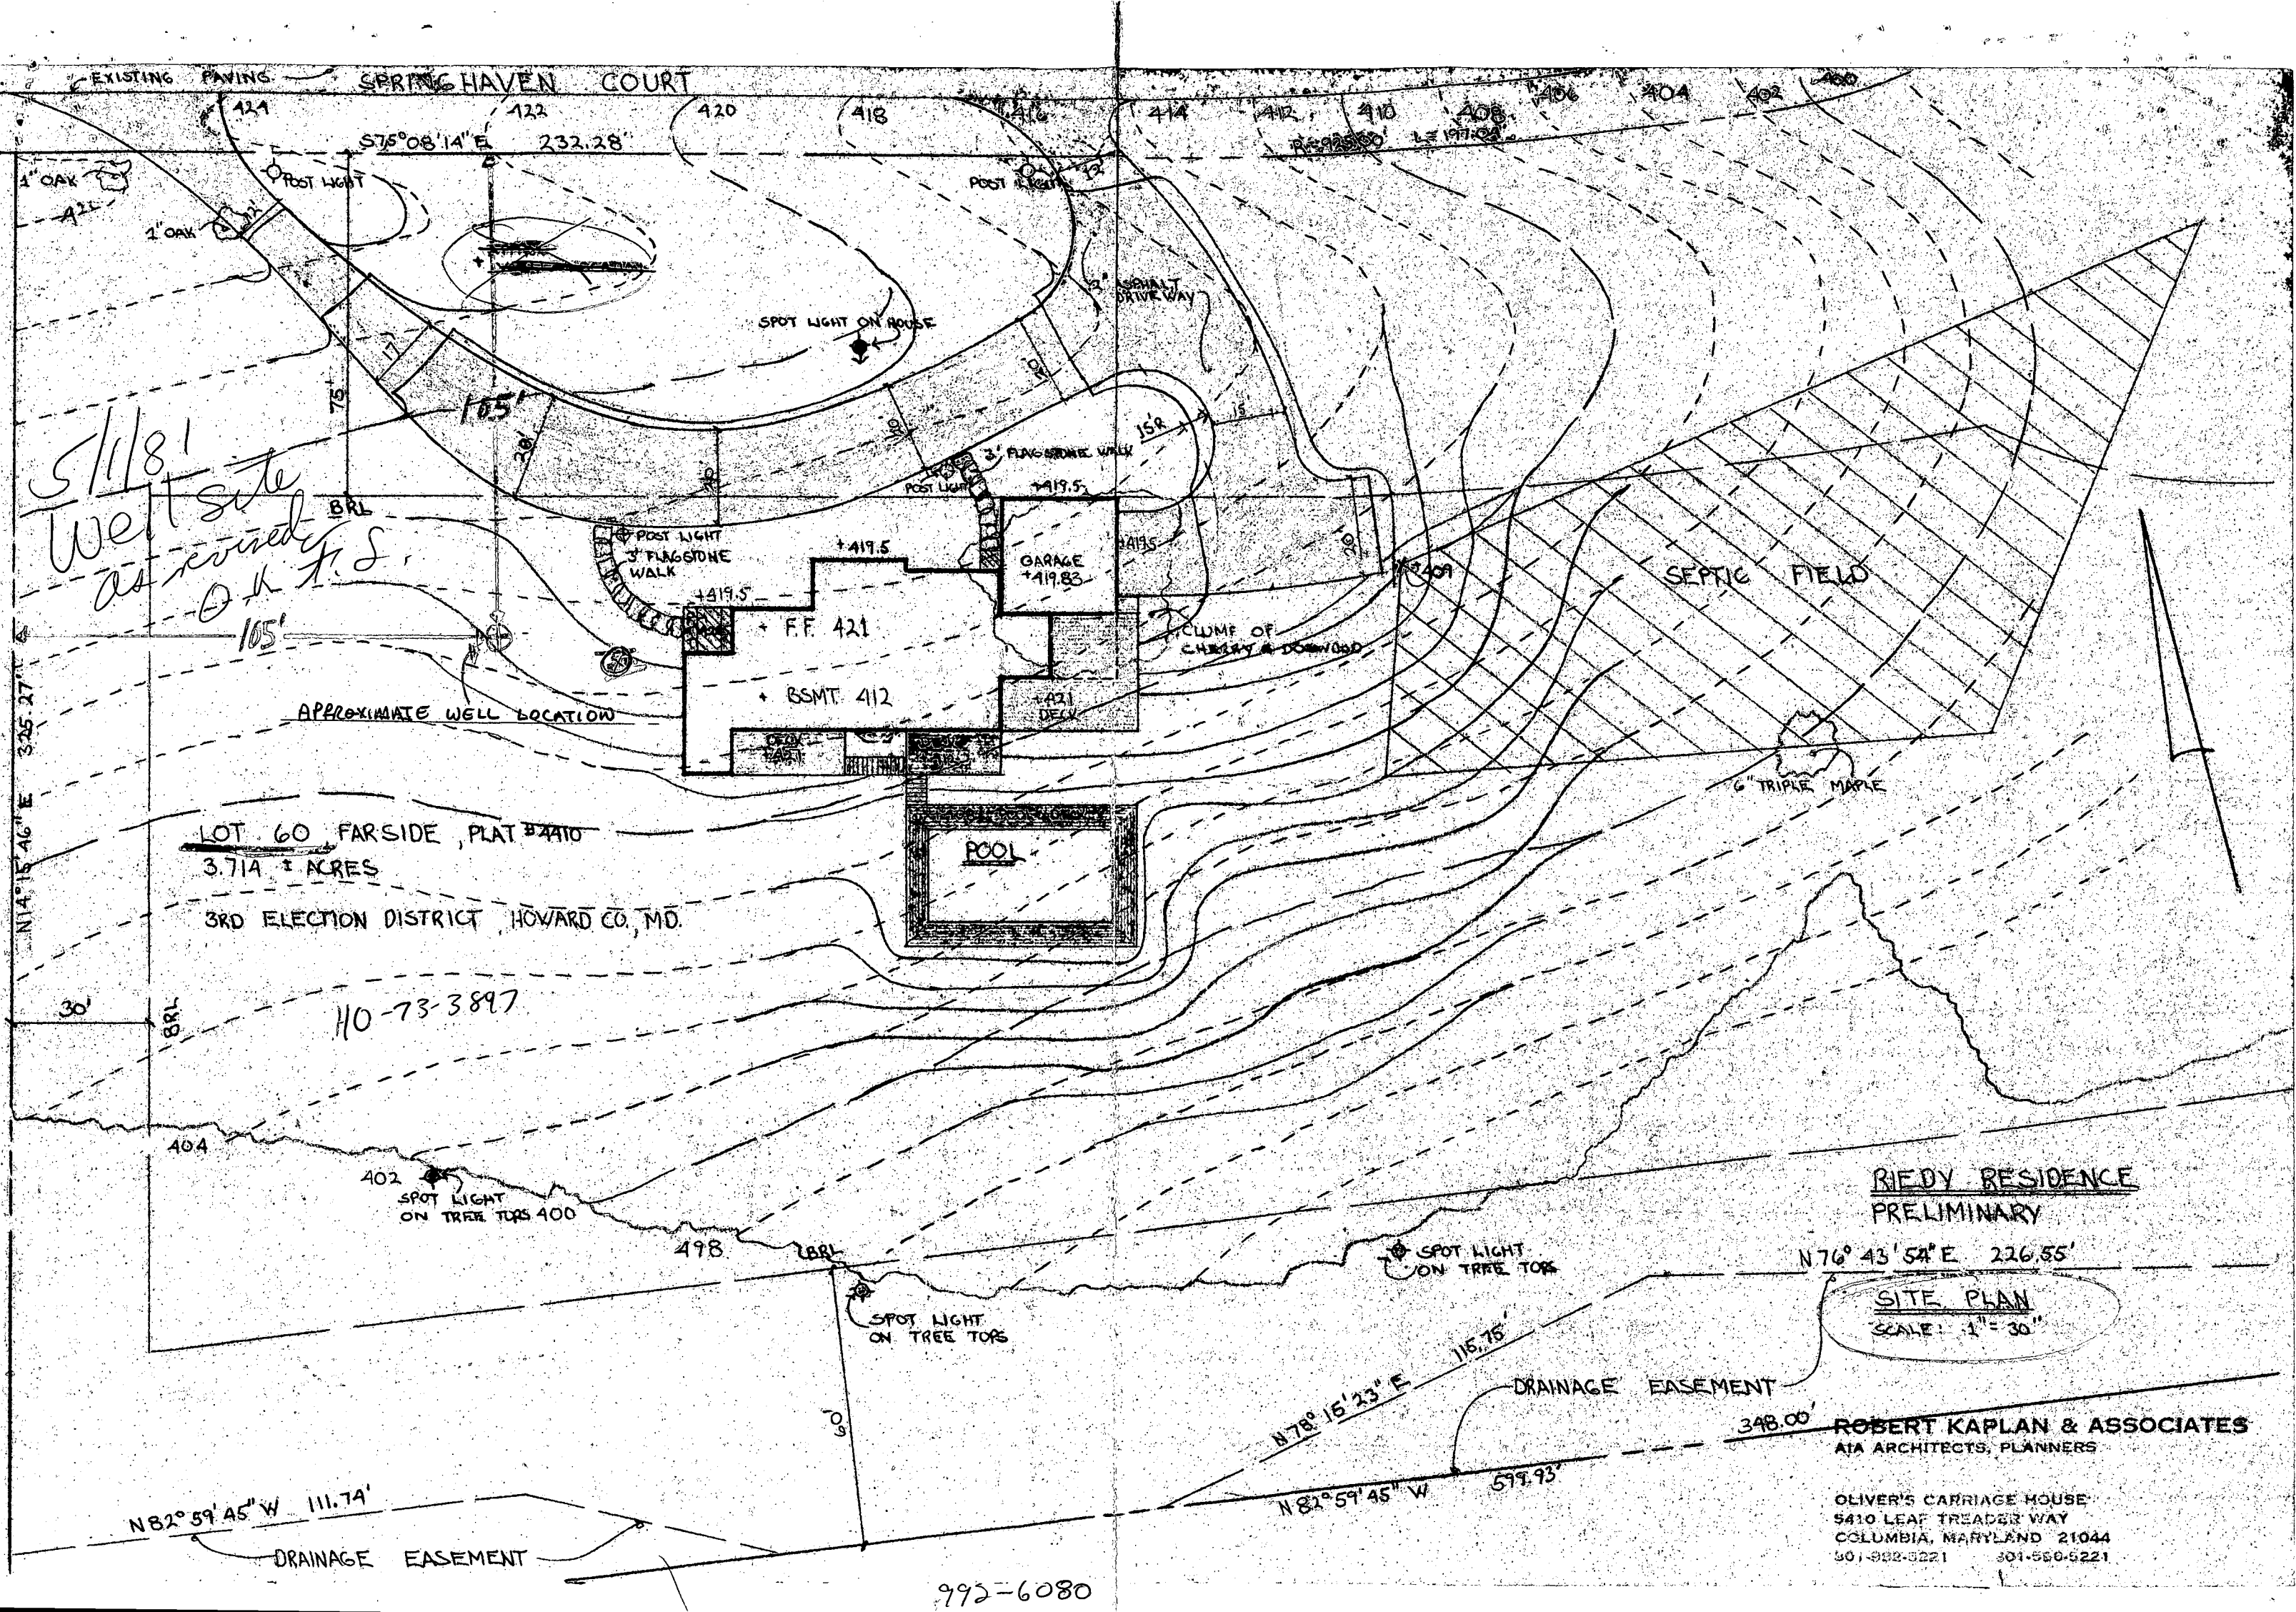

5/1/81
West site
as revised
O.K. H.S.

LOT 60, FAR SIDE, PLAT #4410
3.714 ± ACRES

3RD ELECTION DISTRICT, HOWARD CO., MD.

HO-73-3897

RIEDY RESIDENCE
PRELIMINARY

SITE PLAN
SCALE: 1" = 30'

ROBERT KAPLAN & ASSOCIATES
ATA ARCHITECTS, PLANNERS

OLIVER'S CARRIAGE HOUSE
5410 LEAF TREATER WAY
COLUMBIA, MARYLAND 21044
301-982-3221 301-550-5221

992-6080


APPROVED : For private water and
private sewerage systems.

Howard County Health Department

James Boyer
County Health Officer

Date

R= 25.00'
L= 21.03'

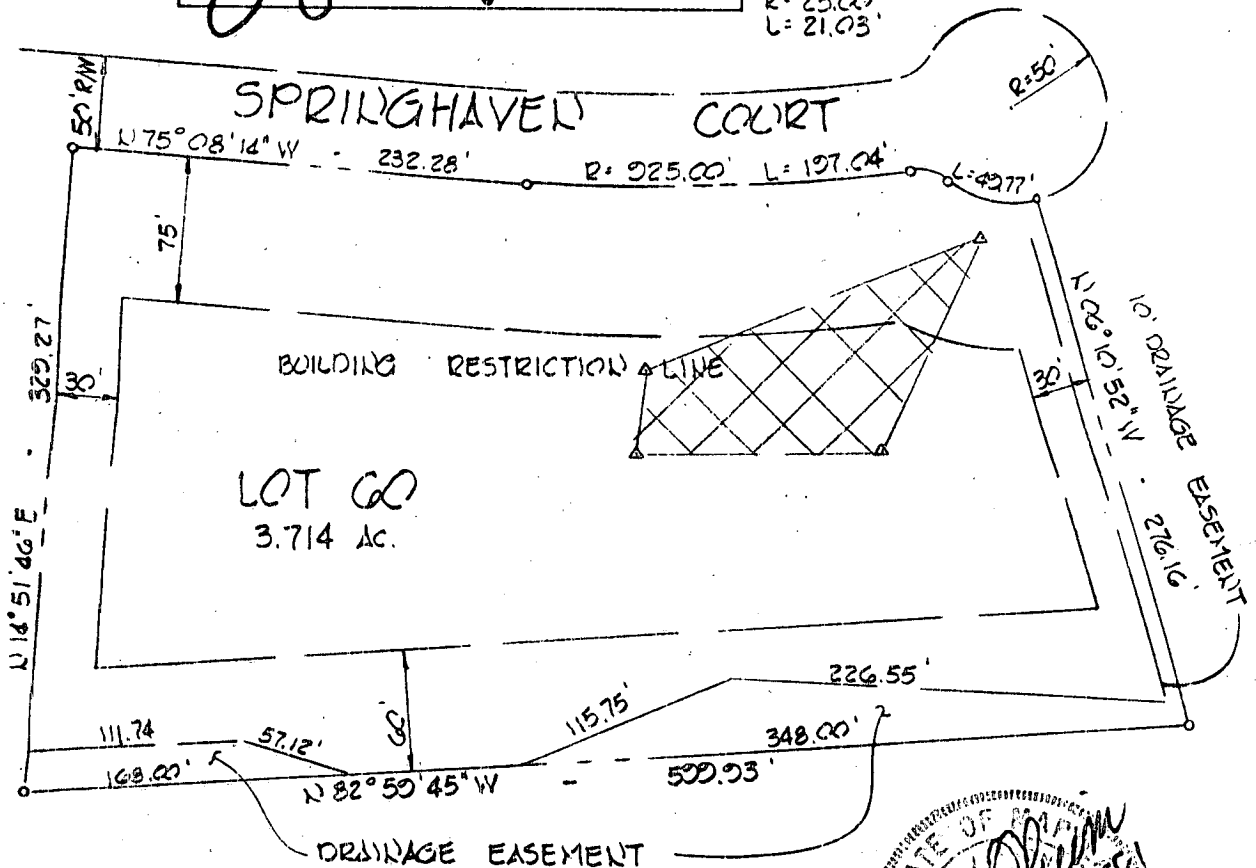


1. The lots shown hereon
comply with the minimum owner-
ship width and lot areas as
required by the MD State
Dept. of health & Mental Hygiene.

2. ☒ This area designates
a private sewerage easement
of approximately 10,000 sq.
ft. as required by the Mary-
land State Department of
Health and Mental Hygiene
for individual sewage dis-
posal. Improvements of any
nature in this area are re-
stricted until public sewage
is available and servicing
any residential structure
constructed on this site.
This easement shall become
null and void upon connec-
tion to a public sewerage
system.

3. ☒ Perculation tests have
been field located.

Perc. Certification

TITLE: "FARSIDE" Lot #60 Record Plat #4410
Sheet 6 of 10 3rd Election District
Howard County, Maryland

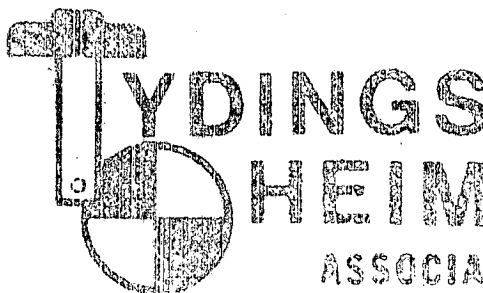

ASSOCIATES INC.

CONSULTING ENGINEERS, LAND & CONSTRUCTION SURVEYORS
8370 COURT AVENUE, ELLICOTT CITY, MD. 21043 465-0660

C1	8265	SEQUENCE NO. (WRA USE ONLY)	STATE OF MARYLAND WELL COMPLETION REPORT FILL IN THIS FORM COMPLETELY PLEASE PRINT OR TYPE		THIS REPORT MUST BE SUBMITTED WITHIN 30 DAYS AFTER WELL IS COMPLETED	
(THIS NUMBER IS TO BE PUNCHED IN COLS. 3-6 ON ALL CARDS)				COUNTY NUMBER A 31216		
Date Received (WRA use only)	6/30/81	DATE WELL COMPLETED	Depth of Well 145		PERMIT NO. FROM "PERMIT TO DRILL WELL" H0-73-3897	
OWNER last name Woodmark Tnc		first name		TOWN Columbia		
STREET OR RFD Farside		SECTION		LOT 60		

WELL LOG	GROUTING RECORD	
Not required for driven wells	WELL HAS BEEN GROUTED (Circle Appropriate Box) YES ☒ NO ☐	
STATE THE KIND OF FORMATIONS PENETRATED, THEIR COLOR, DEPTH, THICKNESS AND IF WATER BEARING	TYPE OF GROUTING MATERIAL CEMENT ☒ BENTONITE CLAY ☐	
DESCRIPTION (Use additional sheets if needed)	FEET	Check if water bearing
	FROM	TO

Top Soil	0	2	
Brown Shale	2	8	
Brown Sandstone	8	22	
Blue Slate	22	80	
Blue Slate	80	85	115
Blue Slate	85	145	

NO. OF BAGS 5	NO. OF POUNDS 770
GALLONS OF WATER 30	
DEPTH OF GROUT SEAL (to nearest foot) from 0 ft. to 20 ft.	

CASING RECORD	
casing types insert appropriate code below	STEEL ☒ CONCRETE ☐ PLASTIC ☐ OTHER ☐
MAIN CASING TYPE	Nominal diameter top/main casing (nearest inch) 6
	Total depth of main casing (nearest foot) 24

OTHER CASING (if used)	
diameter inch	depth (feet) from to

SCREEN RECORD	
screen type or openhole	STEEL ☒ BRASS ☐ OPEN HOLE ☐ BRONZE ☐ PLASTIC ☐ OTHER ☐
insert appropriate code below	

C 2	
(seq. no.)	
DEPTH (nearest ft.) 20 145	
EACH SCREEN	
SLOT SIZE 1 2 3	
DIAMETER OF SCREEN (NEAREST INCH)	

CIRCLE APPROPRIATE BOX	
☒ A	A WELL WAS ABANDONED AND SEALED WHEN THIS WELL WAS COMPLETED
☐ E	ELECTRIC LOG OBTAINED
☐ P	TEST WELL CONVERTED TO PRODUCTION WELL

I HEREBY CERTIFY THAT I HAVE COMPLIED WITH ALL CONDITIONS STATED ON THE ABOVE-CAPTIONED "PERMIT TO DRILL WELL", AND THAT INFORMATION CONTAINED IN THIS REPORT IS TRUE, ACCURATE, AND COMPLETE TO THE BEST OF MY KNOWLEDGE, INFORMATION AND BELIEF.

DRILLERS IDENT. NO.	308
DRILLERS SIGNATURE	
(MUST MATCH SIGNATURE ON APPLICATION)	

SITE SUPERVISOR (sign of driller or journeyman responsible for sitework if different from permittee)	
--	--

GRAVEL PACK	
IF WELL DRILLED WAS FLOWING WELL CIRCLE BOX ☐	

WRA USE ONLY (NOT TO BE FILLED IN BY DRILLER)	
T	(E.R.O.S.)
70	72
TELESCOPE CASING	LOG INDICATOR
OTHER DATA	

C 3	
(seq. no.)	
PUMPING TEST	
HOURS PUMPED (nearest hour) 2	
PUMPING RATE (gal. per min. to nearest gal.) 15	
METHOD USED TO MEASURE PUMPING RATE Bucket	
WATER LEVEL (distance from land surface)	
BEFORE PUMPING 30	
WHEN PUMPING 145	
TYPE OF PUMP USED (for test)	
☒ A	air
☐ P	piston
☐ T	turbine
☐ C	centrifugal
☐ R	rotary
☐ O	other (describe below)
☐ J	jet
☐ S	submersible

PUMP INSTALLED	
YES NO	
DRILLER WILL INSTALL PUMP (CIRCLE APPROPRIATE BOX) ☒ ☐	
IF DRILLER INSTALLS PUMP THIS SECTION MUST BE COMPLETED FOR ALL WELLS EXCEPT HOME USE	
TYPE OF PUMP (WRITE APPROPRIATE LETTER IN BOX - SEE ABOVE: (A, C, J, P, R, S, T, O))	
CAPACITY: GALLONS PER MINUTE (to nearest gallon)	
PUMP HORSE POWER	
PUMP COLUMN LENGTH (nearest ft.)	
CASING HEIGHT (circle appropriate box and enter casing height)	
☒ above	LAND SURFACE
☐ below	2 (nearest foot)

LOCATION OF WELL ON LOT	
SHOW PERMANENT STRUCTURE SUCH AS BUILDING, SEPTIC TANKS, AND/OR LANDMARKS AND INDICATE NOT LESS THAN TWO DISTANCES (MEASUREMENTS TO WELL)	

B 1 6914	SEQUENCE NO. WRA USE ONLY	STATE OF MARYLAND APPLICATION FOR PERMIT TO DRILL WELL please print or type	WRA PERMIT NUMBER HO-73-3897 fill in this form completely
--	------------------------------	---	--

DATE RECEIVED 4/30/81
6/30/81
9:30

8 (WRA USE ONLY) 13
OWNER INFORMATION

Woodmark Inc.
 LAST NAME 12150 Mt. Albert Ct. FIRST NAME
 15 34
Ellicott City, Md. STREET OR RFD 55
 TOWN 57 STATE 76 ZIP

B 1 CONTINUED DRILLER INFORMATION

Stanley W. Bollinger Jr. 308
 DRILLER'S NAME 77 LICENSE NO. 80
Stanley W. Bollinger Jr. 4/29/81
 SIGNATURE DATE

B 2 WELL INFORMATION

APPROX. PUMPING RATE (GAL. PER MIN) 5
 1 2 3 6 8 12
 AVERAGE DAILY QUANTITY NEEDED (GAL. PER DAY) 500
 14 20

USE FOR WATER (CIRCLE APPROPRIATE BOX)

☒ HOME (SINGLE OR DOUBLE HOUSEHOLD UNIT ONLY)
☐ FARMING (LIVESTOCK WATERING & AGRICULTURAL IRRIGATION)
☐ INDUSTRIAL, COMMERCIAL, STATE AND FEDERAL GOV. OTHER (REQUIRES APPROPRIATION PERMIT)
☐ PUBLIC OR PRIVATE WATER COMPANY (REQUIRES APPROPRIATION PERMIT AND STATE HEALTH DEPARTMENT APPROVAL)
☐ TEST, OBSERVATION, MONITORING (MAY REQUIRE APPROPRIATION PERMIT)

APPROXIMATE DEPTH OF WELL 165 FEET
 24 28
 APPROXIMATE DIAMETER OF WELL 6 INCH
 30 37

Method of Drilling (circle one)

BORED (OR AUGERED) JETTED JETTED & DRIVEN
☒ AIR ROTARY ☒ AIR PERCUSSION ☐ ROTARY (HYDRAULIC)
☐ CABLE ☐ REVERSE ROTARY ☐ DRIVE POINT ROTARY
 other _____

REPLACEMENT OR DEEPEMED WELLS
 (Circle Appropriate Box)

☒ THIS WELL WILL NOT REPLACE AN EXISTING WELL
☐ THIS WELL WILL REPLACE A WELL THAT WILL BE ABANDONED AND SEALED
☐ THIS WELL WILL REPLACE A WELL THAT WILL BE USED AS A STANDBY
☐ THIS WELL WILL DEEPM AN EXISTING WELL
 PERMIT NUMBER OF WELL TO BE REPLACED OR DEEPEMED (IF AVAILABLE) 41 52

Not to be filled in by driller (WRA USE ONLY)


APPROX. PERMIT NUMBER GAP
 54 63
 FORCE 1 WRITE INITIALS CONDITIONS ✓
 67 68 IN-BOX 70 71 72 73 74 75 76 77 78 79

B 5 SPECIAL CONDITIONS (WRA USE ONLY)
 1 2 3 6

B 3 LOCATION OF WELL

COUNTY Howard
 SUBDIVISION Foxside
 SECTION 60 LOT 60
 NEAREST TOWN Columbia
 MILES FROM TOWN (enter 0 if in town) 3 **MI**

B 4

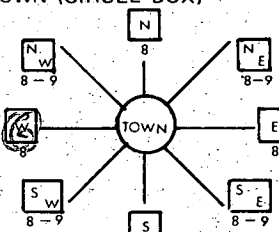DIRECTION OF WELL FROM TOWN (CIRCLE BOX)


NEAR WHAT ROAD Springhaven
 ON WHICH SIDE OF ROAD (CIRCLE APPROPRIATE BOX) ☒ WEST ☐ EAST
80
 34 DISTANCE FROM ROAD (CIRCLE APPROPRIATE BOX) 37 **FT** 38 39


SHOW LOCATION OF WELL WITH AN "X" IN THIS BOX

WRITE THE BOX NUMBER FROM THE MAP HERE

820 6
510 3

24' - casing
 1' - above gr.
 20' - open
 5 - bag cement
 6/30/81 x well

DRAW A SKETCH BELOW SHOWING LOCATION OF WELL IN RELATION TO NEARBY TOWNS AND ROADS AND GIVE DISTANCE FROM WELL TO NEAREST ROAD JUNCTION

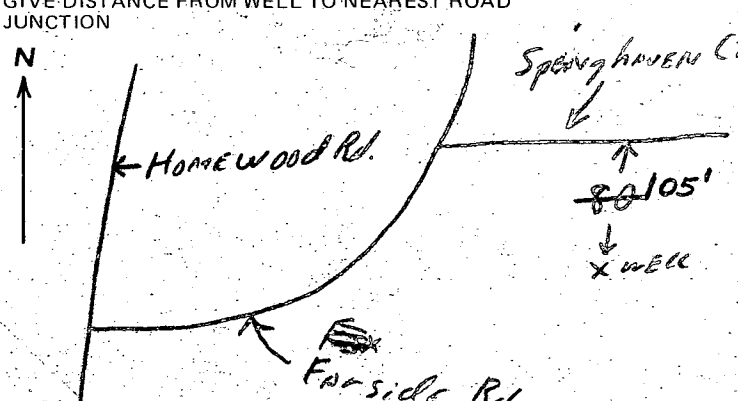

B 4

NOT TO BE FILLED IN BY DRILLER HEALTH DEPARTMENT APPROVAL

HOWARD A 31216
 COUNTY NAME COUNTY NO.
 EHA SIGNATURE Frank Skinner STATE HEALTH CIRCLE BOX ☒ 41
 MO 05 DAY 31 YR 81 DATE
 NORTH 513 EAST 0826 ELEV. (FT.) 51181
 GRID 50 55 GRID 57 63 65 68

PLOT PLAN

OWNER

Mr & Mrs Bob Reidy

Application No. _____

ADDRESS


11730 Springhaven Ct

PLEASE SHOW BELOW:

- property line dimensions and easements.
- existing buildings.
- existing well/septic. (show distance to nearest structure)
- road names and location of alleys.
- if your property is in a tidal or riverine flood area, indicate elevation of lowest floor of proposed work.
- the proposed work and the setback distances to the proposed work.

Front yard setback _____ Left side setback _____
Rear yard setback _____ Right side setback _____

NOTE: If a fence is to be closer than 2 feet to any existing fence or wall, adequate access must be provided for maintenance.

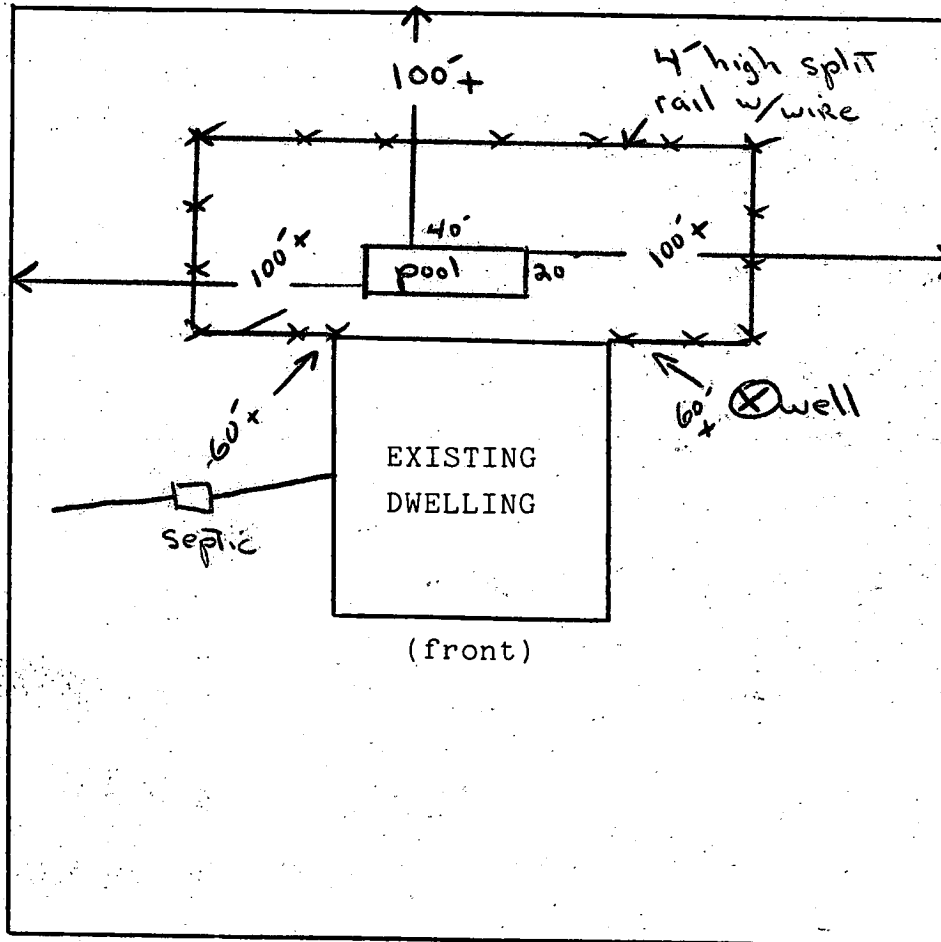

6/17/83
OK TO SIGN
PERMIT
RA

ROAD NAME

Springhaven Ct.

GENERAL NOTES

- 2500 PSI SOIL BEARING ASSUMED. CONTRACTOR TO SEEK APPROPRIATE ENGINEERING ADVICE IF CONDITIONS WARRANT.
- CONCRETE SLABS TO BE ON UNDISTURBED SOIL OR COMPACTED FILL. OTHER CONDITIONS MAY REQUIRE ALTERNATIVE DESIGN NOT SHOWN, AT THE CONTRACTOR'S OPTION AND RESPONSIBILITY.
- 8" THICK CMU WALLS TO HAVE MAX. 4'-0" RETAINAGE.
- STEP FOOTINGS MAX. VERTICAL 2'-0", MIN. HORIZONTAL 4'-0".
- SILL PLATES TO BE SUITIBLY ANCHORED TO MASONRY WITH STRAPS OR ANCHOR BOLTS IMBEDDED IN CONCRETE 4'-0" O.C.
- DIMENSIONS GOVERN OVER SCALE.
- CODES GOVERN OVER DRAWINGS.
- VERIFY ALL MECHANICAL REQUIREMENTS BEFORE FRAMING.
- WINDOW NUMBERS REFER TO ANDERSON UNLESS OTHERWISE NOTED.

STRUCTURAL NOTES


- FOUNDATION:
 - FOOTINGS SHALL BE ON UNDISTURBED SOIL A MINIMUM OF 2'-6" BELOW FINISHED GRADE AND 1' BELOW ORIGINAL GRADE.
 - BACKFILL SHALL NOT BE PLACED UNTIL SUB-FLOOR IS IN PLACE.
- CONCRETE:
 - CONCRETE SHALL BE PROPORTIONED TO DEVELOP COMPRESSIVE STRENGTH OF 3,000 PSI IN 28 DAYS.
 - 6 X 6 #10/10 WIRE MESH SHALL BE PLACED IN ALL SLABS ON GRADE UNLESS NOTED OTHERWISE. LAPS SHALL BE A MINIMUM OF 6".
- MASONRY:
 - ALL MORTAR IN FOUNDATIONS SHALL BE TYPE S PER BOCA BASIC BUILDING CODE, SECTION 816. IT SHALL DEVELOP COMPRESSIVE STRENGTH OF 1,800 PSI IN 28 DAYS.
 - MASONRY WALL REINFORCING SHALL BE STANDARD GAGE DUE-O-WAL, GALVANIZED, LAID IN EVERY SECOND BED JOINT EXCEPT WHERE NOTED OTHERWISE. TWO CONSECUTIVE JOINTS ABOVE AND BELOW OPENINGS AND TOP THREE COURSES OF ALL WALLS SHALL ALSO BE REINFORCED.
 - WHEN DIFFERENTIAL FILL AGAINST OPPOSITE SIDES OF A 12" CONCRETE BLOCK FOUNDATION WALL EXCEEDS 7" AND DOES NOT EXCEED 9", WALL SHALL BE REINFORCED WITH #4 BARS SET VERTICALLY IN CELLS, SPACED 16" APART NEAR THE FACE ON THE LOWER GRADE SIDE. BLOCK CELLS SHALL BE FILLED WITH TYPE S MORTAR. BAR SPLICES SHALL LAP A MINIMUM OF 24". REINFORCE HORIZONTAL JOINTS WITH DUE-O-WAL EVERY COURSE.
 - WHEN DIFFERENTIAL FILL EXCEEDS 9" BUT DOES NOT EXCEED 11", WALL SHALL BE REINFORCED WITH #6 BARS SPACED 16" APART AS IN C ABOVE.
- STRUCTURAL WOOD
 - FRAMING LUMBER SHALL BE HEM FIR #2 OR SOUTHERN YELLOW PINE OR EQUAL.
 - DECK FRAMING AND PLANKING TO BE PRESSURE TREATED.

SITE PLAN LOT 60 FARSIDE

SCALE: 1"=30' PLAT #A410 3RD ELECTION DISTRICT
HOWARD COUNTY, MARYLAND.

CONTRACTOR:
JOHN MOONOUGH BUILDERS, INC.
5829 BANNER ROAD
COLUMBIA, MD. 21044

SURVEY BY:
HUDKINS ASSOCIATES
231 JOSEPH SQUARE
COLUMBIA, MD. 21044

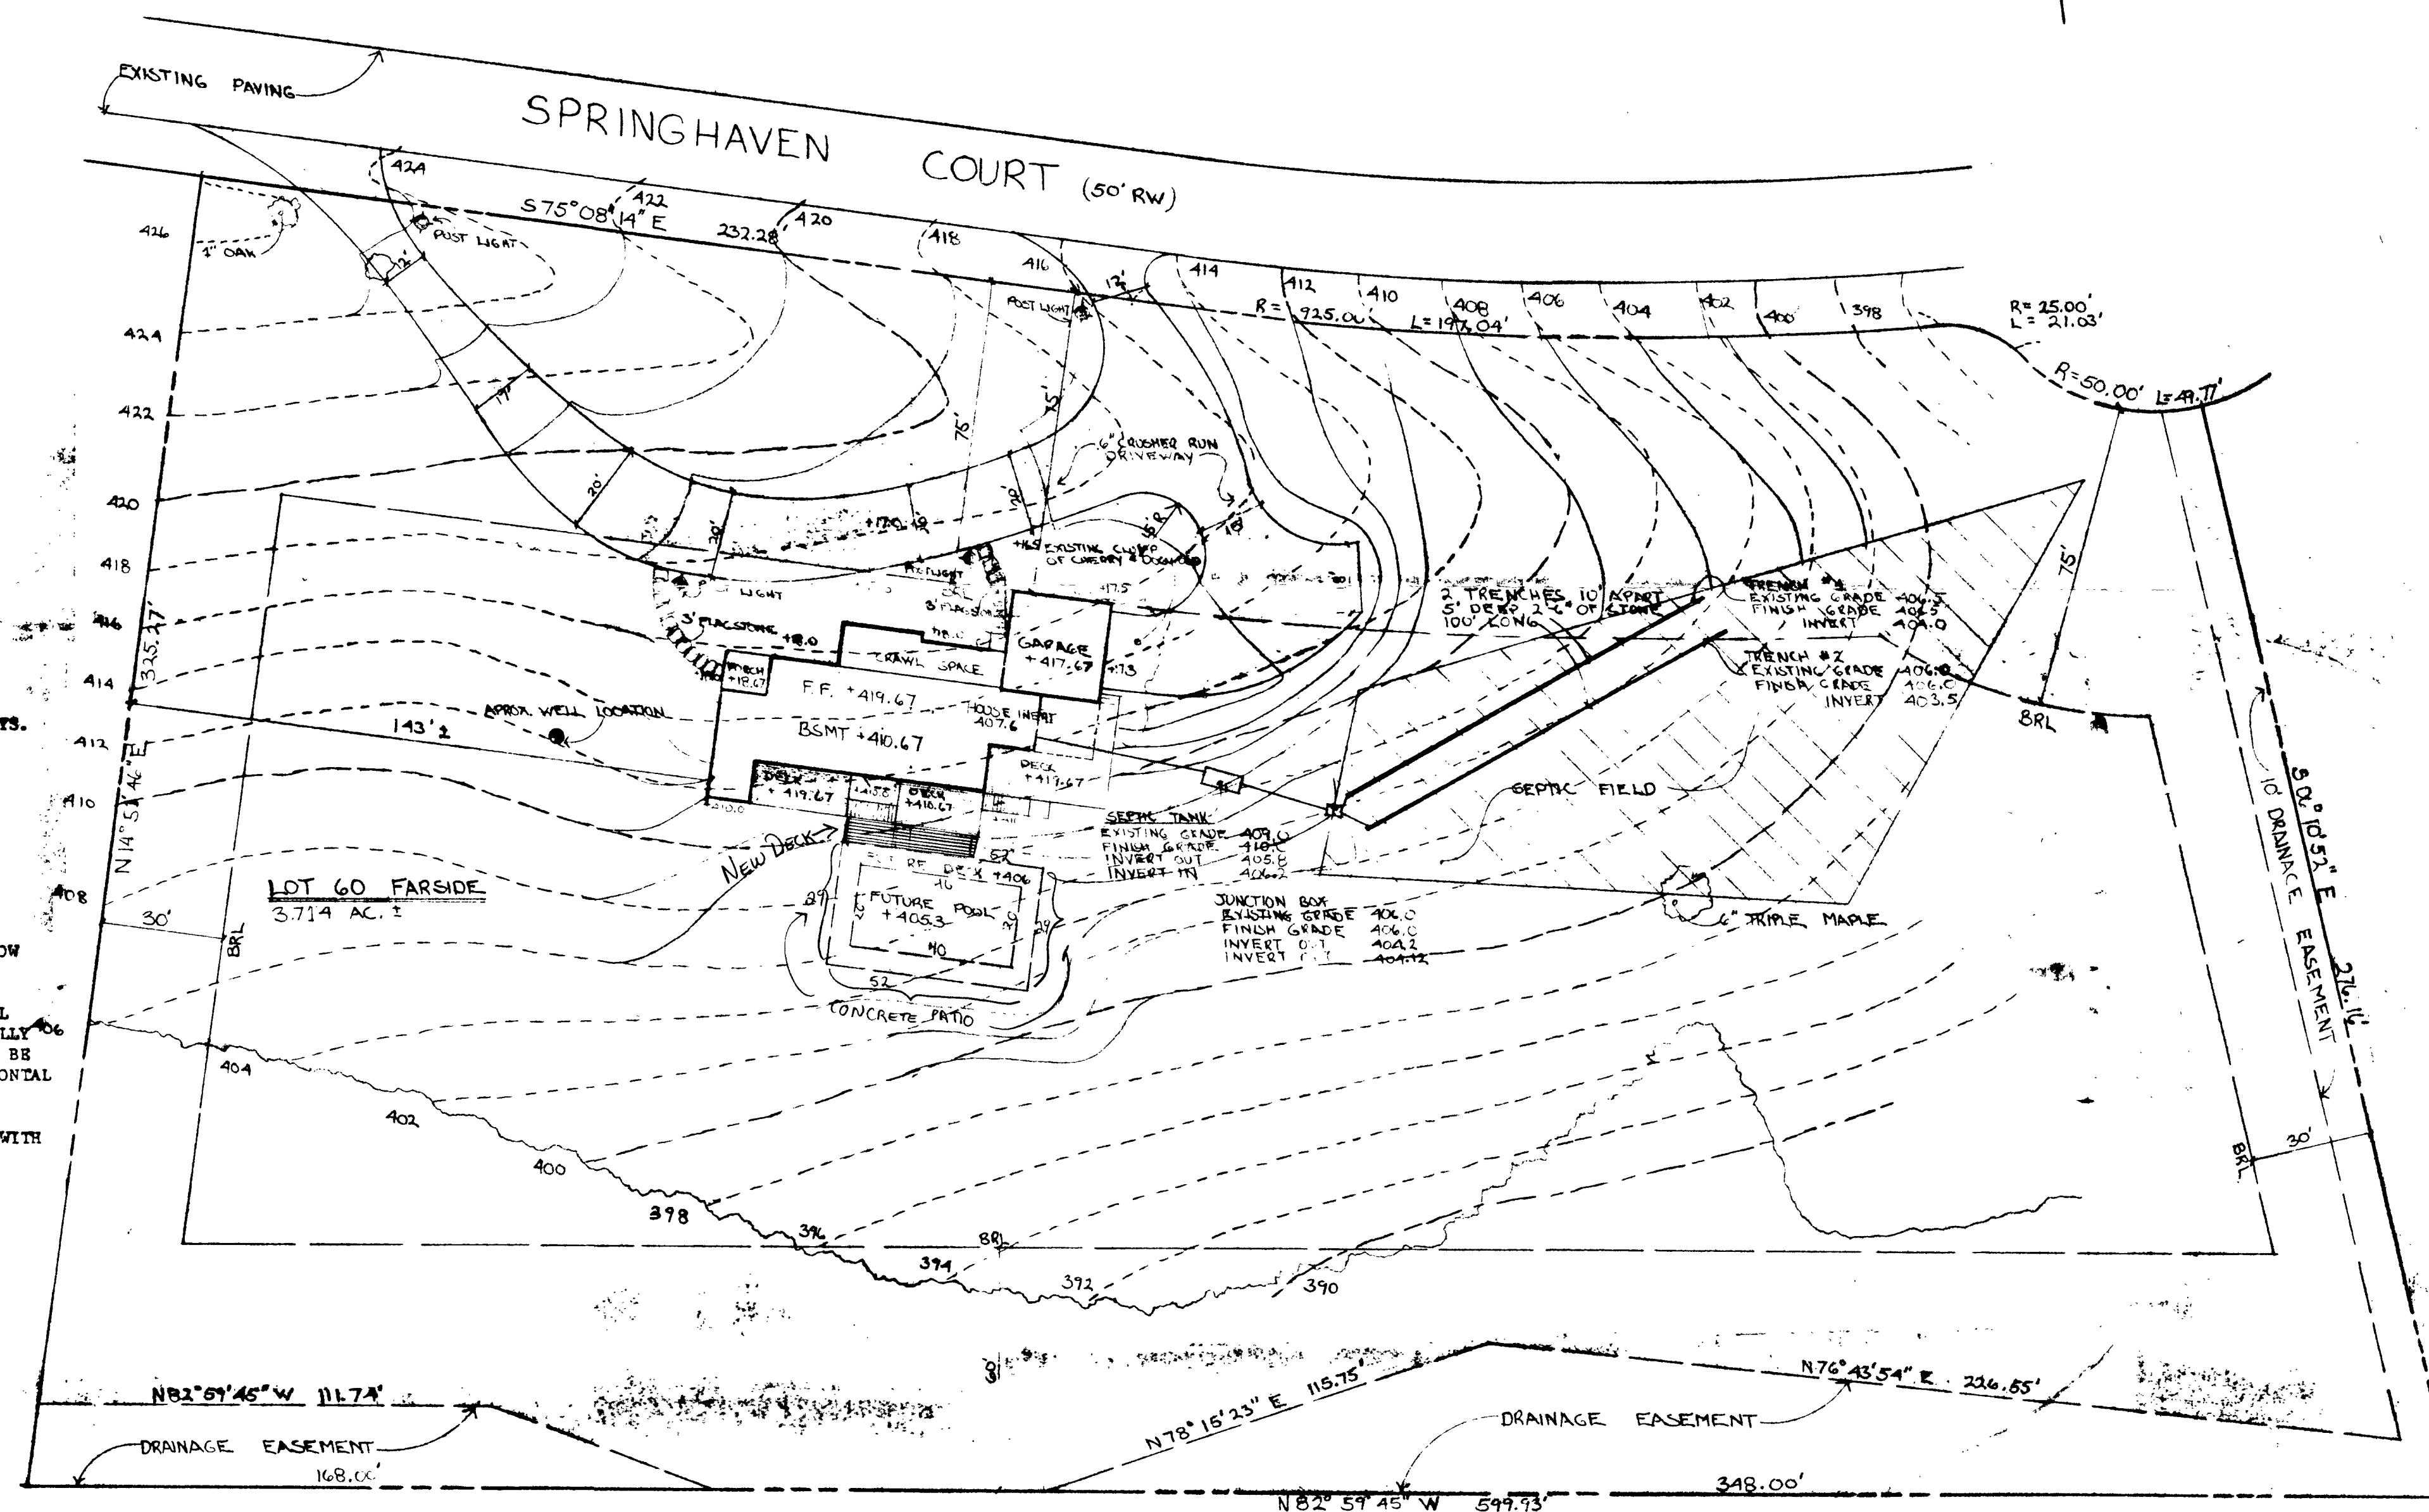

NO OF APPROVED B.E. (KEEP 11-LINE)
OK TO PLO
AS SEWAGE CONNECTION
6-21-83
C. J. RIEDY