

PERMIT

SEWAGE DISPOSAL SYSTEM

DEPARTMENT OF HEALTH AND MENTAL HYGIENE

HOWARD COUNTY HEALTH DEPARTMENT

BUREAU OF ENVIRONMENTAL HEALTH

~~XXXXXXXX~~ 313-2640

05-358876

INDEXED

P 49555

A REPAIR

DISTRICT _____

DATE 8/24/93

DATE SYSTEM APPROVED 7/6/93

INSPECTOR RF

Jack Fyock

IS PERMITTED TO INSTALL _____ ALTER X

ADDRESS _____ PHONE 988-9270

SUBDIVISION _____ LOT _____ ROAD 11890 Route 216

PROPERTY OWNER David Menges

11890 Route 216

ADDRESS Fulton, Maryland 20759

SEPTIC TANK CAPACITY 1250 GALLONS

NUMBER OF BEDROOMS 4

500 ¹³⁵ SQUARE FEET PER BEDROOM

LINEAR FEET OF TRENCH REQUIRED 125

REPAIR - PURPOSE - SEPTIC SYSTEM HAS FAILED.

CALL FOR INSPECTION WHEN GROUND IS OPENED SO SANITARIAN CAN RECOMMEND REPAIR. 06/29/9

PLANS APPROVED BY _____ DATE _____

COVER NO WORK UNTIL INSPECTED AND APPROVED

NEITHER THE HOWARD COUNTY COUNCIL NOR THE HEALTH DEPARTMENT IS RESPONSIBLE FOR THE SUCCESSFUL OPERATION OF ANY SYSTEM

NOTE: CLEANOUT REQUIRED EVERY 70 FEET OF SEWER LINE AND/OR AT 90° SWEEPS IN LINES FROM HOUSE TO DRAIN FIELDS, 90° ELBOWS NOT ACCEPTABLE.

NOTE: ALL PARTS OF SEPTIC SYSTEMS (I.E. TANK, DISTRIBUTION BOX TRENCHES) TO BE 100 FEET FROM WELL (UNLESS OTHERWISE SPECIFICALLY AUTHORIZED)

NOTE: IF DEEP TRENCH(ES) ARE USED CALL FOR INSPECTION BEFORE AND AFTER PLACING GRAVEL IN TRENCH(ES)

NOTE: NO DRY WELL SHALL EXCEED 15 FOOT IN DIAMETER NO ABSORPTION TRENCH TO EXCEED 100 FEET IN LENGTH

NOTE: ALL PIPE FROM HOUSE TO SEPTIC TANK MUST BE CAST IRON OR SCHEDULE 35/40 PVC OR ABS

PERMIT VOID AFTER TWO YEARS


NOTE: INSTALL STAND PIPE ON SEPTIC TANK AND DRY WELL STAND PIPES MUST BE 6 INCHES IN DIAMETER CAST IRON. CONCRETE OR TERRA COTTA OR PVA OR ABS ACCEPTED. IF TOP OF SEPTIC TANK IS DEEPER THAN 3 FEET. MANHOLE TO GRADE REQUIRED.

NOTE: DISTRIBUTION BOXES MUST HAVE BAFFLES

***INSTALLER IS RESPONSIBLE FOR OBTAINING FINAL APPROVAL ON THIS PERMIT**

R 49555

①
BROWN CLAY
PINK BROWN SAND LOAM
12

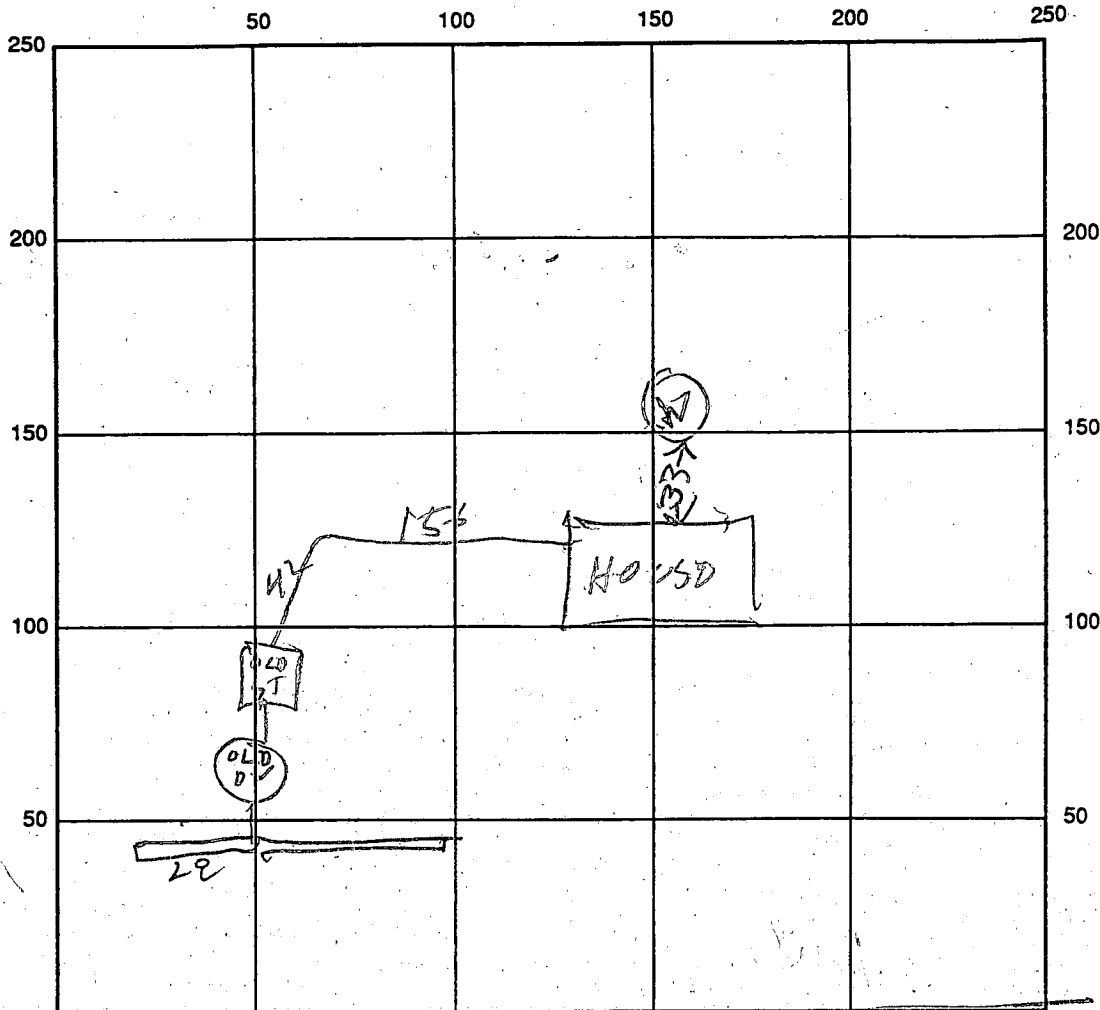

INDICATE NORTH - NAME ADJOINING ROADWAY AS BASE LINE

ROUTE 216

SEPTIC TANK LEVEL _____ CLEANOUTS _____

DISTRIBUTION BOX LEVEL _____

DRAIN FIELD/TITLE DEPTH 12 FT. TRENCH WIDTH 2 FT. INLET DEPTH 3 1/2 FT.

EFFECTIVE GRAVEL DEPTH 8 FT. TOTAL LENGTH 75 FT. 656

NUMBER OF TRENCHES 1 ONE SIDEWALL/BOTTOM AREA 600 SQ. FT.

DRYWALL INSIDE DIAMETER _____ FT. EFFECTIVE DEPTH BELOW INLET _____ FT.

ABSORBENT AREA _____ SQ. FT.

REMARKS: _____

DATE SYSTEM APPROVED 7/6/93 INSPECTOR Raymond Hodger

check out
6-7-66

approved
6/18/66
dwm

PERMIT

SEWAGE DISPOSAL SYSTEM

MARYLAND STATE DEPARTMENT OF HEALTH

HOWARD COUNTY

INDEXED

ELLICOTT CITY

DISTRICT 6

DATE 12/6/65

P 11324

A 10925

David R. Manges

IS PERMITTED TO INSTALL ☒ ALTER

ADDRESS 8224 - 14th Ave., Hyattsville, Md.

PHONE 434-4903

A SEWAGE DISPOSAL SYSTEM LOCATED AT

SUBDIVISION _____ ROAD Rt. 216 LOT _____

PROPERTY OWNER E. E. Judy & David R. Manges

ADDRESS _____

SPECIFICATIONS - 3 bedrooms

DRAIN FIELD _____ DEPTH _____ FEET, BOTTOM AREA _____ SQ. FT.

SEEPAGE PITS _____ ABSORBENT SIDE-WALL AREA _____ SQ. FT.

SEPTIC TANK CAPACITY 750 GALLONS

FOR GARBAGE GRINDER, INCREASE DISPOSAL AREA 22% & TANK CAPACITY 50%.

OTHER Dry well - 300 sq. ft. sidewall area below the inlet.

Place the dry well 30 ft. to 50 ft. from the left side of the lot as seen when facing the lot from Route 216 and 25 ft. to 50 ft. from the front lot line.

Place the tank at least 50 ft. from the well and use cast iron sewer lines within a 50 ft. radius of the well. Place the dry well at least 100 ft. from the well.


PLANS APPROVED BY Raymond Hodges DATE 11/29/65

FILL SEPTIC TANK AND DISTRIBUTION BOX WITH WATER BEFORE CALLING FOR AN INSPECTION. COVER NO WORK UNTIL INSPECTED AND APPROVED.

NEITHER THE HOWARD COUNTY COMMISSIONERS NOR THE HEALTH DEPARTMENT IS RESPONSIBLE FOR THE SUCCESSFUL OPERATION OF ANY SYSTEM.

A
10925

3.14 1/2
 11 1/2
 758
 314
 314
 36.1
 36 1/2
 8 1/2
 18
 288
 906

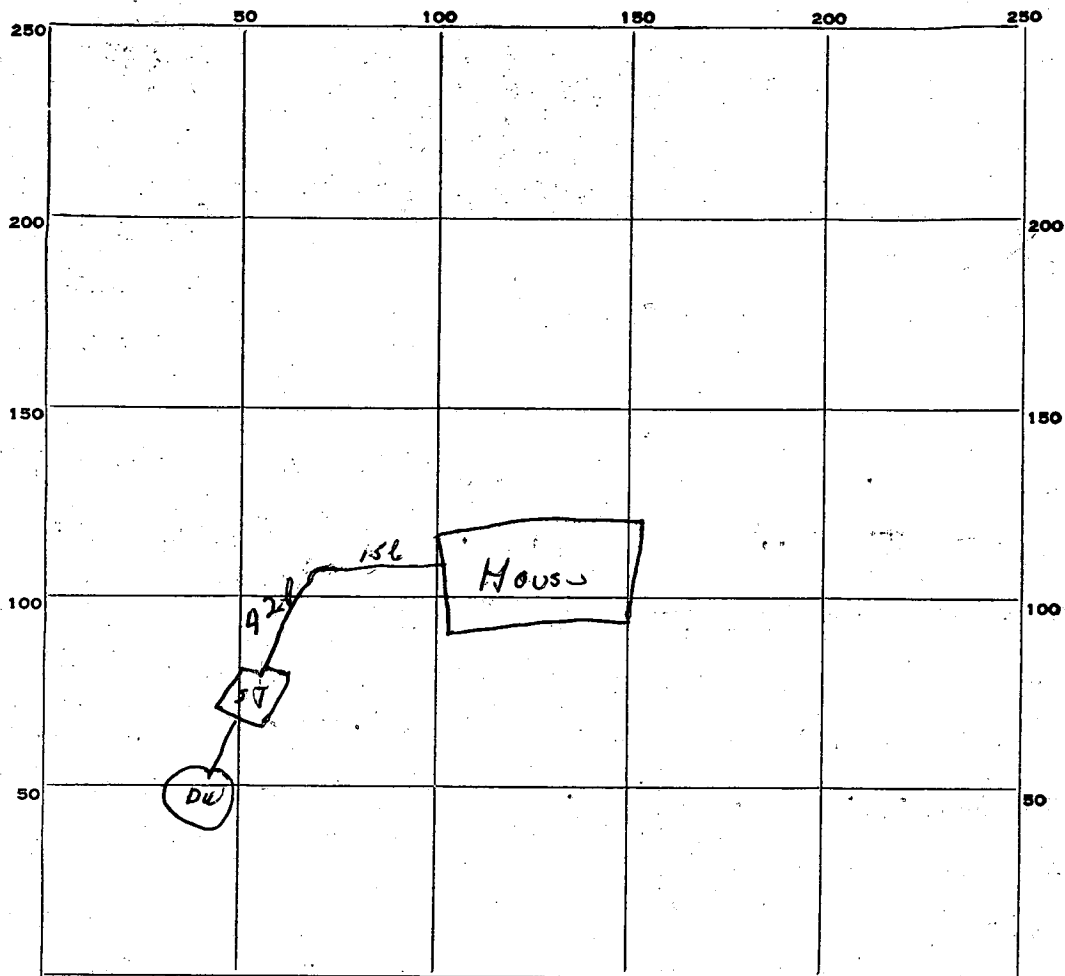

95
 66
 27

PERMIT CARD OK

SEPTIC TANK, LEVEL OK

CLEANOUTS OK

DISTRIBUTION BOX, LEVEL _____

TILE FIELD, DEPTH _____ FT. TRENCH WIDTH _____ FT.

GRAVEL DEPTH _____ IN. TOTAL LENGTH _____ FT.

NUMBER OF TRENCHES _____ TOTAL BOTTOM AREA _____

Oil wall f dirt wall
SEEPAGE PITS, INSIDE DIAMETER 18 1/2" FT. DEPTH BELOW INLET 8 1/2" FT.

ABSORBENT AREA 306 SQ. FT.

REMARKS _____

DATE SYSTEM APPROVED 6-16-66

INSPECTOR Dw. Monaghan

APPLICATION

SEWAGE DISPOSAL TESTING

MARYLAND STATE DEPARTMENT OF HEALTH

HOWARD COUNTY 750 Gallon Tank

ELLICOTT CITY

DISTRICT 6th

DATE 9/13/65

Fill out in triplicate.

Make \$15.00 check payable to:

Howard County Health Dept. - Sanitation

Drywell - 300 sq ft sidewall area below the inlet

Place the dry well 30 ft to 50 ft from the left side of the lot as seen when facing the lot from Route 216 and 25 ft to 50 ft from the front lot line. Place the tank at least 50 ft from the well and use

TO: THE COUNTY HEALTH OFFICER
ELLICOTT CITY, MARYLAND

I, HEREBY, APPLY FOR THE NECESSARY TESTS IN ORDER TO CONSTRUCT OR RECONSTRUCT A SEWAGE DISPOSAL SYSTEM. Cast iron sewer lines within a 50 ft Radius of the well. Place the dry well at least

PROPERTY OWNER E. E. JUDY + DAVID R MANGES

ADDRESS 8224 14th AVE Hyattsville Md. PHONE 434 4903

PROPERTY LOCATION:

SUBDIVISION

LOT NO.

ROAD AND DESCRIPTION

Route 216 Fulton Md. 3rd house on right past the St. Paul's Lutheran Church in Fulton - Church 1 mile from Rt. 29

OCCUPANT

E. E. Judy

PHONE PA 52857

PERSON TO CONSTRUCT SYSTEM

DAVID R MANGES

ADDRESS 8224 14th AVE

PHONE 434 4903

SIZE OF LOT

.930 ACRE

TYPE BLDG.

THREE
NUMBER OF BEDROOMS

IF NOT SINGLE RESIDENCE DESCRIBE

SIGNATURE OF APPLICANT

David R Manges

APPROVED BY

Raymond Hodges FOR Dry Well

DATE 11/29/65

REJECTED BY

FOR

(KIND OF SYSTEM)


DATE

HOLD PENDING FURTHER TESTS

DATE

REASONS FOR REJECTION OR HOLDING

THIS IS NOT A PERMIT

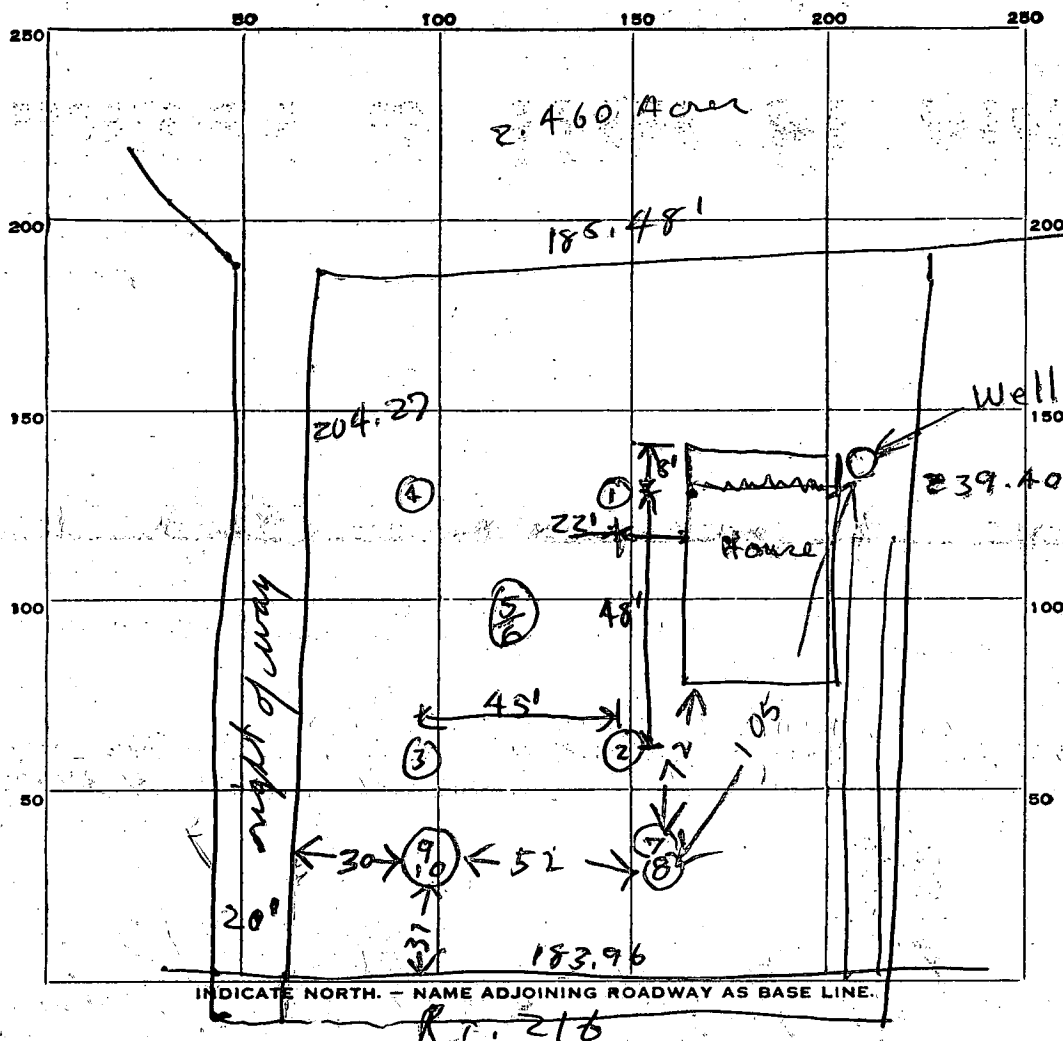

4 3 2


anne 9/50 RT

DATE	TEST NO.	DEPTH	PRE-WET		TEST - 1" DROP		TIME
			START	STOP	START	STOP	
9/23/65	1	3 ft	9:53	failed little space			
	2	3 ft.	9:58	" "	" "	" "	
	3	3 ft.	10:00	" "	" "	" "	
	4	3 ft.	10:01	" "	" "	" "	
	5	9 ft	10:04	10:14	10:14		
	6	5 ft	10:05	failed little space			
10 NOV 65	7	12 1/2	9:56	10:06	10:01	10:07	6
10 NOV 65	8	6 1/2	9:57	10:04	10:04	10:15	11
10 NOV 65	9	11	10:17	10:20	10:20	10:25	5
10 NOV 65	10	6	10:19	10:23	10:23	10:31	8

SOIL AUGER FINDING

TESTED BY R.D.F. 9/23/65

REMARKS

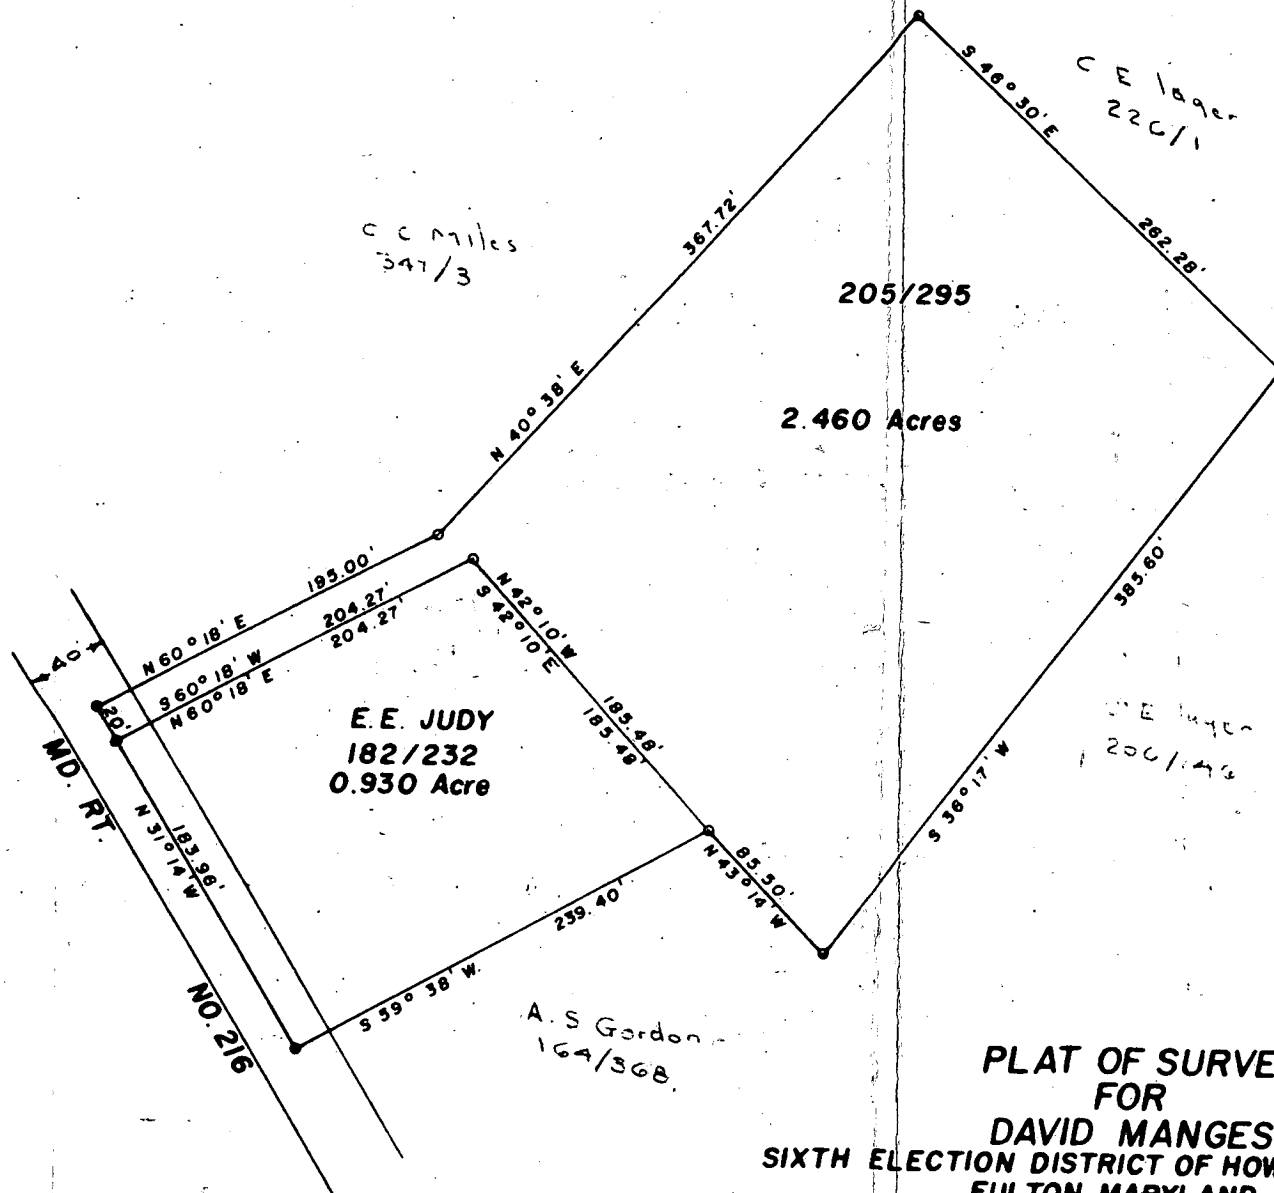

PLAT OF SURVEY
FOR
DAVID MANGES
SIXTH ELECTION DISTRICT OF HOWARD COUNTY
FULTON, MARYLAND
SCALE: 1 IN. = 100 FT. SEPTEMBER 1, 1965

Owner: Ethel E. Judy
Fulton, Maryland

Claude M. Skinner Jr.
Claude M. Skinner Jr. Reg. Engineer & Land Surveyor No. 2237
11 Court Place
Ellicott City, Maryland

Facilities: Private Water & Sewerage

Approved: Type of Facilities above


S/S Per Mr. Shrop
Dr. Theodore R. Shrop
Howard County Health Officer


Date

Approved:

Thomas G. Harris Jr.
Planning Director
Howard County Planning Commission

Date

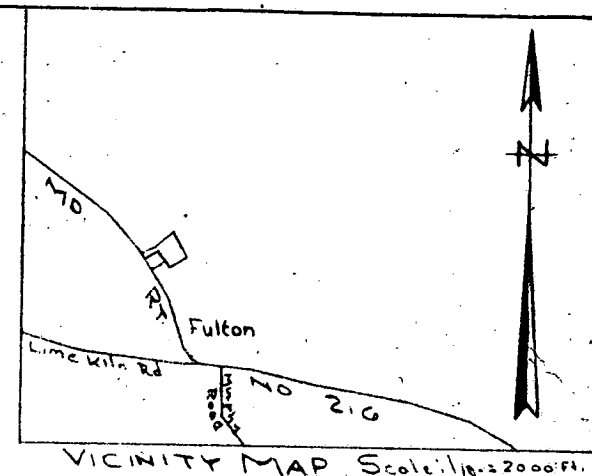

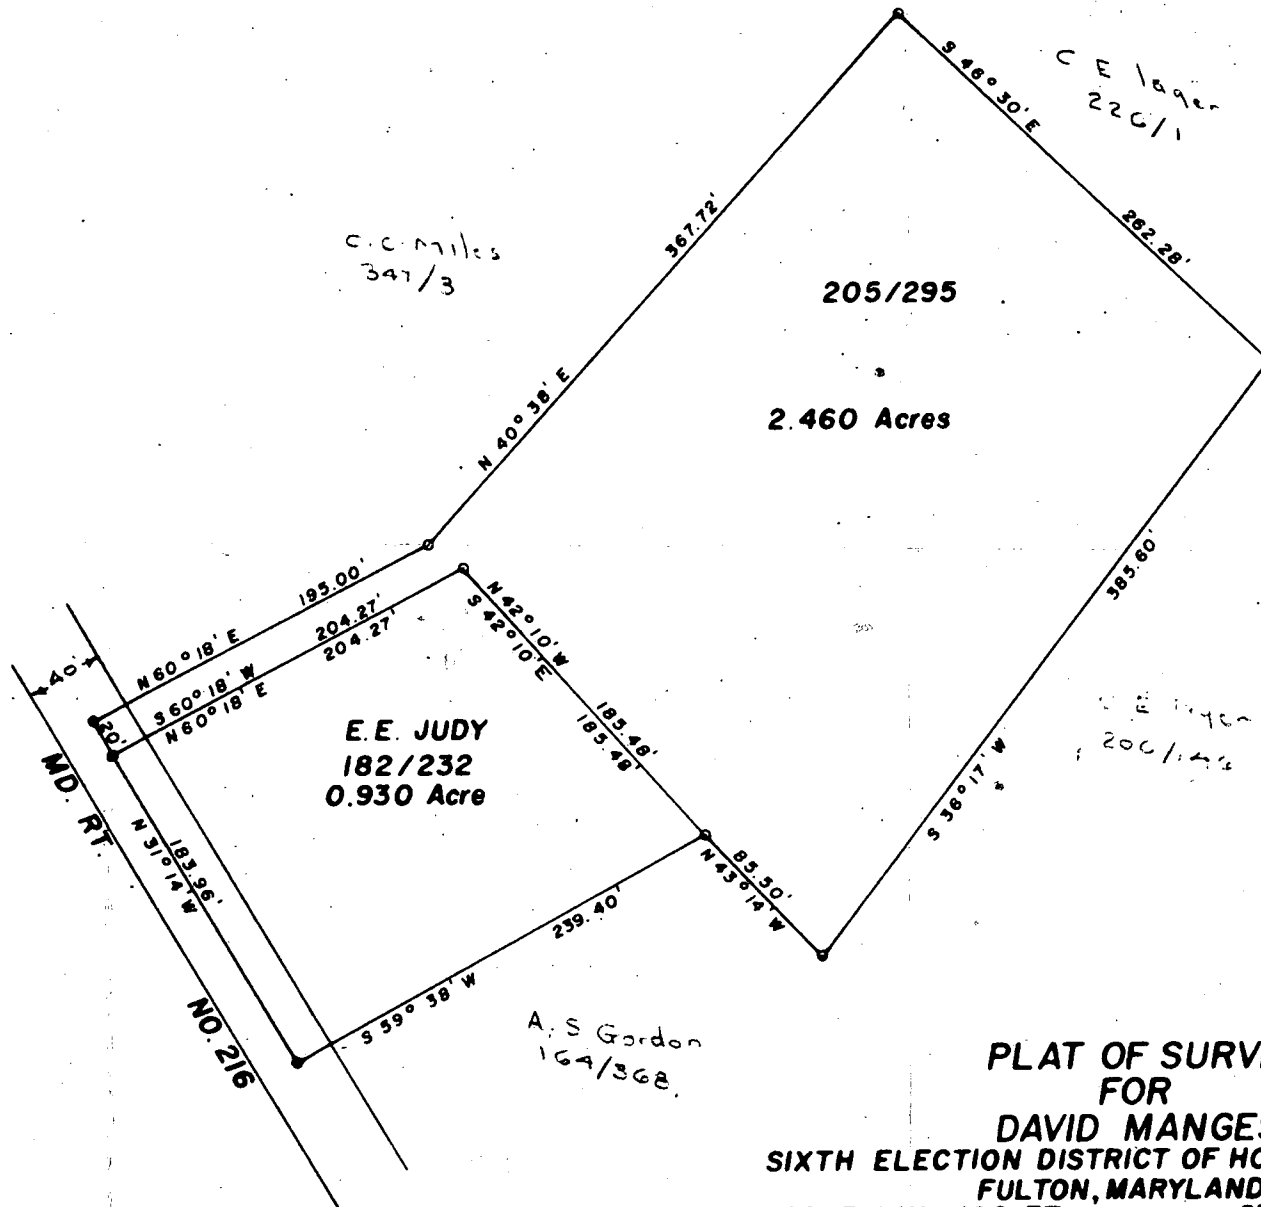


**PLAT OF SURVEY
FOR
DAVID MANGES
SIXTH ELECTION DISTRICT OF HOWARD COUNTY
FULTON, MARYLAND
SCALE: 1 IN. = 100 FT. SEPTEMBER 1, 1965**

Claude M. Skinner Jr.

Claude M. Skinner Jr. Reg. Engineer & Land Surveyor No. 2237
11 Court Place
Ellicott City, Maryland

Owner: Ethel E. Judy
Fulton, Maryland

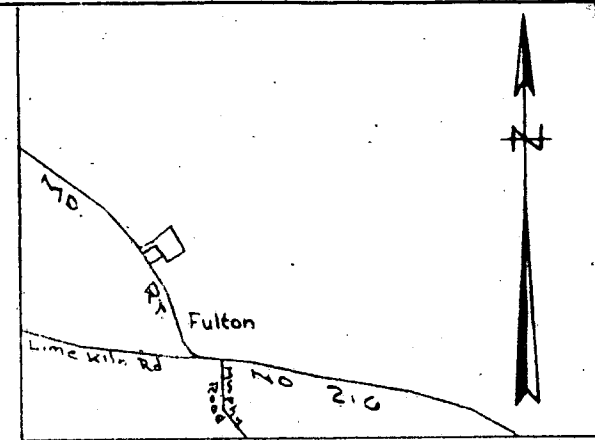

Facilities: Private Water & Sewerage

Approved: Type of Facilities above

Dr. Theodore R. Shrop
Howard County Health Officer,

Date

Approved:

Thomas G. Harris Jr.
Planning Director
Howard County Planning Commission

Date