

8/30/93 ASAT

PERMIT

SEWAGE DISPOSAL SYSTEM

DEPARTMENT OF HEALTH AND MENTAL HYGIENE

HOWARD COUNTY HEALTH DEPARTMENT

BUREAU OF ENVIRONMENTAL HEALTH

~~XXXX-XXXX~~ 313-2640

05-364310

INDEXED

P 49598

A REPAIR

DISTRICT _____

DATE 9/9/93

DATE SYSTEM APPROVED 8/30/93

INSPECTOR RH

Jack Fyock

IS PERMITTED TO INSTALL _____ ALTER X

ADDRESS _____

PHONE 988-9270

Tax Map: 22

SUBDIVISION _____

LOT Parcel: 150

ROAD 4189 Ten Oaks Road

PROPERTY OWNER _____

Richard Rayer

4189 Ten Oaks Road

ADDRESS _____

Dayton, Maryland 21036

SEPTIC TANK CAPACITY _____ GALLONS

NUMBER OF BEDROOMS 3

125 SQUARE FEET PER BEDROOM

LINEAR FEET OF TRENCH REQUIRED 48

REPAIR - PURPOSE - SEPTIC SYS TEM HAS FAILED.

Call for inspection when ground is opened so sanitarian can recommend repair. 08/30/93

8/30/93

TRENCH OFF OLD DRY WELL IN BACK YARD
2FT WIDE, 48FT LONG, INLET 3FT BELOW
GRADE 8 FT STONE BIT

PLANS APPROVED BY _____

DATE _____

COVER NO WORK UNTIL INSPECTED AND APPROVED

NEITHER THE HOWARD COUNTY COUNCIL NOR THE HEALTH DEPARTMENT IS RESPONSIBLE FOR THE SUCCESSFUL OPERATION OF ANY SYSTEM

NOTE: CLEANOUT REQUIRED EVERY 70 FEET OF SEWER LINE AND/OR AT 90° SWEEPS IN LINES FROM HOUSE TO DRAIN FIELDS, 90° ELBOWS NOT ACCEPTABLE.

NOTE: ALL PARTS OF SEPTIC SYSTEMS (I.E. TANK, DISTRIBUTION BOX TRENCHES) TO BE 100 FEET FROM WELL (UNLESS OTHERWISE SPECIFICALLY AUTHORIZED)

NOTE: IF DEEP TRENCH(ES) ARE USED CALL FOR INSPECTION BEFORE AND AFTER PLACING GRAVEL IN TRENCH(ES)

NOTE: NO DRY WELL SHALL EXCEED 15 FOOT IN DIAMETER NO ABSORPTION TRENCH TO EXCEED 100 FEET IN LENGTH

NOTE: ALL PIPE FROM HOUSE TO SEPTIC TANK MUST BE CAST IRON OR SCHEDULE 35/40 PVC OR ABS

PERMIT VOID AFTER TWO YEARS


NOTE: INSTALL STAND PIPE ON SEPTIC TANK AND DRY WELL STAND PIPES MUST BE 6 INCHES IN DIAMETER CAST IRON. CONCRETE OR TERRA COTTA OR PVA OR ABS ACCEPTED. IF TOP OF SEPTIC TANK IS DEEPER THAN 3 FEET. MANHOLE TO GRADE REQUIRED.

NOTE: DISTRIBUTION BOXES MUST HAVE BAFFLES

*INSTALLER IS RESPONSIBLE FOR OBTAINING FINAL APPROVAL ON THIS PERMIT

①
BROWN
SAND
LOAM
2
TAN
PINK
BROWN
SAND
LOAM

POACH
(TANK INSIDE
OF PORCH)

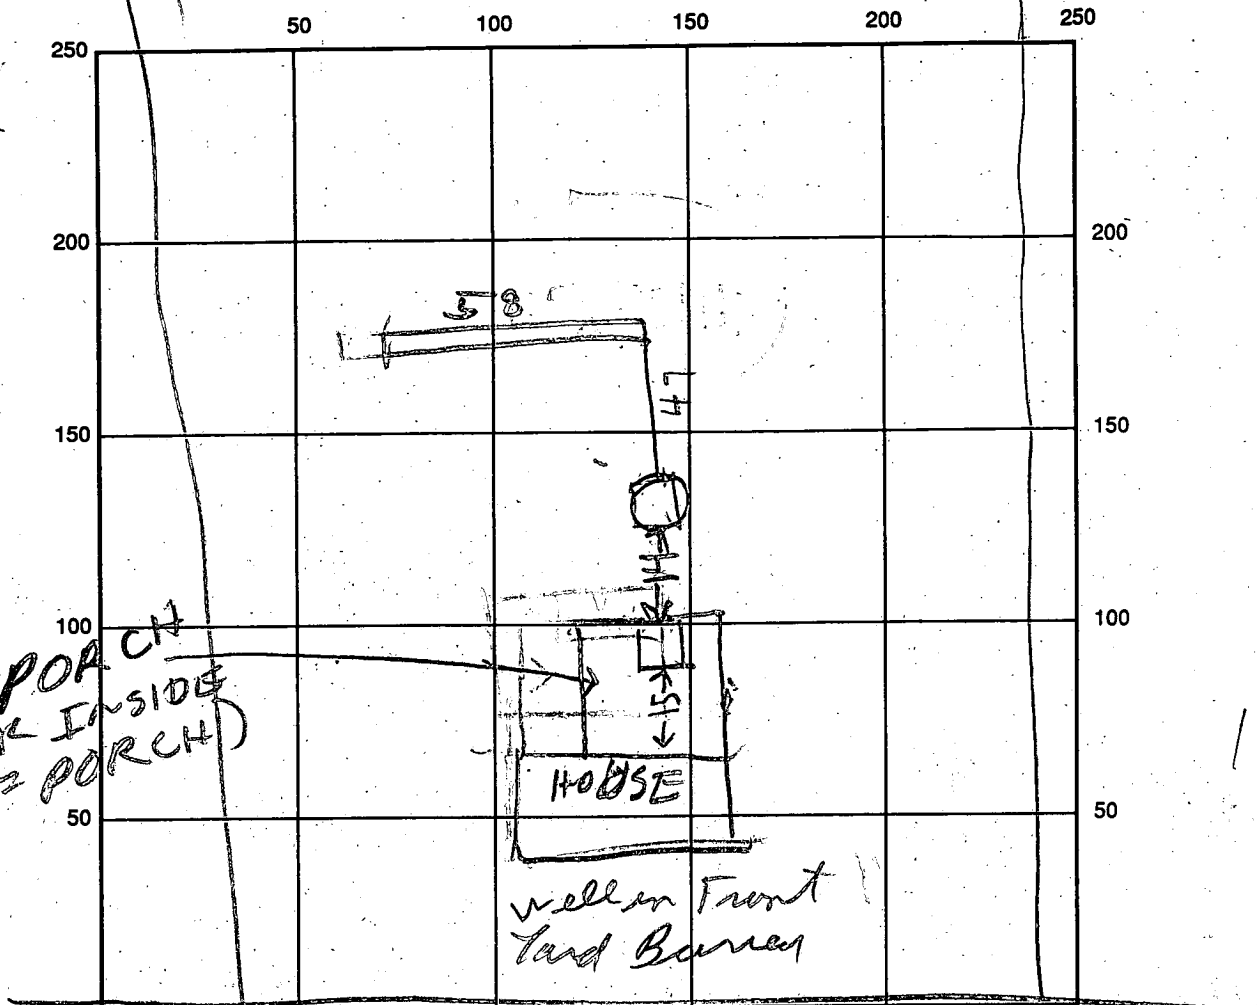

INDICATE NORTH - NAME ADJOINING ROADWAY AS BASE LINE

TEN OAKS

SEPTIC TANK LEVEL _____ CLEANOUTS _____

DISTRIBUTION BOX LEVEL _____

DRAIN FIELD/TITLE DEPTH 11 FT. TRENCH WIDTH 2 FT. INLET DEPTH 3 FT.

EFFECTIVE GRAVEL DEPTH 3 FT. TOTAL LENGTH 58 FT.


NUMBER OF TRENCHES 1 ONE SIDEWALL/BOTTOM AREA 464 SQ. FT.

DRYWALL INSIDE DIAMETER _____ FT. EFFECTIVE DEPTH BELOW INLET _____ FT.

ABSORBENT AREA _____ SQ. FT.

REMARKS: 8/30/93 PORCH INSTALL OVER SEPTIC
TANK. COULD NOT DETERMINE WHICH LOT
I GORDON WALKER SUBDIVISION R/H

DATE SYSTEM APPROVED 8/30/93 INSPECTOR Raymond Dodge

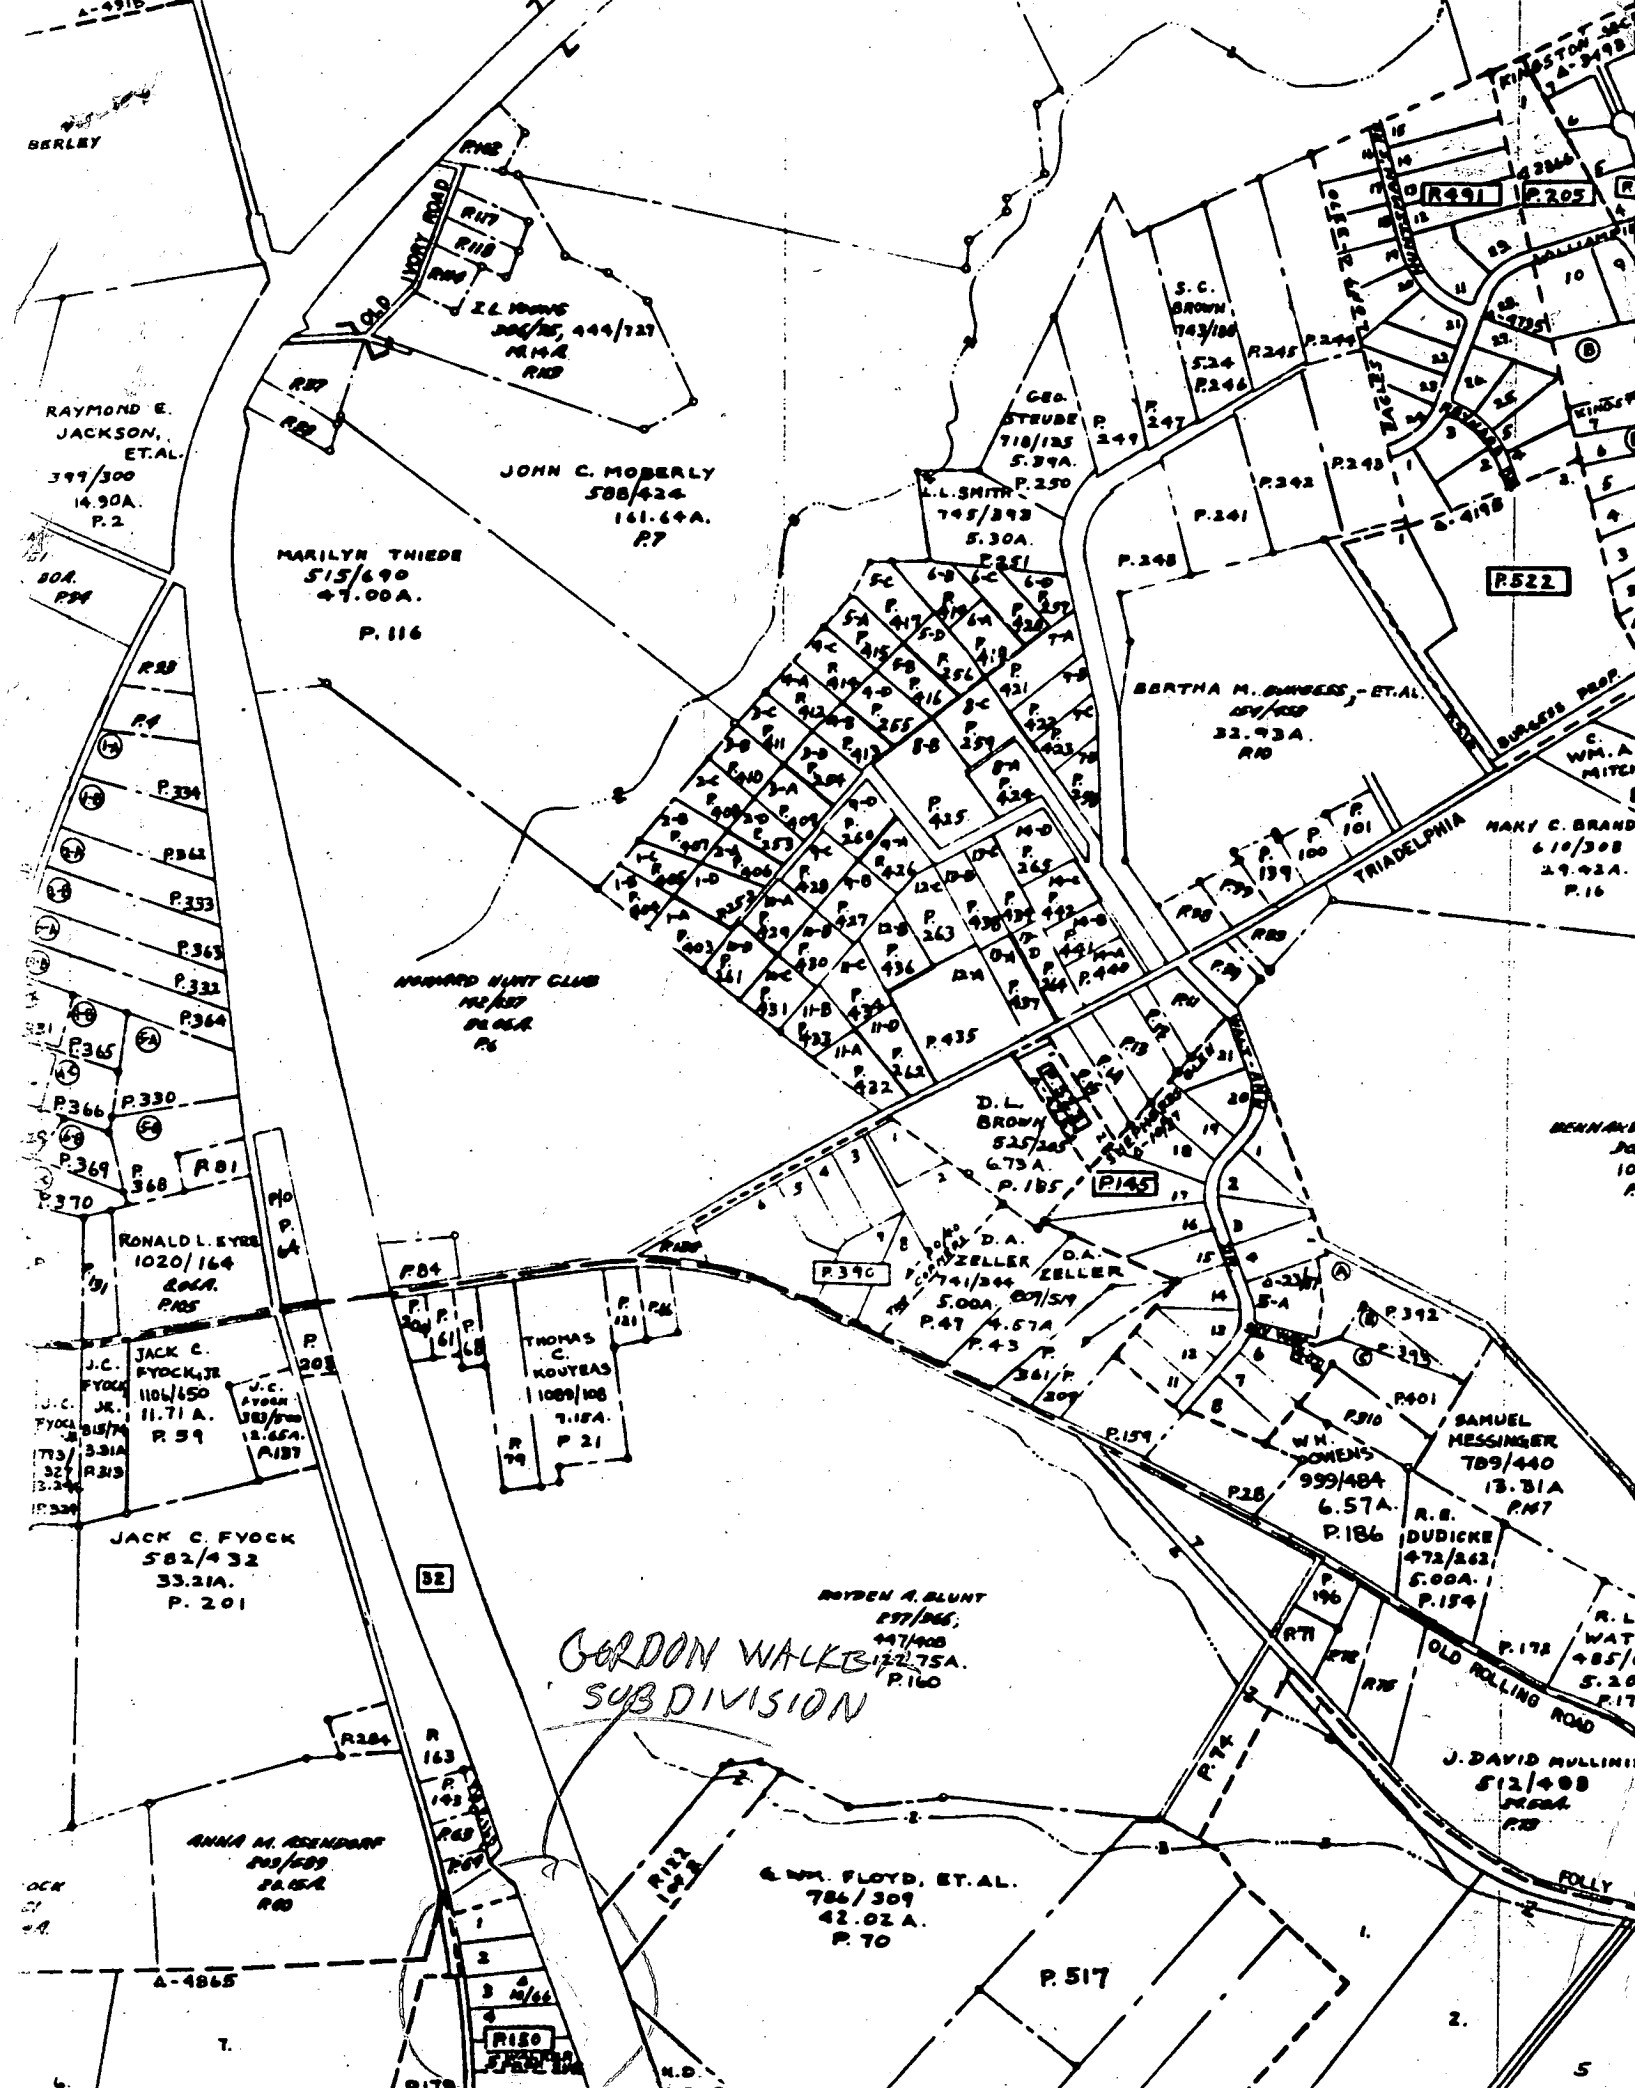

RAYMOND E. JACKSON, ET AL.
399/300
14.90A.
P. 2

MARILYN THIEDE
515/690
47.00A.
P. 116

JOHN C. MOBERLY
588/424
161.64A.
P. 7

HUNTER HUNT CLUB
142/187
P. 68A
P. 6

RONALD L. EYRE
1020/164
20A.
P. 85

JACK C. FYOCK, JR.
1106/150
11.71A.
P. 59

JACK C. FYOCK
582/432
33.21A.
P. 201

THOMAS C. KOUTRAS
1089/108
7.18A.
P. 21

ROYDEN A. BLUNT
P. 166;
447/408
122.75A.
P. 160

GORDON WALKS
SUBDIVISION

E. W. FLOYD, ET AL.
786/309
42.02A.
P. 70

P. 517

J. DAVID MULLIN
512/408
P. 68A
P. 70

SAMUEL MESSINGER
789/440
13.31A
P. 17

W. H. JONES
999/484
6.57A.
P. 186

R. B. DUDICKE
472/262
5.00A.
P. 154

BERTHA M. GUNDESS, ET AL.
154/458
22.93A.
P. 10

HANK C. BRAND
610/308
29.92A.
P. 16

BENHAY
P. 10
P. 1

P. 522

GEO. STEUBE
718/125
5.39A.
P. 247

L. L. SMITH
745/392
5.30A.
P. 250

S. C. BROWN
743/186
5.24
P. 246

P. 491

P. 205

P. 4725

P. 4198

P. 4198

